



LITTLE ROCK A.F.B.
ARKANSAS

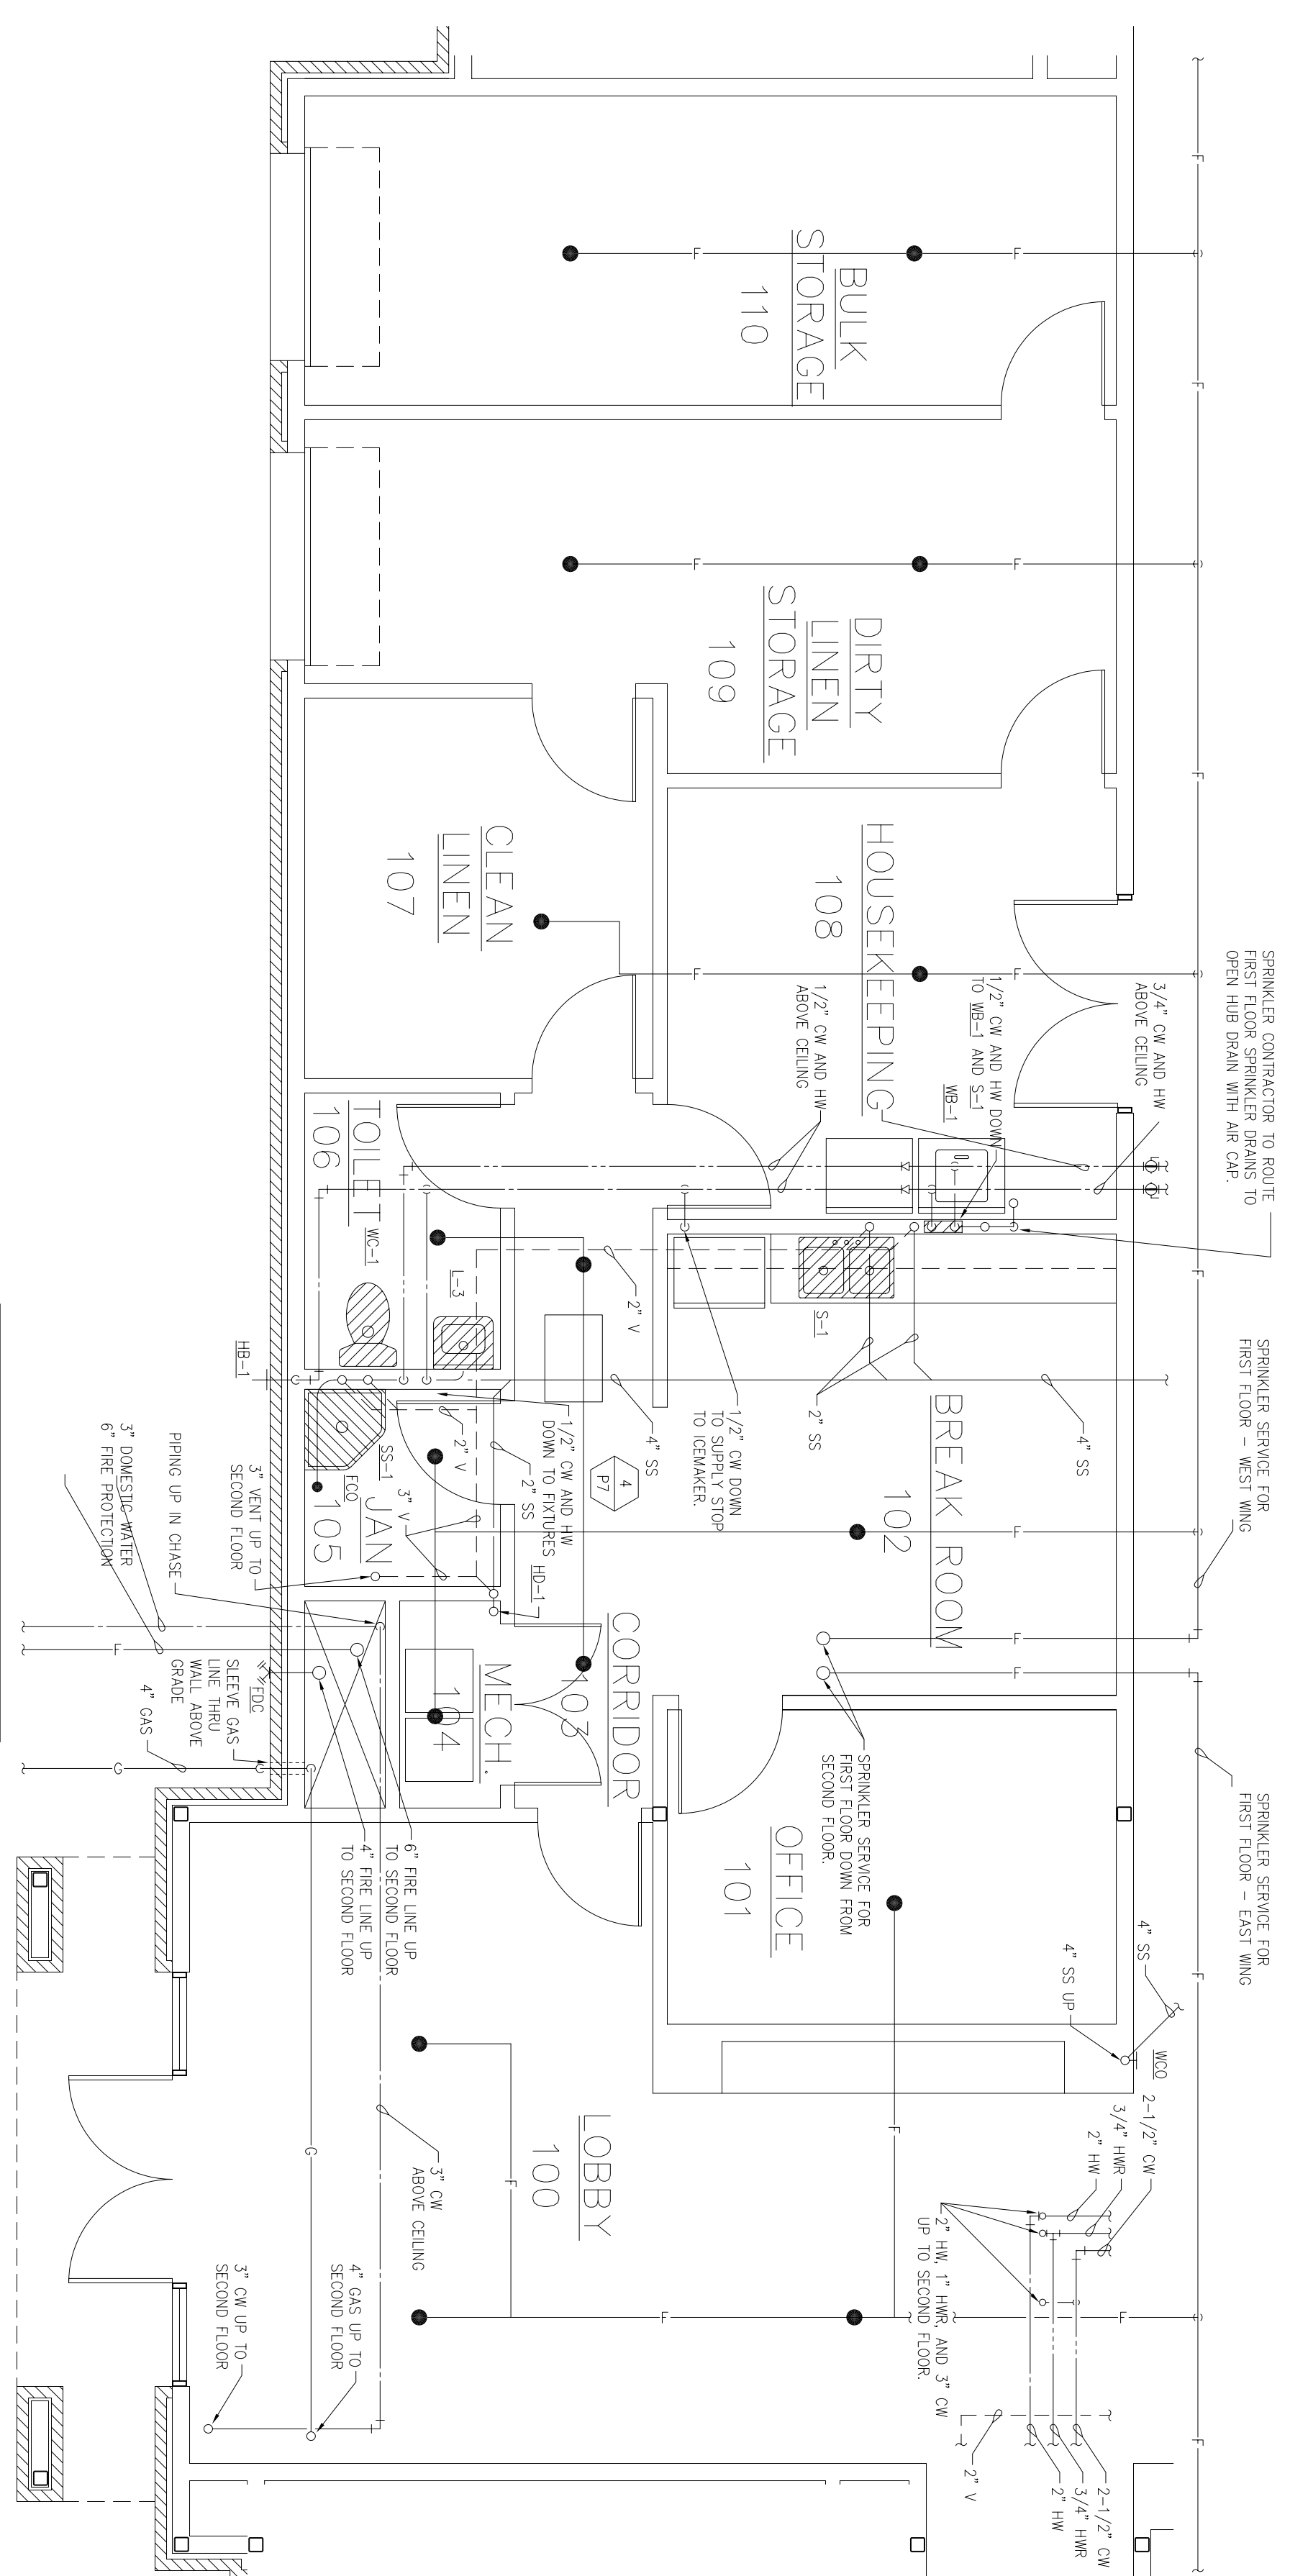

1 ENLARGED PLAN AT SERVICE AREA - PLUMBING
SCALE: 1/4"=1'-0"

- LEGEND:**
- PENDANT TYPE SPRINKLER HEAD
 - UPRIGHT TYPE SPRINKLER HEAD
 - ▲ SIDEWALL TYPE SPRINKLER HEAD
 - FIRE LINE
 - TAMPER SWITCH
 - FS FLOW SWITCH

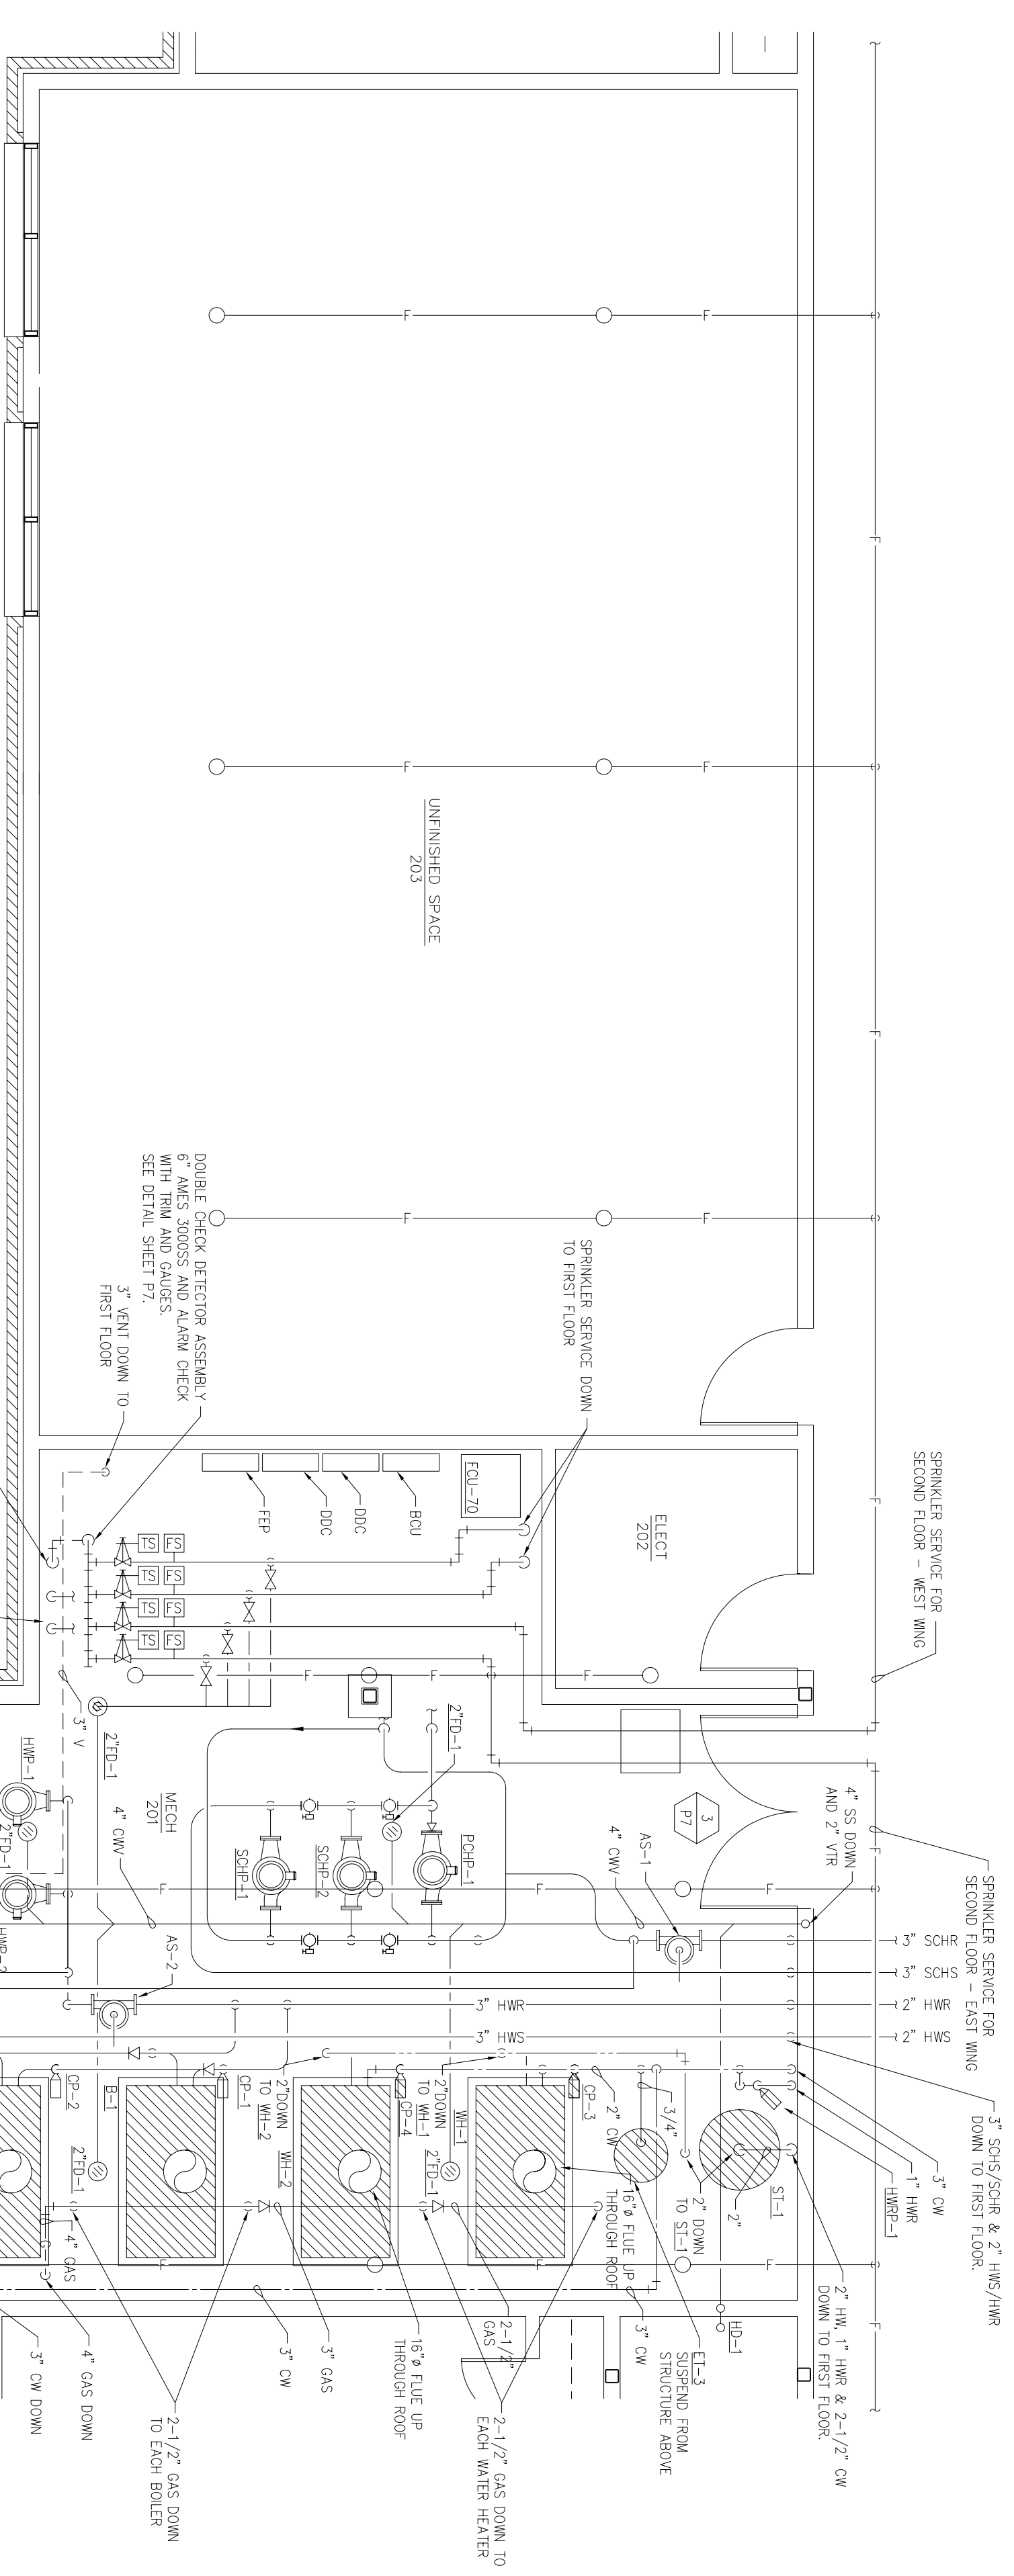

2 ENLARGED PLAN AT SECOND LEVEL - PLUMBING
SCALE: 1/4"=1'-0"

No.	Revision/Issue	Date	BY	APP'D
1	No changes from Design to As-Built			

PROJECT TITLE
TEMPORARY LODGING FACILITY

SHEET TITLE
PARTIAL PLANS - PLUMBING AS-BUILT

DRAWN BY PNS	LEAD DESIGNER WET
TITLE REVISOR	FILE LOCATION
DESIGNED BY LSK	PROJECT NUMBER NKA/A02-5001
DATE 28 MAY 2002	SHEET 91 of 108
SCALE 1/4" = 1'-0"	