


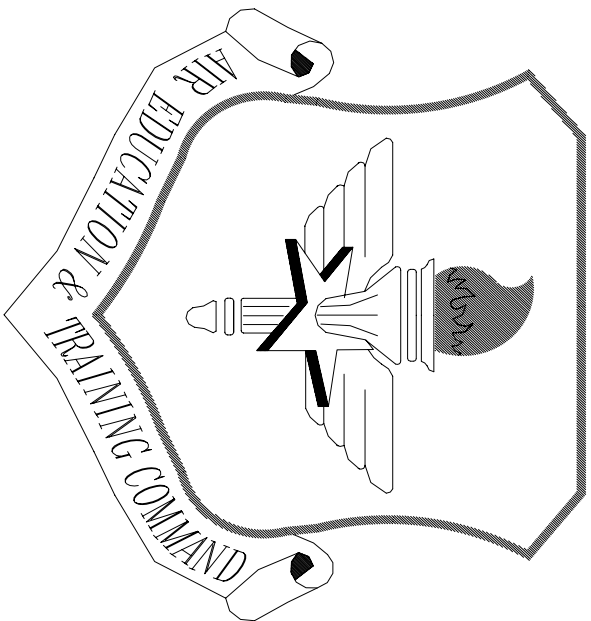

LITTLE ROCK A.F.B.
ARKANSAS


OWN. ENGINEER	CHIEF ENGINEER
CHIEF OF OPERATIONS	BIO ENVIRONMENTAL ENG.
TRNG CHIEF	SAFETY
PROGRAM MANAGER	USING AGENCY

No.	Revision/Issue	Date	BY	APP'D
1	Switch added for Range Hood			

PROJECT TITLE
TEMPORARY LODGING
FACILITY

SHEET TITLE
PARTIAL FIRST FLOOR
POWER & SYSTEMS
PLAN
AS-BUILT


DRAWN BY KRD	LEAD DESIGNER BRM
TECH. REVIEWER	FILE LOCATION
DESIGNED BY BTM	PROJECT NUMBER NKA002-5001
DATE 28 MAY 2002	SHEET E4
SCALE AS NOTED	95 OF 108

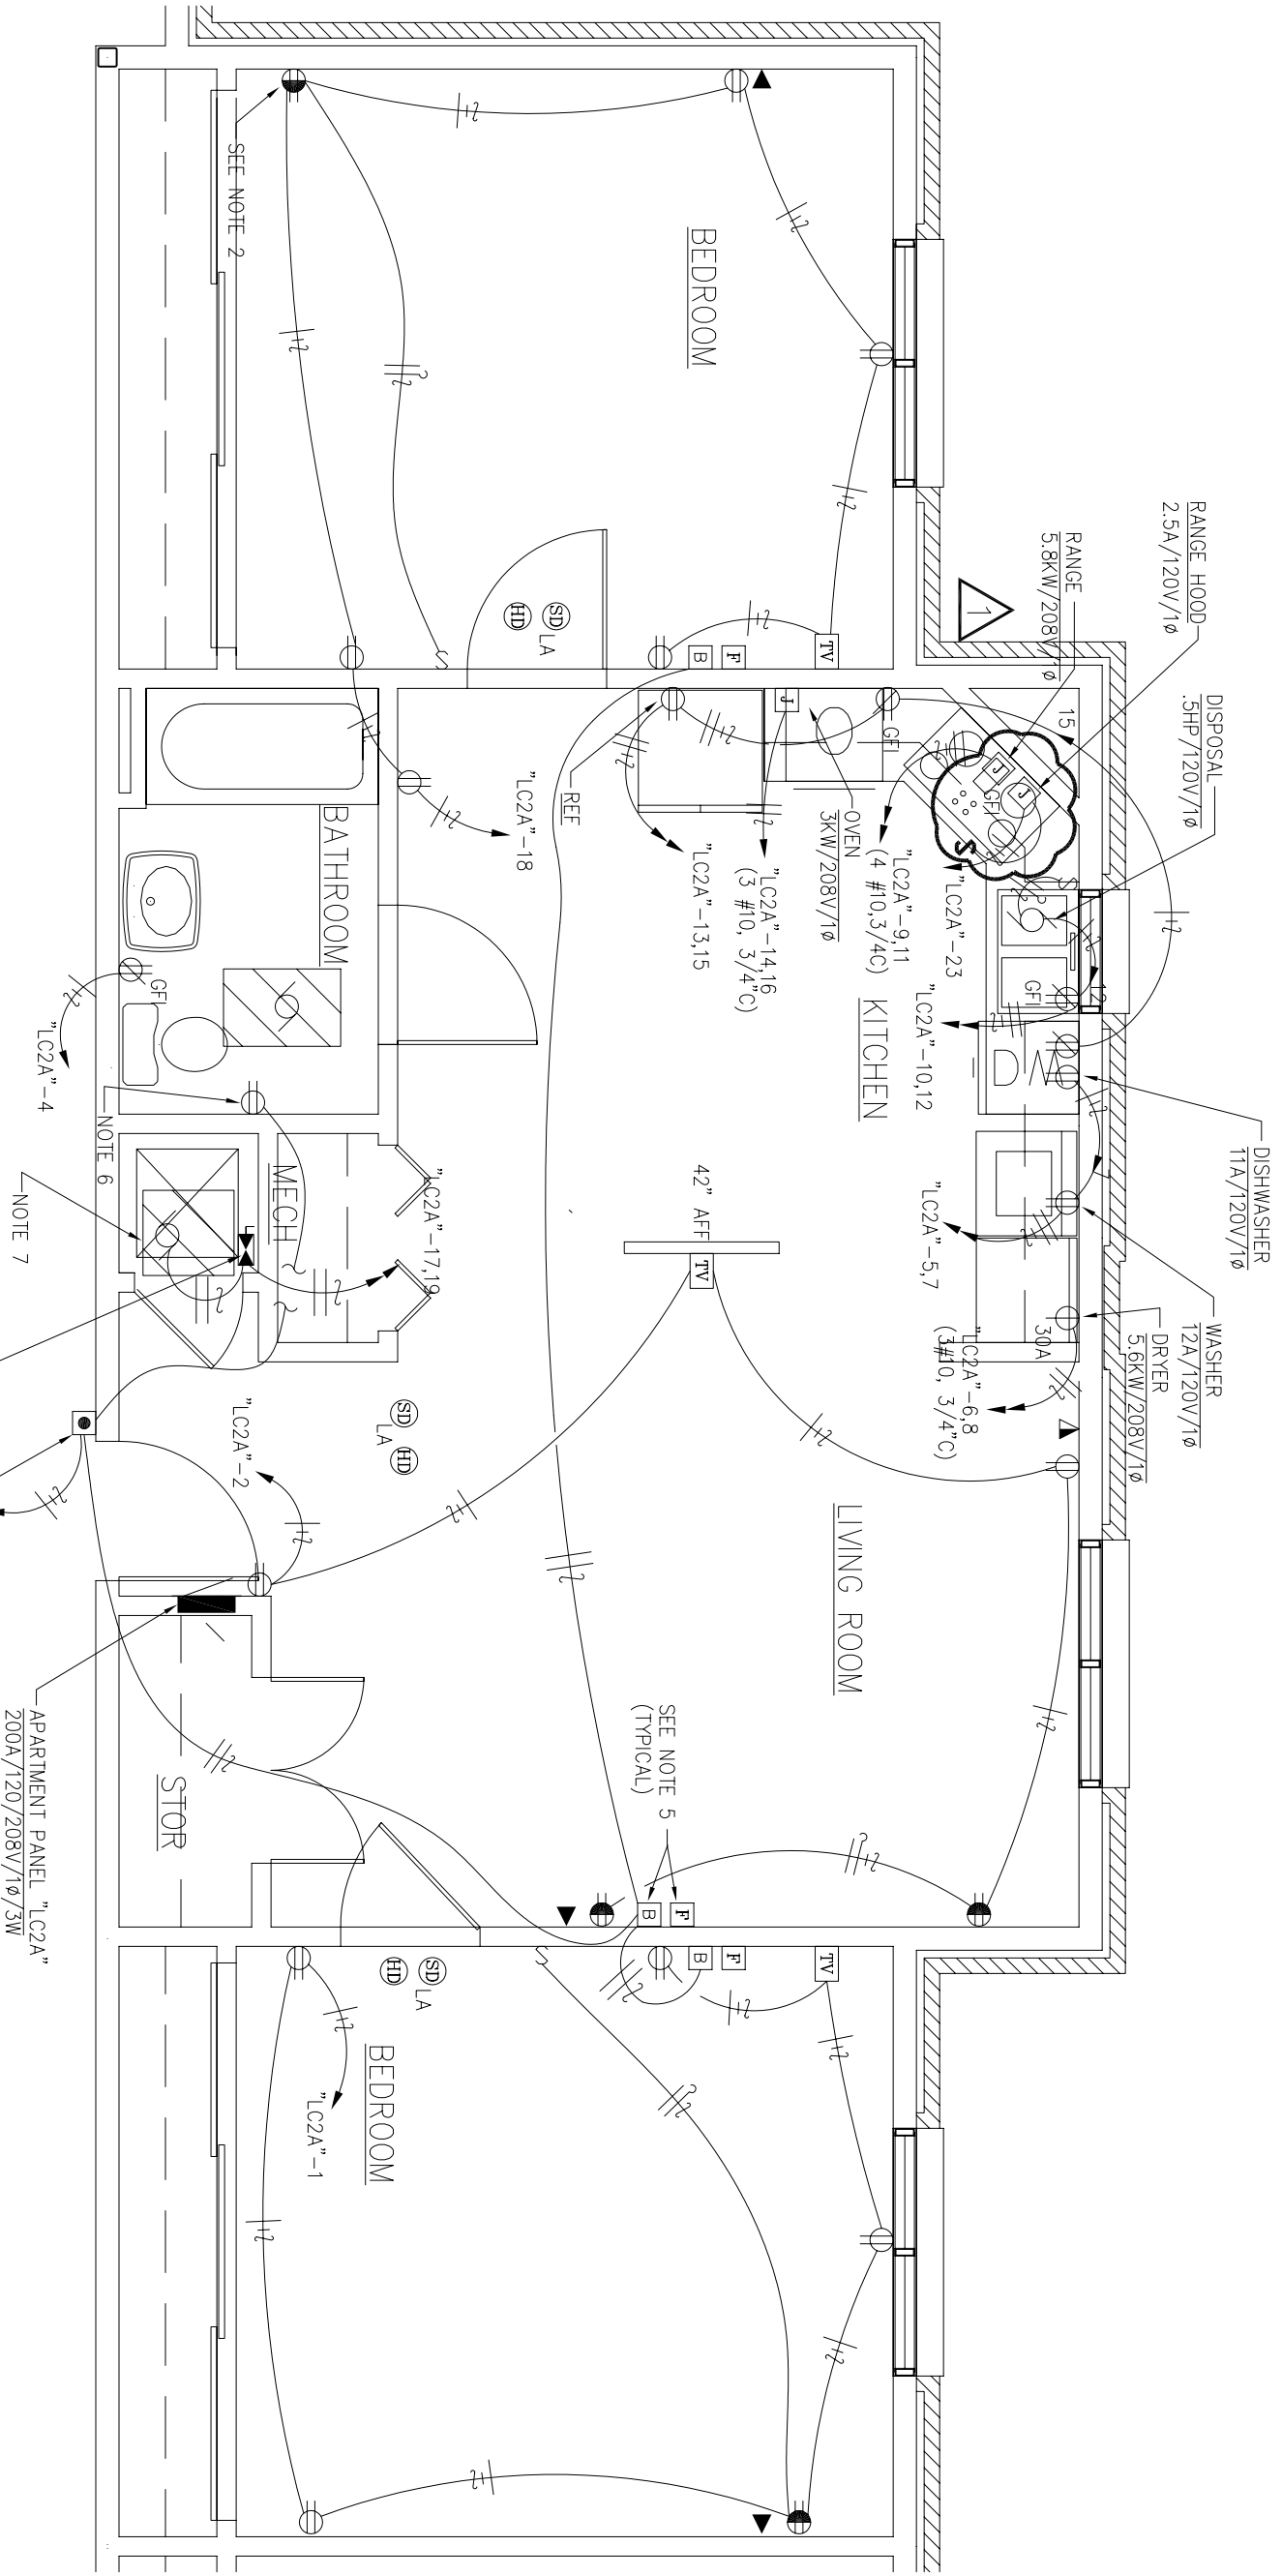

2 TYPICAL TWO-BEDROOM UNIT - POWER & SYSTEMS
RE: 1/4"=1'-0"

- NOTES:
1. INSTALL HEAT AND SMOKE DETECTORS IN ELEVATOR PIT.
 2. TOP HALF OF RECEPTACLE TO BE SWITCHED AT THE DOOR FOR TABLE LAMP - TYPICAL THIS SYMBOL.
 3. DOWN TO ROOM RECEPTACLE CIRCUIT.
 4. NOT USED.
 5. FIRE ALARM VISUAL DEVICE AND DOOR BELL/ALARM SYSTEM TO BE INSTALLED IN ALL UNITS AS SHOWN.
 6. ENERGY RECOVERY UNIT (ERV) - 1.34/120V/1/8 TYPICAL EACH TWO UNITS AS SHOWN. FIELD COORDINATE EXACT LOCATION FOR ACCESSIBILITY.
 7. FAN COIL UNIT (FCU) - 1.34/120V/1/8 TYPICAL EACH TWO UNITS AS SHOWN. FIELD COORDINATE EXACT LOCATION FOR ACCESSIBILITY.
 8. VERIFY LOCATION OF SIRS/DS IN FIELD. UNIT MUST BE ACCESSIBLE.
 9. PROVIDE CENTER SUPPORTED CABLE MANAGEMENT LADDER 4" ABOVE CEILING ON BOTH SIDES OF CORRIDOR IN APPROPRIATE LOCATION. SHOWN. FIELD COORDINATE EXACT LOCATION FOR ACCESSIBILITY.

COMBINATION SIZE 0 STR/NFDS/208V/1/8
TYPICAL (SEE NOTE 8)

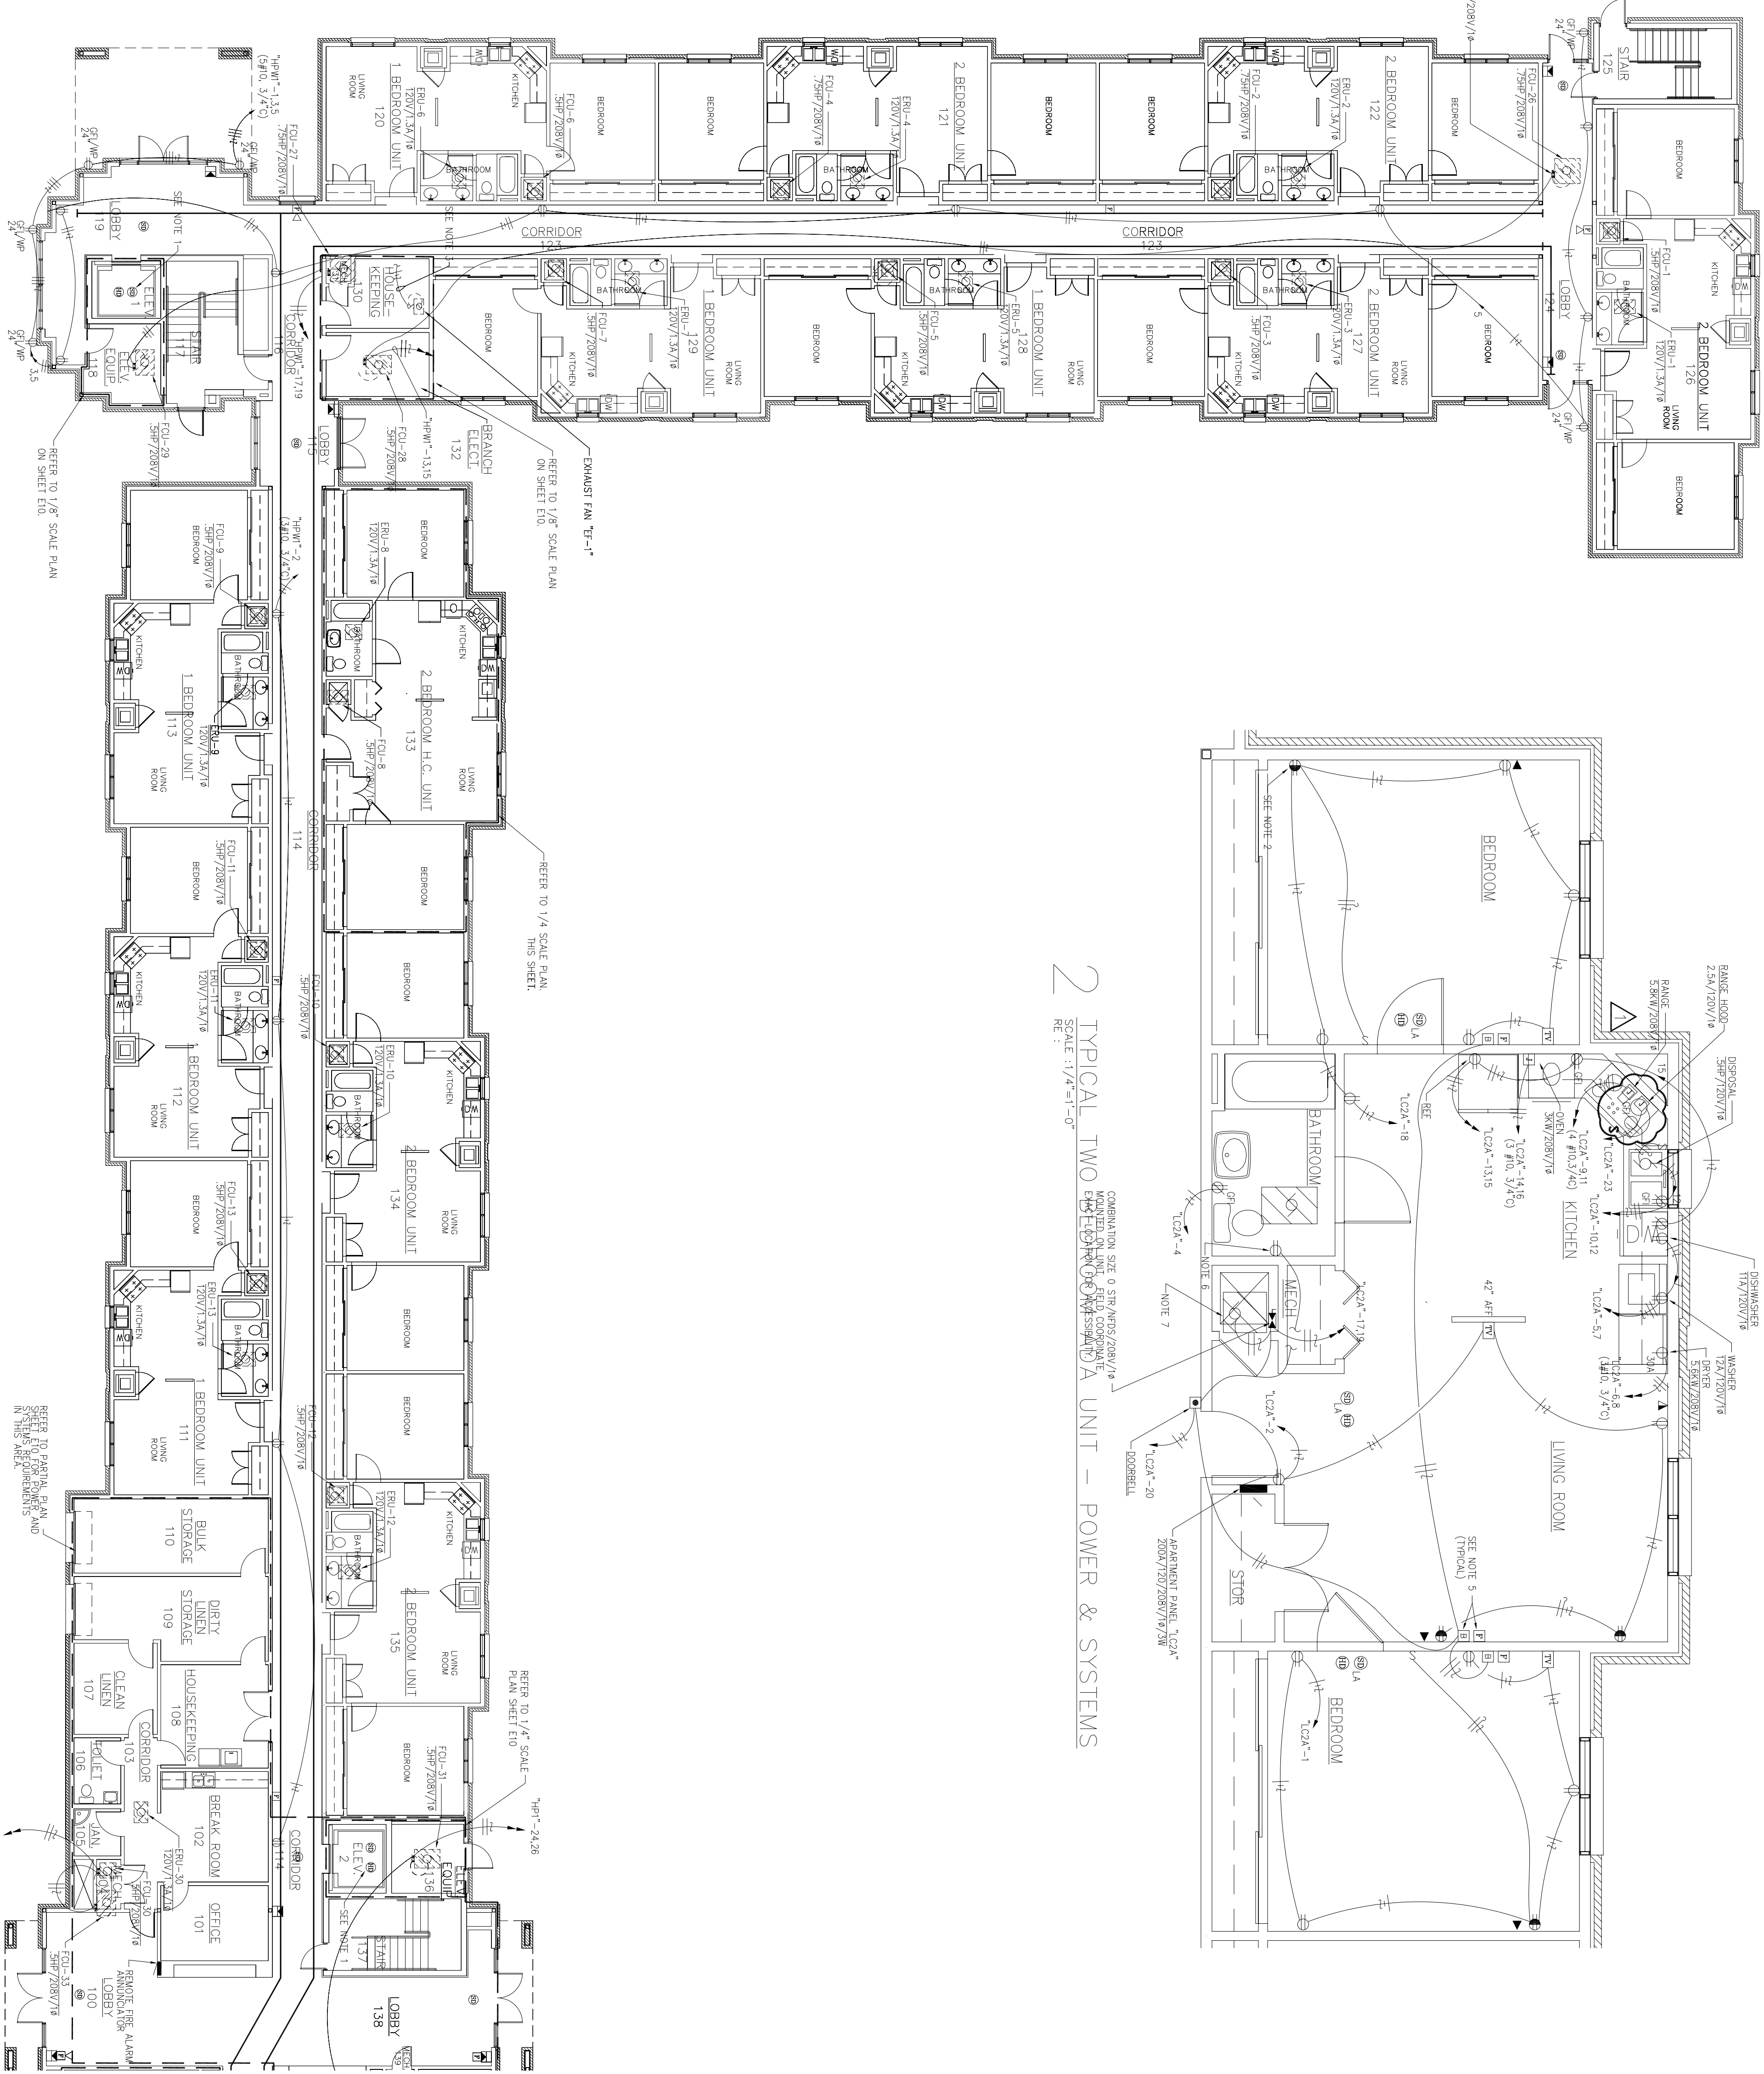

1 PARTIAL FIRST FLOOR POWER & SYSTEMS PLAN - WEST WING
RE: 1/8"=1'-0"

KEY PLAN

