


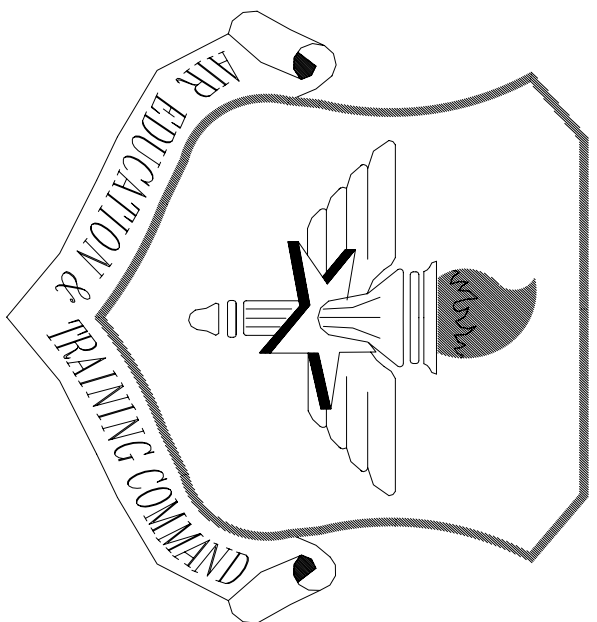

LITTLE ROCK A.F.B.
ARKANSAS

ONE ENGINEER	CHIEF ENGINEER
CHIEF OF OPERATIONS	BIO ENVIRONMENTAL ENG.
FIRE CHIEF	SAFETY
PROGRAM MANAGER	USING AGENCY



No.	Revision/Issue	Date	BY	APP'D
1	No changes from Design to As-Built			

TEMPORARY LODGING
FACILITY


SHEET TITLE
PARTIAL FIRST FLOOR
POWER & SYSTEMS
PLAN
AS-BUILT

DRAWN BY KRD	LEAD DESIGNER BRM
TECH REVIEWER	FILE LOCATION
DESIGNED BY BTM	PROJECT NUMBER NKA002-5001
DATE 28 MAY 2002	SHEET E5
SCALE AS NOTED	96 OF 108


- NOTES:
1. INSTALL HEAT AND SMOKE DETECTORS IN ELEVATOR PIT.
 2. TYPE HALF OF RECEPTACLE TO BE SWITCHED AT THE DOOR FOR TABLE LAMP - TYPICAL THIS SYMBOL.
 3. DOWN TO ROOM RECEPTACLE CIRCUIT.
 4. NOT USED
 5. UNDER BID OPTION #4, INCLUDE FIRE ALARM VISUAL DEVICE IN ALL UNITS AS SHOWN.
 6. ENERGY RECOVERY UNIT "TRN-X" 1.5A/120V/1ø TYPICAL EACH TWO BEDROOM ADA UNIT. REFER TO 3/32" SCALE PLAN FOR UNIT NUMBER. INSTALL RECEPTACLE NEXT TO UNIT.
 7. FIELD COORDINATE EXACT LOCATION OF DEVICE FOR ACCESSIBILITY.
 8. PROVIDE CENTER SUPPORTED CABLE MANAGEMENT LAMPS 4" ABOVE CEILING ON BOTH SIDES OF CORRIDOR IN APPROPRIATE LOCATION SHOWN. FIELD COORDINATE EXACT LOCATION FOR ACCESSIBILITY.

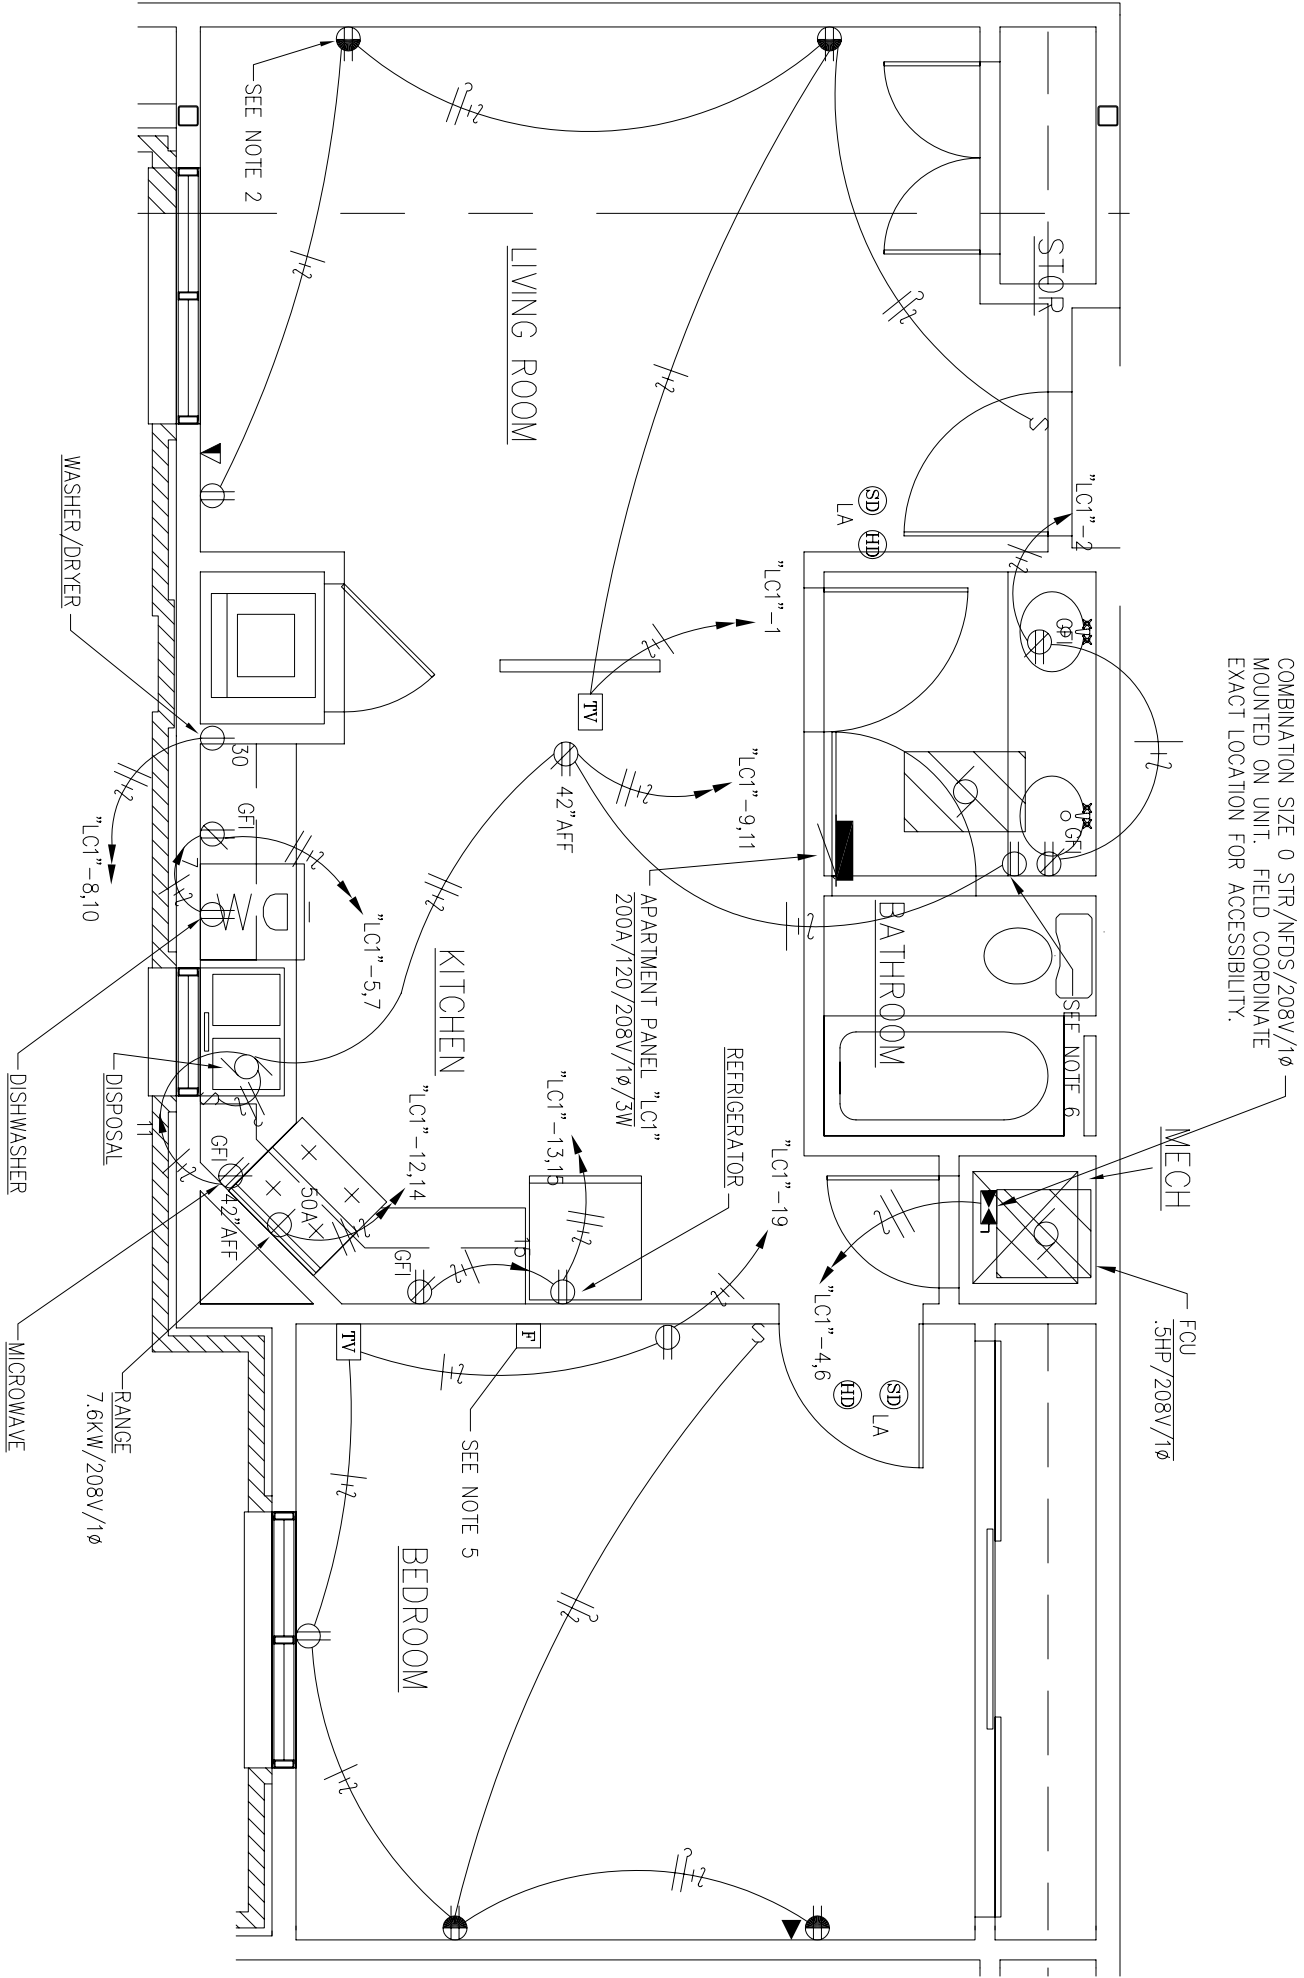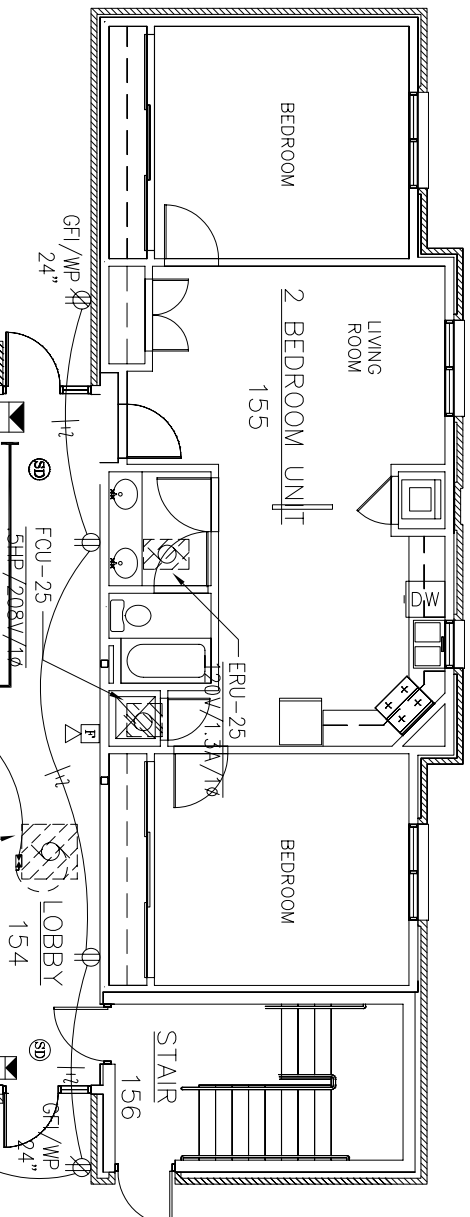

2 TYPICAL ONE BEDROOM UNIT - POWER & SYSTEMS
SCALE: 1/4"=1'-0"

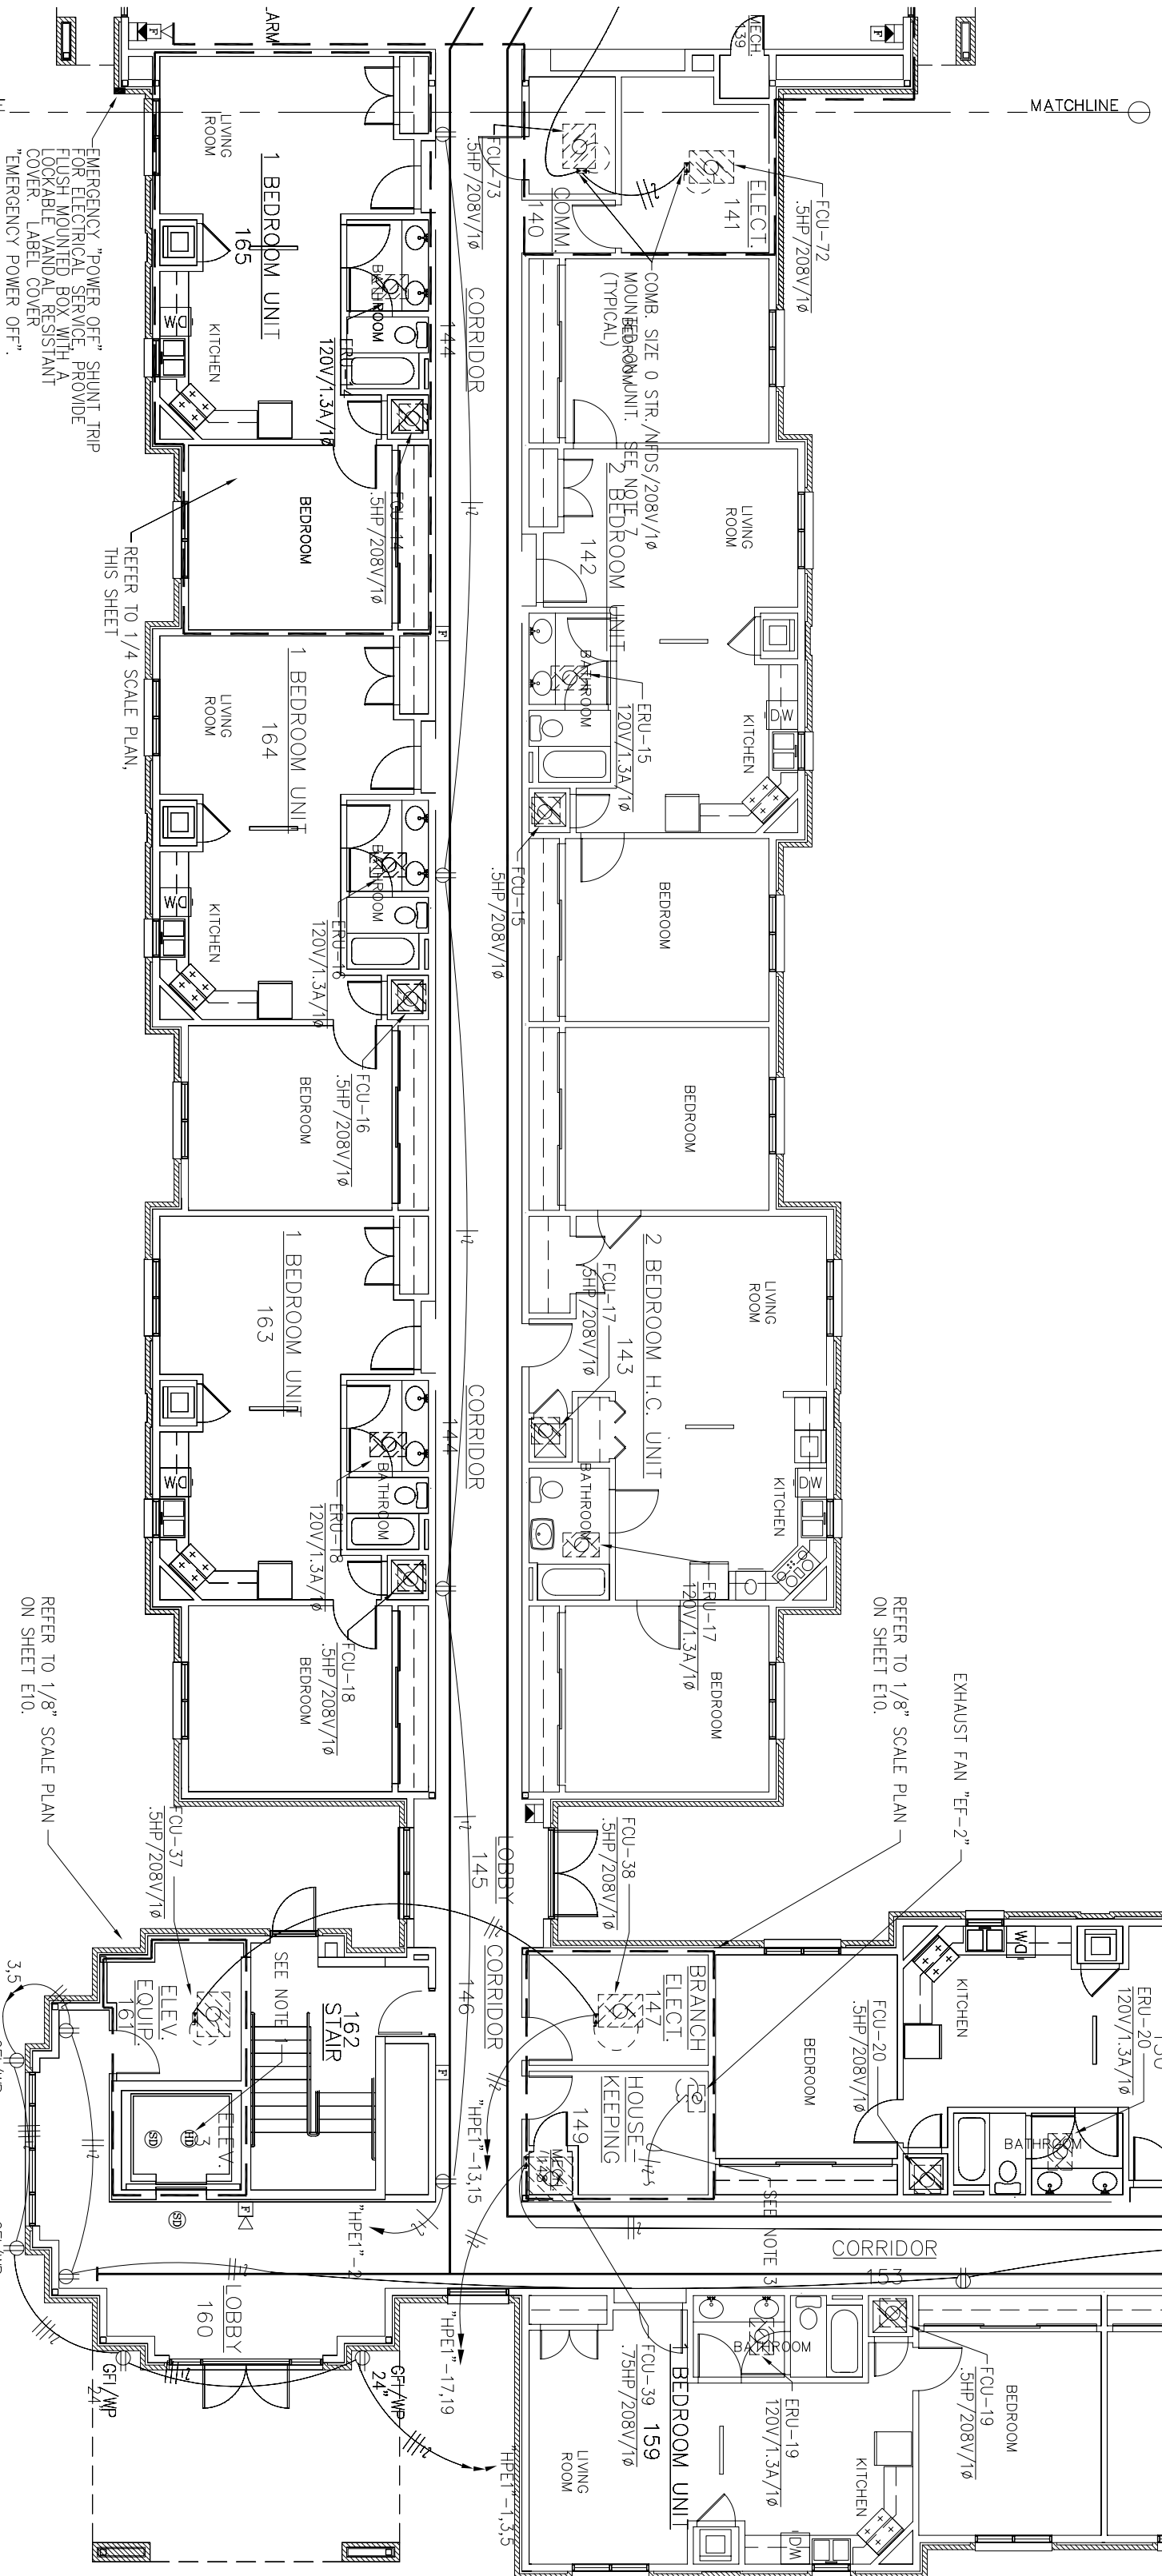

1 PARTIAL FIRST FLOOR POWER & SYSTEMS PLAN - EAST WING
SCALE: 3/32"=1'-0"

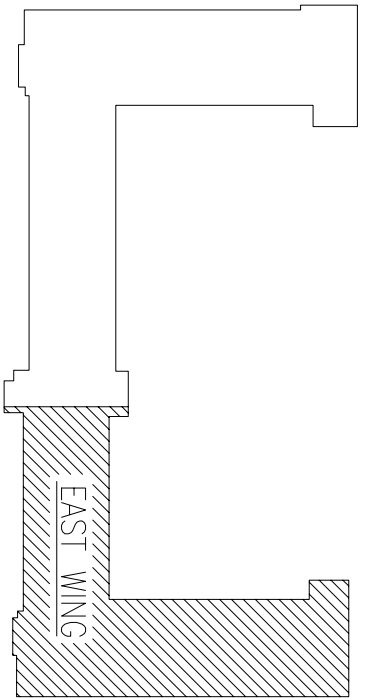

KEY PLAN