

LITTLE ROCK A.F.B.  
ARKANSAS


OWN ENGINEER	CHEF ENGINEER
CHIEF OF OPERATIONS	BIO ENVIRONMENTAL ENG.
FIRE CHIEF	SAFETY
PROGRAM MANAGER	USING AGENCY

No.	Revision/Issue	Date	BY	APP'D
1	Relocated receptacle from other bedroom as noted			

PROJECT TITLE  
**TEMPORARY LODGING FACILITY**


SHEET TITLE  
**PARTIAL SECOND FLOOR POWER & SYSTEMS PLAN**  
**AS-BUILT**

DRAWN BY KRD	LEAD DESIGNER BRM
TECH REVIEWER BTM	FILE LOCATION
DESIGNED BY BTM	PROJECT NUMBER NKA02-5001
DATE 28 MAY 2002	SHEET 98 OF 108
SCALE AS NOTED	

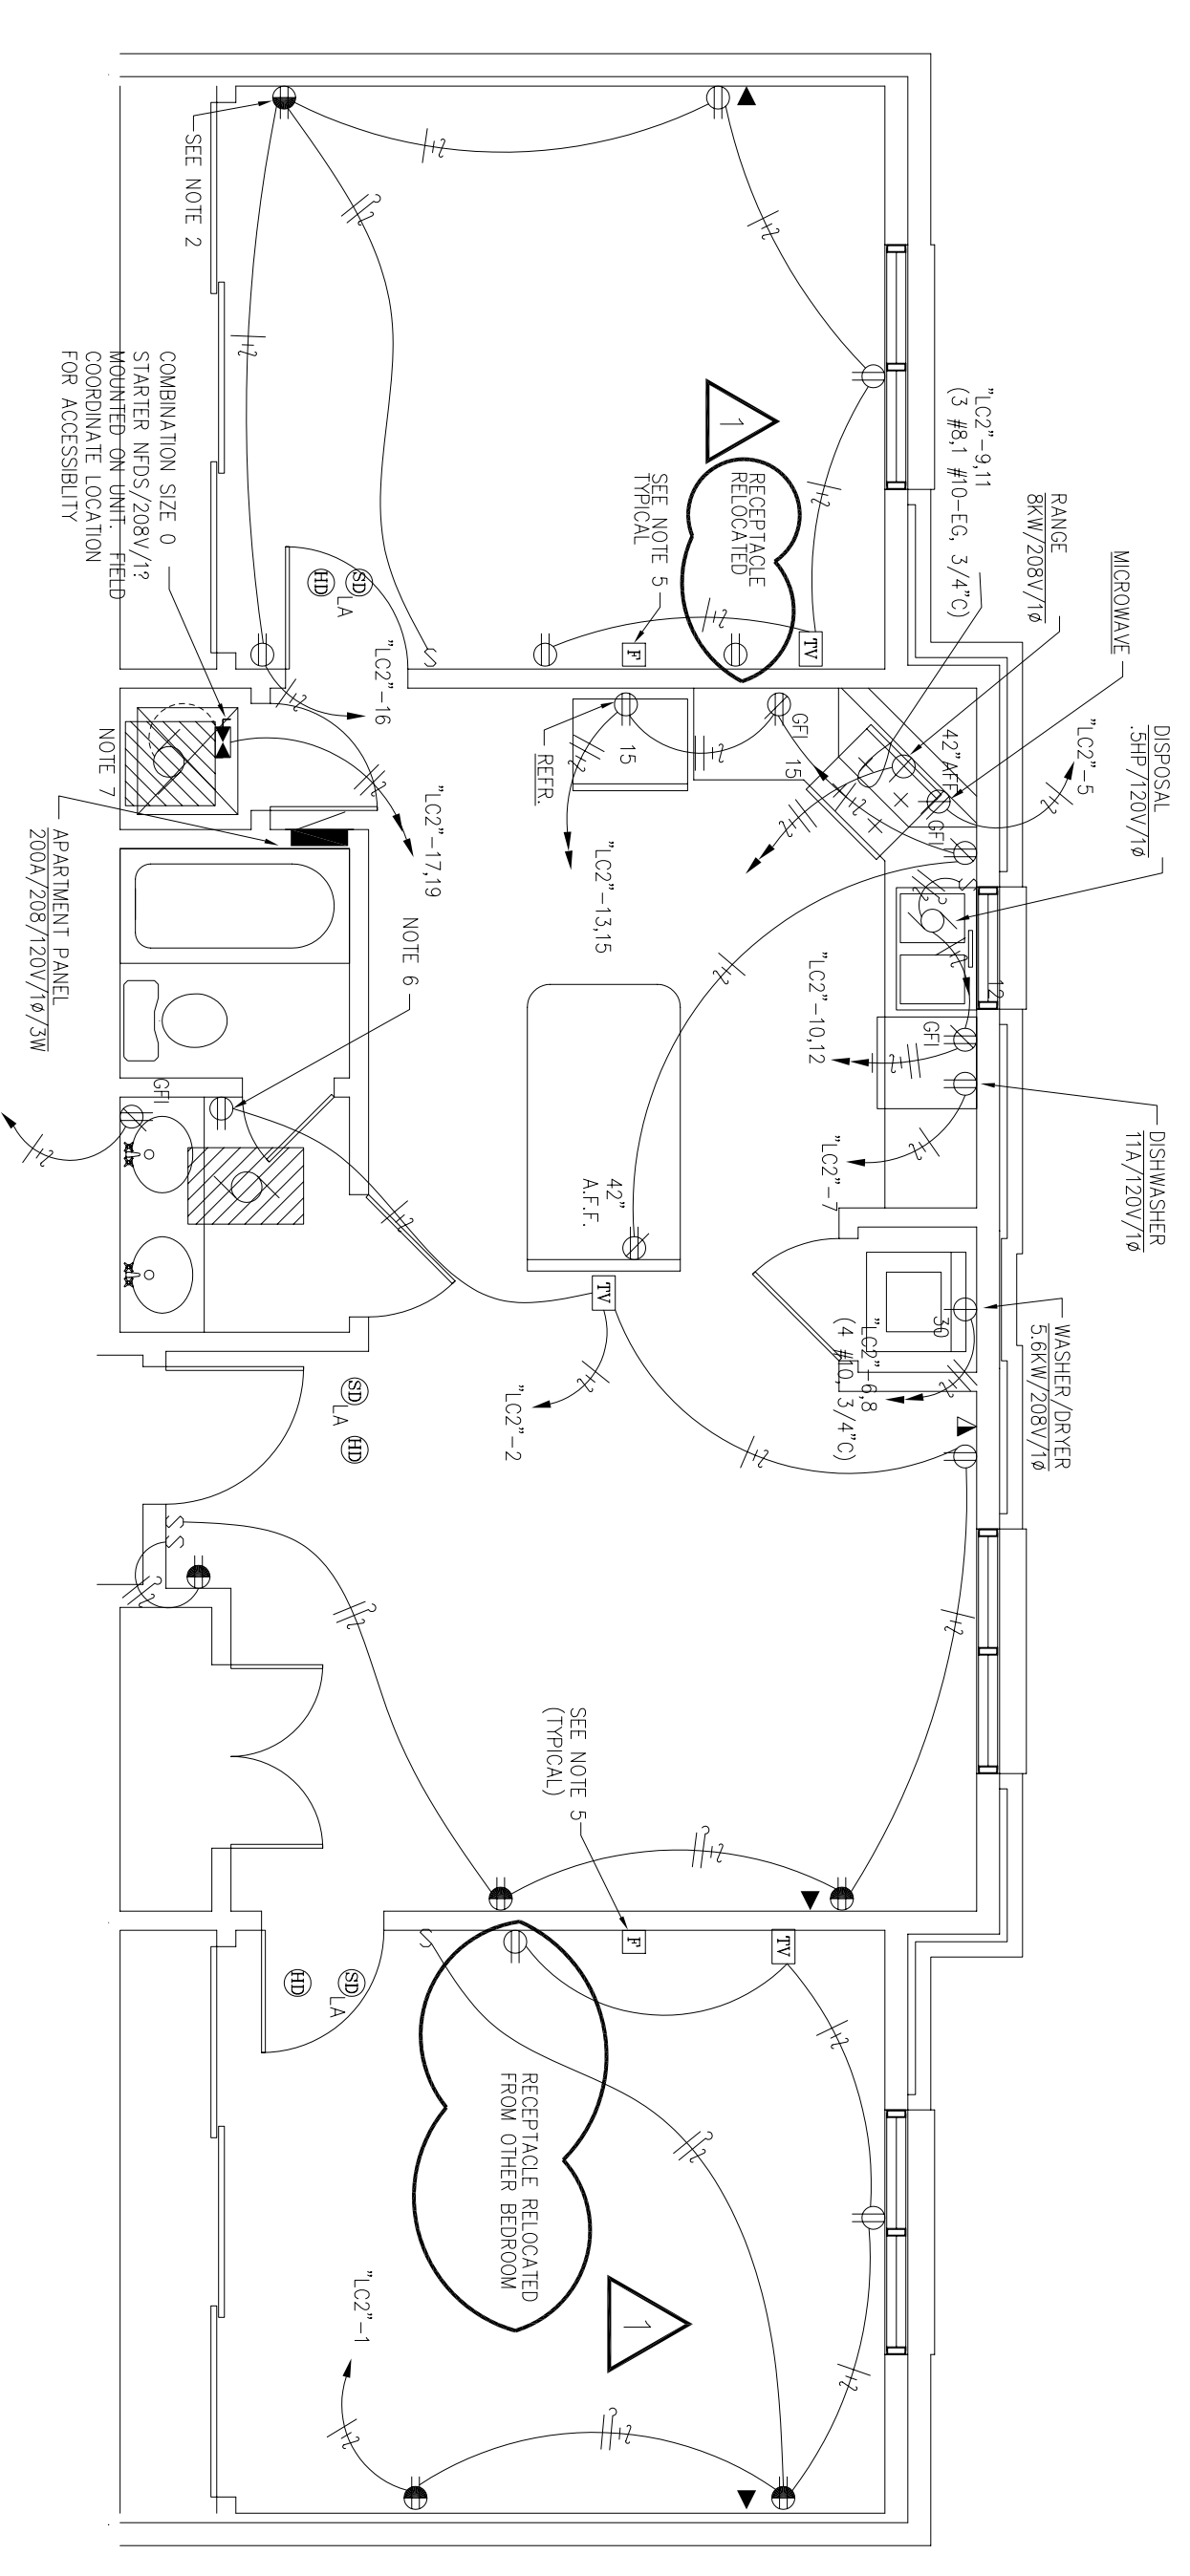


2 1/4" SCALE PLAN - POWER & SYSTEMS  
SCALE: 1/4"=1'-0"

- NOTES:
1. INSTALL SMOKE DETECTOR AND HEAT DETECTOR AT TOP OF SHAFT.
  2. TOP HALF OF RECEPTACLE TO BE SWITCHED AT THE DOOR FOR TABLE LAMP - TYPICAL THIS SYMBOL.
  3. DOWN TO ROOM RECEPTACLE CIRCUIT.
  4. NOT USED
  5. UNDER APPLIQUE ALTERNATE #2 INCLUDE FREE ALARM VISUAL DEVICE IN ALL UNITS AS SHOWN.
  6. ENERGY RECOVERY UNIT TYPICAL 1 1/4" ABOVE 1/4" TYPICAL EACH TWO BEDROOM ADA UNIT REFER TO 3/27" SCALE PLAN FOR UNIT NUMBER. INSTALL RECEPTACLE NEXT TO UNIT.
  7. PAN COIL UNIT TYPICAL 4" ABOVE 2" ABOVE 1/4" TYPICAL EACH TWO BEDROOM ADA UNIT REFER TO 3/27" SCALE PLAN FOR UNIT HEATER.
  8. PROVIDE CENTER SUPPORTED CARE MANAGEMENT LAGER #4 ABOVE STAIRS AND ELEVATOR LANDING AREAS AS SHOWN.
  9. EXHAUST FAN SEE 0 STARTER MOTOR/280V/1P MOUNTED ON UNIT FIELD COORDINATE EXACT LOCATION FOR ACCESSIBILITY.
  10. COMBINATION SIZE 0 STARTER MOTOR/280V/1P MOUNTED ON UNIT FIELD COORDINATE EXACT LOCATION FOR ACCESSIBILITY.

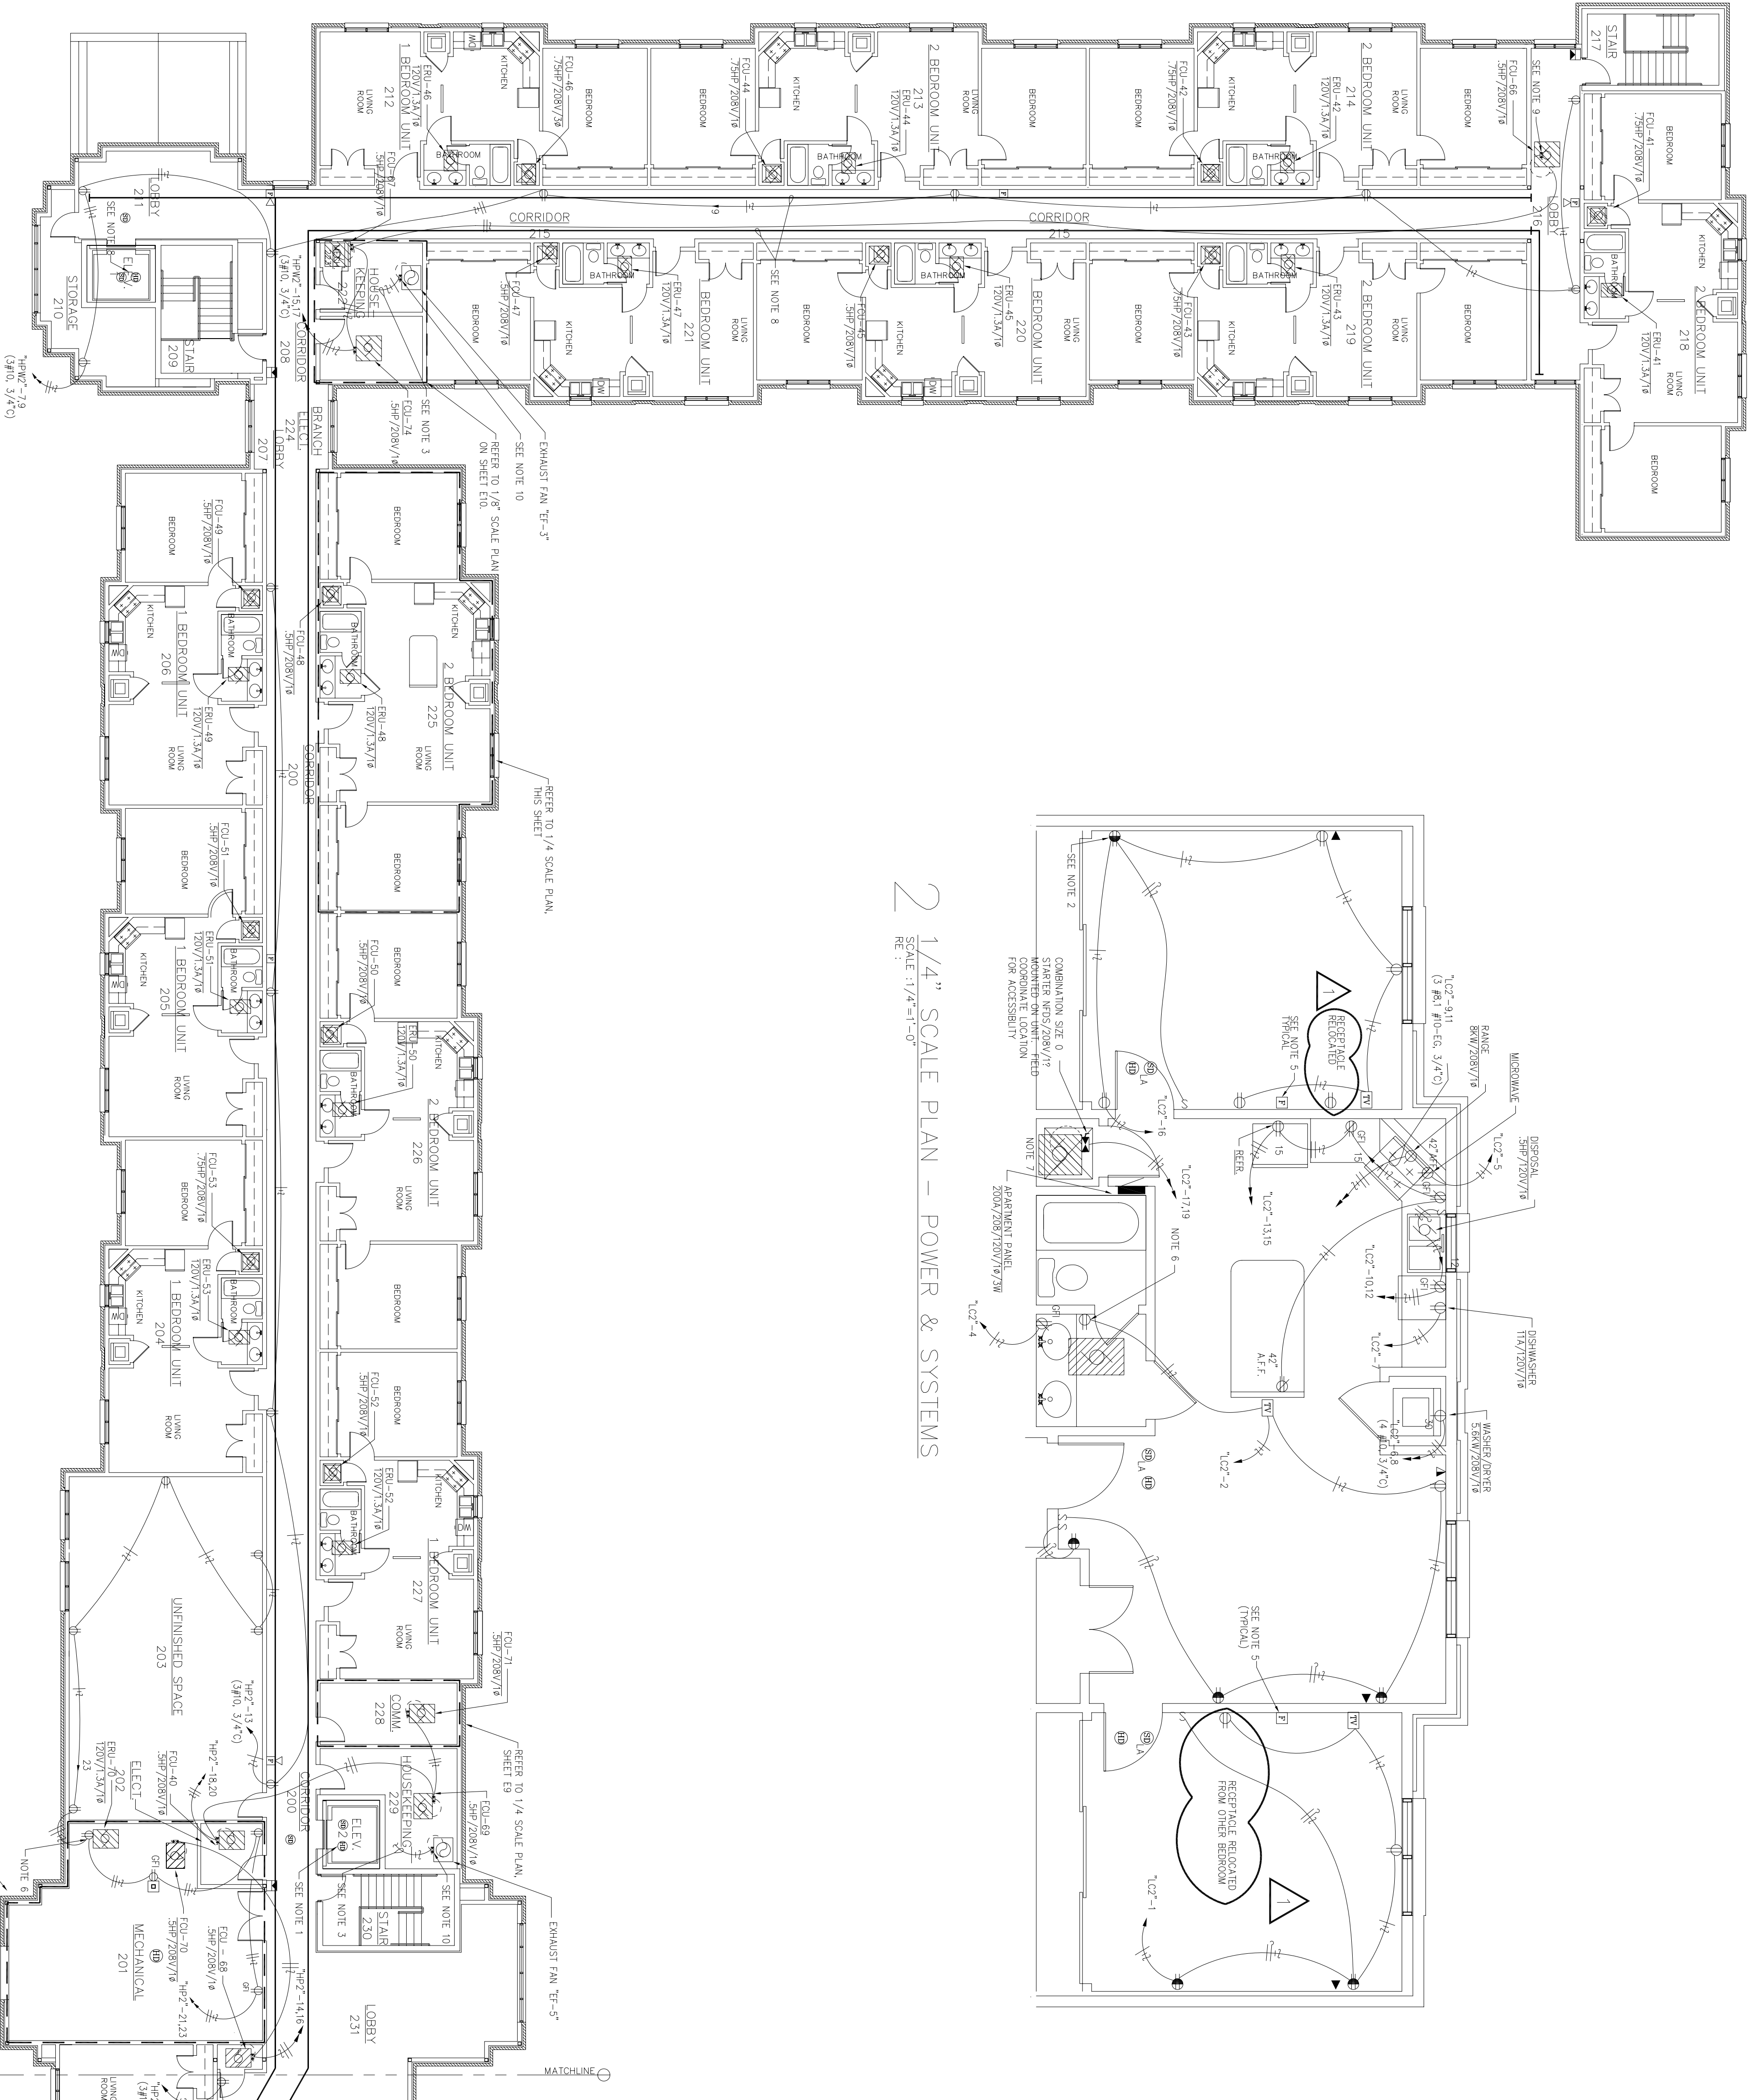

1 PARTIAL SECOND FLOOR POWER & SYSTEMS PLAN - WEST WING  
SCALE: 3/32"=1'-0"

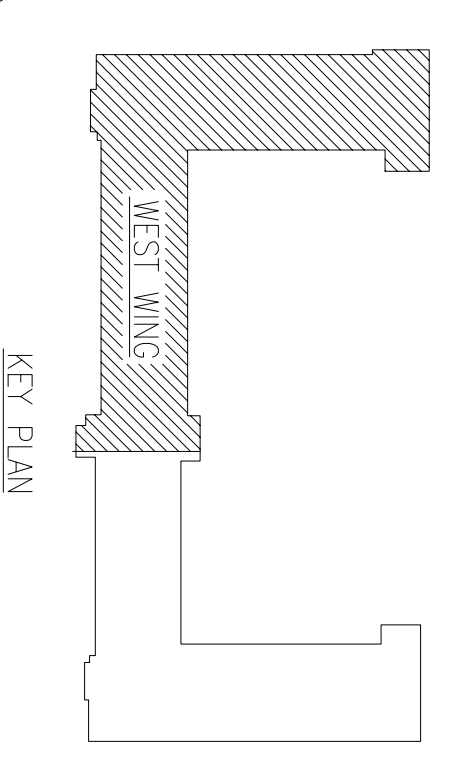

KEY PLAN