



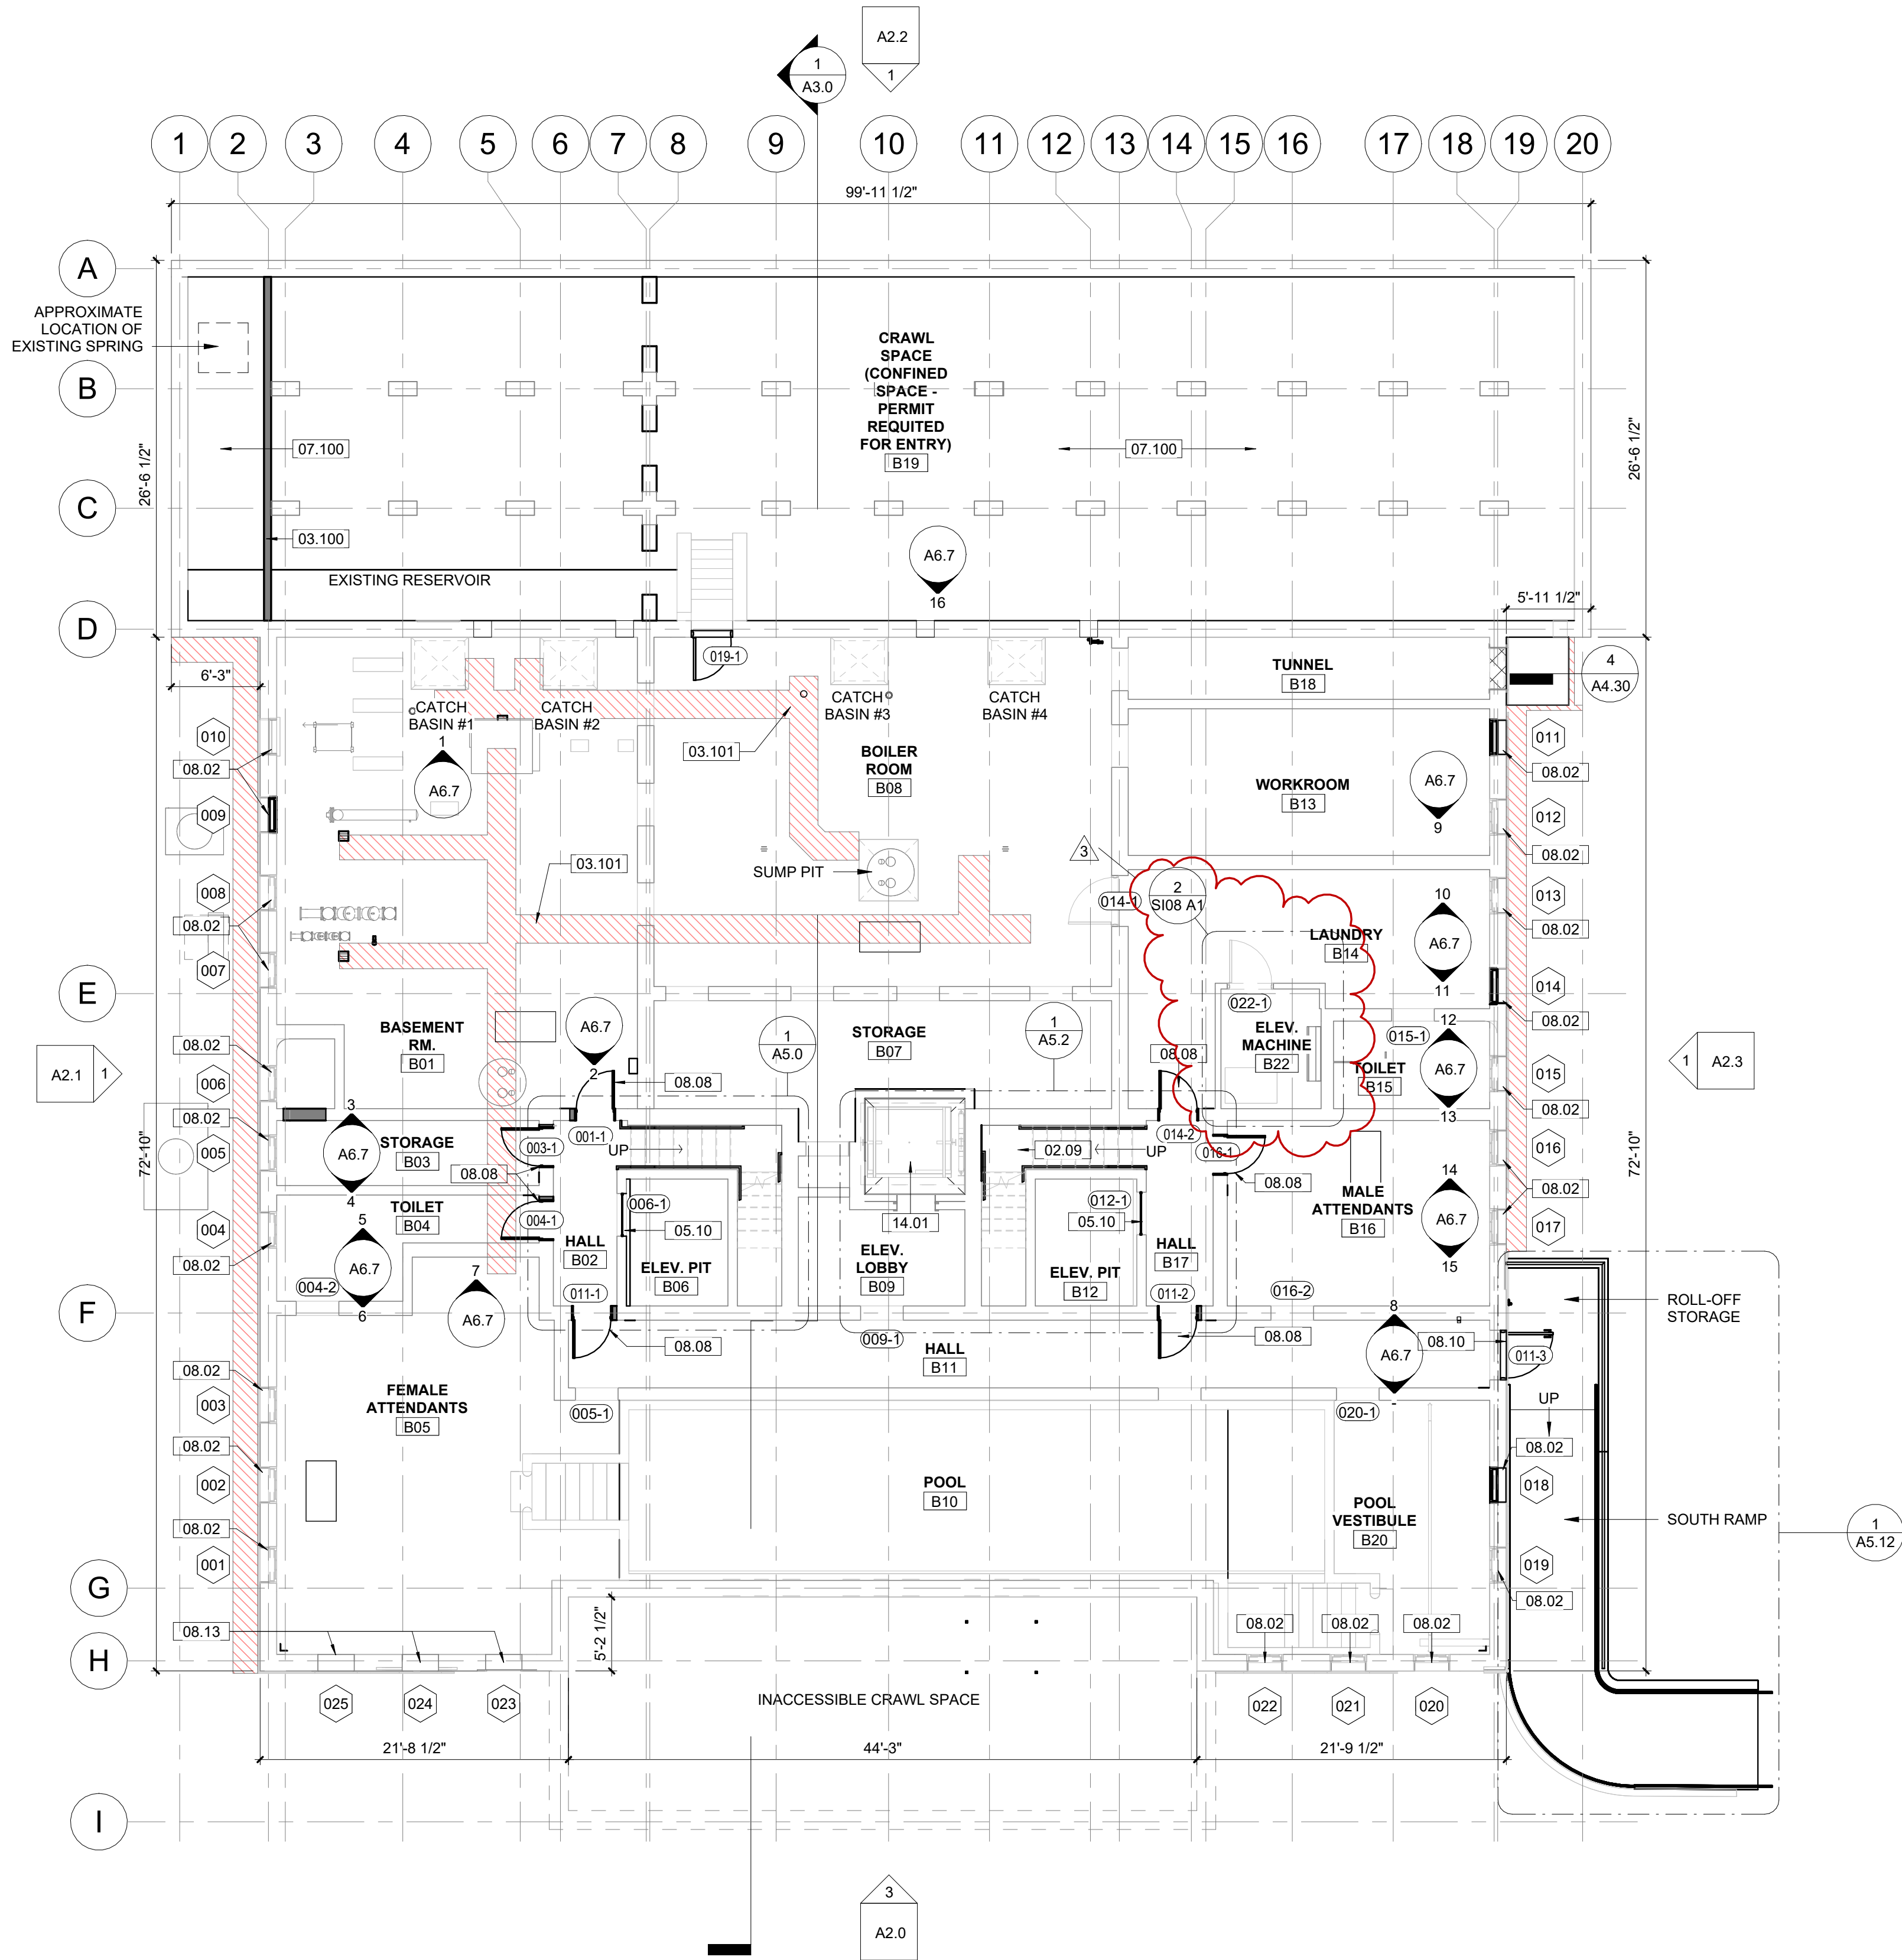

1
A1.0 Proposed Basement Floor Plan
1/8" = 1'-0" SCALE (A)

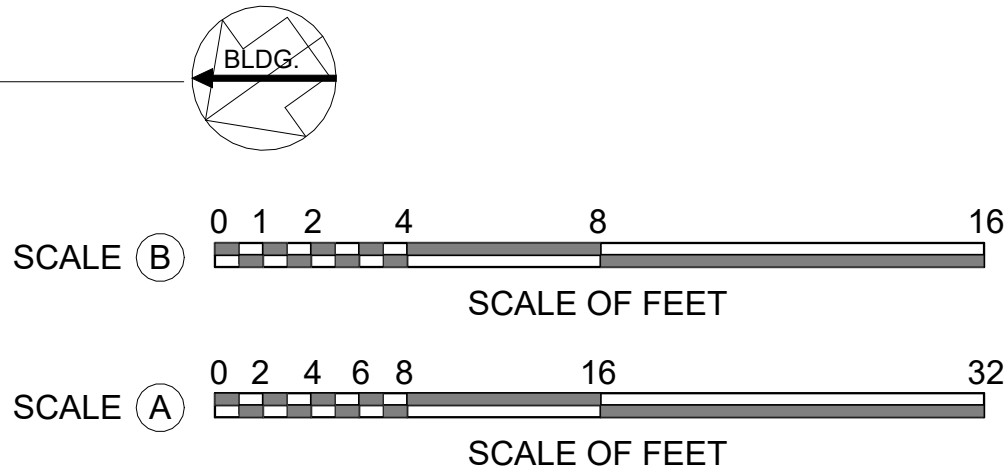

A/E FIRMS PRIME/ARCH: STRATA ARCHITECTURE 1701 OAK STREET, SUITE 100 KANSAS CITY, MO 1-816-474-0900	DESIGNED: CA/AG CADD: CA/ZA/EM TECH. REVIEW: AG DATE: 10.27.2023	SUB SHEET NO.	TITLE OF SHEET MAURICE BATHHOUSE BASEMENT FLOOR PLAN REHABILITATE BATHHOUSES HOT SPRINGS NATIONAL PARK	DRAWING NO. 128 182951 PMIS/PKG NO. 318915 SHEET 42 OF 286
---	---	---------------	--	--

GENERAL NOTES - TREATMENT:

- A. DO NOT SCALE FROM THE DRAWINGS. ALL DIMENSIONS ARE APPROXIMATE. ACTUAL FIELD VERIFIED DIMENSIONS SHALL BE OBTAINED BY THE GENERAL CONTRACTOR OR THE APPLICABLE SUB-CONTRACTORS BEFORE SUBMITTING SHOP DRAWINGS, ORDERING MATERIALS, OR THE COMMENCEMENT OF CONSTRUCTION.
- B. REFER TO THE SPECIFICATIONS FOR THE REQUIREMENT FOR WORKING IN AREAS WHERE LEAD PAINT HAS BEEN IDENTIFIED.
- C. REFER TO THE SPECIFICATIONS FOR THE IDENTIFICATION AND DISPOSAL OF FLUORESCENT LIGHTS AND BALLASTS IN EXISTING FIXTURES
- D. REFER TO THE SPECIFICATIONS FOR REQUIRED SAFETY MEASURES REQUIRED FOR THE EXCAVATION OF SOILS SURROUNDING THE MAURICE STRUCTURE WHERE ELEVATED LEVELS OF METALS WERE IDENTIFIED.

KEYNOTES

02.09	REFERENCE ENLARGE VERTICAL CIRCULATION PLANS FOR REQUIRED WORK, TYPICAL.
03.100	030130.52, 033000 - CRAWL SPACE: INSTALL NEW CONCRETE WALL WITH OVERFLOW, REFERENCE STRUCTURAL.
03.101	030130.52, 033000 - INSTALL NEW CONCRETE AT BASEMENT SLAB, REFERENCE MEP AND STRUCTURAL DRAWINGS. TOP OF NEW CONCRETE SLAB TO ALIGN WITH EXISTING FLOOR SLAB, TYPICAL.
05.10	051200 - INSTALL NEW EXTERIOR GALVANIZED STAIR AND LANDING TO SPAN NEW CONCRETE RUNNEL, REFERENCE STRUCTURAL DRAWINGS. STAIR CONFIGURATION TO BE APPROVED BY CO PRIOR TO INSTALLATION.
07.100	072800 - CRAWL SPACE: INSTALL NEW HEAVY-DUTY VAPOR BARRIER THROUGHOUT ENTIRE CRAWLSPACE, PER SPECIFICATIONS. REFERENCE MEP AND STRUCTURAL DRAWINGS FOR ADDITIONAL WORK REQUIRED WITHIN THE CRAWL SPACE.
08.02	080152.61, 088000 - REFERENCE EXTERIOR TREATMENT ELEVATIONS, THE WINDOW SCHEDULE, AND SPECIFICATIONS FOR WORK REQUIRED FOR ALL EXTERIOR WINDOWS AND WINDOW TRIM."
08.08	081113, 087100 - INSTALL 1-HR FIRE RATED HOLLOW METAL DOOR AND HOLLOW METAL FRAMES, REFERENCE DOOR SCHEDULE AND SPECIFICATIONS FOR ADDITIONAL INFORMATION.
08.10	081113, 087100 - INSTALL INSULATED HOLLOW METAL DOOR AND FRAME, REFERENCE DOOR SCHEDULE AND SPECIFICATIONS FOR ADDITIONAL INFORMATION.
08.13	EXISTING WINDOWS ARE INFILLED AND WILL REMAIN INFILLED.
14.01	142400 - REFURBISH EXISTING ELEVATOR CAB AND INSPECT/REPAIR CONTROLS AND OPERATING MECHANISMS, REFERENCE SPECIFICATIONS.

TREATMENT PLAN LEGEND

	REPLACEMENT MATERIAL INSTALLED		NEW HOLE IN EXISTING WALL
	AREA REQUIRING RESTORATION DUE TO SIGNIFICANT MATERIAL DETERIORATION		NEW WALLS
	EXISTING WALLS		

THIS PAGE WAS PREPARED WITH COLORED LINES AND HATCHES. WHEN PRINTING, USE COLOR.