


KEYNOTES	
1	6" BUILDING DRAIN LINE. REFER TO CIVIL PLANS FOR CONTINUATION. 652 D.F.U.
2	4" SD LINE. REFER TO CIVIL PLANS FOR CONTINUATION.
3	4" SS DISCHARGE. COORDINATE WITH CIVIL AND ON-SITE CONDITIONS FOR CONTINUATION.
4	INSTALL GREASE INTERCEPTOR(S) AND SAMPLING PORT(S) PER MANUFACTURER'S SPECIFICATIONS, INCLUDING THE FINISHED TO GRADE CONCRETE PAD WITH REBAR.

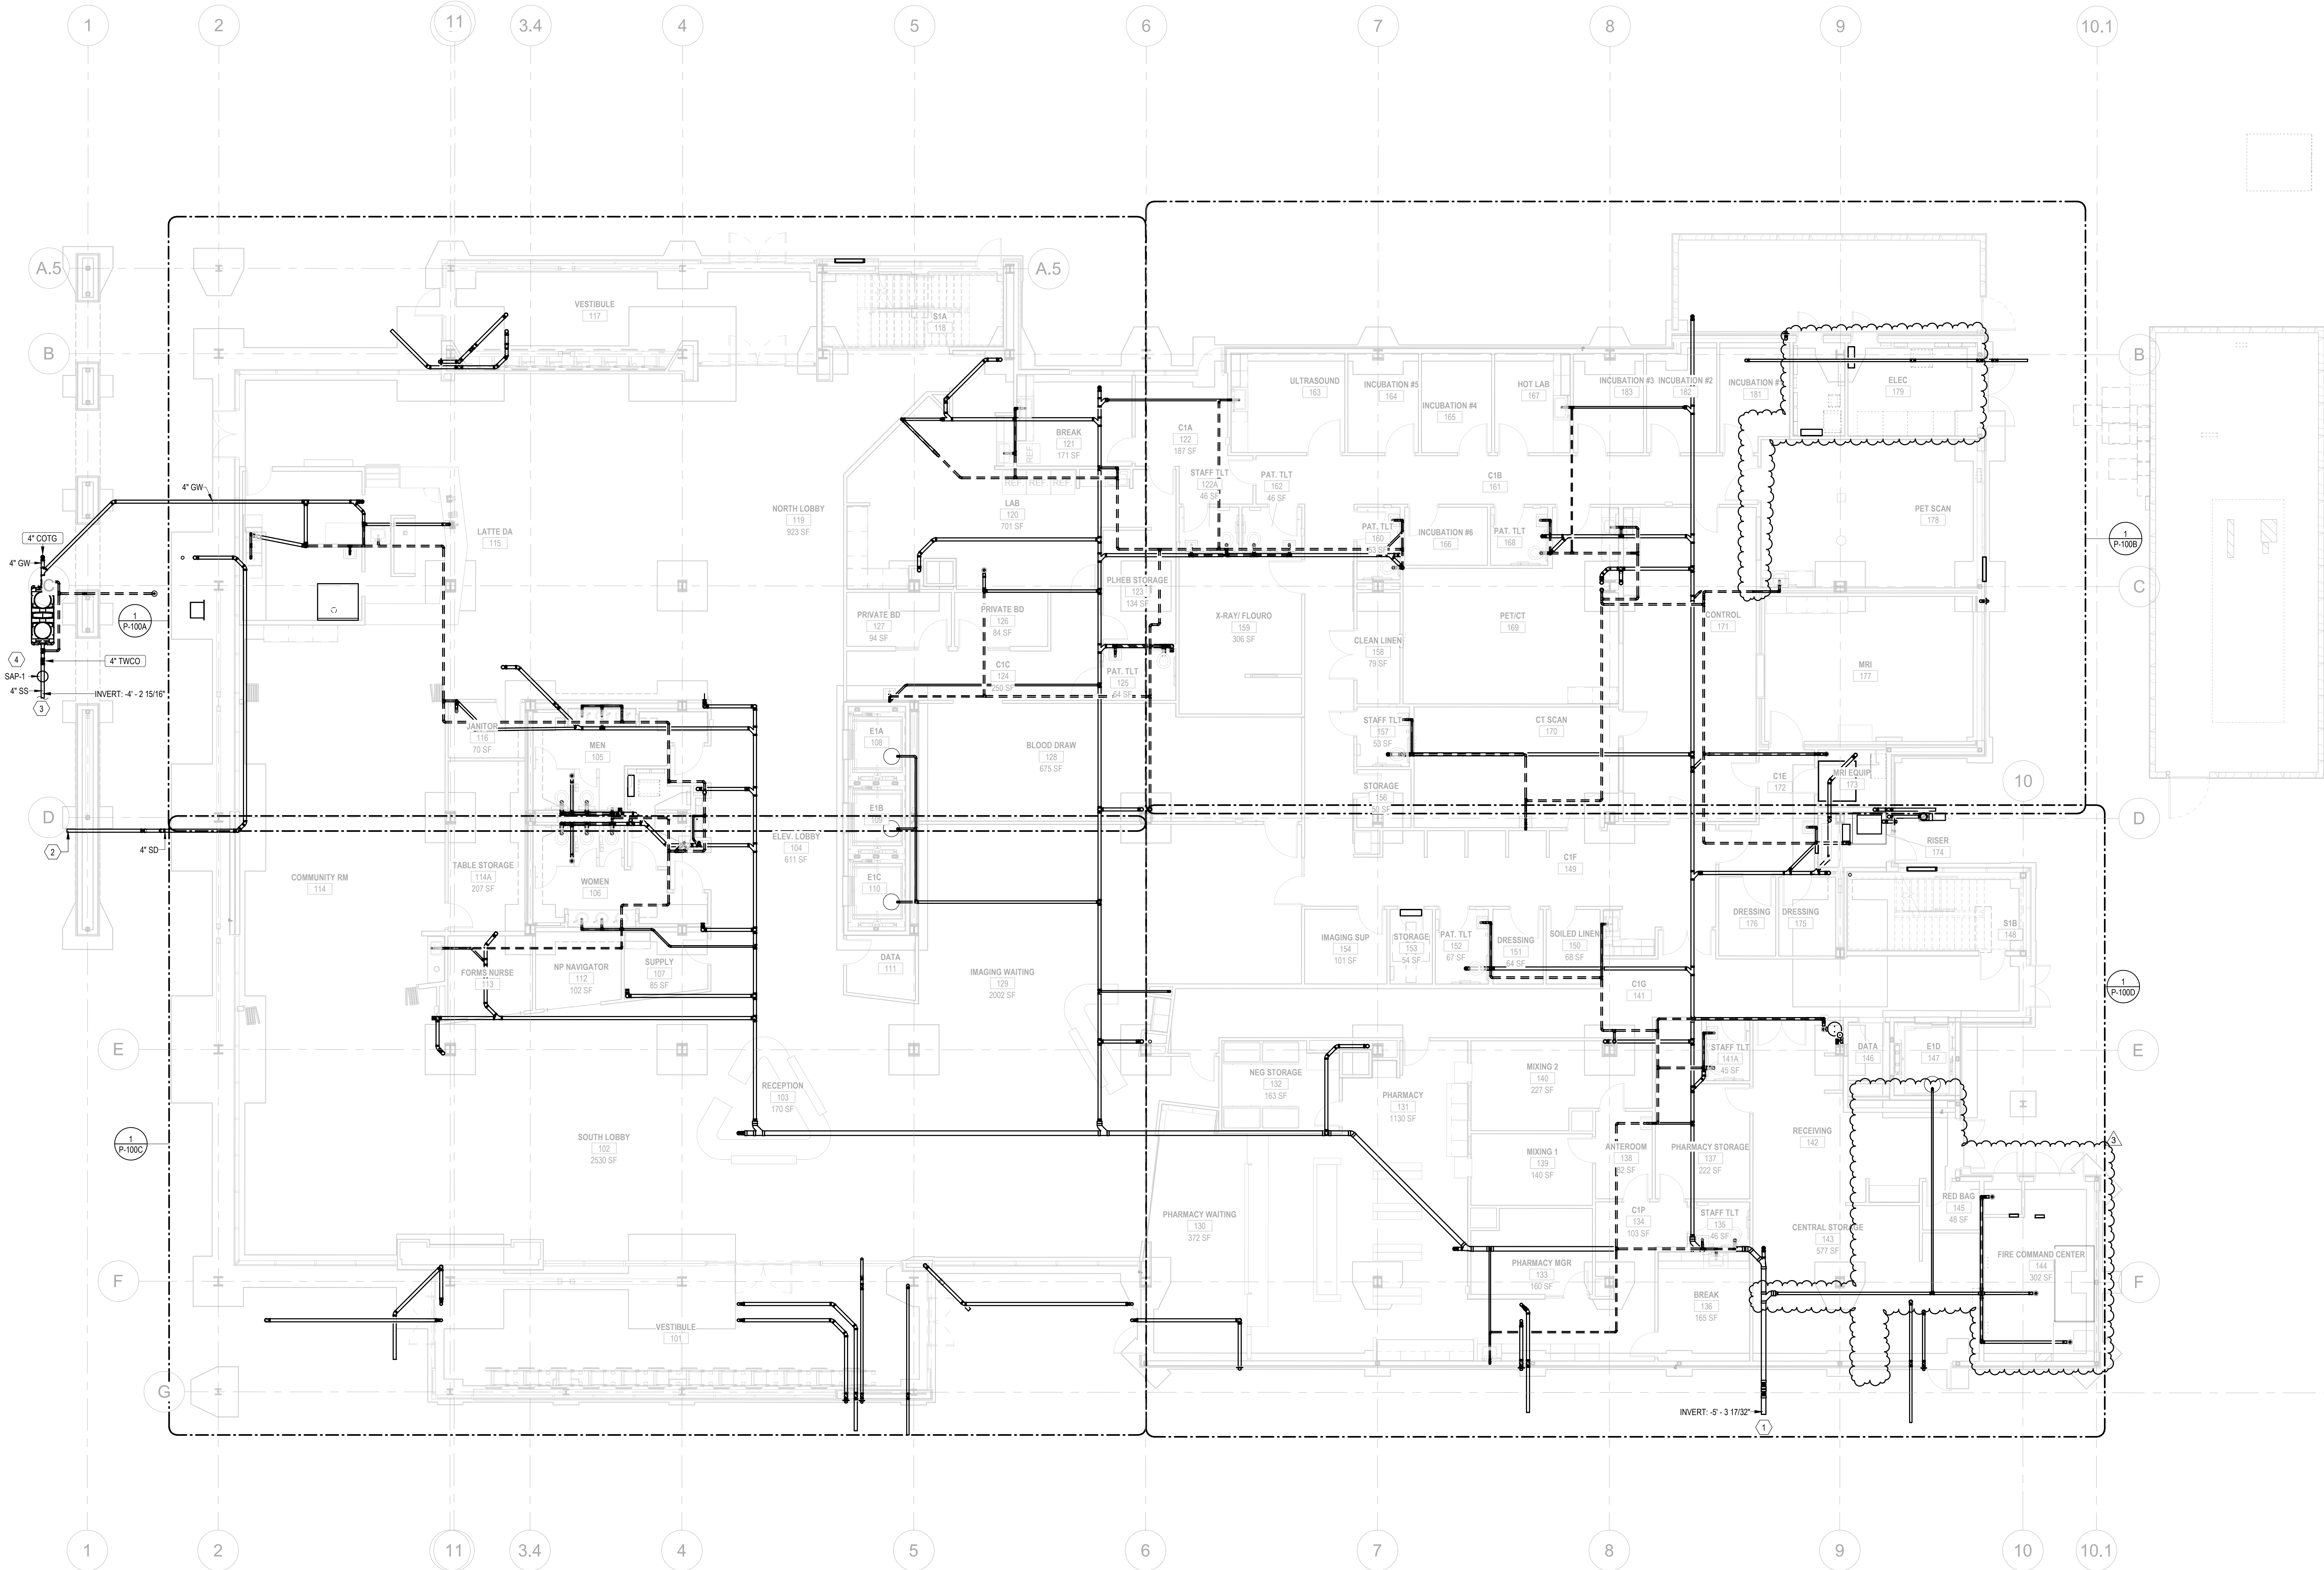


1 LEVEL 1 PLUMBING PLAN
1/8" = 1'-0"


Key

No.	Description	Date
1	ADDENDUM 03	02/04/26
2	PLAN REVIEW COMMENTS	07/22/26
3	P.R. #03	08/28/26

This document, and the ideas and designs incorporated herein, as an instrument of professional service, is the property of Crafton, Tull & Associates, Inc., and is not to be used, in whole or in part, for any other project, without the written authorization of Crafton, Tull & Associates, Inc.

PROJECT	230303R	DATE	07/22/26
ISSUE	11/26/25	DATE	02/04/26
CONTACT	W. BURGESS	DATE	07/22/26
CHECKED		DATE	08/28/26
100%			
© 2025 Crafton, Tull & Associates, Inc.			
PLUMBING DRAIN PLAN - 1ST FLOOR			

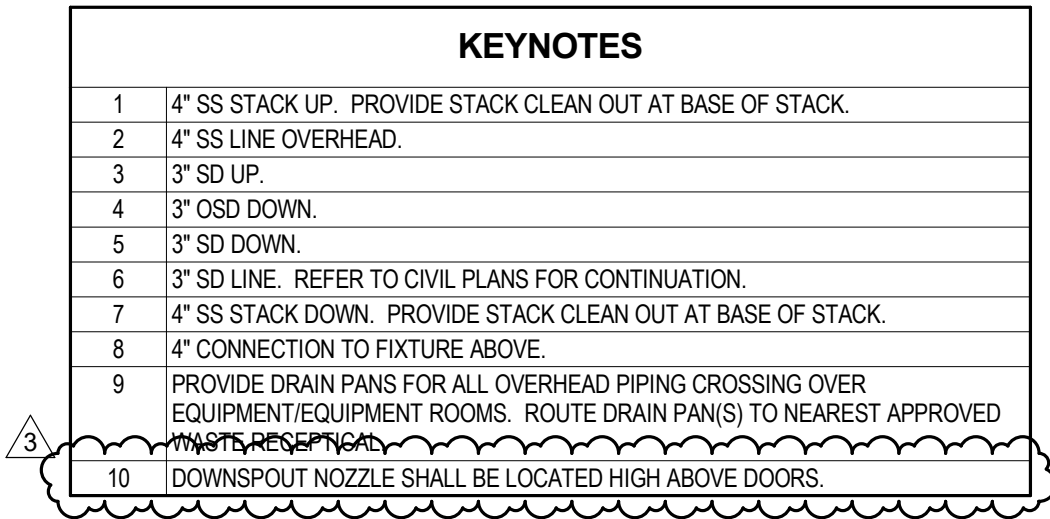

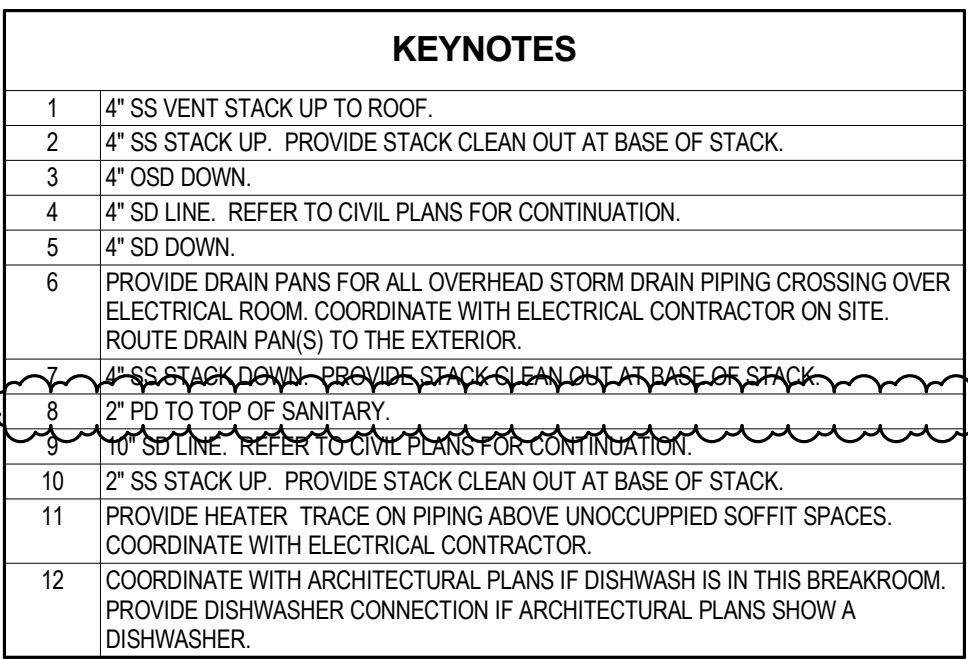

HP ENGINEERING

now  **IMEG**

5504 W. PINNACLE POINTE DRIVE
SUITE 200
ROGERS, AR 72758
479.899.6370 www.imegcorp.com


PROJECT NUMBER: 230303R	
100%	COMPLETION


HIGHLANDS BUILDING
ROGERS, AR


HIGHLANDS
ONCOLOGY GROUP
SOUTH JB HUNT DRIVE
ROGERS, AR 72756

This document, and the ideas and designs incorporated herein, as an instrument of professional service, is the property of Crafton, Tull & Associates, Inc., and is not to be used, in whole or in part, for any other project, without the written authorization of Crafton, Tull & Associates, Inc.

P-100D

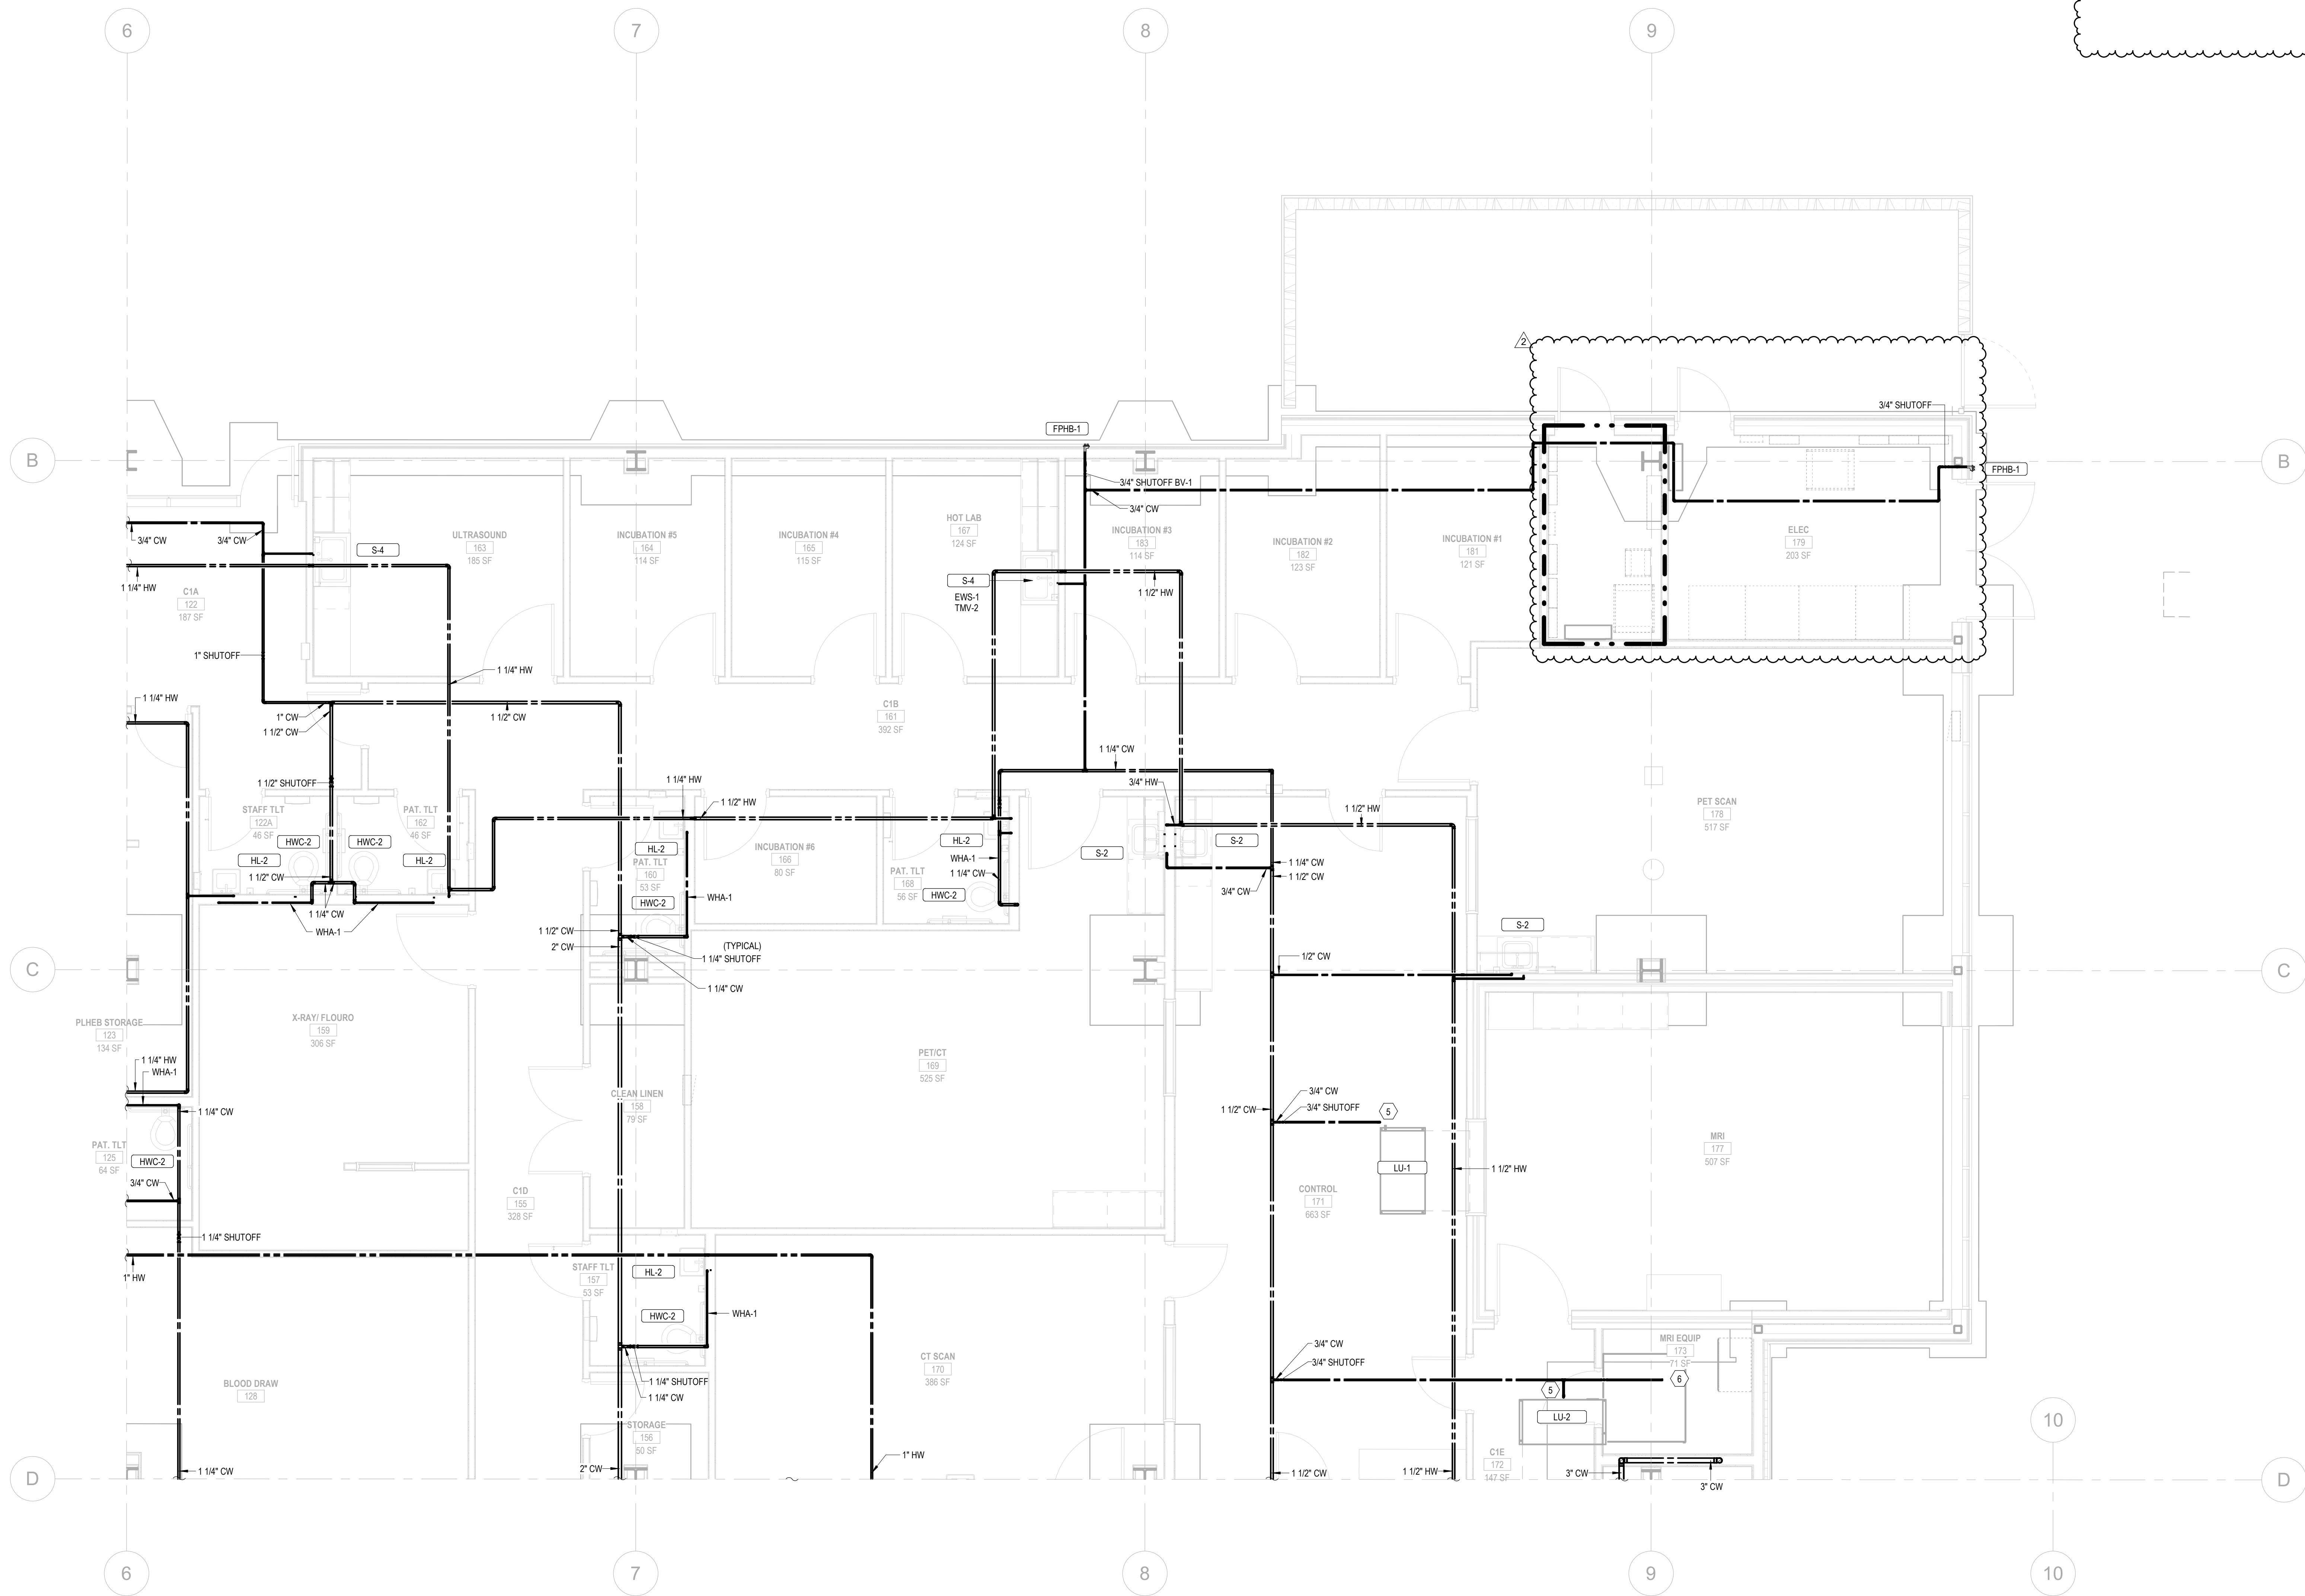

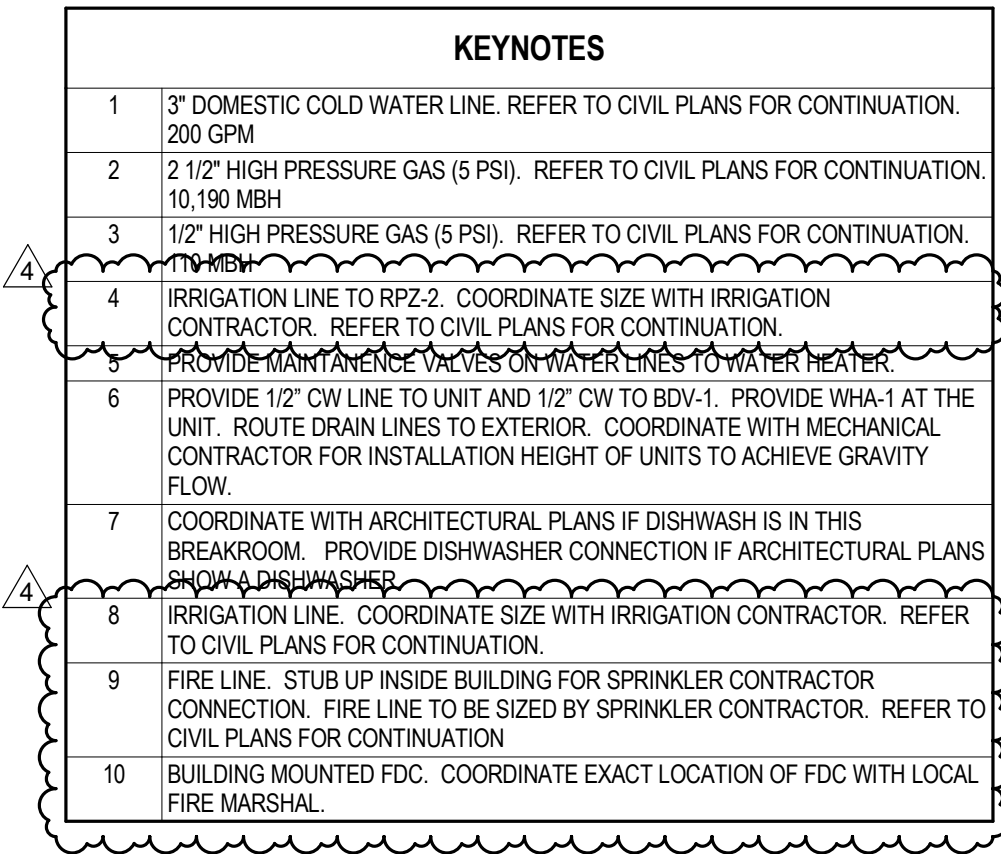

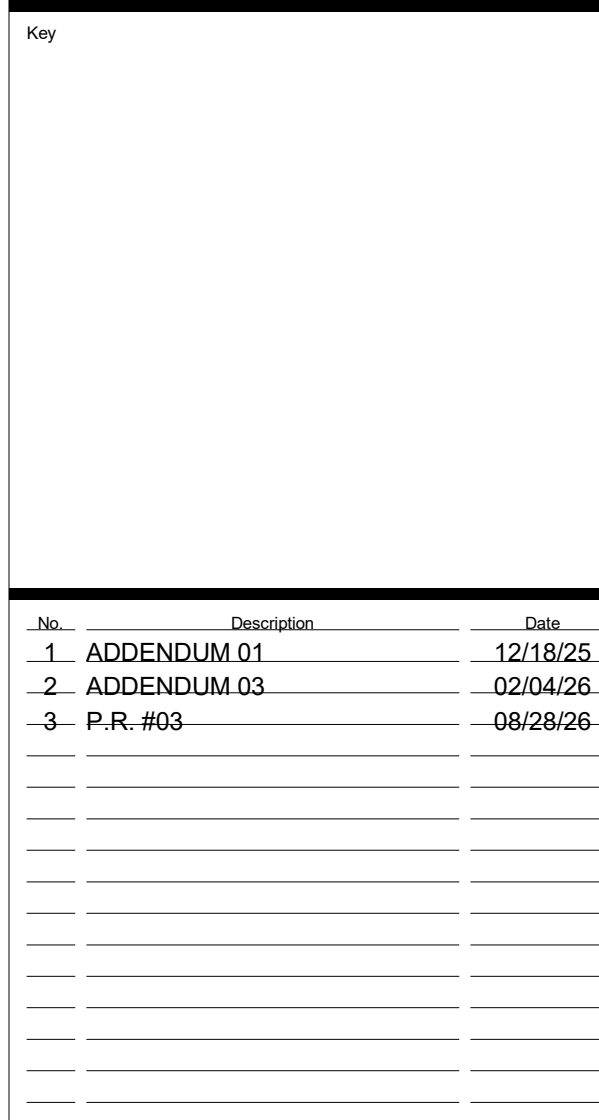

PROJECT 230303R
ISSUE 11/26/25
CONTACT W.BURGESS
CHECKED

100%

© 2025 Crafton, Tull & Associates, Inc.

PLUMBING DRAINAGE

09/02/26

STATE OF ARKANSAS
REGISTERED PROFESSIONAL ENGINEER
No. 19299
STEPHEN D. EDMONDSON