

GENERAL NOTES

- A. REFER TO SHEET PL01 FOR LEGEND, ABBREVIATIONS, SCHEDULES AND GENERAL NOTES.
- B. UTILITY SERVICES MUST BE MAINTAINED TO THE FLOOR ABOVE. ANY DISRUPTION IN SERVICES SHALL BE COORDINATED WITH THE C.O.R. TWO WEEKS BEFORE THE DISRUPTION. SERVICES SHALL NOT BE OUT FOR MORE THAN 5 HOURS UNLESS ALLOWED BY THE C.O.R.
- C. ALL WORK ON THE FLOORS BELOW SHALL BE DONE ON NIGHTS OR WEEK ENDS UNLESS OTHERWISE PERMITTED BY C.O.R.

SHEET KEYNOTES

1. NEW SUPPLY PIPING FOR FUTURE USE ON FLOOR ABOVE. CAP ENDS.
2. EXISTING DOMESTIC WATER CONDUIT AND SERVICES FLOOR ABOVE SHALL REMAIN UNDISTURBED AND IN SERVICE. TYPICAL OF ALL INSTANCES.
3. FOR ANY WORK ON OR ABOVE FLOOR, WORK MUST BE PERFORMED AFTER HOURS AND MUST BE PATIENT ACCESSIBLE DURING FACILITY OPERATION HOURS. SEE SHEET AE11-A FOR MORE INFORMATION.


PARTITION LEGEND

- EXISTING PARTITION / BARRIER - WALL TO REMAIN
- EXISTING PARTITION / BARRIER - WALL TO BE REMOVED
- NEW PARTITION / BARRIER - WALL


PARTITION GRAPHICS

- NO RATING
- SMOKE RESISTIVE PARTITION - NON RATED
- 1 HOUR FIRE BARRIER
- 1 HOUR FRESMOKE BARRIER
- 2 HOUR FIRE BARRIER
- 2 HOUR FIRE/ SMOKE BARRIER

KEY PLAN

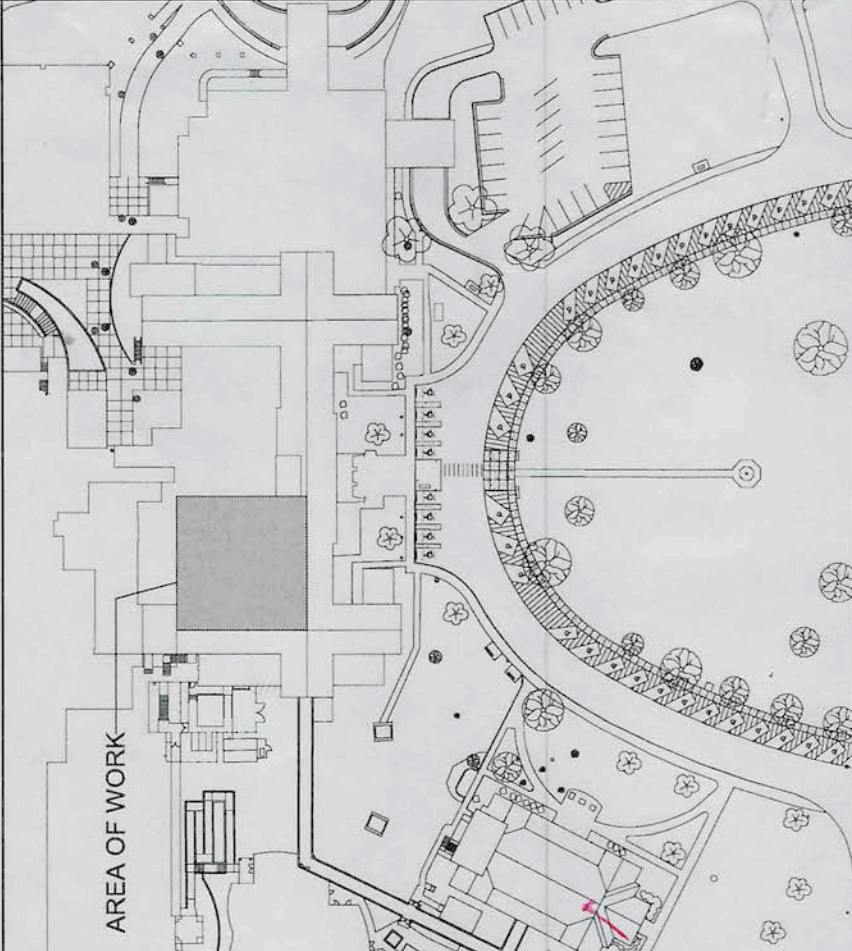


NORTH LEGEND

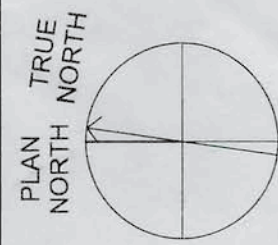

PLAN TRUE NORTH

FIRST FLOOR - FFE 0'-0"

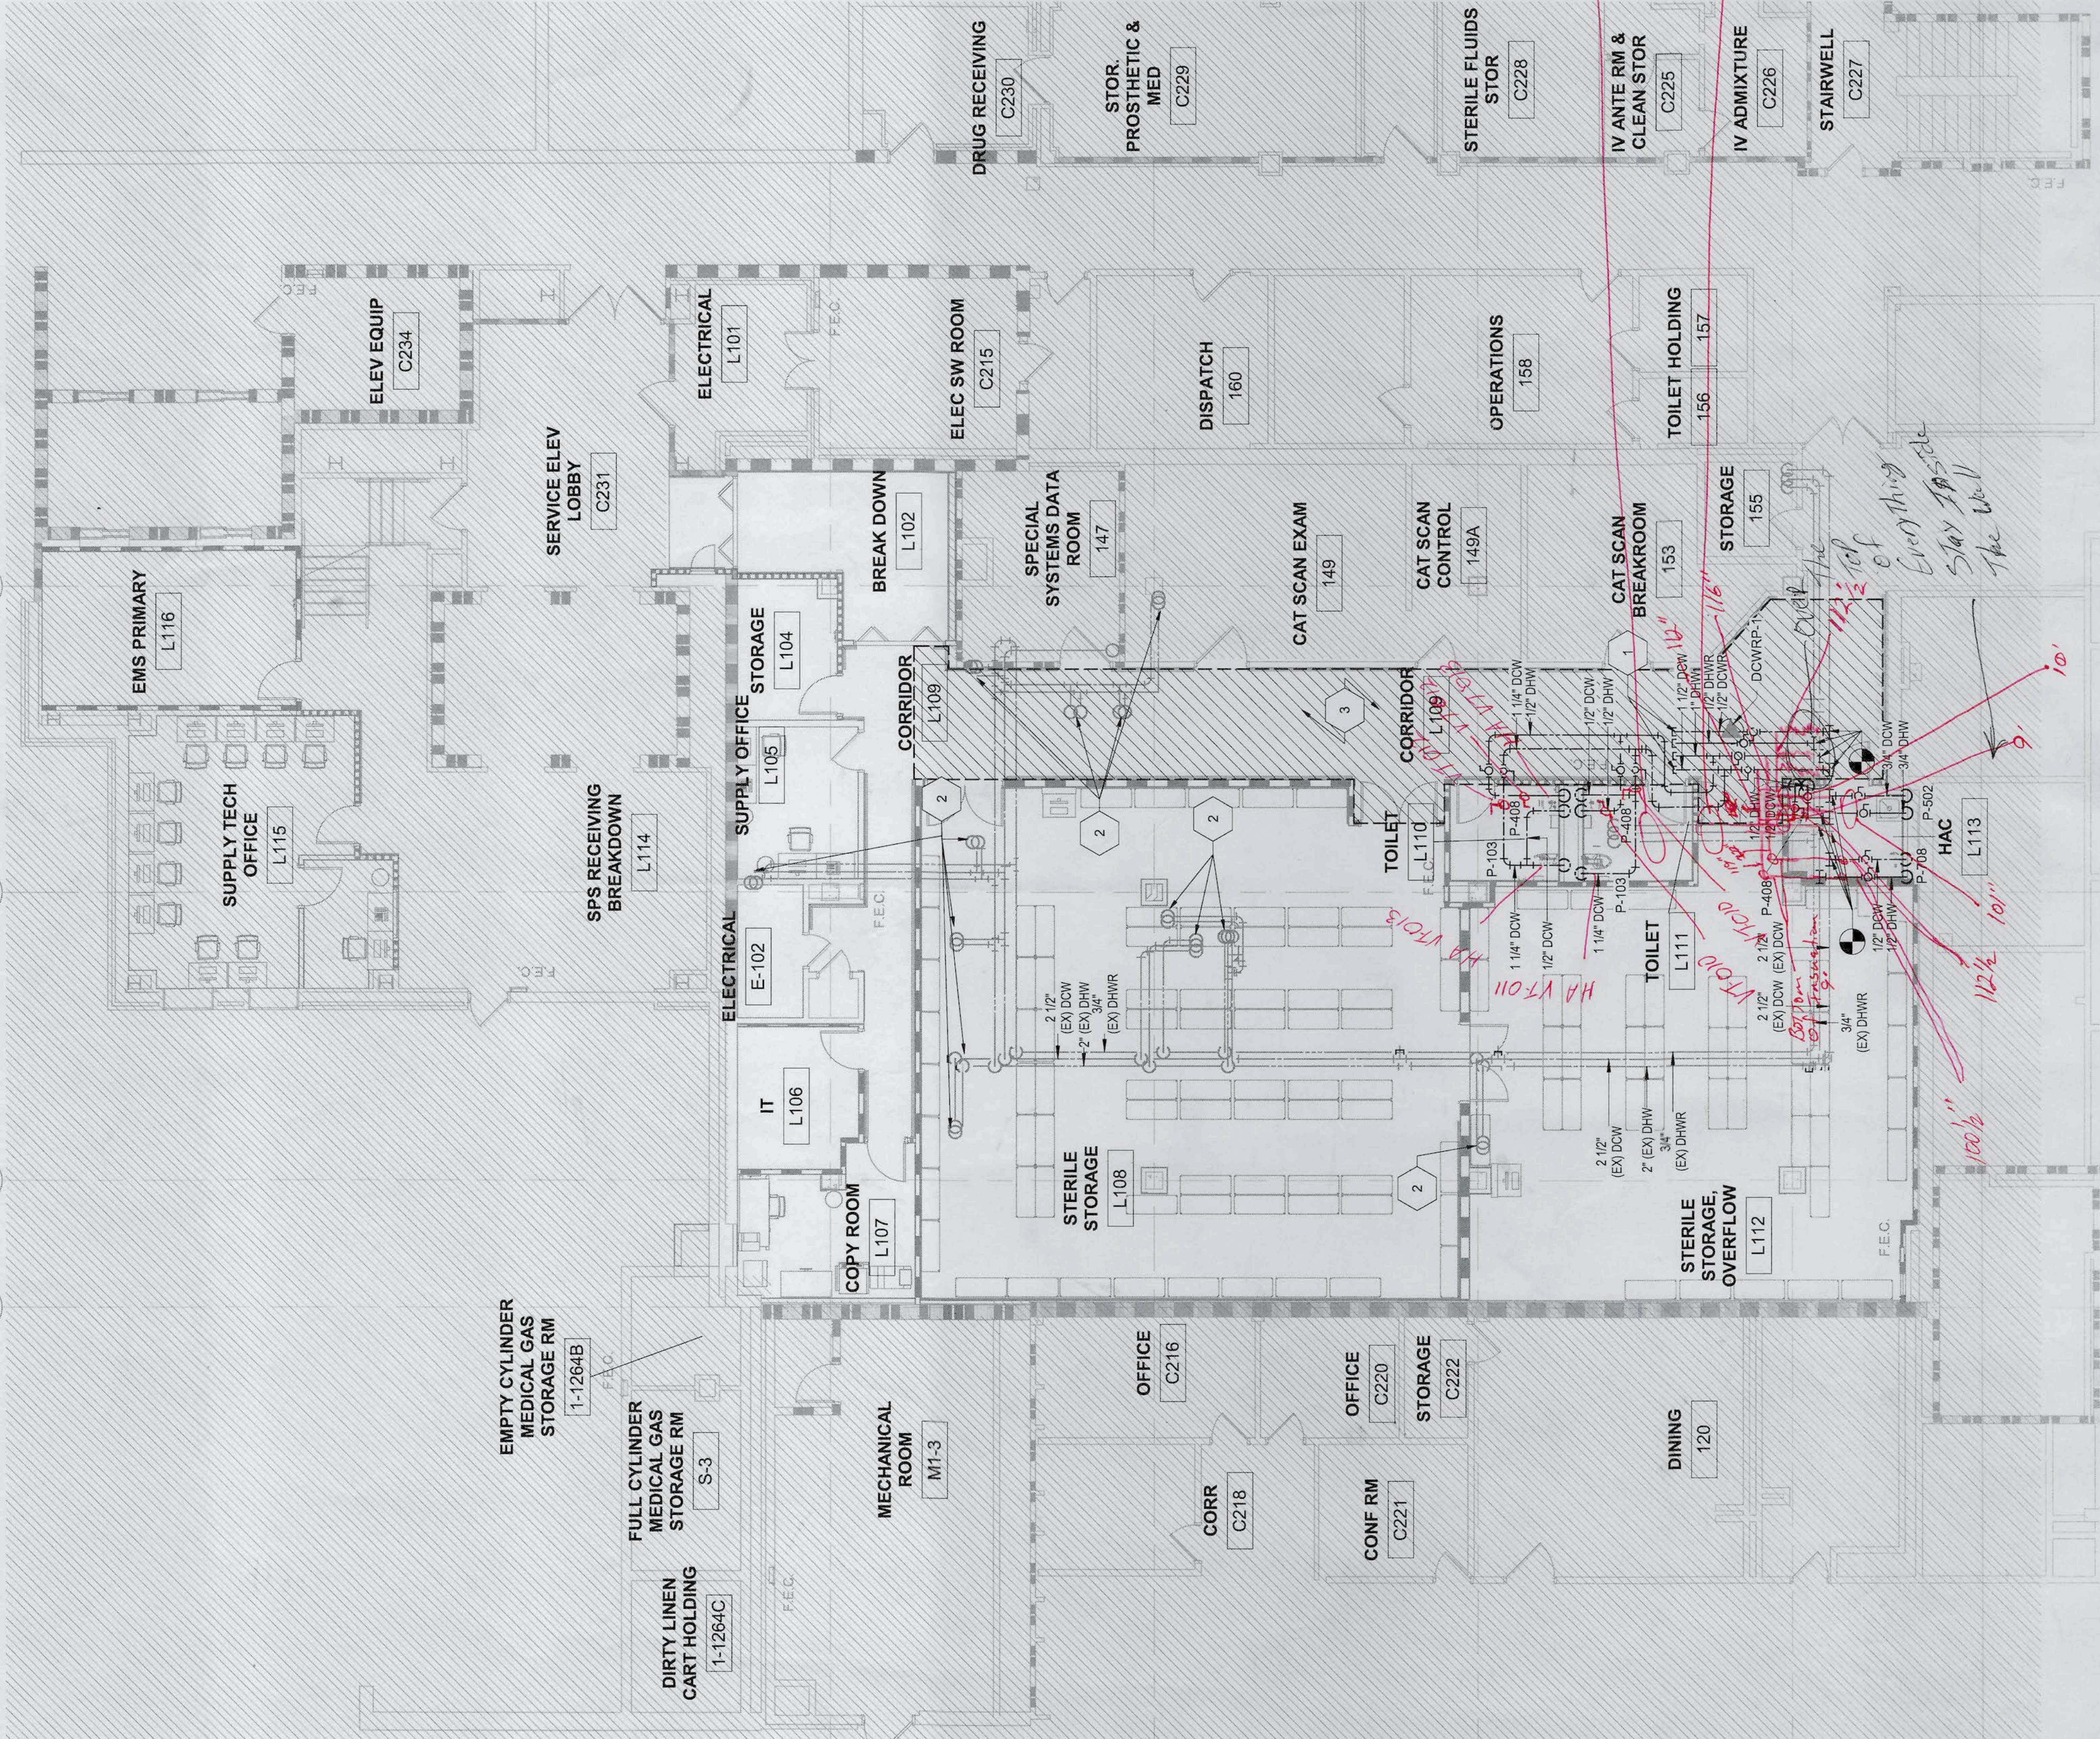

FIRST FLOOR DOMESTIC WATER PLAN

1/8" = 1'-0"

CONSULTANTS



ARCHITECT/ENGINEER OF RECORD

A/E: HARRELL DESIGN GROUP PC
10720 SIKES PLACE, SUITE 100
CHARLOTTE, NC 28277
704-814-1346
POC: LEE HARRELL, PE, LEED AP, OGP
HARRELL DESIGN GROUP
WWW.HARRELLDG.COM
COPYRIGHT © 2024

DRAWING TITLE

FIRST FLOOR DOMESTIC WATER PLANS

PHASE

CONSTRUCTION

DOCUMENTS SUBMISSION

FULLY SPRINKLERED

PROJECT TITLE

RENOVATE SPACE FOR LOGISTICS (B-1)

PROJECT NUMBER

564-24-104


BUILDING NUMBER

1

DRAWING NUMBER

PL101-A

Engineering Service

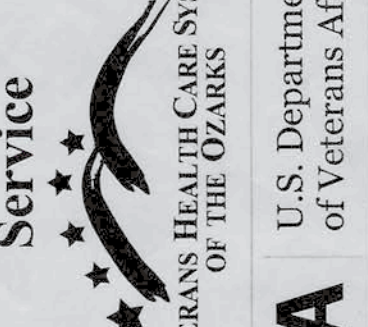

U.S. Department of Veterans Affairs