
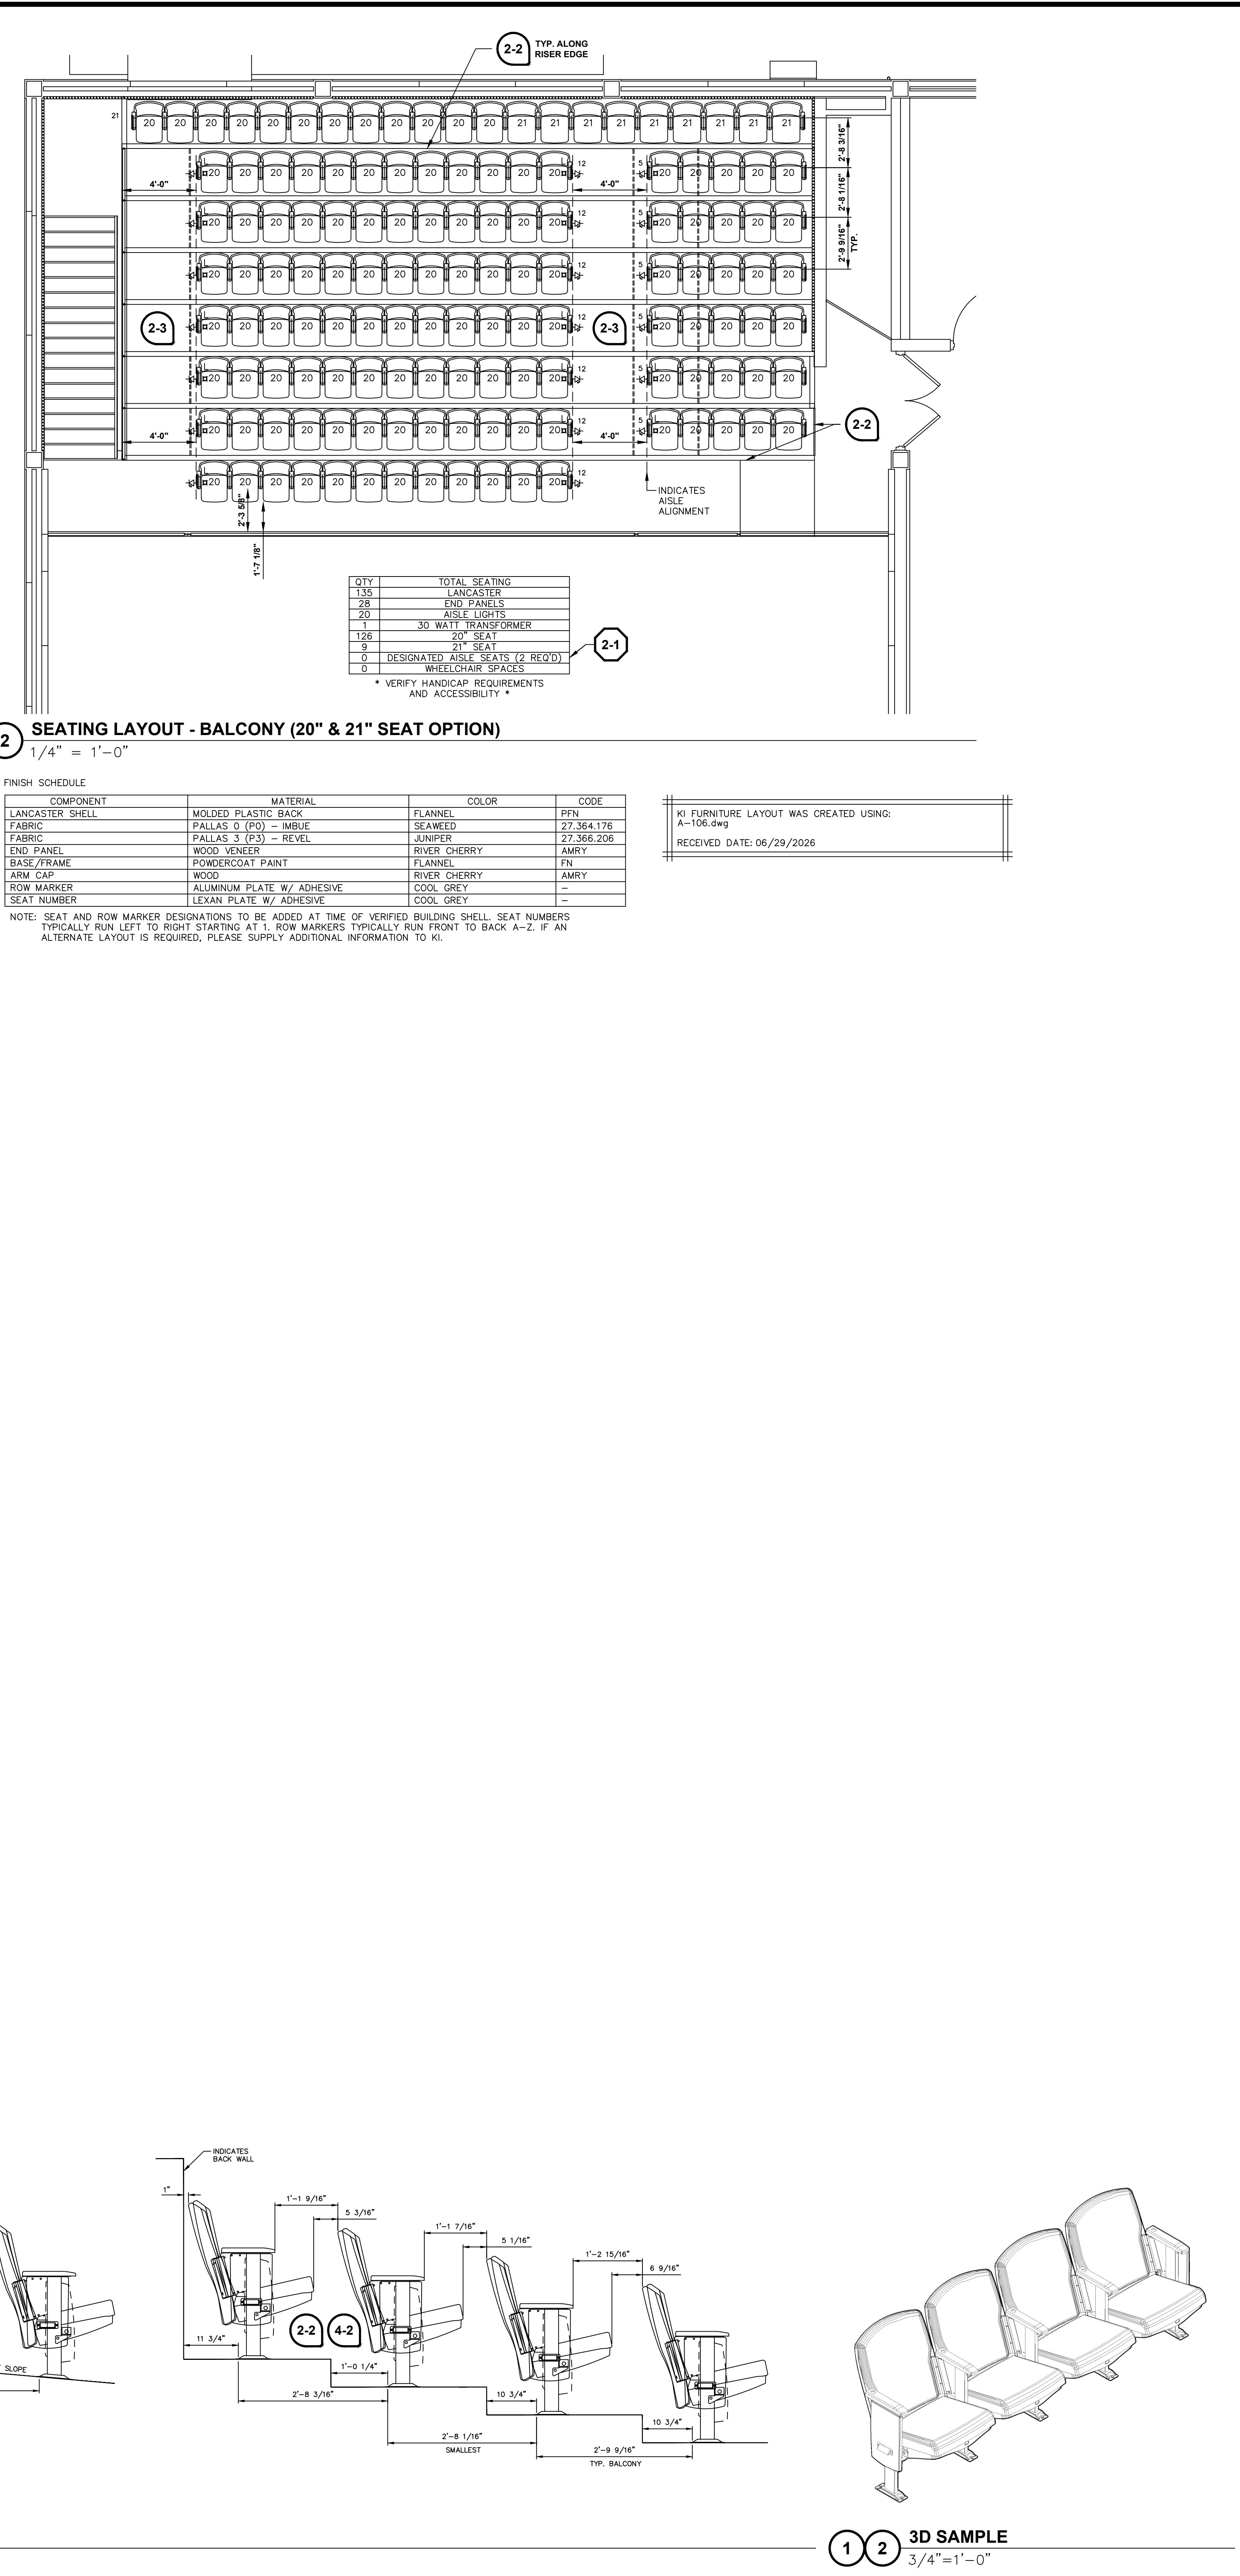
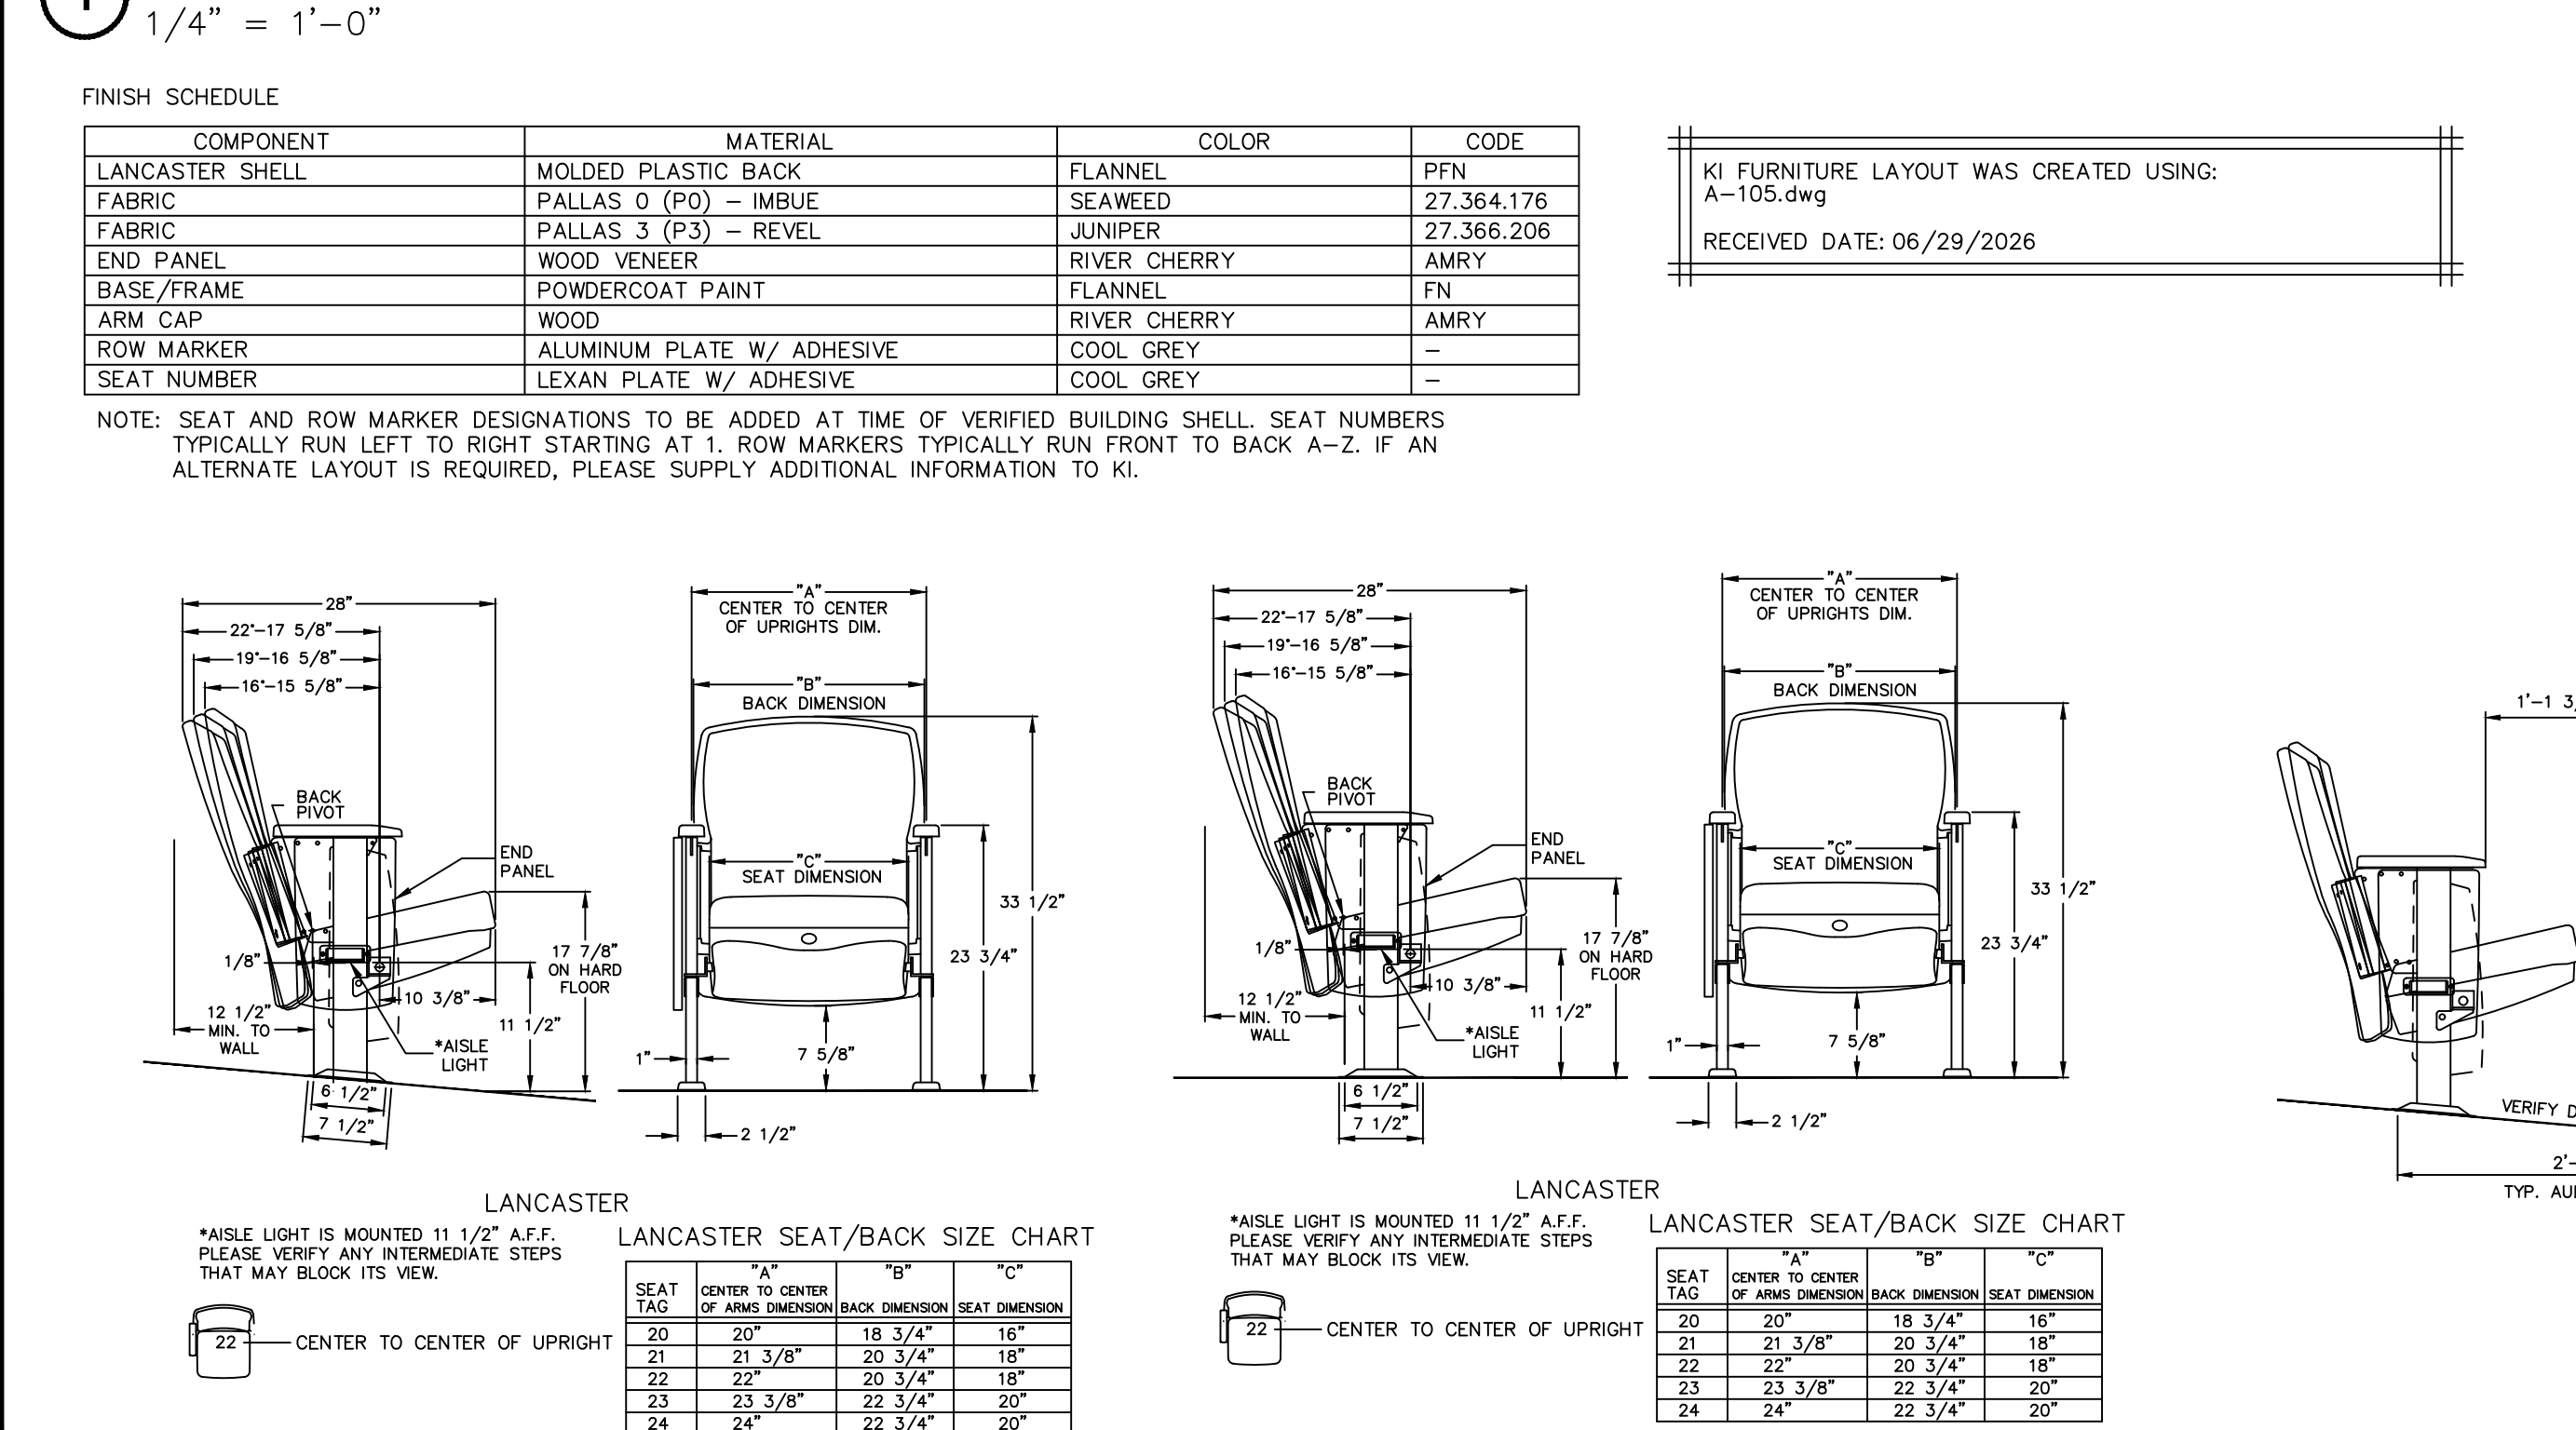


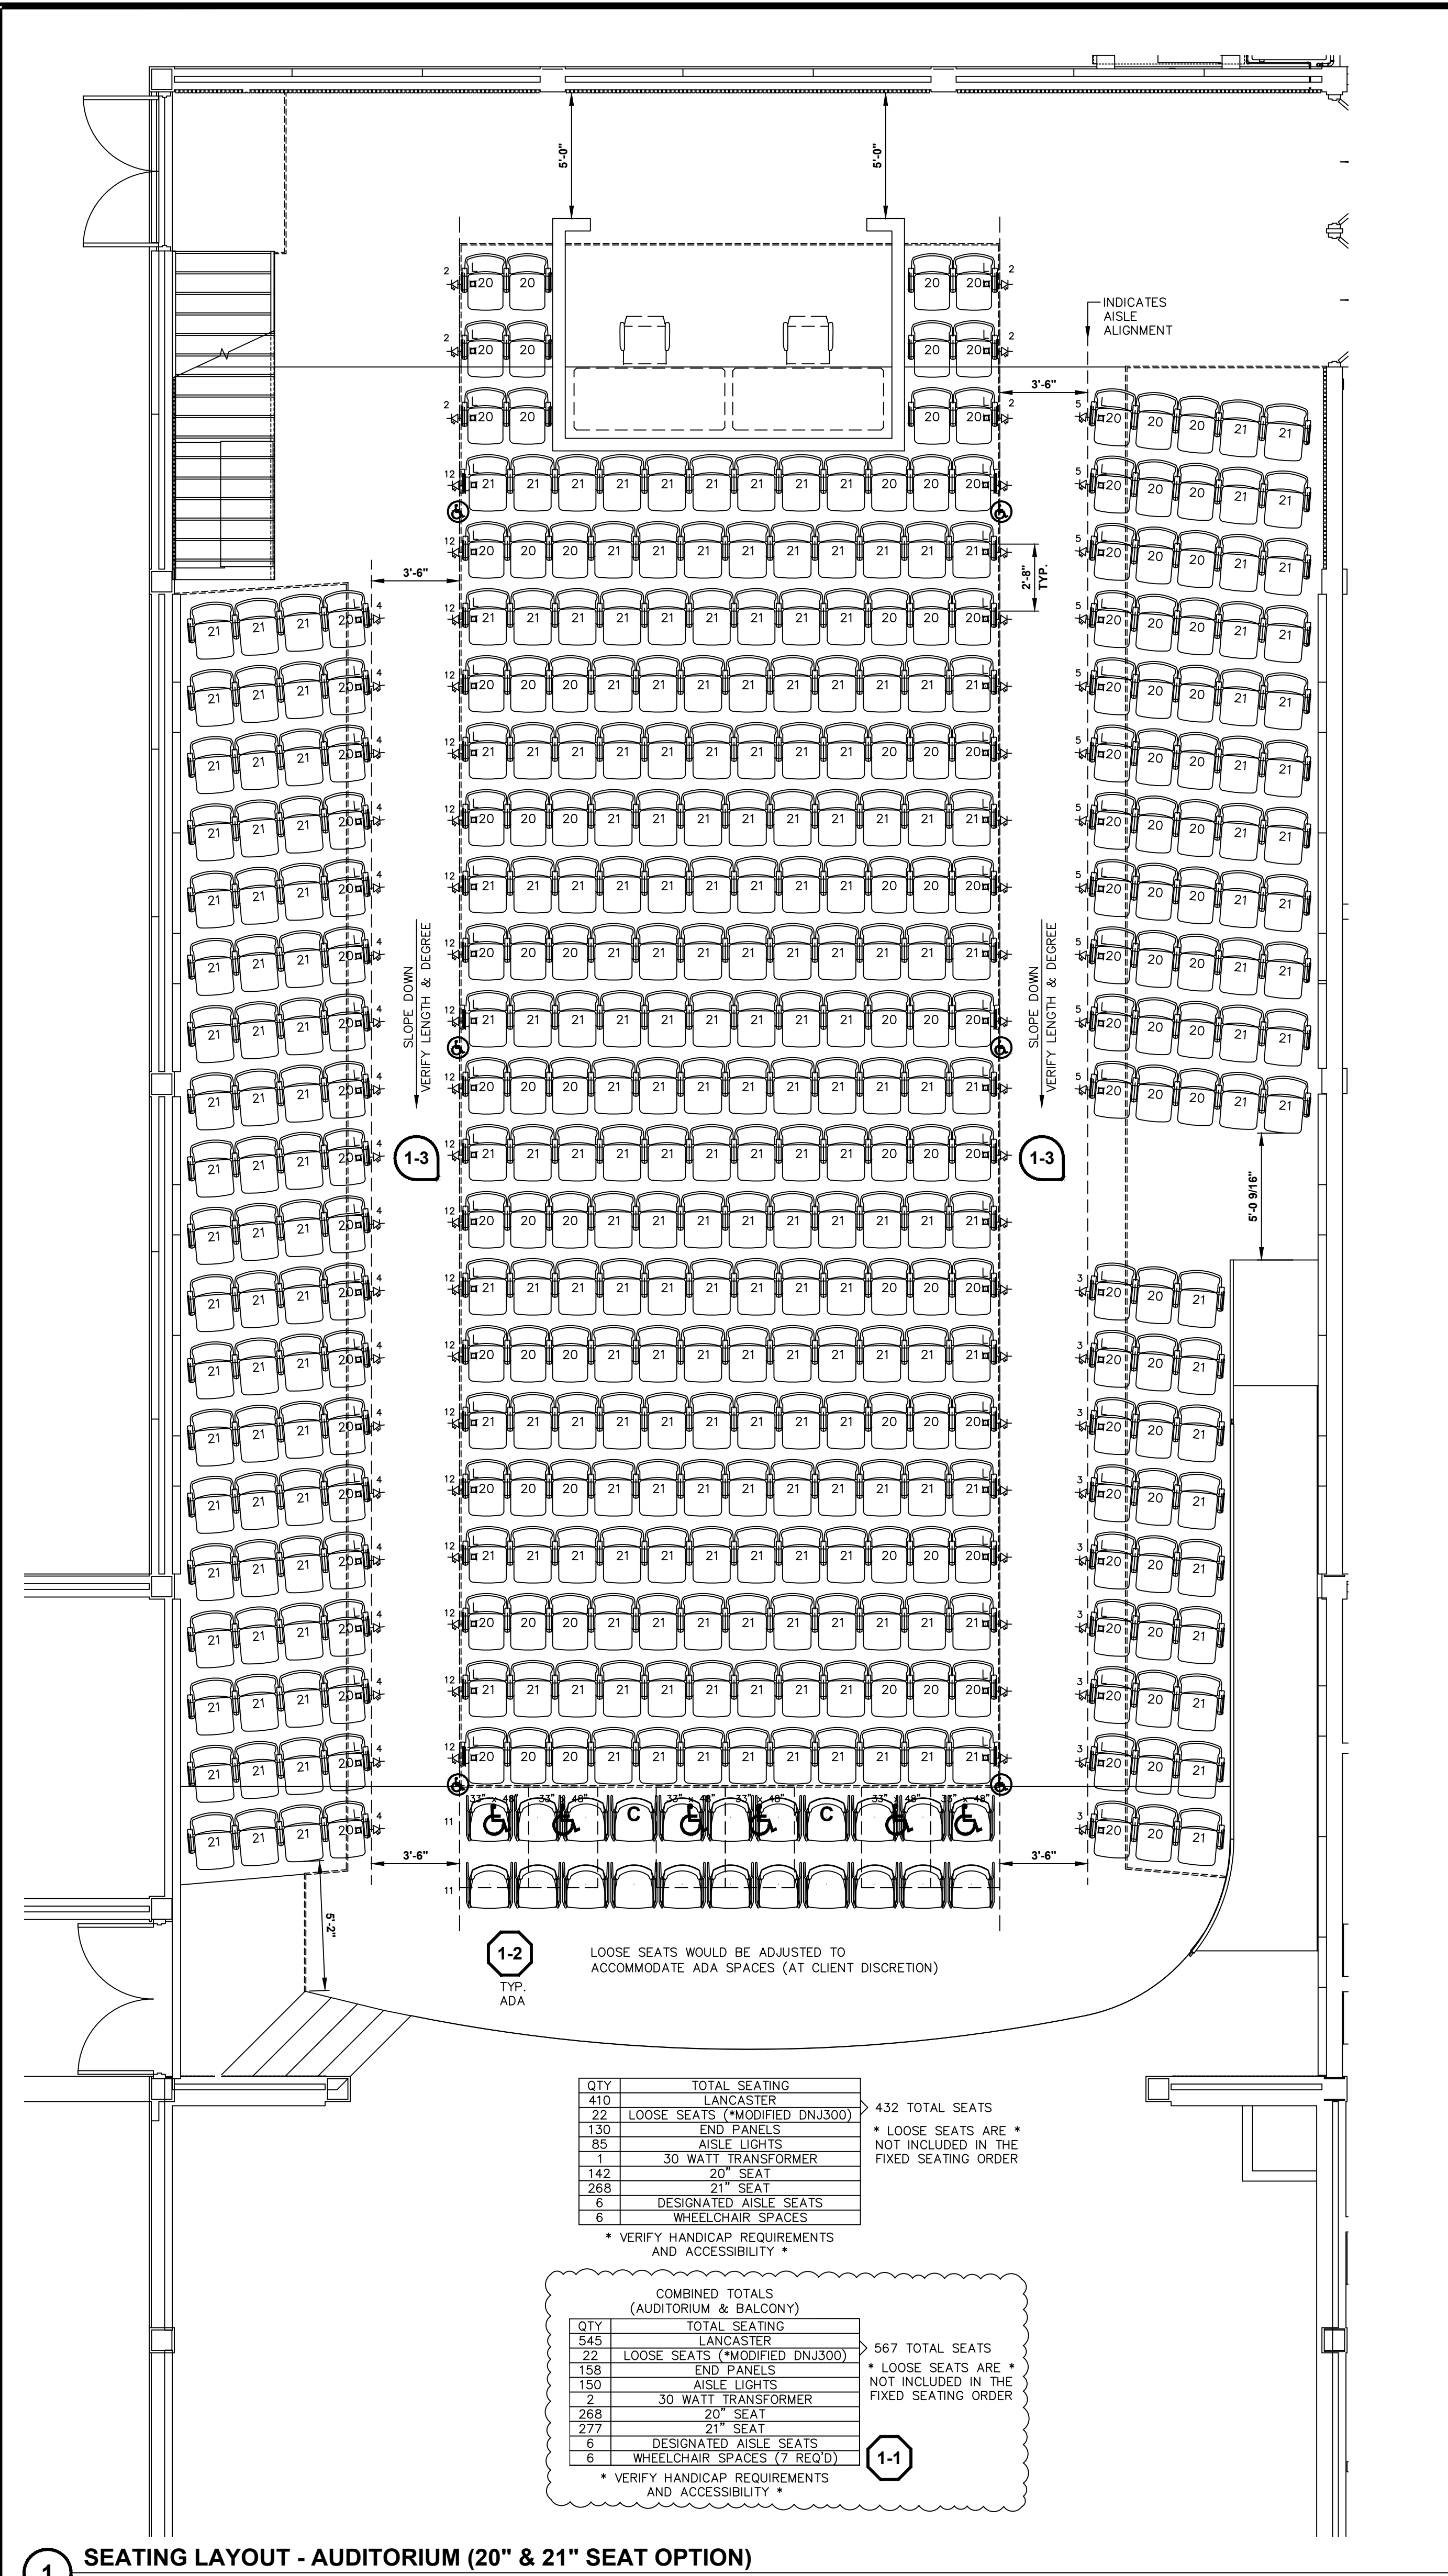

*** AUDITORIUM SEATING LEGEND ***

- WP = WORKING POINT
- C = COMPANION SEAT
- A = DESIGNATED AISLE SEAT
- LI = LAYOUT NOTE INDICATOR (CODE VIOLATION)
- RI = LAYOUT NOTE INDICATOR (RECOMMENDATION)
- I = END PANEL
- S = SEAT NUMBER
- R = ROW MARKER
- L = AISLE LIGHT (LOW VOLTAGE)
- LI = AISLE LIGHT INFEEED

*** AISLE LIGHT NOTES ***

L.E.D. AISLE LIGHT NOTES:

- LOW VOLTAGE: 12 VOLTS
- POWER PER LIGHT: 24 WATTS
- TRANSFORMER REQUIRED
- HARDWIRING TO BUILDING COMPLETED BY CERTIFIED ELECTRICIAN (DONE BY OTHERS)

1. AISLE LIGHT INFEEED LOCATIONS WILL BE PLACED AS INDICATED UNLESS OTHERWISE NOTED

2. VERIFY LOCATION OF INFEEEDS PER ROW

*** FIELD VERIFICATIONS REQUIRED TO* RELEASE ORDER**

THIS DRAWING WAS CREATED WITHOUT VERIFIED FIELD DIMENSIONS (VFD). KI WILL NOT BE RESPONSIBLE FOR ANY FIT ISSUES THAT OCCUR DUE TO INACCURACY OF THE DIMENSIONS DEPICTED IN OUR DRAWING AND THE ACTUAL FIELD CONDITIONS.

NOTE: SEATING CAPACITY WAS DETERMINED USING A MINIMUM SEAT SIZE OF 21". SEAT COUNT IS SUBJECT TO VARY PENDING VFD'S AND FINAL APPROVAL AND WILL BE CONFIRMED AT TIME OF ORDER.

*** MINIMUM FLOOR CONSTRUCTION * FOR PRODUCT INSTALLATION**

WOOD FLOORS

- MINIMUM TWO LAYERS OF 3/4" APA GRADED PLYWOOD OR MINIMUM 1 1/2" THICK SPRUCE-PINE-FIR WITH MINIMUM SPECIFIC GRAVITY OF 0.42
- ALLOW MINIMUM EMBEDMENT 1 1/2" WITH LAG SCREWS

CONCRETE FLOORS

- MINIMUM 3000 PSI CONCRETE, COMPRESSED STRENGTH, CRACKED, LIGHTWEIGHT
- SEE SPECIFIC ANCHOR DIAGRAM IN ASSEMBLY INSTRUCTIONS FOR MINIMUM ANCHOR EMBEDMENT

STRUCTURAL CONCRETE FLOOR

- MINIMUM TWO LAYERS OF 3/4" CONCRETE PANELS WITH MINIMUM 14 GAUGE STEEL BETWEEN

RAISED FLOORS

- KI IS RESPONSIBLE FOR HOW FLOORING IS SECURED.
- PLEASE RELAY FLOOR CONSTRUCTION TO KI CUSTOMER SERVICE FOR SPECIFICATION OF PROPER ANCHORS

RISER MOUNT

- CONCRETE: MINIMUM 3000 PSI CONCRETE, COMPRESSED STRENGTH, CRACKED, NORMAL WEIGHT
- LANCASTER: MINIMUM 4000 PSI CONCRETE, COMPRESSED STRENGTH, CRACKED, NORMAL WEIGHT
- ALL OTHERS: MINIMUM 5000 PSI CONCRETE, COMPRESSED STRENGTH, CRACKED, LIGHTWEIGHT
- SEE SPECIFIC ANCHOR DIAGRAM IN ASSEMBLY INSTRUCTIONS FOR MINIMUM ANCHOR EMBEDMENT

NOTE: FLOOR MOUNTING FASTENERS ARE PROVIDED UNLESS SPECIFIED OTHERWISE.

NOTE: WARRANTY NULL AND VOID IF KI PRODUCT IS INSTALLED ON FLOORING NOT MEETING MINIMUM STRUCTURAL REQUIREMENTS STATED ABOVE.

FOR QUESTIONS CONCERNING ANCHOR SELECTION AND SPECIAL FLOOR CONDITIONS, PLEASE CONTACT KI CUSTOMER SERVICE.

*** LAYOUT NOTES ***

KI HAS PREPARED THESE PLANS IN ACCORDANCE WITH REQUIREMENTS AND INSTRUCTIONS PROVIDED BY THE OWNER/ ARCHITECT/ CONTRACTOR. THE MATTERS IDENTIFIED BELOW ARE AREAS IN WHICH THESE REQUIREMENTS AND/OR INSTRUCTIONS DO NOT COMPLY WITH THE IDENTIFIED CODE, STANDARDS OR RECOMMENDATION. APPROVAL OF THESE PLANS BY THE OWNER/ ARCHITECT/ CONTRACTOR CONSTITUTES AGREEMENT THAT KI SHALL SUFFER NO LIABILITY FOR ANY CLAIMS, DAMAGES, OR OTHER HARM CAUSED BY SUCH NON-COMPLIANCE.

THE QUANTITY OF WHEELCHAIR SPACES IN THIS ROOM DOES NOT COMPLY WITH **IBC 118.2.3.1** WHICH INDICATES THAT SEATING CAPACITIES OF 501 TO 5,000, REQUIRE 6 WHEELCHAIR SPACES PLUS 1 MORE FOR EVERY 150 SEATS OR FRACTION THEREOF BETWEEN 501 & 5,000 (& CORRESPONDING COMPANION SEATS).

PER **IBC 118.2.3.2** EACH WHEELCHAIR SPACE IS REQUIRED TO HAVE A COMPANION SEAT WHICH ALLOWS FOR SHOULDER TO SHOULDER ALIGNMENT AS INDICATED BY **IBC A117.1.5.9.2.2**.

PER **IBC 118.2.3.2** AT LEAST ONE BUT NOT LESS THAN ONE OF THE TOTAL NUMBER OF SEATS SHALL BE IDENTIFIED WITH THE INTERNATIONAL SYMBOL OF ACCESSIBILITY AND BE LOCATED CLOSEST TO AN ACCESSIBLE ROUTE.

PLEASE VERIFY ELEVATION CHANGE IN THIS AREA. A GUARD MAY BE REQUIRED TO PREVENT A TRIP HAZARD.

PLEASE VERIFY ANY HANDRAILS THAT MAY BE REQUIRED ALONG THIS AISLE. PLEASE COMMUNICATE THE SIZE & LOCATION OF ANY HANDRAILS NOT SHOWN ON THIS PLAN.

*** HANDRAILS AT A CENTER AISLE 21" (584mm) MINIMUM FROM EDGE OF SEAT TO EDGE OF HANDRAIL (IBC 108.3.3)**

*** HANDRAILS AT SIDE AISLES: SIDE HANDRAILS ARE PERMITTED TO PROTRUDE 4 1/2" (114mm) INTO THE AISLE, ANYTHING GREATER THAN THIS WILL INFRINGE ON MINIMUM AISLE REQUIREMENTS (IBC 1014.8)**

NOTE: SYMBOL KEY

- LAYOUT NUMBER
- RECOMMENDATION

LANCASTER ANCHOR HOLE LOCATION

LANCASTER AISLE LIGHT INFEEED LOCATION

3D SAMPLE

3/4" = 1'-0"

KI

THIS PLAN IS THE CONFIDENTIAL PROPERTY OF KROGER INTERNATIONAL, INC. AND CONTAINS INFORMATION THAT IS NOT TO BE USED EXCEPT IN CONNECTION WITH THE PROJECT AND AS SHOWN ON THESE PLANS. ANY REPRODUCTION OR COPIING OF THIS PLAN, IN WHOLE OR PART, IS PROHIBITED.

FIELD VERIFICATION

This Plan incorporates building information compiled from various sources associated with this project and deemed as reliable. Conditions already affecting the product or its installation must be field verified.

CODE REQUIREMENTS

It is typically required that upon an interpretation of applicable sections of the 2015 International Building Code (IBC), however, due to nature, layout and/or complexity of the project, the Designer/Architect/Contractor, this Plan may not be IBC compliant. As a result, and notwithstanding anything to the contrary, it is a part of this Plan to require the Contractor to verify that the Plan complies with the applicable code requirements. If the Contractor is unable to verify that the Plan complies with the applicable code requirements, the Contractor shall notify the Designer/Architect/Contractor in writing, and the Designer/Architect/Contractor shall be responsible for obtaining the necessary approvals and permits. The Contractor shall not be responsible for any non-compliance with applicable codes.

KI recommends that these Plans and the resulting products be reviewed by a local fire inspector to verify compliance with all local building codes. KI disclaims responsibility for any non-compliance with applicable codes or any non-compliance with local building codes.

THIS PLAN IS NOT INTENDED TO BE USED FOR BUILDING CONSTRUCTION

DRAWING REVIEW

These Plans are intended to comply with the contract. As such, these Plans must be reviewed by the Designer/Architect/Contractor, or other appropriate representative, if it is to proceed with construction. It is the responsibility of the Designer/Architect/Contractor to verify that the Plans comply with the contract and to complete the information of the bottom of this page and return this document to KI. If these Plans are to be corrected, mark the "Revised and Resubmitted" box below, complete and complete the information of the bottom of this page and return this document to KI. Authorized signature indicates review of these Plans. Below signature print name, title, company or affiliation, and date. Description of product shown. If not reviewed and signed, return to complete and authorize signature is required.

It is the Designer/Architect/Contractor's responsibility to verify that the conditions have changed or are different from those shown on the Plans. If the conditions have changed or are different from those shown on the Plans, the Designer/Architect/Contractor must notify KI and obtain approval before proceeding with construction. If the Designer/Architect/Contractor does not notify KI and proceeds with construction, the Designer/Architect/Contractor shall be responsible for any non-compliance with applicable codes or any non-compliance with local building codes.

APPROVED AS NOTED: ☐

REVISED AND RESUBMITTED: ☐

SIGNATURE: _____

DATE: _____

COMPANY: _____

DATE: _____

KI WALL DEPT USE ONLY

☐ FIELD APPROVAL

☐ DRAWING APPROVAL

☐ WCP/AS/MS/OMS

☐ AUDIT COMPLETE

PROJECT TITLE: CROWNELL ARCHITECTS SPRINGDALE PHILANDER SMITH VOLUME 2

FLOOR/AREA: AUDITORIUM & BALCONY

PRODUCT LINE: Lancaster

REPRESENTATIVE: HANOVER

DEALER: _____

ORDER NUMBER: _____

DATE: 02/10/2026

SFDC: 781526

REVISIONS:

NO.	DATE	DESCRIPTION
3	06/16/2024	ADD 21" MIN SEAT SIZE
4	06/26/2024	NEW BUILDING SHELL
5	07/06/2024	ADD 21" MIN SEAT SIZE
6	07/06/2024	ADD ADA/AS/MS/OMS
7	08/06/2024	ADD LOOSE SEATING NOTE
8	07/06/2024	ADD 21" MIN SEAT SIZE
9	07/06/2024	ADD 21" MIN SEAT SIZE

DRAWING NO.: D781526-00-00-L01-F

DATE: 02/10/2026

SCALE: AS NOTED

SHEET: Seating (1)

1 of 4.7