


① SANITARY WASTE RISER DIAGRAM - BLDG 6

As-Builts
1/12/2025
CSUSA

CONSULTANTS:
STRUCTURAL
Bernhard TME
PLUMBING
Bernhard TME
MECHANICAL
Bernhard TME
ELECTRICAL
Bernhard TME
FIRE PROTECTION
Bernhard TME
CIVIL
Development Consultants Inc
CONSTRUCTION DOCUMENTS

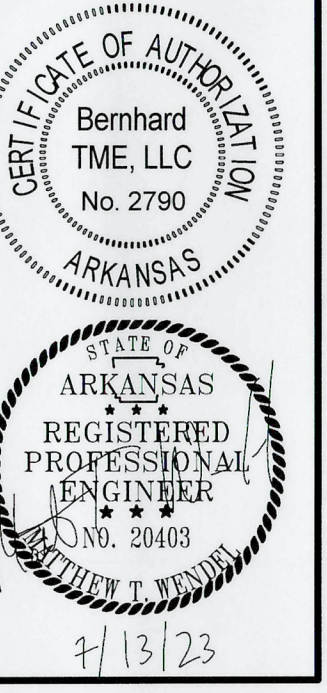

NEW DORMITORIES - PHASE IIB
BUILDING # 6
BOONEVILLE HUMAN DEVELOPMENT CENTER
87 REED ROAD, BOONEVILLE, ARKANSAS

REVISIONS

No.	Description	Date
1	ADD 001	10/24/22
2	RFI 047	07/10/23
3	RFI 051	07/13/23

ISSUE DATE
OCTOBER 7, 2022

PROJECT NUMBER: 2002-B

DBA NUMBER: 7102208

CONTENTS
RISERS - PLUMBING
- BLDG 6

SHEET NUMBER

P3.1

BUILDING # 6