

0 2'-8" 5'-4" 10'-8"

SCALE:  $\frac{3}{16}'' = 1'-0''$

**PD101**



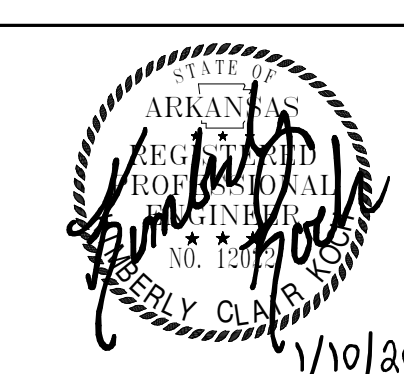
1. CONNECT NEW 4"SS AND 3"V TO EXISTING SANITARY SEWER AND VENT SERVING WOMEN'S RR 7E-110.
2. CONNECT NEW 1/2"H.W., 1/2"C.W., 1/2"H.W.R TO EXISTING COLD WATER, HOT WATER, & HOT WATER RETURN SERVING WOMEN'S RR 7E-110.

MANUFACTURER AND MODEL NUMBERS LISTED ARE BASIS OF DESIGN, APPROVED EQUALS ARE ALLOWED UNLESS OTHERWISE NOTED.

MANUFACTURER AND MODEL NUMBERS LISTED ARE BASIS OF DESIGN, APPROVED EQUALS ARE ALLOWED UNLESS OTHERWISE NOTED



MISSION CRITICAL  
CONSTRUCTION DOCUMENTS



**VA** | U.S. Department  
of Veterans Affairs

Approved: Project Director

**FULLY SPRINKLERED**

Location	VAMC LITTLE ROCK
----------	------------------

Drawn  
CJC

Number

**PK101**



PLUMBING GENERAL NOTES

1.

ALL PIPING IN FINISHED ROOMS OR SPACES SHALL BE CONCEALED IN A FURRED CHASE OR ABOVE A HARD SUSPENDED CEILING.
2.

ACCESS PANELS IN HARD SUSPENDED CEILINGS ARE REQUIRED FOR ALL VALVES, TRAPS, CLEANOUTS, CONTROLS, ETC. COORDINATE LOCATION OF PANELS WITH MECHANICAL INSTALLATION AND DEMONSTRATE ACCESS TO EQUIPMENT SERVED.
3.

ALL PIPE ROUTING AND CONSTRUCTION SHOWN ON THE DRAWINGS ARE DIAGRAMMATIC IN NATURE AND MAY NOT BE SHOWN IN EXACT LOCATIONS OR WITH ALL ANCILLARY ITEMS REQUIRED FOR A COMPLETE AND OPERATING SYSTEM. CONTRACTOR SHALL COORDINATE ROUTING OF ALL PIPING PER TYPICAL CONSTRUCTION PRACTICE IN THE MOST EFFICIENT WAY POSSIBLE WHILE ADHERING AS CLOSELY TO THE DRAWINGS AS POSSIBLE. CONTRACTOR IS RESPONSIBLE FOR COORDINATING ALL INSTALLATION WITH THE WORK OF OTHER TRADES. FIELD MODIFICATIONS SUCH AS OFFSETS IN PIPING NEEDED DUE TO OBSTRUCTIONS OR INTERFERENCES SHALL BE PROVIDED AT NO ADDITIONAL COST.
4.

ALL WORK SHALL BE PERFORMED IN A NEAT AND WORKMANLIKE MANNER WITHIN STANDARD OF CARE FOR PROFESSION. ALL LABOR, MATERIAL, TOOLS, PERMITS, INSPECTIONS, TESTING, CERTIFICATION, ETC. REQUIRED FOR A COMPLETE AND SATISFACTORY INSTALLATION TO DESIGN INTENT SHALL BE FURNISHED BY CONTRACTOR. PROVIDE, AT NO ADDITIONAL COST, INCLUDING INCIDENTAL ITEMS NOT SHOWN WHEN REQUIRED FOR TYPICAL COMPLETION OF WORK.
5.

DRAWINGS NOT BEARING THE STAMP OR SEAL AND SIGNATURE OF A REGISTERED PROFESSIONAL ENGINEER SHALL NOT BE USED FOR BIDDING OR CONSTRUCTION PURPOSES UNLESS EXPRESSLY APPROVED IN WRITING BY THE ARCHITECT. THE CONTRACTOR SHALL BE RESPONSIBLE FOR ENSURING THAT ALL DRAWINGS AND SPECIFICATIONS BEING USED FOR BIDDING AND CONSTRUCTION PURPOSES ARE OF THE LATEST REVISION AVAILABLE AND ALL ADDENDUM DOCUMENTS HAVE BEEN INCORPORATED EITHER BY REVISION RELEASE OF DRAWINGS/SPECIFICATIONS OR ATTACHMENT OF SKETCHES OR OTHER ADDENDUM INFORMATION.
6.

THE PLUMBING CONTRACTOR SHALL FURNISH AND INSTALL NEW PRODUCTS OF ESTABLISHED AND REPUTABLE MANUFACTURERS. NO EQUIPMENT SUBSTITUTIONS SHALL BE MADE THAT WOULD LEAVE INADEQUATE OPERATING OR SERVICE SPACE. EQUIPMENT SHALL BE INSTALLED IN ACCORDANCE WITH MANUFACTURER'S RECOMMENDED INSTALLATION PROCEDURES AND IN AN ARRANGEMENT THAT WILL GIVE THE GREATEST PRACTICAL EASE OF OPERATION AND SERVICE TO THE OWNER.
7.

ALL WORK SHALL BE INSTALLED IN ACCORDANCE WITH THE REQUIREMENTS OF ALL APPLICABLE CODES AND REGULATIONS INCLUDING BUT NOT LIMITED TO CAVHS, NATIONAL, CITY, STATE, AND LOCAL ORDINANCES. ALL PLUMBING MATERIALS, INSTALLATION PROCEDURES, AND SYSTEM LAYOUTS SHALL BE APPROVED BY ALL APPLICABLE AUTHORITIES HAVING JURISDICTION. THE CONTRACTOR SHALL PROVIDE ALL MATERIALS AND LABOR NECESSARY TO COMPLY WITH THESE RULES, REGULATIONS, AND ORDINANCES. THESE CODES REPRESENT THE MINIMUM ACCEPTABLE REQUIREMENTS. THEREFORE, WHERE DRAWINGS AND/OR SPECIFICATIONS INDICATE MATERIALS OR CONSTRUCTION MORE STRINGENT THAT CODE REQUIREMENTS, THE DRAWINGS AND/OR SPECIFICATIONS SHALL GOVERN.
1.

IT IS THE RESPONSIBILITY OF THE PLUMBING CONTRACTOR TO PAY FOR ALL NECESSARY PERMITS AND APPROVALS FOR THIS INSTALLATION.
2.

ALL DOMESTIC WATER PIPING SHALL CONFORM TO THE REQUIREMENTS OF THE ANSI SAFETY CODE AND BE FREE FROM ALL DEFECTS AND BE PROPERLY IDENTIFIED.
3.

STERILIZE THE ENTIRE WATER DISTRIBUTION SYSTEM PER THE REQUIREMENTS OF THE LOCAL AUTHORITY HAVING JURISDICTION.
4.

DOMESTIC WATER SYSTEM, WASTE, SOIL AND VENT SYSTEM SHALL ALL BE TESTED PER LOCAL AUTHORITY HAVING JURISDICTION. TEST AND OBTAIN APPROVAL ON ALL UNDERGROUND PIPING FROM ADMINISTRATIVE AUTHORITY HAVING JURISDICTION PRIOR TO COVERING WORK.
5.

ALL EXPOSED PIPING BELOW LAVATORY'S DESIGNATED AS HANDICAPPED SHALL BE TOTALLY INSULATED.
6.

ALL NON-DRAINAGE PIPING SHALL BE RUN LEVEL AND GENERALLY FREE OF TRAPS AND UNNECESSARY BENDS, ARRANGED TO CONFORM TO THE BUILDING REQUIREMENTS AND TO SUIT THE NECESSITIES OF CLEARANCES FOR OTHER MECHANICAL WORK. PROVIDE VALVED DRAINAGE OUTLETS IN AREAS OF PIPING WHICH WOULD BE UNDRAINABLE DURING MAINTENANCE OR REPAIRS.
7.

ALL EQUIPMENT, PIPING, ETC., SHALL BE SUPPORTED AS DETAILED AND/OR SPECIFIED. PROVIDE ADDITIONAL SUPPORTS AS REQUIRED TO PROVIDE A VIBRATION-FREE, RIGID INSTALLATION.
8.

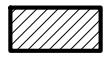

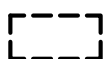






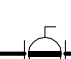
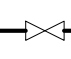
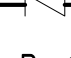


 
PENETRATIONS OF WALLS OR FLOORS FOR THE PASSAGE OF PIPING OR OTHER EQUIPMENT SHALL BE PROPERLY SEALED AFTER INSTALLATION OF ITEMS AND EQUIPMENT.
9.

PROVIDE UNIONS OR FLANGES AT PIPING CONNECTIONS TO EQUIPMENT TO ALLOW DISASSEMBLY FOR MAINTENANCE. ARRANGE PIPING TO ALLOW PULL SPACE FOR EQUIPMENT REMOVAL.
10.

PROVIDE ESCUTCHEONS FOR EXPOSED PIPING PENETRATIONS INTO FINISHED ROOMS.
11.

PIPING, LEAK PROTECTION APPARATUS, OR OTHER EQUIPMENT FOREIGN TO ELECTRICAL SWITCHBOARDS, PANELBOARDS, DISTRIBUTION BOARDS, OR MOTOR CONTROL CENTERS SHALL NOT BE INSTALLED WITHIN THE REQUIRED SPACE FOR WORKING CLEARANCES OR DEDICATED SPACES OF THE ELECTRICAL EQUIPMENT, EXTENDING IN FRONT OF AND FROM FLOOR TO STRUCTURAL CEILING WITH A WIDTH AND DEPTH OF THE ELECTRICAL EQUIPMENT IN ACCORDANCE WITH NEC-110.26.

PLUMBING LEGEND

SYMBOL	DESCRIPTION
	NEW EQUIPMENT
	EXISTING EQUIPMENT TO REMAIN
	EXISTING EQUIPMENT TO BE DEMOLISHED
	PIPING TO BE DEMOLISHED
	COLD WATER (CW)
	HOT WATER (HW)
	HOT WATER RETURN (HWR)
	SANITARY SEWER
	VENT
	BALL VALVE
	GATE VALVE
	CHECK VALVE
	PLUMBING FIXTURE DESIGNATION
	CONNECT TO EXISTING
	POINT OF DEMOLITION

As-Built  
CSUSA  
10/23/2023



CONSULTANTS




**MEP ENGINEER**  
INSIGHT ENGINEERING, PLLC  
201 S. CHESTER, SUITE B  
LITTLE ROCK, AR 72201



**FIRE PROTECTION**  
FP&C CONSULTANTS KC, LLC  
1330 Burlington Street, Ste. 200  
North Kansas City, MO 64116

ARCHITECT/ENGINEER OF RECORD

**A/E**  
**JohnsonDanforth & Associates**  
2200 N. RODNEY PARHAM ROAD  
SUITE 210  
LITTLE ROCK, AR 72212  
501-464-4811  
jda@johnsondanforth.com  
JDA PROJECT # D-19-11



STAMP



Office of  
Construction  
and Facilities  
Management



Drawing Title  
**PLUMBING GENERAL NOTES AND  
LEGEND**

Approved: Project Director

Phase  
**CONSTRUCTION  
DOCUMENTS**

FULLY SPRINKLERED

Project Title  
**RELOCATE MEDICAL MEDIA**

Location  
**VAMC LITTLE ROCK**

Issue Date  
2020.01.10

Checked  
KCK

Drawn  
CJC

Project Number  
**598-19-125**

Building Number  
**JLM**

Drawing Number  
**PL100**

MISSION CRITICAL  
CONSTRUCTION DOCUMENTS



