

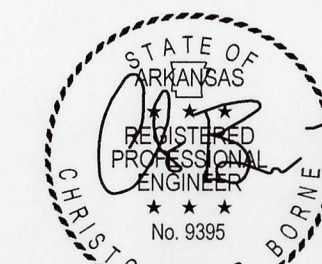
- 1 RELOCATE EXISTING AIR DEVICE. SEE M-101 FOR NEW LOCATION.
- 2 RELOCATE EXISTING VAV BOX. SEE M-101 FOR NEW LOCATION.
- 3 REMOVE EXISTING VAV BOX.
- 4 RELOCATE EXISTING THERMOSTAT.
- 5 REMOVE EXISTING THERMOSTAT.



CSUSA
As builds
1-24-24

Design Phase _____

**CONSTRUCTION
DOCUMENTS**

Stamp _____

Project Number **2020-171**
Issue Date **04-06-2023**
Sheet Title

Sheet Number _____

MD101