

Design Phase

Revisions:

Stamp

04-06-2023

- Project Number _____


Issue Date _____

Sheet Title _____

Sheet Number _____

KEYED NOTES

- 1 CONNECT TO EXISTING HWS/HWR PIPING LOOP.
ALL RUNOUTS TO BE 3/4" UNLESS OTHERWISE
NOTED ON PLANS.
- 2 NEW LOCATION OF EXISTING THERMOSTAT.
- 3 NEW LOCATION OF EXISTING VAV BOX.

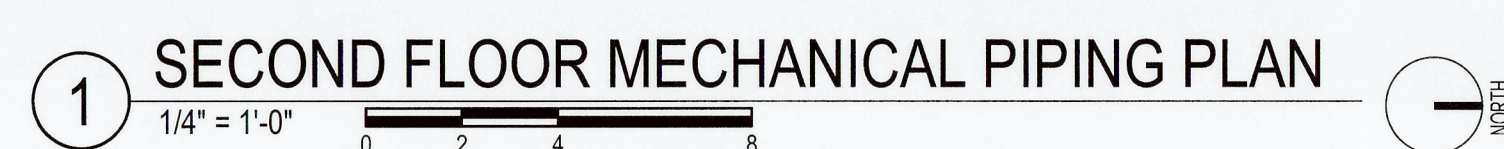

CSUSA
As Bu. 10,
1-24-24