


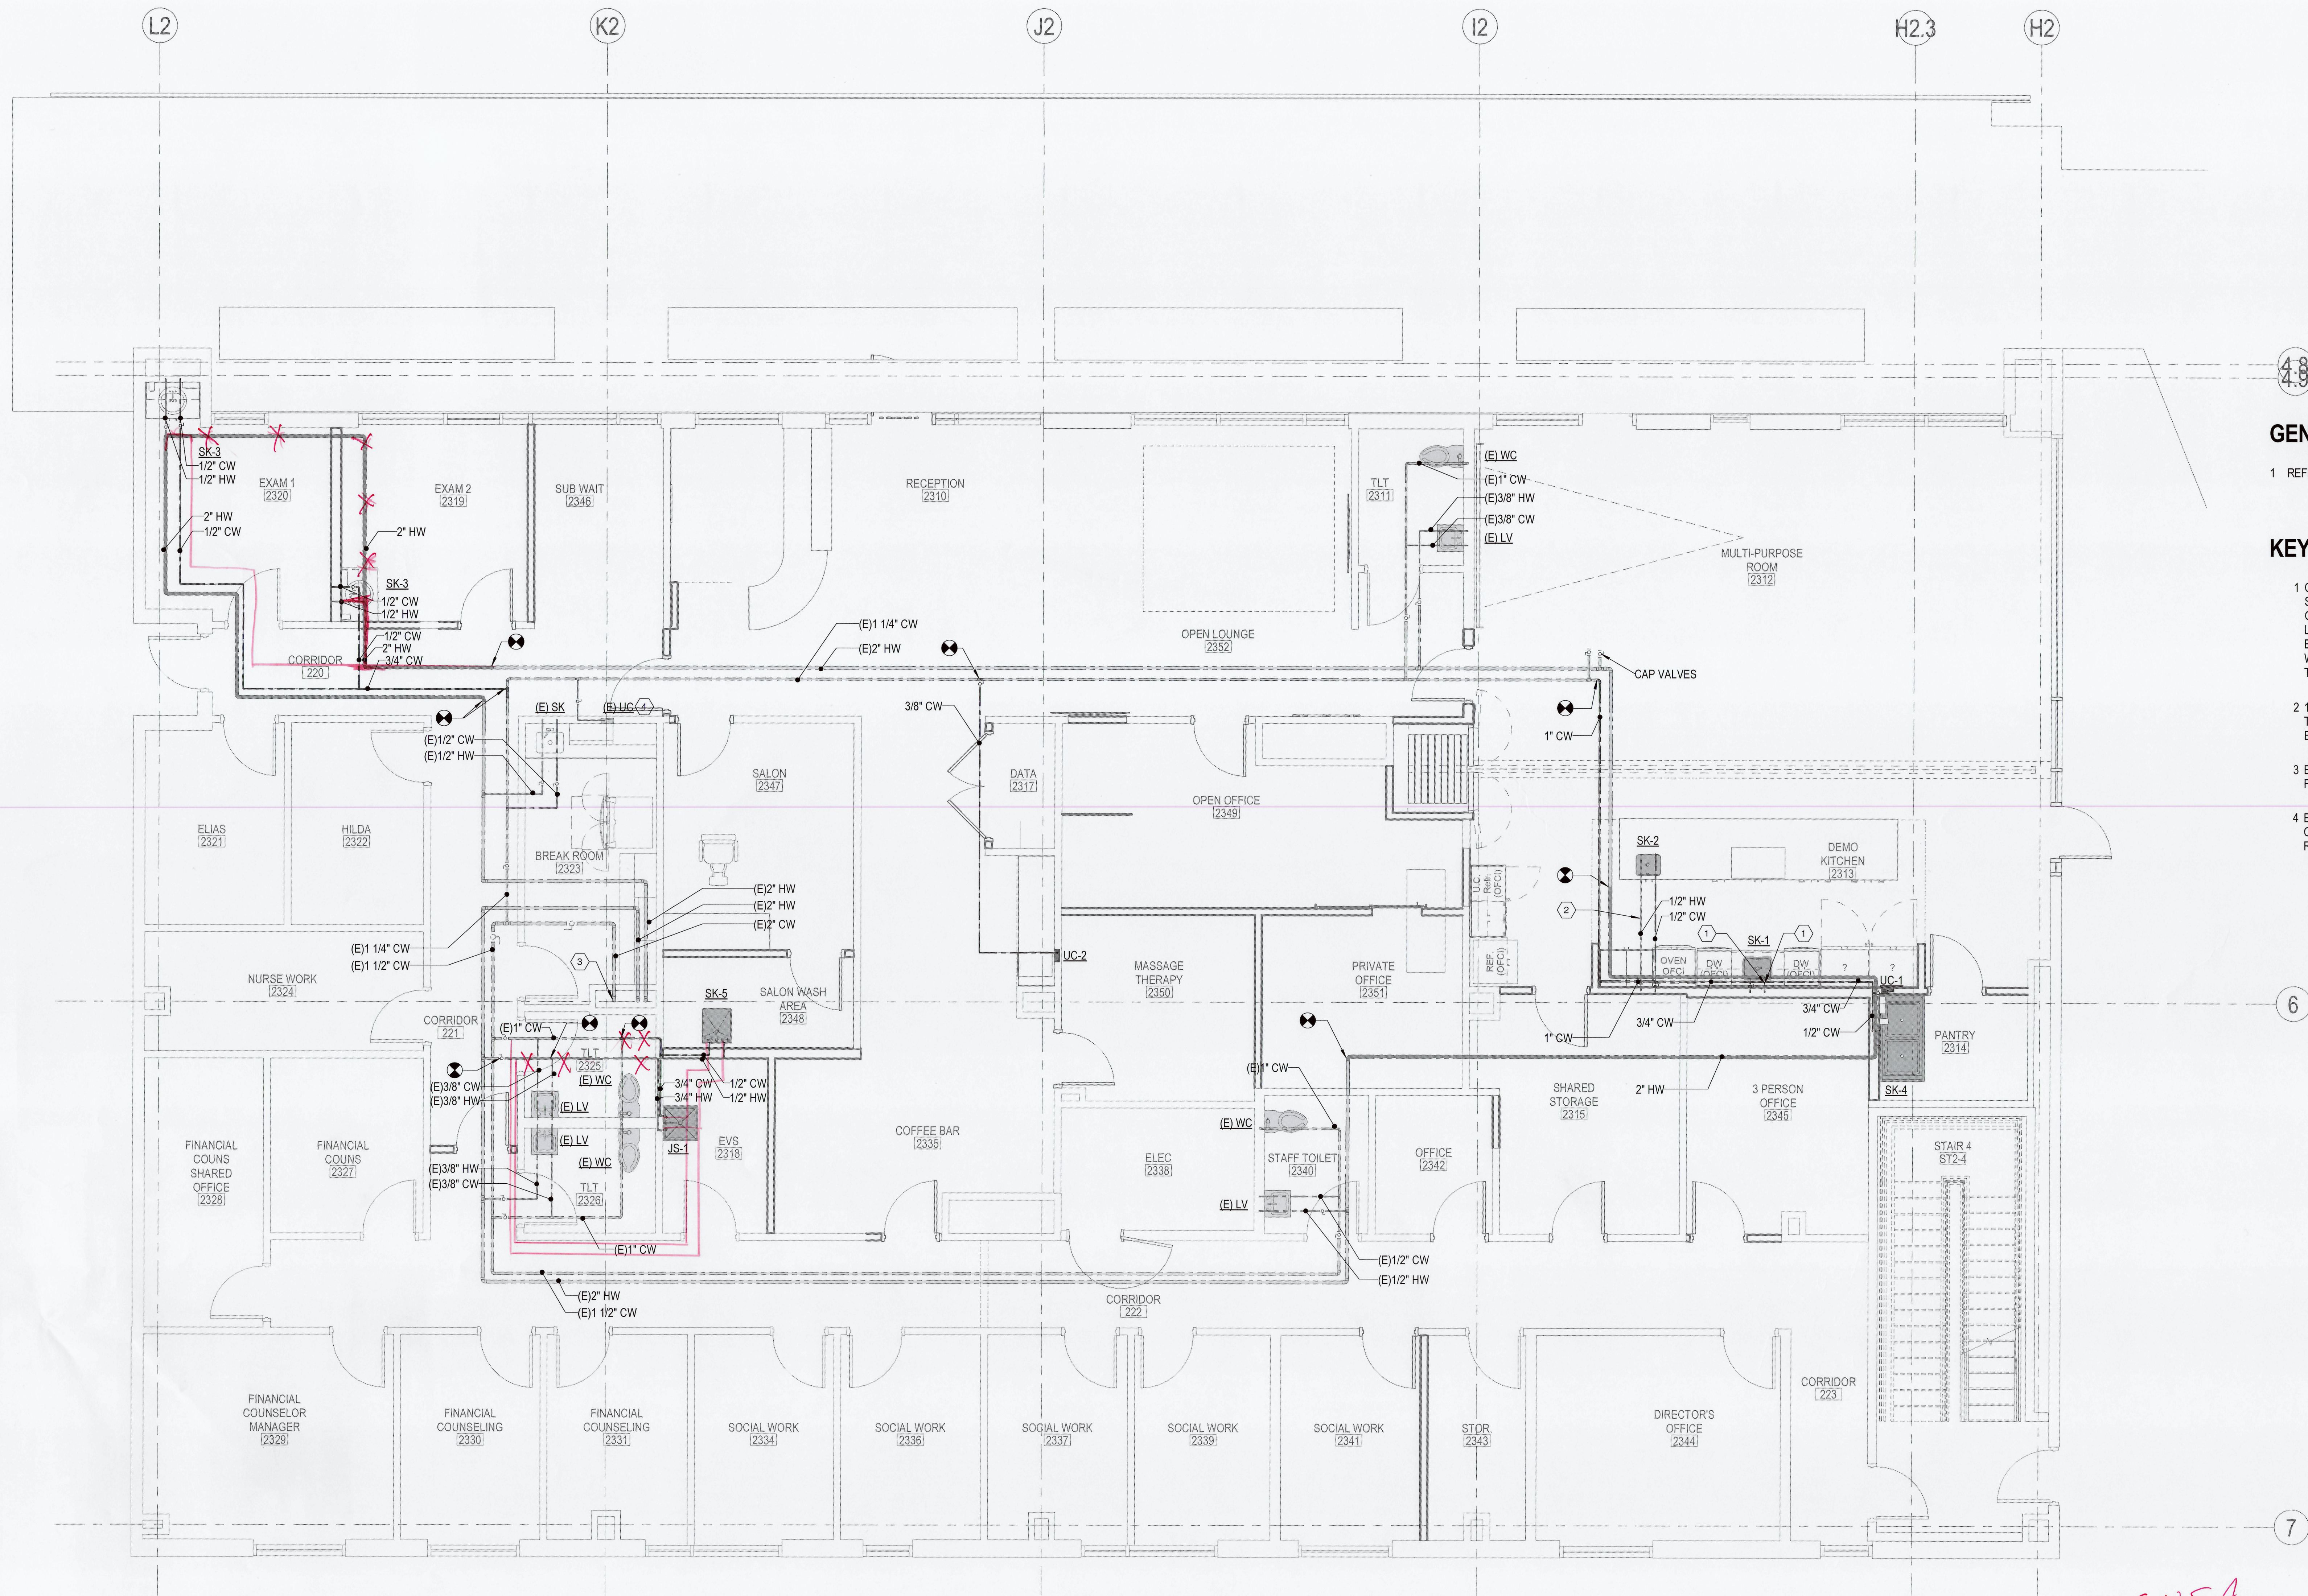

4.8

GENERAL NOTES

- 1 REFER TO SHEET P-001 FOR LEGEND AND NOTES.

KEYED NOTES

- 1 CONNECT NEW 3/8\"/>
- 2 1/2\"/>
- 3 EXISTING CW/HW PIPING ROUTED BELOW FLOOR AT APPROXIMATELY THIS LOCATION.
- 4 EXISTING 3/8\"/>

6

7


1 SECOND FLOOR DOMESTIC WATER PLAN
1/4\"/>

CS USA
As Buid's
1-24-24

CARTI CANCER CENTER-BRIDGE PATIENT RESOURCE CENTER

CONSTRUCTION DOCUMENTS

Revisions	No.	Date	Description

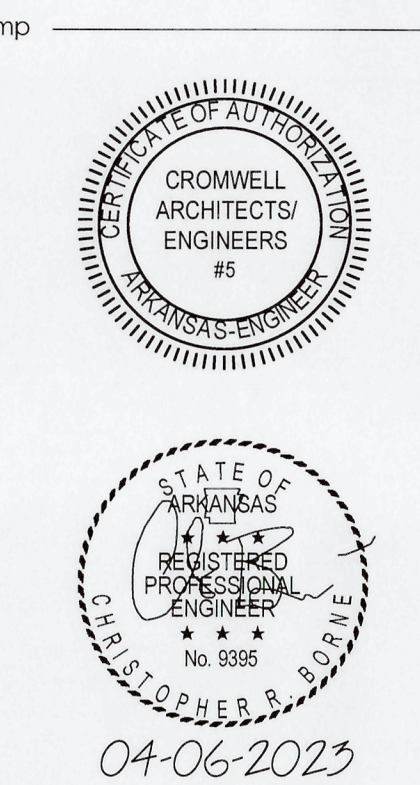

Notes
1. CROMWELL ARCHITECTS ENGINEERS, INC.
ALL RIGHTS RESERVED
2. THIS SHEET DESIGNED FOR COLOR PRINTING.
CRITICAL INFORMATION MAY BE LOST WITH
BLACK AND WHITE PRINTING.
Project Number 2020-171
Issue Date 04-06-2023
Sheet Title

SECOND FLOOR DOMESTIC WATER PLAN

Sheet Number

P-101