


**7 TYPICAL CLEANOUTS**  
NOT TO SCALE

*C S USA  
As Builts  
1-24-24*

**CARTI CANCER CENTER-BRIDGE  
PATIENT RESOURCE CENTER**

**CONSTRUCTION  
DOCUMENTS**

Revisions		
No.	Date	Description

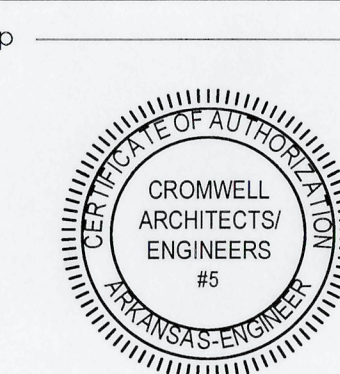

Notes  
04-06-2023

1. CROMWELL ARCHITECTS ENGINEERS, INC. ALL RIGHTS RESERVED  
2. THIS SHEET DESIGNED FOR COLOR PRINTING. CRITICAL INFORMATION MAY BE LOST WITH BLACK AND WHITE PRINTING.

Project Number 2020-171

Issue Date 04-06-2023

Sheet Title

**PLUMBING DETAILS**

Sheet Number

**P-501**