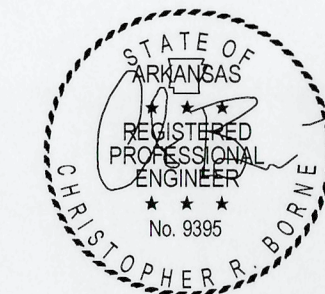


Design Phase

Revisions

Stamp

04-06-2023

- Project Number _____

Issue Date: 2020-11-11

Issue Date 04-06-2023

Sheet Title _____

Sheet Number

P-601

WATER HAMMER ARRESTOR					
P.D.I. UNITS	A	B	C	D	F
FIXTURE UNITS	1-11	12-32	33-60	61-113	114-154
WADE "SHOCKSTOP" #4481 SERIES WATER HAMMER ARRESTORS. SEAMLESS COPPER CONSTRUCTION, POLYPROPYLENE PISTON, (2) EPDM ORINGS, MNPT CONNECTION, MAX. PRESS. 350 PSI, MAX. TEMP. 250°F, PROVIDE PROPERLY SIZED WATER HAMMER ARRESTORS AND LOCATE ON PIPING IMMEDIATELY UPSTREAM OF ALL QUICK CLOSING VALVES (E.G. FLUSH VALVES, DISHWASHER, ICE MAKERS, SOLENOID VALVES, ETC.)					

CSUSA
As builds
1-24-24