

## Design Phase

### Revisions

Stamp

## Notes


- Project Number

Issue Date: 2020-17

04-06-2023

Sheet Number

1 DOMESTIC WATER RISER  
NOT TO SCALE

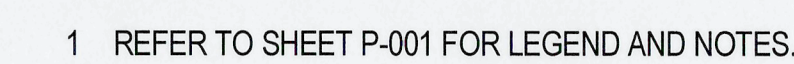

- 1 EXISTING SS/V PIPING ROUTED BELOW FLOOR AT APPROXIMATELY THIS LOCATION.
- 2 EXISTING CW/HW PIPING ROUTED BELOW FLOOR AT APPROXIMATELY THIS LOCATION.

