

CARTI CANCER CENTER-BRIDGE
PATIENT RESOURCE CENTER

GENERAL NOTES

- 1 REFER TO SHEET P-001 FOR LEGEND AND NOTES.

KEYED NOTES

- 1 REMOVE EXISTING SS AND VENT PIPING AS SHOWN AND CAP AT APPROXIMATELY THIS LOCATION. VERIFY SIZE AND LOCATION OF EXISTING PIPING BEFORE DEMOLITION.
- 2 REMOVE EXISTING PLUMBING FIXTURE AND ALL ASSOCIATED PIPING BACK TO POINT INDICATED.
- 3 REMOVE EXISTING HW PIPING AS SHOWN AND CAP AT APPROXIMATELY THIS LOCATION. VERIFY SIZE AND LOCATION OF EXISTING PIPING BEFORE DEMOLITION.

Design Phase



CONSTRUCTION
DOCUMENTS

Revisor

No.	Date	Description
-----	------	-------------

[illegible]

Stamp

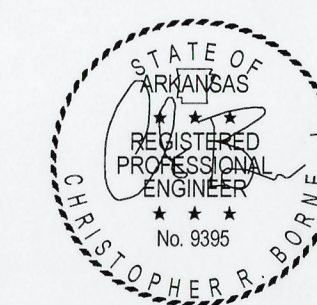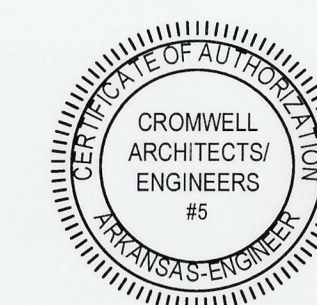

Notes

1. CROMWELL ARCHITECTS ENGINEERS, INC.
ALL RIGHTS RESERVED
2. THIS SHEET DESIGNED FOR COLOR PRINTING.
CRITICAL INFORMATION MAY BE LOST WITH
BLACK AND WHITE PRINTING.

Project Number

2020-171

Issue Date

04-06-2023

Sheet Title

SECOND FLOOR PLUMBING DEMO PLAN

Sheet Number

PD101

1 SECOND FLOOR PLUMBING DEMO PLAN

CSUS
As bu. id.
1-24-24