

0

В

0

A


0 E

0

D

F

0

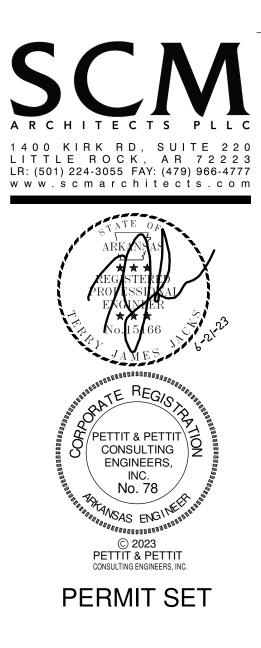

**O** 1

• 2

CLUB TRY COUN K PLEASANT 01 RENOVATION /ALLEY DRIVE ARKANSAS 72 Ш S AND  $\mathbf{O}$ SANT V ROCK ITION m

REVISIONS

≤ш

Ш

<

**РКОЈЕСТ NO**. 21075 DATE: June 21, 2023

