

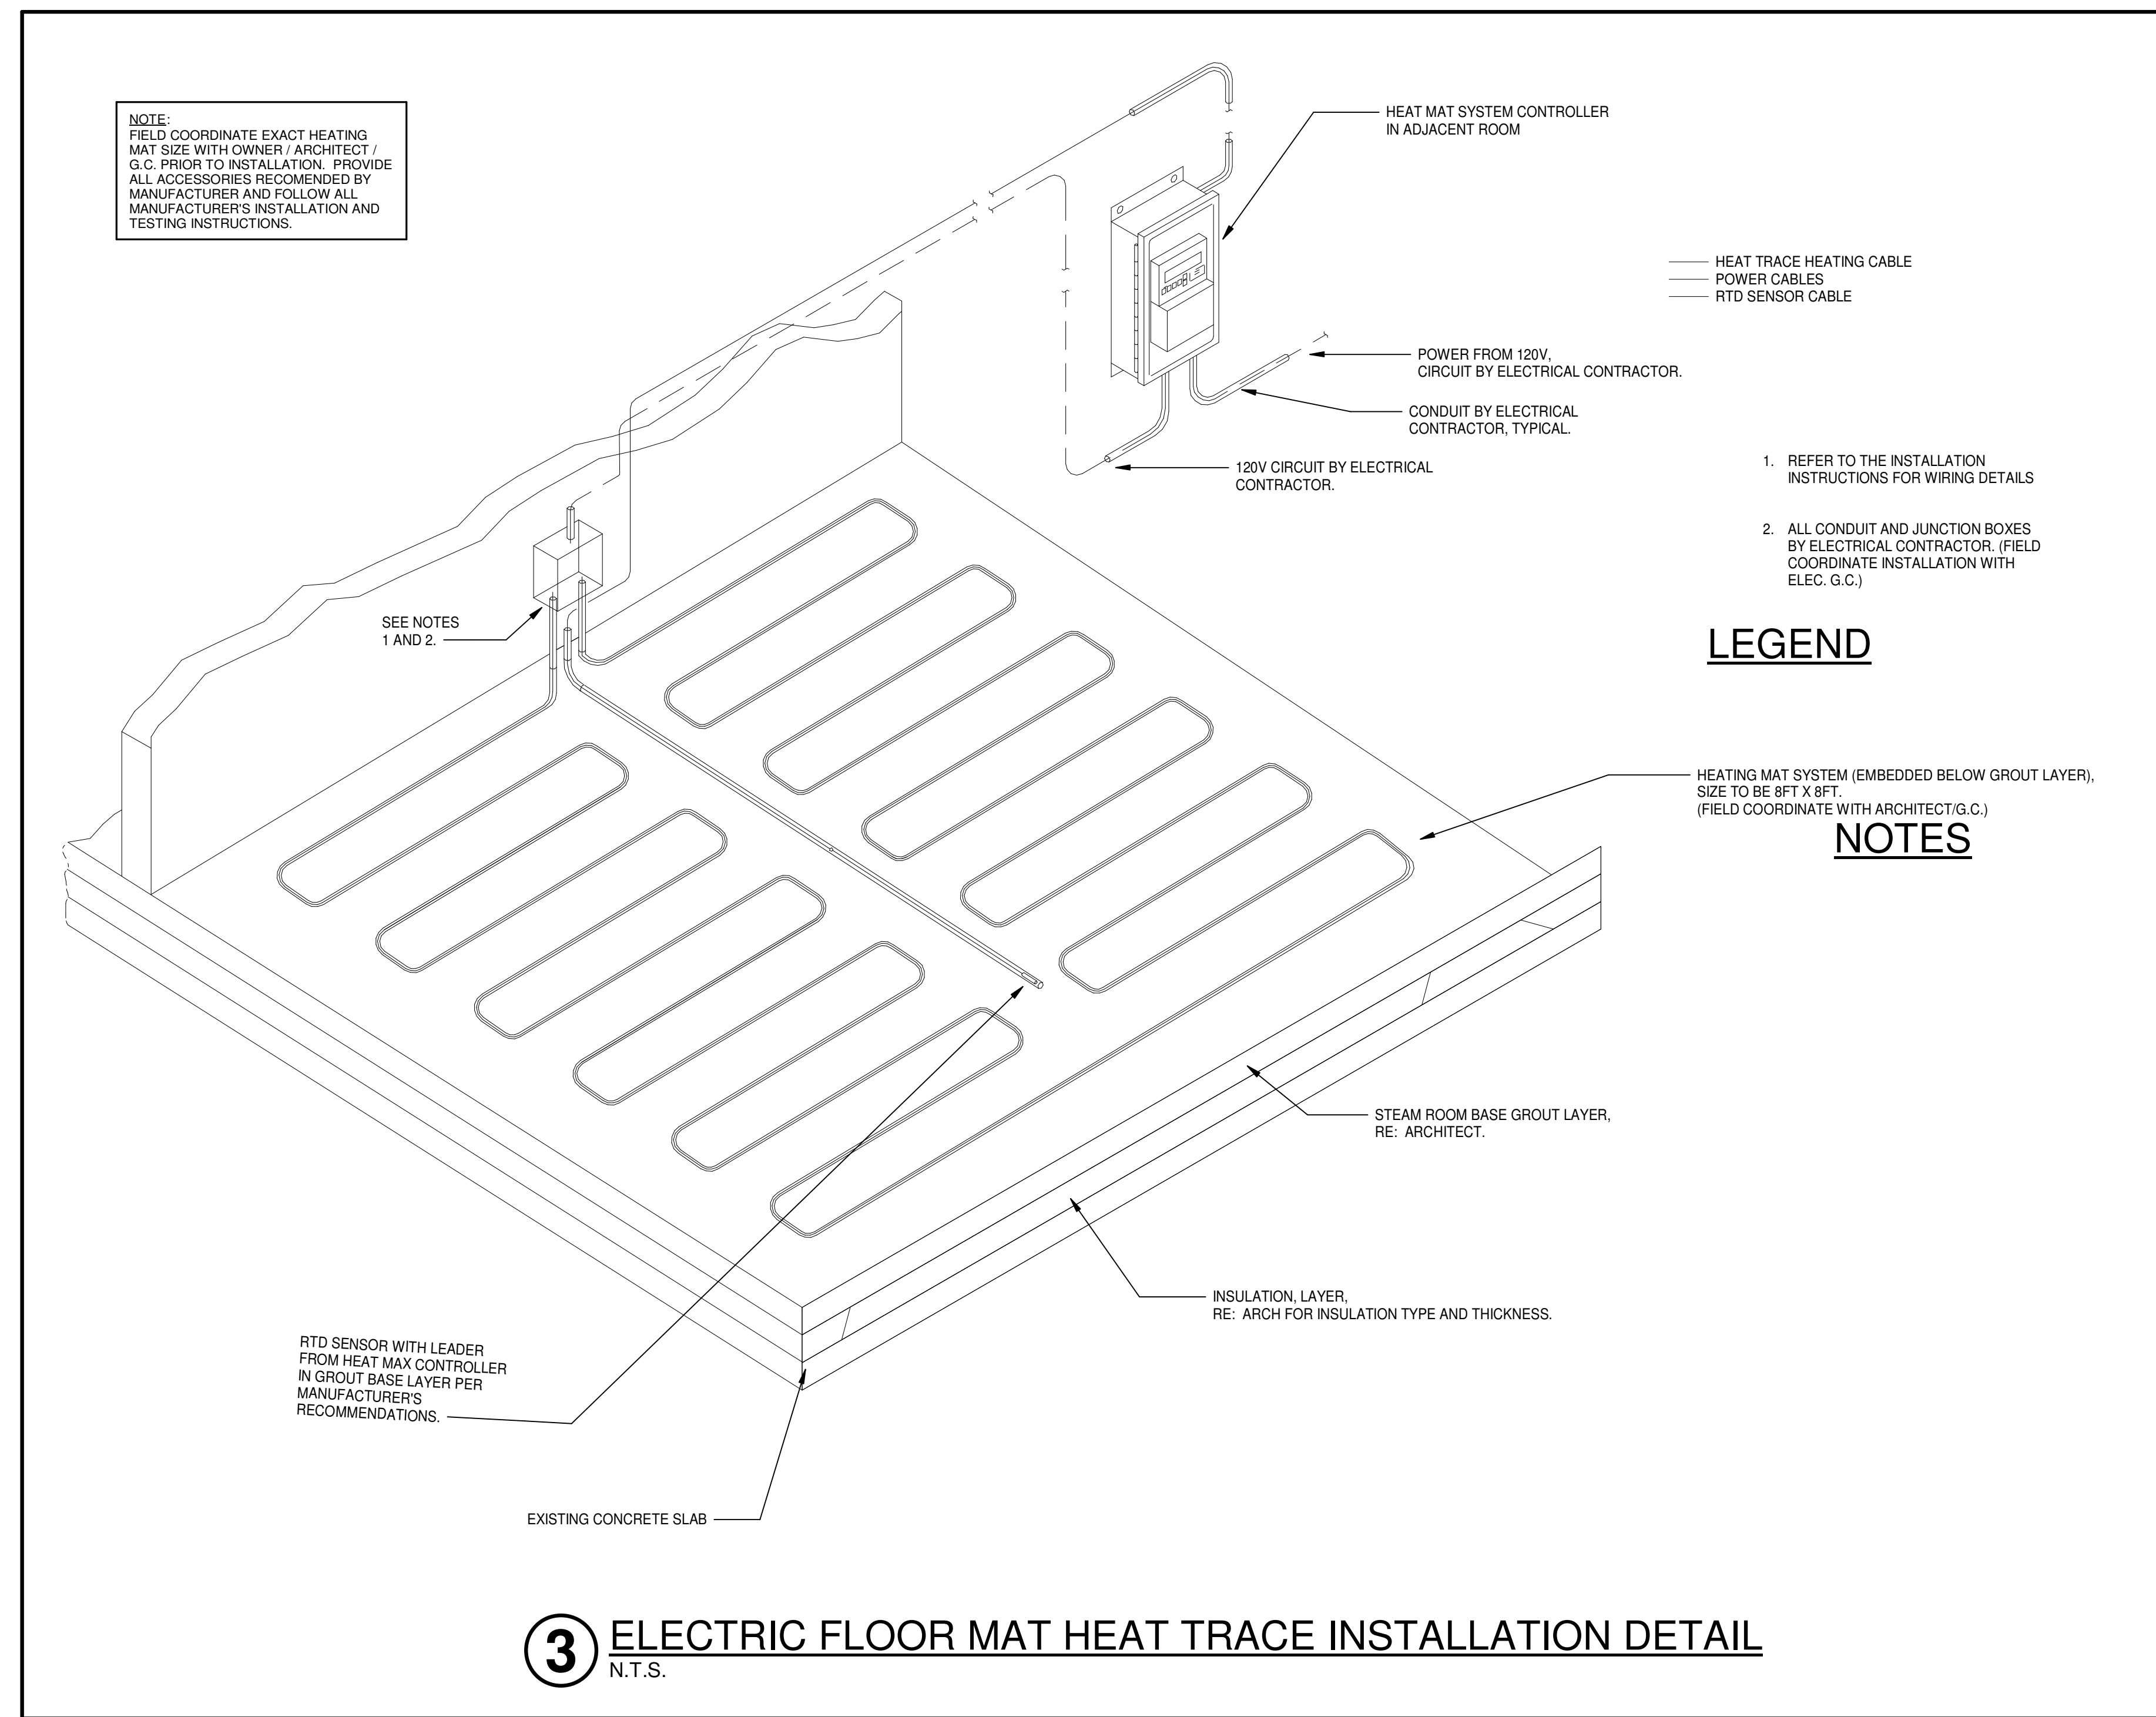
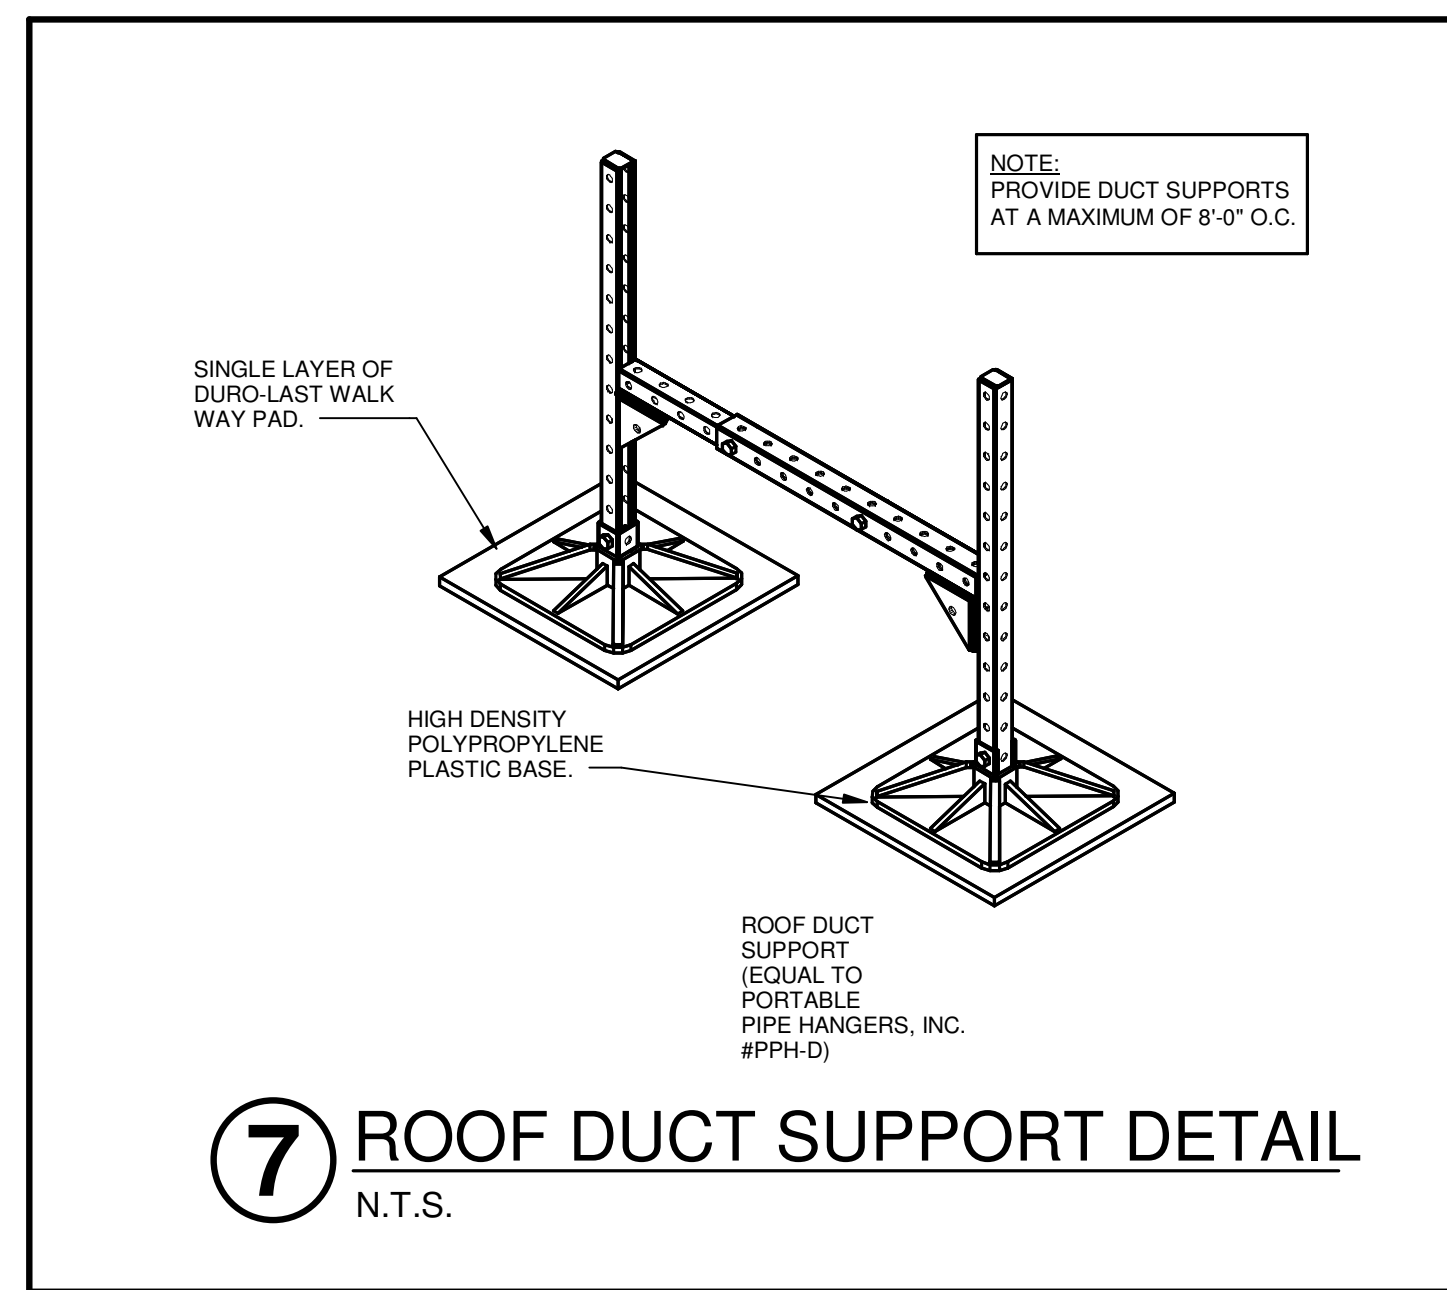
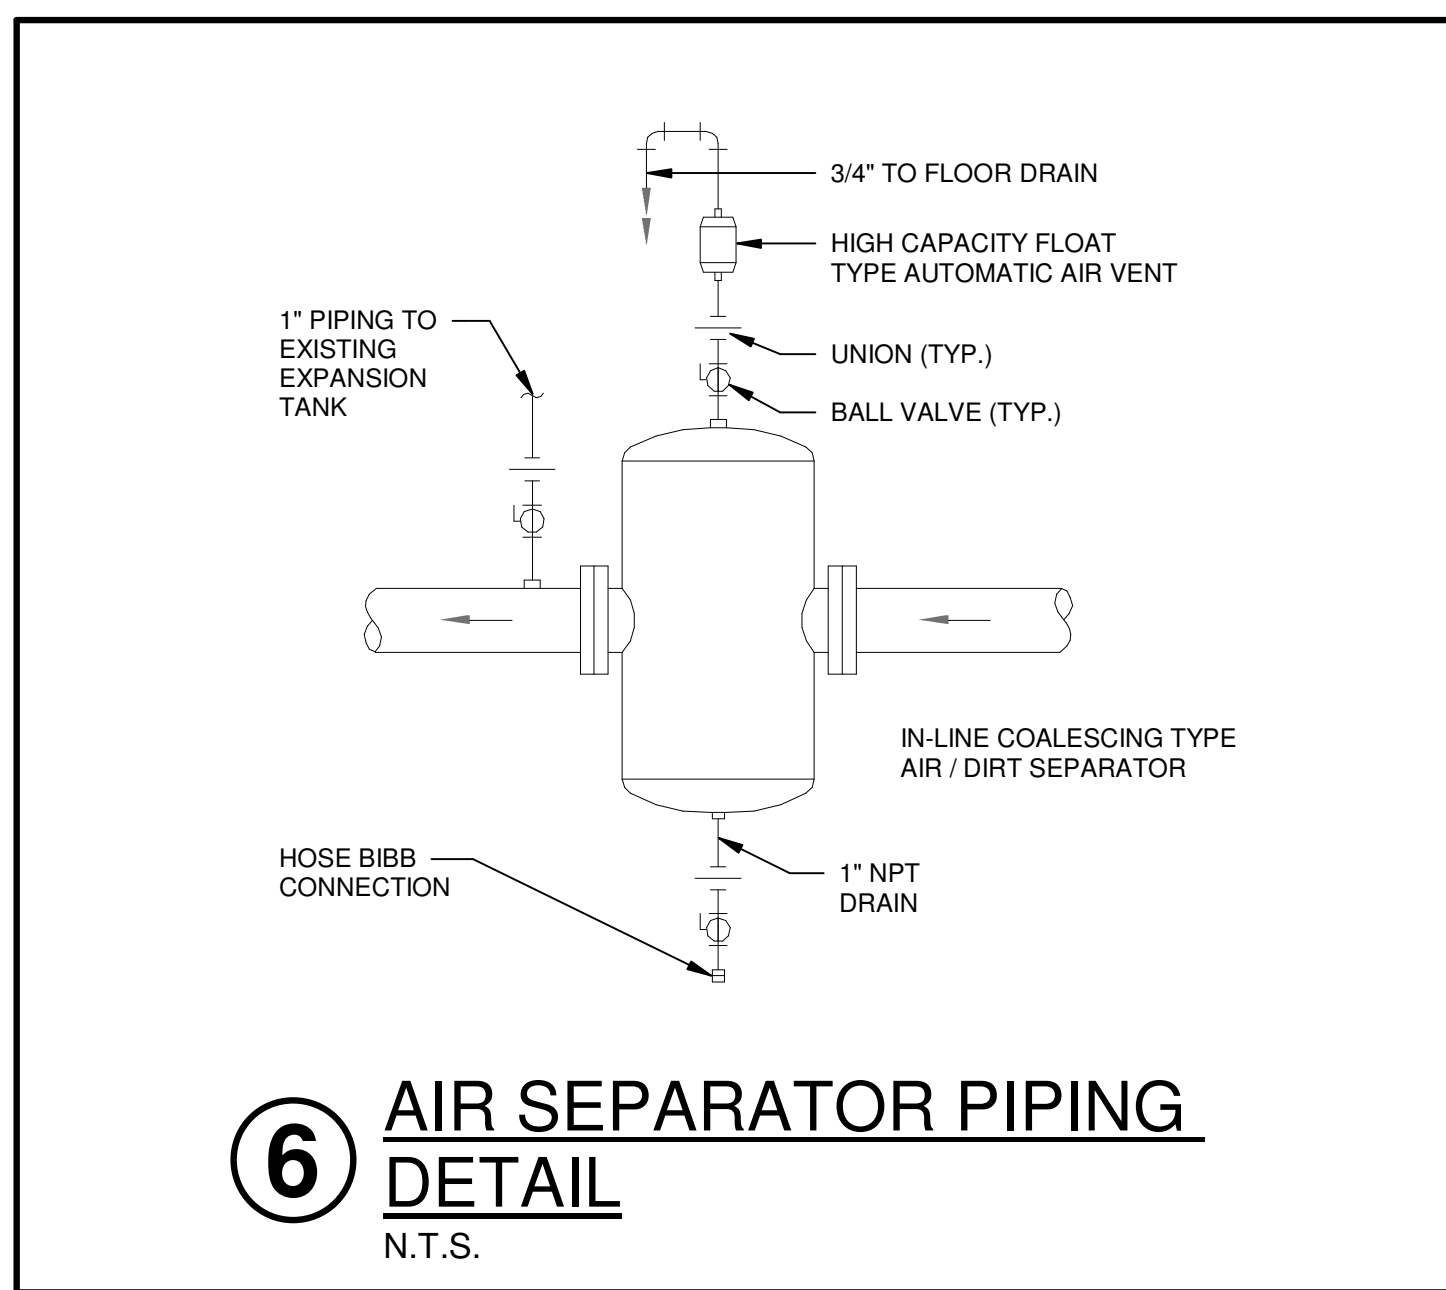
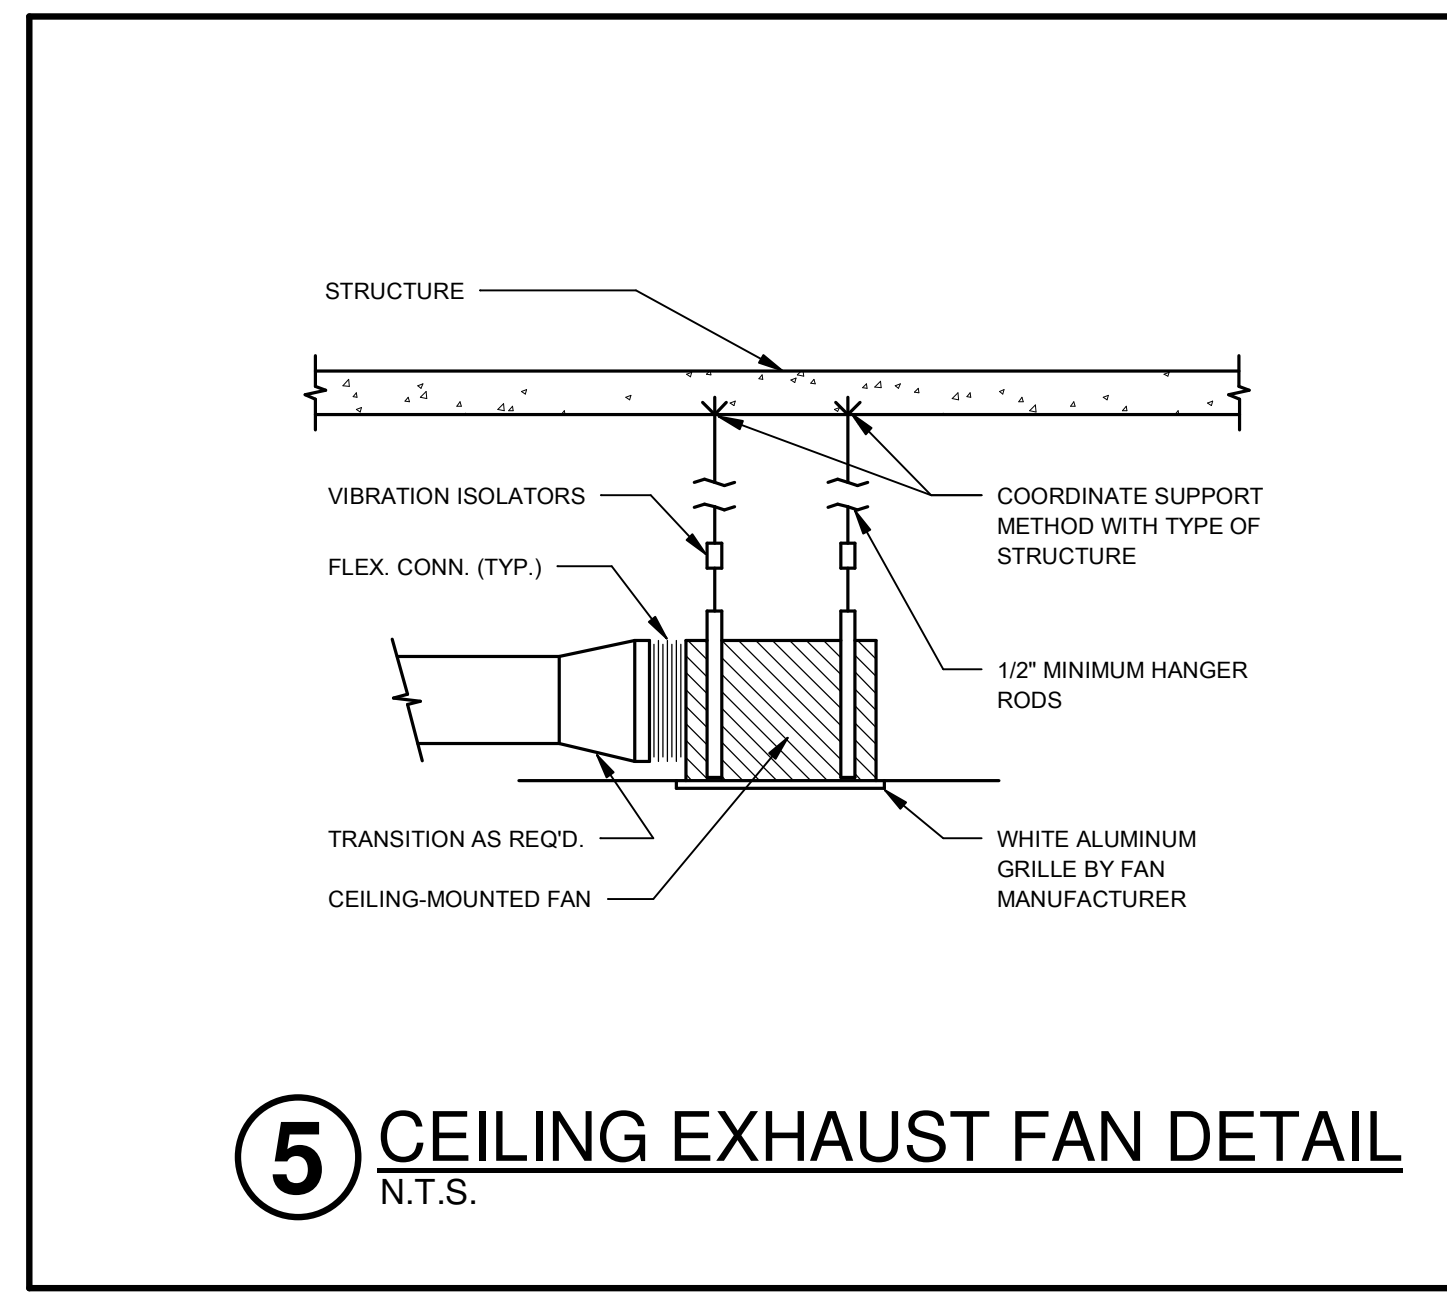
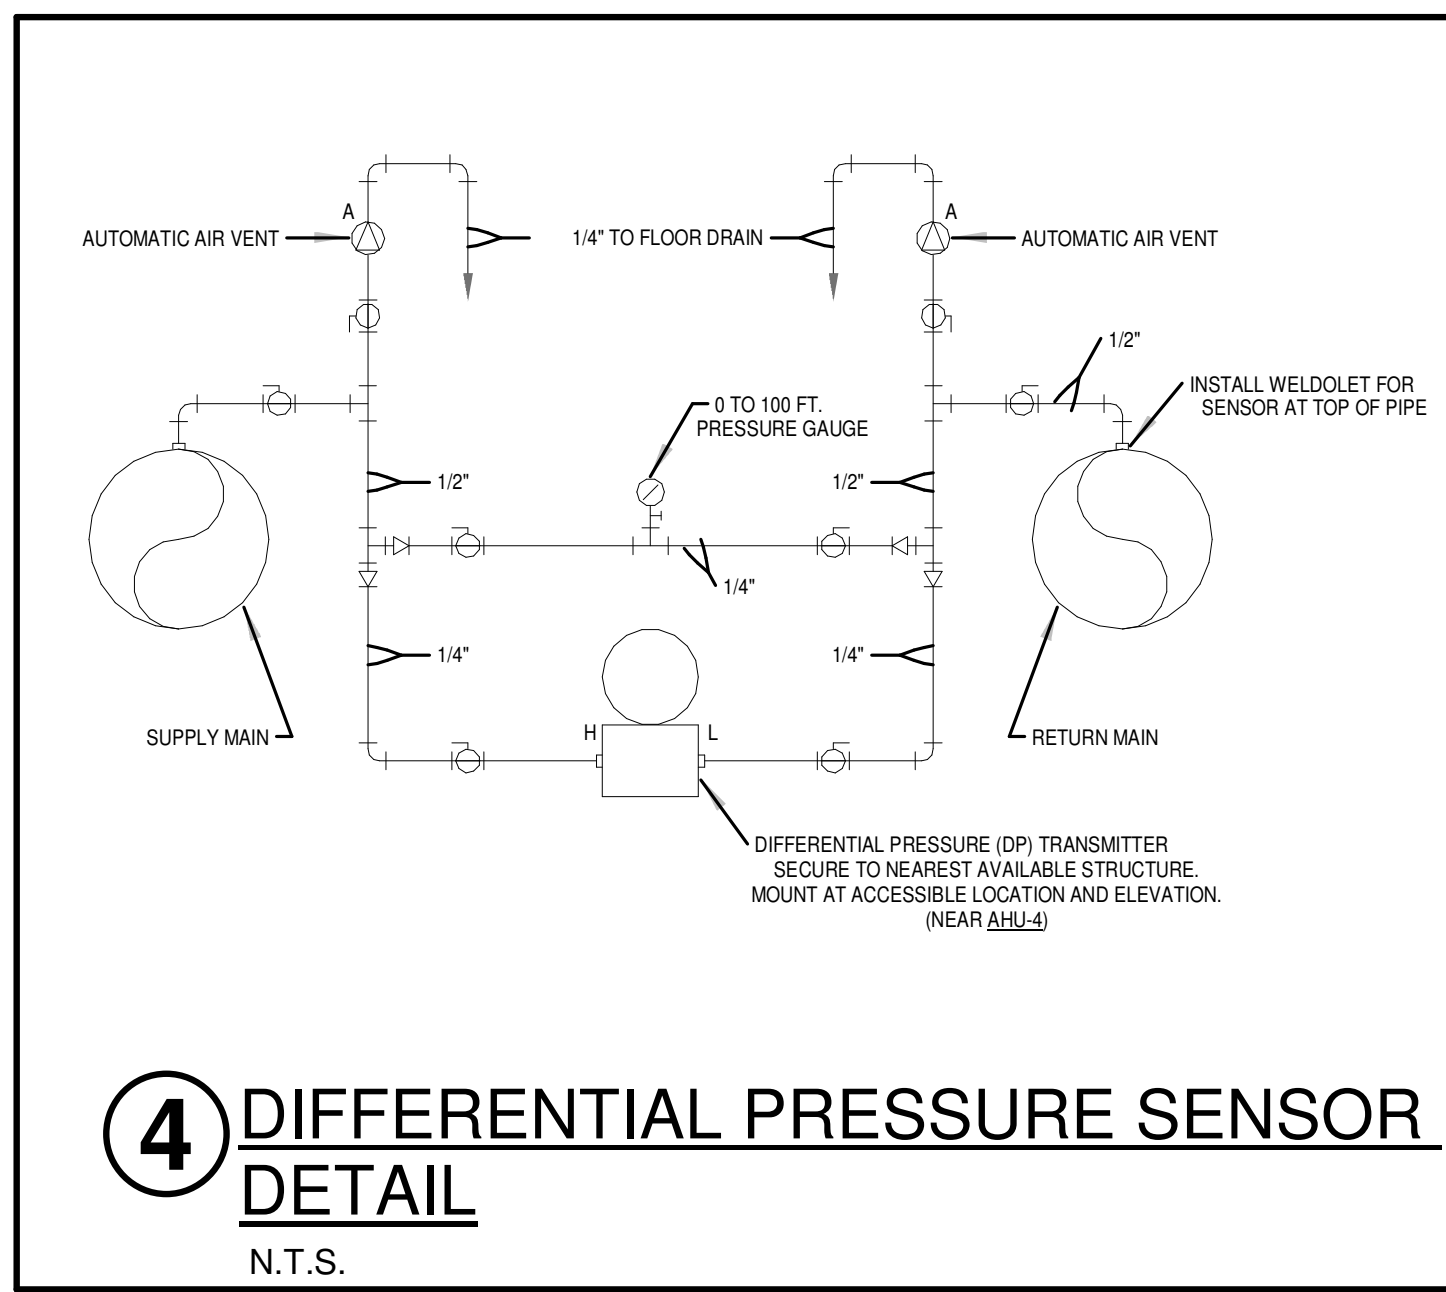


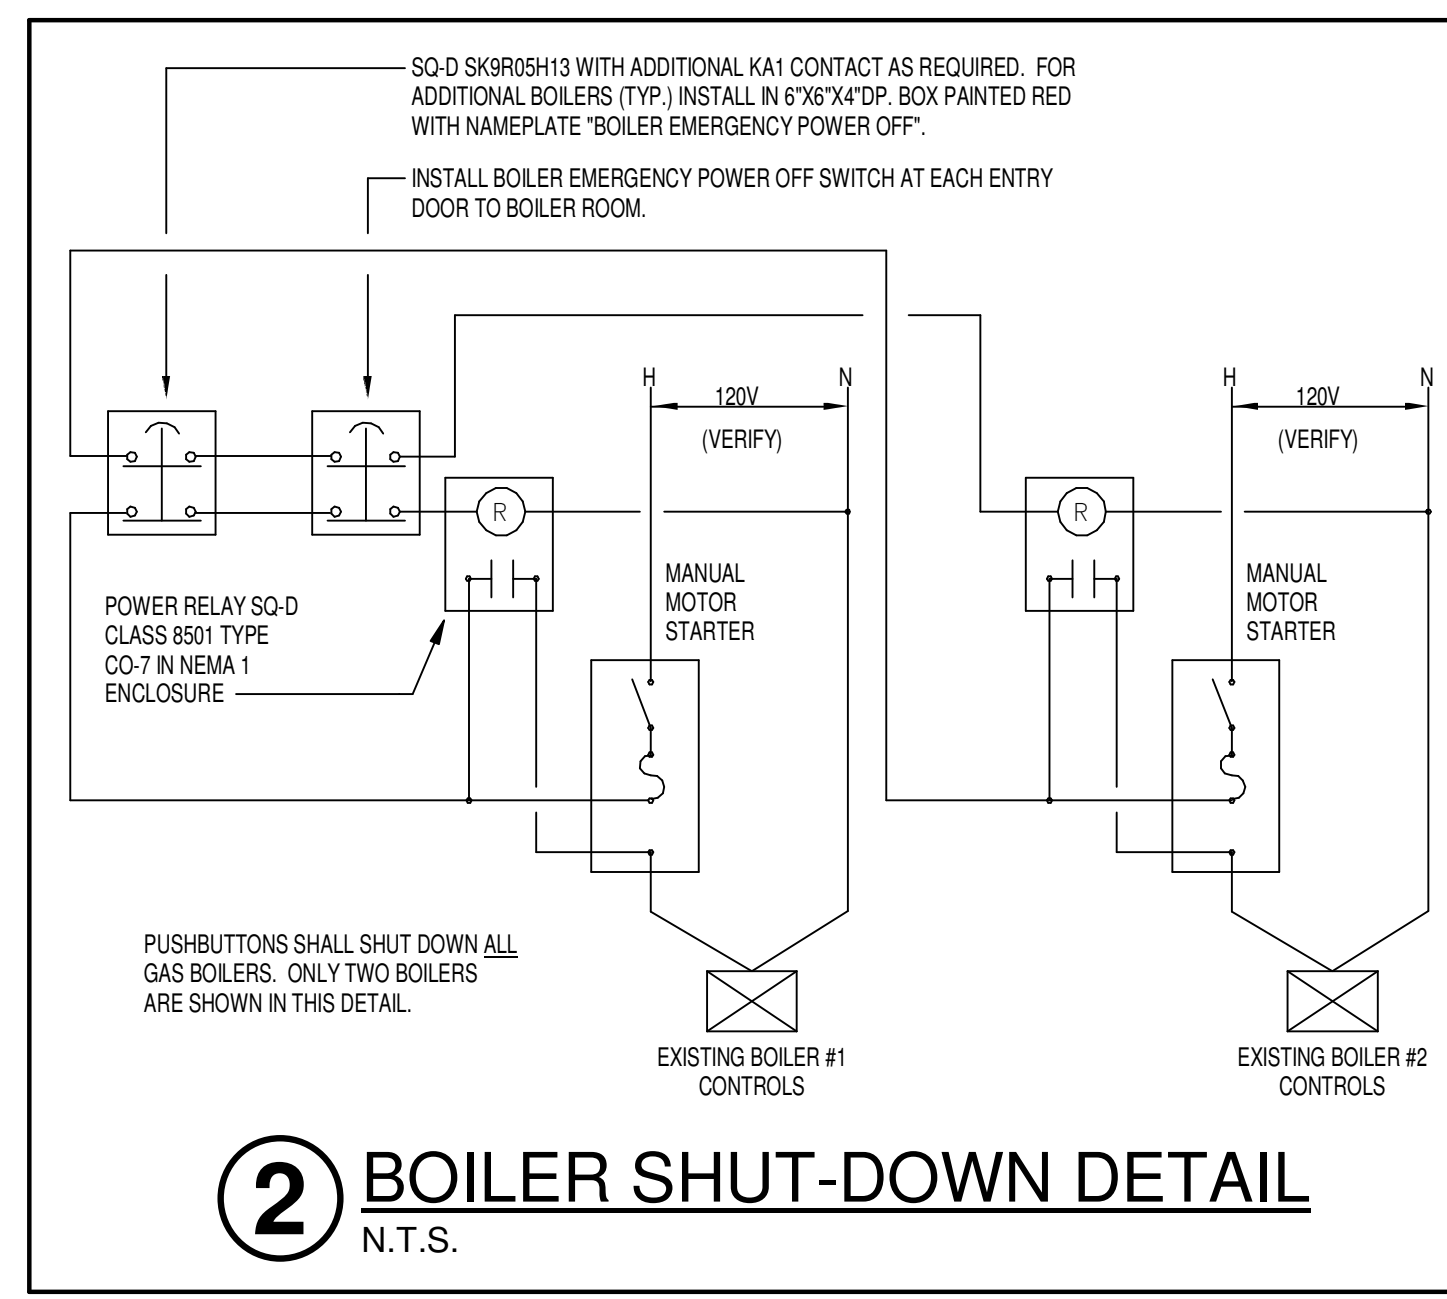

PETTIT & PETTIT  
CONSULTING ENGINEERS, INC.  
PERMIT SET

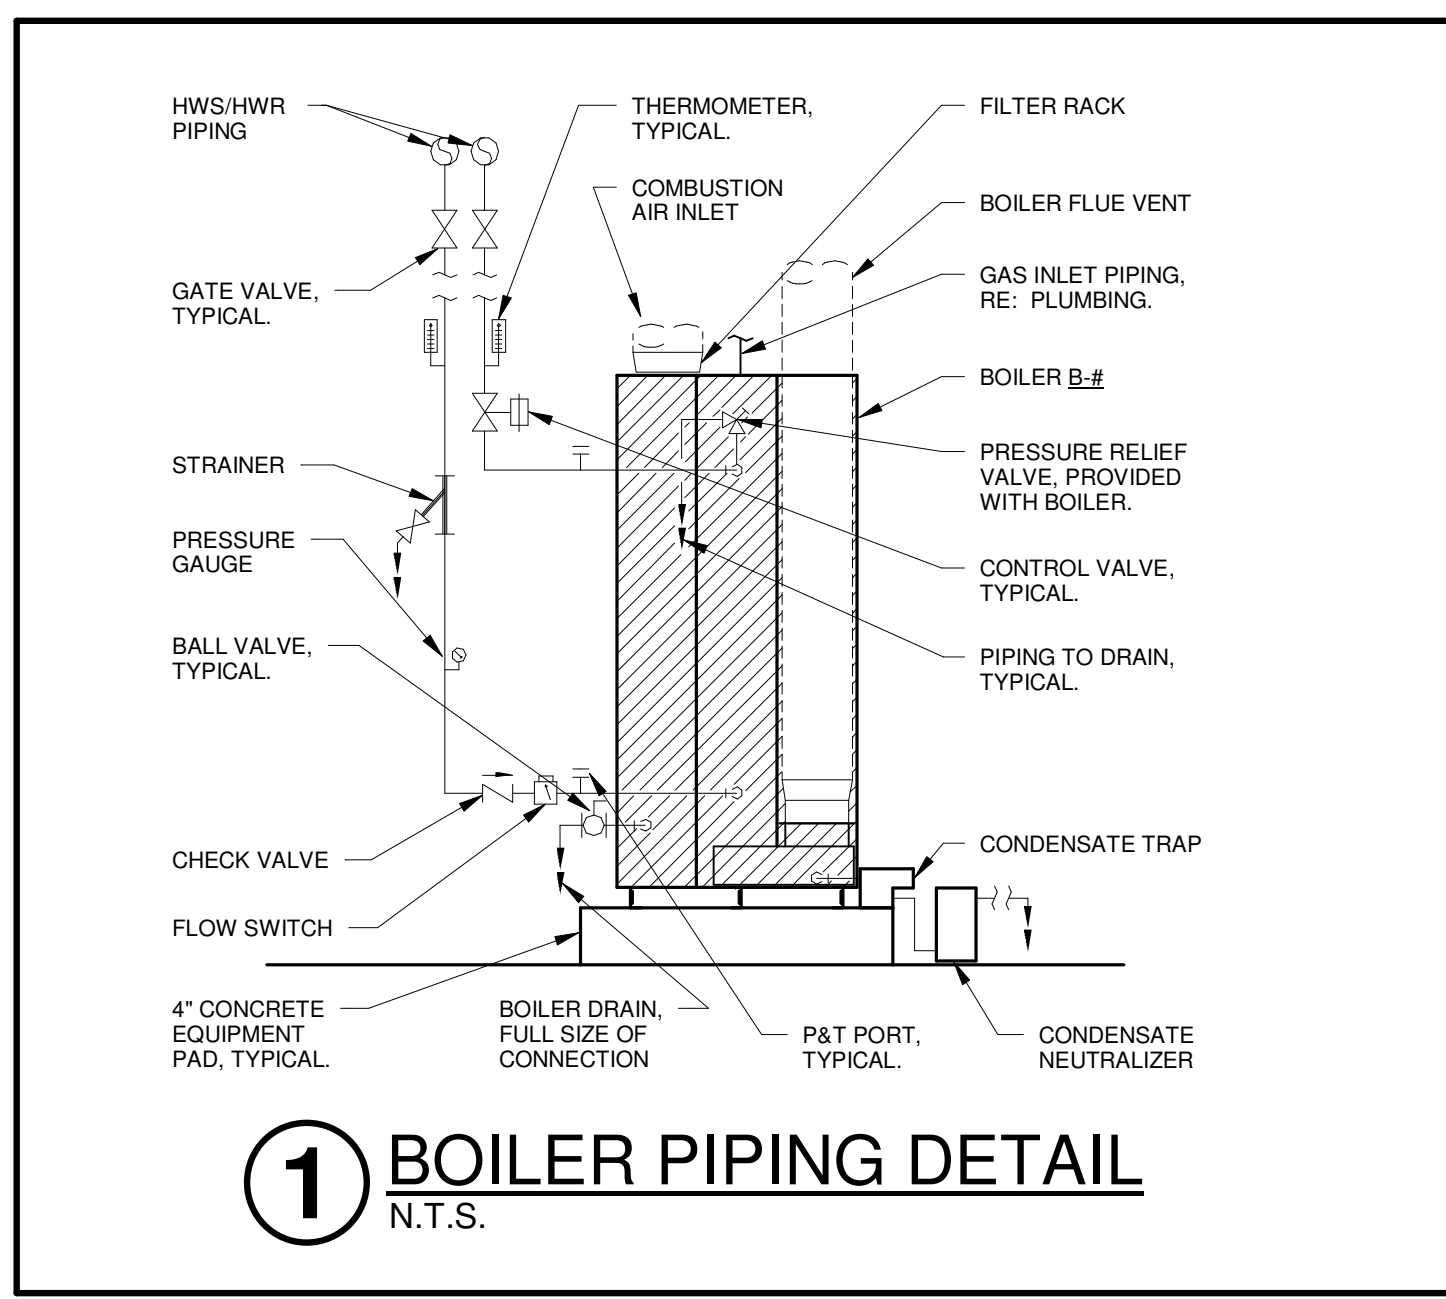

ADDITION AND RENOVATION TO PLEASANT VALLEY COUNTRY CLUB

**CLUBHOUSE**  
1 PLEASANT VALLEY DRIVE  
LITTLE ROCK, ARKANSAS 72212

REVISIONS

PROJECT NO. 21075  
DATE: June 21, 2023

HVAC DETAILS  
**M3.03-A**