

PERMIT SET

ADDITION AND RENOVATION TO PLEASANT VALLEY COUNTRY CLUBHOUSE
1 PLEASANT VALLEY DRIVE
LITTLE ROCK, ARKANSAS 72212

REVISIONS

PROJECT NO. 21075
DATE: June 21, 2023


KITCHEN DETAILS

M6.06-A

PROJECT 11/22/2022
 MARK
 PLEASANT VALLEY COUNTRY CLUB HOOD CONTROLS
 AIRTECH CORPORATION
 91 FORREST MOSELEY
 FORREST@AIRTECHCORP.COM 501280-0404
 GREENHECK

CONTROL INFORMATION		ELECTRICAL CONTROL PACKAGE		USER INTERFACE		FANS CONTROLLED										
MARK	MODEL	LOCATION	TYPE	LOCATION	FAN #	TYPE	FAN	FAN MARK	ZONE	CFM	MOTOR HP	MOTOR VOLT	CYCLE	MOTOR PHASE	MOTOR STARTER IN PANEL	VFD IN PANEL
CONTROLS	GKC-DCV-S-11-3-1-0	WALL CABINET ON KH-2	FULL COLOR TOUCHSCREEN	WALL CABINET - WALL CABINET ON KH-2	1	SUPPLY	S1	MAU -J2	1	8048	10	460	60	3	NO	NO
					2	EXHAUST	E1	KEF -1	1	10060	7.5	460	60	3	NO	YES

CONTROL FEATURES
 HOOD LIGHT CONTROL
 TEMP SENSORS (FACTORY INSTALLED) - QTY. 3
 DRY FIRE CONTACTS - QTY. 1
 LIGHTS OFF DURING FIRE
 EXHAUST MAX DURING FIRE
 SUPPLY OFF DURING FIRE

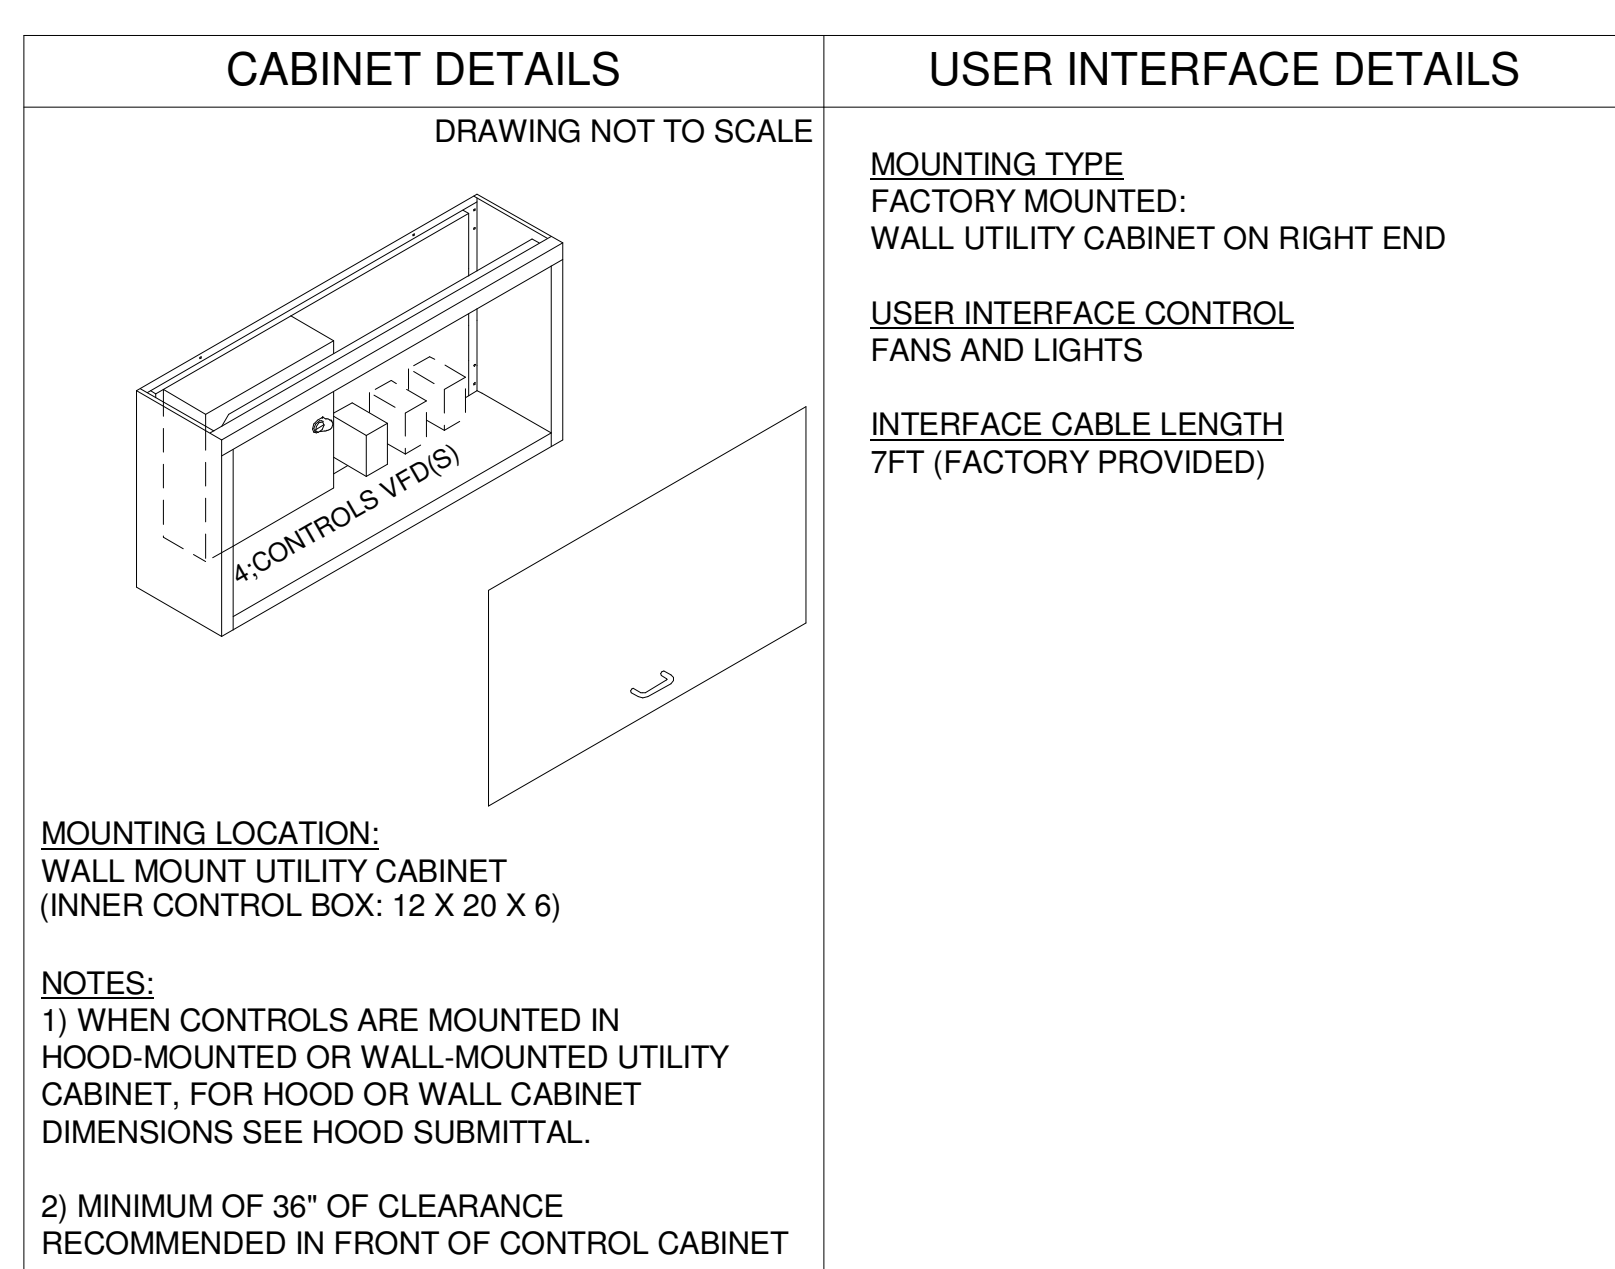


MOUNTING LOCATION:
 WALL MOUNT UTILITY CABINET (INNER CONTROL BOX: 12 X 20 X 6)
 DIMENSIONS SEE HOOD SUBMITTAL.
 NOTES:
 1) WHEN CONTROLS ARE MOUNTED IN HOOD-MOUNTED OR WALL-MOUNTED UTILITY CABINET, FOR HOOD OR WALL CABINET DIMENSIONS SEE HOOD SUBMITTAL.
 2) MINIMUM OF 36" OF CLEARANCE RECOMMENDED IN FRONT OF CONTROL CABINET


ZONE #	ZONE	ROOM TEMP
1	Z1	PRESET

HOOD #	HOOD	HOOD MARK	ZONE	EXHAUST	SUPPLY	MB TEMP SENSORS	HCB
1	H1	KH-1 SECTION 1	Z1	E1	S1	TS1	NO
2	H2	KH-1 SECTION 2	Z1	E1	S1	TS2	NO
3	H3	KH-2 SECTION 1	Z1	E1	S1	TS3	NO




FAN #	TYPE	FAN	FAN MARK	ZONE	MIN CFM	MAX CFM	MODBUS VFD	VFD ADDRESS	MIN FREQ.	MAX FREQ.	MIN VDC	MAX VDC
1	SUPPLY	S1	KMAU	Z1	4024	8048	NO	-	-	-	0.0	10.0
2	EXHAUST	E1	KEF-1-1	Z1	5000	10060	YES	2	30	60	-	-

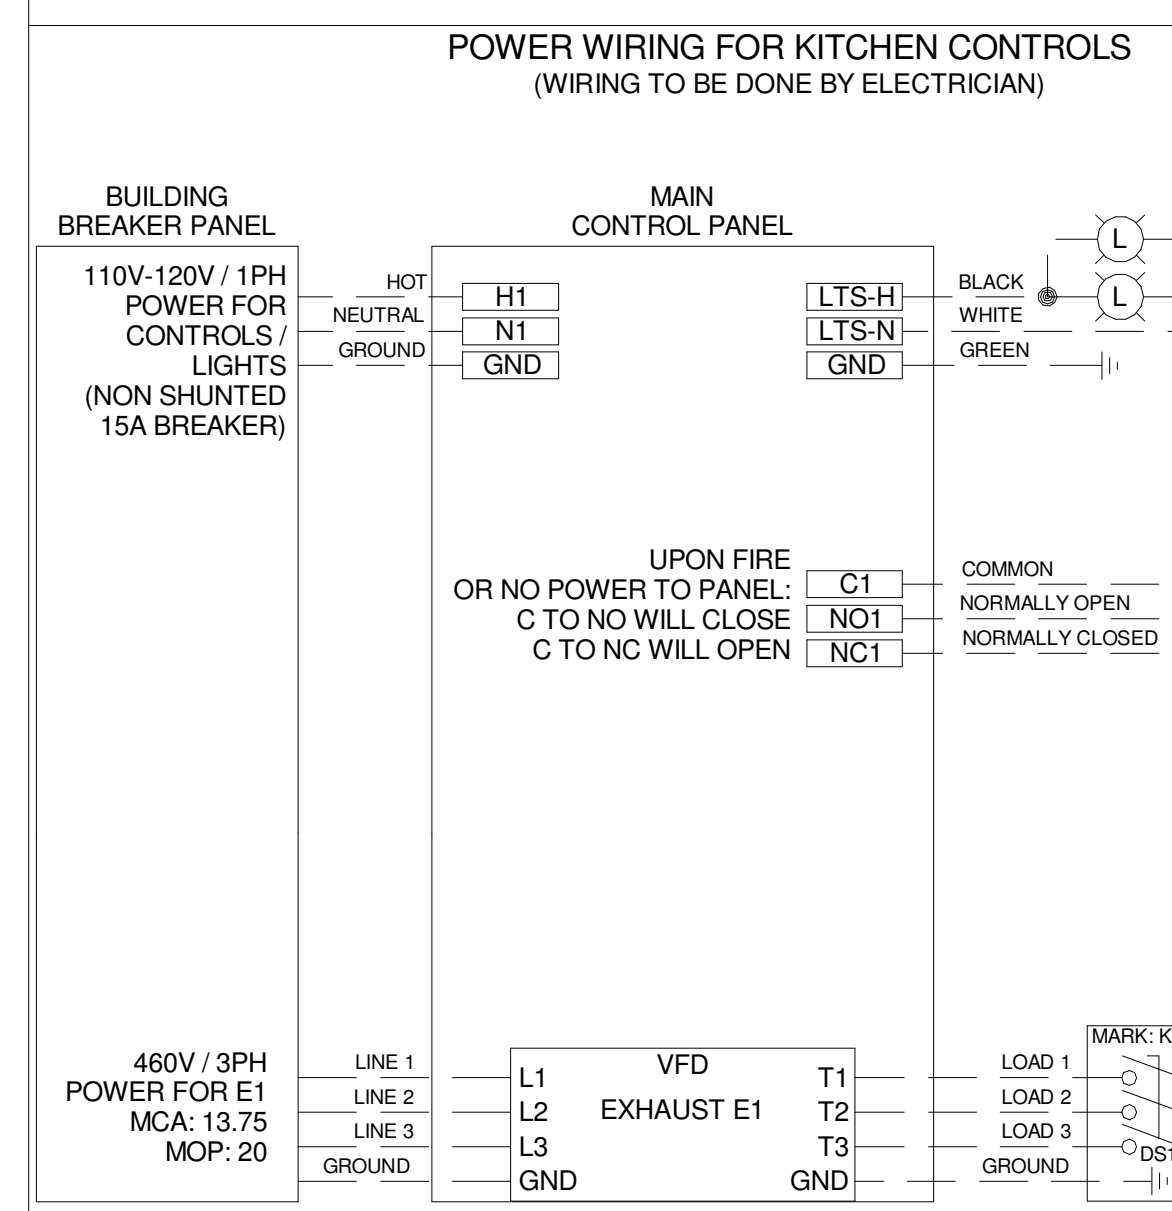

CAUTION
 UNIT MUST BE GROUNDED IN ACCORDANCE WITH N.E.C. POWER MUST BE OFF WHILE SERVICING.
ATTENTION
 L'APPAREIL DOIT ÊTRE MIS À LA TERRE CONFORMÉMENT AU CODE C.E.L. L'ALIMENTATION DOIT ÊTRE COUPÉE DURANT L'ENTRETIEN.
 COMMERCIAL APPLIANCE OUTLET CENTER
 ELECTRICAL RATINGS: 110-240V, 1PHASE, 50-60HZ, 15A
 BASE FILE #E200816, ML FILE #E313851
 LISTED 43BM

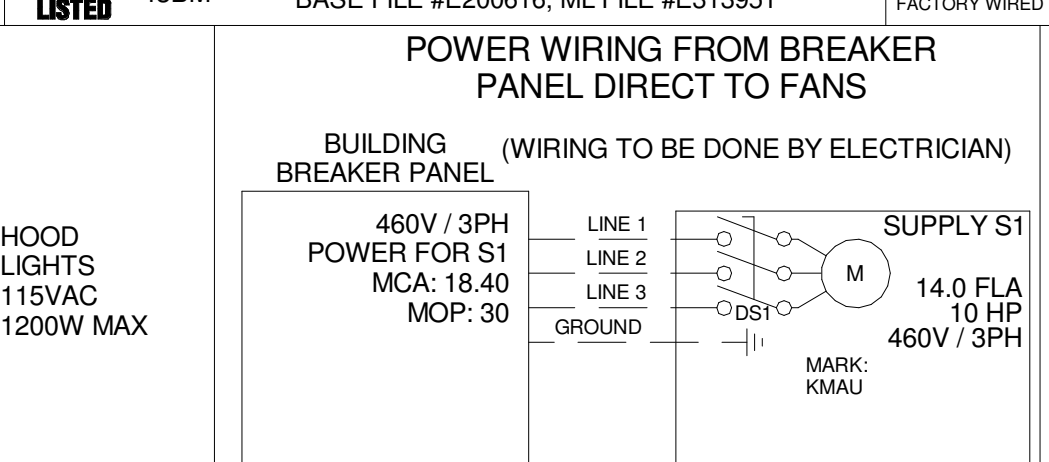

WARNING
 THESE DRAWINGS SHALL NOT BE REMOVED FROM THE EQUIPMENT. USE COPPER CONDUCTORS RATED TO MP, UNLESS SPECIFIED. TORQUE TORQUE POWER. USE SCREWS TO COMPONENT PARTS LISTED. TORQUE CONTROL BOARD SCREWS TERMINALS TO 3.5 LB. IN. FIELD CONTROL WIRING RESISTANCE SHOULD NOT EXCEED 0.75 OHM. SEE IOM FOR ADDITIONAL INFORMATION, OR CALL FACTORY AT 1-800-371-8688.
 NE PAS RETIRER CES DESSINS DE CET ÉQUIPEMENT. SAUF INDICATION CONTRAIRE UTILISER DES CONDUCTEURS EN CUivre CLASSÉS PAR TORQUE. TORQUE TORQUE. UTILISER LES VIS POUR LES COMPOSANTS ÉNUMÉRÉS POUR LE COMPOSANT. SERRER LES BORNES À VIS DE LA CARTE DE COMMANDE À 3.5 LB. PO. LA RÉSISTANCE DU CÂBLAGE DE COMMANDE NE DOIT PAS DÉPASSER 0.75 OHM. POUR PLUS D'INFORMATION, CONSULTER LE MANUEL OU APPELER 1-800-371-8688.
 WIRING DIAGRAM CODE: WDC#
 JOB NAME: PLEASANT VALLEY COUNTRY CLUB HOOD
 MODEL: GKC-DCV-S-11-3-1-0
 SERIAL NUMBER: WDSN#
 MARK: CONTROLS

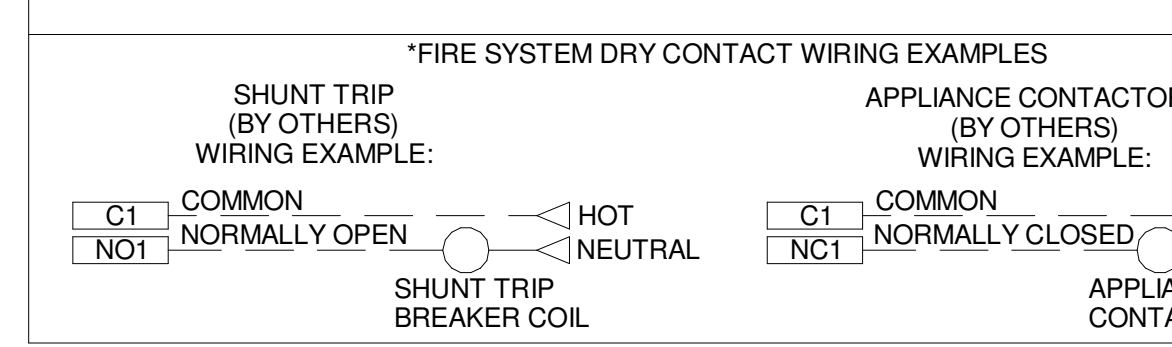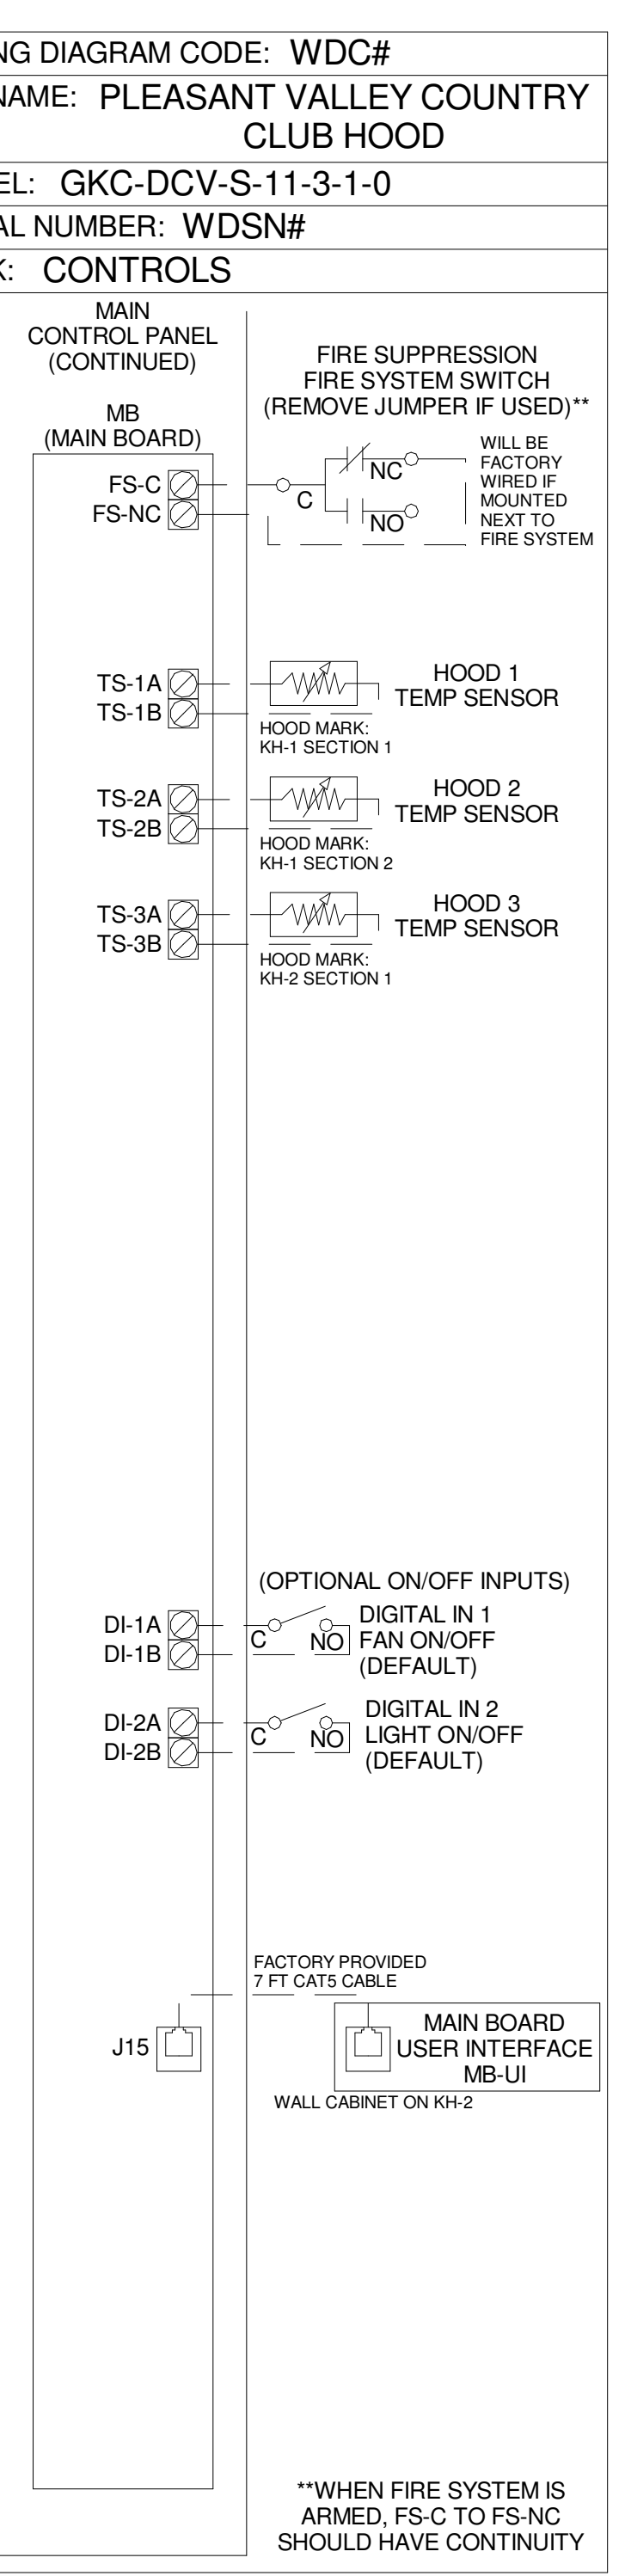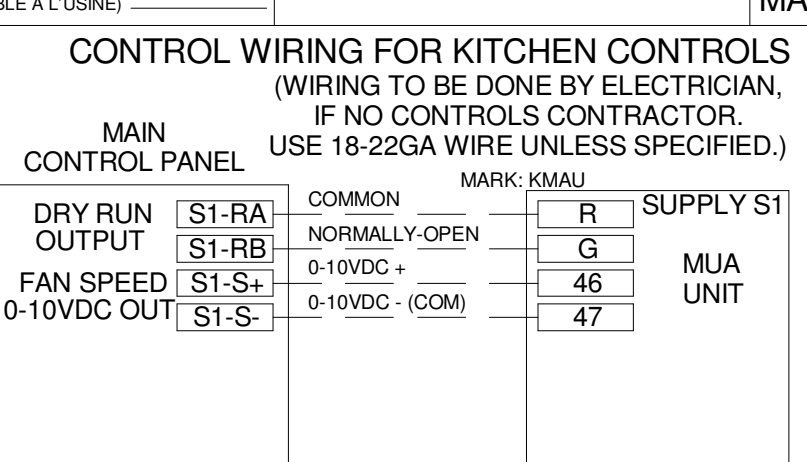

1 HOOD CONTROLS CABINET DETAILS
 NOT TO SCALE