
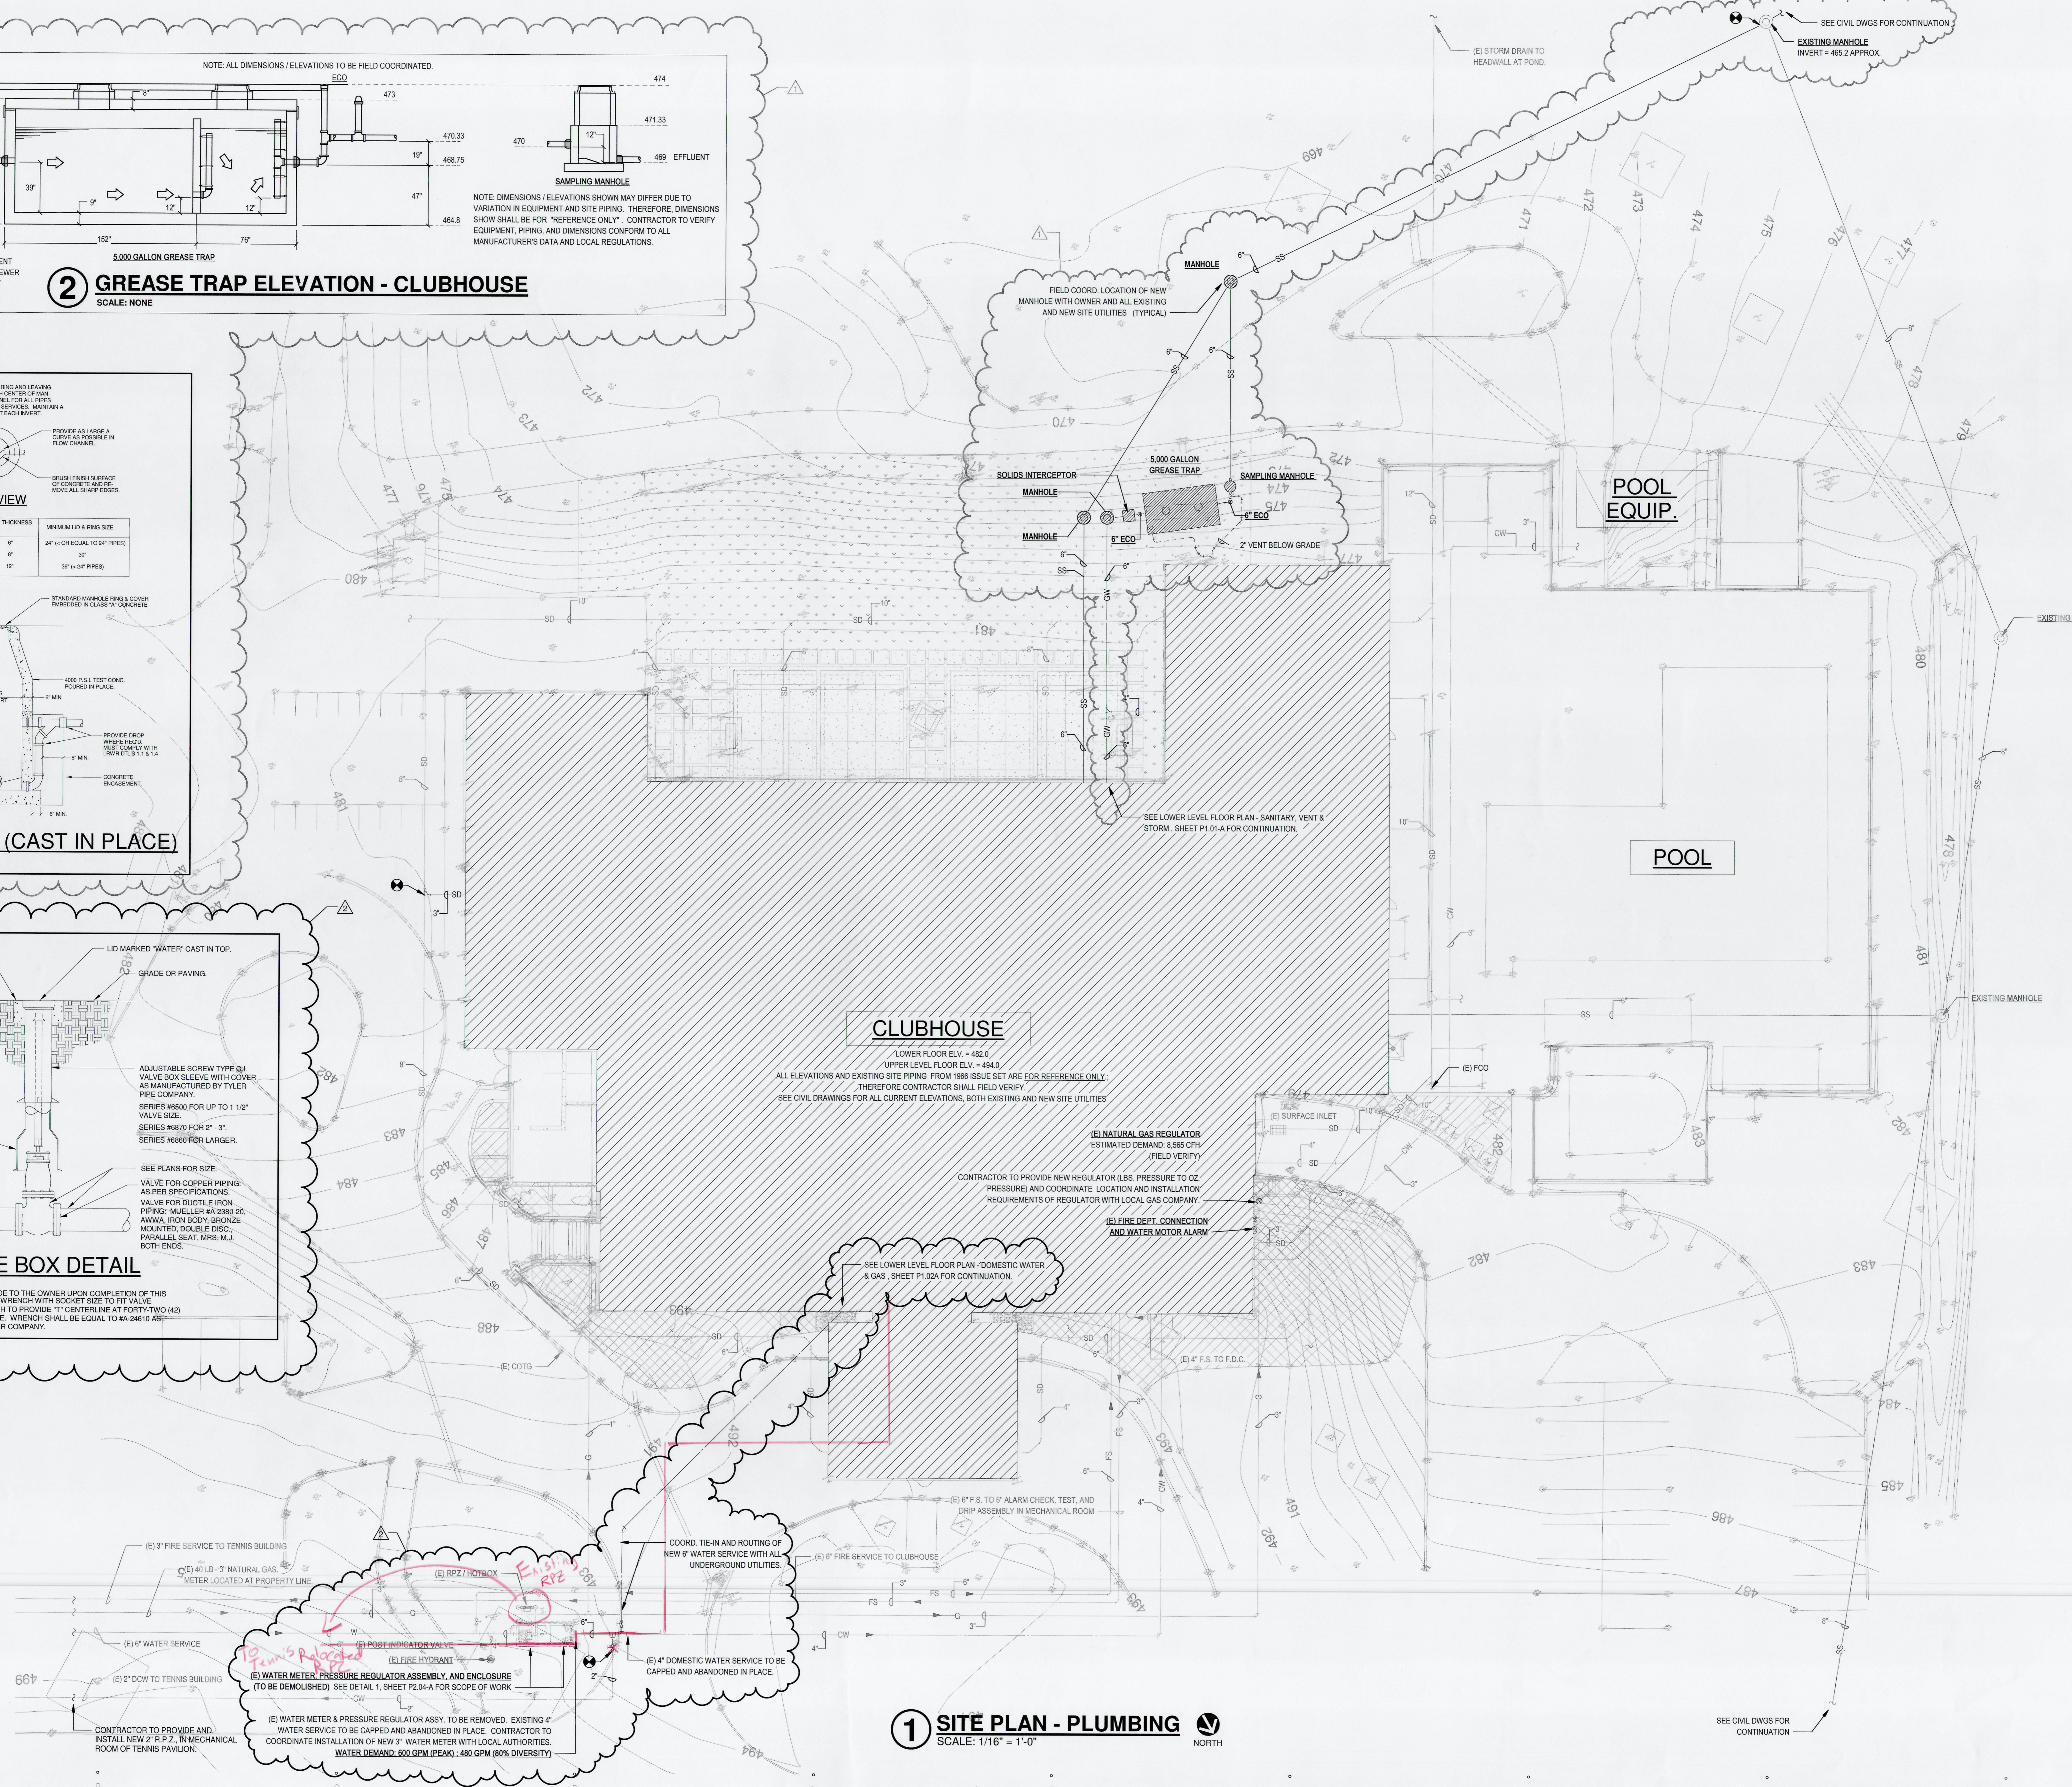
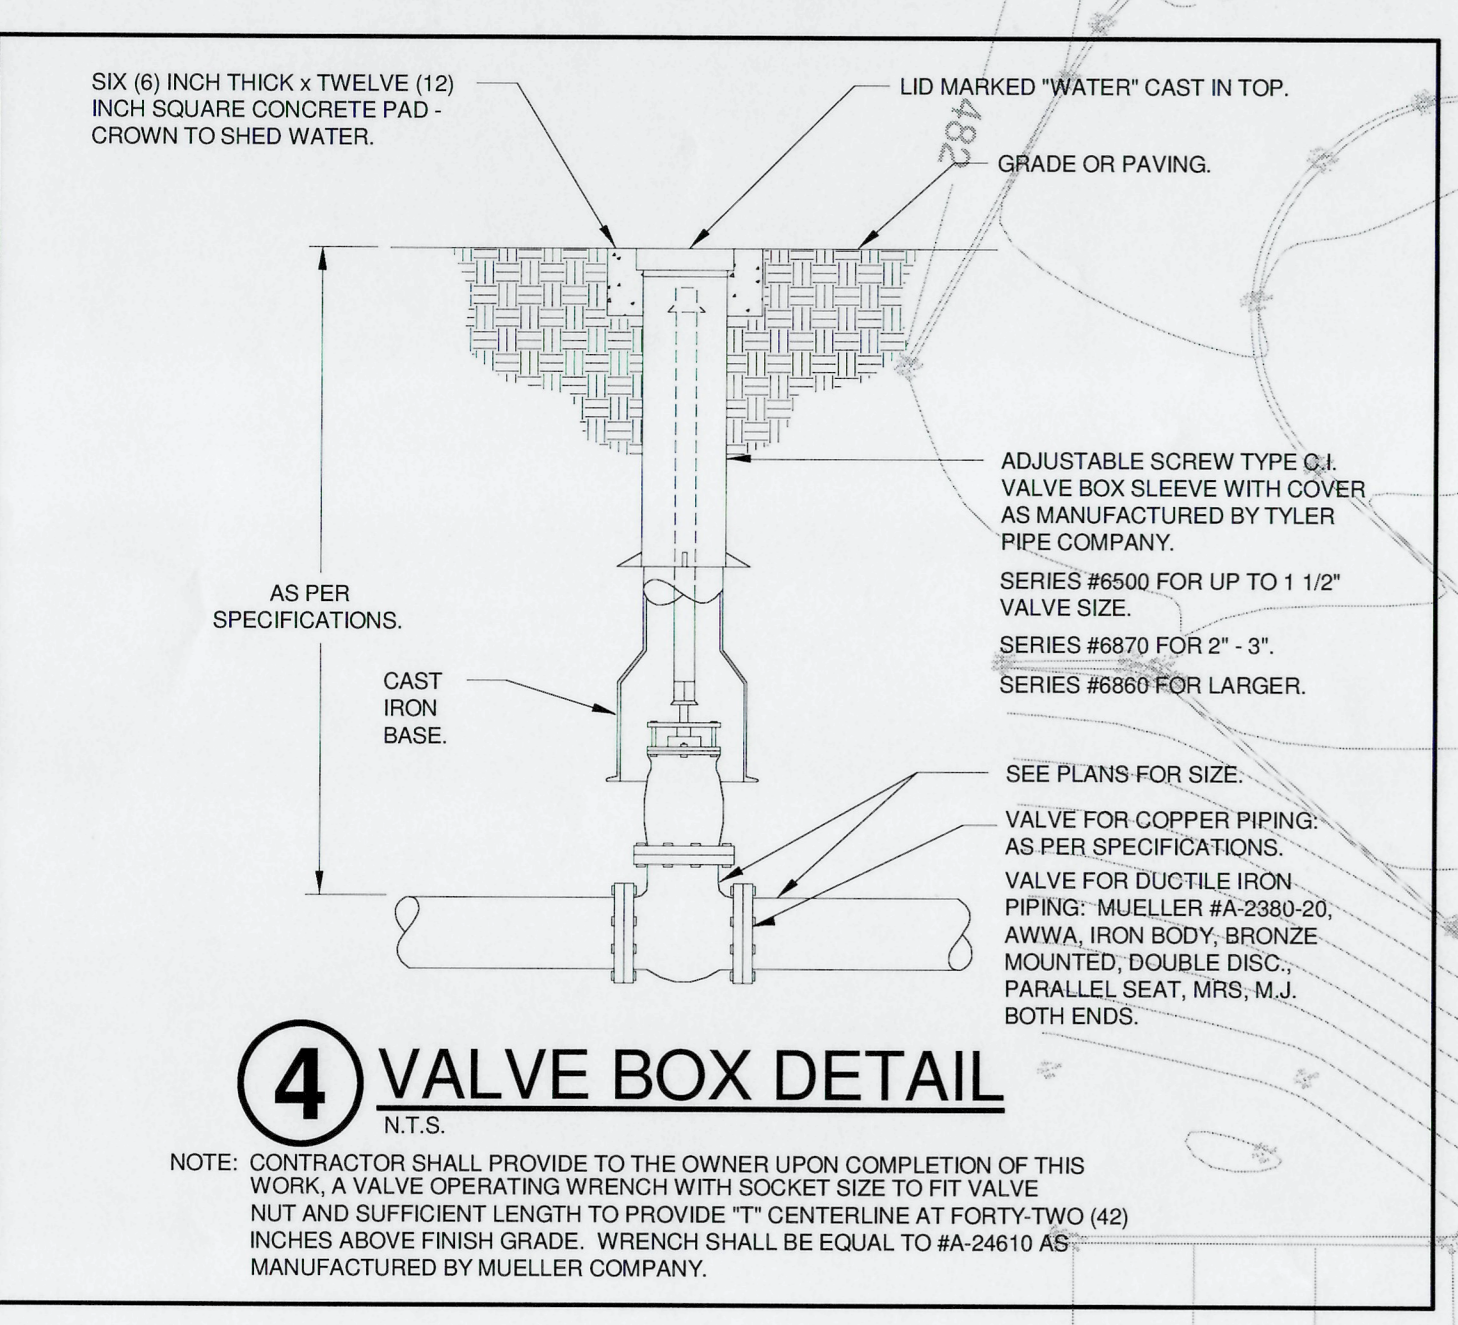
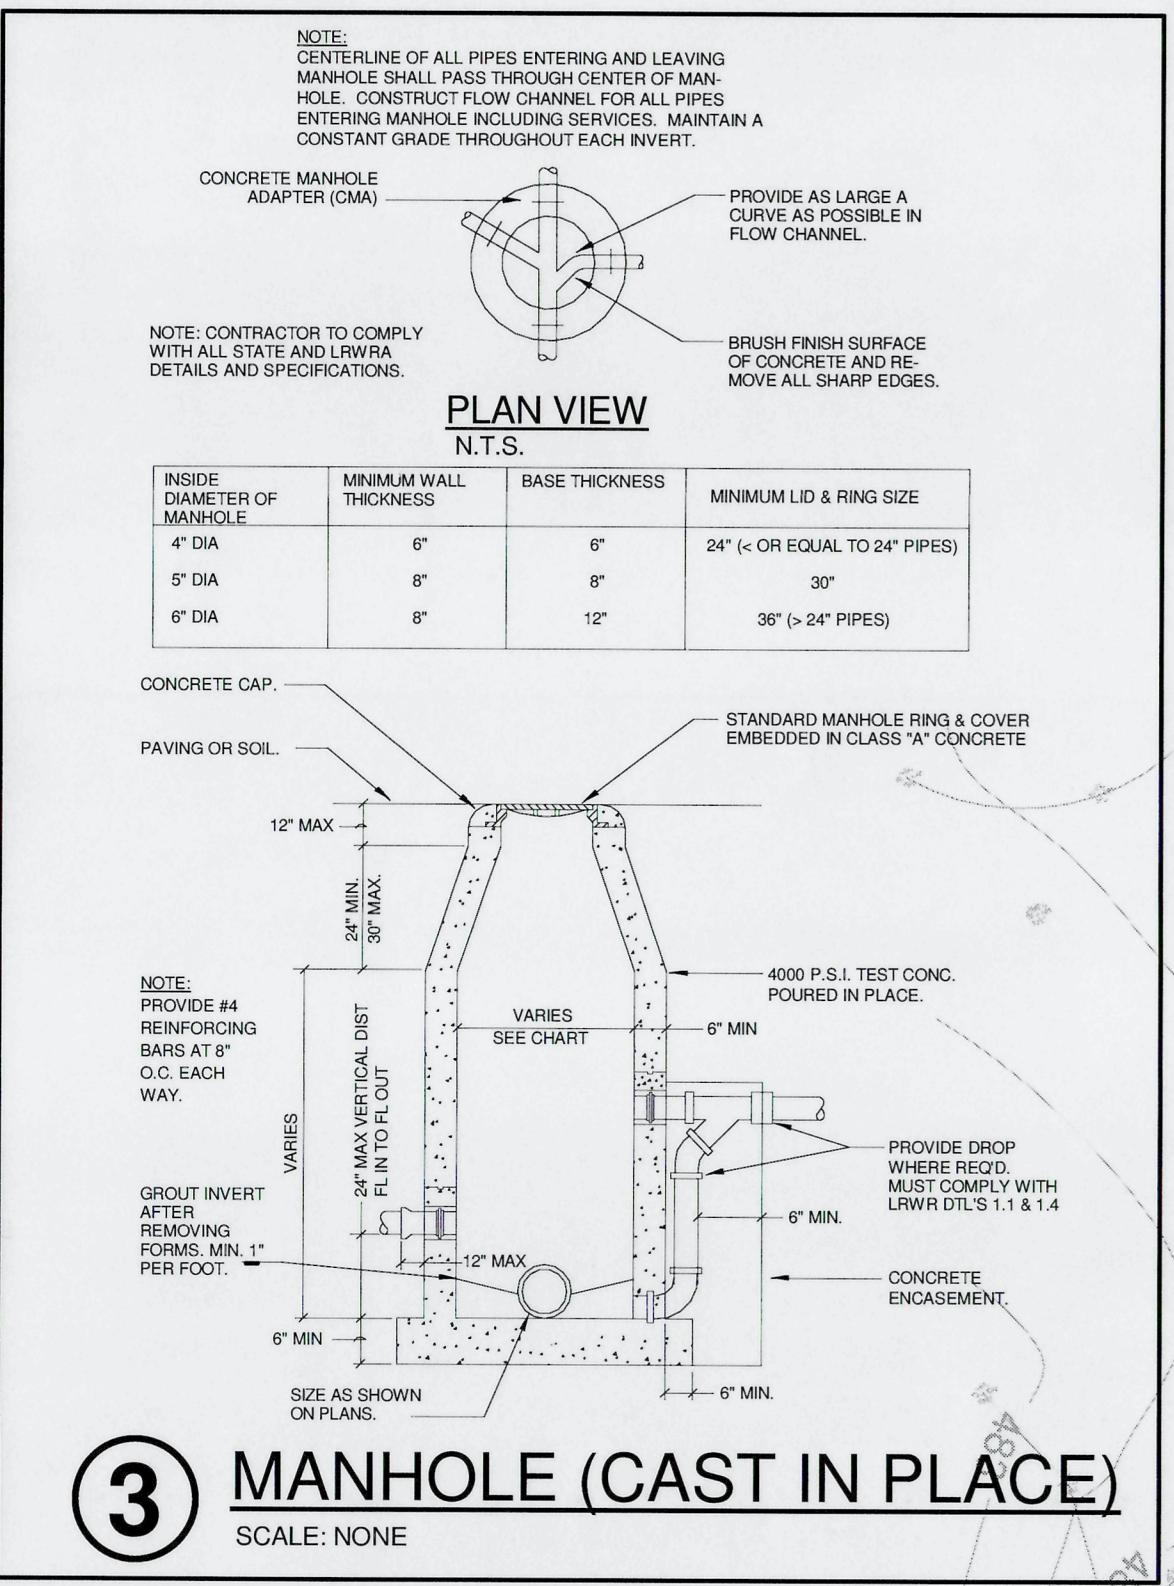


PERMIT SET

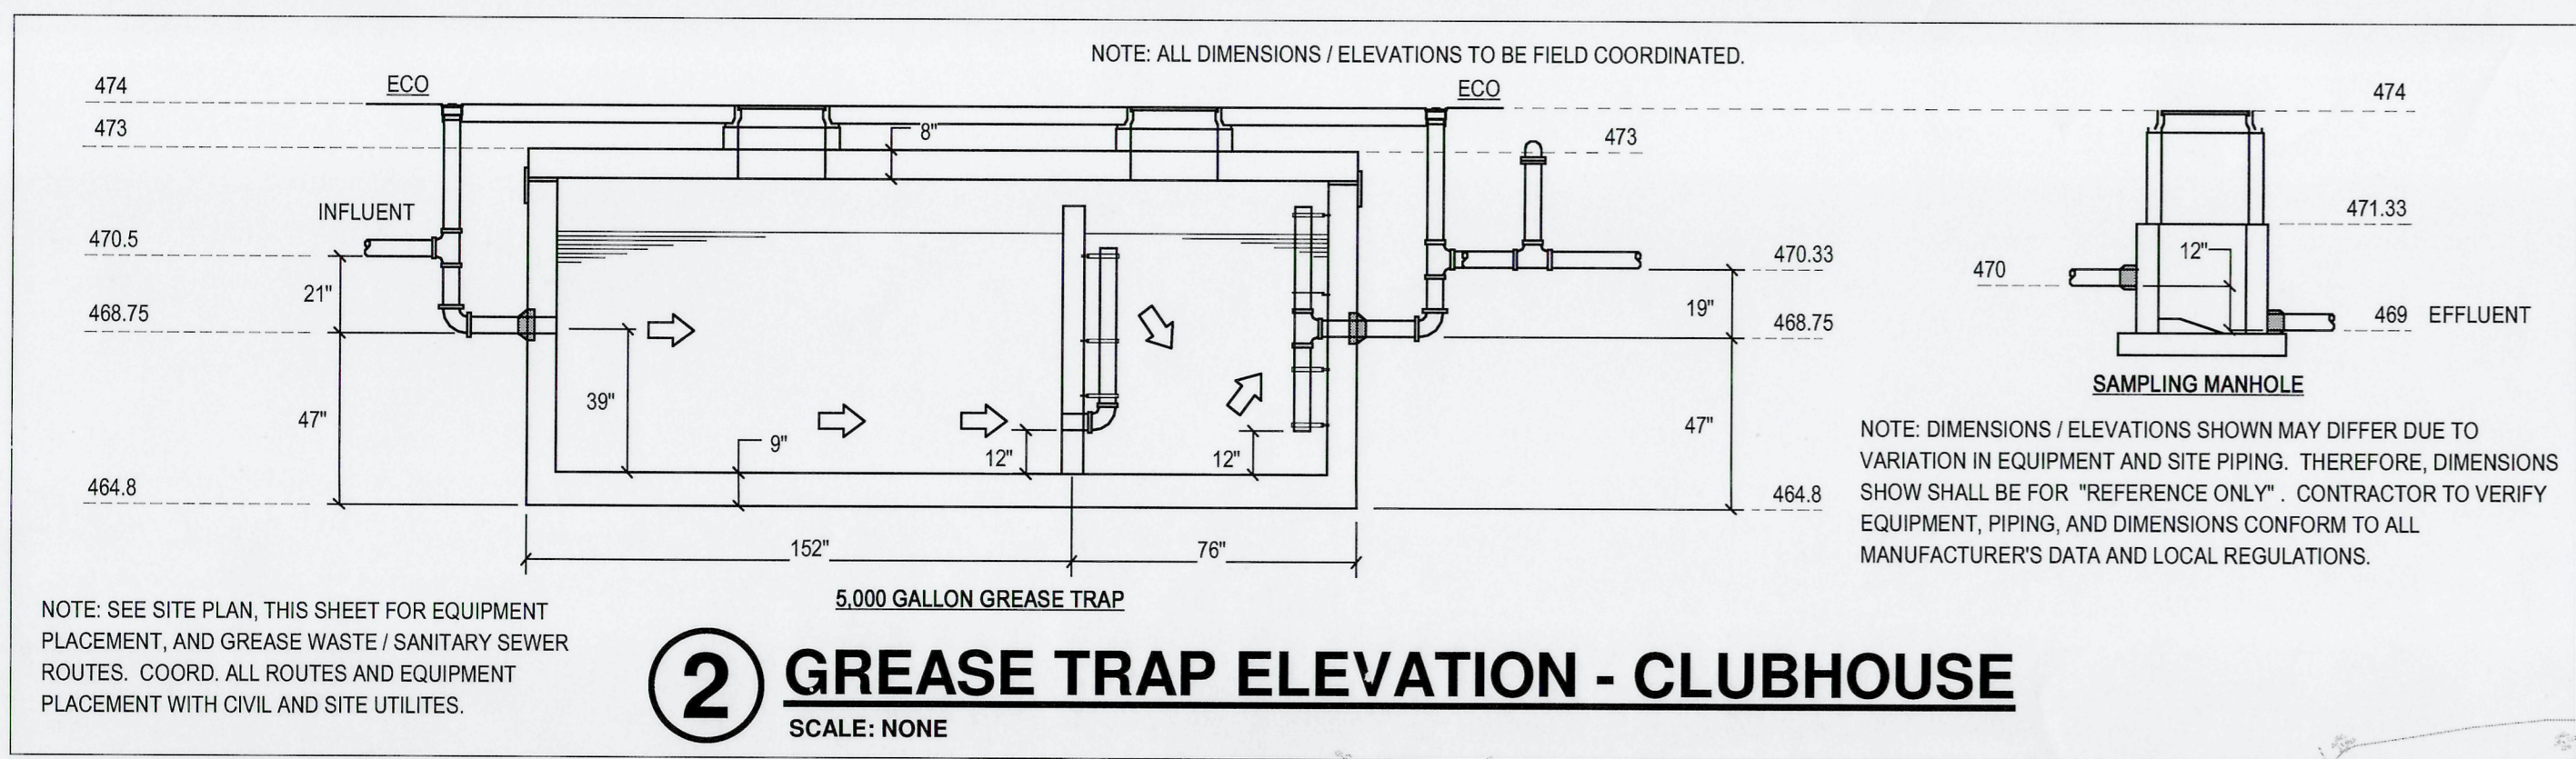

ADDITION AND RENOVATION TO PLEASANT VALLEY COUNTRY CLUB  
**CLUBHOUSE**  
1 PLEASANT VALLEY DRIVE  
LITTLE ROCK, ARKANSAS 72212

REVISIONS	
1	RFP 30 10-31-23
2	RFP 03 11-16-23

PROJECT NO: 21075  
DATE: June 21, 2023

SITE PLAN - PLUMBING  
**P1.00-A**  
SCM ARCHITECTS PLLC