




PERMIT SET

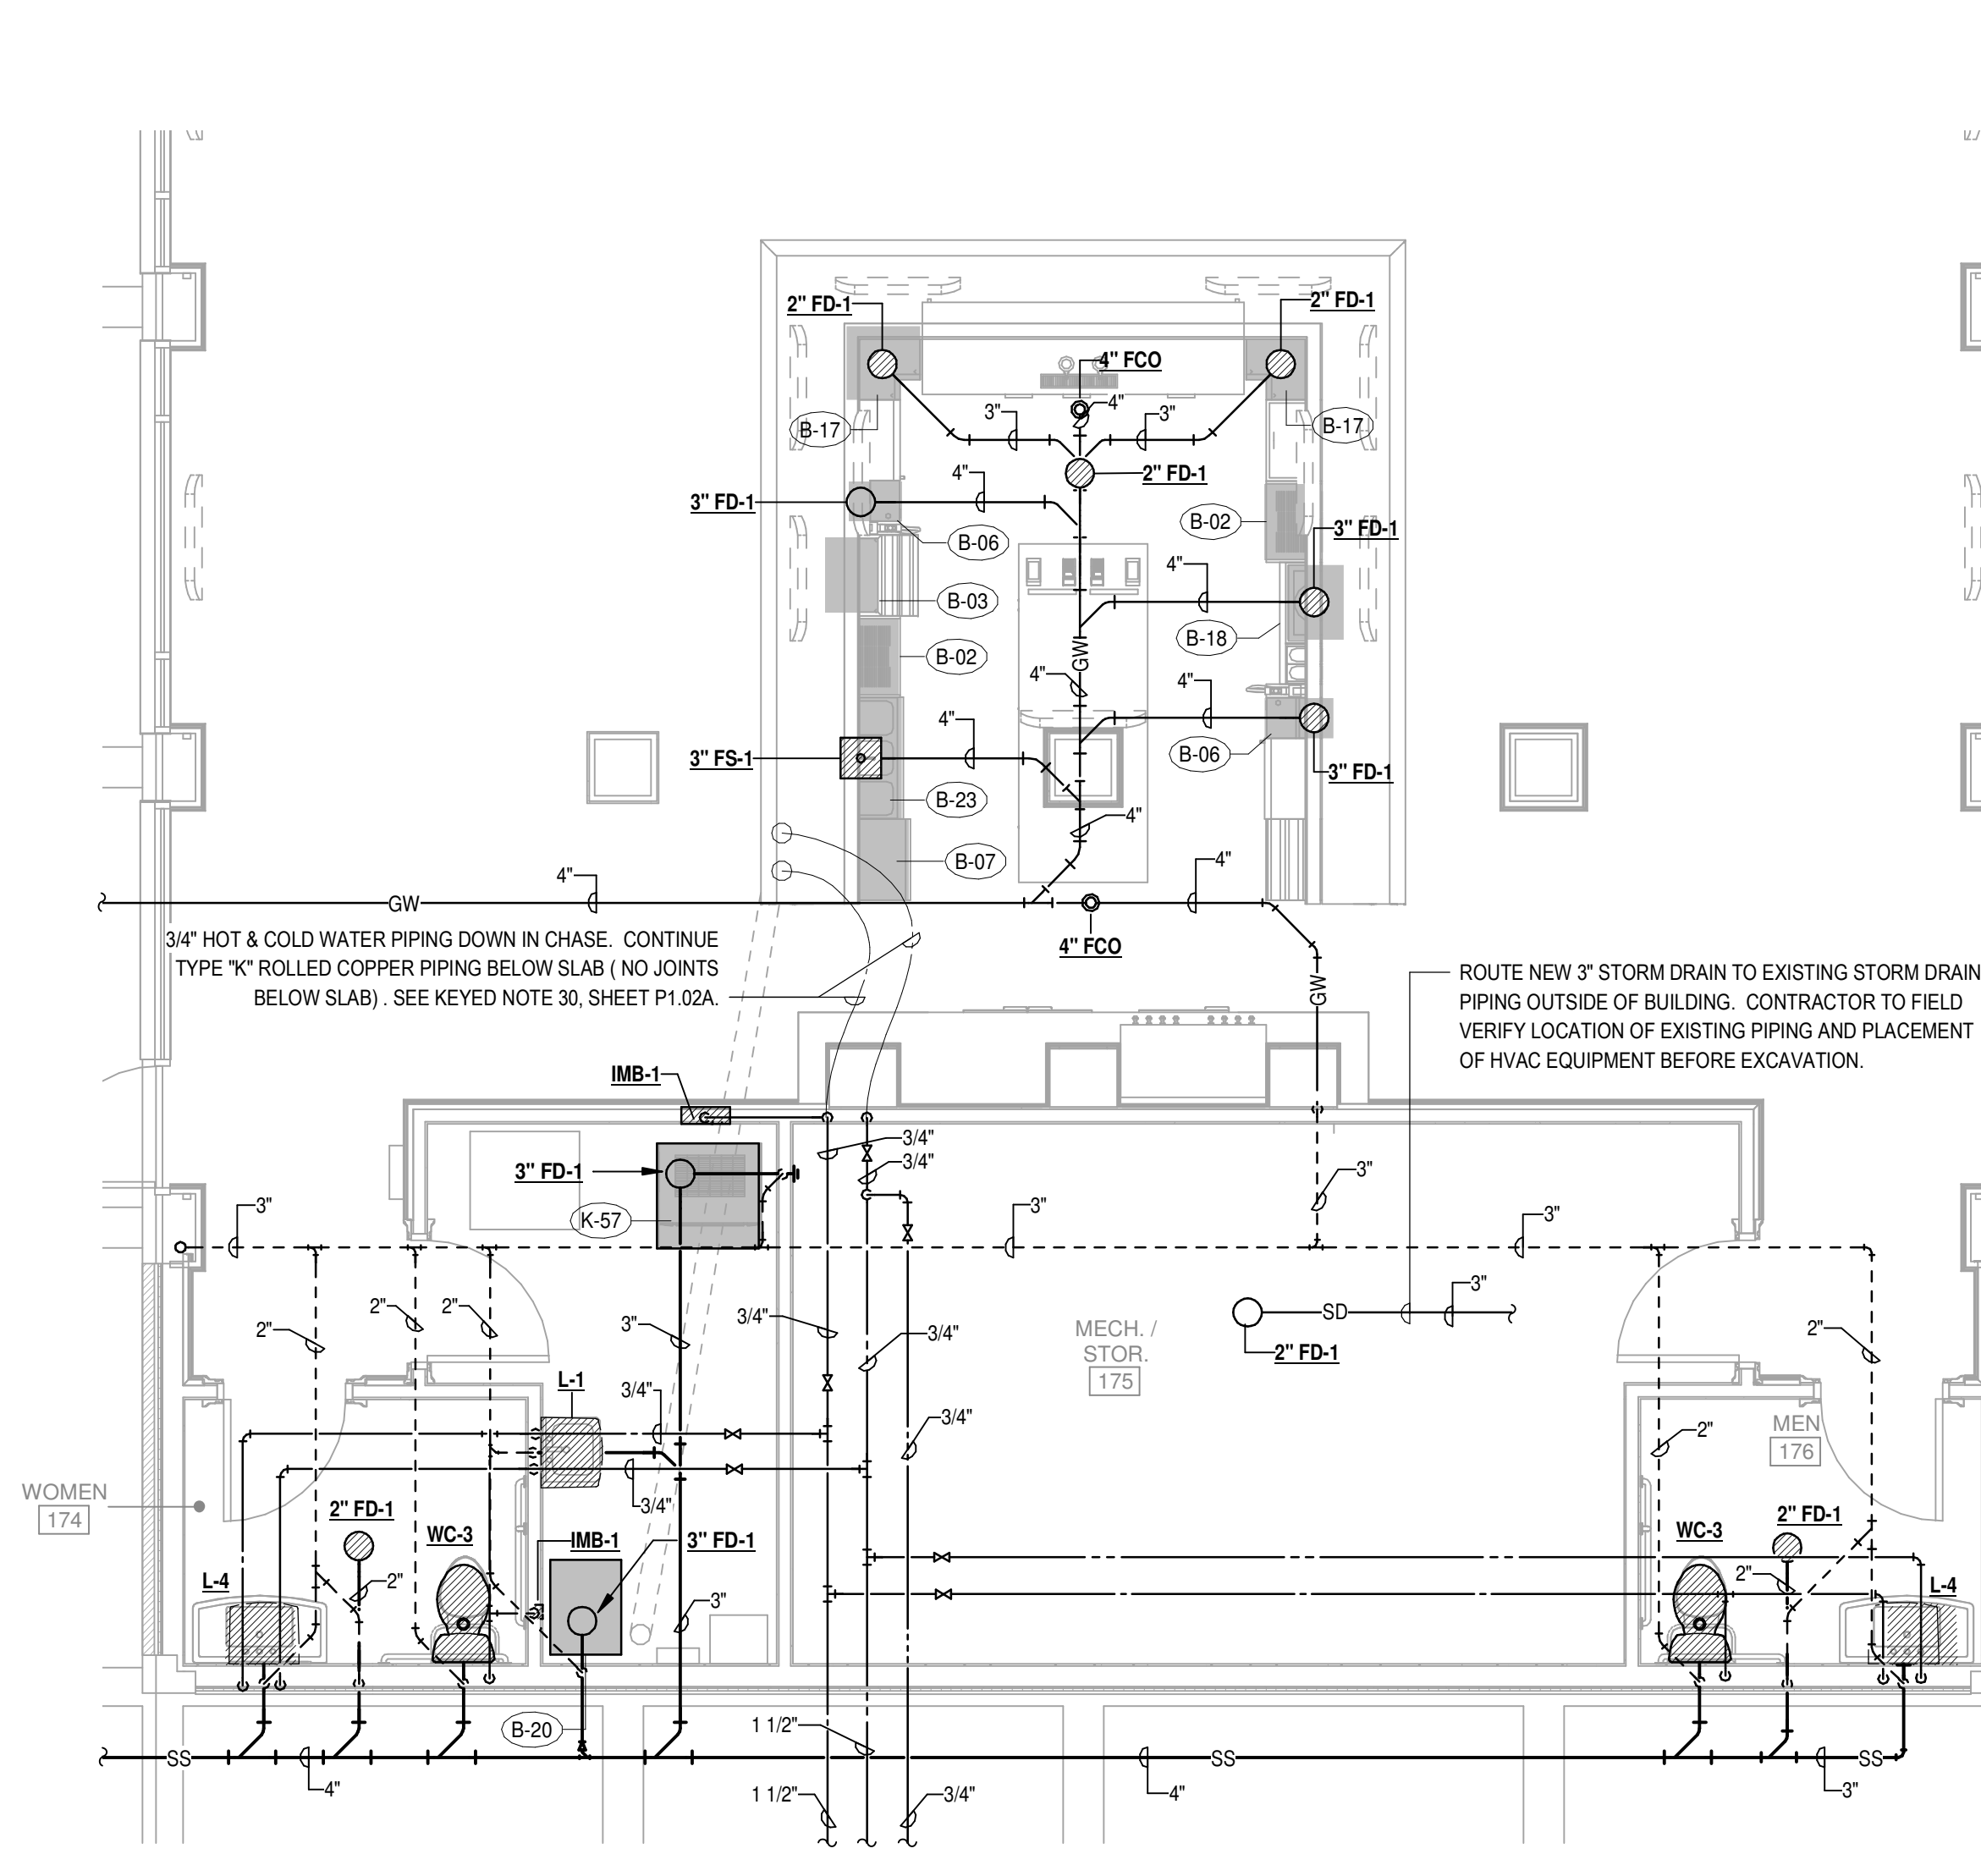


1 ENLARGED PLAN VIEW - PLUMBING - (BAR & RR)  
1/4" = 1'-0"

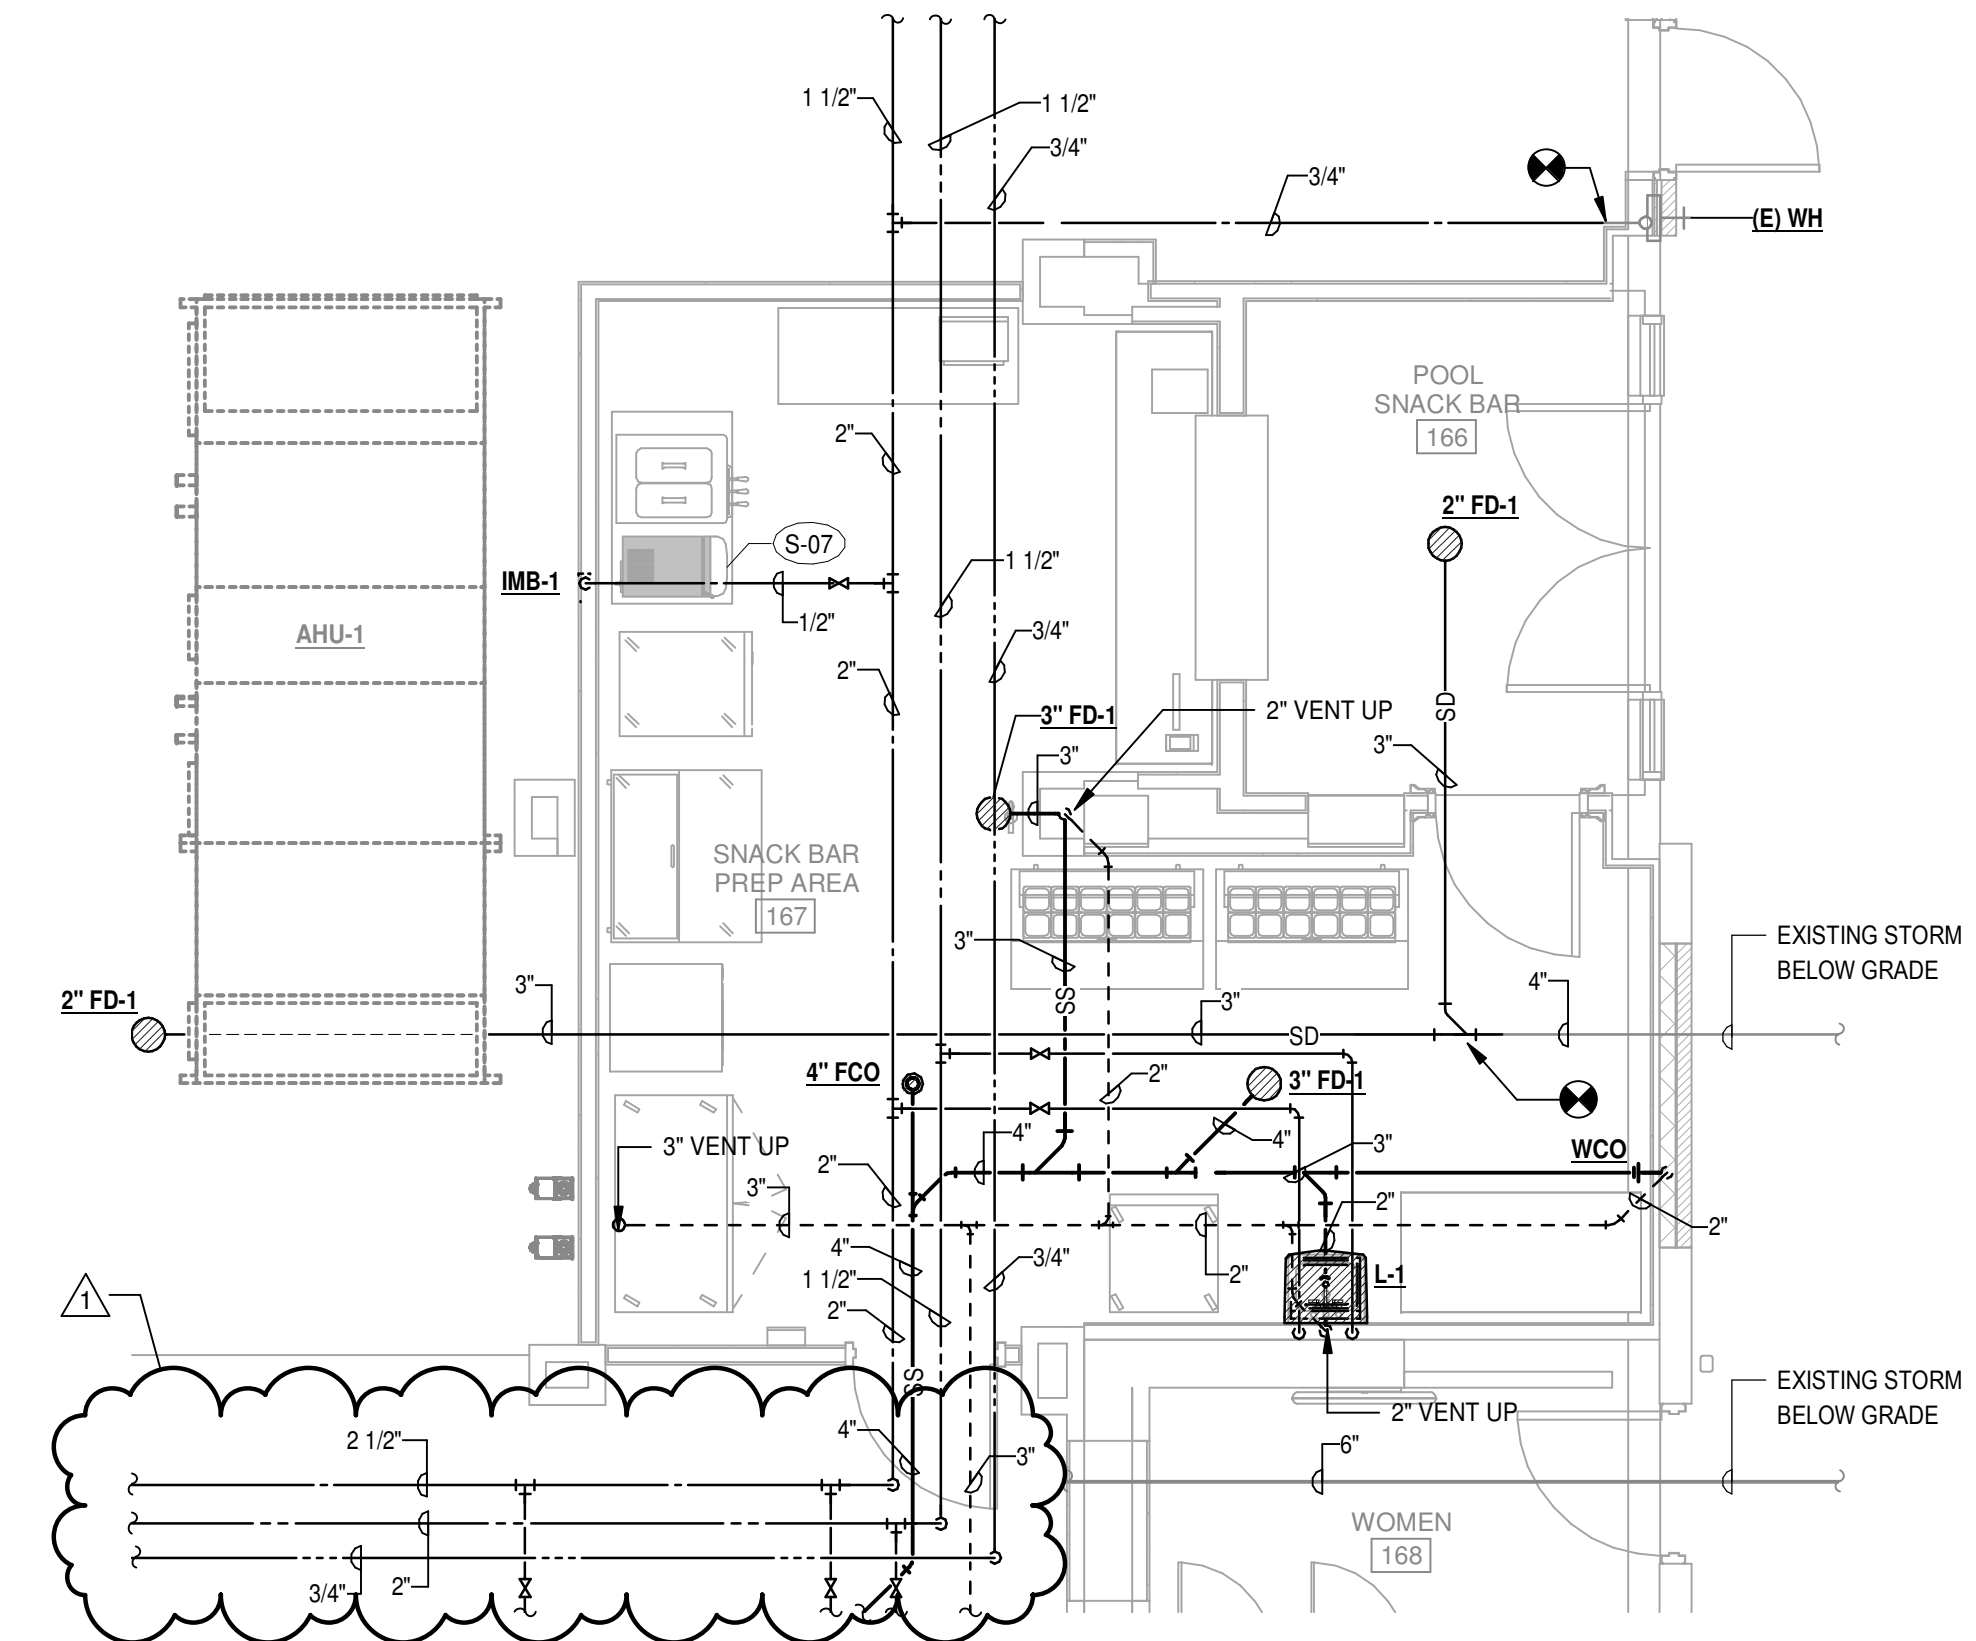


2 ENLARGED PLAN VIEW - PLUMBING - (SNACK BAR)  
1/4" = 1'-0"

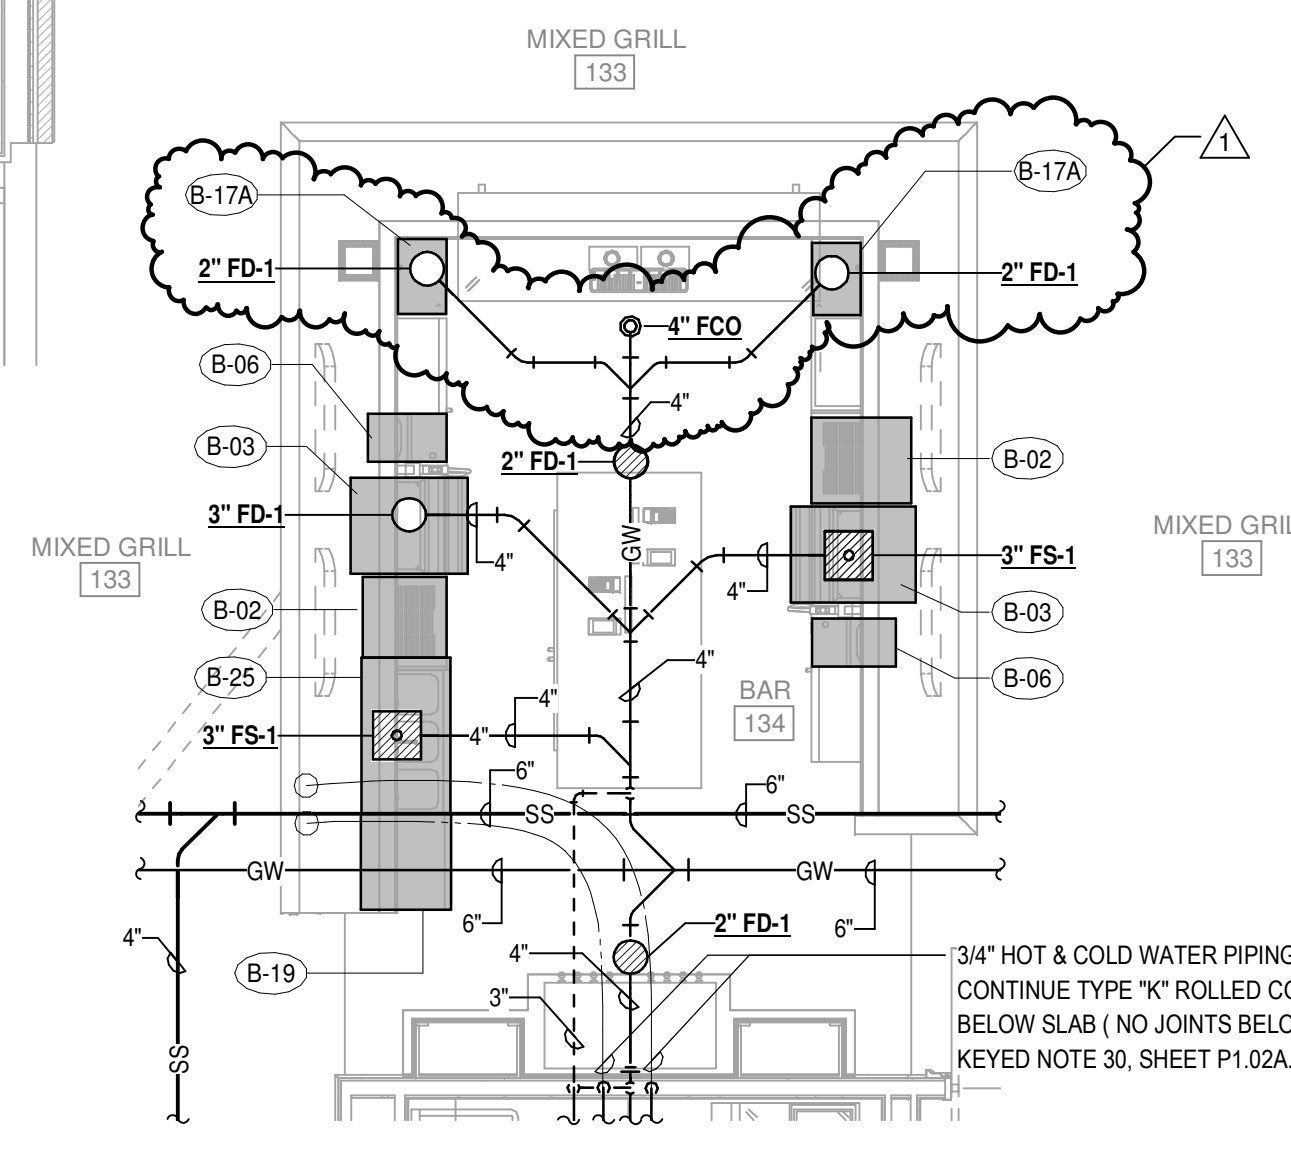


3 ENLARGED FLOOR PLAN - PLUMBING - (BAR - 134)  
1/4" = 1'-0"

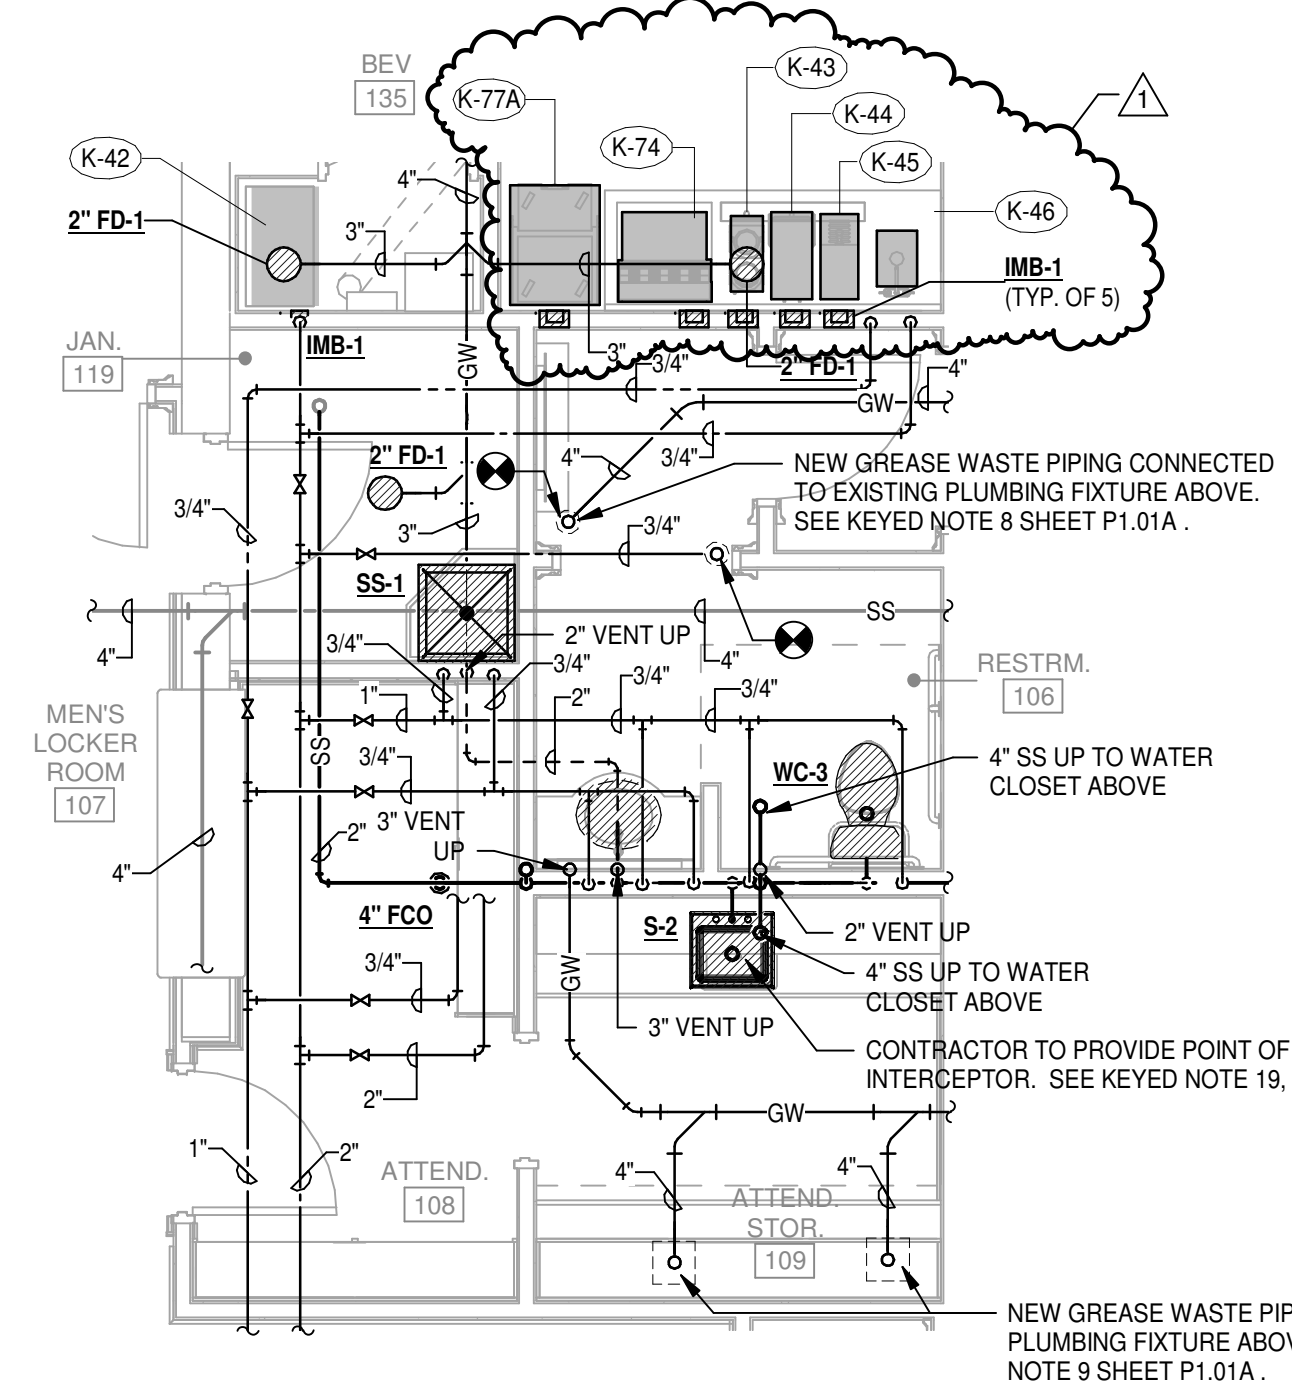


4 ENLARGED FLOOR PLAN - PLUMBING - (RR - 106)  
1/4" = 1'-0"

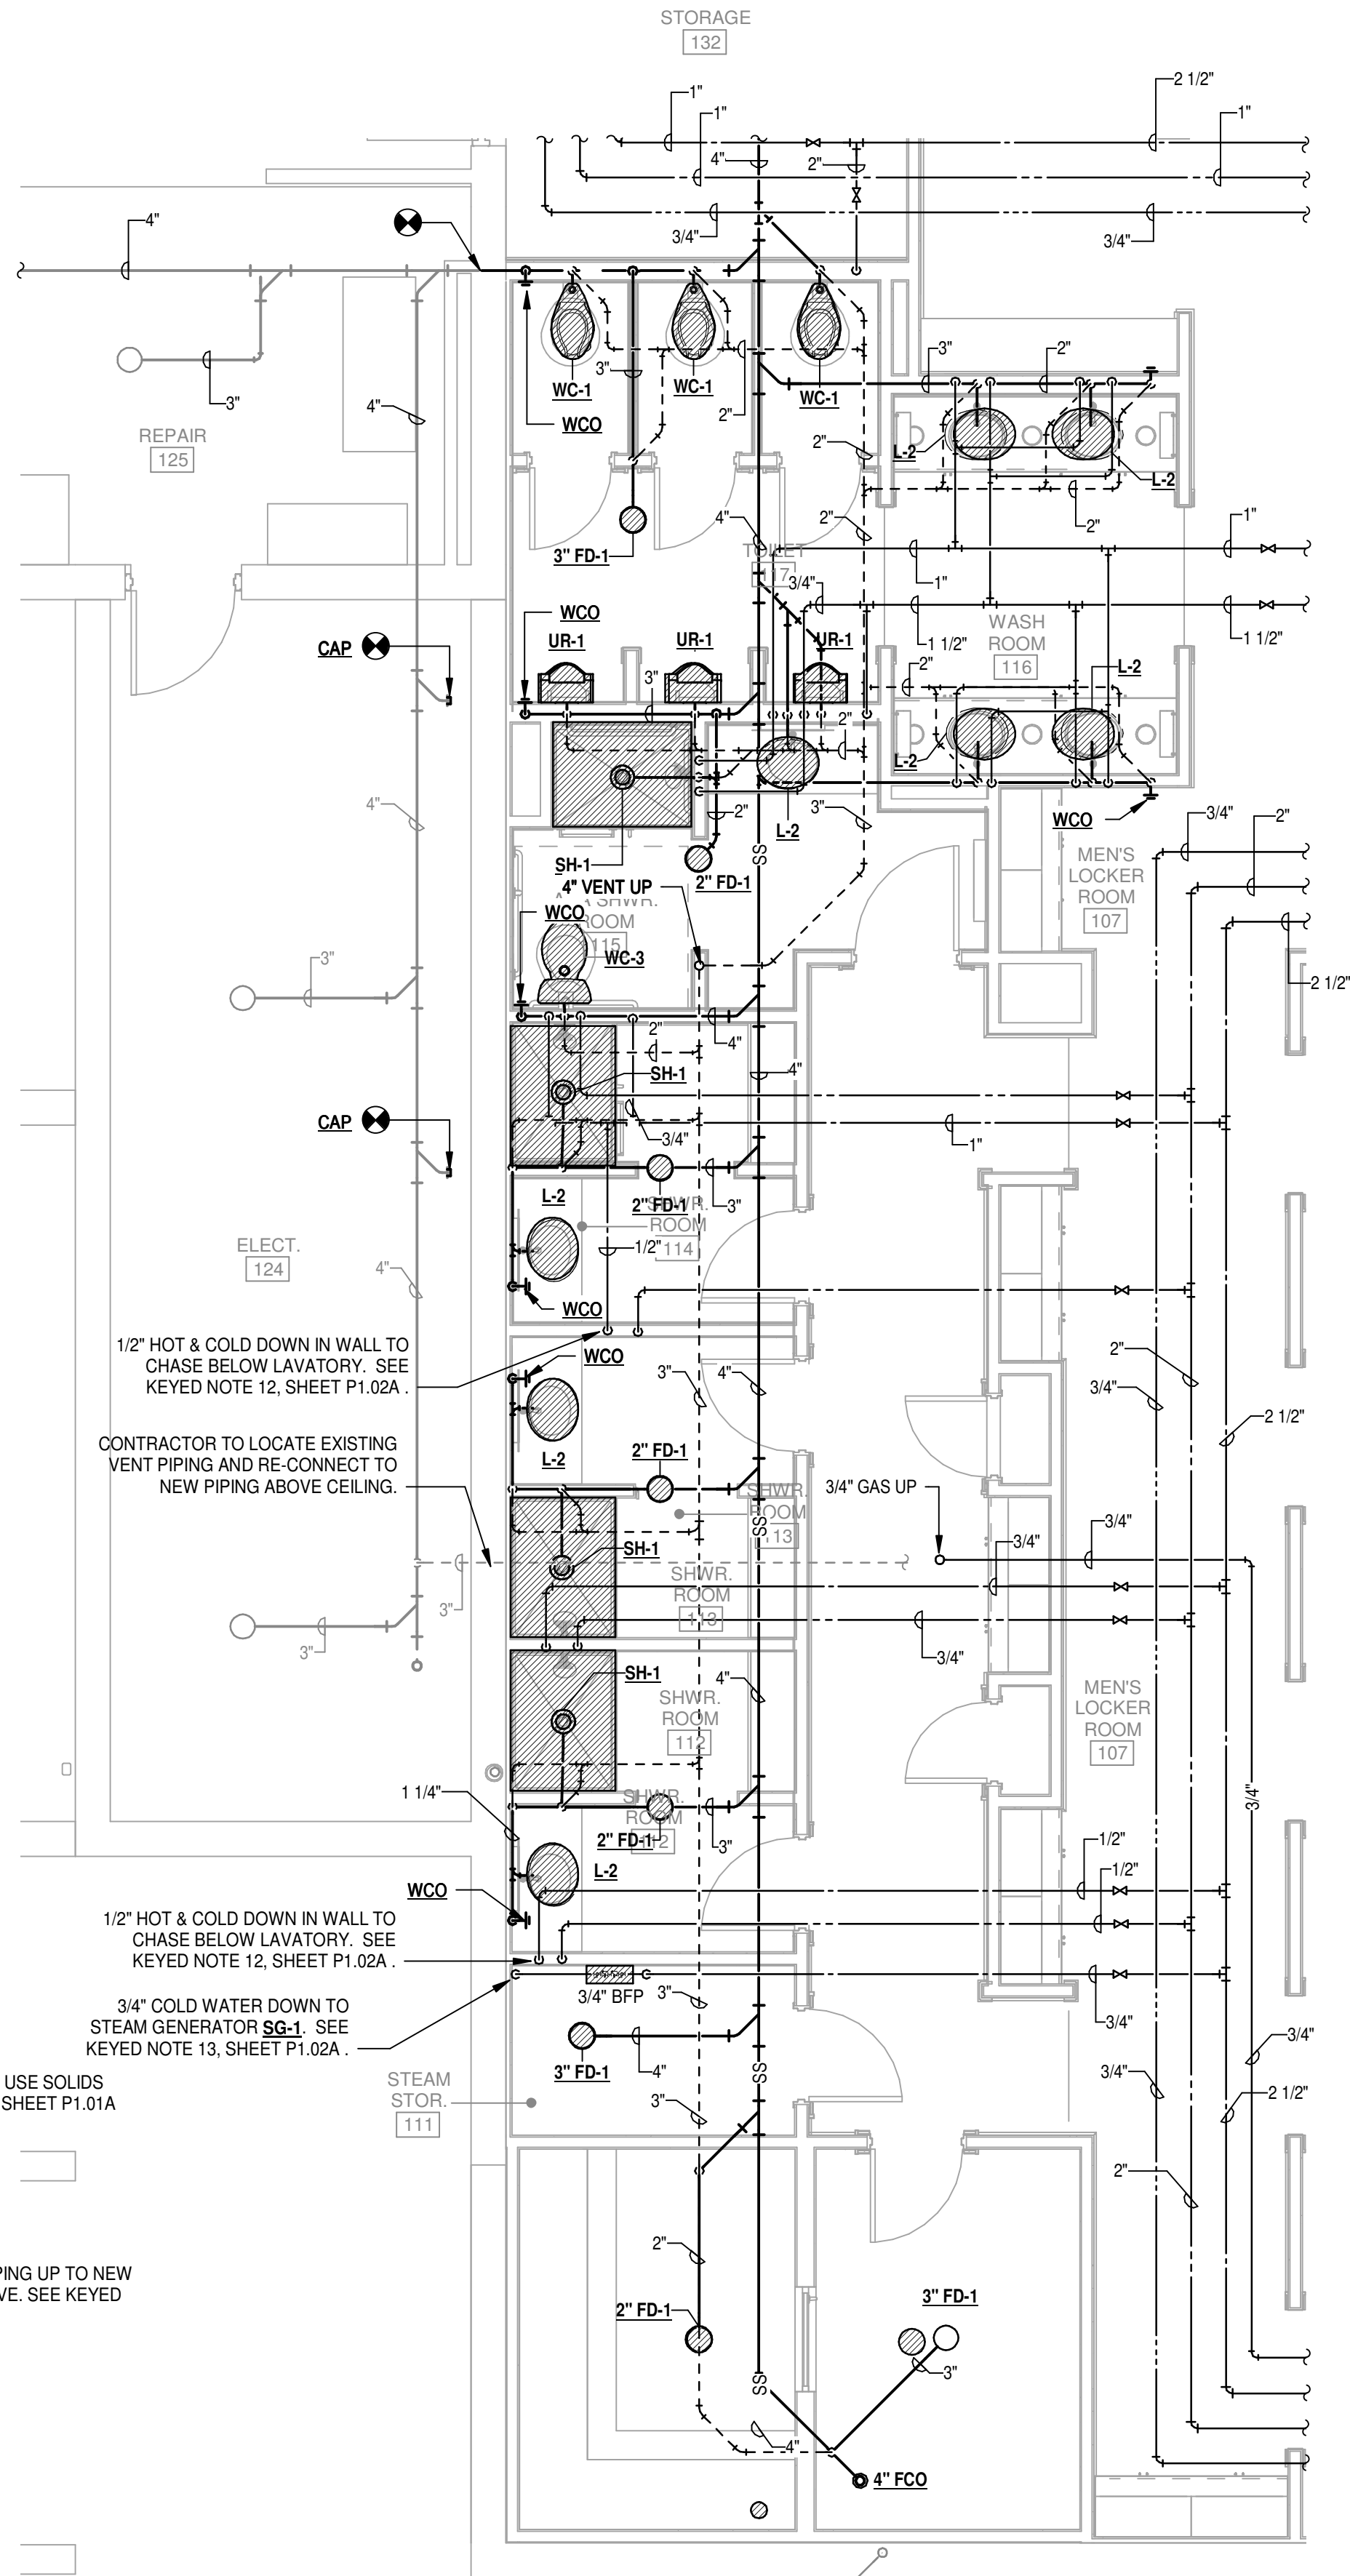

5 ENLARGED PLAN VIEW - PLUMBING - (MEN'S LOCKER ROOM AREA)  
1/4" = 1'-0"

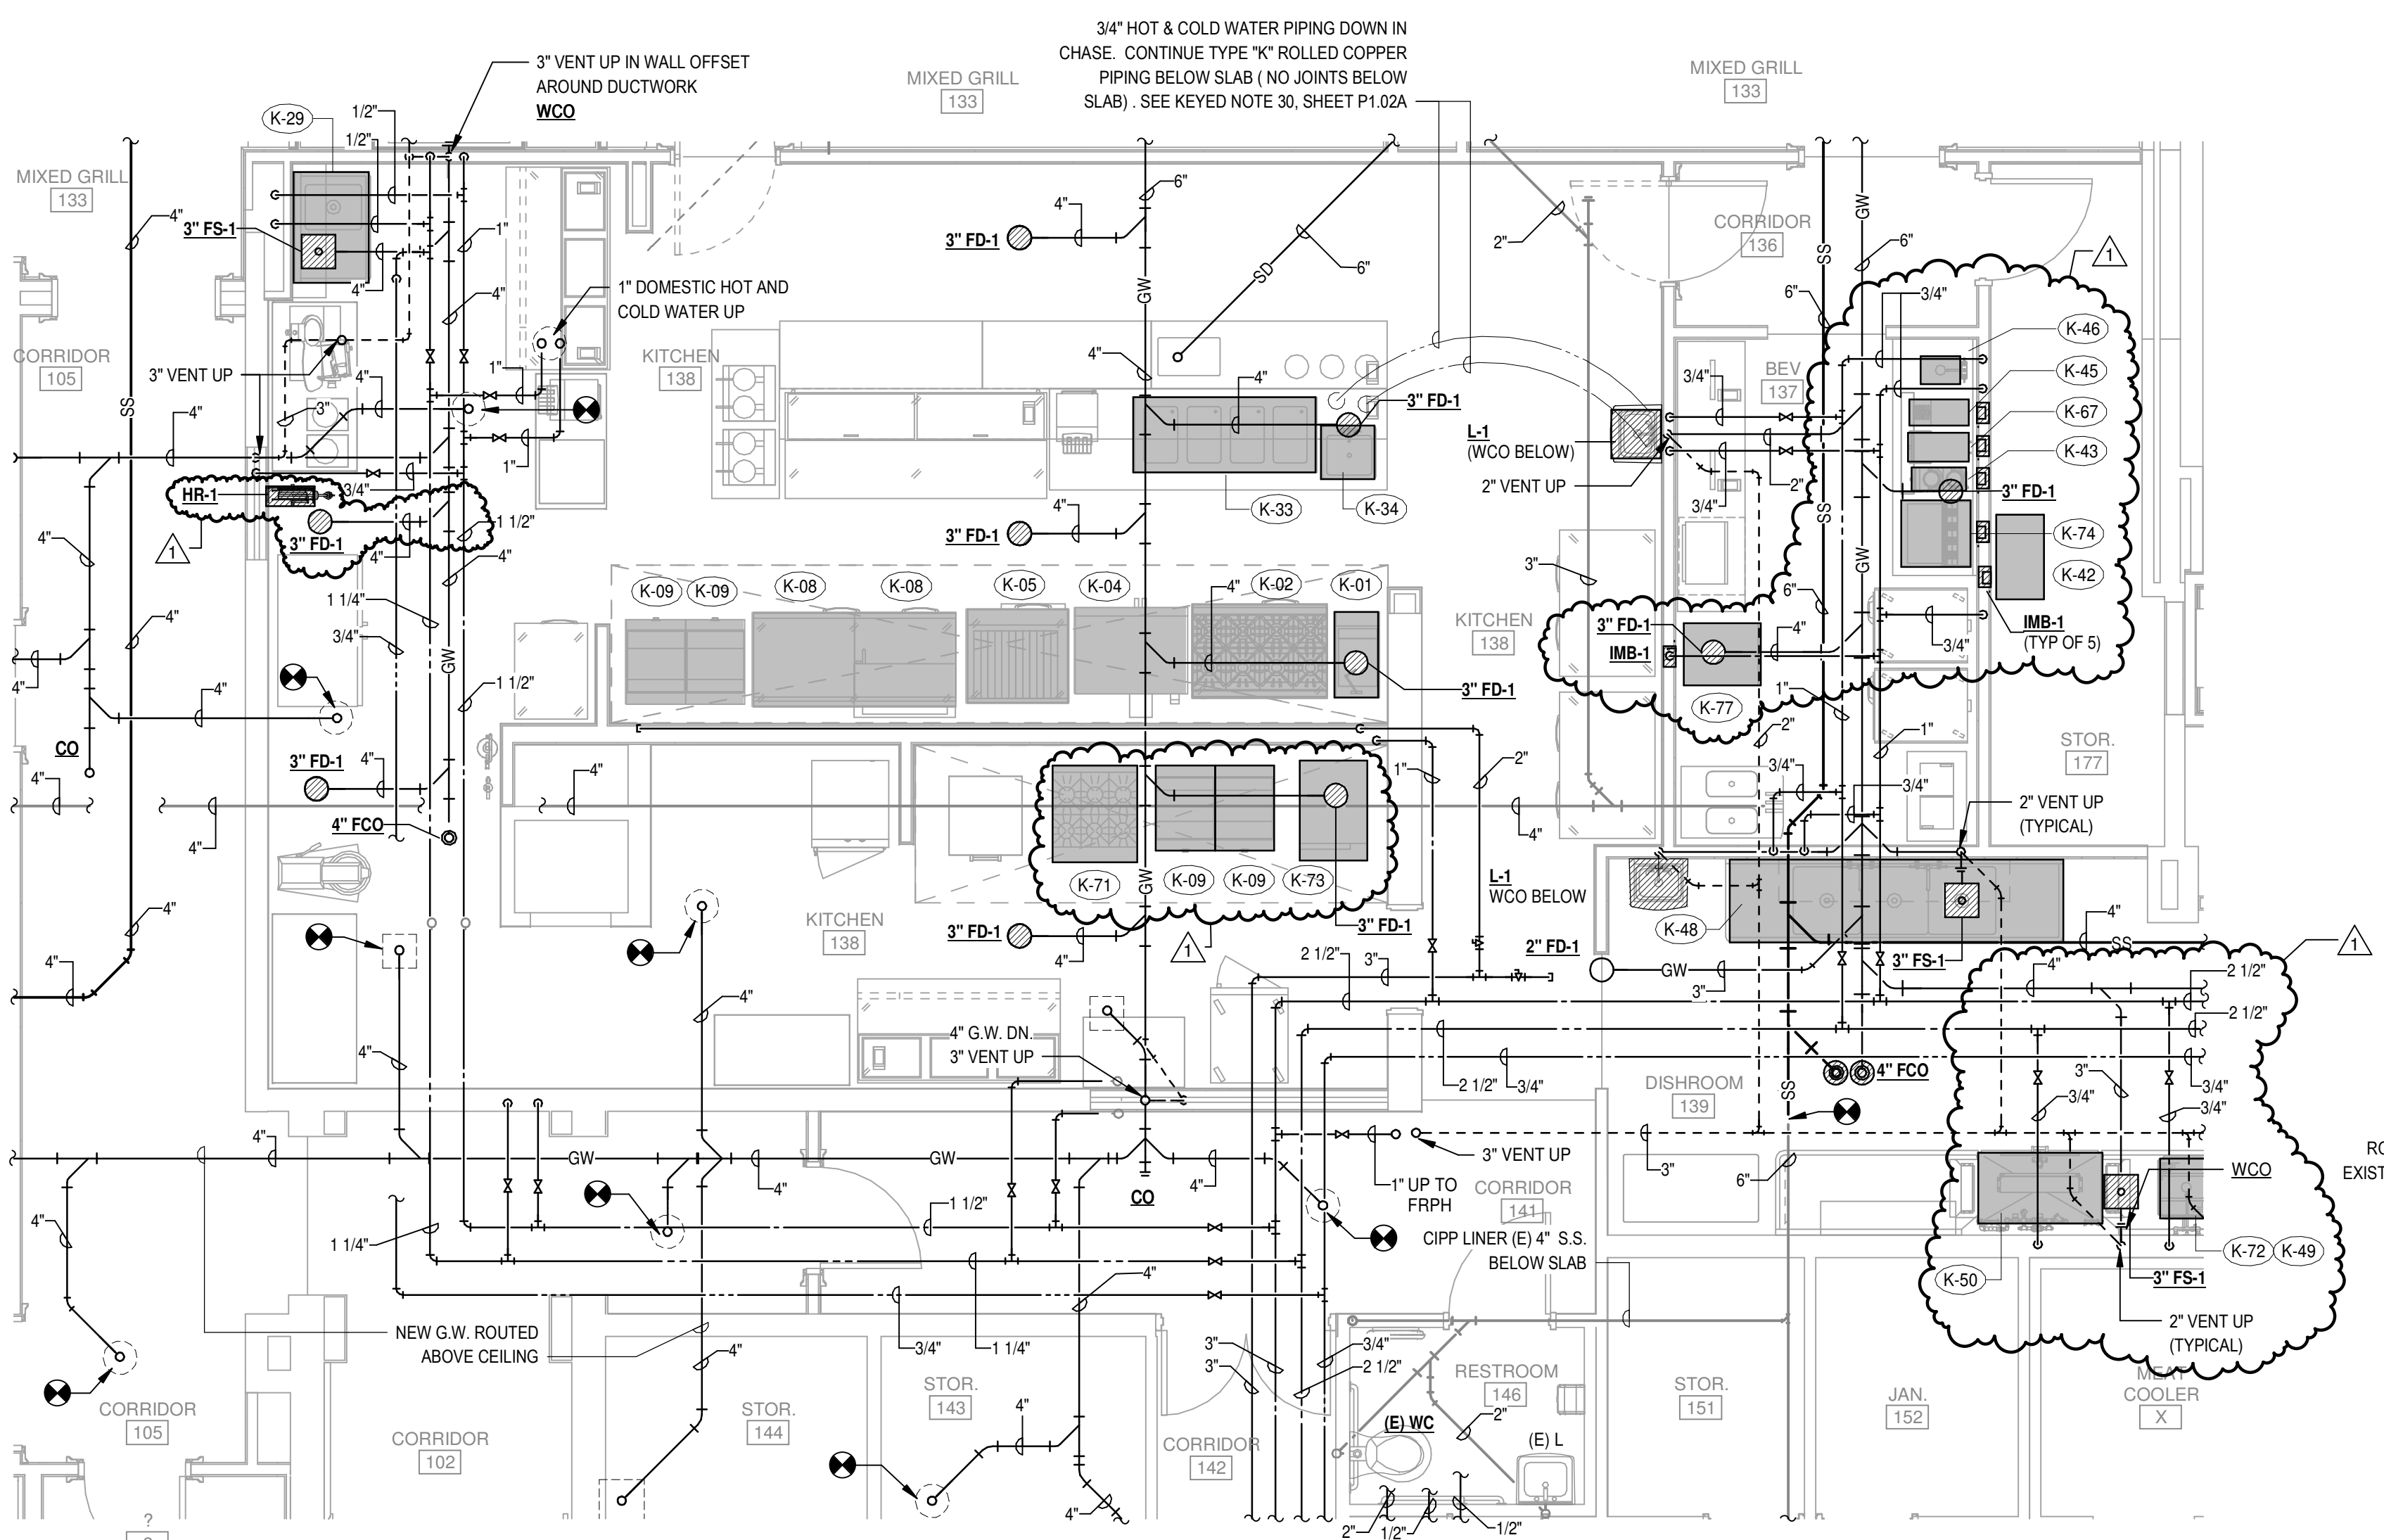

6 ENLARGED FLOOR PLAN - PLUMBING - (KITCHEN - 138)  
1/4" = 1'-0"

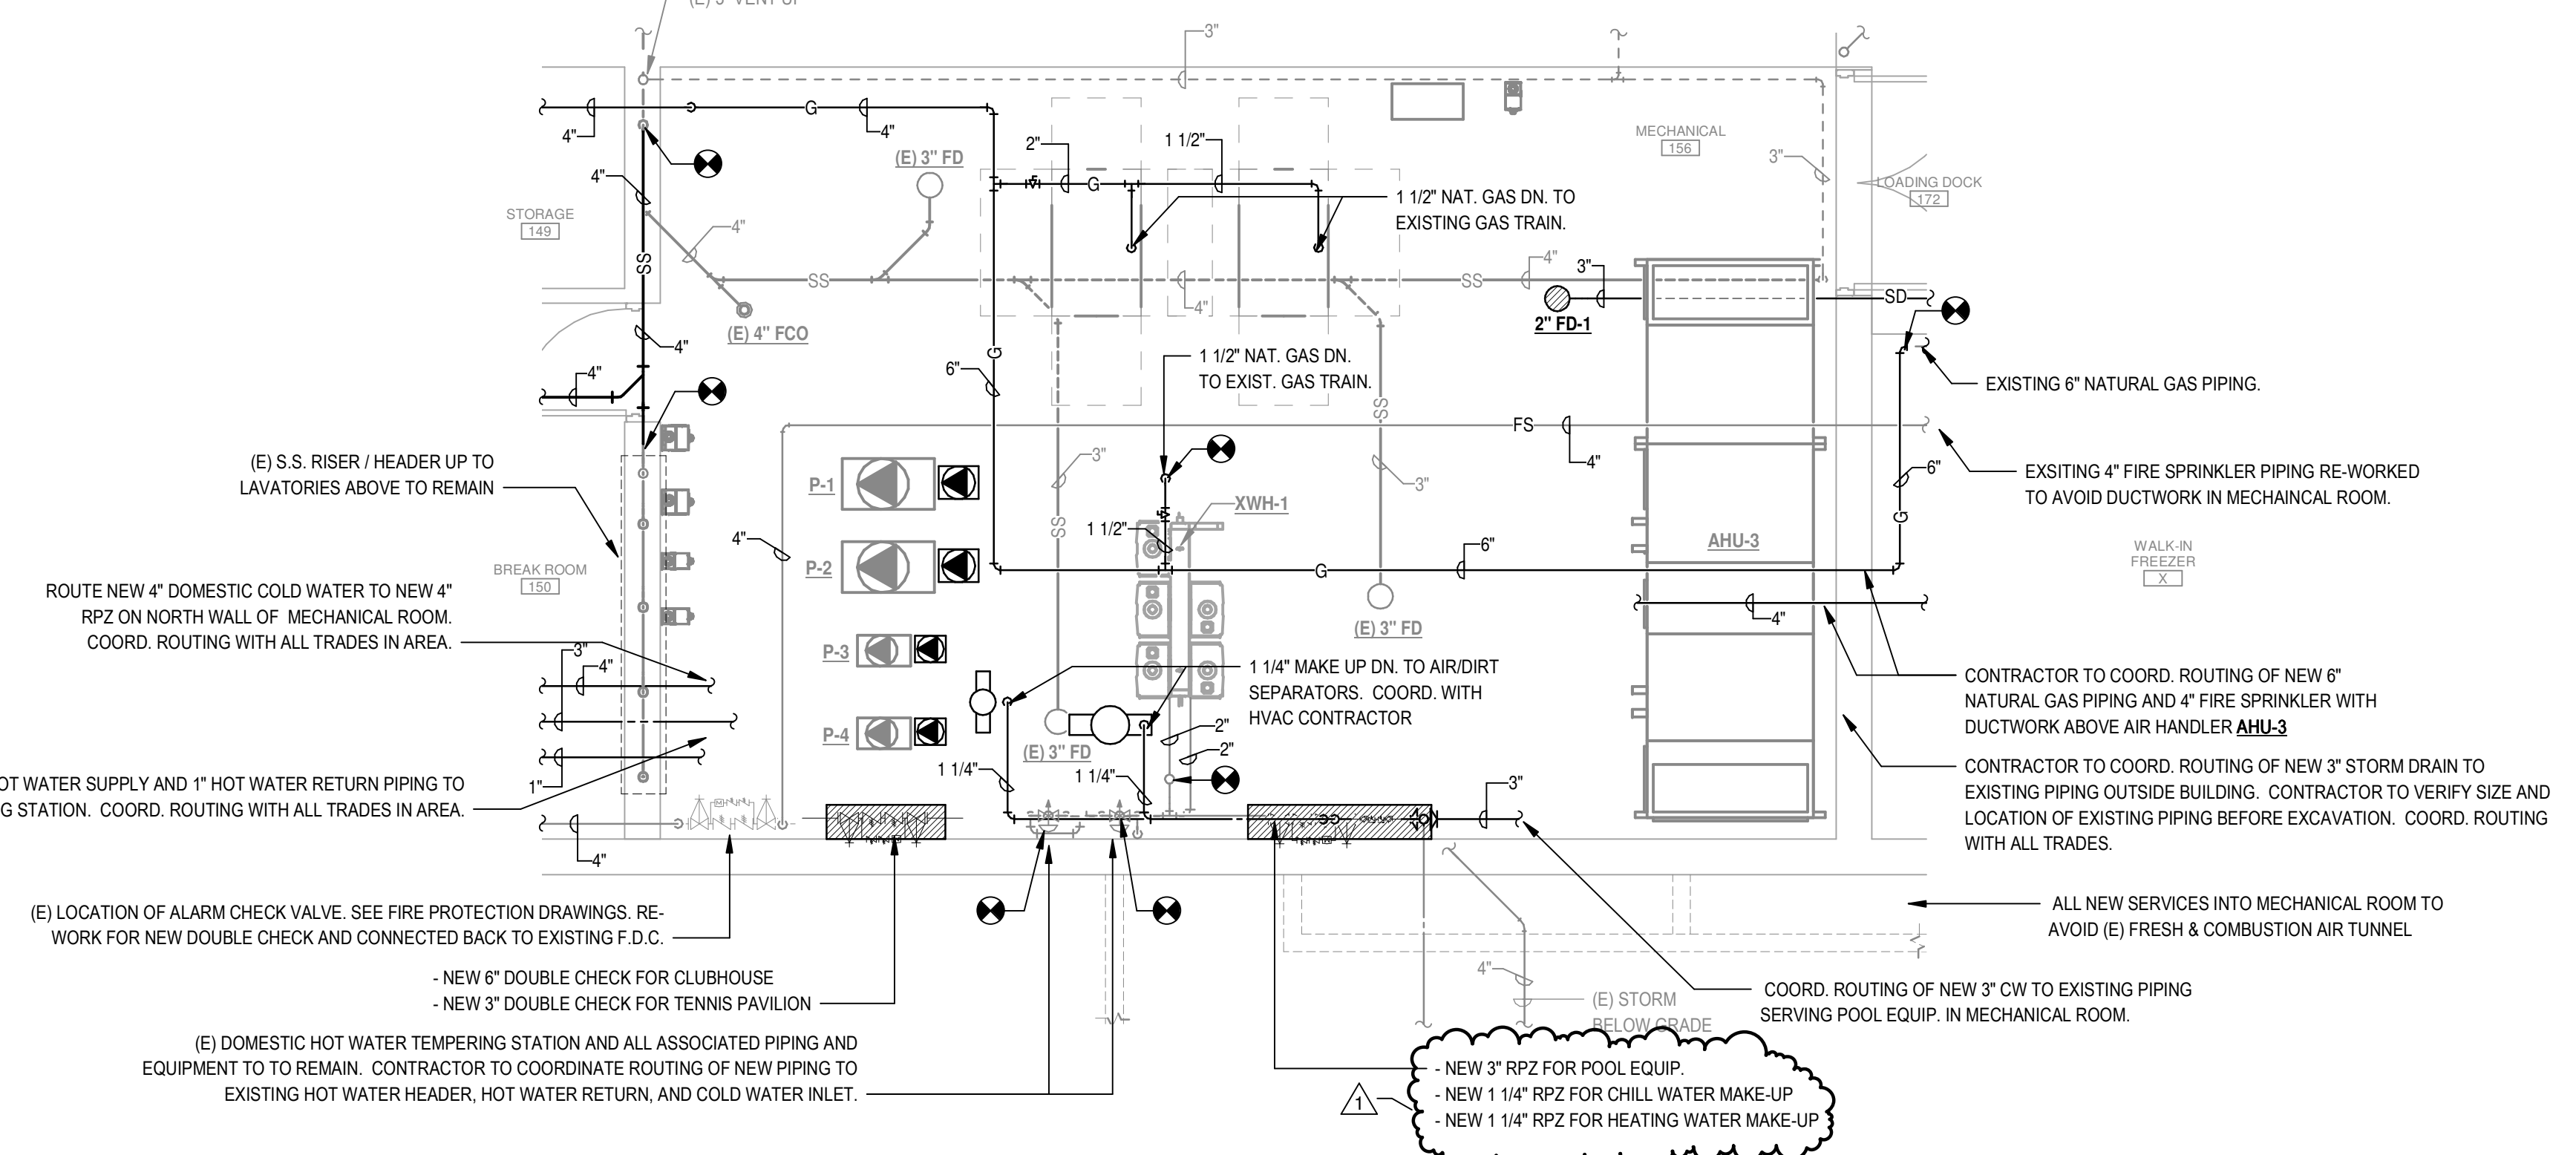

7 ENLARGED FLOOR PLAN - PLUMBING - (MECHANICAL ROOM - 156)  
1/4" = 1'-0"

ADDITION AND RENOVATION TO PLEASANT VALLEY COUNTRY CLUB

**CLUBHOUSE**

1 PLEASANT VALLEY DRIVE  
LITTLE ROCK, ARKANSAS 72212

REVISIONS		
1	ASI 05	08-25-23

PROJECT NO. 21075  
DATE: June 21, 2023

ENLARGED PLAN - PLUMBING

P1.05-A