




PERMIT SET

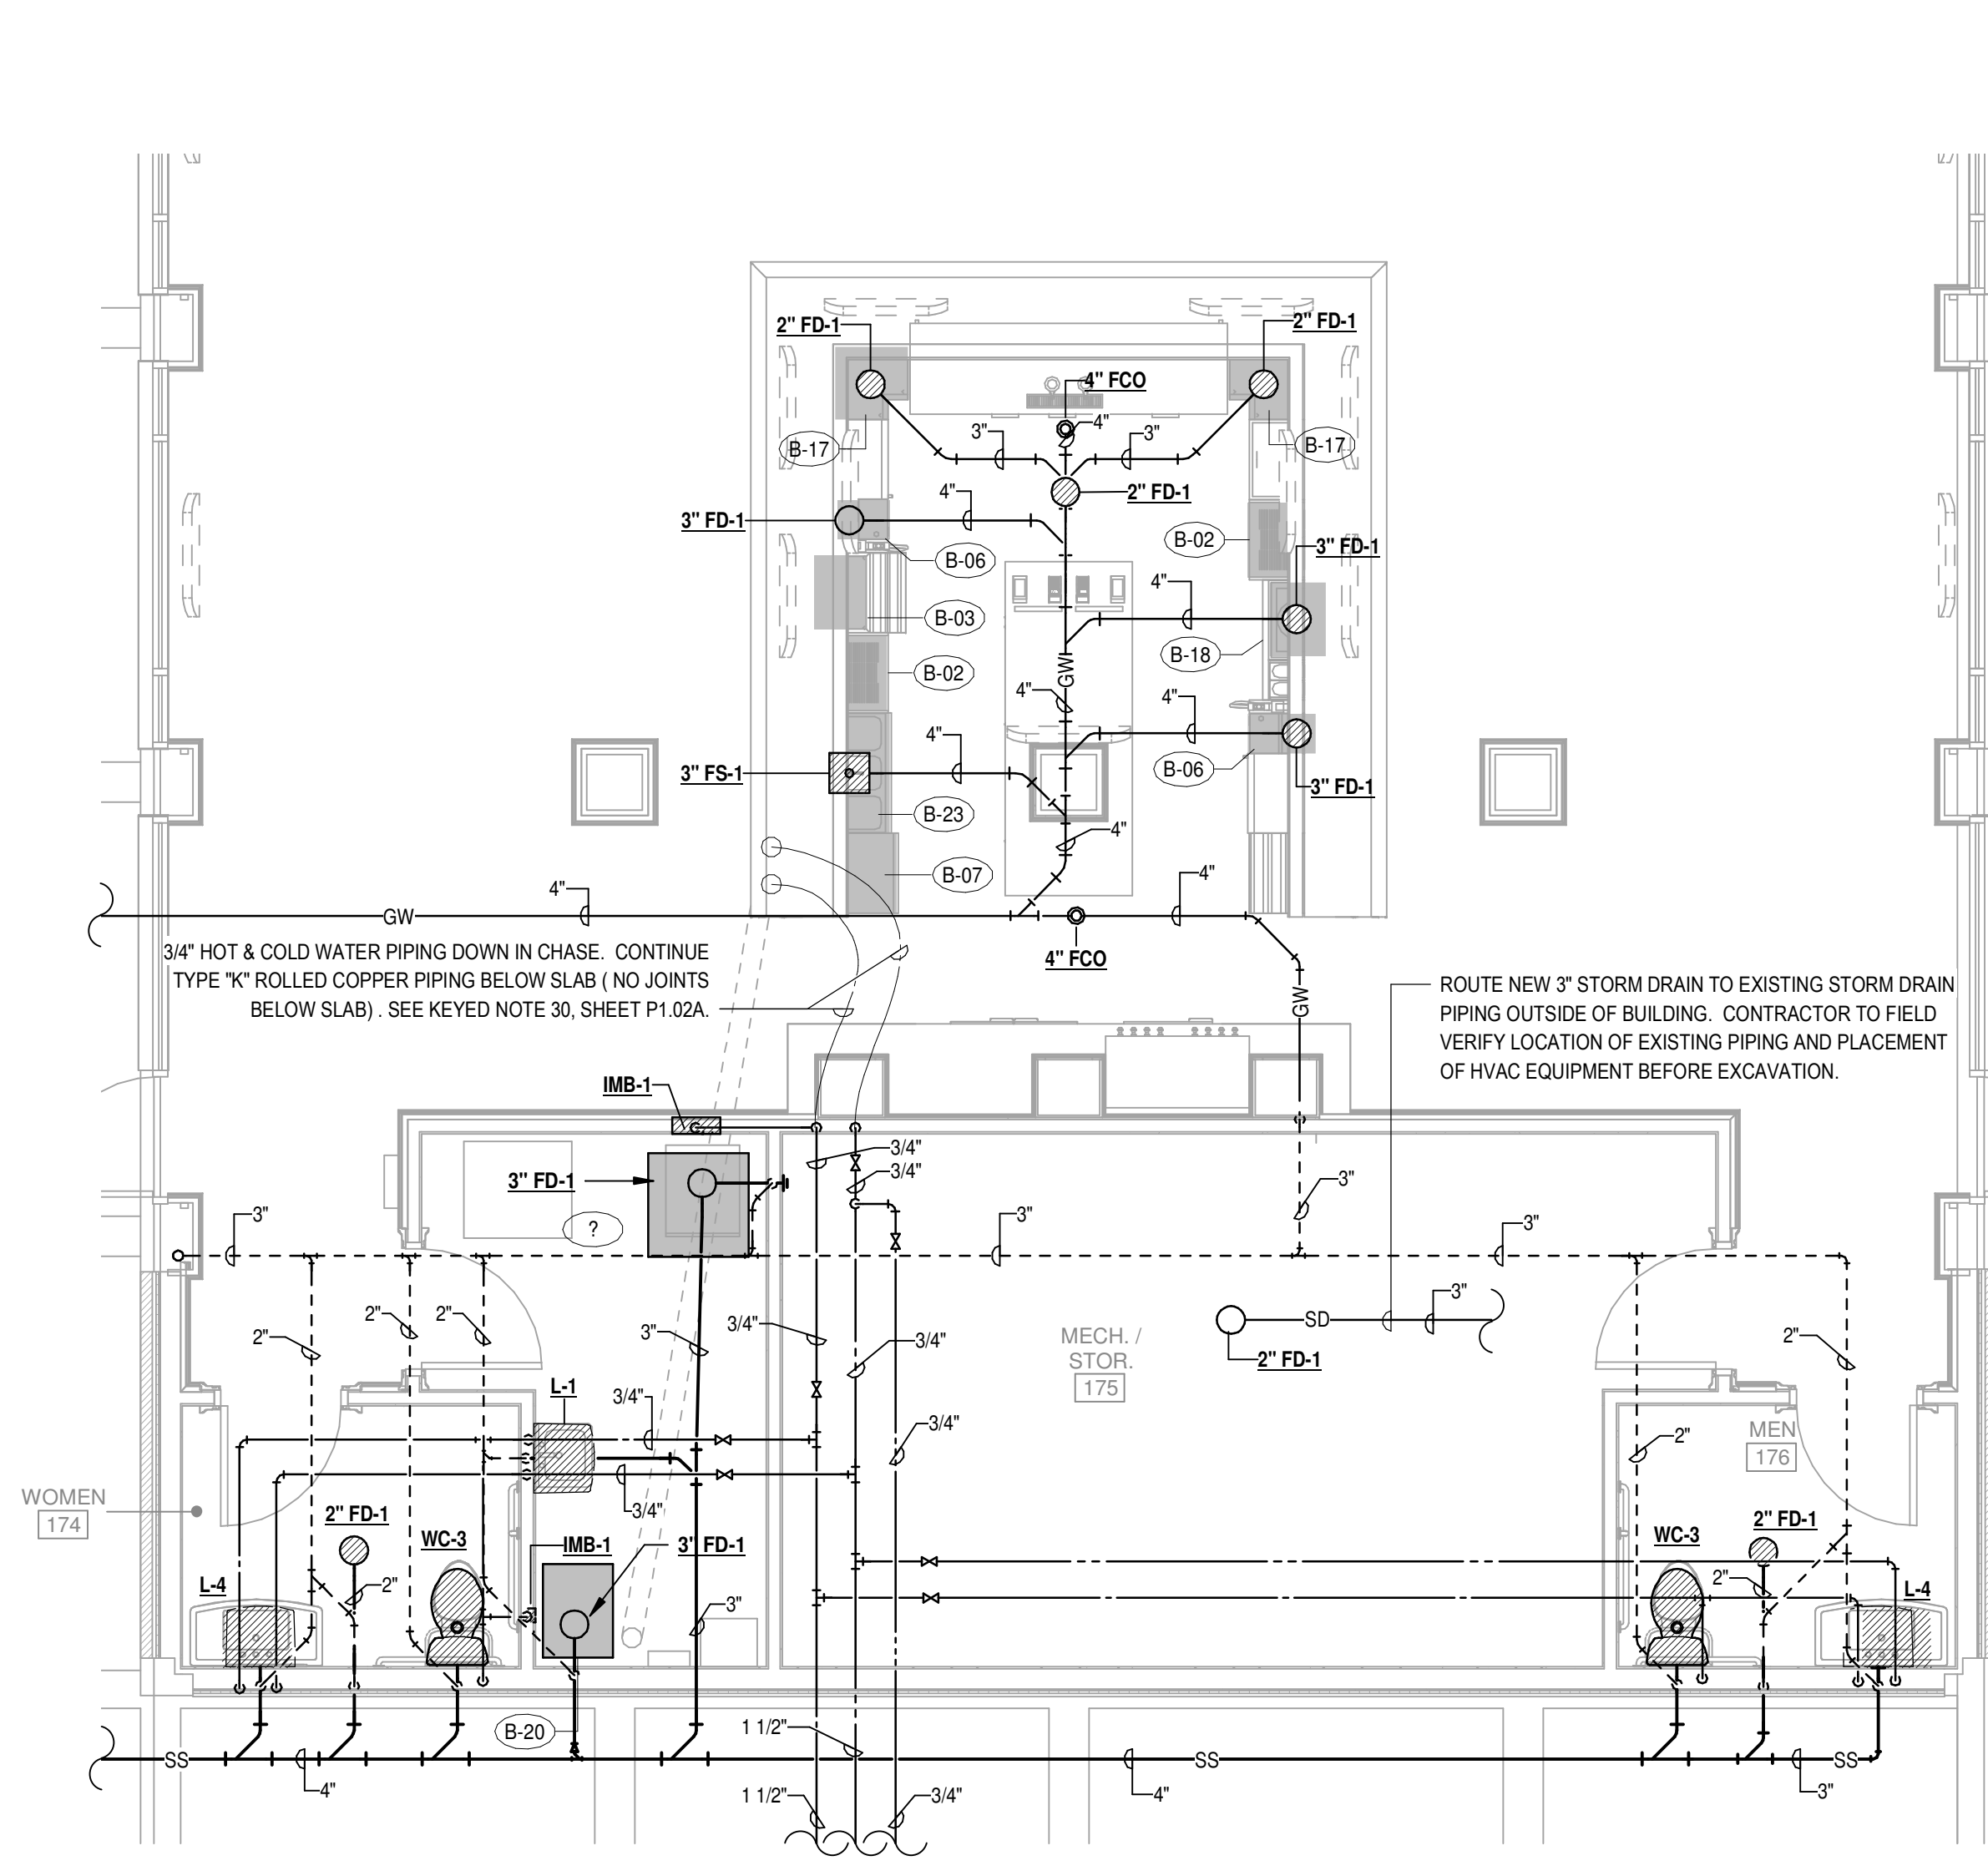


1 ENLARGED PLAN VIEW - PLUMBING - (BAR & RR)
1/4" = 1'-0"

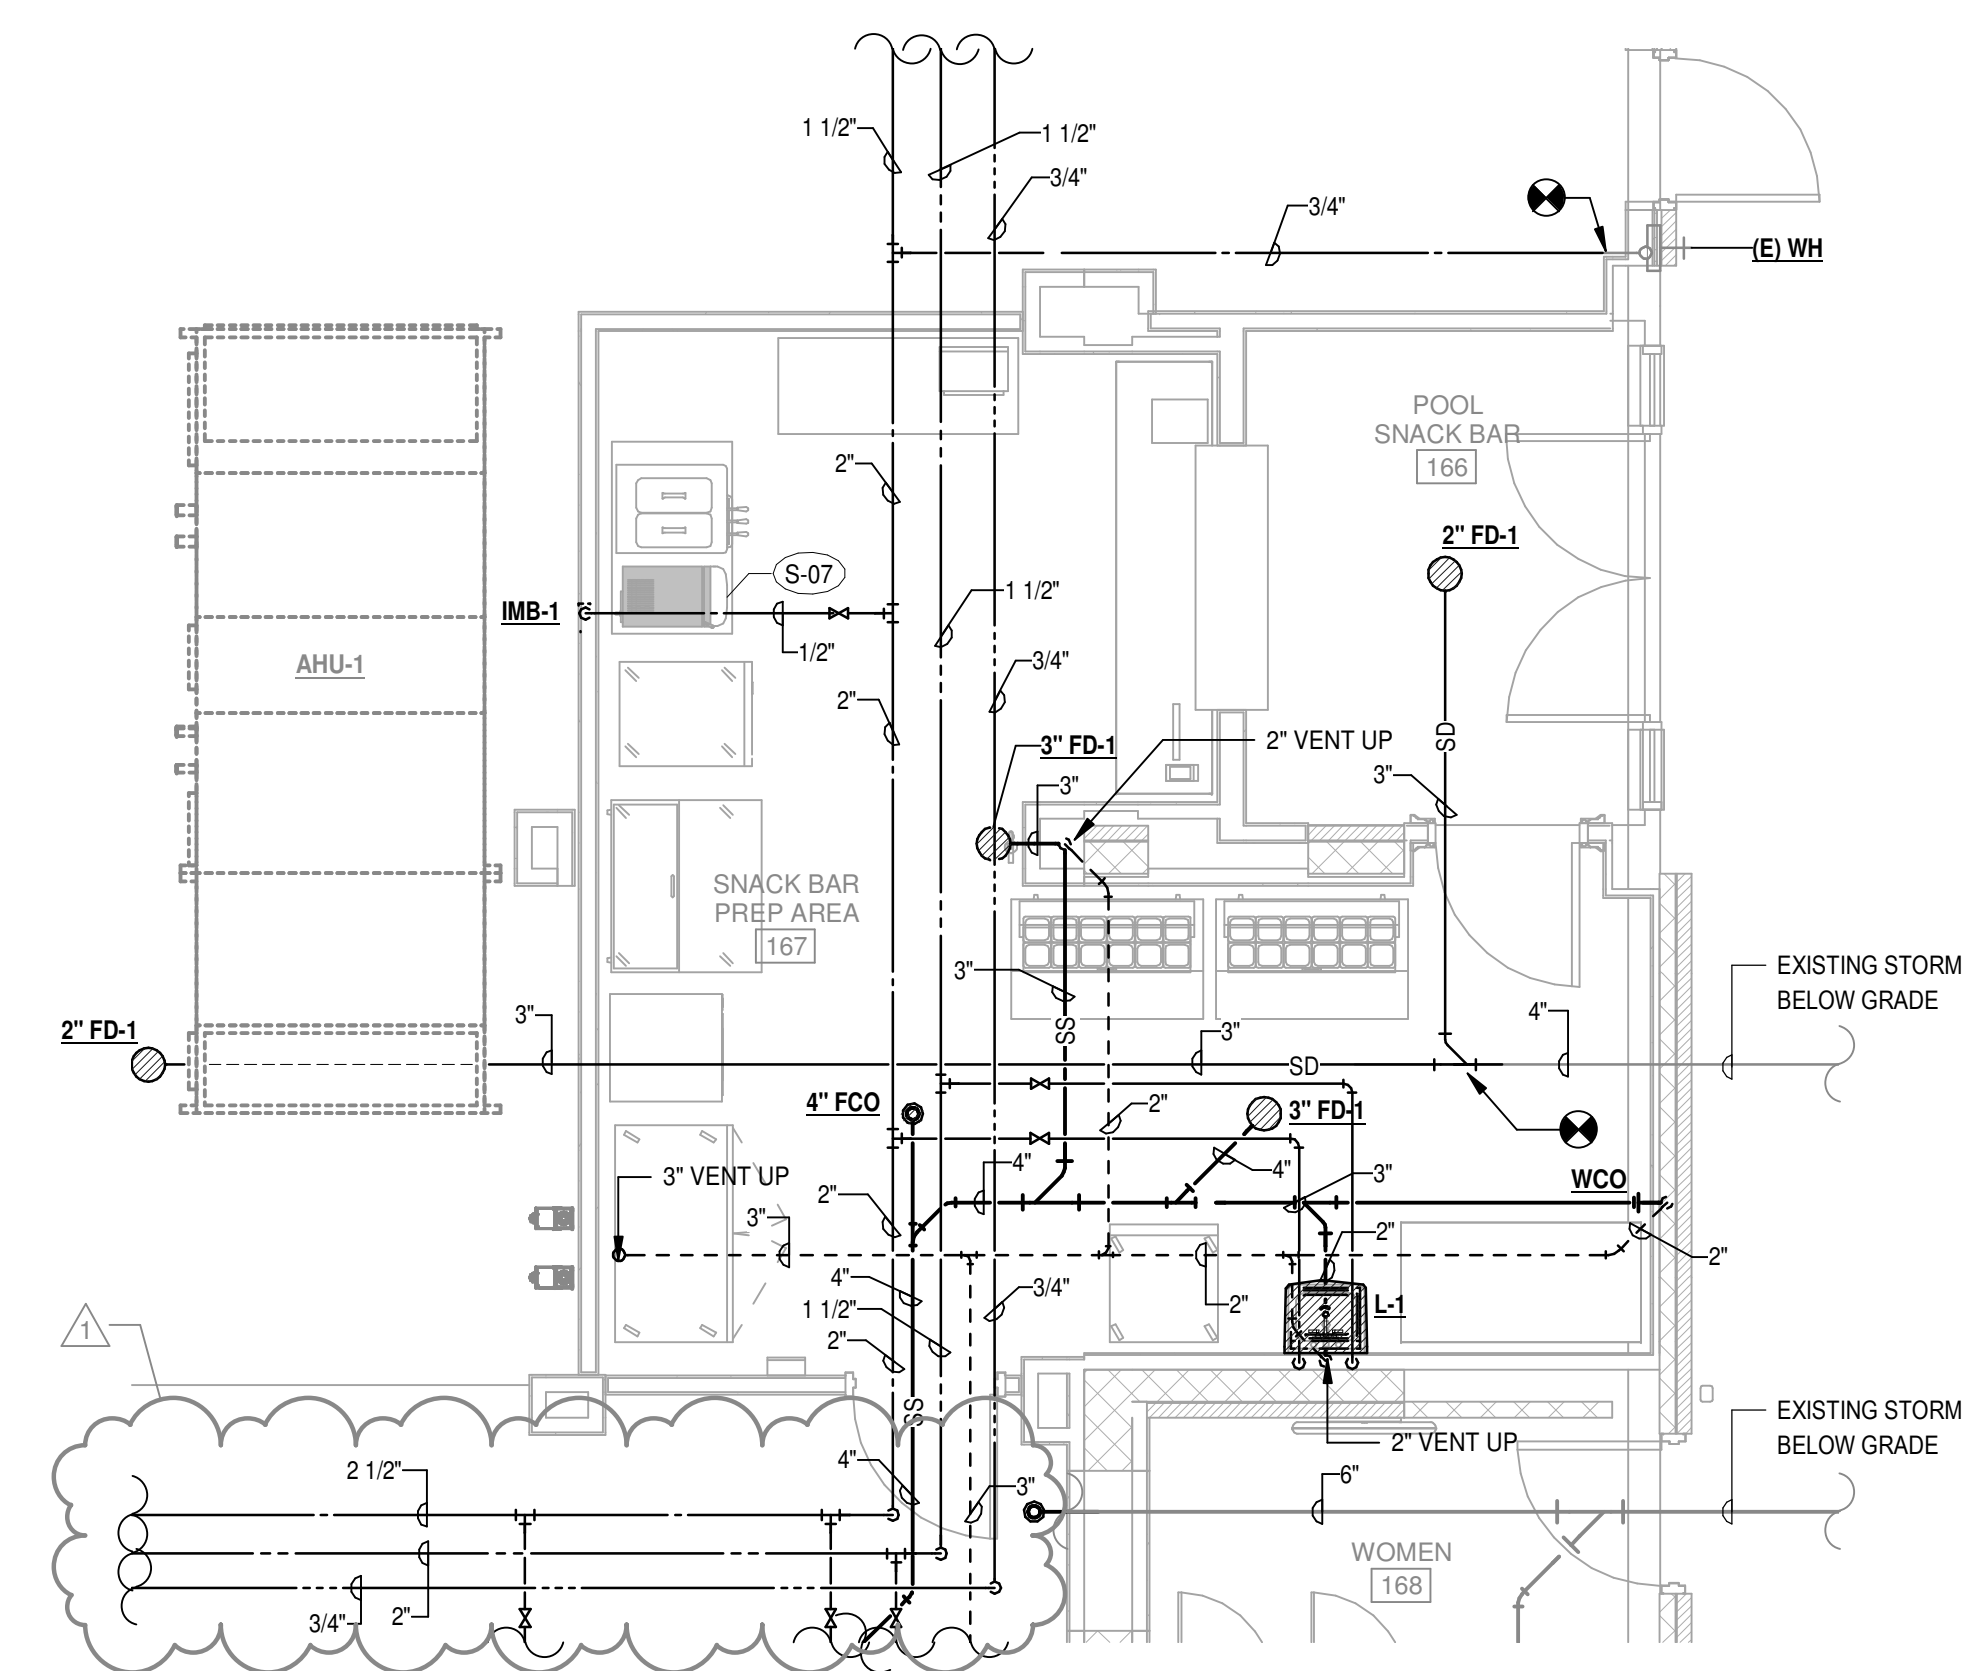


2 ENLARGED PLAN VIEW - PLUMBING - (SNACK BAR)
1/4" = 1'-0"

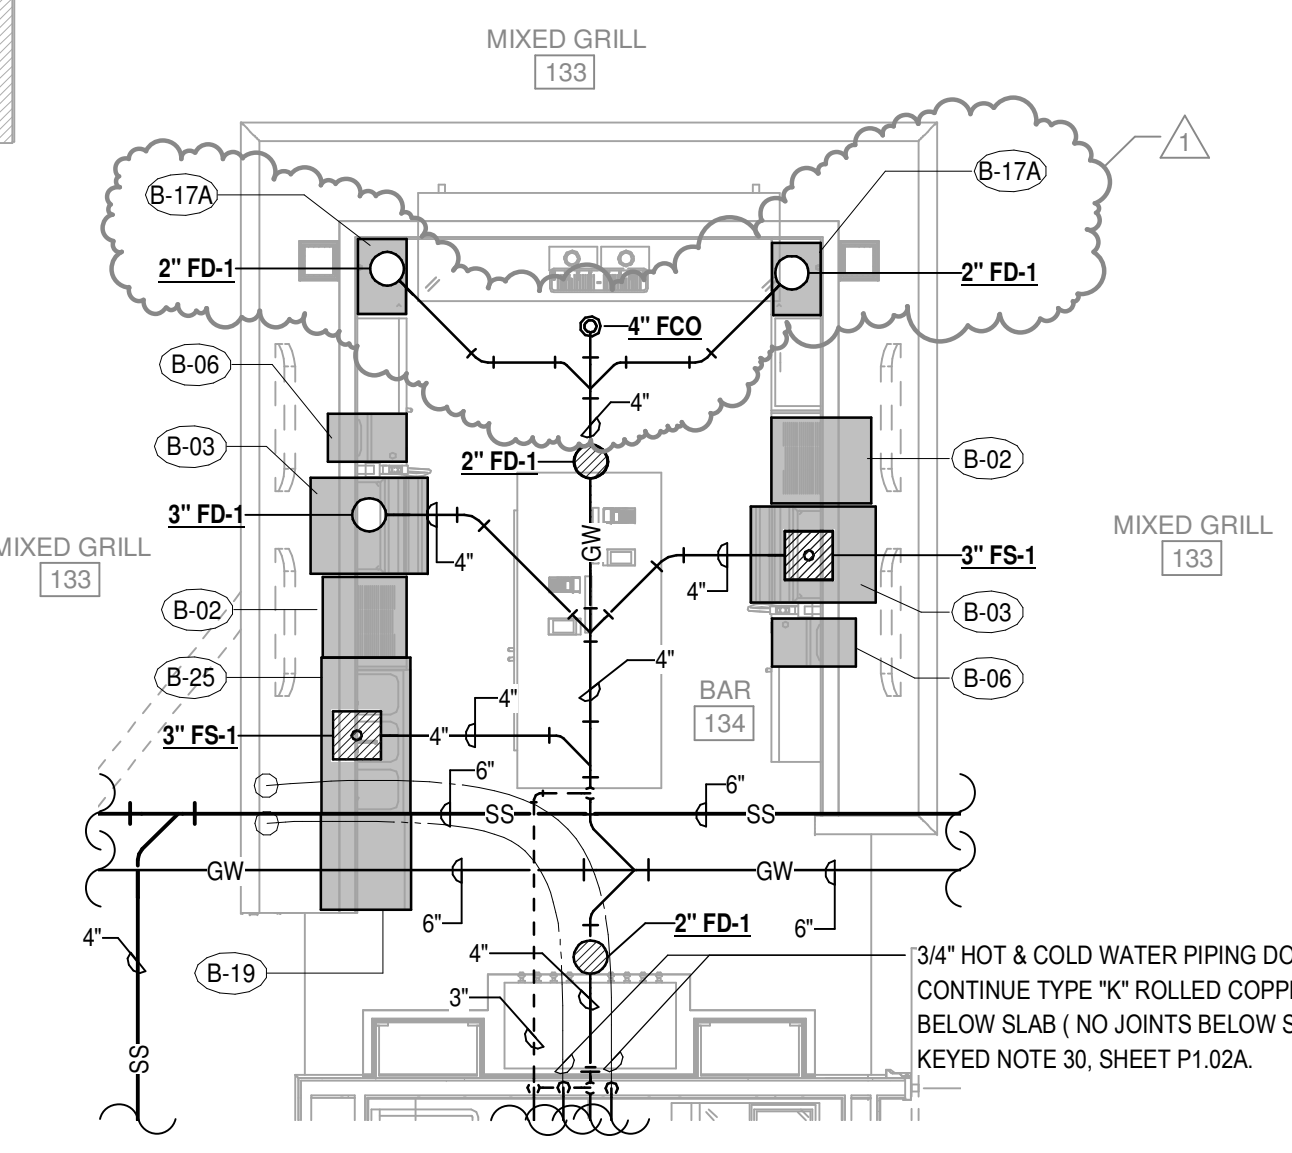


3 ENLARGED FLOOR PLAN - PLUMBING - (BAR - 134)
1/4" = 1'-0"

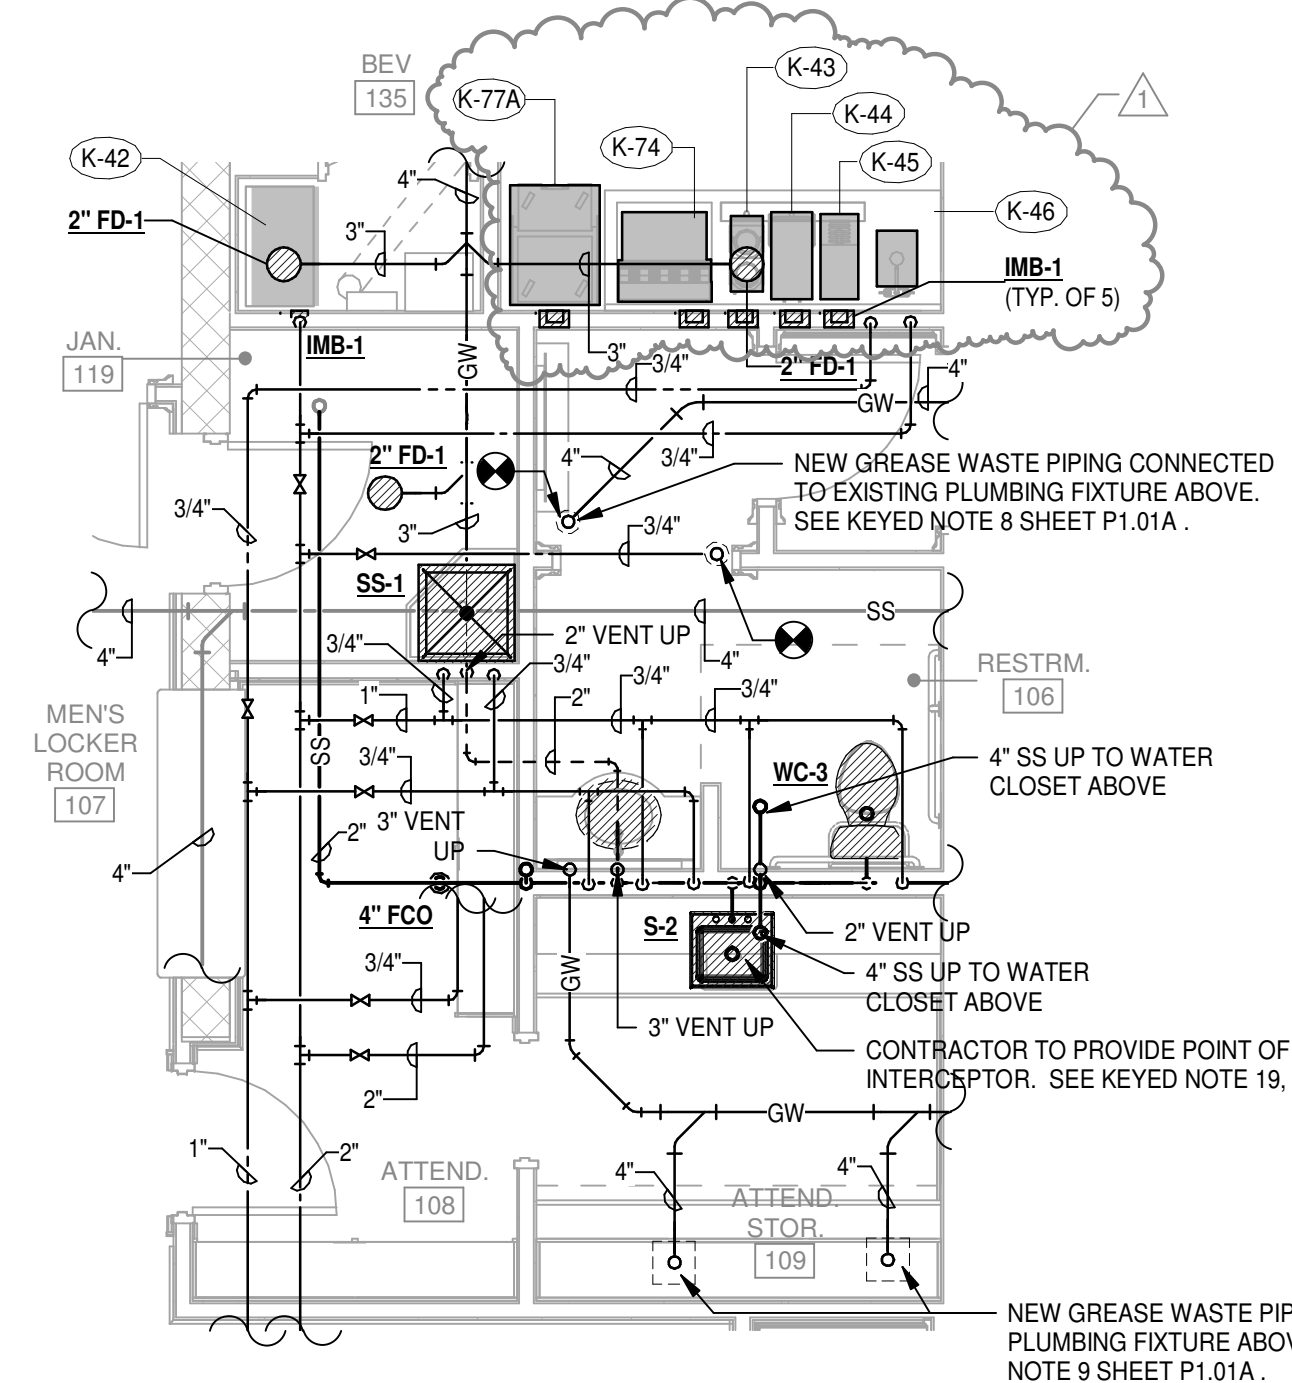


4 ENLARGED FLOOR PLAN - PLUMBING - (RR - 106)
1/4" = 1'-0"

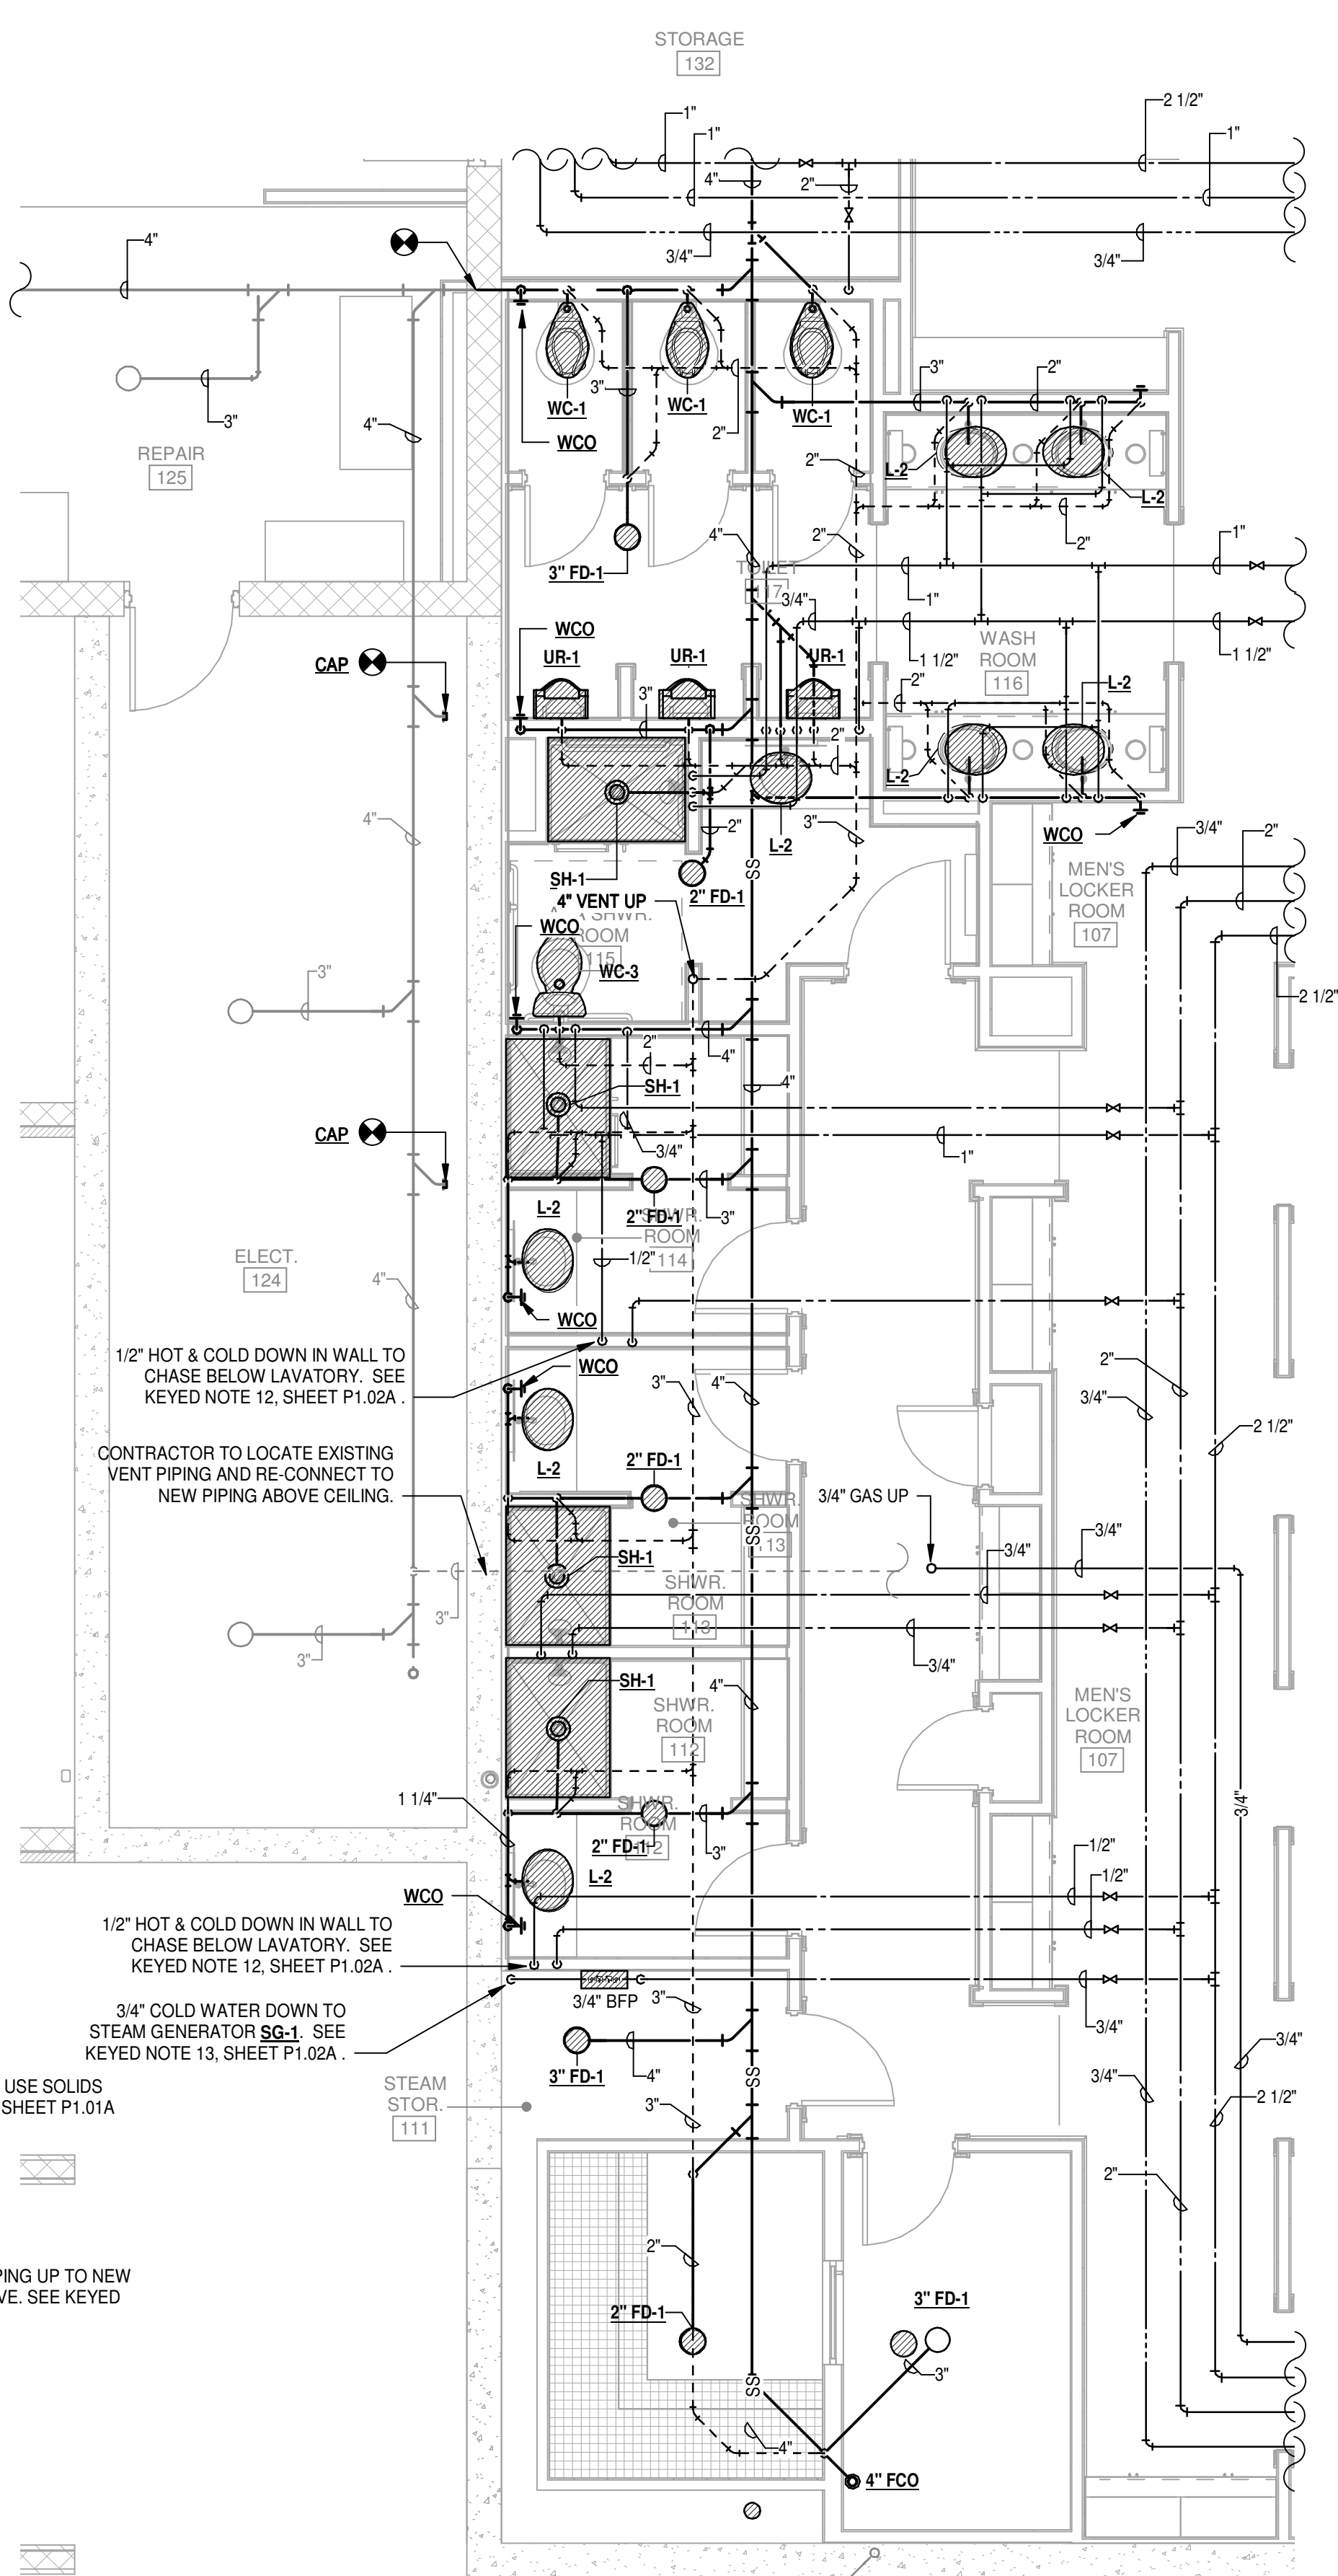

5 ENLARGED PLAN VIEW - PLUMBING - (MEN'S LOCKER ROOM AREA)
1/4" = 1'-0"

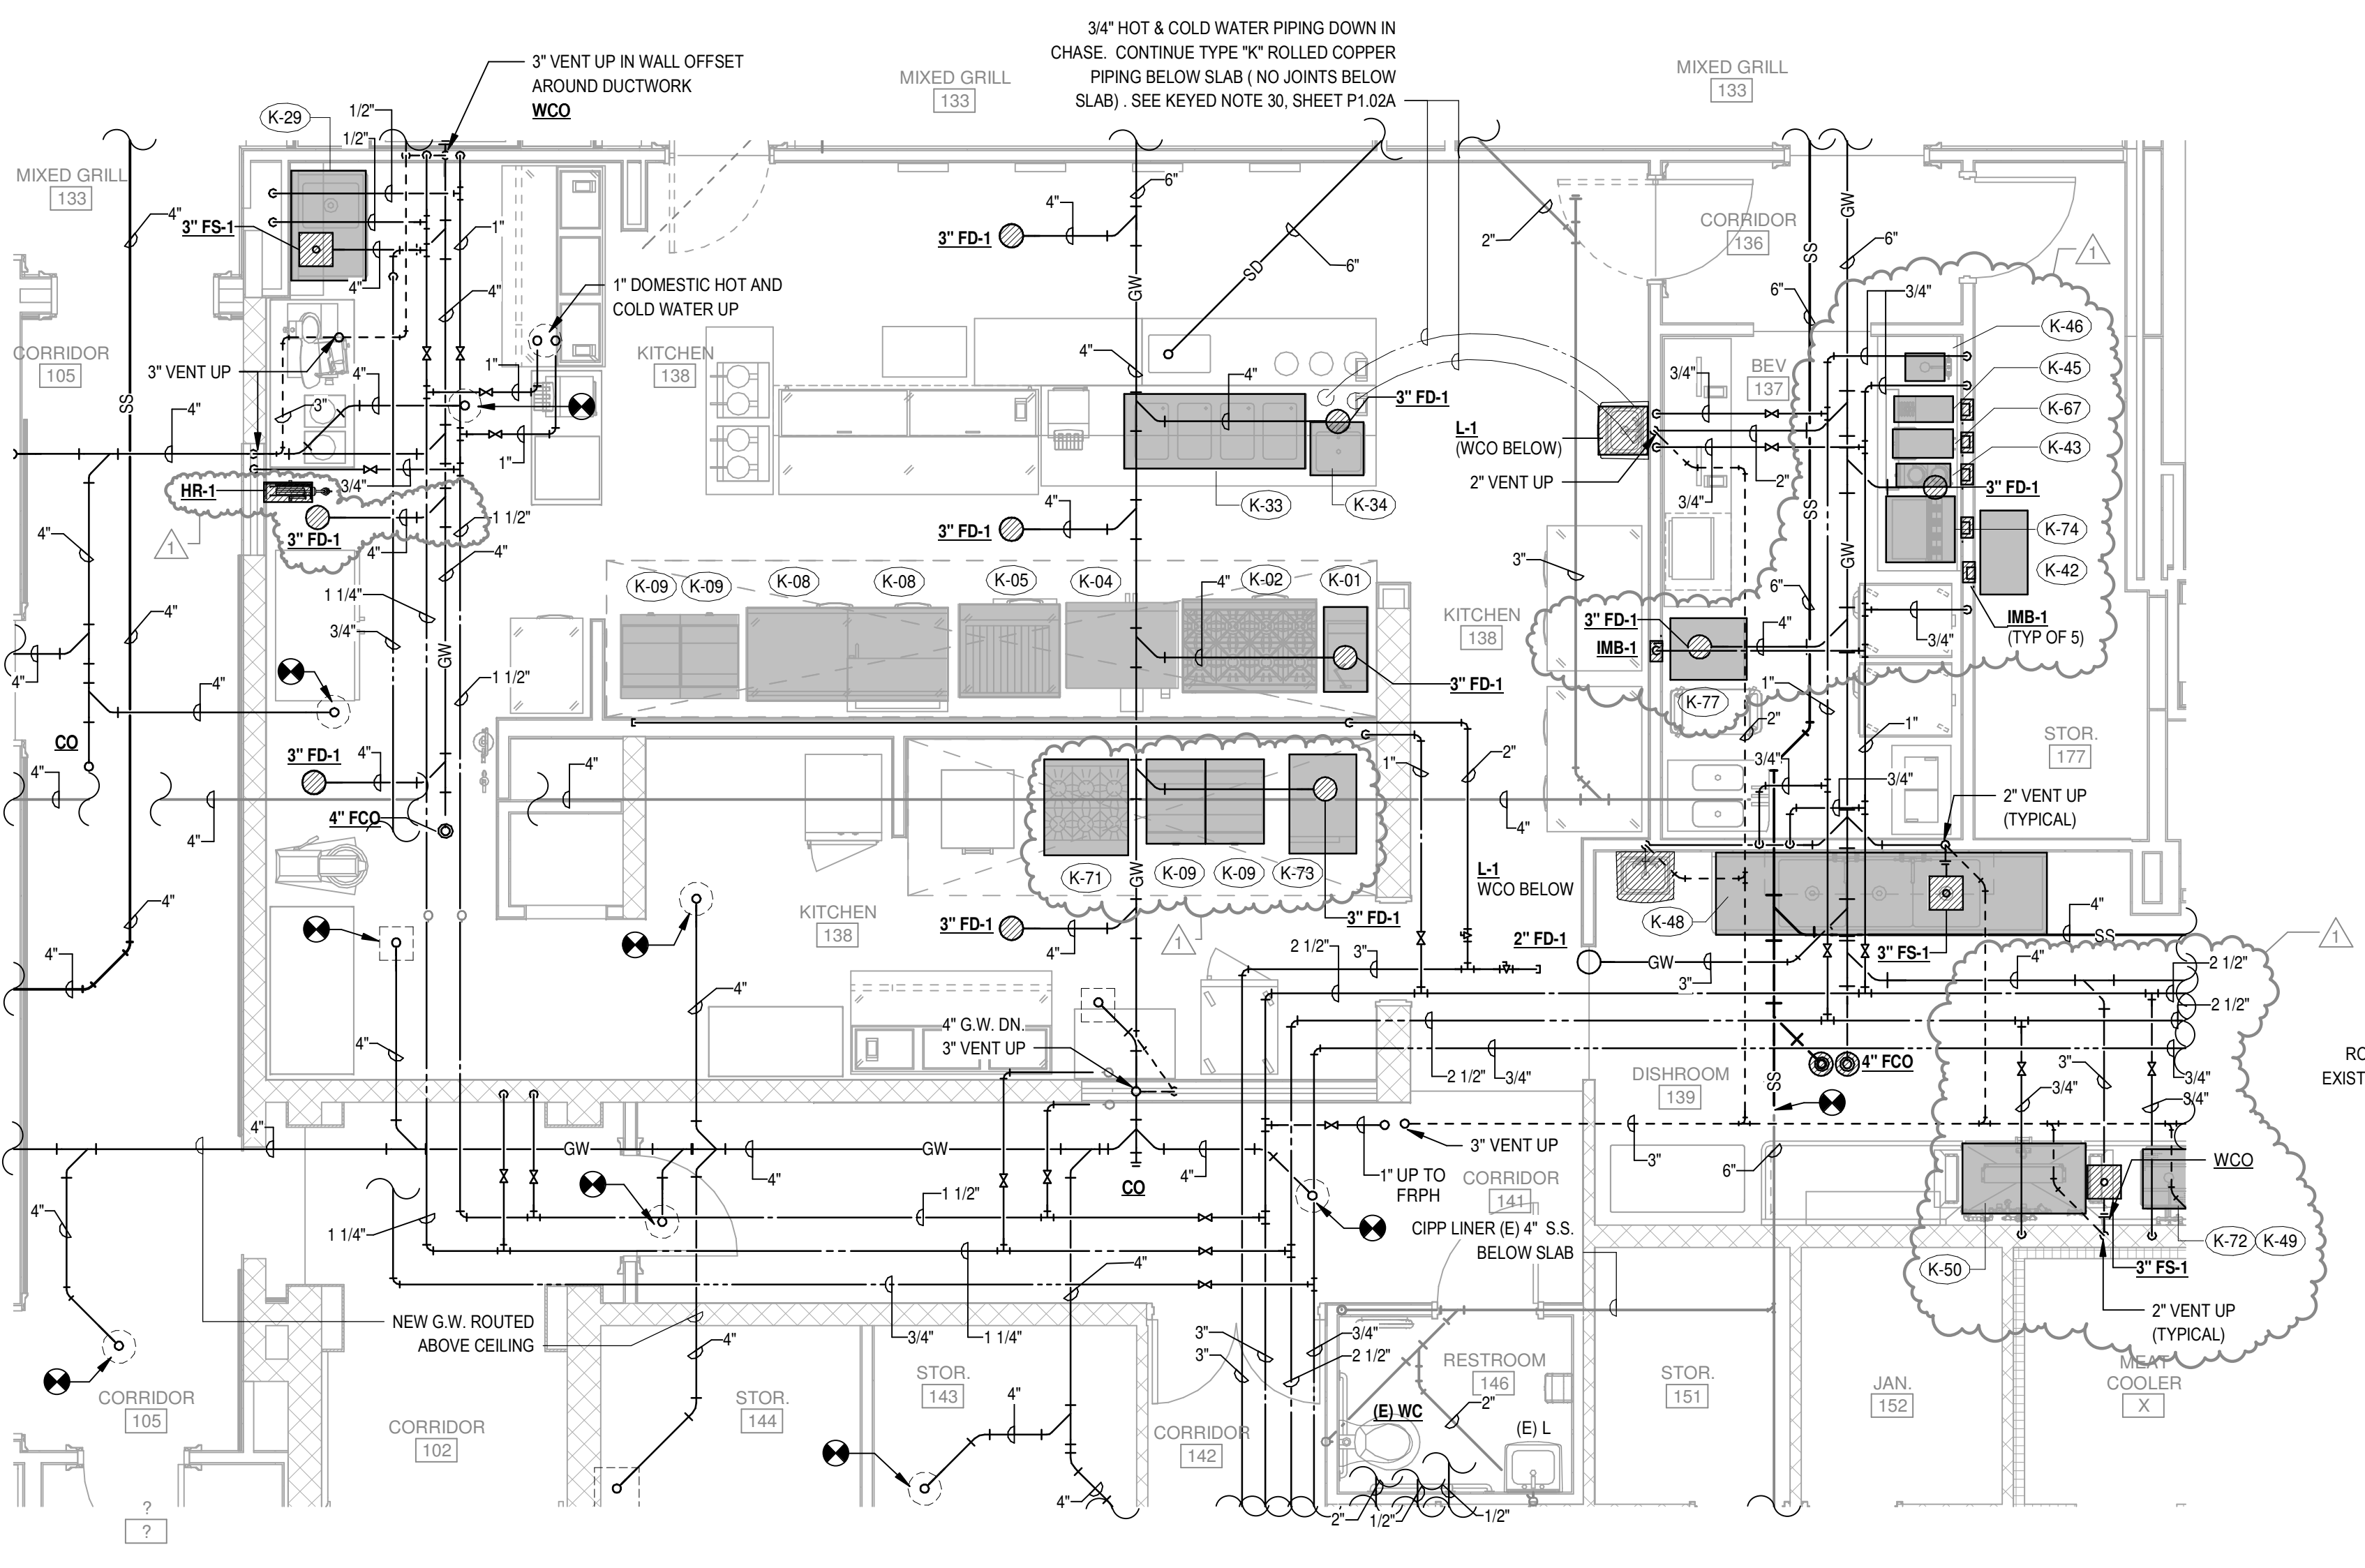

6 ENLARGED FLOOR PLAN - PLUMBING - (KITCHEN - 138)
1/4" = 1'-0"

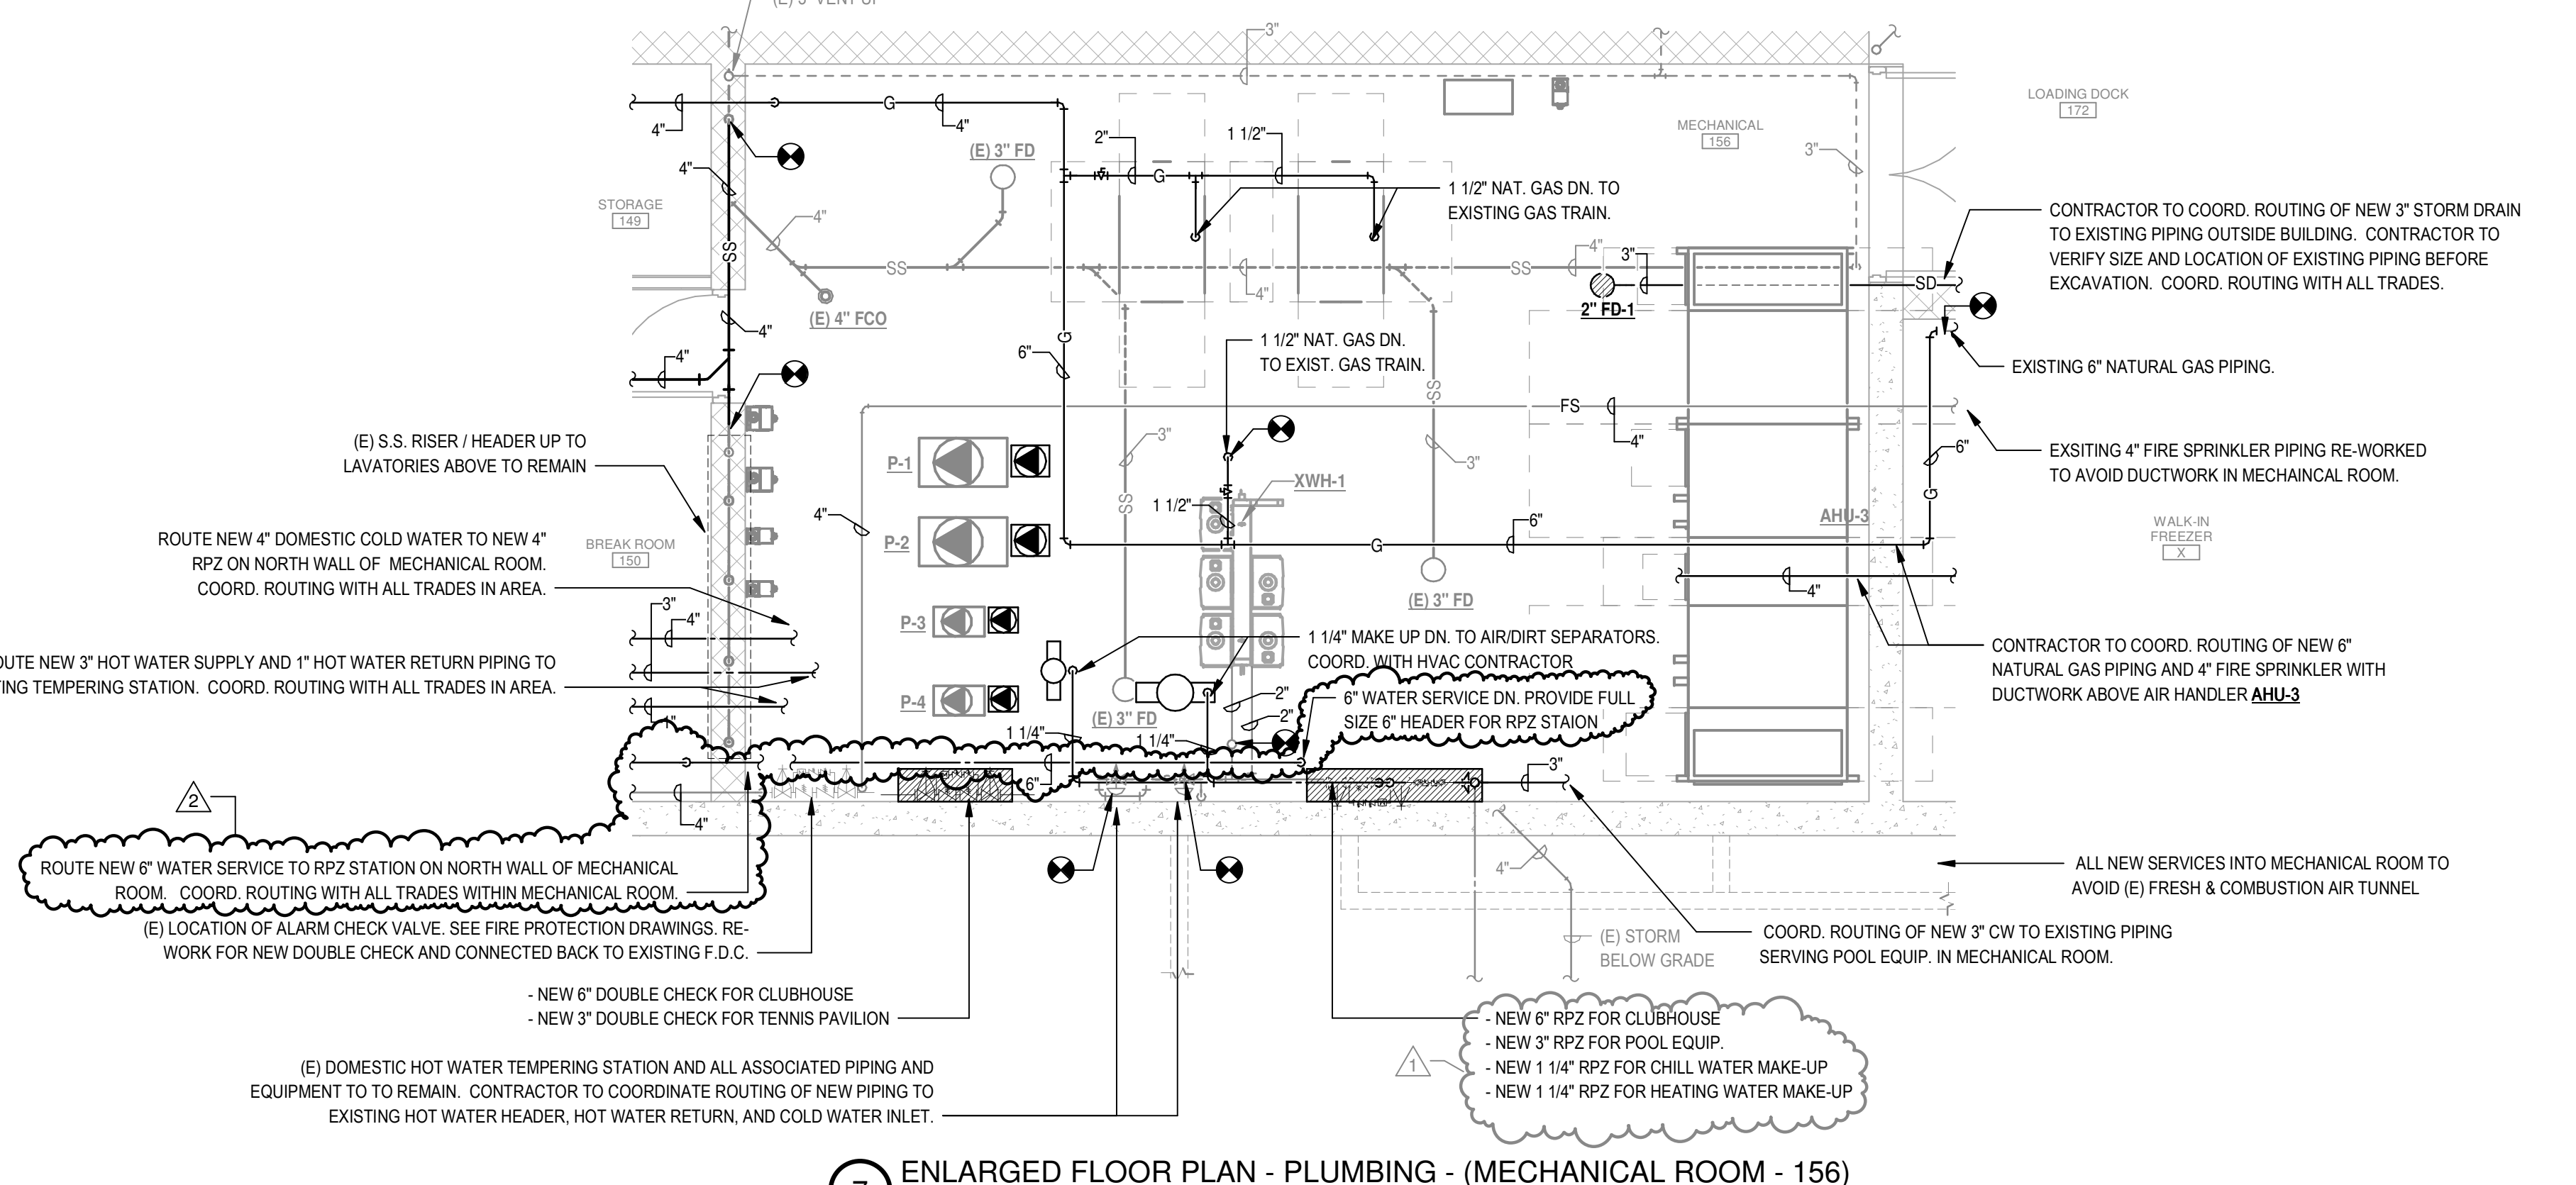

7 ENLARGED FLOOR PLAN - PLUMBING - (MECHANICAL ROOM - 156)
1/4" = 1'-0"

ADDITION AND RENOVATION TO PLEASANT VALLEY COUNTRY CLUB

CLUBHOUSE

1 PLEASANT VALLEY DRIVE
LITTLE ROCK, ARKANSAS 72212

REVISIONS		
1	ASI 05	08-25-23
2	RFP 03	11-16-23

PROJECT NO. 21075
DATE: June 21, 2023

ENLARGED PLAN - PLUMBING

P1.05-A