
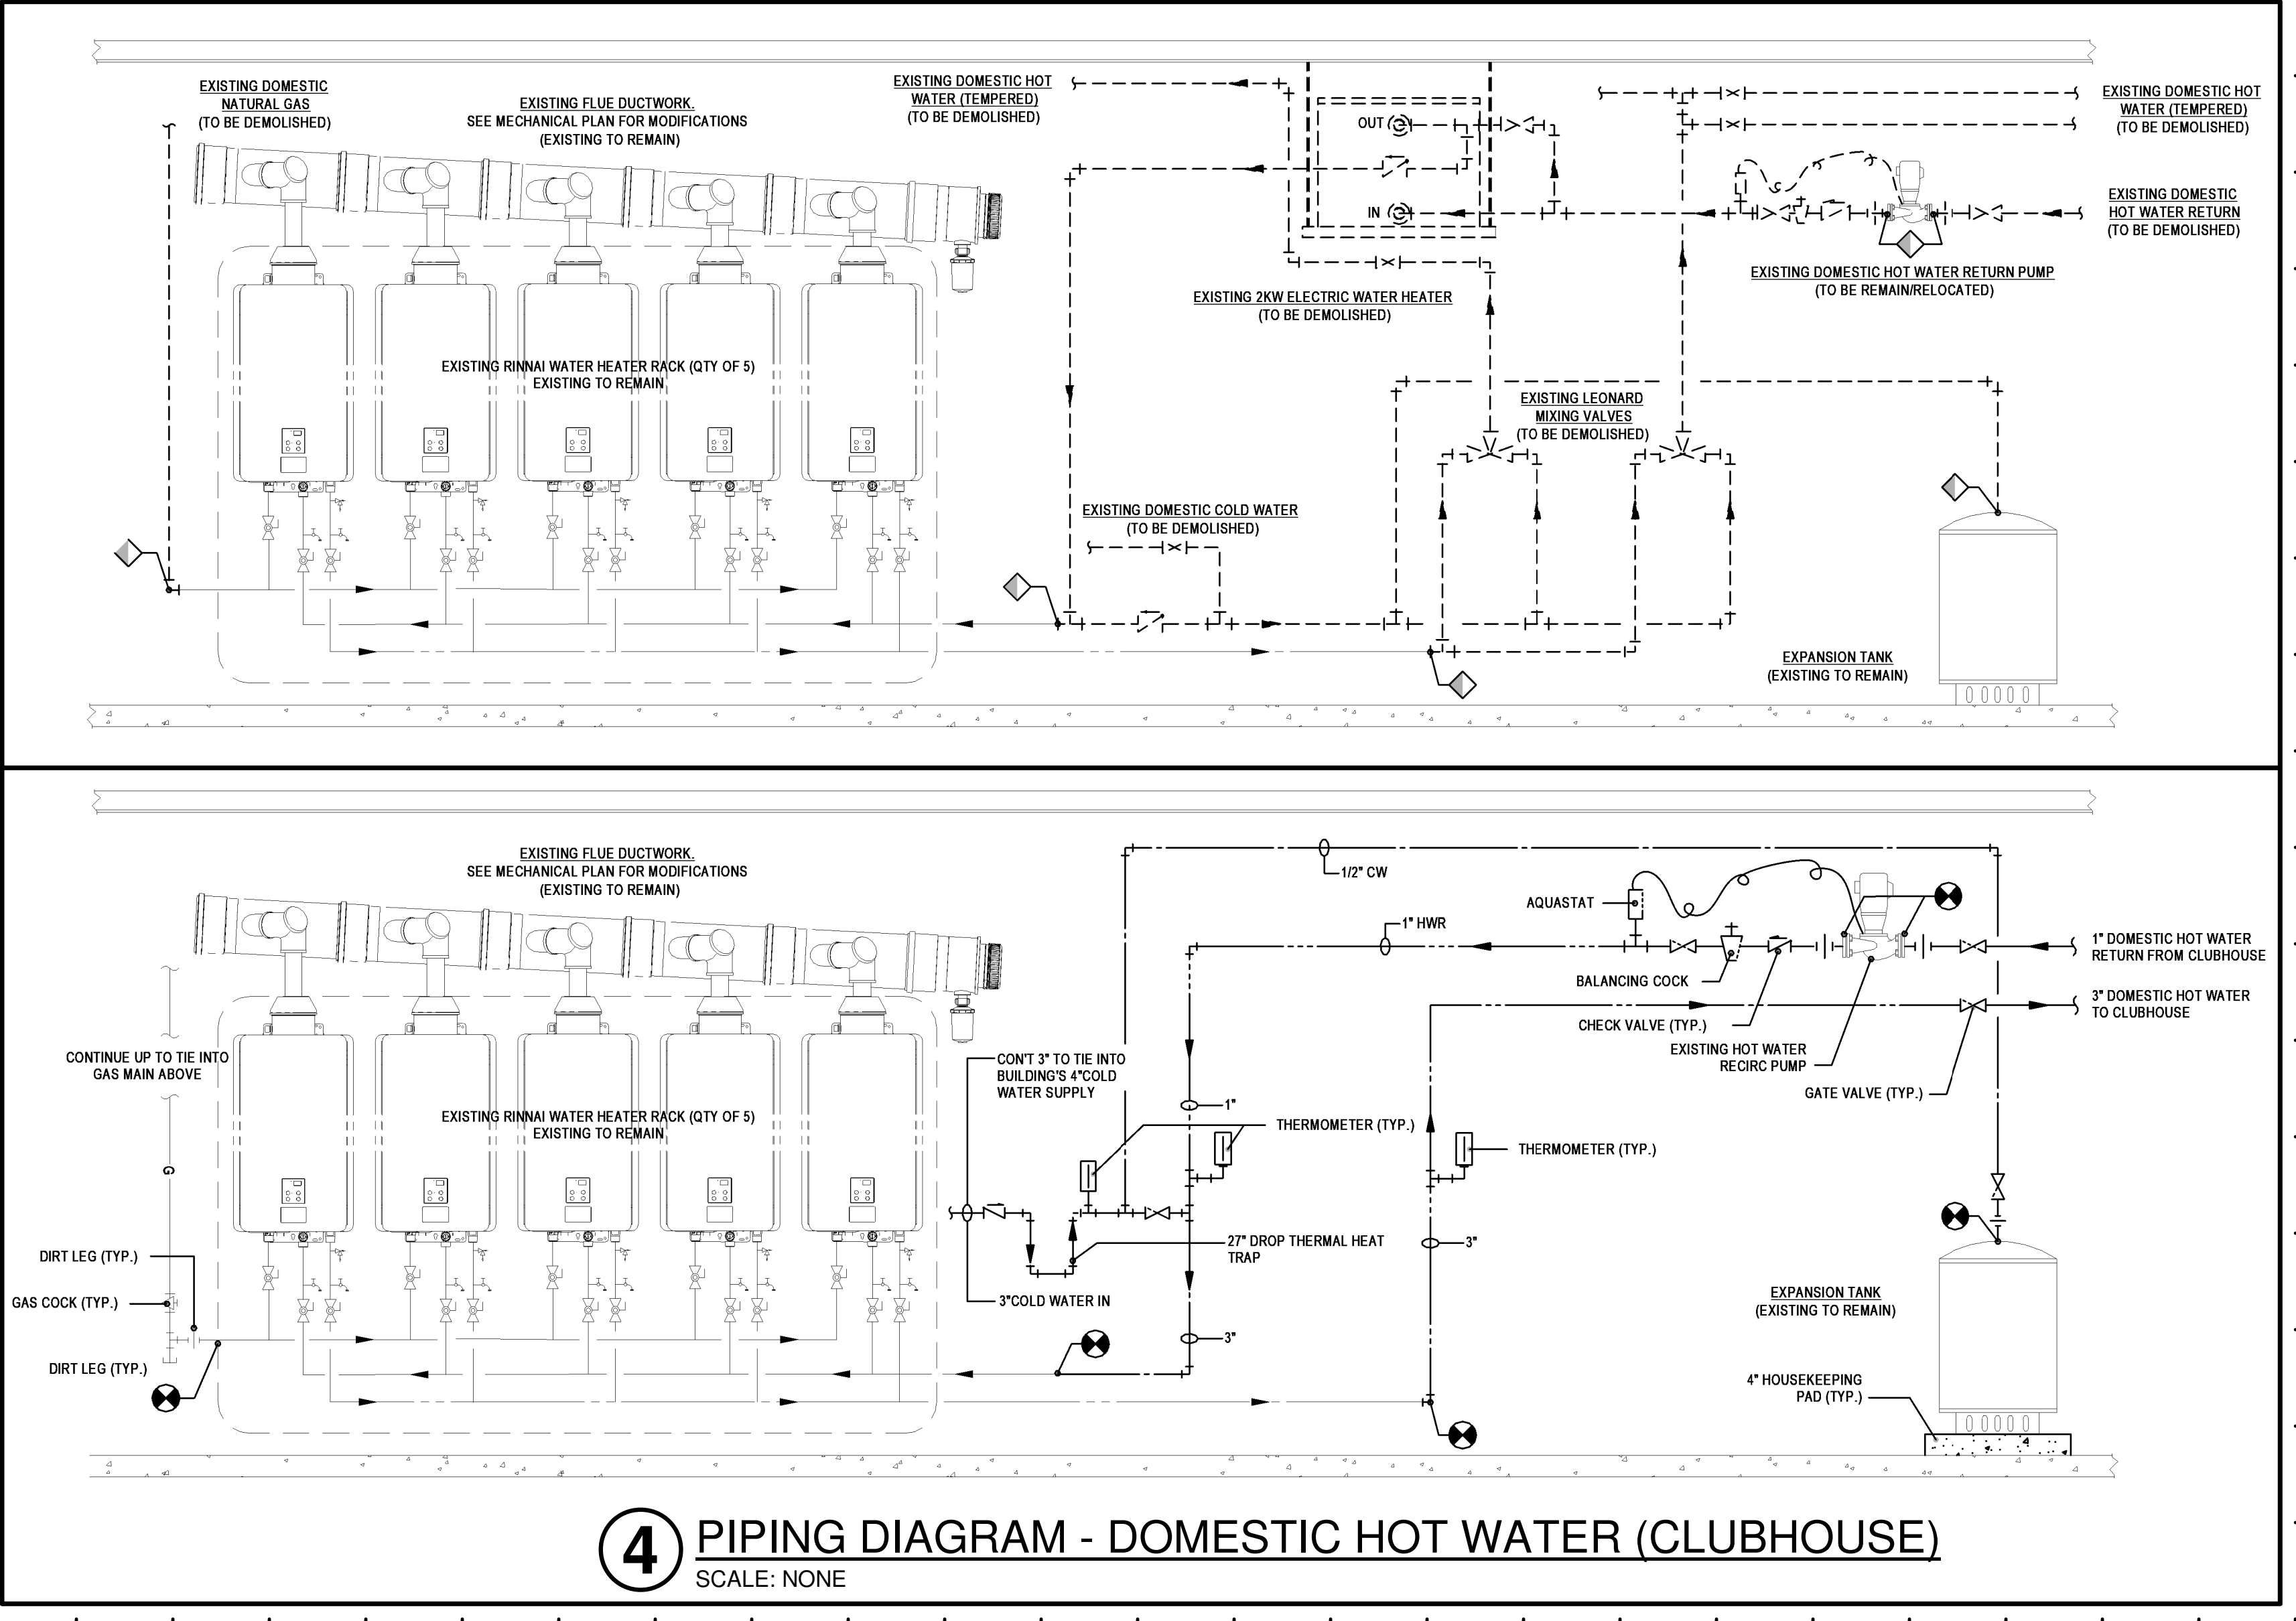
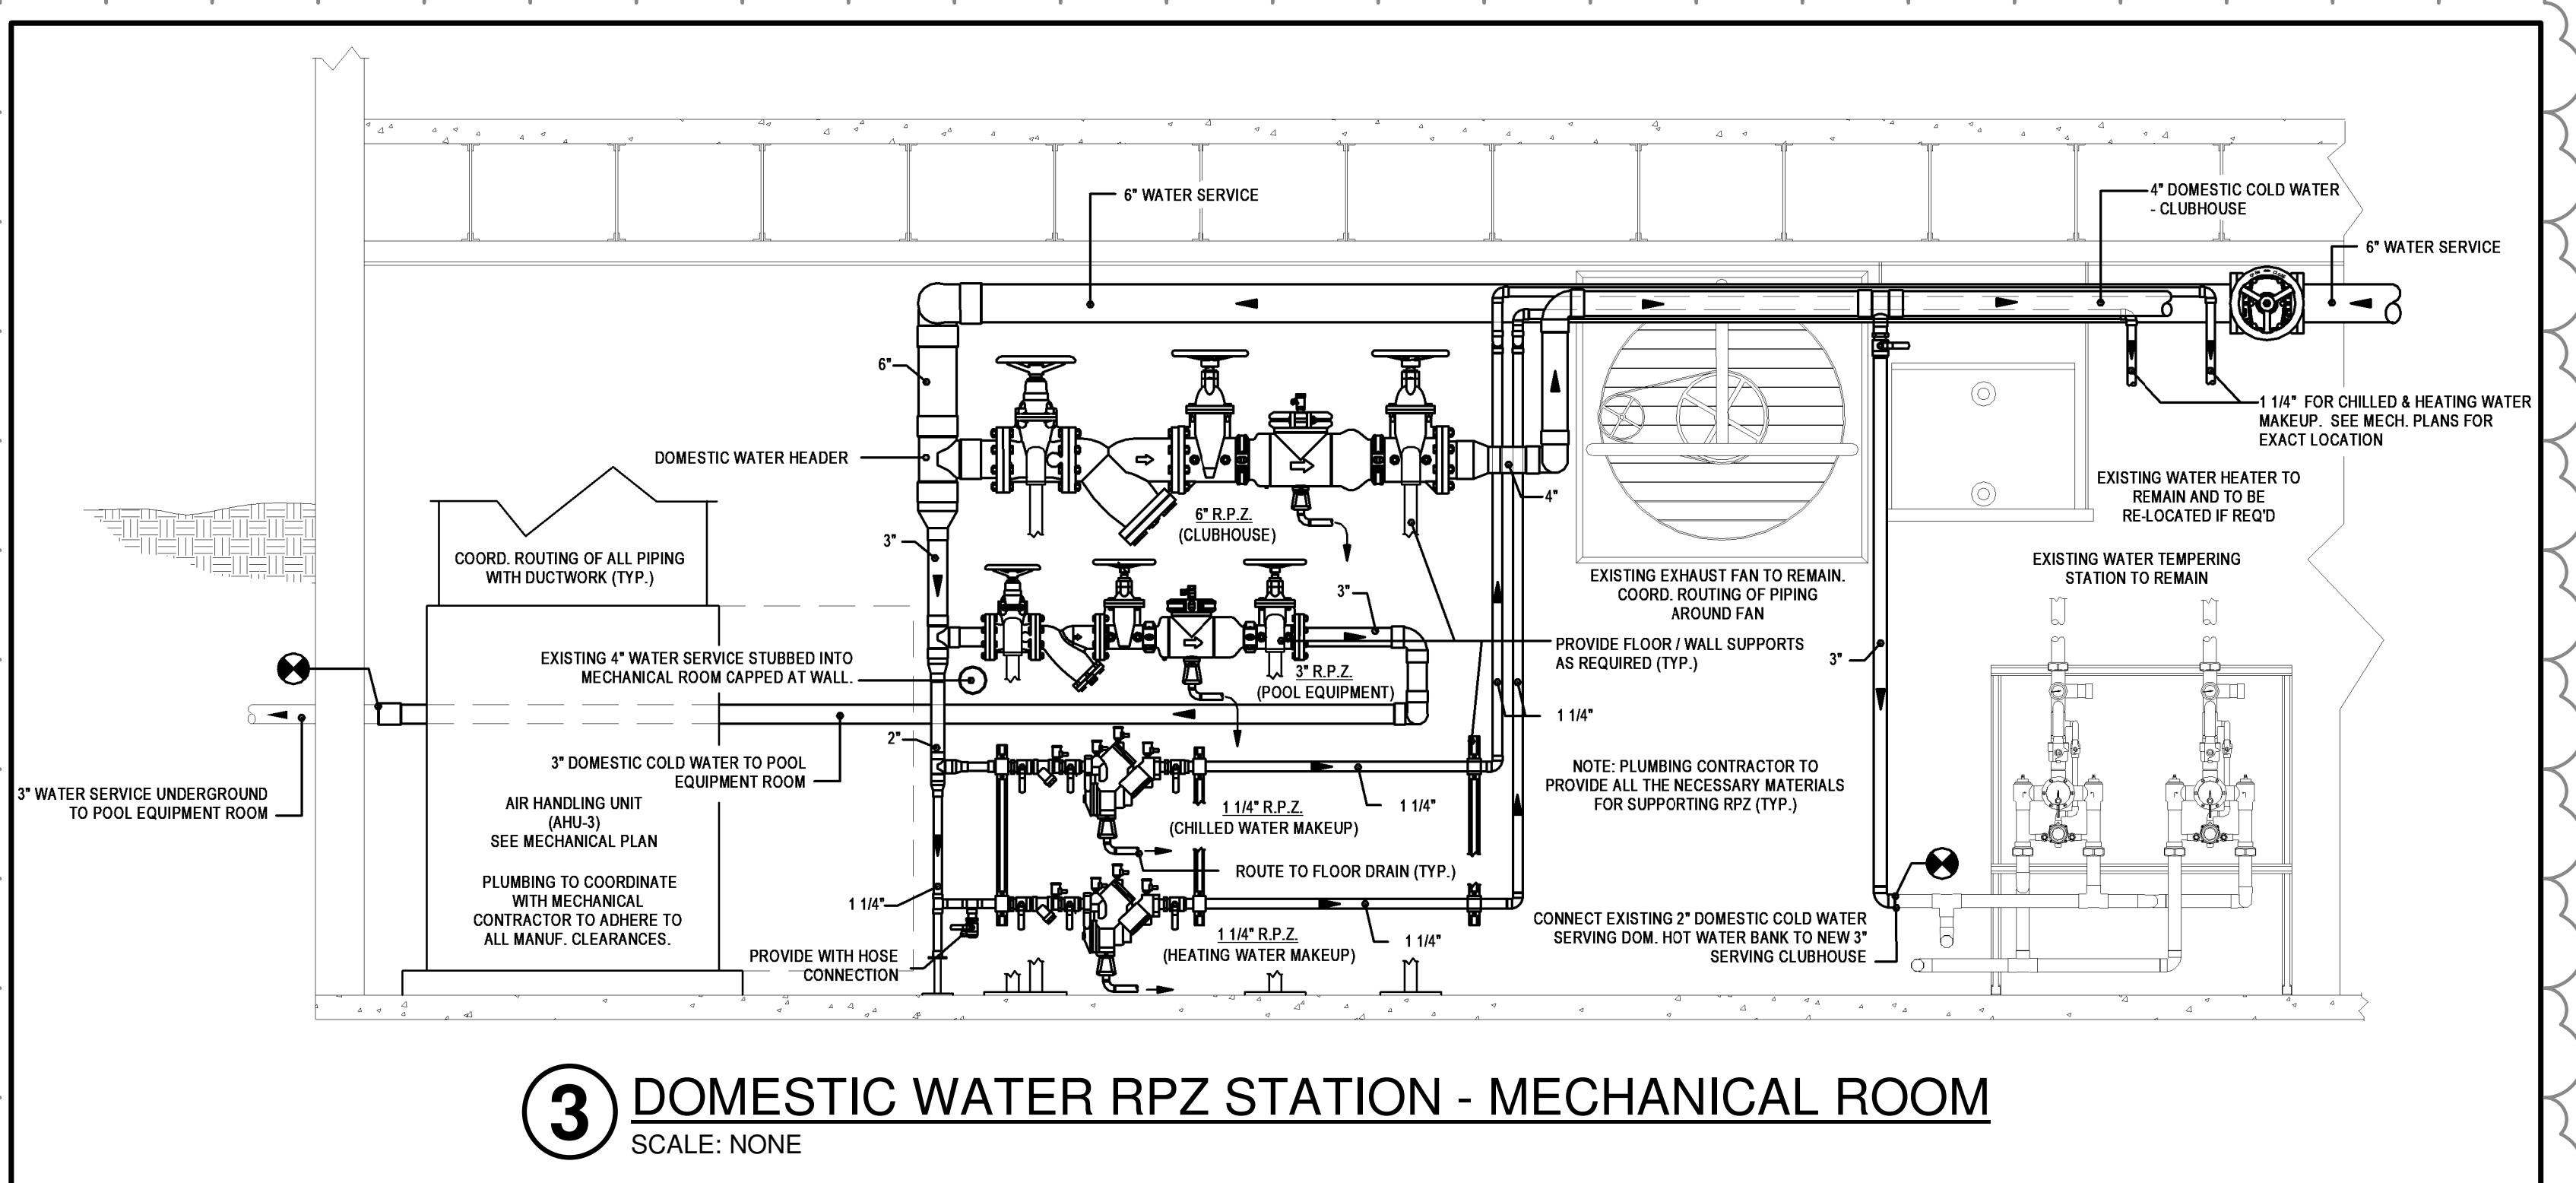
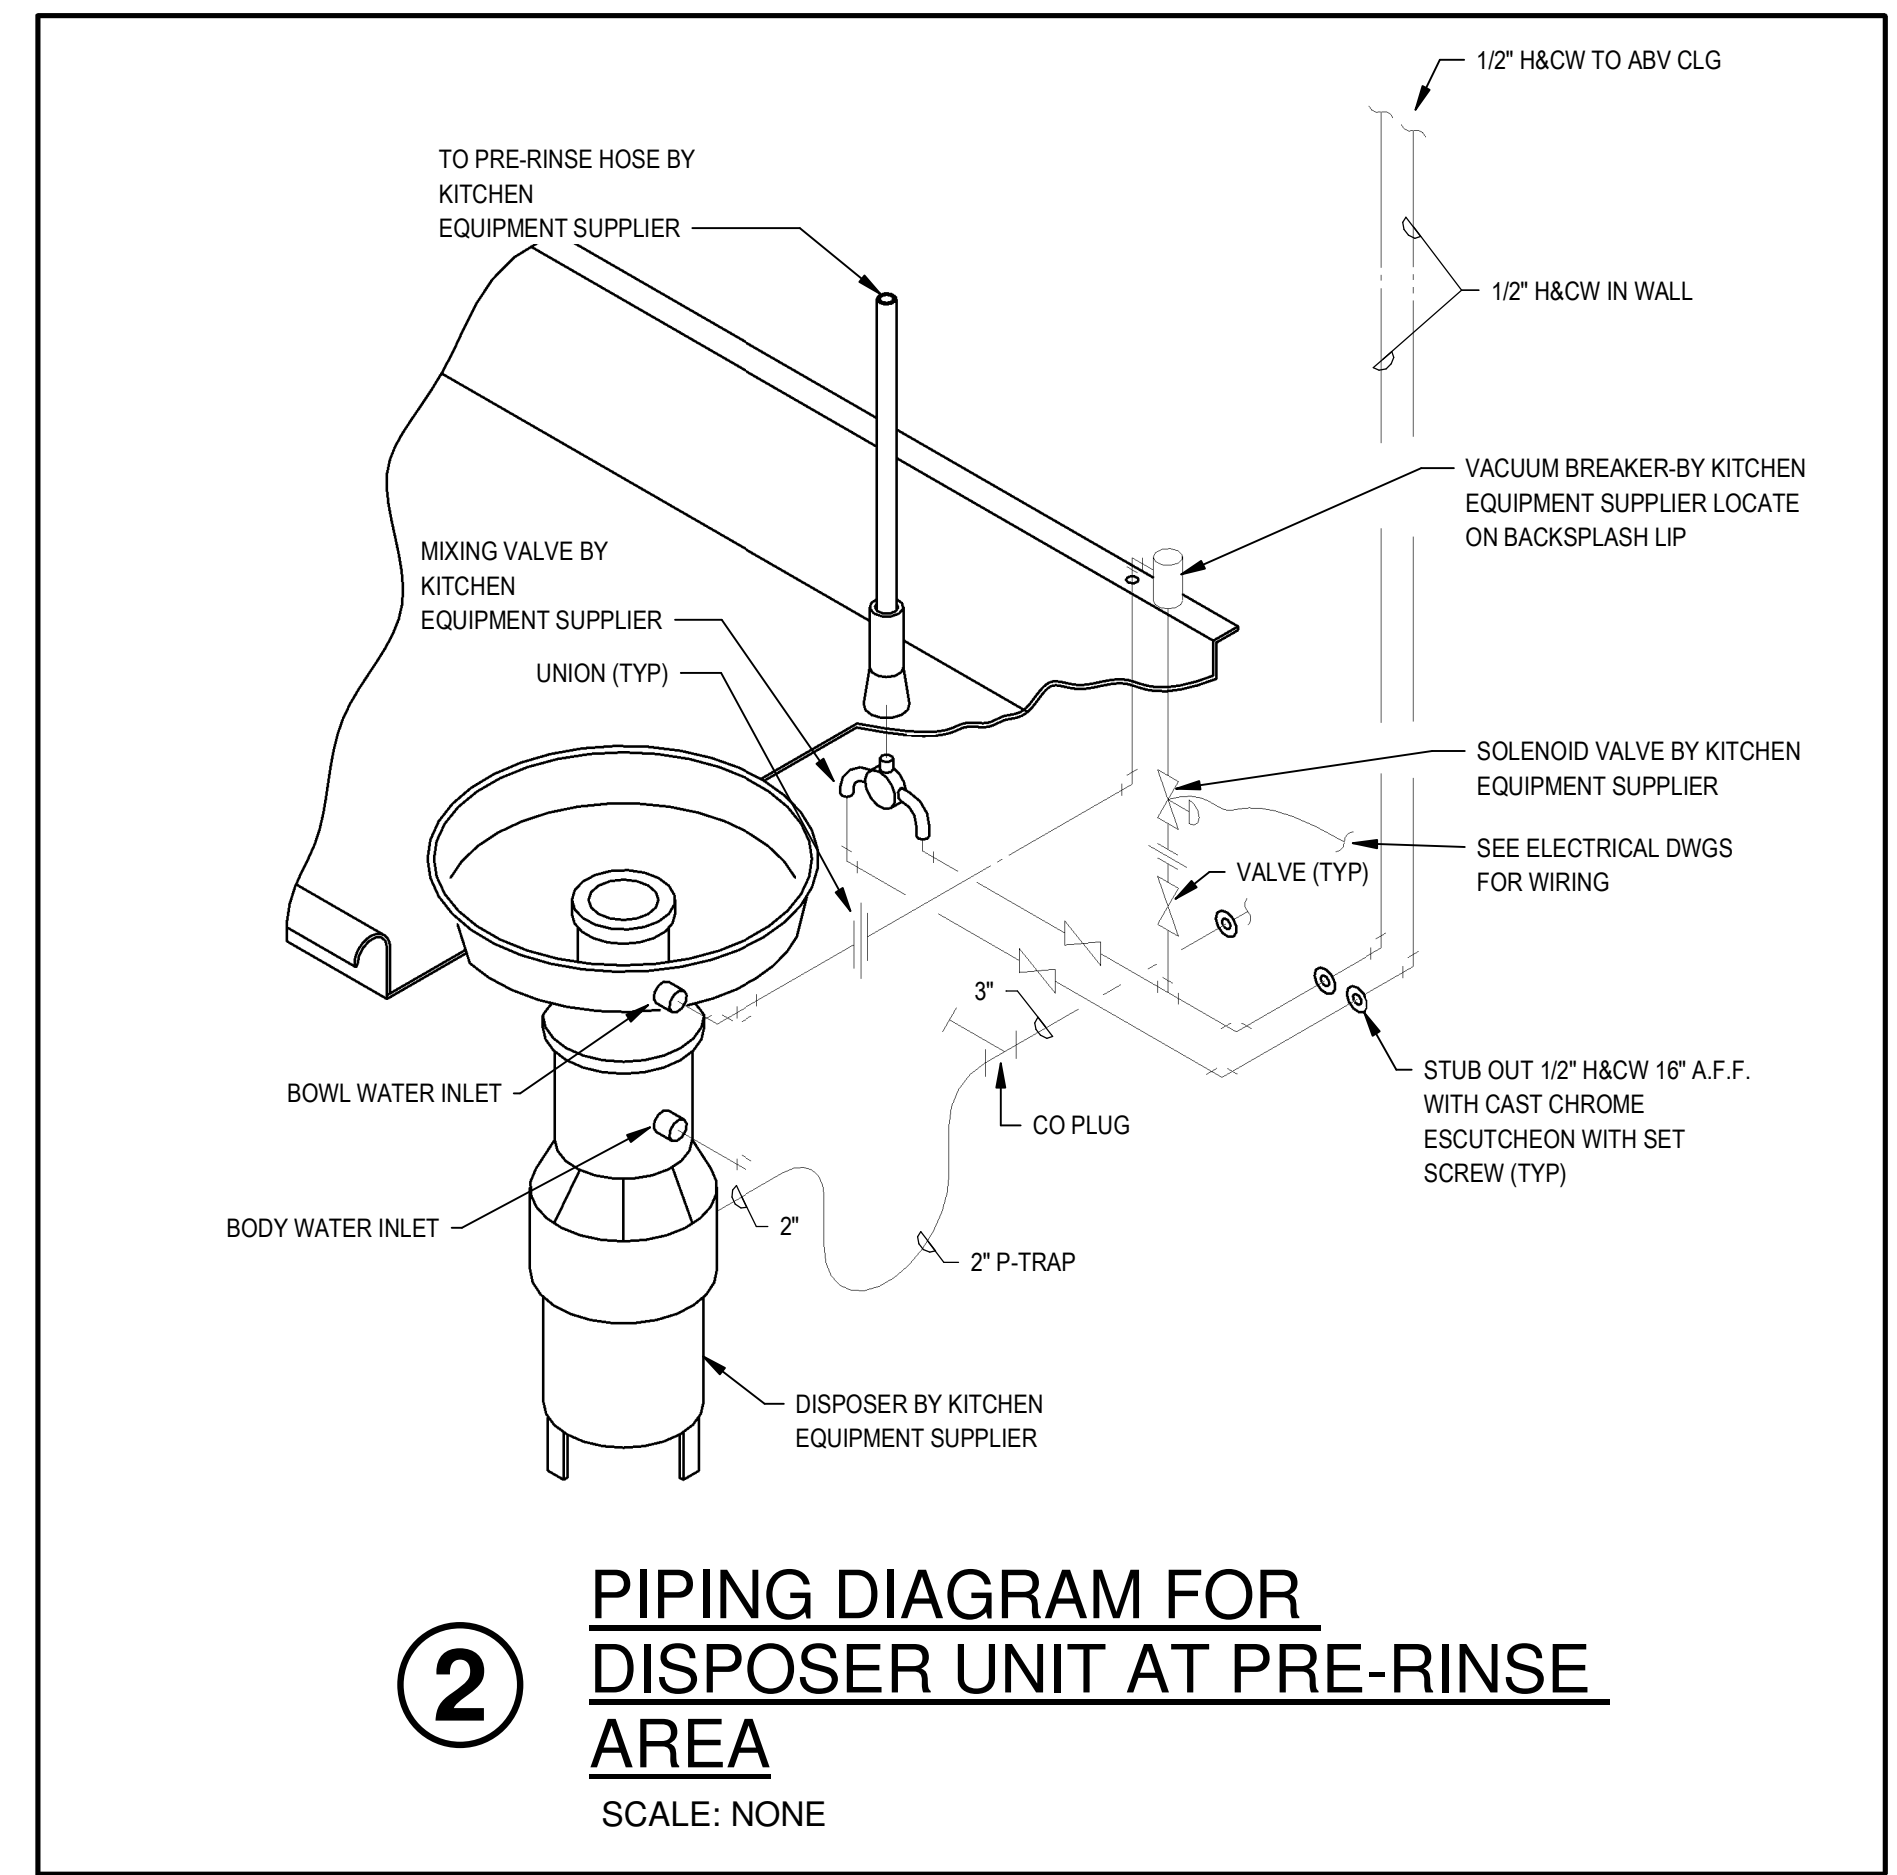
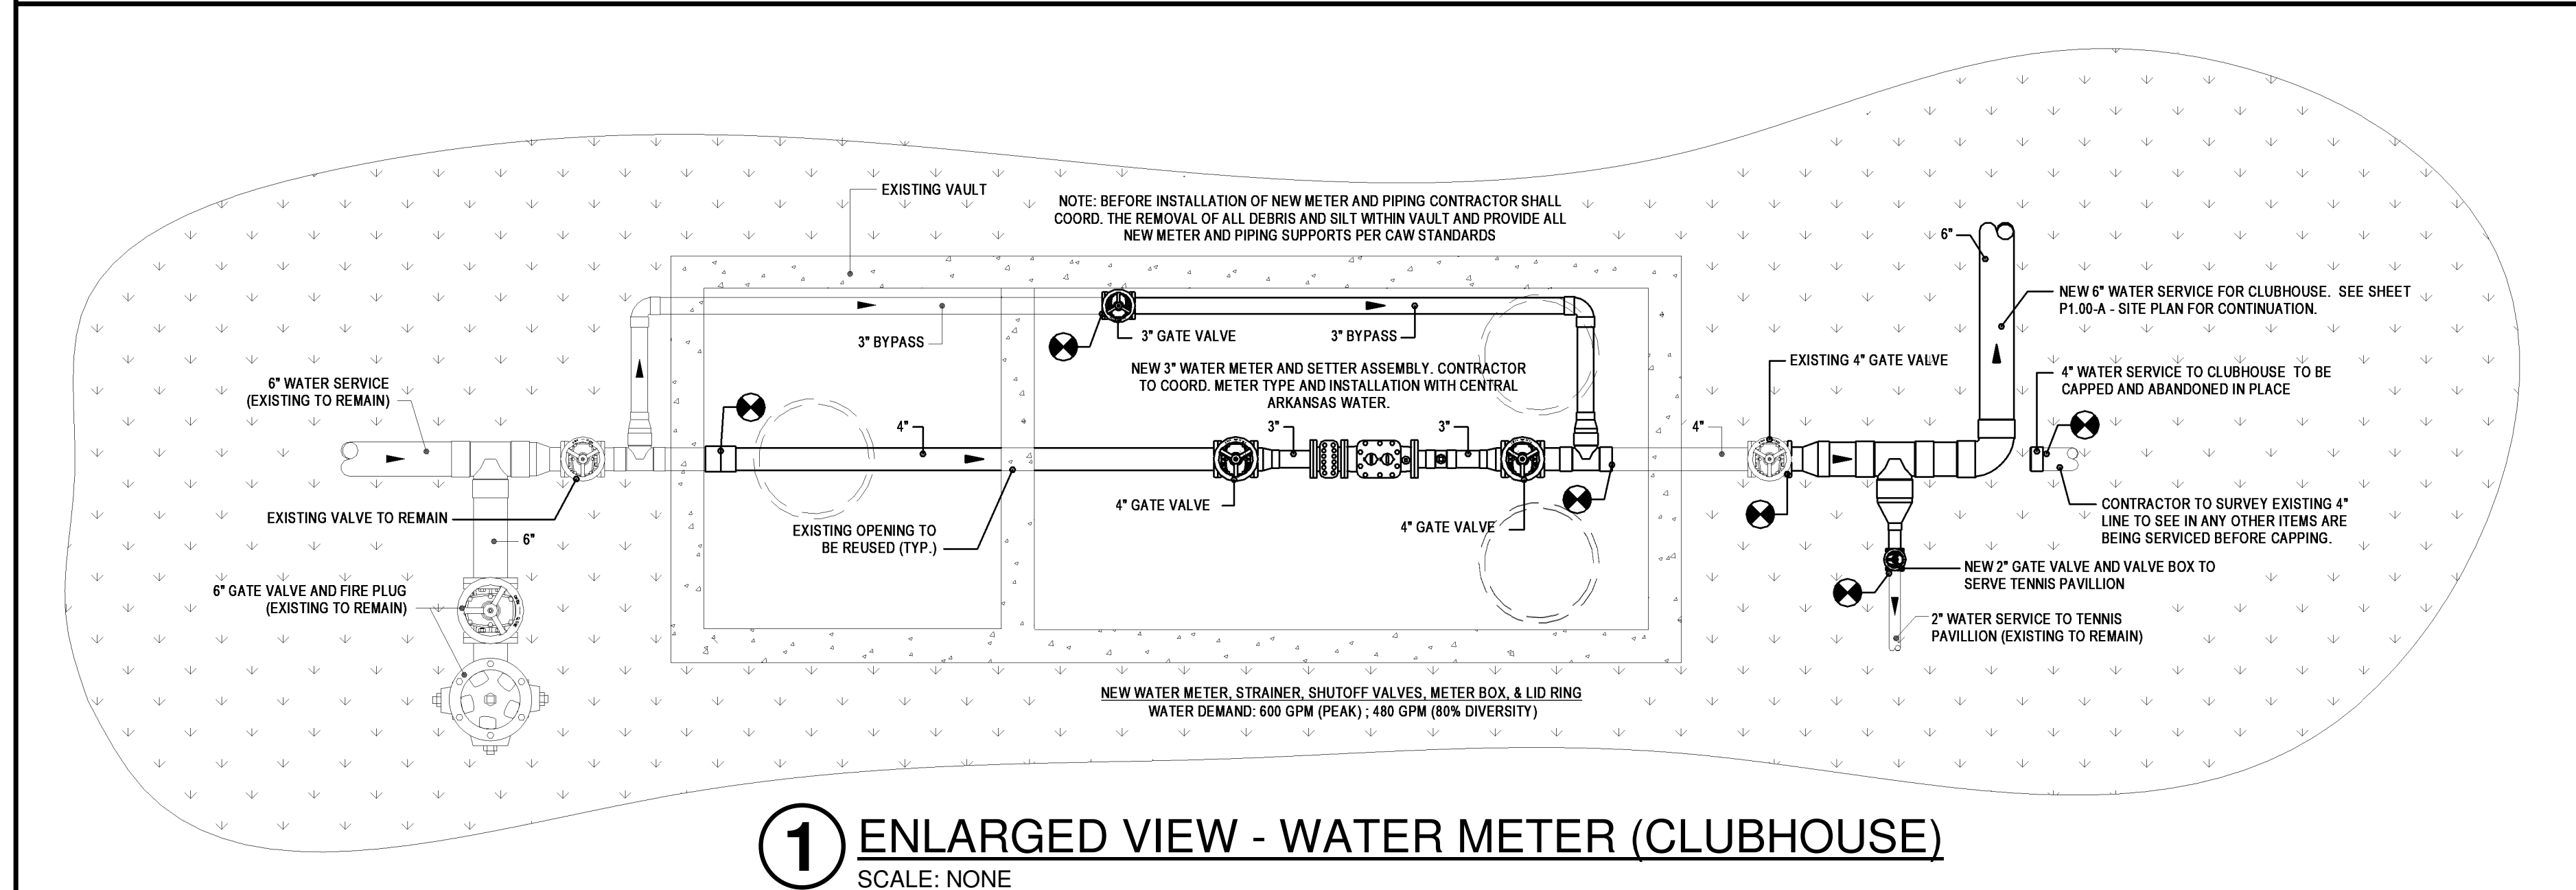


PETTIT & PETTIT
CONSULTING ENGINEERS, INC.
No. 78
© 2022
PETTIT & PETTIT
CONSULTING ENGINEERS, INC.
PERMIT SET

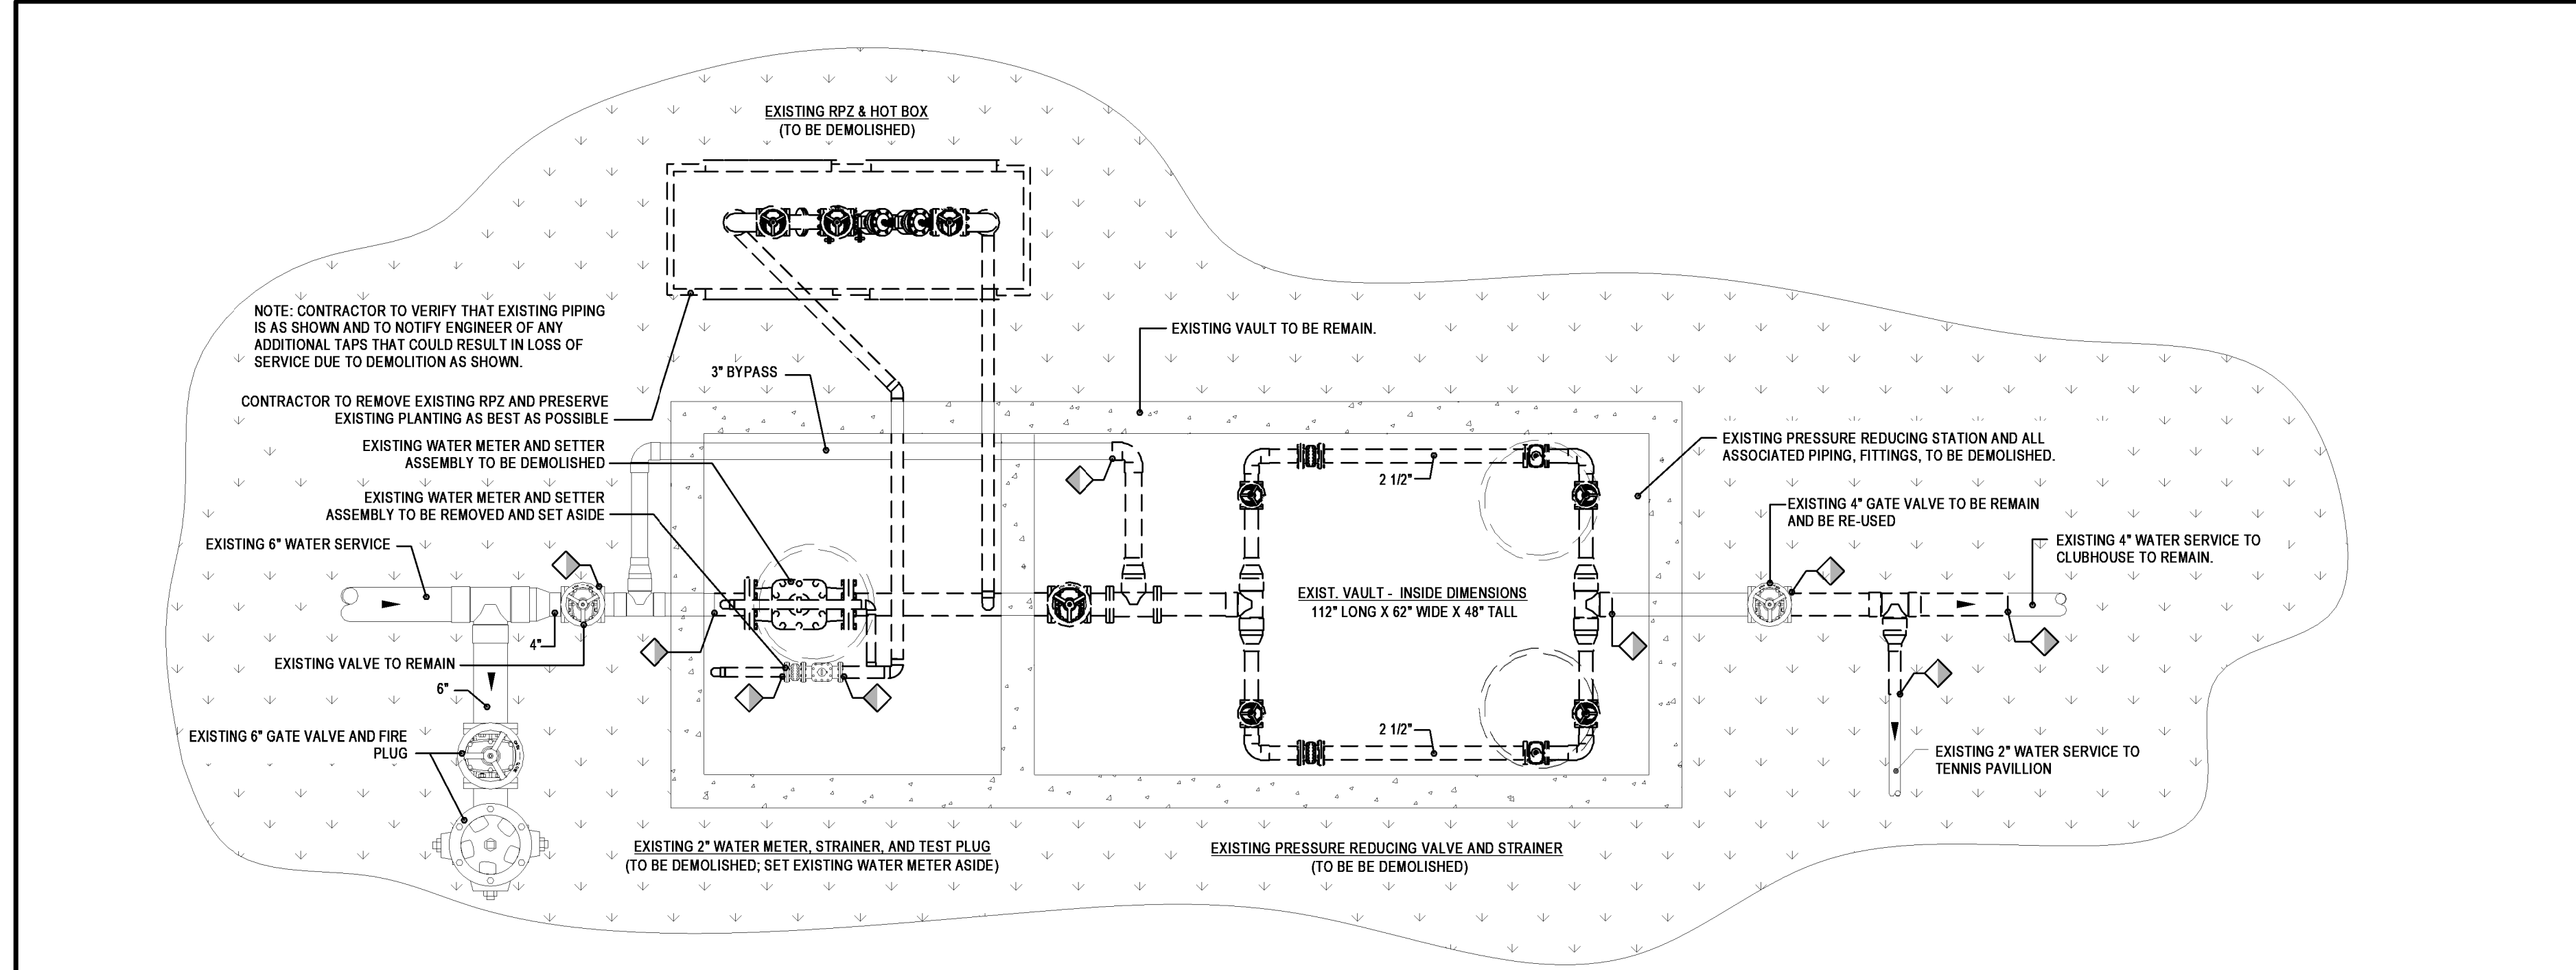

ADDITION AND RENOVATION TO PLEASANT VALLEY COUNTRY CLUB

CLUBHOUSE

1 PLEASANT VALLEY DRIVE
LITTLE ROCK, ARKANSAS 72212

REVISIONS		
1	RFP 03	01-04-24
2	ASI 11	11-17-23
3	RFI 08	03-05-24

PROJECT NO. 21075
DATE: June 21, 2023
PLUMBING DETAILS
P2.04-A