


PERMIT SET

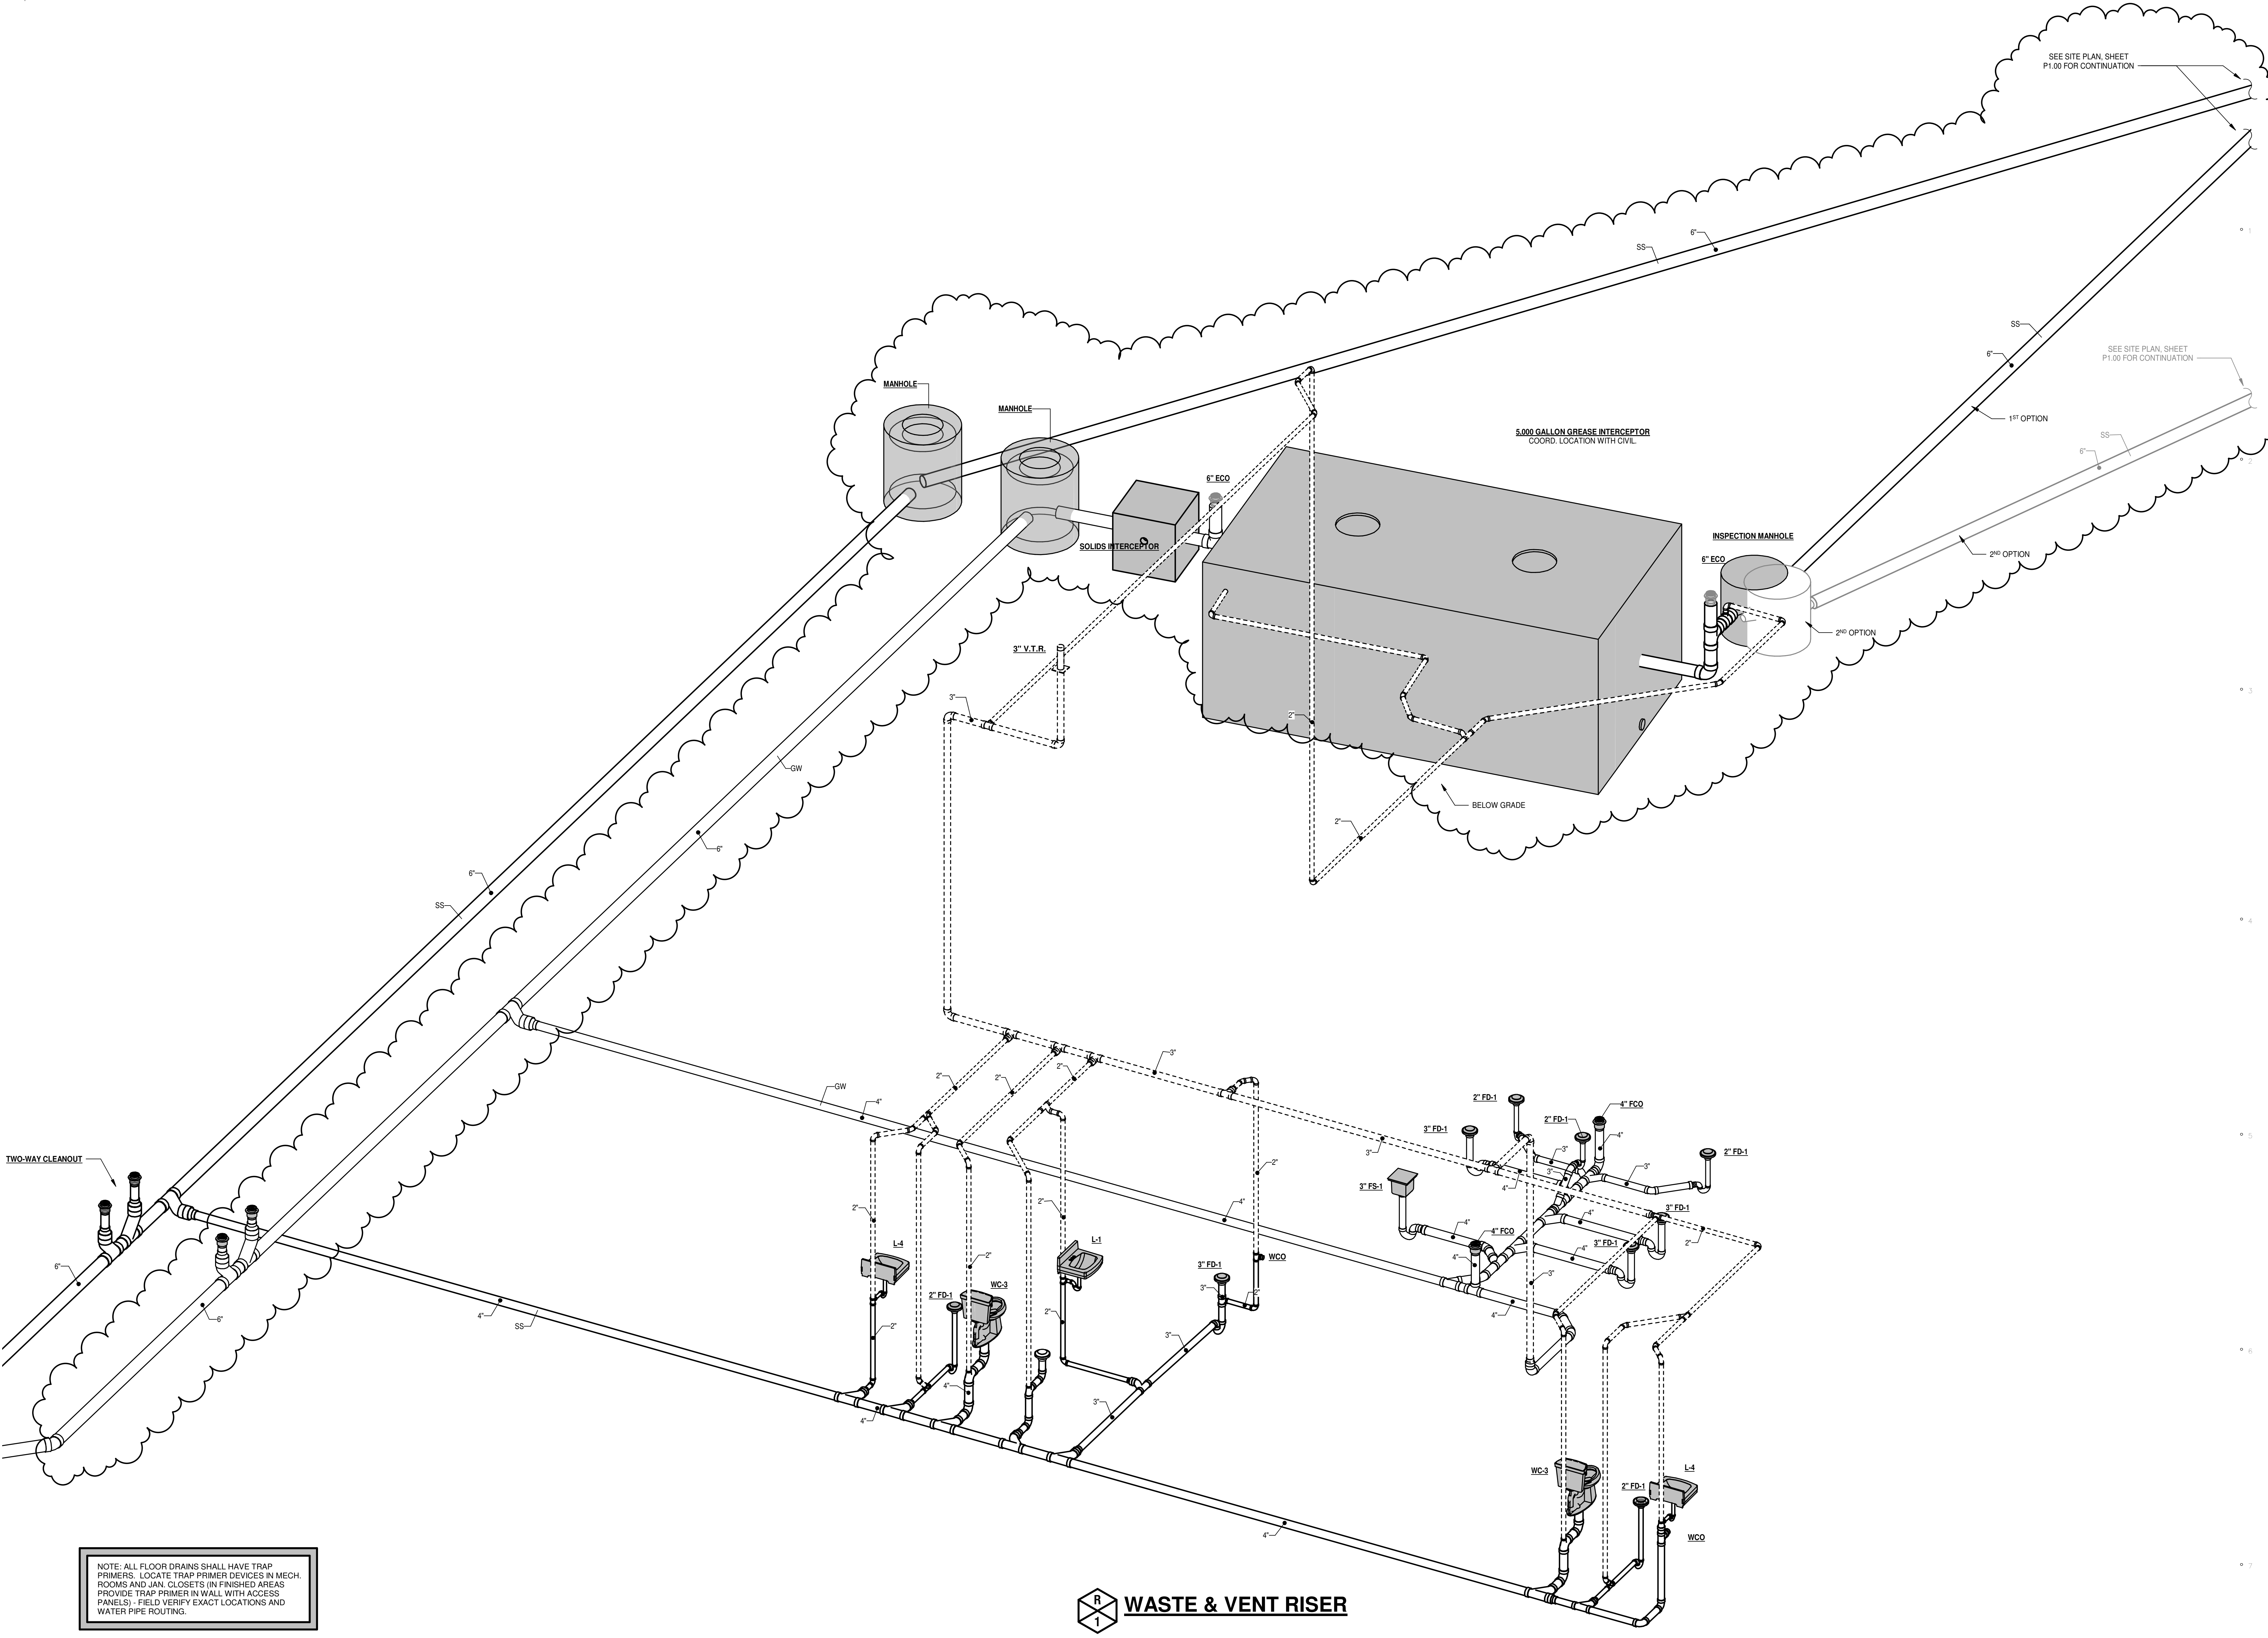

NOTE: ALL FLOOR DRAINS SHALL HAVE TRAP PRIMERS. LOCATE TRAP PRIMER DEVICES IN MECH. ROOMS AND JAN. CLOSETS (IN FINISHED AREAS PROVIDE TRAP PRIMER IN WALL WITH ACCESS PANELS). FIELD VERIFY EXACT LOCATIONS AND WATER PIPE ROUTING.

WASTE & VENT RISER

ADDITION AND RENOVATION TO PLEASANT VALLEY COUNTRY CLUB

CLUBHOUSE
1 PLEASANT VALLEY DRIVE
LITTLE ROCK, ARKANSAS 72212

REVISIONS	
1	GREASE WASTE 10-27-23

PROJECT NO. 21075
DATE: June 21, 2023

PLUMBING RISER
P3.05-A