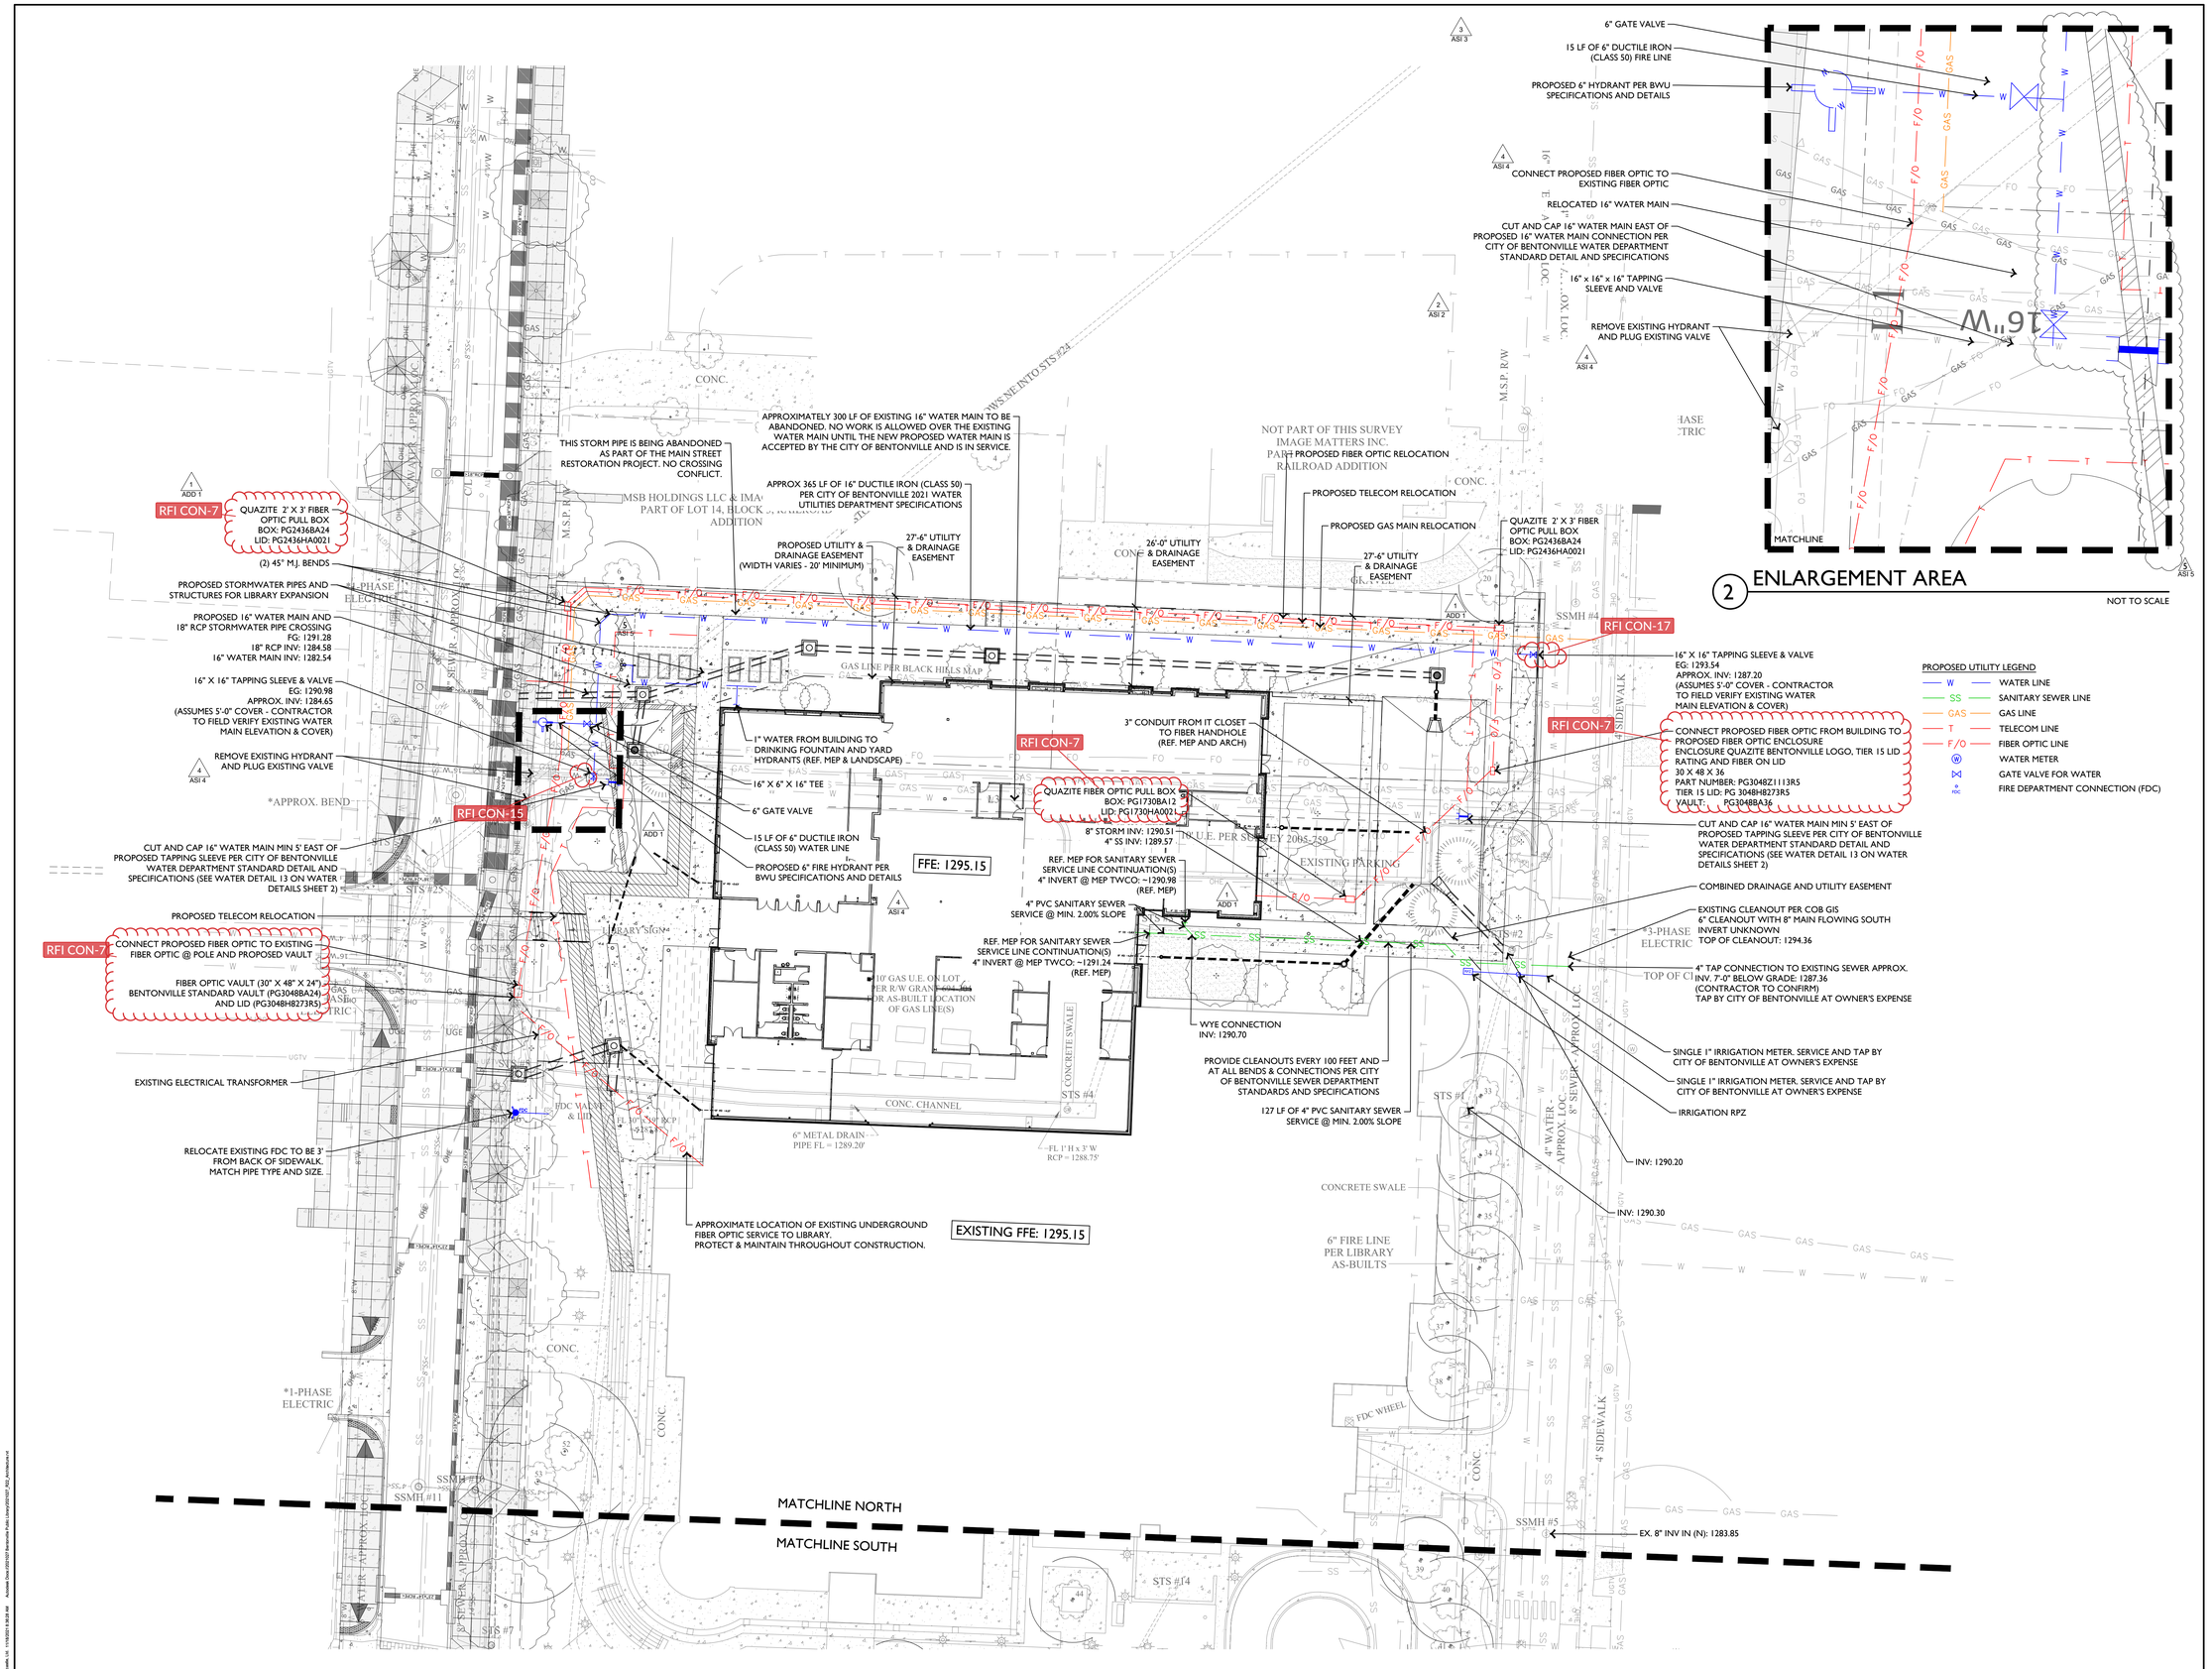

1 SITE UTILITY PLAN (NORTH)

2 ENLARGEMENT AREA

NOT TO SCALE

PROPOSED UTILITY LEGEND

W	WATER LINE
SS	SANITARY SEWER LINE
GAS	GAS LINE
T	TELECOM LINE
F/O	FIBER OPTIC LINE
W	WATER METER
	GATE VALVE FOR WATER
FDC	FIRE DEPARTMENT CONNECTION (FDC)

Architecture and Interiors
MSRDesign
510 Marquette Avenue South, Suite 200
Minneapolis, MN 55402 | 612.375.0336

Associate Architect
Hight Jackson Associates PA
5201 W Village Pkwy #300
Rogers, AR 72758 | 479.464.4965

Civil Engineer
E | D | G
216 West Birch Street
Rogers, AR 72756 | 501.378.0200

Landscape Architect
TEN x TEN
575 SE 9th St #210
Minneapolis, MN 55414 | 612.440.8369

Structural Engineer
Tatum Smith Welcher Engineers, Inc.
3100 S Market St #202
Rogers, AR 72758 | 479.621.6128

MEP Engineer
HP Engineering, Inc.
5214 W Village Pkwy #120
Rogers, AR 72758 | 479.899.6370

APPROVED FOR CONSTRUCTION
07/24/2023 1:35:19 PM

Bentonville Public Library Expansion

405 S Main Street
Bentonville, AR 72712

Project No: 2021027

AFC - Bentonville Public Library Expansion - LSD22-0062 - REVISION 2 - 7/24/2023

I hereby certify that this plan, specification or report was prepared by me or under my direct supervision and that I am a duly Licensed Architect under the Laws of the State of Minnesota.

Architect Seal

CERTIFICATE OF AUTHORIZATION Ecological Design Group, Inc. No. 2513 ARKANSAS

STATE OF ARKANSAS REGISTERED PROFESSIONAL ENGINEER No. 14694 BRAHM M. DRIVER 1/6/23

Signature _____

Print Name _____

Date _____ License No _____

BID SET

ISSUE / REVISION

Mark	Date	Description
	12/10/2021	SCHEMATIC DESIGN PRICING
	06/22/2022	DESIGN DEVELOPMENT PRICING
	8/1/2022	DD VE OPTION B
	10/13/2022	PRE APP SET
	10/28/2022	LARGE SCALE DEVELOPMENT SUBMITTAL
	10/31/2022	CD PRICING SET
	11/14/2022	SECOND LSD SUBMITTAL
	11/28/2022	THIRD LSD SUBMITTAL
	12/21/2022	PERMIT SET
	01/06/2023	BID SET
	01/18/2023	BID SET - ADDENDUM 1
	02/22/2023	BID SET - ADDENDUM 3
	03/30/2023	ASI 2
	05/25/2023	ASI 4
	07/24/2023	ASI 5

Drawing 2021 Copyright Meyer, Scherer & Rockcastle, Ltd.

SITE UTILITY PLAN (NORTH)

C200

Drawing 2021 Copyright Meyer, Scherer & Rockcastle, Ltd. 11/15/2021 9:30:28 AM Autodesk Docs://2021027 Bentonville Public Library/2021027_MSR_Architecture.rvt