AF 52351

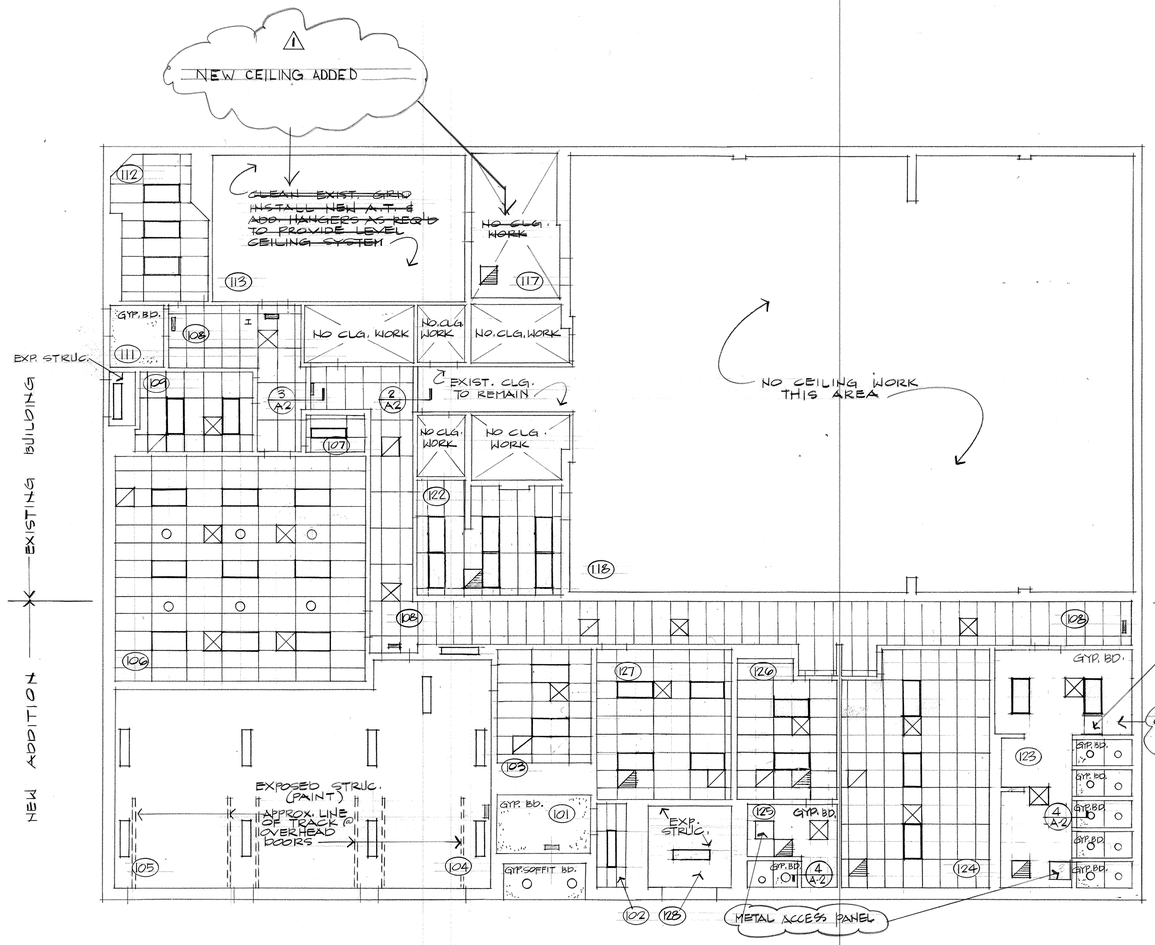

1 REFLECTED CEILING PLAN
1/8" = 1'-0"

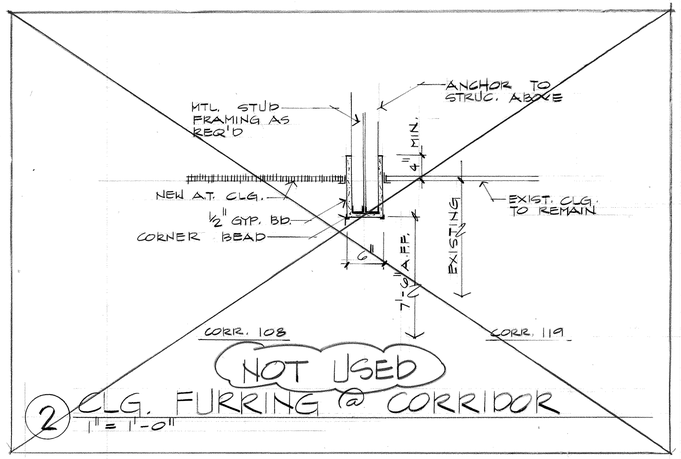

2 CLG. FURRING @ CORRIDOR
1" = 1'-0"

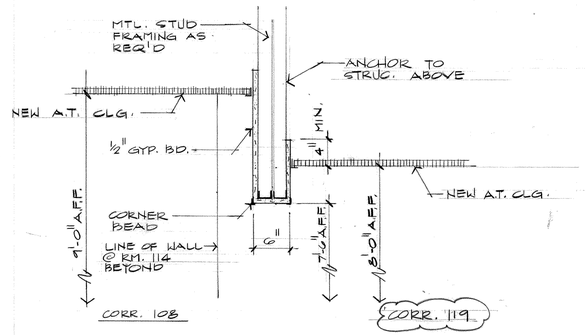

3 CLG. FURRING @ CORRIDOR
1" = 1'-0"

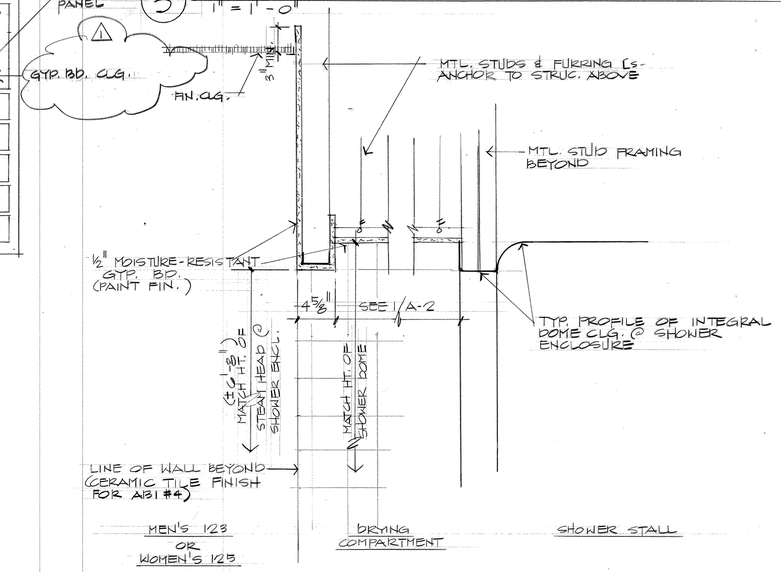

4 CLG. DETAIL @ SHWR. ENCLOSURE
1½" = 1'-0"

MICHAEL G. JOHANSON REGISTERED ARCHITECT No. 1951 ARKANSAS

ADDITION / ALTERATION OF
FIRE STATION
ARKANSAS AIR NATIONAL GUARD
FORT SMITH, ARKANSAS

a+ architecture plus
120 North 9th Street • Fort Smith, Arkansas • 501/783-8395

REFLECTED CEILING PLAN

REVISIONS:
⚠ AS BUILT

PROJECT: 88-18
DATE: 7-24-89
SHT. A-2 OF 7

a+

PROJ. NO. HKRZ001633