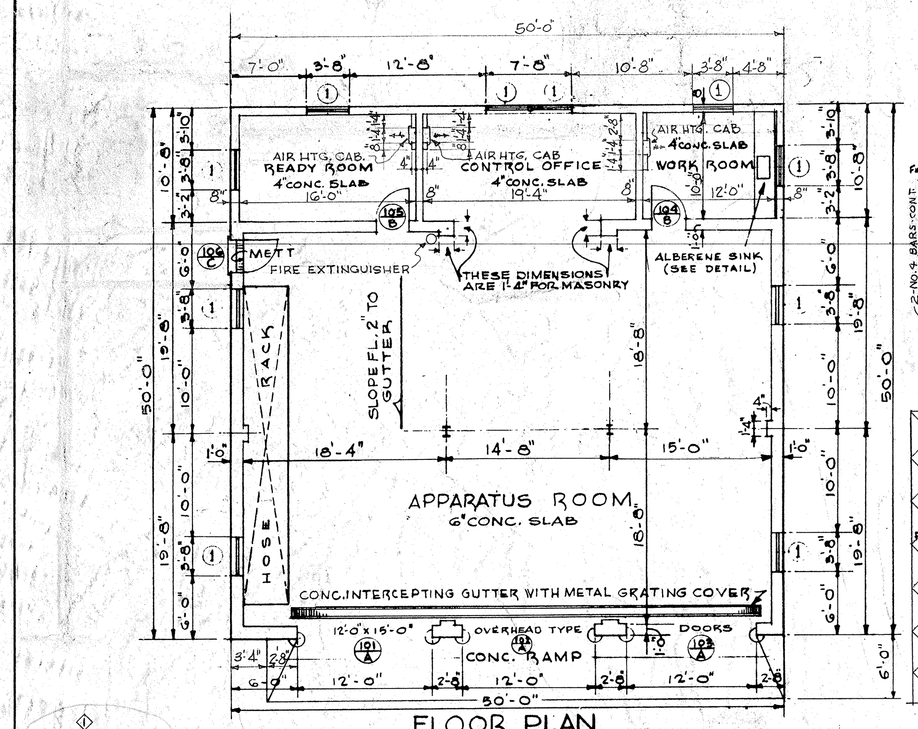

FLOOR PLAN
SCALE 1/8"=1'-0"

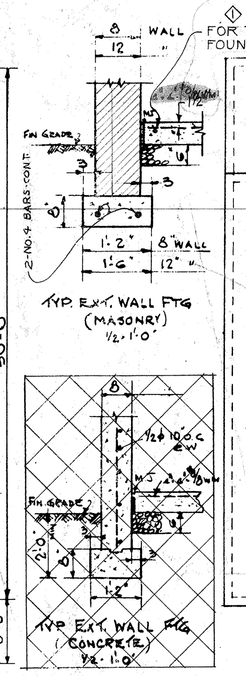

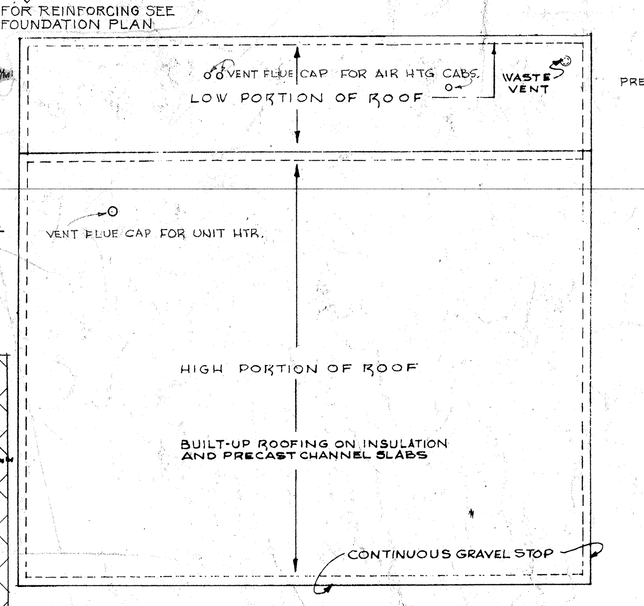
figure_VENT FLUE CAP FOR AIR HTG CABS.
WASTE VENT
LOW PORTION OF ROOF
VENT FLUE CAP FOR UNIT HTR.
HIGH PORTION OF ROOF
BUILT-UP ROOFING ON INSULATION AND PRECAST CHANNEL SLABS
CONTINUOUS GRAVEL STOP

ROOF PLAN
SCALE 1/8"=1'-0"

LINTLE SCHEDULE		
L1	3 L3 4"x3½"x¼"	4" LEG VERT
L2	2 L3 4"x3½"x¼"	"

BEARING PLATE SCHEDULE	
BP1	8"x6"x⅜"
BP2	8"x6"x⅜"

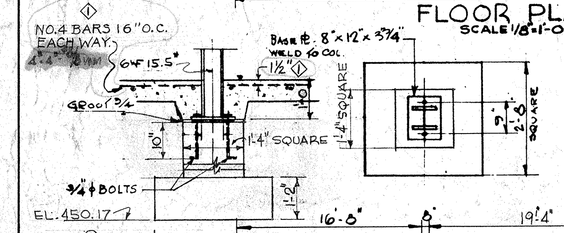

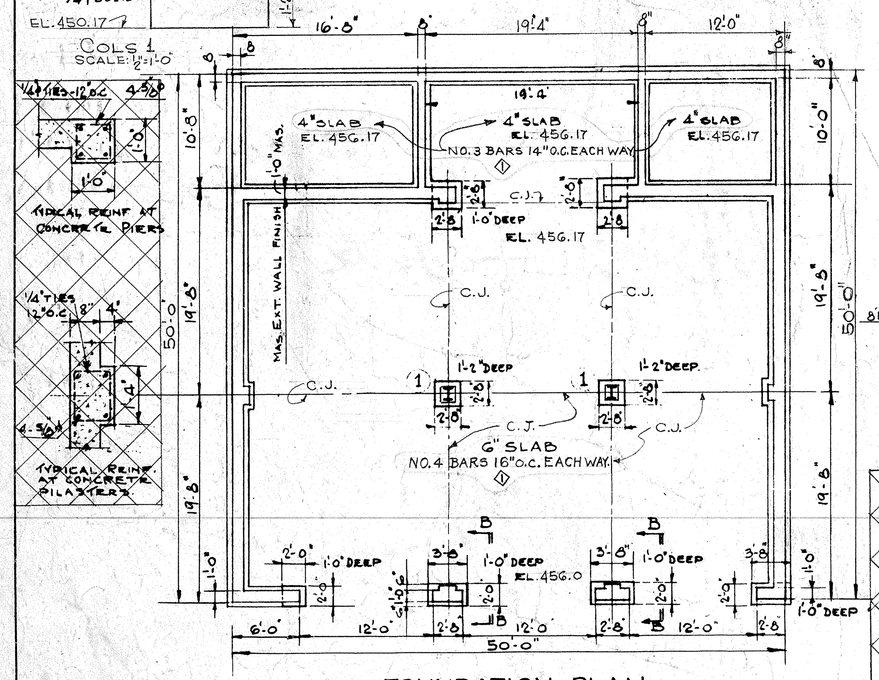

FOUNDATION PLAN
SCALE 1/8"=1'-0"

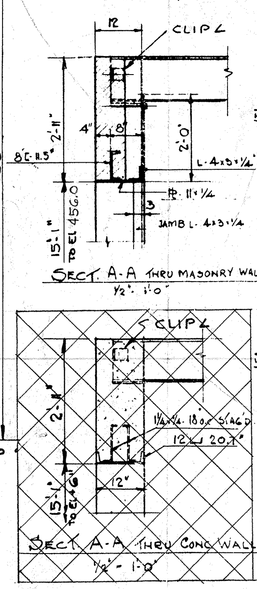

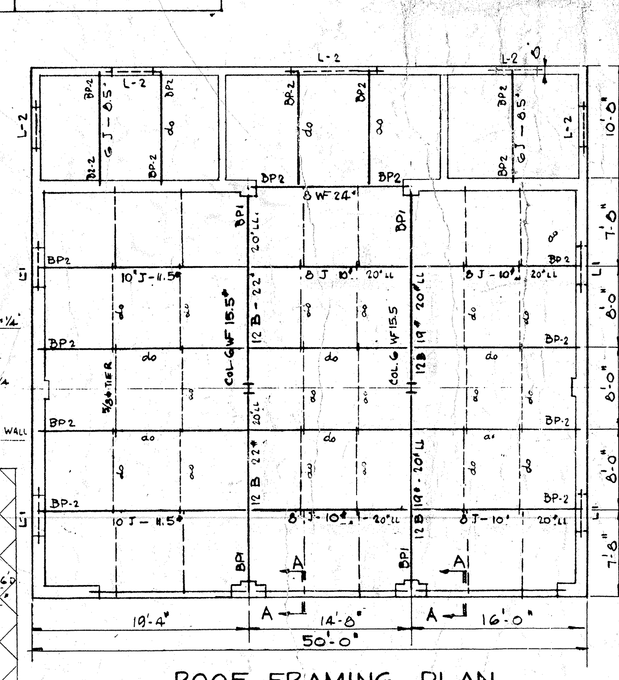
L-2
BP2
BP1
BP2
BP1
BP2
BP2
BP2