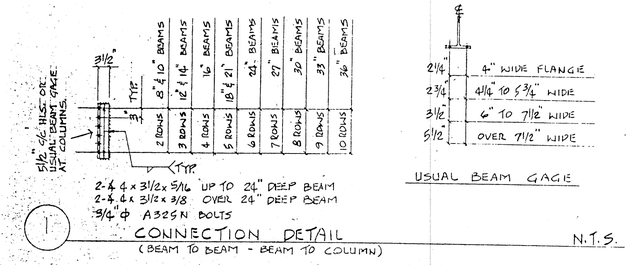

1 CONNECTION DETAIL
(BEAM TO BEAM - BEAM TO COLUMN) N.T.S.

USUAL BEAM GAGE

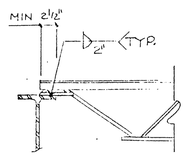

2 DETAIL NTS

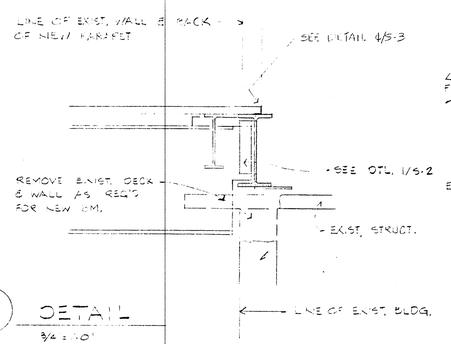

3 DETAIL
3/4" = 1'-0"

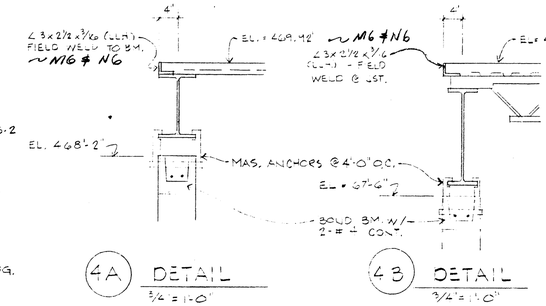

4A DETAIL
3/4" = 1'-0"

4B DETAIL
3/4" = 1'-0"

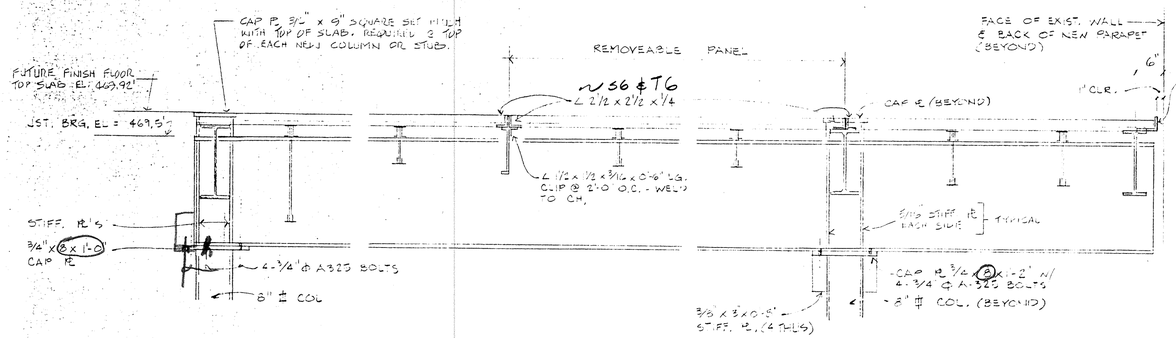

5 DETAIL
3/4" = 1'-0"

6 DETAIL
3/4" = 1'-0"

7 DETAIL
3/4" = 1'-0"

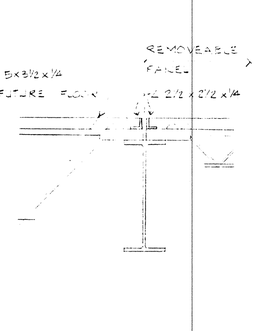

8 DETAIL
3/4" = 1'-0"

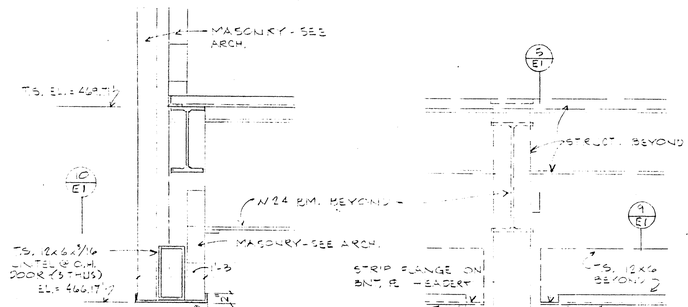

9 DETAIL
3/4" = 1'-0"

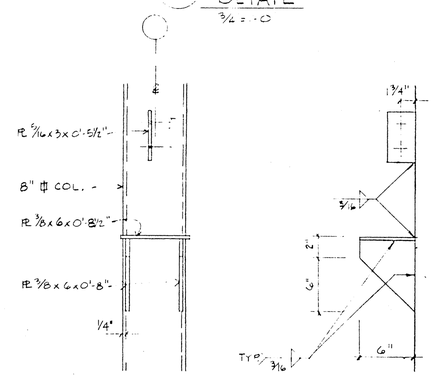

10 DETAIL
3/2" = 1'-0"

11 CONNECTION DETAIL
1/2" = 1'-0"

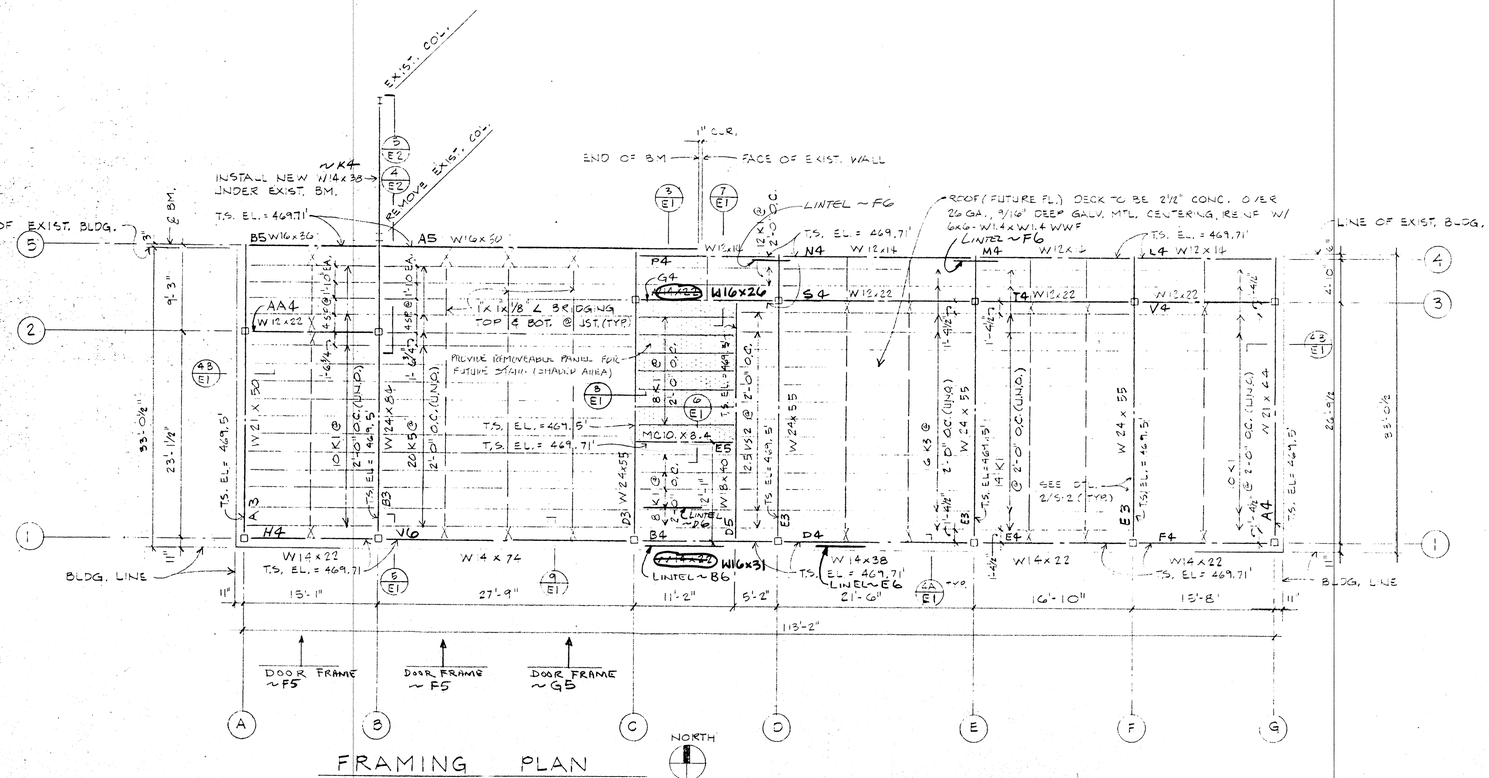

FRAMING PLAN
1/8" = 1'-0"

REVIEWED FOR COMPLIANCE WITH GENERAL DESIGN REQUIREMENTS. DIMENSIONS AND QUANTITIES HAVE NOT NECESSARILY BEEN CHECKED. FABRICATION AND CONSTRUCTION MAY PROCEED IN ACCORDANCE WITH THIS SUBMITTAL AND ANY COMMENTS NOTED. PROVIDED DRAWING AND SPECIFICATION REQUIREMENTS ARE OBSERVED.
STATON & NUSEN, INC.
CONSULTING ENGINEERS NOV 8 1991
BY _____ DATE _____

MERIT
STEEL PROCESSING AND FABRICATION
P.O. BOX 6821
FT. SMITH, AR 72906
501-646-9440 PLANT 501-783-3515

CUSTOMER: BESHEARS CONST. INC.

SCALE:	APPROVED BY:	DRAWN BY SIMMONS
DATE:		REVISED

JOB TITLE: ADD'N/ALTERATION OF FIRE STATION
LOCATION: ARK. AIR NATIONAL GUARD - FORT SMITH, ARK.
ARCH. OR ENG: ARCH. PLUS
120 N. 9TH - FT. SMITH, ARK. - 783-8895
DRAWING NUMBER E1 OF 2

14 X 36 PRINTED ON MO 1000H CLEARPRINT ®