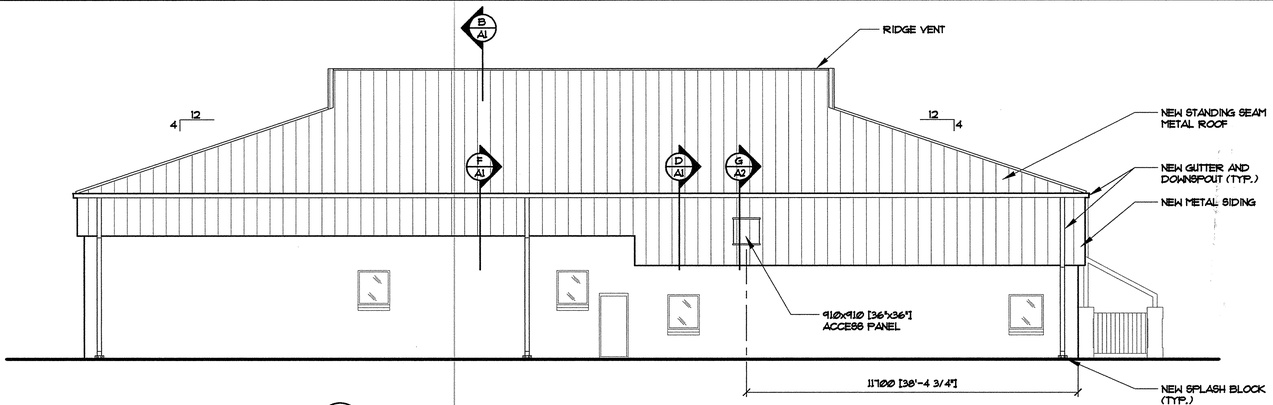

A A2 **NORTH ELEVATION**
SCALE: 1:100

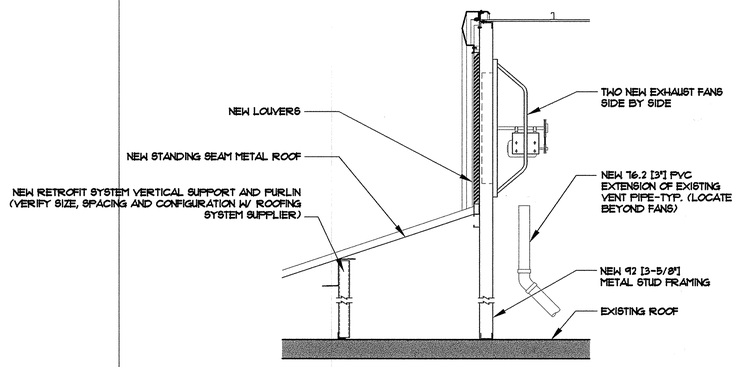

B A2 **FANS AND LOUVER DETAIL**
SCALE: 1:20

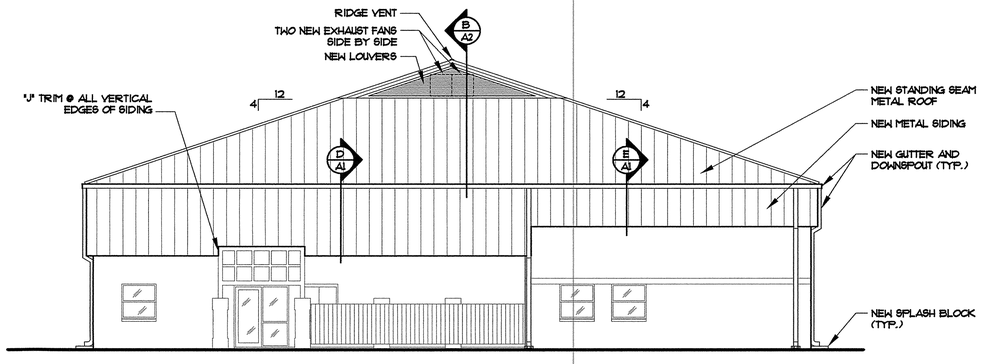

C A2 **WEST ELEVATION**
SCALE: 1:100

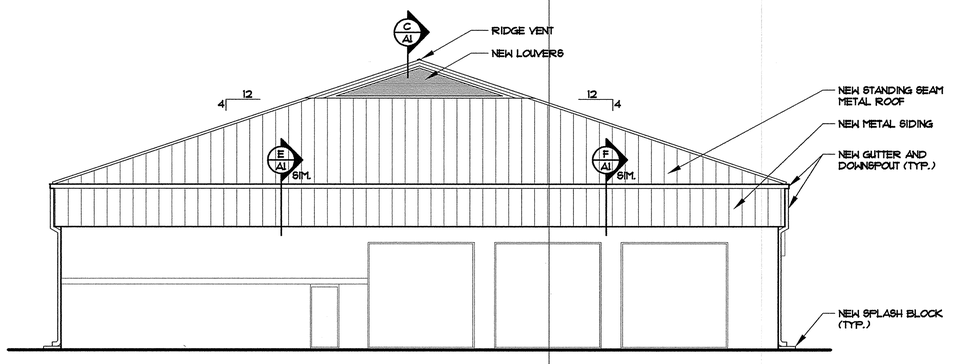

D A2 **EAST ELEVATION**
SCALE: 1:100

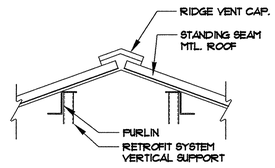

E A2 **RIDGE VENT**
SCALE: N.T.S.

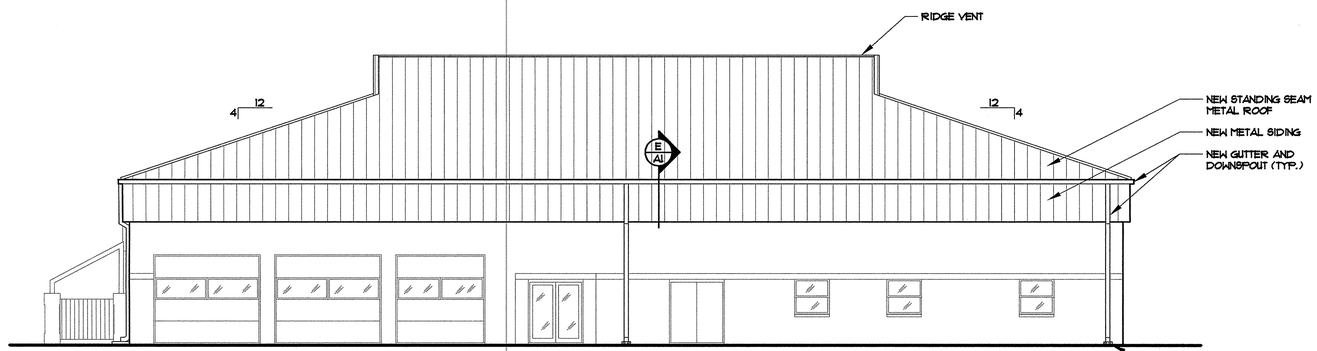

F A2 **SOUTH ELEVATION**
SCALE: 1:100

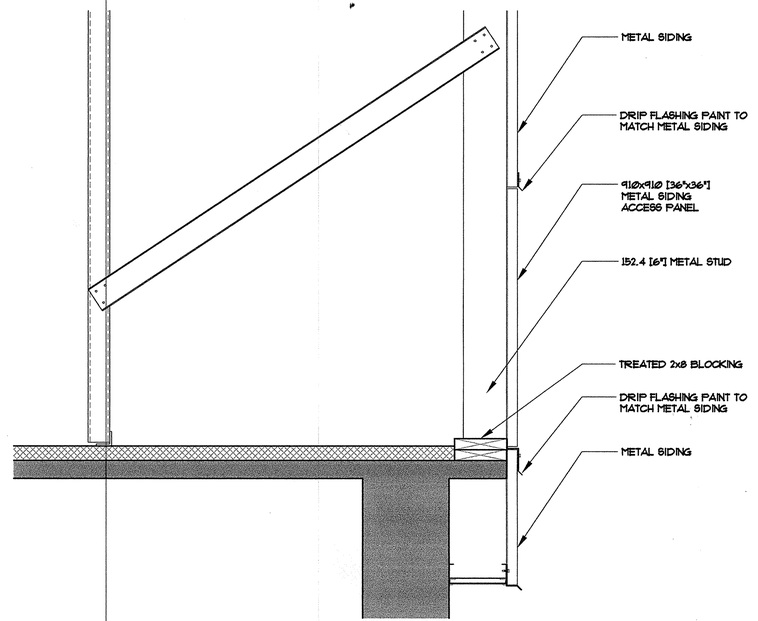

G A2 **ACCESS PANEL DETAIL**
SCALE: 1:10

FIRE STATION BUILDING 201
ARKANSAS AIR NATIONAL GUARD
FORT SMITH, ARKANSAS – HKRZ002010

REPAIR ROOF SYSTEM
TYPE "B" SERVICES

The Benham Group
Architects • Engineers
Planners • Consultants
210 Town Center SE
Bella Vista, Arkansas 72714
(501) 855-2030

DATE: 08/21/00
SCALE: AS NOTED
DESIGNED: JSR
DRAWN: ART
APPROVED: TBG

NO.	DATE	REVISIONS	BY

A2 | OF

Drawing: T:\ANG ROOF PROJECTS\201\201A02
XRefs: T:\ANG ROOF PROJECTS\DETAILS.DWG
Saved: 08/01/2000 13:15 By: LOIS DimScale: 0.00 (TM=0)