LEGEND

- BUILDING DEMOLITION
- PAVEMENT DEMOLITION
- UTILITY DEMOLITION
- STORM SEWER DEMOLITION

NOTES

1. SEE C-001 FOR GENERAL NOTES, DEMOLITION NOTES, ABBREVIATIONS AND LEGENDS.
2. CONTRACTOR TO FIELD VERIFY ALL EXISTING UTILITIES, AND NOTIFY CONTRACTING OFFICER OF ANY DISCREPANCIES.
4. ALL DIMENSIONS MEASURED FROM FACE OF CURB TO FACE OF CURB, WHERE CURB IS PRESENT, UNLESS NOTED OTHERWISE.
5. SEED ALL OPEN AREAS DISTURBED DUE TO DEMOLITION WORK. SEE EROSION AND SEDIMENT CONTROL PLAN AND DETAILS AS WELL AS DIVISION 02 SEEDING SPECIFICATION.
6. CONTRACTOR TO HAVE THE NEW GAS LINE IN PLACE PRIOR TO TAPPING INTO THE EXISTING LINE.

KEYED NOTES

① CONTRACTOR TO COORDINATE CONSTRUCTION OF NEW SEWER MAIN PRIOR TO DEMOLITION OF EXISTING SEWER MAIN TO AVOID BYPASS PUMPING.

② CONTRACTOR TO OBTAIN APPROVAL AND COORDINATE UTILITY SHUT OFFS FOR NEW UTILITY TIE INS WITH CONTRACTING OFFICER AND UTILITY COMPANIES. SEE C102 FOR NEW TIE IN LOCATIONS. PROPOSED UTILITY LINES MAY NEED TO BE INSTALLED AND TAPPED INTO EXISTING TIE IN LOCATIONS PRIOR TO DEMOLITION TO MINIMIZE UTILITY SERVICE SHUT-OFFS TO EXISTING BUILDINGS THAT ARE TO REMAIN.

③ EXISTING SSMH INVERTS WERE OBTAINED DURING A FIELD SURVEY DATED MONTH XX, 2007. CONTRACTOR TO VERIFY INVERTS AND NOTIFY CONTRACTING OFFICER OF ANY DISCREPANCIES.

④ TRANSFORMER TO BE USED FOR TEMPORARY POWER DURING CONSTRUCTION AND WILL BE DEMOLISHED AND RELOCATED NEAR THE END OF THE PROJECT.

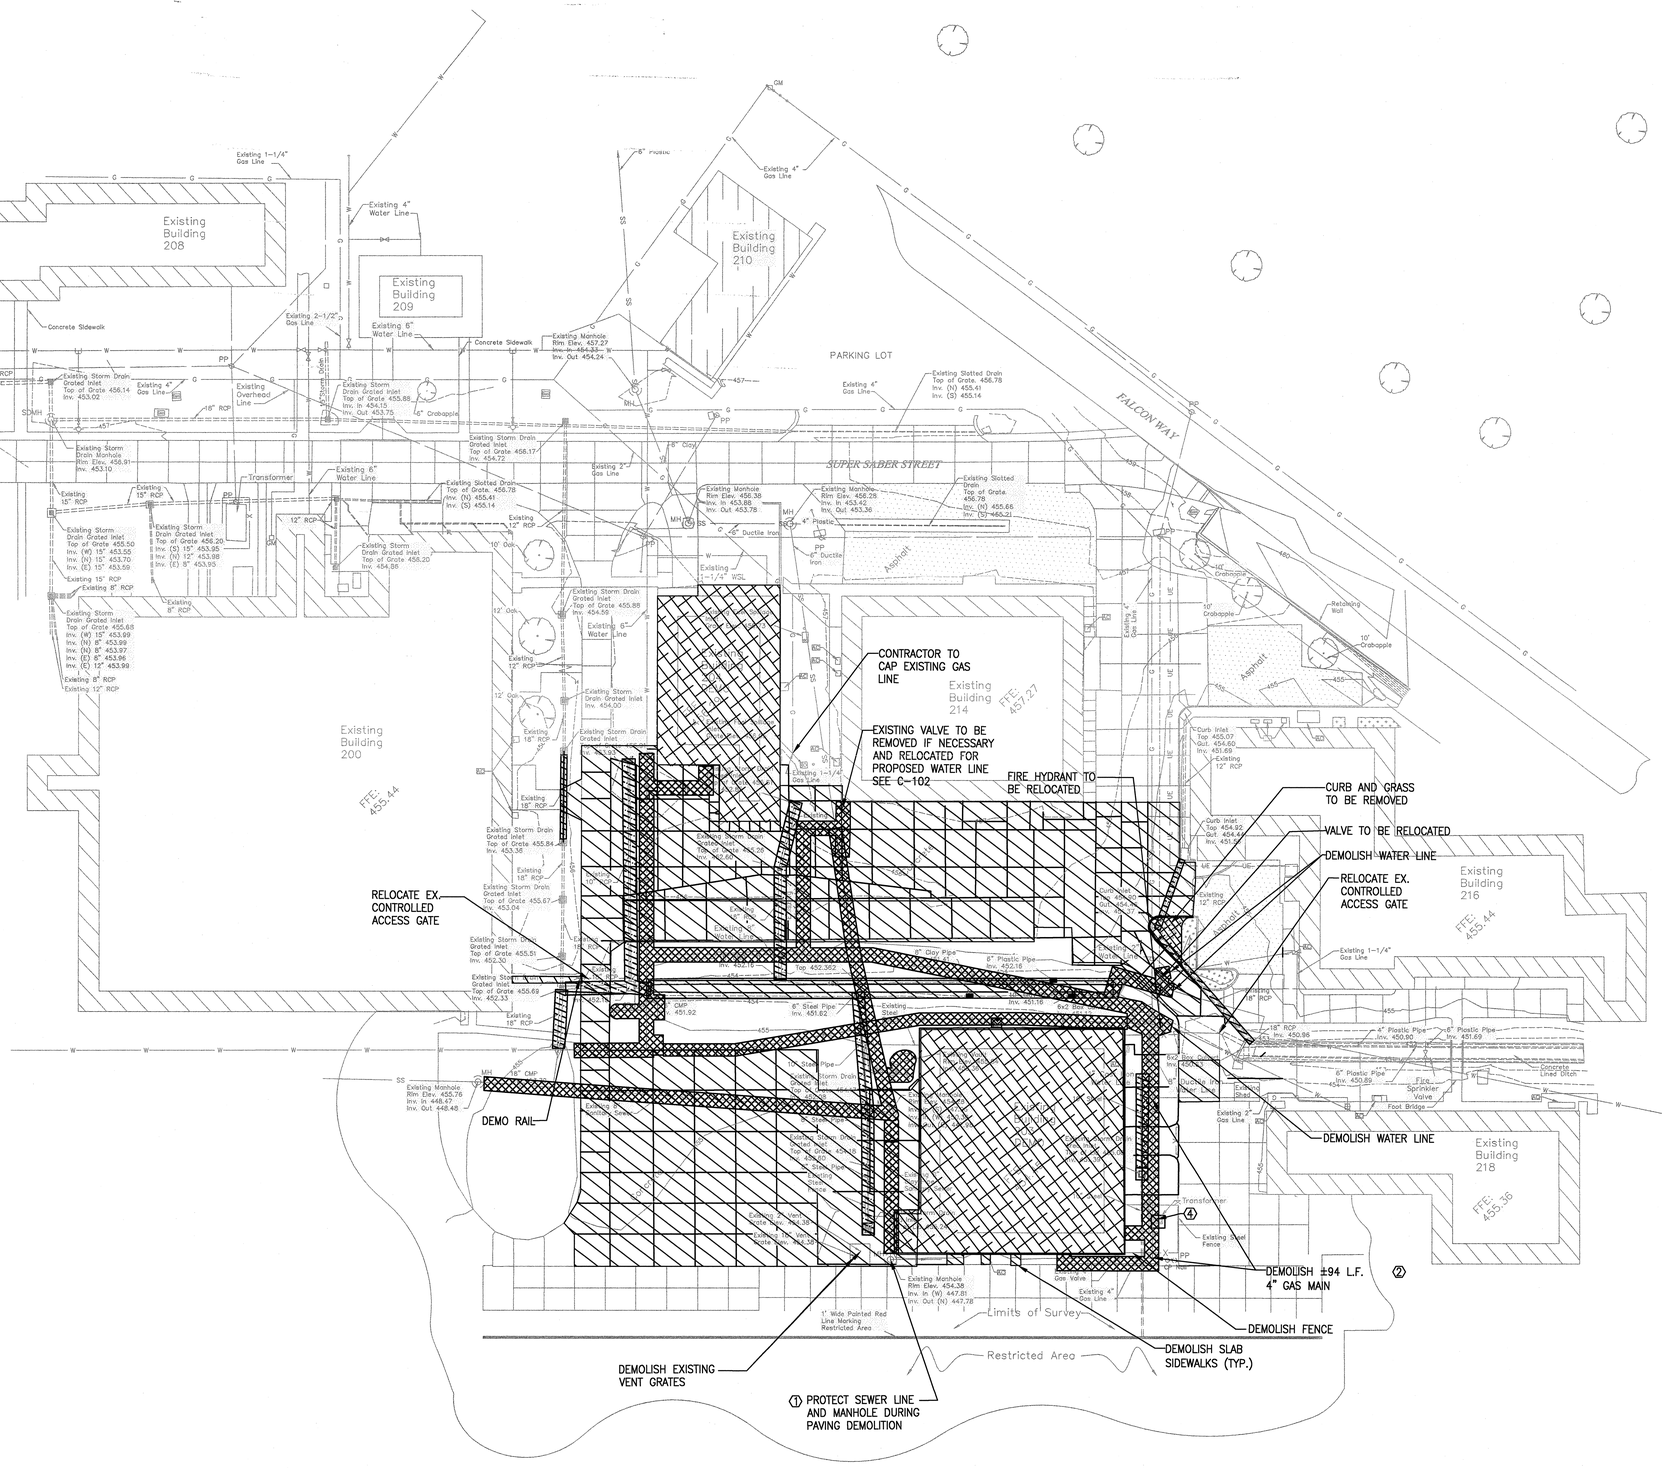
Existing Building 208
Existing Building 209
Existing Building 210
Existing Building 214
Existing Building 216
Existing Building 218
Existing Building 200
PARKING LOT
SUPER SABER STREET
FALCON WAY
Existing 1-1/4" Gas Line
Existing 4" Water Line
Existing 2-1/2" Gas Line
Existing 6" Water Line
Existing 4" Gas Line
Existing 2" Gas Line
Concrete Sidewalk
Existing Overhead Line
Existing Storm Drain Grated Inlet Top of Grate 456.14 Inv. 453.02
Existing Storm Drain Grated Inlet Top of Grate 455.88 Inv. In 454.10 Inv. Out 453.75
Existing Manhole Rim Elev. 457.27 Inv. In 454.33 Inv. Out 454.24
Existing Storm Drain Grated Inlet Top of Grate 456.17 Inv. 454.72
Existing Slotted Drain Top of Grate. 456.78 Inv. (N) 455.41 Inv. (S) 455.14
Existing Manhole Rim Elev. 456.38 Inv. In 453.88 Inv. Out 453.78
Existing Manhole Rim Elev. 456.28 Inv. In 453.42 Inv. Out 453.36
Existing Slotted Drain Top of Grate 456.78 Inv. (N) 455.66 Inv. (S) 455.21
Existing Storm Drain Manhole Rim Elev. 455.91 Inv. 453.10
Existing Storm Drain Grated Inlet Top of Grate 455.50 Inv. (W) 15" 453.55 Inv. (N) 15" 453.70 Inv. (E) 15" 453.59
Existing Storm Drain Grated Inlet Top of Grate 456.20 Inv. (S) 15" 453.95 Inv. (N) 12" 453.98 Inv. (E) 8" 453.93
Existing Storm Drain Grated Inlet Top of Grate 455.68 Inv. (W) 15" 453.99 Inv. (N) 8" 453.99 Inv. (N) 8" 453.97 Inv. (E) 8" 453.86 Inv. (E) 12" 453.99
Existing Storm Drain Grated Inlet Top of Grate 455.20 Inv. 454.86
Existing Storm Drain Grated Inlet Top of Grate 455.88 Inv. 454.59
Existing Storm Drain Grated Inlet Inv. 454.00
Existing Storm Drain Grated Inlet Top of Grate 455.84 Inv. 453.38
Existing Storm Drain Grated Inlet Top of Grate 455.67 Inv. 453.04
Existing Storm Drain Grated Inlet Top of Grate 455.51 Inv. 452.30
Existing Storm Drain Grated Inlet Top of Grate 455.69 Inv. 452.33
Existing Manhole Rim Elev. 455.76 Inv. In 448.47 Inv. Out 448.48
Existing Manhole Rim Elev. 454.38 Inv. In (W) 447.81 Inv. Out (N) 447.78
Existing Curb Inlet Top 455.07 Gut. 454.60 Inv. 451.69
Curb Inlet Top 454.92 Gut. 454.42 Inv. 451.94
Existing Transformer
Existing Steel Fence
Existing Fire Sprinkler Valve
Existing Concrete Lined Ditch
Existing Foot Bridge
Existing Retaining Wall
Existing Gas Valve
