REVISIONS			
LET	DESCRIPTION	DATE	APPROVED
	AS-BUILT DRWG. NO CORRECTIONS	7-24-73	HWM

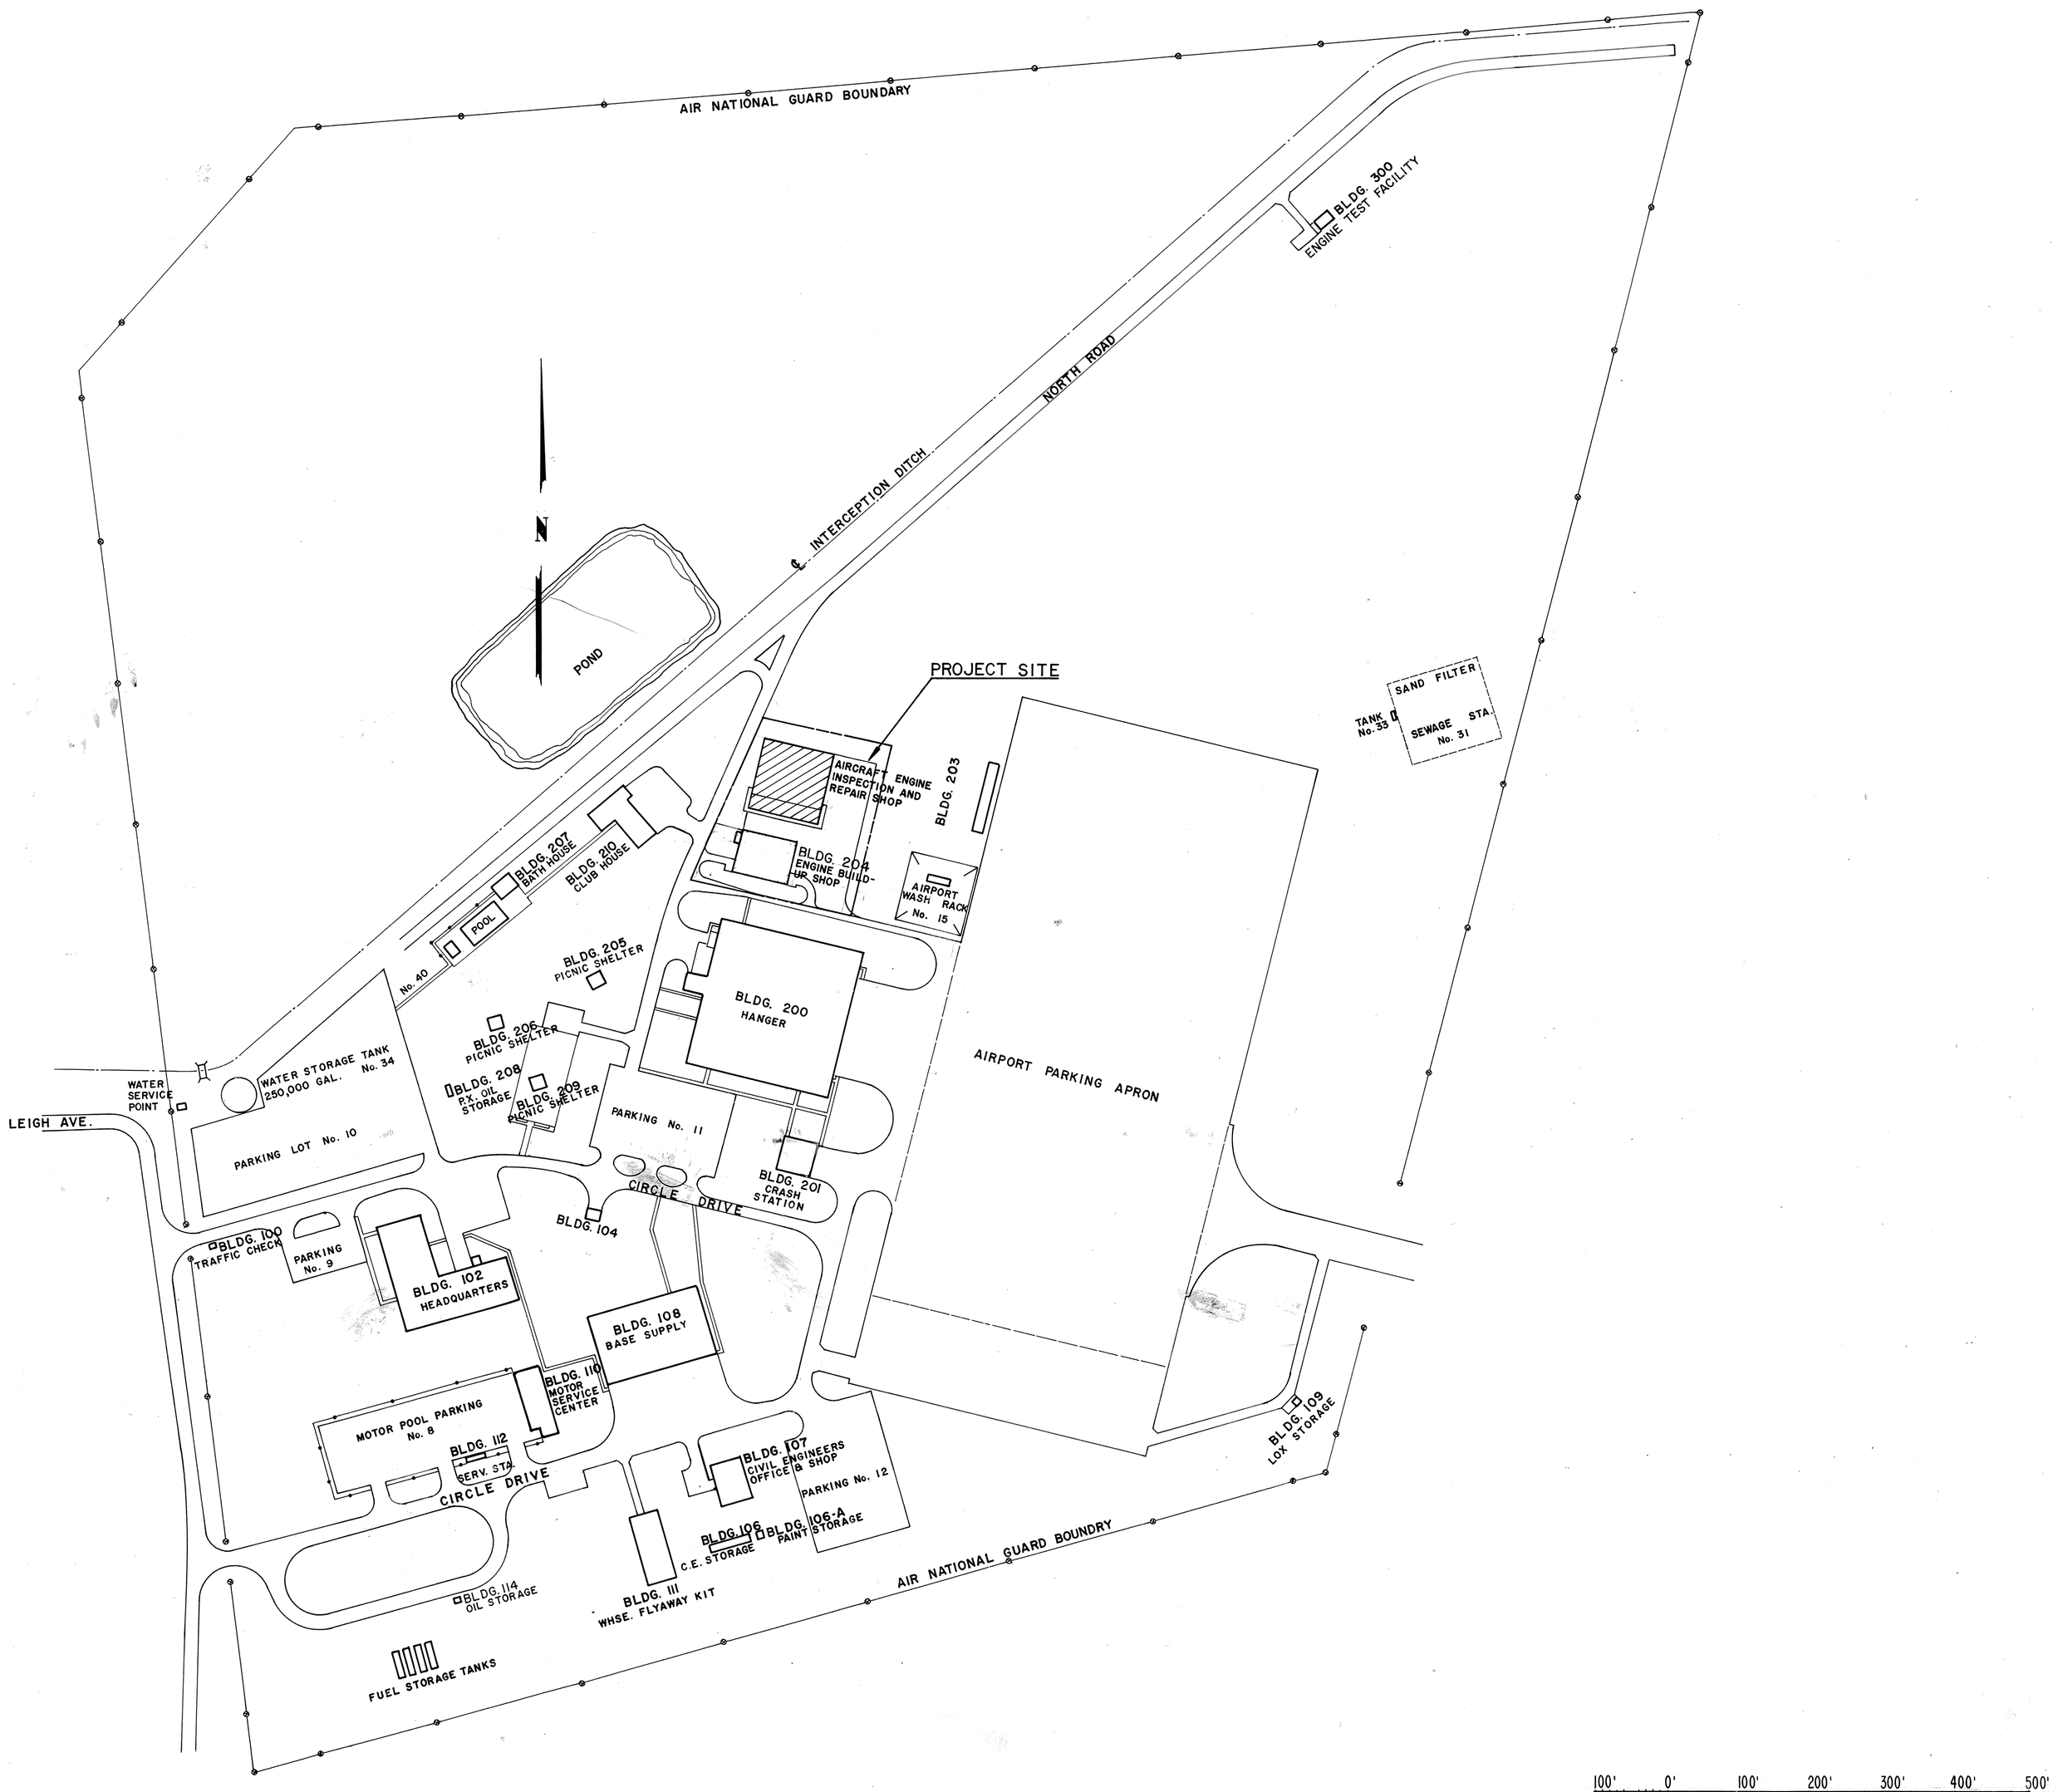

SHEET INDEX

DRAWING NUMBER		
1350142	1	LOCATION PLAN & LEGENDS
1350143	2	SITE PLAN
1350144	3	FLOOR PLAN & SCHEDULES
1350145	4	ELEVATIONS & SECTIONS
1350146	5	WALL SECTIONS
1350147	6	MISCELLANEOUS DETAILS
1350148	7	FOUNDATION PLAN & DETAILS
1350149	8	FRAMING PLAN & DETAILS
1350150	9	MECHANICAL PLAN
1350151	10	PLUMBING PLAN
5017393	11	ELECTRICAL-LIGHTING PLAN
5017394	12	ELECTRICAL-POWER PLAN
5017395	13	GRADING & DRAINAGE PLAN

LEGEND

	EXISTING DRAINAGE SWALE
	NEW DRAINAGE SWALE
SD	STORM DRAIN
+ 455.4	EXISTING SPOT ELEVATIONS
455.11	NEW SPOT ELEVATIONS
2/6 DETAIL NUMBER / SHEET NUMBER	DETAIL REFERENCE
2/5 DETAIL NUMBER / SHEET NUMBER	SECTION
5/4 DETAIL NUMBER / SHEET NUMBER	BUILDING SECTION

ABBREVIATIONS

RCP	REINFORCED CONCRETE PIPE
CI	CAST IRON PIPE
GAL	GALVANIZED PIPE
N.I.C.	NOT IN CONTRACT
WWM.	WELDED WIRE MESH
CONC.	CONCRETE
DS.	DOWNSPOUT
MT.	METAL THRESHOLD

SYMBOLS

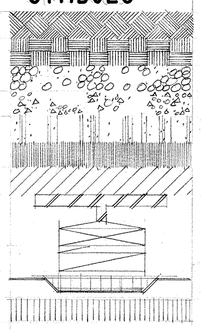

COMPACTED FILL
UNDISTURBED FILL
DRAINAGE FILL
CONCRETE
CONCRETE MASONRY UNITS
BITUMINOUS PAVING
BRICK
STEEL
WOOD BLOCKING CONTINUOUS
WOOD BLOCKING DISCONTINUOUS
FOIL-BACKED INSULATION
RIGID INSULATION

RECORD DRAWING
DATE 30 JUL 1973

NOTE: DO NOT SCALE DRAWINGS

MAHAFFEY & ASSOC.-ENGINEERS
FAYETTEVILLE, ARKANSAS

DEPARTMENT OF THE NAVY NAVAL FACILITIES ENGINEERING COMMAND
SOUTHERN DIVISION
CHARLESTON, S. C.

AIR NATIONAL GUARD - MUNICIPAL AIRPORT FT. SMITH, ARKANSAS
AIRCRAFT ENGINE INSPECTION AND REPAIR SHOP

LOCATION PLAN & LEGENDS

DSGN DR JCN III CHK
SUPV CH ENGR
SUBMITTED BY DATE
FIRM MEMBER (TITLE)
SOUTHERN DIV. DESIGN DIVISION
PDE H. Morales DIR D. Black
APPROVED DATE
OFFICER IN CHARGE
APPROVED DATE 11/18/71
EFDIVCE COMMANDER NAVFAC

SIZE	CODE IDENT NO.	NAVFAC DRAWING NO.
F	80091	1350142

CONSTR CONTR NO. N62467-70-C-0586
SCALE 1" = 100.0' SPEC 06-70-0586 SHEET 1 OF 13