REVISIONS			
LET	DESCRIPTION	DATE	APPROVED
A	PAVED ACCESS ROAD ADDED NEW MH. ADDED EXISTING ROAD LOCATION CHANGED REVISED ELECTRICAL SERVICE	1/12/72	[signature]
B	DRWG. CORRECTED TO AS-BUILT	7-24-73	HWM

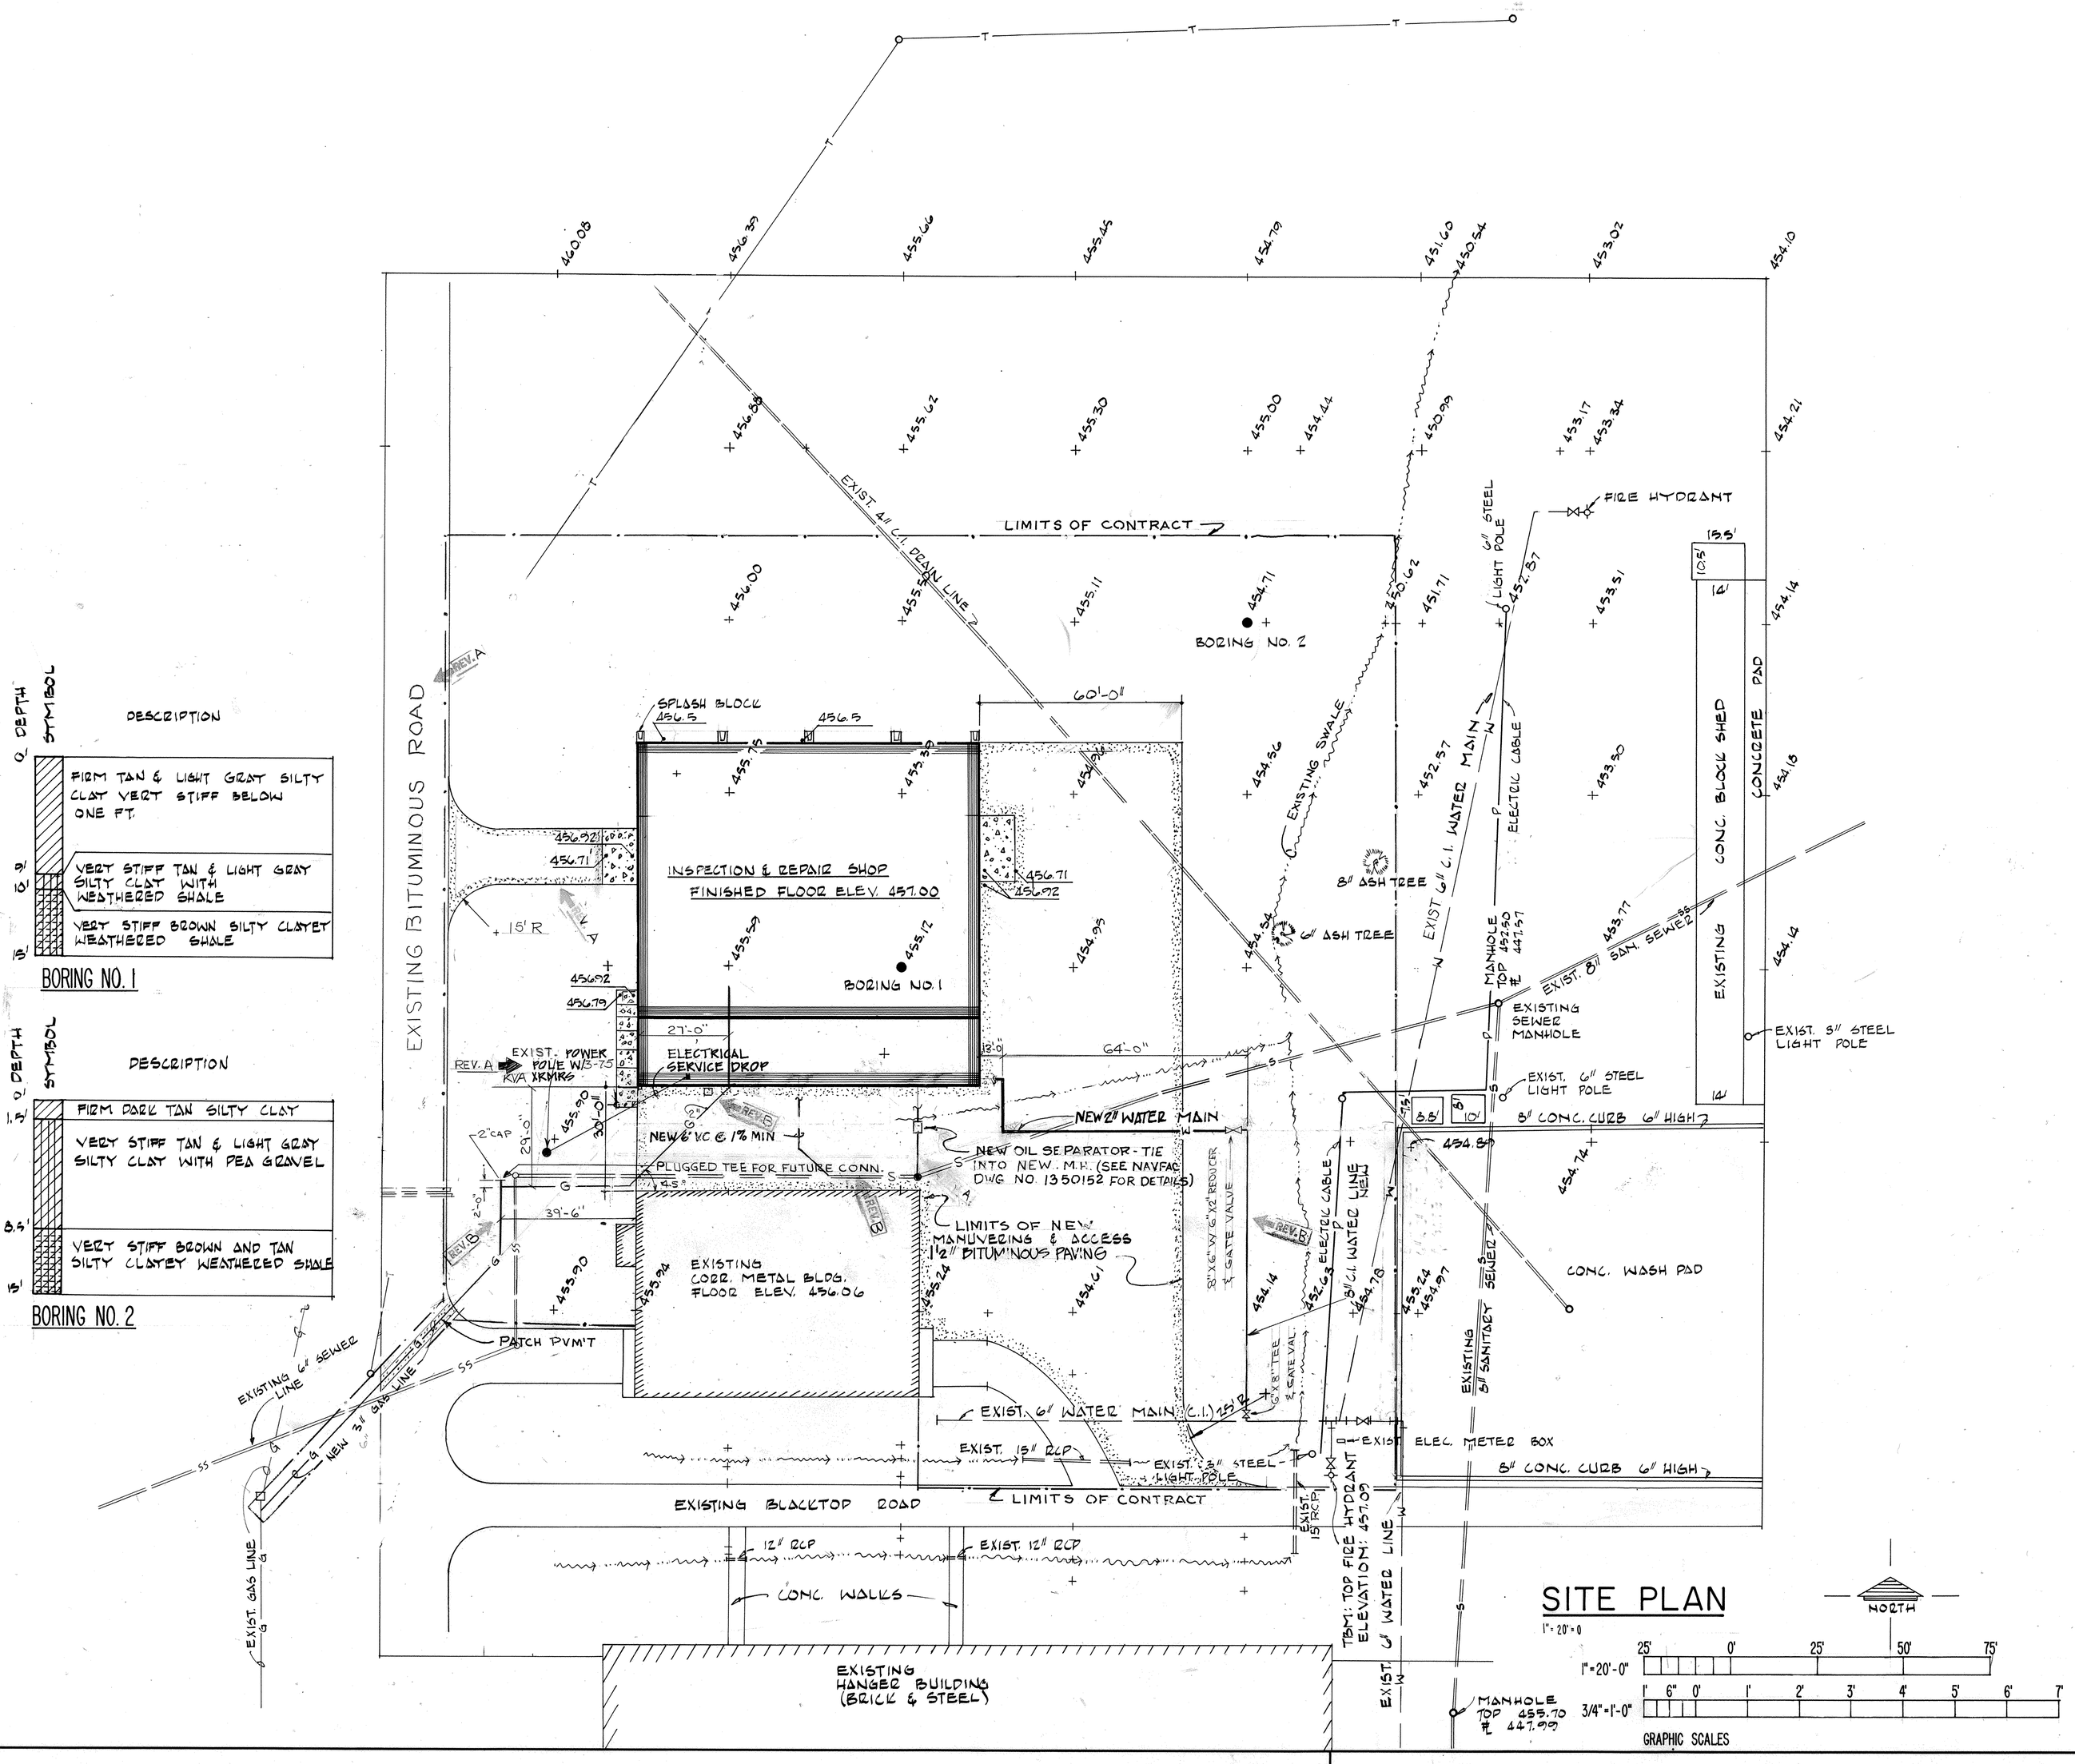

NOTE:
SEE SHEET NO. 13 FOR GRADING AND DRAINAGE.

RECORD DRAWING
DATE 30 JUL 1973

SITE PLAN
1" = 20' = 0

DO NOT SCALE DRAWINGS

MAHAFFEY & ASSOC.-ENGINEERS
FAYETTEVILLE, ARKANSAS

DEPARTMENT OF THE NAVY NAVAL FACILITIES ENGINEERING COMMAND
SOUTHERN DIVISION
CHARLESTON, S. C.

AIR NATIONAL GUARD-MUNICIPAL AIRPORT FT. SMITH, ARKANSAS
AIRCRAFT ENGINE INSPECTION AND REPAIR SHOP

SITE PLAN

SIZE	CODE IDENT NO.	NAVFAC DRAWING NO.
F	80091	1350143
SCALE AS SHOWN		CONSTR CONTR NO. N62467-70-C-0586
		SPEC 06-70-0586 SHEET 2 OF 13

DSGN DR CHK
SUPV CH ENGR
SUBMITTED BY DATE
FIRM MEMBER (TITLE)
SOUTHERN DIV. DESIGN DIVISION
PDE H. Moseley DIR
APPROVED DATE
OFFICER IN CHARGE
APPROVED DATE 11/18/71
EFD FOR COMMANDER, NAVFAC