REVISIONS			
LET	DESCRIPTION	DATE	APPROVED
SEE	NOTE BELOW CONCERNING "AS BUILT" CONDITION	7/24/73	GJL

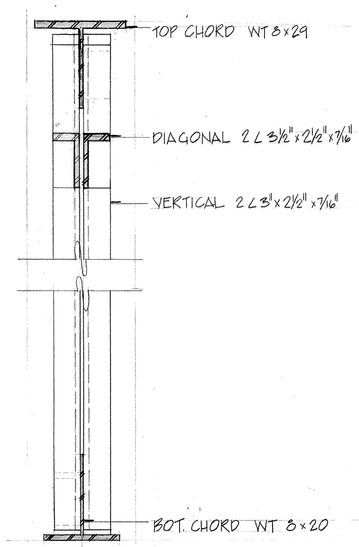

1 TRUSS DETAIL
1/2" = 1'-0"

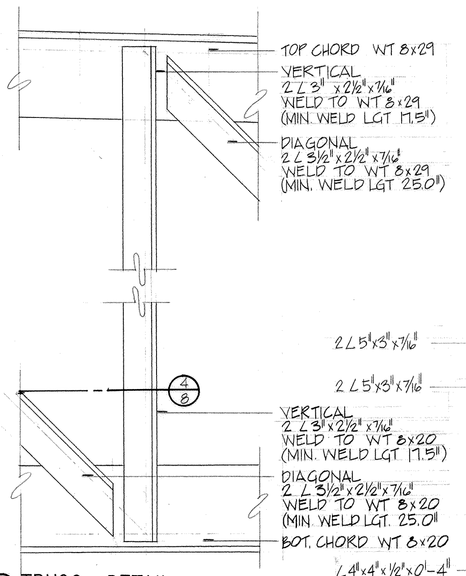

2 TRUSS DETAIL
1/2" = 1'-0"

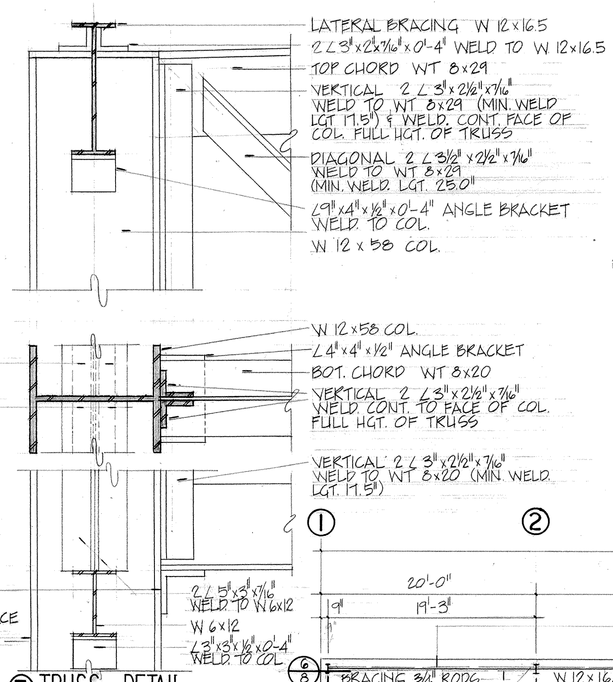

3 TRUSS DETAIL
1/2" = 1'-0"

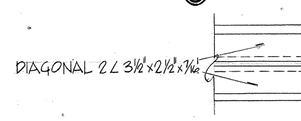

4 TRUSS DETAIL
1/2" = 1'-0"

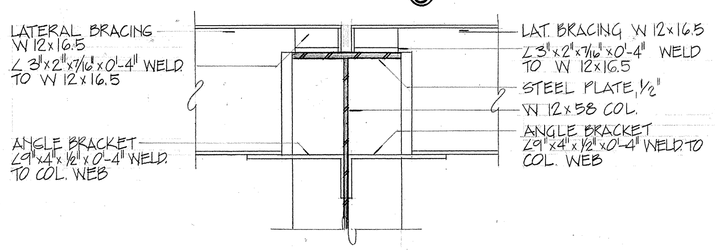

5 FRAMING DETAIL
1/2" = 1'-0"

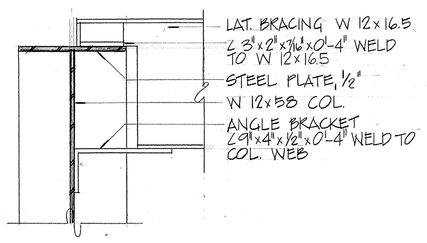

6 FRAMING DETAIL
1/2" = 1'-0"

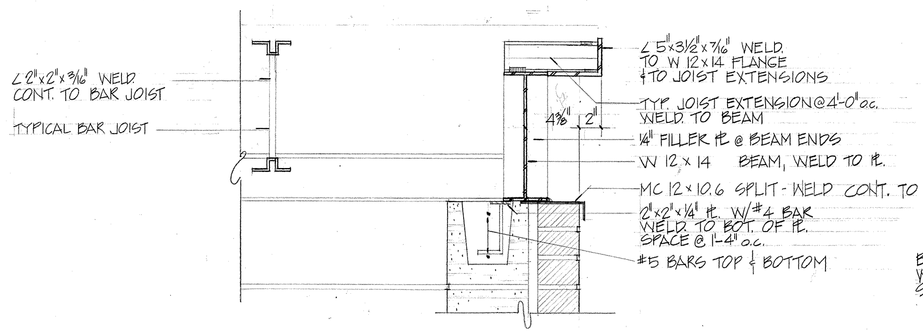

7 FRAMING DETAIL
1/2" = 1'-0"

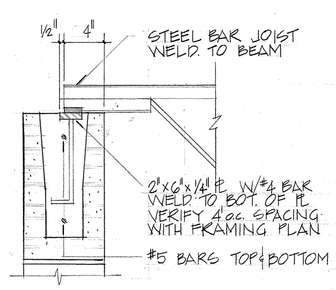

8 FRAMING DETAIL
1/2" = 1'-0"

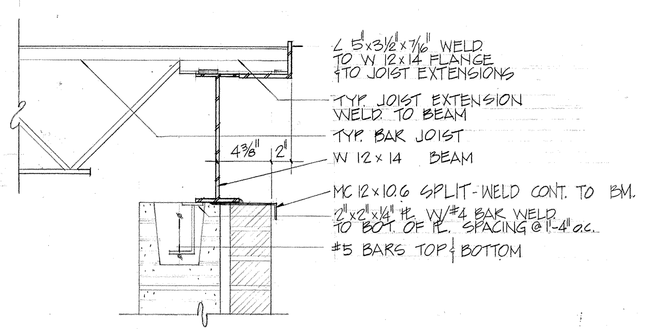

9 FRAMING DETAIL
1/2" = 1'-0"

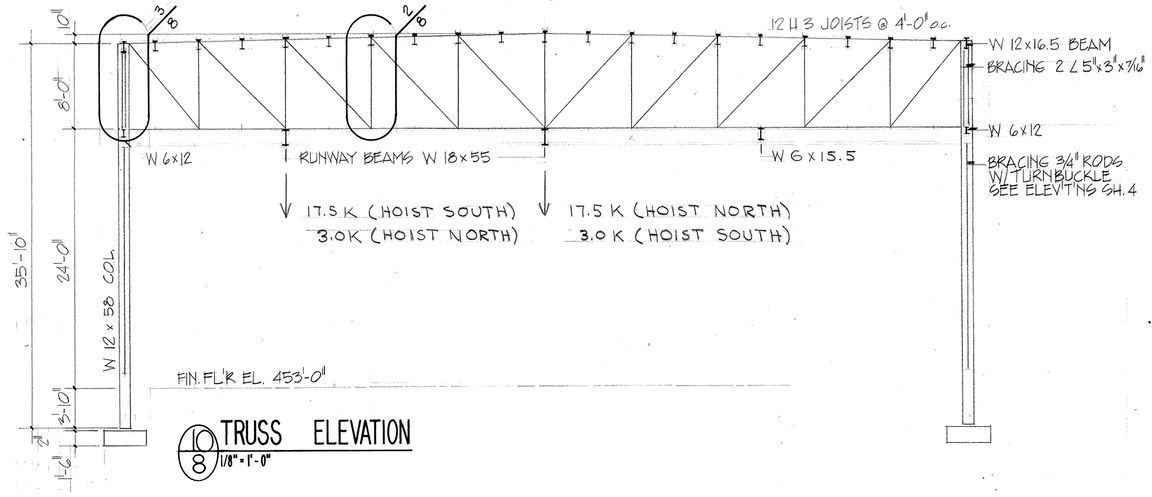

10 TRUSS ELEVATION
1/8" = 1'-0"

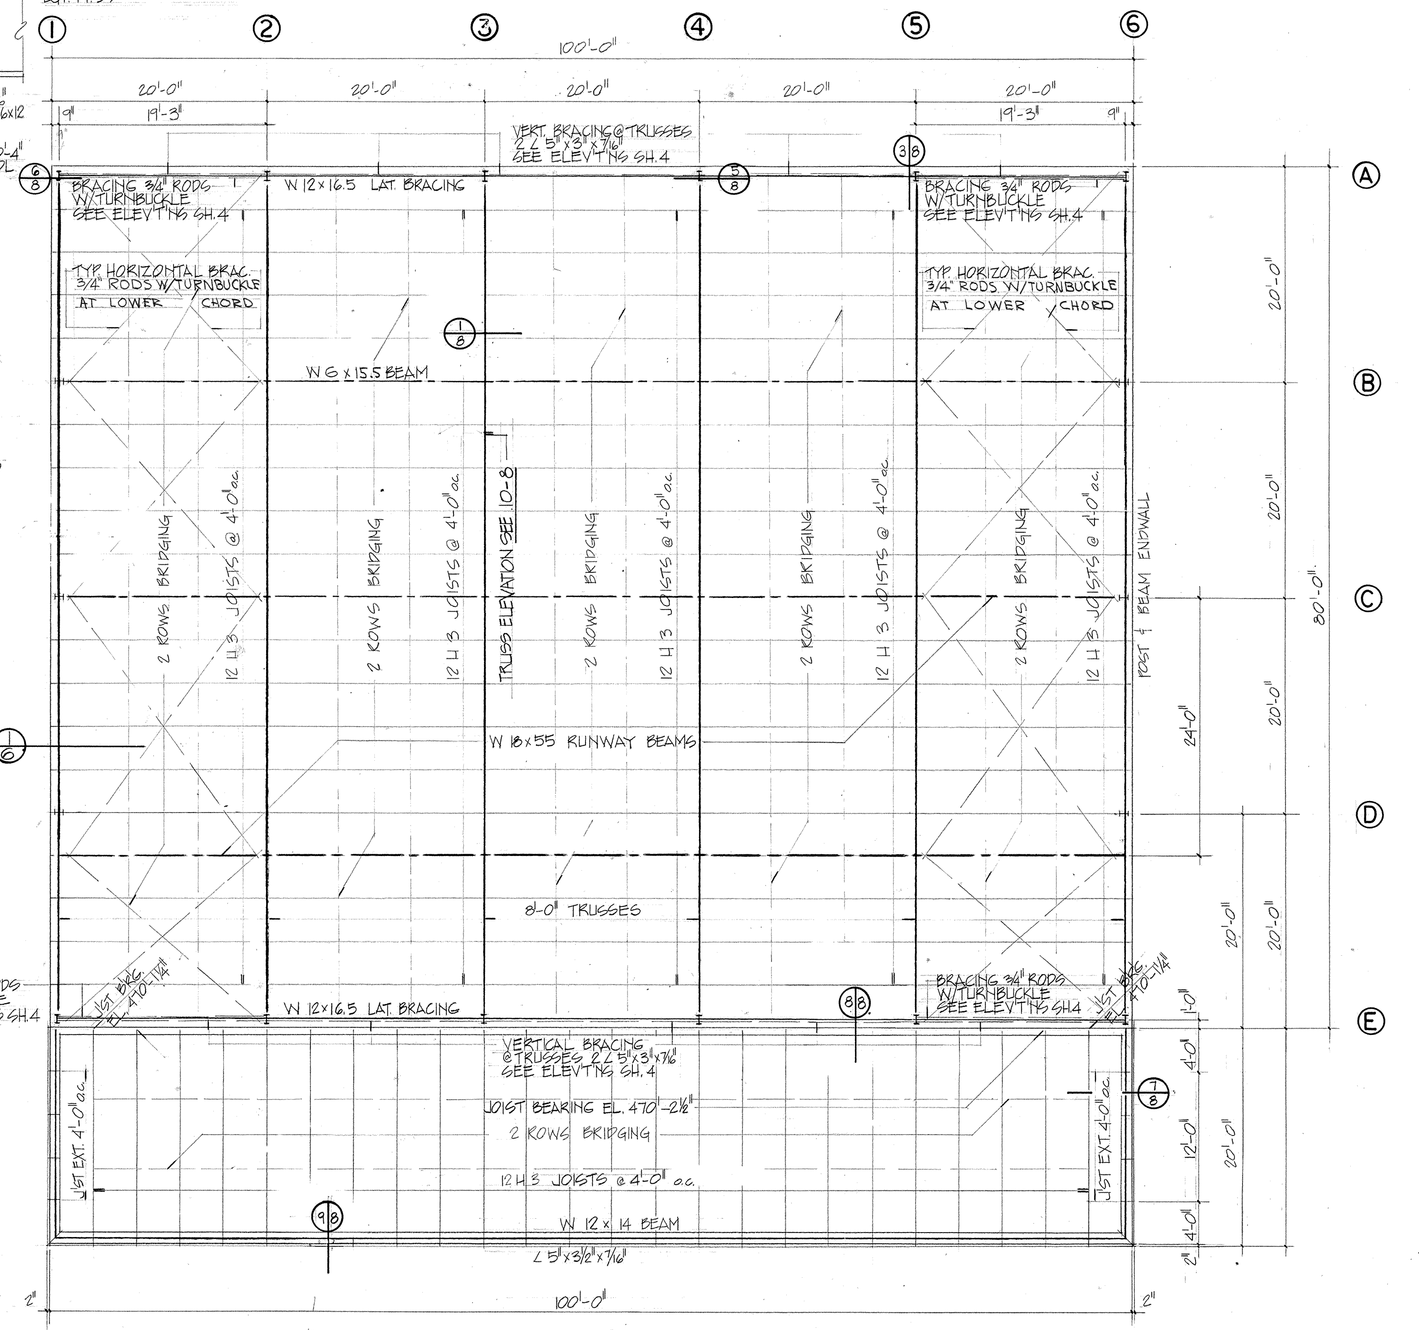

FRAMING PLAN
1/8" = 1'-0"

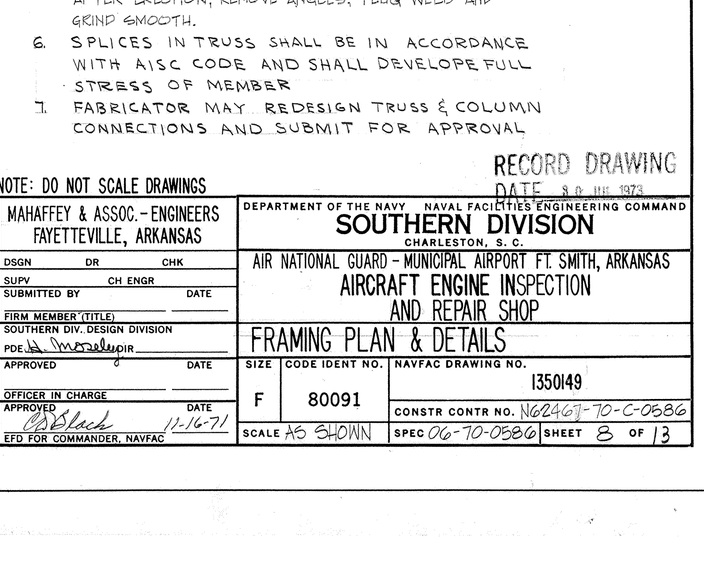

COLUMN SCHEDULE
1/4" = 1'-0"

GENERAL NOTES:

1. ALL STRUCTURAL STEEL SHALL BE NEW AND FREE FROM RUST, AND SHALL BE A.I.S.C. SPEC. A-36 STRUCT STEEL
2. ALL STEEL BELOW GRADE SHALL BE PROTECTED W/ A MIN. COVER OF 3" OF CONCRETE
3. ALL STEEL SHALL BE FABRICATED AND ERECTED AS PER SPECS. FOR DESIGN & ERECTION OF STRUCTURAL BLDG. OF AMER. INST. STEEL CONST.
4. ALL EXPOSED STEEL CONNECTIONS SHALL BE WELDED — OPTION OF BOLTED OR WELDED CONNECTIONS IN CONCEALED LOCATIONS
5. PROVIDE ERECTION ANGLES & HOLES AS REQ'D AFTER ERECTION, REMOVE ANGLES, PLUG WELD AND GRIND SMOOTH.
6. SPLICES IN TRUSS SHALL BE IN ACCORDANCE WITH AISC CODE AND SHALL DEVELOPE FULL STRESS OF MEMBER
7. FABRICATOR MAY REDESIGN TRUSS & COLUMN CONNECTIONS AND SUBMIT FOR APPROVAL

THIS DRAWING NOT CORRECTED TO AS-BUILT SINCE CONTRACTOR ELECTED TO EXERCISE OPTION TO FURNISH PRE-ENGINEERED METAL BUILDING

RECORD DRAWING

GRAPHIC SCALES
1/8" = 1'-0": 5' 0' 5' 10' 15' 20' 25' 30' 35' 40'
1/4" = 1'-0": 5' 0' 5' 10' 15'
3/4" = 1'-0": 1' 6" 0' 1' 2' 3' 4' 5' 6' 7'

NOTE: DO NOT SCALE DRAWINGS

MAHAFFEY & ASSOC. - ENGINEERS
FAYETTEVILLE, ARKANSAS

DSGN DR CHK
SUPV CH ENGR
SUBMITTED BY DATE
FIRM MEMBER (TITLE)
SOUTHERN DIV. DESIGN DIVISION
PDE
APPROVED DATE
OFFICER IN CHARGE
APPROVED 11-16-71
EFD FOR COMMANDER, NAVFAC

DEPARTMENT OF THE NAVY NAVAL FACILITIES ENGINEERING COMMAND
SOUTHERN DIVISION
CHARLESTON, S. C.

AIR NATIONAL GUARD - MUNICIPAL AIRPORT FT. SMITH, ARKANSAS
AIRCRAFT ENGINE INSPECTION AND REPAIR SHOP

FRAMING PLAN & DETAILS

SIZE F | CODE IDENT NO. 80091 | NAVFAC DRAWING NO. 1350149
CONSTR CONTR NO. N62467-70-C-0586
SCALE AS SHOWN | SPEC 06-70-0586 | SHEET 8 OF 13