REVISIONS			
LET	DESCRIPTION	DATE	APPROVED
	SEE NOTE BELOW CONCERNING "AS BUILT" CONDITIONS	7/24/73	RJS

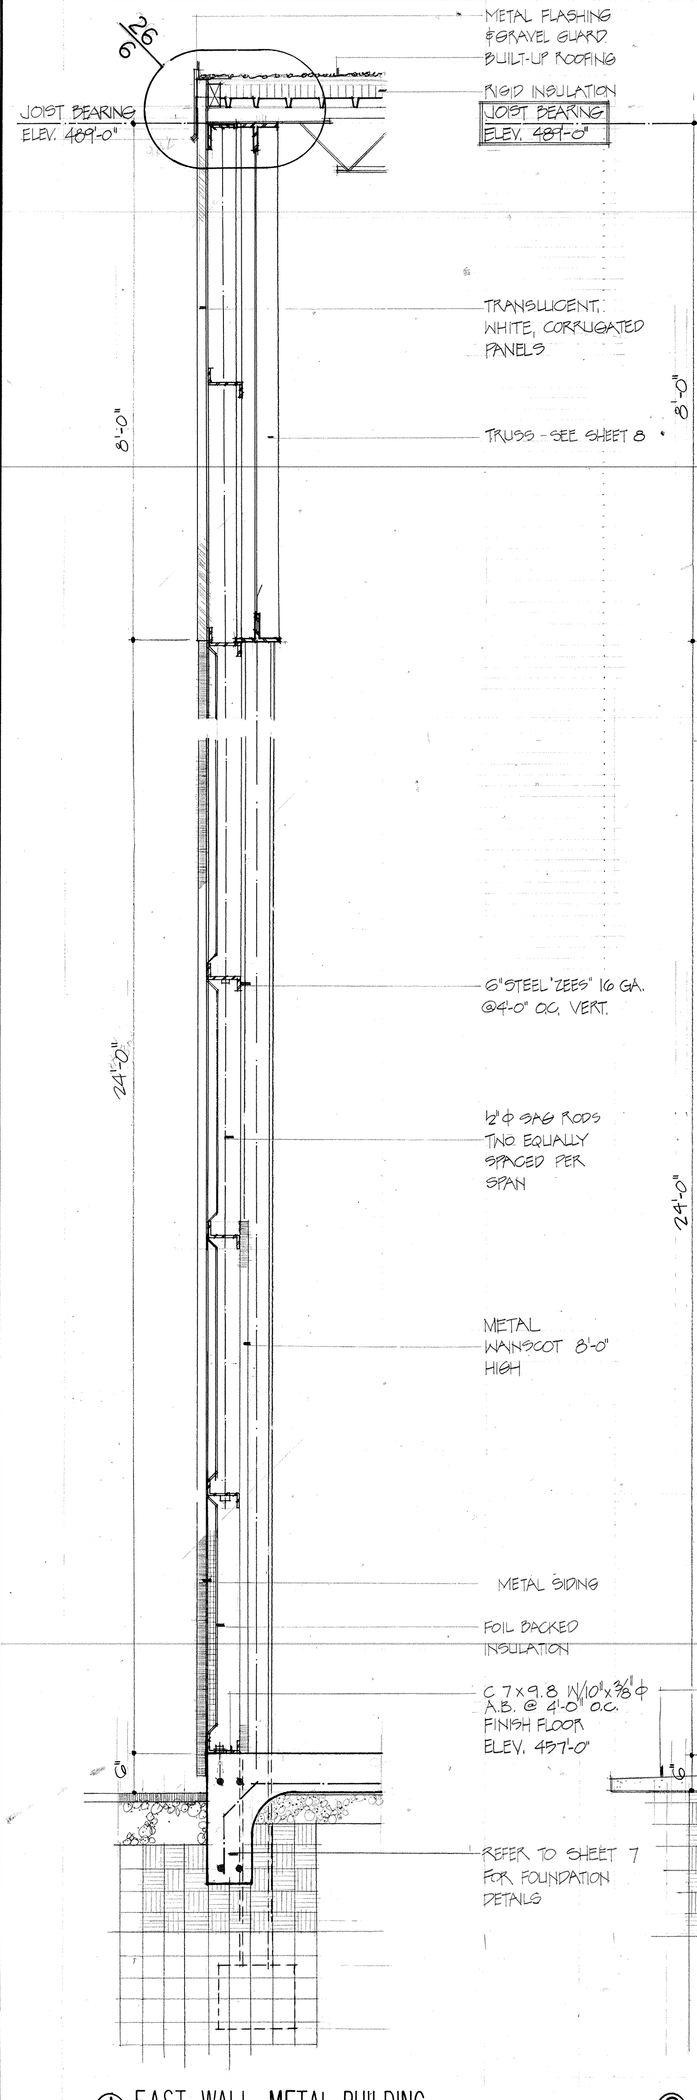

1/5 EAST WALL METAL BUILDING
3/4"=1'-0"

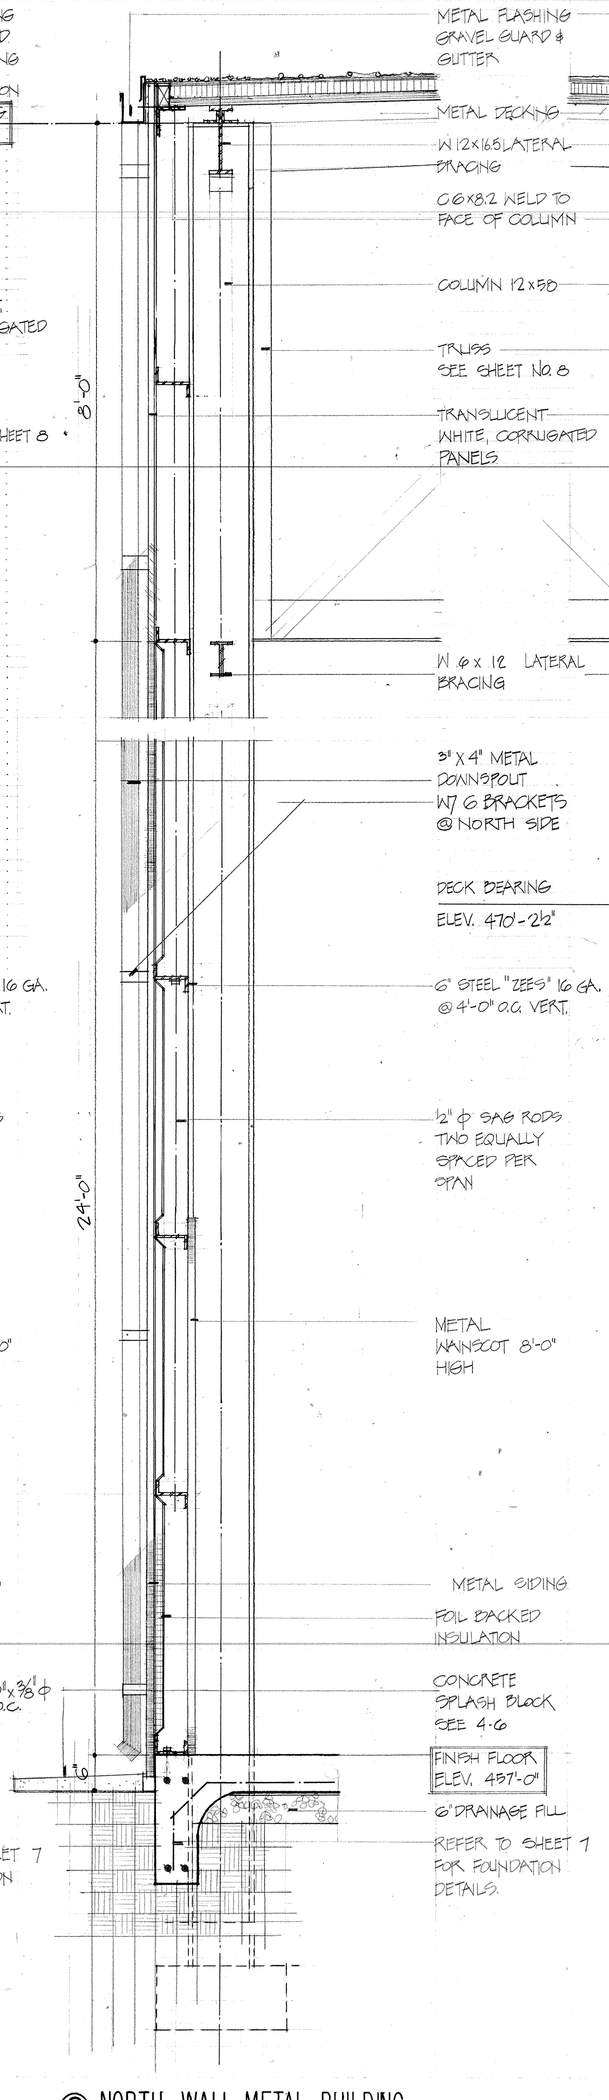

2/5 NORTH WALL METAL BUILDING
3/4"=1'-0"

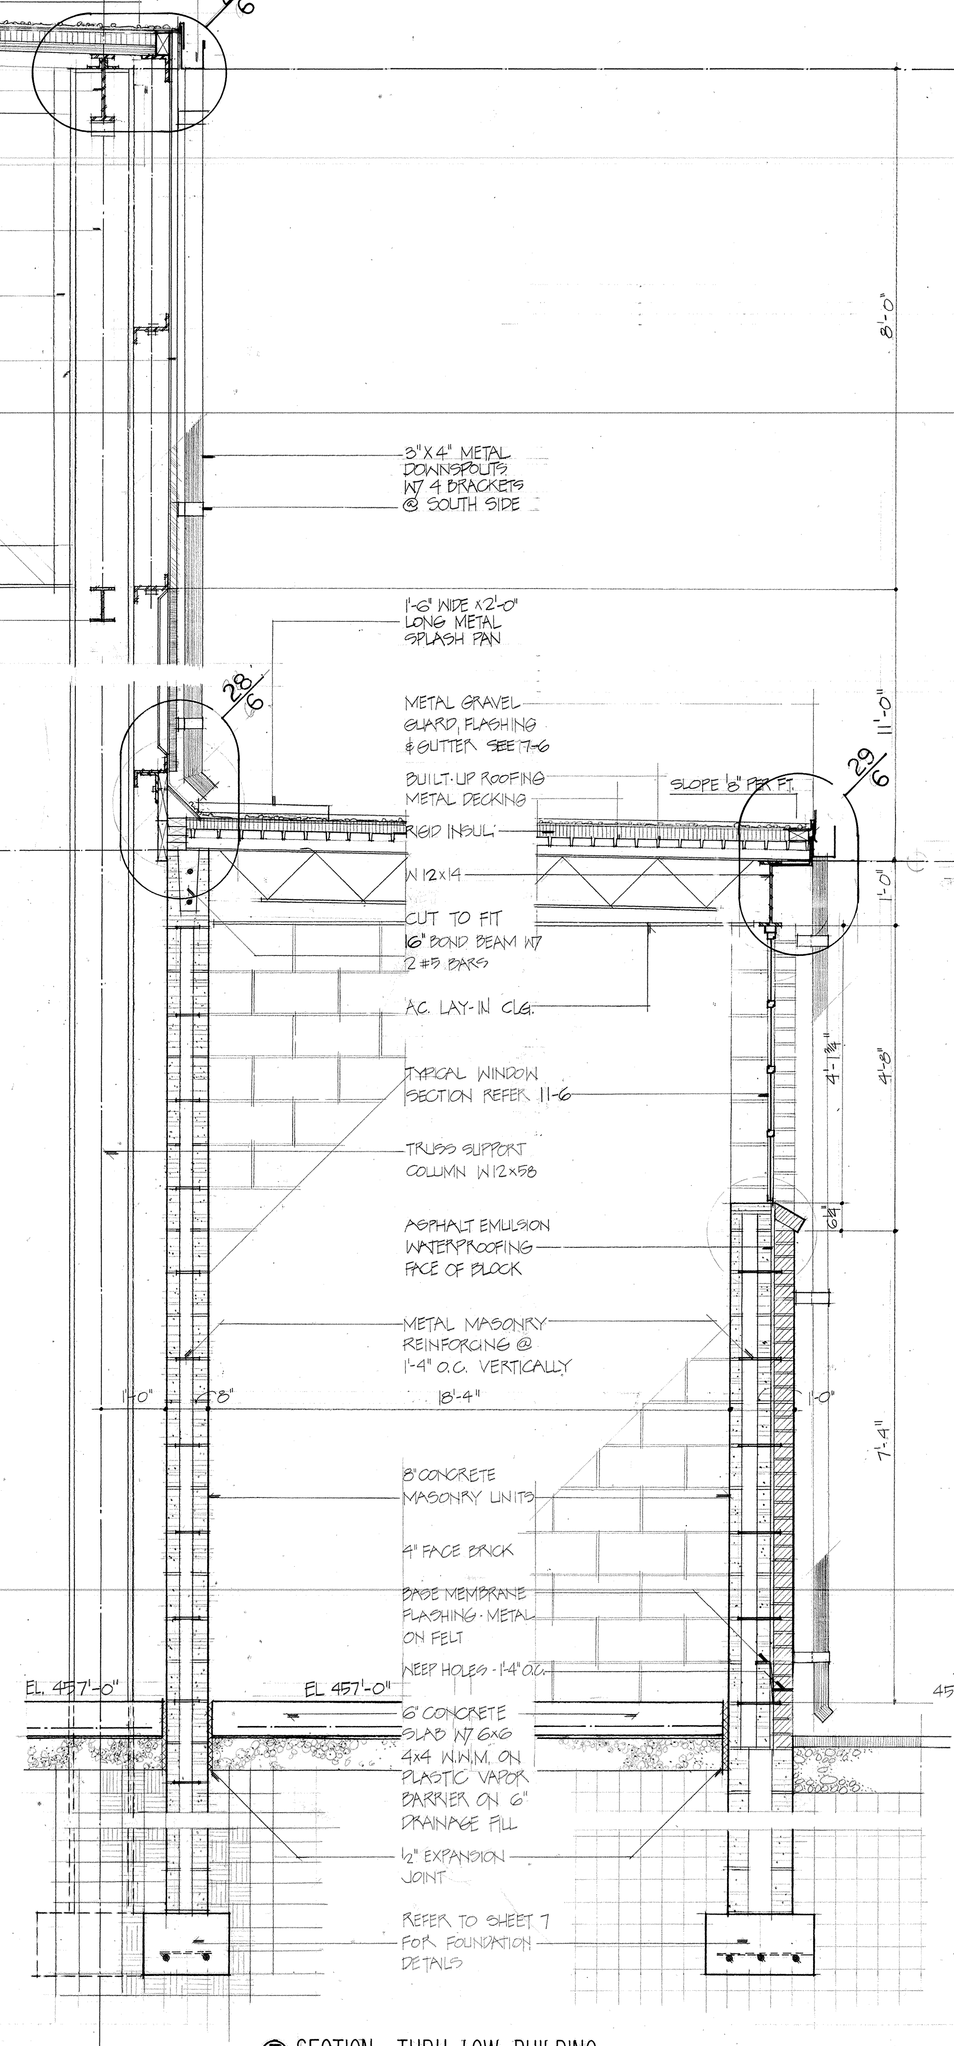

3/5 SECTION THRU LOW BUILDING
3/4"=1'-0"

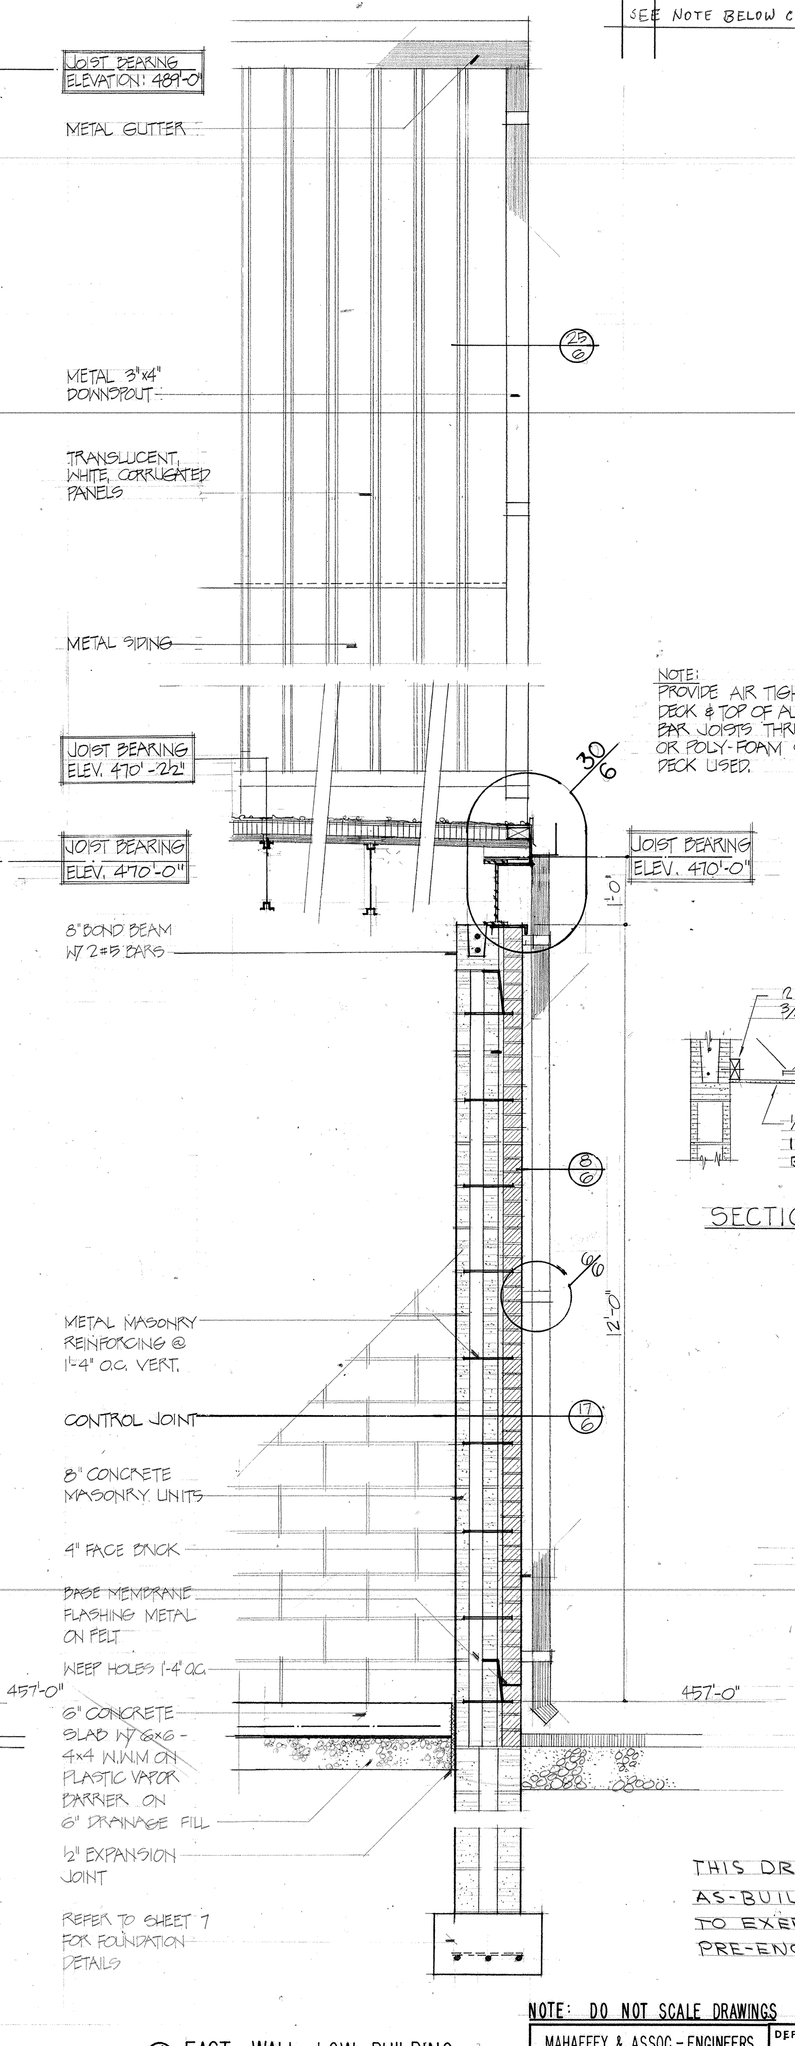

4/5 EAST WALL LOW BUILDING
3/4"=1'-0"

NOTE:
PROVIDE AIR TIGHT SEAL BETWEEN RIBS OF METAL DECK & TOP OF ALL BLOCK WALLS & AROUND ALL BAR JOISTS THRU BLOCK WALLS. USE RUBBER OR POLY-FOAM CUT OR PRE-FORMED FOR TYPE DECK USED.

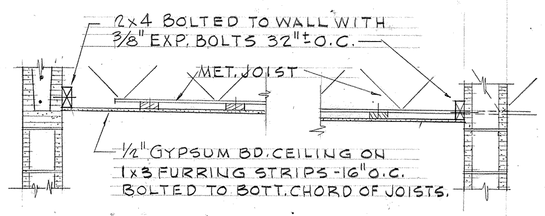

SECTION THRU CEILING - ROOM 104
SCALE: 3/4"=1'-0"

THIS DRAWING NOT CORRECTED TO AS-BUILT SINCE CONTRACTOR ELECTED TO EXERCISE OPTION TO PROVIDE PRE-ENGINEERED METAL BUILDING

RECORD DRAWING
DATE 8 0 JUL 1973

3/4"=1'-0" 1' 6" 0' 1' 2' 3' 4' 5' 6' 7'
GRAPHIC SCALE

NOTE: DO NOT SCALE DRAWINGS

MAHAFFEY & ASSOC. - ENGINEERS FAYETTEVILLE, ARKANSAS	DEPARTMENT OF THE NAVY NAVAL FACILITIES ENGINEERING COMMAND SOUTHERN DIVISION CHARLESTON, S. C.
DSGN DR CHK	AIR NATIONAL GUARD - MUNICIPAL AIRPORT, FT. SMITH, ARKANSAS
SUPV CH ENGR	AIRCRAFT ENGINE INSPECTION AND REPAIR SHOP
SUBMITTED BY DATE	
FIRM MEMBER (TITLE)	WALL SECTIONS
SOUTHERN DIV. DESIGN DIVISION PDE W. Smoak DIR	
APPROVED DATE	SIZE F; CODE IDENT NO. 80091; NAVFAC DRAWING NO. 1350146
OFFICER IN CHARGE	
APPROVED DATE 11-16-71	CONSTR CONTR NO. N62467-70-C-0586
EFD FOR COMMANDER, NAVFAC	SCALE 3/4"=1'-0" SPEC 06-70-0586 SHEET 5 OF 13