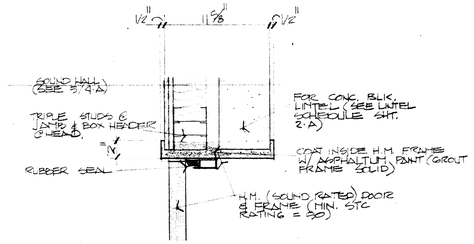

1 HEAD & JAMB 1½"=1'-0"

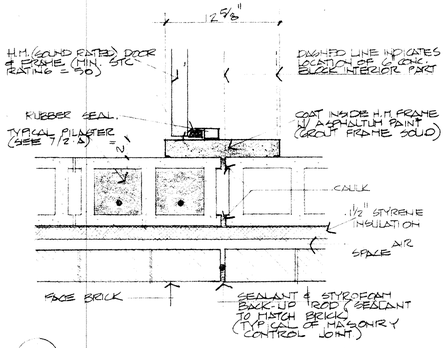

2 JAMB 1½"=1'-0"

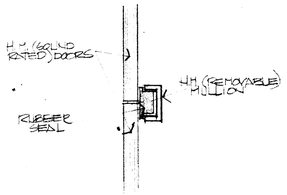

3 MULLION 1½"=1'-0"

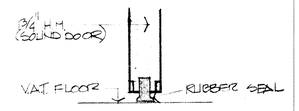

4 DETAIL 3"=1'-0"

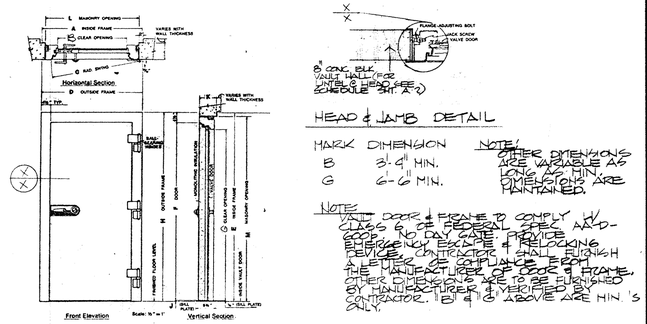

HEAD & JAMB DETAIL

MARK	DIMENSION
B	3'-4" MIN.
G	6'-6" MIN.

NOTE: OTHER DIMENSIONS ARE VARIABLE AS LONG AS MIN. DIMENSIONS ARE MAINTAINED.


5 VAULT DOOR DETAILS NO SCALE

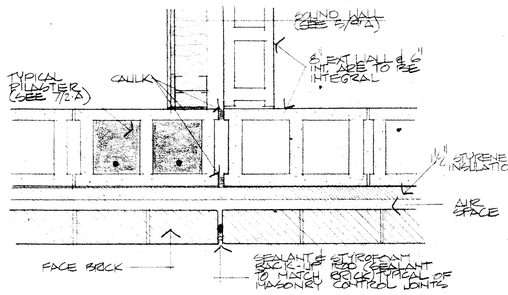

6 DETAIL 1½"=1'-0"

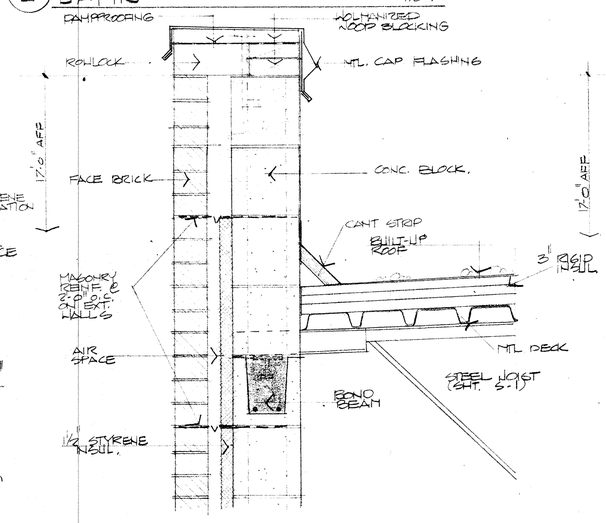

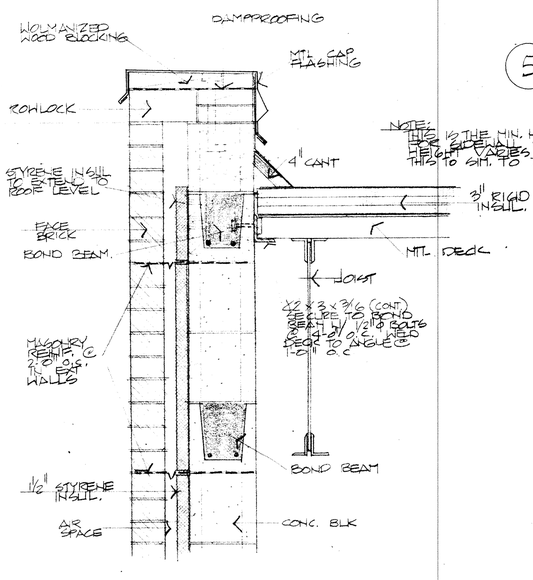

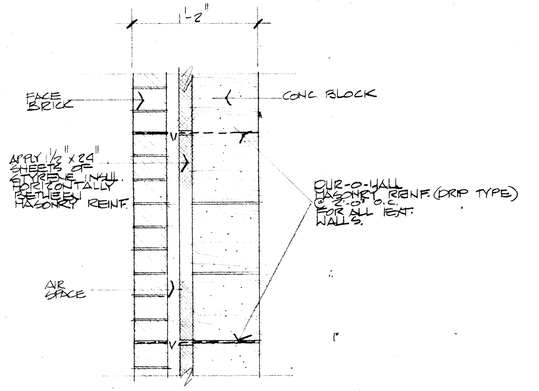

7 PARAPET DETAIL 1½"=1'-0"

8 PARAPET DETAIL 1½"=1'-0"

9 INSULATION DETAIL 1½"=1'-0"

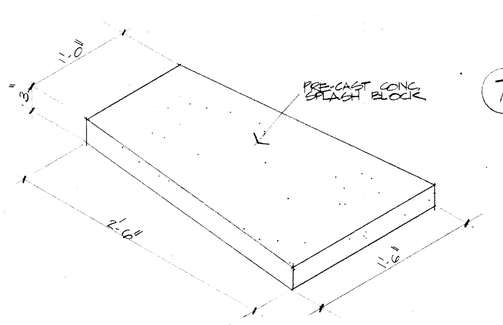

10 SPLASH BLOCK DETAIL 1½"=1'-0"

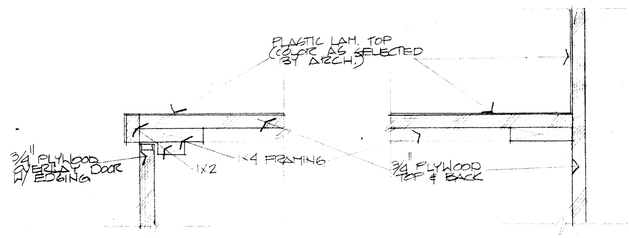

11 DETAIL 3"=1'-0"

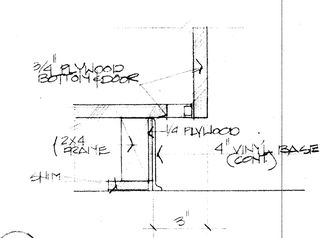

12 DETAIL 3"=1'-0"

13 DETAIL 3"=1'-0"

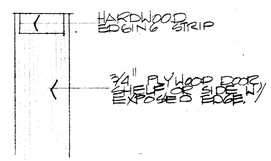

14 EDGING DETAIL

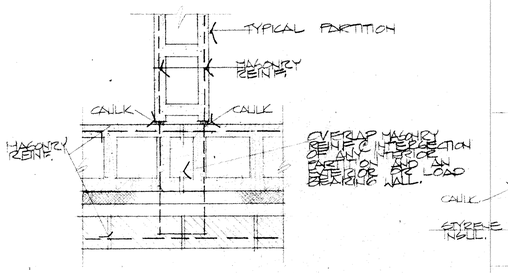

15 DETAIL 1½"=1'-0"

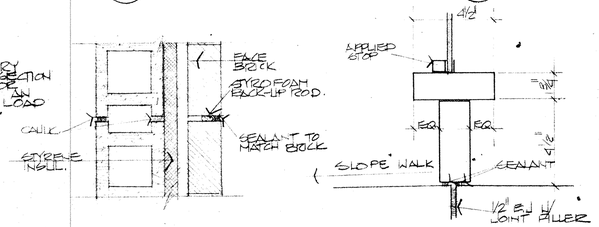

16 TYPICAL CONTROL JOINT 1½"=1'-0"

17 TEE-SECTION 3"=1'-0"

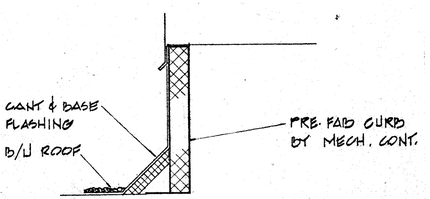

18 ROOF CURB DETAIL NO SCALE

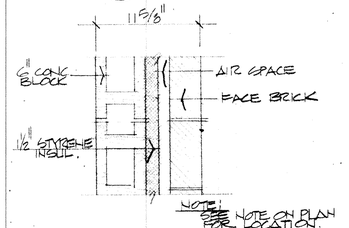

19 12" EXT. WALL 1½"=1'-0"

LKHG

LASER KNIGHT HATHAWAY & GUEST, P.A.
ARCHITECTS • ENGINEERS • HEALTH CARE PLANNERS
800 FIRST NATIONAL BANK • FORT SMITH, ARKANSAS

REGISTERED ARCHITECT

AVIONICS FACILITY

ARKANSAS AIR NATIONAL GUARD
FORT SMITH, ARKANSAS

MISCELLANEOUS DETAILS

REVISIONS

JOB NUMBER 1966

DATE 2.9.77

SHEET 5 of 5 SHEETS

CATEGORY A