FIXTURE SCHEDULE

TYPE	MANUFACTURER	LAMPS	REMARKS	VOLT.	EQUAL MANUF.
A	DAYBRITE #SQ24-SRA12D-ESB	4-F40/RS/WM	2'x4' FLUOR. LAY-IN	277	LITHONIA, METALUX
A1	DAYBRITE #ESQ24-SRA12D-ESB	4-F40/RS/WM	2'x4' FLUOR. LAY-IN W/ EMERG. BATTERY PACK	277	" "
B	DAYBRITE #SQ242-SRA12D-ESB	2-F40/RS/WM	2'x4' FLUOR. LAY-IN	277	" "
B1	DAYBRITE #ESQ242-SRA12D-ESB	2-F40/RS/WM	2'x4' FLUOR. LAY-IN W/ EMERG. BATTERY PACK	277	" "
C	DAYBRITE #4NZR-ESB	2-F40/RS/WM	4' STRIP W/ REFLECTOR	277	LITHONIA, WILLIAMS
C1	DAYBRITE #ENZR-ESB	2-F40/RS/WM	4' STRIP W/REFLECTOR-EMERG. BATTERY PACK	277	" "
D	KEENE #3231501LX-PC	1-150W/HPS	HID WALL LT.	277	McPHILBIN, ERVINE
E	OMEGA #C5014TW-C	1-150W/R40	INC. DN. LT.	120	MARCO, KIRLIN
E_R	———	RELAMP	EXISTING LIGHT FIXTURE TO BE RELOCATED	—	———
⊗ N.S.	McPHILBIN #ER40C-BF	W/UNIT	EMG. MTD. EXIT SIGN ARROWS AS INDICATED	277	EXIDE, LITHONIA
E_X	———	RELAMP	EXIST'G LIGHT FIXTURE TO REMAIN	—	———

NOTE: ALL EXISTING FIXTURES SHOWN ON THIS SHT. SHALL BE RELAMPED W/ F40/RS/WM ENERGY SAVING LAMPS.

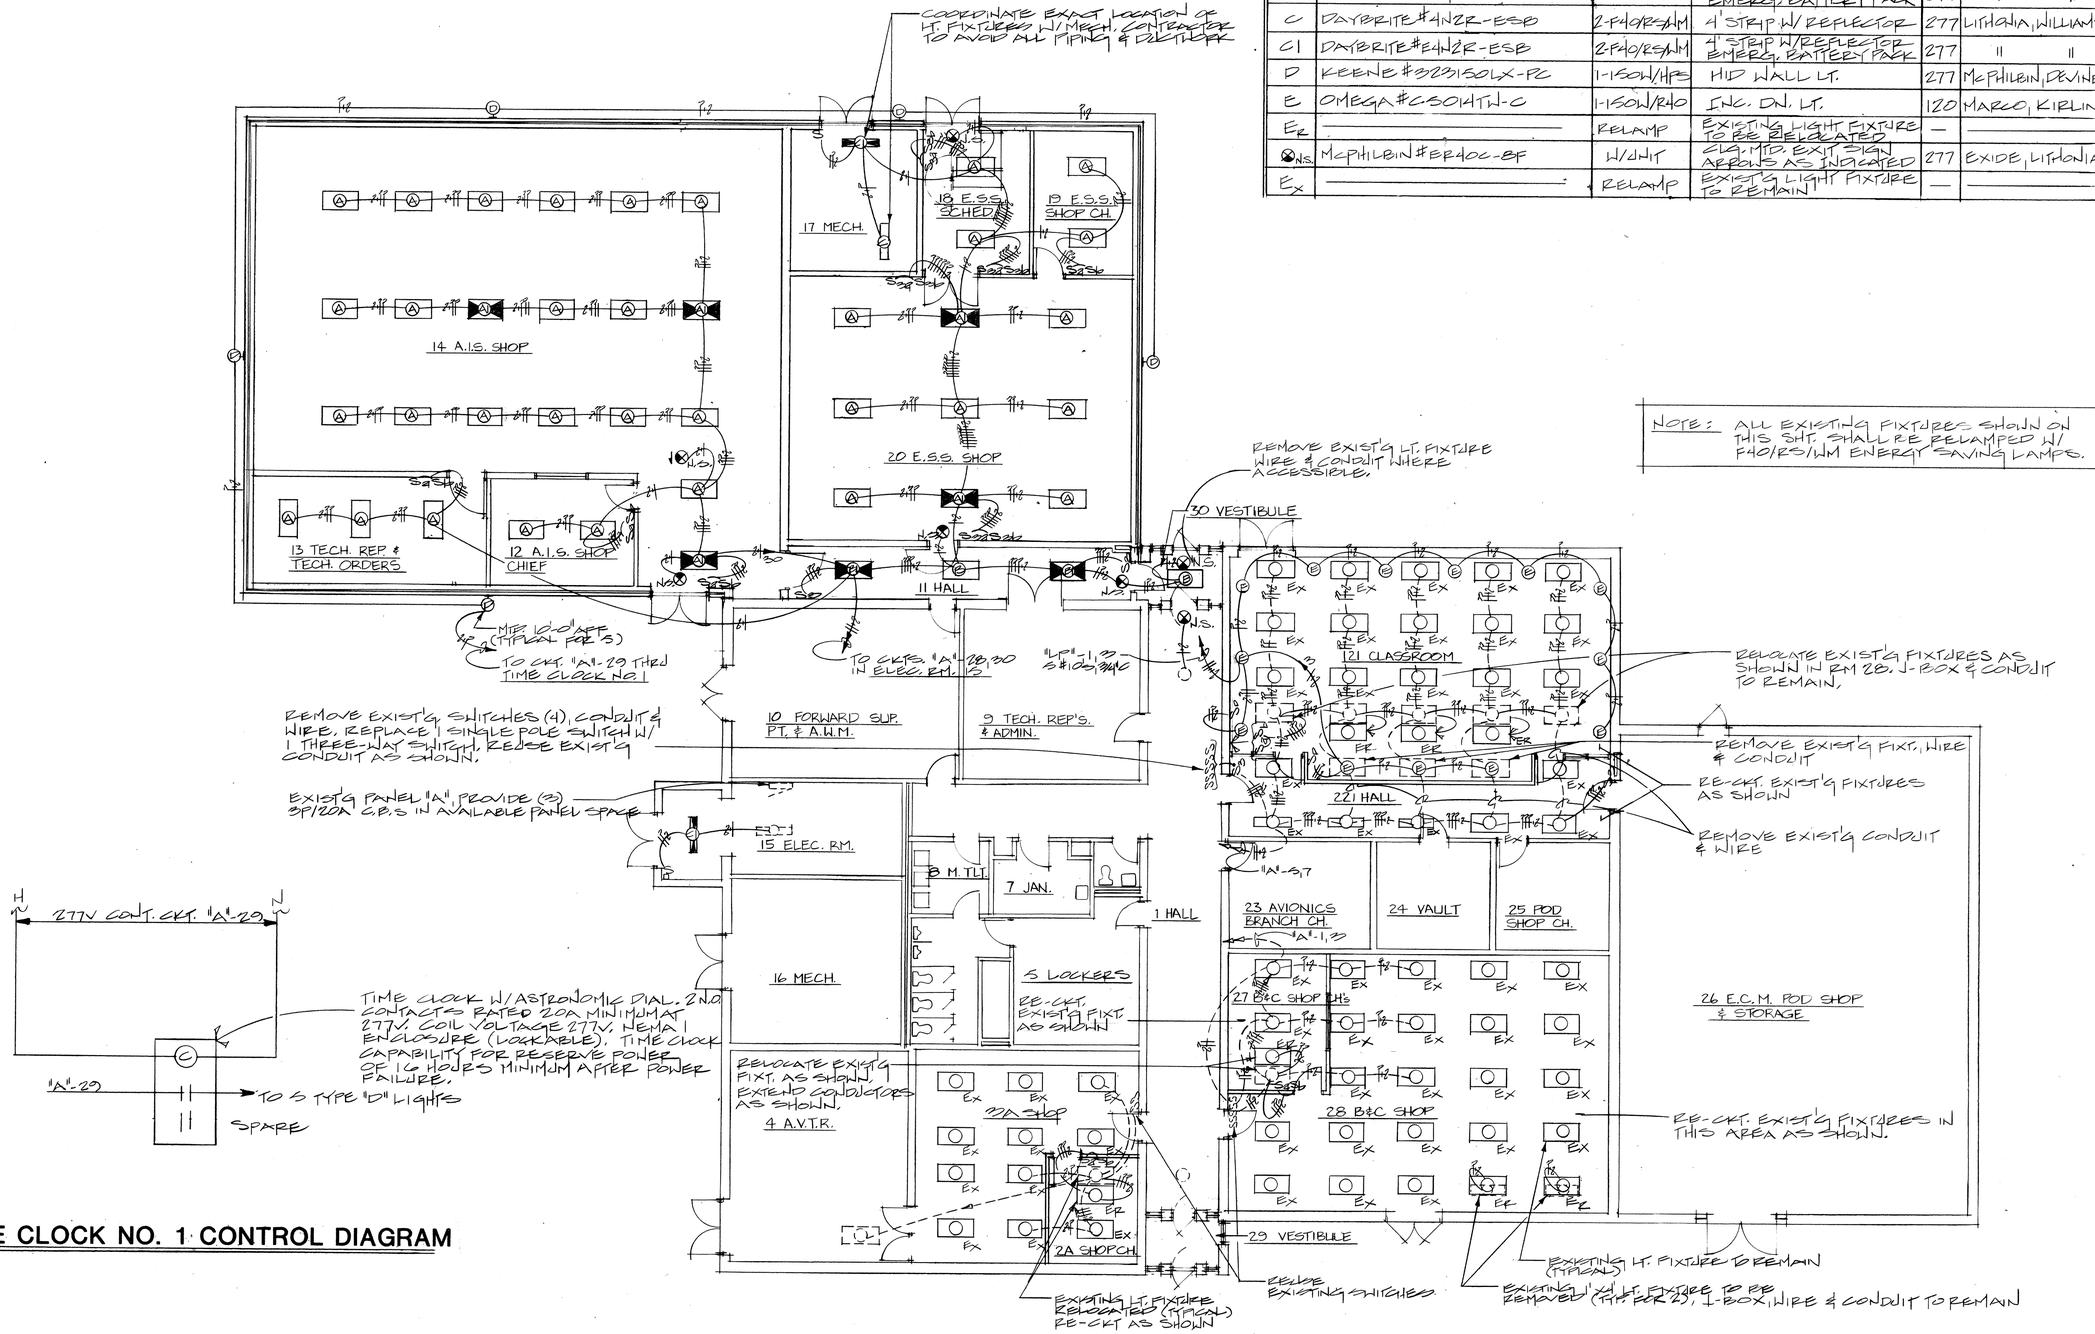

TIME CLOCK NO. 1 CONTROL DIAGRAM

NTS

FLOOR PLAN – LIGHTING

SCALE 1/8":1'-0"

MM MG
Mott Mobley McGowan & Griffin, P.A.: Architects
302 North Sixth Street Fort Smith, Arkansas 72901

STATE OF ARKANSAS REGISTERED PROFESSIONAL ENGINEER No. 4781 LONNIE L. BITH

REGISTERED ARCHITECTS MOTT MOBLEY McGOWAN & GRIFFIN, P.A. C19 ARKANSAS

CONTRACT NO. DAHA03 - 87 - C - 0007

PROJECT NO. FSM-40997

ADD./ALTER AVIONICS/ECM POD SHOP/STORAGE

AIR NATIONAL GUARD TRAINING FACILITY
MUNICIPAL AIRPORT – FT. SMITH, ARKANSAS

FLOOR PLAN – LIGHTING

Revisions

1357 Plan Number

11-16-88 Date

E1.2 Of

BRUNING 40-77 A0311