THE WILLIAM J. CLINTON PRESIDENTIAL CENTER

LITTLE ROCK, ARKANSAS

100% CONSTRUCTION DOCUMENTS

PART ONE

SEPTEMBER 27, 2002

POLSHEK PARTNERSHIP ARCHITECTS, LLP / POLK STANLEY YEARY ARCHITECTS, LTD
WITSELL EVANS & RASCO / WOODS CARADINE ARCHITECTS

WILLIAM J. CLINTON PRESIDENTIAL CENTER

LITTLE ROCK, ARKANSAS

Architect

POLSHEK PARTNERSHIP LLP
320 West 13th Street
New York, New York 10014
212.807.7171

Coordinating Architects

POLK STANLEY YEARY ARCHITECTS Ltd
700 South Schiller Street
Little Rock, Arkansas 72201
501.378.0878

WITSELL EVANS RASCO
901 West Third Street
Little Rock, Arkansas 72201
501.374.6300

WOODS CARADINE ARCHITECTS
2200 South Main Street
Little Rock, Arkansas 72206
501.374.4060

Landscape Architects

HARGREAVES ASSOCIATES
118 Magazine Street
Cambridge, Massachusettes 02139
617.661.0070

LANDSCAPE ARCHITECTURE, Inc.
2300 Cottondale Lane Suite 202
Little Rock, Arkansas 72202
501.374.5610

Structural Engineer

LESLIE E. ROBERTSON ASSOC., RLLP
30 Broad Street, 47th Floor
New York, New York 10004
212.750.9000

MEP Engineers

FLACK + KURTZ Inc.
475 Fifth Avenue
New York, New York 10017
212.532.9600


CROMWELL ARCHITECTS ENGINEERS
101 South Spring Street
Little Rock, Arkansas 72201
501.372.2900

Curtainwall Consultant

R. A. HEINTGES ARCHITECTS
126 Fifth Avenue, 9th Floor
New York, New York 10011
212.652-2966

Seal

Issue	Date
100% Construction Documents	09/27/02
90% Progress Printing	08/30/02
ASI #05	08/20/02
100% Struct./ CD Progress	07/01/02
Bridge Bldg. Substructure	06/14/02
100% Steel & Concrete CD & Architectural CD Progress	05/15/02
100% Design Development	03/01/02

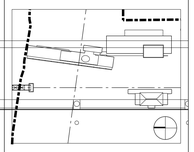

Job No.
9908

Scale

Date
September 27, 2002

Title

Sheet No.

FOR OFFICIAL USE ONLY

THE WILLIAM J. CLINTON PRESIDENTIAL CENTER

LITTLE ROCK, ARKANSAS

100% CONSTRUCTION DOCUMENTS

PART ONE

SEPTEMBER 27, 2002

POLSHEK PARTNERSHIP ARCHITECTS, LLP / POLK STANLEY YEARY ARCHITECTS, LTD
WITSELL EVANS & RASCO / WOODS CARADINE ARCHITECTS

WILLIAM J. CLINTON PRESIDENTIAL CENTER

LITTLE ROCK, ARKANSAS

Architect

POLSHEK PARTNERSHIP LLP
320 West 13th Street
New York, New York 10014
212.807.7171

Coordinating Architects

POLK STANLEY YEARY ARCHITECTS Ltd
700 South Schiller Street
Little Rock, Arkansas 72201
501.378.0878

WITSELL EVANS RASCO
901 West Third Street
Little Rock, Arkansas 72201
501.374.6300

WOODS CARADINE ARCHITECTS
2200 South Main Street
Little Rock, Arkansas 72206
501.374.4060

Landscape Architects

HARGREAVES ASSOCIATES
118 Magazine Street
Cambridge, Massachusettes 02139
617.661.0070

LANDSCAPE ARCHITECTURE, Inc.
2300 Cottondale Lane Suite 202
Little Rock, Arkansas 72202
501.374.5610

Structural Engineer

LESLIE E. ROBERTSON ASSOC., RLLP
30 Broad Street, 47th Floor
New York, New York 10004
212.750.9000

MEP Engineers

FLACK + KURTZ Inc.
475 Fifth Avenue
New York, New York 10017
212.532.9600


CROMWELL ARCHITECTS ENGINEERS
101 South Spring Street
Little Rock, Arkansas 72201
501.372.2900

Curtainwall Consultant

R. A. HEINTGES ARCHITECTS
126 Fifth Avenue, 9th Floor
New York, New York 10011
212.652-2966

Seal

Issue	Date
100% Construction Documents	09/27/02
90% Progress Printing	08/30/02
ASI #05	08/20/02
100% Struct./ CD Progress	07/01/02
Bridge Bldg. Substructure	06/14/02
100% Steel & Concrete CD & Architectural CD Progress	05/15/02
100% Design Development	03/01/02

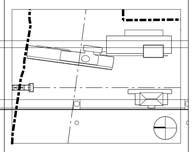

Job No.
9908

Scale

Date
September 27, 2002

Title

Sheet No.

FOR OFFICIAL USE ONLY

THE WILLIAM J. CLINTON PRESIDENTIAL CENTER

LITTLE ROCK, ARKANSAS

GT11

100% CONSTRUCTION DOCUMENTS

PART TWO

SEPTEMBER 27, 2002

POLSHEK PARTNERSHIP ARCHITECTS, LLP / POLK STANLEY YEARY ARCHITECTS, LTD
WITSELL EVANS & RASCO / WOODS CARADINE ARCHITECTS

FOR OFFICIAL USE ONLY

PART ONE

ARCHITECTURAL DRAWINGS

	Cover Sheet
A001	Drawing List• Abbreviations and Symbols
A002	Site Plan
A003	Key Plans
A100a	*Not Used.*
A100b	Basement Level Partial Plan
A100c	Basement Level Partial Plan
A100d	Basement Level Partial Plan *(formerly A100c)*
A101a	*Not Used*
A101b	Ground Level Partial Plan
A101c	Ground Level Partial Plan
A101d	Ground Level Partial Plan *(formerly A101c)*
A102a	Second Level Partial Plan
A102b	Second Level Partial Plan
A102c	*Not Used*
A102d	Second Level Partial Plan *(formerly A102c)*
A103a	Museum Lower Level Partial Plan
A103b	Museum Lower Level Partial Plan
A103c	*Not Used*
A103d	Third Level Partial Plan *(formerly A103c)*
A104a	Museum Upper Level Partial Plan
A104b	Museum Upper Level Partial Plan
A104c	*Not Used*
A104d	*Not Used*
A105a	Executive Level Partial Plan *(formerly A106a)*
A105b	Executive Level Partial Plan
A105c	*Not Used*
A105d	*Not Used*
A106a	*Deleted • Renamed A105a*
A106b	Roof Partial Plan
A106c	Roof Partial Plan
A106d	Roof Partial Plan
A300	*Deleted*
A301	*Not Used*
A302	Museum Building Sections
A303	Museum Building Sections
A304	Museum Building Sections
A305	Museum Building Sections
A306	Museum Building Section
A307	Museum Building Section
A308	Museum Building Section
A309	Museum Building Section
A310	Archive Building Sections
A311	Archive Building Partial Sections
A320	Wall System A1: Plans, Elevation and Section
A321	Wall System A1: Plans and Sections
A322	Wall System A1: Plans, Elevation and Sections
A323	Wall Systems A2: Sections
A324	Wall System A2 and A3: Plans
A325	Wall System A3: Plan, Elevation and Sections
A325a	Wall System A3: Elevation and Sections
A326	Wall System C: Elevation, Plan and Section
A327	Wall System C: Plans and Sections
A328	Wall System C: Plan and Sections *(Includes Details from Former A331)*
A329	*Deleted (Renamed to A330)*
A330	Wall System C: Section and Developed RCP *(New sheet • old A330 renamed A331)*
A331	Wall System C: Section and Developed RCP *(Sheet A330 renamed A331. Details from former A331 moved to A328)*
A332	*Not Used*
A333	Wall System D: Elevation and Section
A334	Wall Systems D • E: Elevation and Section
A335	Wall Systems D • E: Plans and Section
A336	Wall System F: Plan, Elevation and Section•
A337	Wall System F: Elevation and Detail•
A338	Wall System F: Plans, Elevation and Sections• *•A336, A337, A338, A371 Reorranged• See A336, A337, A338, and A371*
A339	Archive Building Stair 11 Wall Sections
A339a	Wall System G: Plan, Elevation and Sections
A340	Wall System G: Plan, Elevation and Sections
A341	Wall System G: Plans
A342	Wall System H: Plans/ Sections at Neck Connector
A343	Wall Systems H: Plan, Elevation and Sections
A344	Wall System H: Plan and Sections
A345	Wall System J: Plan and Sections
A346	Wall System K • E: Elevation and Sections
A347	Wall System K: Plan and Sections
A348	Entrance Canopy: Plan and Elevation
A349	Entrance Canopy: Section
A355	Wall System A1: Section Details
A356	Wall System A1 • A2: Plan Details
A357:	Wall System A2: Section Details
A358:	Wall System A3: Section and Plan Details
A359	*Deleted (some details moved to A358)*
A360	Wall System C: Plaza and Base Detail Sections
A361	Wall System C: Detail Sections *(Some details rearranged onto sheets A362, A363, A364)*
A362	Wall System C: Detail Sections & Plans
A363	Wall System C: Glazing Details
A364	Wall System C: Glazing Details *(New sheet. Details on former A364 now on A362, A363)*
A365	Wall System D • E: Detail Sections
A366	Wall System D: Section Details
A367	Wall System D: Section Details
A368	Wall System D: Plan Details
A368a	Wall System D: Miscellaneous Details
A369	Wall System E: Plan and Section Details
A370	Wall System E: Plan and Section Details
A371	Wall System F: Sections•
A372	Archive Building Roof Details
A373	*Deleted•*
A374	*Not Used*
A375	Wall System G: Detail Plans & Sections
A376	*Not Used*
A377	Wall System H Glass: Plans and Sections
A378	Wall System H Glass: Plan and Section Details
A379	Wall System F &H: Plan and Sections
A380	Wall System J: Details
A381	*Not Used*
A382	Wall System K: Detail Sections
A383	Wall System K: Plan & Section Details
A384	*Not Used*
A385	*Deleted (Consolidated into A360)*
A386	Museum Building: Roof Details
A387	*Not Used*
A388	Museum Building: Roof Details - Exec. Lvl. Roof & Skylight
A389	Museum Building: Sunscreen Executive Level
A390	Expansion Joint Details
A391	Museum Building: Exterior Railing Details
A392	Museum Building: Exterior Railing Details
A397	Archive Building: Miscellaneous Details
A400	Partition Types
A401	Door Types *(Sheet used to be named A402)*
A402	Door Details *(New sheet. Former A402 renamed to A401)*
A403	Door Details
A404	Door Details
A405	Door Details
A406	Door/Window Details
A407	Sill Details *(New sheet. Former A407 renamed to A409)*
A408	*Not Issued*
A409	*Not Issued*
A410	Interior Materials, Finish Abbreviations, and Device Mounting Heights
A411	Museum Building Interior Elevations: Basement ••
A412	Museum Building Interior Elevations: Ground Floor••
A413	Museum Building Interior Elevations••
A414	Museum Building Interior Elevations••
A415	Museum Building Interior Elevations••
A416	*Deleted (Details moved to A412 and A551)*
A417	*Deleted (Details moved to A412, A551, A521.1)*
A418	*Deleted (Details moved to A551)*
A419	*Deleted (Details moved to A412, A413)*
A420	Museum Building Interior Elevations: Glass Railings•• *(Dlls moved to A414, A411)*
A421	*Deleted (Sheet renamed A432)*
A422	*Deleted (Sheet renamed A433)* *••A400 sheets rearranged as interior details were developed*
A430	Interior Elevations: Archive
A431	Interior Elevations: Archive
A432	Interior Elevations: Archive *(Formerly Sheet A421)*
A433	Interior Elevations: Archive *(Formerly Sheet A422)*
A434	Interior Elevations: Archive
A435	Gold Storage: Plans, Sections, Details
A436	NARA Holding: Plans, Sections, Details
A440	*Deleted (Details moved to A522.1 and A524.1)*
A441	*Deleted (Details moved to A523.1)*
A442	*Deleted (Details moved to A525.1 and A526.1)*
A450	Museum Interior Details: Interior Storefront Systems *(Former A450 details moved to A522.1, 524.1 and A526.1)*
A451	Museum Building Interior Details: Interior Storefront Systems *(Former A451 details moved to A523.1)*
A452	Museum Building Interior Details: Interior Storefront Systems *(Former A452 details moved to A525.1)*
A453	Museum Building Interior Details: Interior Storefront Systems
A454	Museum Building Interior Details: Metal Panel Systems
A455	Museum Building Interior Details: Stone
A456	*Not Used*
A457	Museum Building Interior Details: Metal Panel Systems••
A458	Museum Building Wood Panel System: Details ••
A459	Museum Building Wood Panel System: Details ••
A460	Museum Building Wood Panel System: Details ••
A461	Museum Building Ceiling Details• *••A400 sheets rearranged as interior details were developed*
A470	Archive Building Interior Details
A471	Archive Building Interior Details *(Former A471 details moved to Door Detail Sheets)*
A472	Archive Building Interior Details *(Former A472 details moved to A471, A473, A474)*
A473	Archive Building Interior Details
A474	Archive Building Interior Details
A475	Archive Building Interior Details
A476	Archive Building Interior Details
A477	Archive Building Interior Details
A478	Archive Building Interior Details: Ceiling Details
A479	Archive Building Interior Details: Floor and Base Details
A490	Archive Building: Millwork (Lobby/Reception)
A491	Millwork Sections: Archive Ground Level
A492	Millwork Sections: Archive Upper Levels
A493	Millwork Sections: Archive Upper Levels
A500	Museum Building Ornamental Stair: Plans and Sections (1/3/7)•••
A501	Museum Building Ornamental Stair: Details••• *(New Sheet. Former A501 details on A502)*
A501a	Museum Building Ornamental Stair: Details•••
A502	Museum Building Stair 2: Plans and Sections••• *(Issued originally as A501. Former A502 details moved to A505)*
A503	Museum Building Stair 2: Details••• *(New Sheet. Former A503 details on A506)*
A504	*Not Used*
A505	Museum Building Stair 4: Plans and Sections••• *(Issued originally as A502. Former A505 details on A510)*
A506	Museum Building Stair 5: Plans and Sections••• *(Issued originally as A503. Former A506 details on A511)*
A507	Museum Building Stair 6: Plans and Sections••• *(New sheet. Issued originally as A504.)*
A508	*Not Used*
A509	*Not Used*
A510	Stairs 8/9/12••• *(New sheet. Issued originally as A505)*
A511	Stairs 10/11••• *(New sheet. Issued originally as A506)* *•••A500 sheets rearranged as stair details were developed*
A512	Stair Details
A513	Stair Details
A514	Stair Details
A515	Fire Stair - Typical Details
A521	Escalator Plans
A521.1	Escalator Plans and Details
A522	Elevator Layout
A522.1	Elevator P1/P2: Plans, Sections, Interior Elevations *(New sheet: details moved from former sheet A440)*
A523	Elevator Layout
A523.1	Elevator F3: Plans, Sections, Interior Elevations *(New sheet: details moved from former sheet A441)*
A524	Elevator Layout
A524.1	Elevator P7: Plans, Section, Interior Elevations *(New sheet: details moved from former sheet A440)*
A525	*Not Used*
A525.1	Elevator S4 Plans, Sections, Elevations
A526	*Deleted (Former A526 details moved to A530)*
A526.1	Elevator P6 Plans, Sections, Elevations
A527	*Deleted (Former A527 details moved to A530)*
A527.1	Elevator F5 Plans, Sections, Elevations
A528	*Deleted (Former A528 details moved to A531)*
A530	Museum Building Restrooms: Plans and Elevations *(Details formerly issued on sheets A526 and A527)*
A531	Museum Building Restrooms: Plans, Elevations, & Schedule *(Details formerly issued on sheet A528)*
A532	Museum Building Restrooms: Plans and Elevations
A533	Restrooms - Plans, Elevations & Schedules
A534	Core • Plans Elevations & Schedules
A535	Core • Plans Elevations & Schedules
A540	*Deleted*
A541	*Deleted*
A550	Geometry Drawing of Oval Office Structural Dome
A551	Orientation Theater: Enlarged Plans and Elevations
A600a	*Not Issued*
A600b	Basement Level Partial Reflected Ceiling Plan
A600c	Basement Level Partial Reflected Ceiling Plan
A600d	Basement Level Partial Reflected Ceiling Plan *(Formerly A600c)*
A601a	Ground Level Partial Reflected Ceiling Plan
A601b	Ground Level Partial Reflected Ceiling Plan
A601c	Ground Level Partial Reflected Ceiling Plan
A601d	Ground Level Partial Reflected Ceiling Plan *(Formerly A601c)*
A602a	Second Level Partial Reflected Ceiling Plan
A602b	Second Level Partial Reflected Ceiling Plan
A602c	*Not Used*
A602d	Second Level Reflected Ceiling Plan *(Formerly A602c)*
A603a	Museum Lower Level Partial Reflected Ceiling Plan
A603b	Museum Lower Level Partial Reflected Ceiling Plan
A603c	*Not Used*
A603d	Third Level Reflected Ceiling Plan *(Formerly A603c)*
A604a	Museum Upper Level Partial Reflected Ceiling Plan
A604b	Museum Upper Level Partial Reflected Ceiling Plan
A604c	*Not Used*
A604d	*Not Used*
A605a	*Not Used*
A605b	Executive Level Reflected Ceiling Plan
A605c	*Not Used*
A606d	*Not Used*
A710	*Renamed S220.1*
A711	*Renamed S220.2*
A720	*Deleted*
A721	*Deleted*
FM-1	*Deleted*
FM-2	Façade Maintenance System: Sections and Details
FM-3	Façade Maintenance System: Sections and Details

STRUCTURAL DRAWINGS

S100b	Foundation and Basement Level Plan
S100c	Foundation and Basement Level Plan
S100d	Foundation and Basement Level Plan
S101b	Ground Level Plan
S101c	Ground Level Plan
S101d	Ground Level Plan
S102a	Second Level Plan
S102b	Second Level Plan
S102c	Second Level Plan
S102d	Second Level Plan
S102e	Second Level Plan
S103a	Museum Lower Level Plan
S103b	Museum Lower Level Plan
S103c	Third Level Plan
S104a	Museum Upper Level Plan
S104b	Museum Upper Level Plan
S105a	Executive Level Plan
S105b	Executive Level Plan
S106b	Executive Roof Plan
S106c	Roof Level Plan
S106d	Executive Roof Canopy Plan
S100a.1	Basement Level Partial Slab Plan•••••
S100b.1	Basement Level Partial Slab Plan•••••
S100c.1	Basement Level Partial Slab Plan•••••
S100d.1	Basement Level Partial Slab Plan•••••
S101b.1	Ground Level Partial Slab Plan•••••
S101c.1	Ground Level Partial Slab Plan•••••
S101d.1	Ground Level Partial Slab Plan•••••
S102a.1	Second Level Partial Slab Plan•••••
S102b.1	Second Level Partial Slab Plan•••••
S102c.1	Second Level Partial Slab Plan•••••
S102d.1	Second Level Partial Slab Plan•••••
S103a.1	Museum Lower Level Partial Slab Plan•••••
S103b.1	Museum Lower Level Partial Slab Plan•••••
S103d.1	Third Level Partial Slab Plan•••••
S104a.1	Museum Upper Level Partial Slab Plan•••••
S104b.1	Museum Upper Level Partial Slab Plan•••••
S104d.1	Fourth Level Partial Slab Plan•••••
S105a.1	Executive Level Partial Slab Plan•••••
S105b.1	Executive Level Partial Slab Plan•••••
S106b.1	Roof Partial Slab Plan••••• *•••••Issued originally as A700 drawings*
S110	Slab Reinforcement Ground and Second Level Plan
S111	Slab Reinforcement Museum Lower and Upper Level Plan
S112	Slab Reinforcement Executive Level and Executive Roof Roof
S200	Museum Building Truss Elevations
S201	Museum Building Truss Elevations
S205	East Wall Elevation
S210	Pier 4 Elevation
S215	Stair •2
S220	Wall Elevations Museum Building
S221	Wall Elevations Museum Building
S222	Wall Elevations Archive Building
S223	Wall Elevations Archive Building
S220.1	Stair 4 Shear Wall Elevations *(Issued originally as A710)*
S220.2	Stair 5 Shear Wall Elevations *(Issued originally as a711)*

PART TWO

MECHANICAL DRAWINGS:

M000	HVAC Symbols & Abbreviations
M300b	Museum Basement Level Mechanical Partial Plan
M300c	Archives Basement Level Mechanical Partial Plan
M300d	Archive Basement Level Mechanical Partial Plan
M301b	Museum Ground Level Mechanical Partial Plan
M301c	Archives Ground Level Mechanical Partial Plan
M301d	Archives Ground Level Mechanical Partial Plan
M302a	Museum Second Level Mechanical Partial Plan
M302b	Museum Second Level Mechanical Partial Plan
M302c	Archives Roof/ Second Level Mechanical Partial Plan
M302d	Archives Roof/ Second Level Mechanical Partial Plan
M303a	Museum Lower Level Mechanical Partial Plan
M303b	Museum Lower Level Mechanical Partial Plan
M303d	Archives Third Level Mechanical Partial Plan
M304a	Museum Upper Level Mechanical Partial Plan
M304b	Museum Upper Level Mechanical Partial Plan
M304d	Archives Third Level Roof Mechanical Partial Plan
M305a	Museum Roof/Executive Level Mechanical Partial Plan
M305b	Museum Roof/Executive Level Mechanical Partial Plan
M400b	Museum Basement Level Mechanical Piping Partial Plan
M400c	Archives Basement Level Mechanical Piping Partial Plan
M400d	Archives Basement Level Mechanical Piping Partial Plan
M401b	Museum Ground Level Mechanical Piping Partial Plan
M401c	Archives Ground Level Mechanical Piping Partial Plan
M401d	Archives Ground Level Mechanical Piping Partial Plan
M402a	Museum Second Level Mechanical Piping Partial Plan
M402b	Museum Second Level Mechanical Piping Partial Plan
M402d	Archives Roof/Second Level Mechanical Piping Partial Plan
M403a	Museum Lower Level Mechanical Piping Partial Plan
M403b	Museum Lower Level Mechanical Piping Partial Plan
M403d	Archives Third Level Mechanical Piping Partial Plan
M404a	Museum Upper Level Mechanical Piping Partial Plan
M404b	Museum Upper Level Mechanical Piping Partial Plan
M405b	Museum Roof/Executive Level Mechanical Piping Partial Plan
M406a	Museum Lower Level Radiant Piping Partial Plan
M406b	Museum Lower Level Radiant Piping Partial Plan
M407a	Museum Upper Level Radiant Piping Partial Plan
M407b	Museum Upper Level Radiant Piping Partial Plan
M500	HVAC Air Riser Diagram No. 1
M501	HVAC Air Riser Diagram No. 2
M502	HVAC Water Riser Diagram No. 1
M503	HVAC Water Riser Diagram
M504	HVAC Enlarged Plans and Sections
M505	HVAC Sections
M506	HVAC Sections
M507	Air Handling Unit-Plans and Elevations
M600	HVAC Details Sheet One
M601	HVAC Details Sheet Two
M602	HVAC Details Sheet Three
M603	HVAC Details Sheet Four
M604	HVAC Details Sheet Five
M605	HVAC Details Sheet Six
M700	HVAC Schedules Sheet One
M701	HVAC Schedules Sheet Two
M702	HVAC Schedules Sheet Three
M703	HVAC Schedules Sheet Four

ELECTRICAL DRAWINGS:

E001	Electrical Symbol List & Abbreviations
E100b	Basement Level Area B Power Plan
E100c	Basement Level Area C Power Plan
E100d	Basement Level Area D Power Plan
E101a	Ground Level Area A Power Plan
E101b	Ground Level Area B Power Plan
E101c	Ground Level Area C Power Plan
E101d	Ground Level Area D Power Plan
E102a	Second Level Area A Power Plan
E102b	Second Level Area B Power Plan
E102d	Second Level& Archive Road Area D Power Plan
E103a	Museum Lower Level Area A Power Plan
E103b	Museum Lower Level Area B Power Plan
E103d	Museum Lower Level Area D Power Plan
E104a	Museum Upper Level Area A Power Plan
E104b	Museum Upper Level Area B Power Plan
E105b	Executive Level& Roof Area B Power Plan
E106a	Executive Level Roof Area A Power Plan
E106b	Roof Area B Power Plan
E106c	Roof Area C Power Plan
E106d	Roof Area D Power Plan
E200a	Basement Level Area A Lighting Plan
E200b	Basement Level Area B Lighting Plan
E200c	Basement Level Area C Lighting Plan
E200d	Basement Level Area D Lighting Plan
E201a	Ground Level Area A Lighting Plan
E201b	Ground Level Area B Lighting Plan
E201c	Ground Level Area C Lighting Plan
E201d	Ground Level Area D Lighting Plan
E202a	Second Level Area A Lighting Plan
E202b	Second Level Area B Lighting Plan
E202d	Second Level& Archive Roof Area D Lighting Plan
E203a	Museum Lower Level Area A Lighting Plan
E203b	Museum Lower Level Area B Lighting Plan
E203d	Third Level Area D Lighting Plan
E204a	Museum Upper Level Area A Lighting Plan
E204b	Museum Upper Level Area B Lighting Plan
E205b	Executive Level& Roof Area B Lighting Plan
E206a	Roof Area A Lighting Plan
E206b	Roof Area B Lighting Plan
E206c	Roof Area C Lighting Plan
E206d	Roof Area D Lighting Plan
E401	Kitchen Part Plans
E501	Electrical Panelboard Schedules
E502	Electrical Panelboard Schedules
E503	Electrical Panelboard Schedules
E504	Electrical Panelboard Schedules
E505	Electrical Panelboard Schedules
E506	Electrical Panelboard Schedules
E507	Electrical Panelboard Schedules
E508	Electrical Panelboard Schedules
E509	Electrical Panelboard Schedules
E510	Electrical Panelboard Schedules
E511	Electrical Panelboard Schedules
E512	Electrical Panelboard Schedules
E513	Electrical Panelboard Schedules
E514	Electrical Panelboard Schedules
FA001	Fire Alarm Project Notes
FA100b	Basement Level Area B Fire Alarm Plan
FA100c	Basement Level Area C Fire Alarm Plan
FA100d	Basement Level Area D Fire Alarm Plan
FA101b	Ground Level Area B Fire Alarm Plan
FA101c	Ground Level Area C Fire Alarm Plan
FA101d	Ground Level Area D Fire Alarm Plan
FA102a	Second Level Area A Fire Alarm Plan
FA102b	Second Level Area B Fire Alarm Plan
FA102d	Second Level& Archive Roof Area D Fire Alarm Plan
FA103a	Museum Lower Level Area A Fire Alarm Plan
FA103b	Museum Lower Level Area B Fire Alarm Plan
FA103d	Museum Lower Level Area D Fire Alarm Plan
FA104a	Museum Upper Level Area A Fire Alarm Plan
FA104b	Museum Upper Level Area B Fire Alarm Plan
FA105b	Executive Level& Roof Area B Fire Alarm Plan
FA500	Ground Level Document Storage Fire Alarm Plan
FA501	Ground Level Document Storage Fire Alarm Plan

PLUMBING DRAWINGS:

P0001	Plumbing Notes
PF100b	Museum Basement Level Foundation Drain Partial Plan
PF100c	Archives Basement Level Foundation Drain Partial Plan
PF100d	Archives Basement Level Foundation Drain Partial Plan
P100b	Museum Basement Level Plumbing Partial Plan
P100c	Archives Basement Level Plumbing Partial Plan
P100d	Archives Basement Level Plumbing Partial Plan
P101b	Museum Ground Level Plumbing Partial Plan
P101c	Archives Ground Level Plumbing Partial Plan
P101d	Archives Ground Level Plumbing Partial Plan
P102a	Museum Second Level Plumbing Partial Plan
P102b	Museum Second Level Plumbing Partial Plan
P102c	Archives Roof/ Second Level Plumbing Partial Plan
P102d	Archives Roof/Second Level Plumbing Partial Plan
P103a	Museum Lower Level Plumbing Partial Plan
P103b	Museum Lower Level Plumbing Partial Plan
P103d	Archives Third Level Plumbing Partial Plan
P104a	Museum Upper Level Plumbing Partial Plan
P104b	Museum Upper Level Plumbing Partial Plan
P104d	Archives Third Level Roof Plumbing Partial Plan
P105a	Executive Level Plumbing Partial Plan
P105b	Executive Level Plumbing Partial Plan
P106b	Executive Level Plumbing Roof Plan
P201	Enlarged Basement Kitchen Plan
P202	Enlarged Museum Lower Level Kitchen Plan and Rough-In Notes
P301	Plumbing Domestic Water & Gas Riser Diagrams
P302	Plumbing Sanitary Riser Diagram
P303	Archives Waste and Vent Riser Diagram
P401	Plumbing Details
P402	Plumbing Schedules

FIRE PROTECTION DRAWINGS:

F001	Fire Protection Notes, Details & Schedules
F100b	Museum Basement Level Fire Protection Partial Plan
F100c	Archives Basement Level Fire Protection Partial Plan
F100d	Archives Basement Level Fire Protection Partial Plan
F101b	Museum Ground Level Fire Protection Partial Plan
F101c	Archives Ground Level Fire Protection Partial Plan
F101d	Archives Ground Level Fire Protection Partial Plan
F102a	Museum Second Level Fire Protection Partial Plan
F102b	Museum Second Level Fire Protection Partial Plan
F102c	Archives Roof/Second Level Fire Protection Partial Plan
F102d	Archives Roof/Second Level Fire Protection Partial Plan
F103a	Museum Lower Level Fire Protection Partial Plan
F103b	Museum Lower Level Fire Protection Partial Plan
F103d	Archives Third Level Fire Protection Partial Plan
F104a	Museum Upper Level Fire Protection Partial Plan
F104b	Museum Upper Level Fire Protection Partial Plan
F105a	Museum Roof/Executive Level Fire Protection Partial Plan
F105b	Museum Roof/Executive Level Fire Protection Partial Plan

TELECOM DRAWINGS:

T001	Telecom Legend & Symbols List
T300b	Basement Level Telecom Plan
T300c	Basement Level Tele Plan
T300d	Basement Level Tele Plan
T301b	Ground Level Telecom Plan
T301c	Ground Level Telecom Plan
T301d	Ground Level Telecom Plan
T302a	Second Level Telecom Plan
T302b	Second Level Telecom Plan
T302d	Second Level Telecom Plan
T303a	Museum Lower Level Telecom Plan
T303b	Museum Lower Level Telecom Plan
T303c	Museum Lower Level Telecom Plan
T304a	Museum Upper Level Telecom Plan
T304b	Museum Upper Level Telecom Plan
T305a	Executive Level Telecom Plan
T305b	Executive Level Telecom Plan
T400	Basement Closet Telecom Details
T401	Second & Executive Level Closets Telecom Details
T500	Telecom Backbone Pathways Riser Diagram
T501	Telecom Backbone Copper/Fiber Riser Diagram
T502	Telecom Grounding Riser Diagram
T600	Telecom Details Sheet 1 of 2
T600	Telecom Details Sheet 2 of 2

ACOUSTIC & AUDIOVISUAL DRAWINGS:

AV-101	Great Hall Facility Plan
AV-101a	Great Hall Elevations and Sections
AV-102	Conference Room 2nd Level
AV-103	Overflow Connections at Orientation Theater Facility Plan
AV-104	Ground Level Divisible Classrooms
AV-200	Audiovisual Electrical Symbols & Notes
AV-201	Great Hall Audiovisual Electrical Plan
AV-201a	Cable/Conduit Riser Diagrams
AV-202	Conference Room 2nd Level Audiovisual Electrical Plan
AV-203	Overflow AV Connections at Orientation Theater Electrical Plan
AV-204	Ground Level Divisible Classrooms Audiovisual Electrical Plans

FOOD SERVICE DRAWINGS:

FS-1	Food Service Lower Level Equipment Plan
FS-2	Food Service Ground Level Equipment Plan
FS-2.1	Food Service Equipment Schedule
FS-SC1	Food Service Lower Level Special Conditions Plan
FS-SC2	Food Service Ground Level Special Conditions Plan
FS-M1	Food Service Mechanical Hood Plan
FS-M2	Food Service Mechanical Hood Plan
FS-P1	Food Service Lower Level Plumbing Rough In Plan
FS-P2	Food Service Ground Level Plumbing Rough In Plan
FS-P2.1	Food Service Plumbing Schedule
FS-E1	Food Service Lower Level Electrical Rough In Plan
FS-E2	Food Service Ground Level Electrical Rough In Plan
FS-E2.1	Food Service Electrical Schedule
FS-FAB1	Food Service Custom Elevations and Details
FS-FAB2	Food Service Custom Elevations and Details
FS-FAB3	Food Service Custom Elevations and Details

SECURITY DRAWINGS:

SE-000	Security Legend
SE-001	Security Site Plan
SE-100b	Security Basement Level Partial Plan
SE-100c	Security Basement Level Partial Plan
SE-100d	Security Basement Level Partial Plan
SE-101b	Security Ground Level Partial Plan
SE-101c	Security Ground Level Partial Plan
SE-101d	Security Ground Level Partial Plan
SE-102a	Security Second Level Partial Plan
SE-102b	Security Second Level Partial Plan
SE-102d	Security Second Level Partial Plan
SE-103a	Security Museum Lower Level Partial Plan
SE-103b	Security Museum Lower Level Partial Plan
SE-103d	Security Third Level Plan
SE-104a	Security Museum Upper Level Partial Plan
SE-104b	Security Museum Upper Level Partial Plan
SE-105b	Security Executive Level Partial Plan
SE-106a	Security Roof Partial Plan
SE-106b	Security Roof Partial Plan
SE-106c	Security Roof Partial Plan
SE-106d	Security Roof Partial Plan
SE-200	Security ACS/IDS Riser
SE-201	Security ACS/IDS Riser
SE-202	ACS/IDS Riser
SE-203	Security CCTV Riser
SE-300	Security Details
SE-301	Security Details
SE-302	Security Details
SE-303	Security Details
SE-304	Security Details

WILLIAM J. CLINTON PRESIDENTIAL CENTER

LITTLE ROCK, ARKANSAS

Architect

POLSHEK PARTNERSHIP LLP
320 West 13th Street
New York, New York 10014
212.807.7171

Coordinating Architects

POLK STANLEY YEARY ARCHITECTS Ltd
700 South Schiller Street
Little Rock, Arkansas 72201
501.378.0878

WITSELL EVANS RASCO
901 West Third Street
Little Rock, Arkansas 72201
501.374.5300

WOODS CARADINE ARCHITECTS
2200 South Main Street
Little Rock, Arkansas 72206
501.374.4060

Landscape Architects

HARGREAVES ASSOCIATES
118 Magazine Street
Cambridge, Massachusettes 02139
617.661.0070

LANDSCAPE ARCHITECTURE, Inc.
2300 Cottondale Lane Suite 202
Little Rock, Arkansas 72202
501.374.5610

Structural Engineer

LESLIE E. ROBERTSON ASSOC., RLLP
30 Broad Street, 47th Floor
New York, New York 10004
212.750.9000

MEP Engineers

FLACK + KURTZ Inc.
475 Fifth Avenue
New York, New York 10017
212.532.9600


CROMWELL ARCHITECTS ENGINEERS
101 South Spring Street
Little Rock, Arkansas 72201
501.372.2900

Curtainwall Consultant

R. A. HEINTGES ARCHITECTS
126 Fifth Avenue, 9th Floor
New York, New York 10011
212.652-2966

Seal

Issue	Date
100% Construction Documents	09/27/02
90% Progress Printing	08/30/02
100% Struct./ CD Progress	07/01/02
Bridge Bldg. Substructure	06/14/02
100% Steel & Concrete CD & Architectural CD Progress	05/15/02
100% Design Development	03/01/02

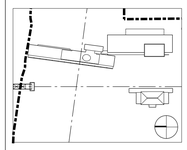

Job No. 9908

Scale

Date September 27, 2002

Title

DRAWING LIST

Sheet No.

A000

FOR OFFICIAL USE ONLY

ABBREVIATIONS

A/C	AIR CONDITIONING
ACOUST	ACOUSTICAL
ACT	ACOUSTICAL CEILING TILE
AD	AREA DRAIN
ADA	AMERICANS WITH DISABILITIES ACT
ADDL	ADDITIONAL
ADJ	ADJACENT
AESS	ARCHITECTURALLY EXPOSED STRUCTURAL STEEL
AFF	ABOVE FINISH FLOOR
AIA	AMERICAN INSTITUTE OF ARCHITECTS
ALT	ALTERNATE
ALUM	ALUMINUM
ANSI	AMERICAN NATIONAL STANDARDS INSTITUTE
APPROX	APPROXIMATE
ARCH	ARCHITECT
ASHRAE	THE AMERICAN SOCIETY OF HEATING REFRIGERATING AND AIR-CONDITIONING ENGINEERS
ASTM	AMERICAN SOCIETY FOR TESTING AND MATERIALS
BD	BOARD
BLDG	BUILDING
BLK	BLOCK
BLKG	BLOCKING
BM	BEAM
BO	BY OTHERS
BOC	BOTTOM OF CURB
BOF	BOTTOM OF FOOTING
BOCA	BUILDING OFFICIALS AND CODE ADMINISTRATORS INTERNATIONAL INC.
BOS	BOTTOM OF SLAB
BOW	BOTTOM OF WALL
BOT	BOTTOM
BSMT	BASEMENT
BTWN	BETWEEN
CAB	CABINET
CADD	COMPUTER-AIDED DESIGN DRAFTING
CB	CATCH BASIN
CCTV	CLOSED-CIRCUIT TELEVISION
CLG	CEILING
CH	CEILING HEIGHT
CLOS	CLOSET
CLR	CLEAR(ANCE)
CLS	CLOSURE
COMP	COMPRESSIVE
CMU	CONCRETE MASONRY UNIT
COL	COLUMN
CONF	CONFERENCE ROOM
CONC	CONCRETE (CAST IN PLACE)
CONST JT	CONSTRUCTION JOINT
CONT	CONTINUOUS OR CONTINUE
CONTR	CONTRACTOR
COORD	COORDINATE
CORR	CORRIDOR
COV	CARPET
CPT	COVER
CT	CERAMIC TILE
CTR	CENTER
D	DEEP/DEPTH
DB	DECIBEL(S)
DBL	DOUBLE
DDC	DIRECT DIGITAL CONTROL
DEG (o)	DEGREE
DEMO	DEMOLITION
DET	DETAIL
DIA (DIAM.)	DIAMETER
DIF	DIFFUSER
DIM	DIMENSION
DN	DOWN
DR	DOOR
DV	DIVISION
DWG	DRAWING
DWR	DRAWER
EA	EACH
EL	ELEVATION
ELEC	ELECTRIC(AL)
ELEV	ELEVATOR

ABBREVIATIONS

EMER	EMERGENCY
EMR	EDIT MACHINE ROOM
EPA	ENVIRONMENTAL PROTECTION AGENCY
EQ	EQUAL
EQUP	EQUIPMENT
EXP	EXPOSED
EXP JT	EXPANSION JOINT
EXG	EXISTING
EXT	EXTERIOR
FAI	FRESH AIR INTAKE
FCVA	FIRE CONTROL VALVE ASSEMBLY
FD	FLOOR DRAINS
FDN	FOUNDATION
FDV	FIRE DEPARTMENT VALVE
FIN	FINISHED)
FLR	FLOOR(ING)
FLUOR	FLUORESCENT
FO	FACE OF
FPSC	FIRE-PROOF SELF-CLOSING
FT (')	FOOT
FTG	FOOTING
FURN	FURNITURE
GA.	GAUGE
GALV	GALVANIZED
GFRG	GLASS FIBER REINFORCED GYPSUM
GL	GLASS GLAZING
GL BLK	GLASS BLOCK
GSF	GROSS SQUARE FEET
GWB	GYPSUM WALL BOARD
GYP	GYPSUM
H	HEIGHT
HC	HANDICAPPED
HDWR	HARDWARE
HM	HOLLOW METAL
HORIZ	HORIZONTAL
HP	HIGH POINT
HR	HOUR
HVAC	HEATING/VENTILATING/ AIR CONDITIONING
IN. (")	INCH
INCL	INCLUDE (D) (ING)
INSUL	INSULATE (D) (TION)
INT	INTERIOR
INV	INVERT
JAN	JANITOR
JT	JOINT(D)
LAM	LAMINATE
LEED	LEADERSHIP IN ENERGY AND ENVIRONMENTAL DESIGN
LIN	LINEAR
LP	LOW POINT
LT	LIGHT
LT WT	LIGHTWEIGHT
LVL	LEVEL
MACH	MACHINE
MATL	MATERIAL(S)
MAX	MAXIMUM
MECH	MECHANICAL)
MED	MEDIUM
MEP	MECHANICAL, ELECTRICAL AND PLUMBING
MEZZ	MEZZANINE
MFR	MANUFACTURE(R)
MH	MANHOLE
MIN	MINIMUM/ MINUTE
MISC	MISCELLANEOUS
MO	MASONRY OPENING
MTD	MOUNTED
MTL	METAL
MULL	MULLION
N/A	NOT APPLICABLE
NFPA	NATIONAL FIRE PROTECTION AGENCY
NIC	NOT IN CONTRACT
NO/ #	NUMBER
NOM	NOMINAL
NSF	NET SQUARE FEET
NTS	NOT TO SCALE

ABBREVIATIONS

OC	ON CENTER
OD	OUTSIDE DIAMETER
OFF	OFFICE
OH	OVERHEAD
OPG	OPENING
OPP	OPPOSITE
OSHA	OCCUPATIONAL SAFETY AND HEALTH ADMINISTRATION
PLAM	PLASTIC LAMINATE
PE	PASSENGER ELEVATOR
PERF	PERFORATE(D)
PL	PLATE
PL	PROPERTY LINE
PLAS	PLASTER
PLF	POUNDS PER LINEAR FOOT
PLMB	PLUMBING
PNL	PANEL
PSF	POUNDS PER SQUARE FOOT
PSI	POUNDS PER SQUARE INCH
PT	POINT
PNT	PAINT
PTD	PAINT(ED)
PLYWD	PLYWOOD
QT	QUARRY TILE
RAD	RADIUS
RD	ROOF DRAIN
REF	REFERENCE
REINF	REINFORCE(D)
REQ	REQUIREMENTS
REV	REVISION(S)
RFI	REQUEST FOR INFORMATION
RFP	REQUEST FOR PROPOSAL
RM	ROOM
SCP	SCUPPER
SD	SIDE
SE	SERVICE ELEVATOR
SHR	SHOWER
SF	SQUARE FEET
SIM	SIMILAR
SMACNA	SHEET METAL AND AIR CONDITIONING CONTRACTORS' NATIONAL ASSOCIATION
SOG	SLAB ON GRADE
SP&SD	STAND PIPE AND SPRINKLER DRAIN
SPEC	SPECIFICATION(S)
SQ	SQUARE
ST	STAINLESS
STC	SOUND TRANSMISSION COEFFICIENT
STD	STANDARD
STL	STEEL
STOR	STORAGE
STRUCT	STRUCTURE/STRUCTURAL
SUSP	SUSPENDED
T	TREAD
TD	TRENCH DRAIN
TOS	TOP OF SLAB
TO STL	TOP OF STEEL
TOW	TOP OF WALL
T&G	TONGUE AND GROOVE
TECH	TECHNICAL
TEL	TELEPHONE
TEMP	TEMPERED
TERR	TERRACE
THK	THICK(NESS)
TO	TOP OF
TOC	TOP OF CURB
TV	TELEVISION
TYP	TYPICAL
TZ	TERRAZZO
UL	UNDERWRITERS LABORATORY
UOI	UNLESS OTHERWISE INDICATED
UON	UNLESS OTHERWISE NOTED
UV	ULTRAVIOLET
VAV	VARIABLE AIR VOLUME
VB	VINYL BASE
VCT	VINYL COMPOSITION TILE
VERT	VERTICAL
VEST	VESTIBULE
VFY	VREIFY
"	VERIFY IN FIELD
W/O	WITH/ WITHOUT
	WOOD
WI	WEIGHT

DRAWING SYMBOLS

T.O. FIN FLR EL. 15'-0" — ELEVATION IN SECTION

T.O. FIN FLR EL. 15'-0" — ELEVATION IN PLAN

N

3 — COLUMN GRIDS

PROPERTY LINE

CENTER LINE

CUT LINE

LINE ABOVE OR BELOW PLAN (SOFFITS, ETC.)

DETAIL NUMBER / A202 / SHEET NUMBER — ELEVATION SYMBOL

FIN-EL — INTERIOR FINISH (REFER TO FINISH SCHEDULE AND MATERIAL INDEX)

CPT — MATERIAL (REFER TO FINISH SCHEDULE AND MATERIAL INDEX)

DETAIL NUMBER / A202 / SHEET NUMBER — SECTION SYMBOL

800 — PARTITION TYPE (REFER TO DWG A401)

DETAIL NUMBER / A504 / SHEET NUMBER — ENLARGED DETAIL SYMBOL

SMOKE PARTITION

1-HOUR, FIRE RATED WALL

2-HOUR, FIRE RATED WALL

3-HOUR, FIRE RATED WALL

RCP DEVICE KEY

BUILDING ENTRANCE

WILLIAM J. CLINTON PRESIDENTIAL CENTER

LITTLE ROCK, ARKANSAS

Architect

POLSHEK PARTNERSHIP LLP
320 West 13th Street
New York, New York 10014
212.807.7171

Coordinating Architects

POLK STANLEY YEARY ARCHITECTS Ltd
700 South Schiller Street
Little Rock, Arkansas 72201
501.378.0878

WITSELL EVANS RASCO
901 West Third Street
Little Rock, Arkansas 72201
501.374.5300

WOODS CARADINE ARCHITECTS
2200 South Main Street
Little Rock, Arkansas 72206
501.374.4060

Landscape Architects

HARGREAVES ASSOCIATES
118 Magazine Street
Cambridge, Massachusettes 02139
617.661.0070

LANDSCAPE ARCHITECTURE, Inc.
2300 Cottondale Lane Suite 202
Little Rock, Arkansas 72202
501.374.5610

Structural Engineer

LESLIE E. ROBERTSON ASSOC., RLLP
30 Broad Street, 47th Floor
New York, New York 10004
212.750.9000

MEP Engineers

FLACK + KURTZ Inc.
475 Fifth Avenue
New York, New York 10017
212.532.9600


CROMWELL ARCHITECTS ENGINEERS
101 South Spring Street
Little Rock, Arkansas 72201
501.372.2900

Curtainwall Consultant

R. A. HEINTGES ARCHITECTS
126 Fifth Avenue, 9th Floor
New York, New York 10011
212.652-2966

Seal

Issue	Date
100% Construction Documents	09/27/02
90% Progress Printing	08/30/02
100% Struct./ CD Progress	07/01/02
Bridge Bldg. Substructure	06/14/02
100% Steel & Concrete CD	05/15/02
& Architectural CD Progress	
100% Design Development	03/01/02

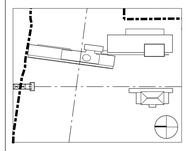

Job No. 9908

Scale

Date September 27, 2002


Title

ABBREVIATIONS AND SYMBOLS

Sheet No.

A001

FOR OFFICIAL USE ONLY

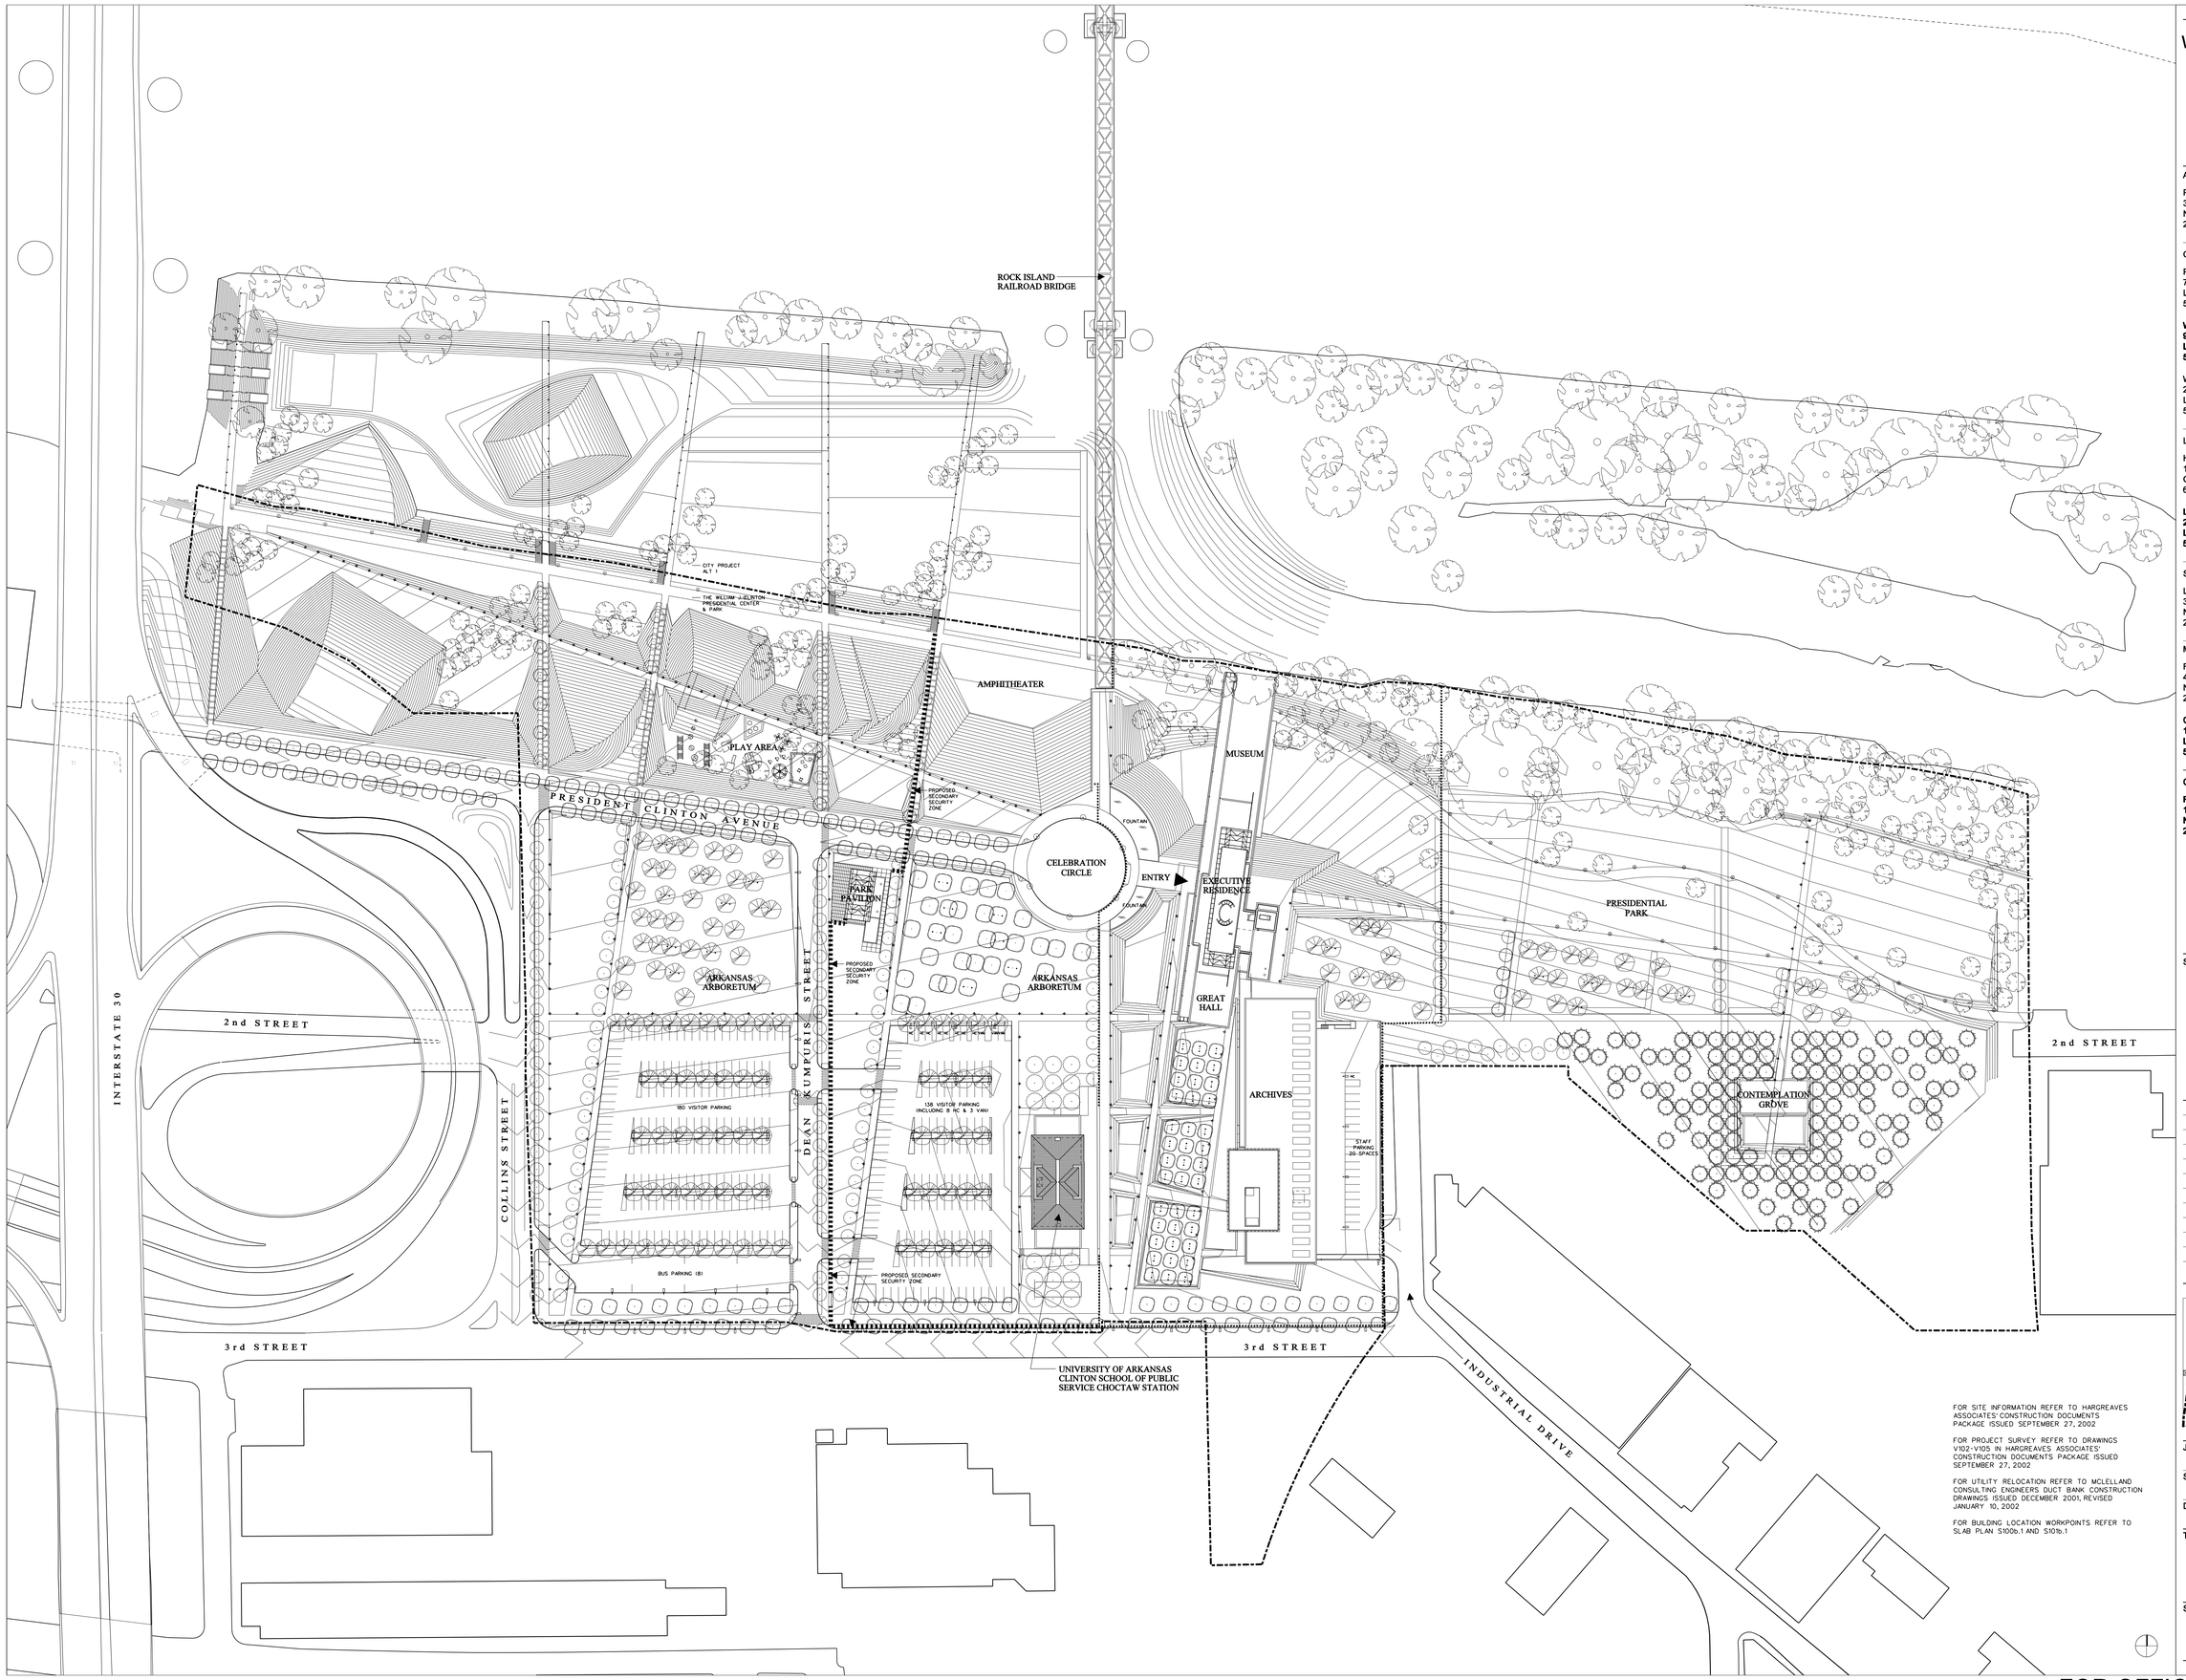

FOR SITE INFORMATION REFER TO HARGREAVES ASSOCIATES' CONSTRUCTION DOCUMENTS PACKAGE ISSUED SEPTEMBER 27, 2002

FOR PROJECT SURVEY REFER TO DRAWINGS V102-V105 IN HARGREAVES ASSOCIATES' CONSTRUCTION DOCUMENTS PACKAGE ISSUED SEPTEMBER 27, 2002

FOR UTILITY RELOCATION REFER TO MCLELLAND CONSULTING ENGINEERS DUCT BANK CONSTRUCTION DRAWINGS ISSUED DECEMBER 2001, REVISED JANUARY 10, 2002

FOR BUILDING LOCATION WORKPOINTS REFER TO SLAB PLAN S100b.1 AND S101b.1

WILLIAM J. CLINTON PRESIDENTIAL CENTER

LITTLE ROCK, ARKANSAS

Architect

POLSHEK PARTNERSHIP LLP
320 West 13th Street
New York, New York 10014
212.807.7171

Coordinating Architects

POLK STANLEY YEARY ARCHITECTS Ltd
700 South Schiller Street
Little Rock, Arkansas 72201
501.378.0878

WITSELL EVANS RASCO
901 West Third Street
Little Rock, Arkansas 72201
501.374.5300

WOODS CARADINE ARCHITECTS
2200 South Main Street
Little Rock, Arkansas 72206
501.374.4060

Landscape Architects

HARGREAVES ASSOCIATES
118 Magazine Street
Cambridge, Massachusettes 02139
617.661.0070

LANDSCAPE ARCHITECTURE, Inc.
2300 Cottondale Lane Suite 202
Little Rock, Arkansas 72202
501.374.5610

Structural Engineer

LESLIE E. ROBERTSON ASSOC., RLLP
30 Broad Street, 47th Floor
New York, New York 10004
212.750.9000

MEP Engineers

FLACK + KURTZ Inc.
475 Fifth Avenue
New York, New York 10017
212.532.9600

CROMWELL ARCHITECTS ENGINEERS
101 South Spring Street
Little Rock, Arkansas 72201
501.372.2900

Curtainwall Consultant

R. A. HEINTGES ARCHITECTS
126 Fifth Avenue, 9th Floor
New York, New York 10011
212.652-2966

Seal

Issue	Date
100% Construction Documents	09/27/02
90% Progress Printing	08/30/02
100% Struct./ CD Progress	07/01/02
Bridge Bldg. Substructure	06/14/02
100% Steel & Concrete CD & Architectural CD Progress	05/15/02
100% Design Development	03/01/02

Job No. 9908

Scale 1:80

Date **September 27, 2002**


Title

SITE PLAN

Sheet No.


A002

FOR OFFICIAL USE ONLY

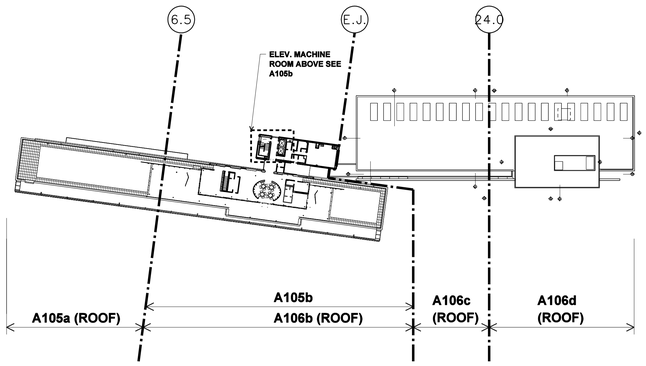


EXECUTIVE LEVEL PLAN

SCALE: 1:70 FOR INFORMATION ONLY 32

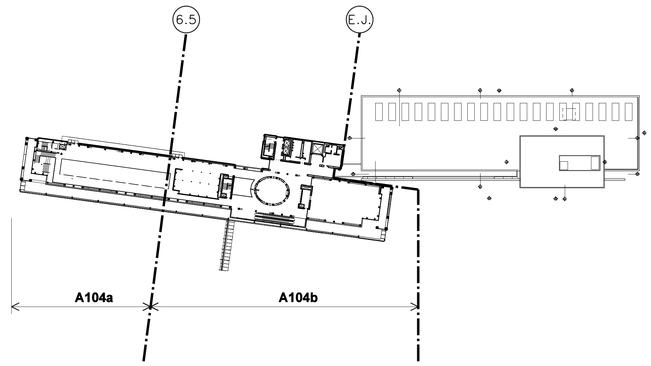


MUSEUM UPPER-LEVEL PLAN

SCALE: 1:70 FOR INFORMATION ONLY 31

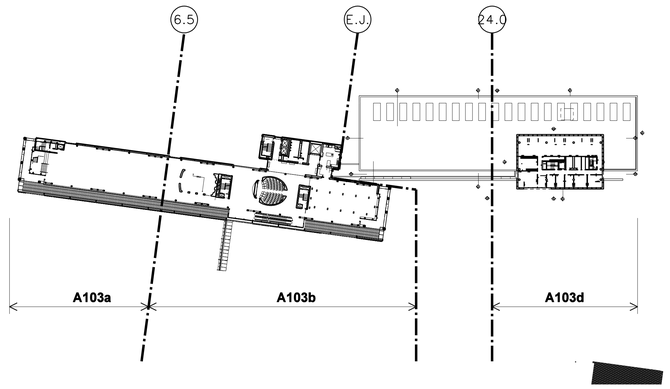


MUSEUM LOWER-LEVEL PLAN

SCALE: 1:70 FOR INFORMATION ONLY 30

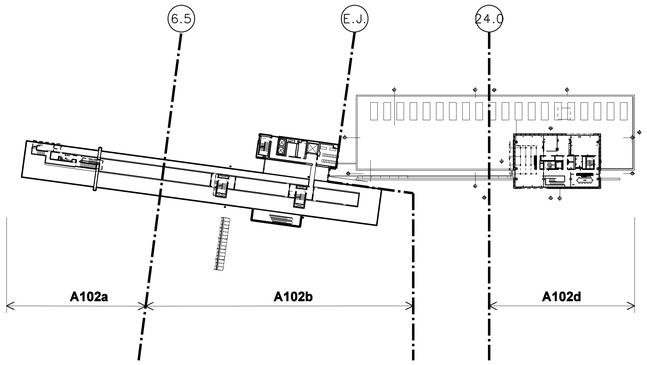


SECOND LEVEL PLAN

SCALE: 1:70 FOR INFORMATION ONLY 22

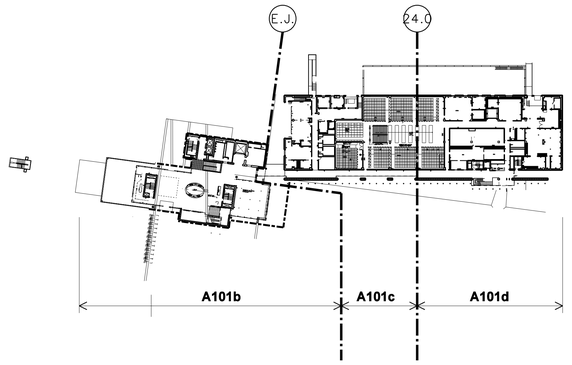


GROUND LEVEL PLAN

SCALE: 1:70 FOR INFORMATION ONLY 21

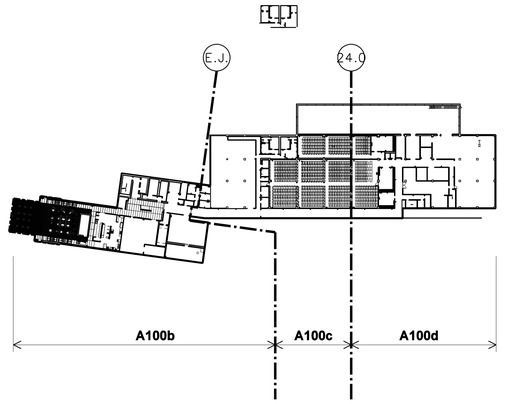


BASEMENT LEVEL PLAN

SCALE: 1:70 FOR INFORMATION ONLY 20

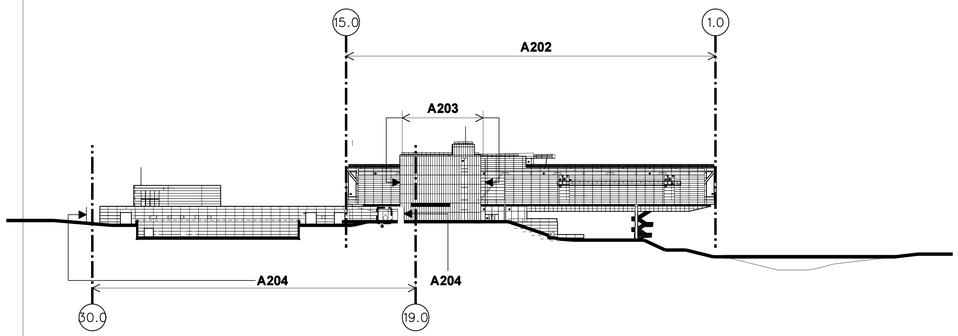

EAST ELEVATION

SCALE: 1:70 FOR INFORMATION ONLY 11

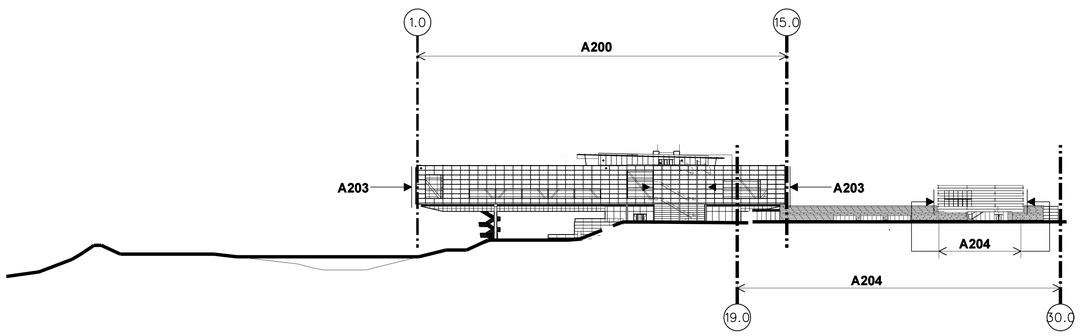

WEST ELEVATION

SCALE: 1:70 FOR INFORMATION ONLY 10

WILLIAM J. CLINTON PRESIDENTIAL CENTER

LITTLE ROCK, ARKANSAS

Architect

POLSHEK PARTNERSHIP LLP
320 West 13th Street
New York, New York 10014
212.807.7171

Coordinating Architects

POLK STANLEY YEARY ARCHITECTS Ltd
700 South Schiller Street
Little Rock, Arkansas 72201
501.378.0878

WITSELL EVANS RASCO
901 West Third Street
Little Rock, Arkansas 72201
501.374.5300

WOODS CARADINE ARCHITECTS
2200 South Main Street
Little Rock, Arkansas 72206
501.374.4060

Landscape Architects

HARGREAVES ASSOCIATES
118 Magazine Street
Cambridge, Massachusettes 02139
617.661.0070

LANDSCAPE ARCHITECTURE, Inc.
2300 Cottondale Lane Suite 202
Little Rock, Arkansas 72202
501.374.5610

Structural Engineer

LESLIE E. ROBERTSON ASSOC., RLLP
30 Broad Street, 47th Floor
New York, New York 10004
212.750.9000

MEP Engineers

FLACK + KURTZ Inc.
475 Fifth Avenue
New York, New York 10017
212.532.9600


CROMWELL ARCHITECTS ENGINEERS
101 South Spring Street
Little Rock, Arkansas 72201
501.372.2900

Curtainwall Consultant

R. A. HEINTGES ARCHITECTS
126 Fifth Avenue, 9th Floor
New York, New York 10011
212.652-2966

Seal

Issue	Date
100% Design Development	03/01/02
& Architectural CD Progress	
100% Steel & Concrete CD	05/15/02
100% Struct./ CD Progress	07/01/02
90% Progress Printing	08/30/02
100% Construction Documents	09/27/02

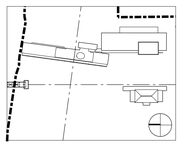

Job No. 9908

Scale AS NOTED

Date September 27, 2002


Title

KEY PLANS

Sheet No.

A003

FOR OFFICIAL USE ONLY

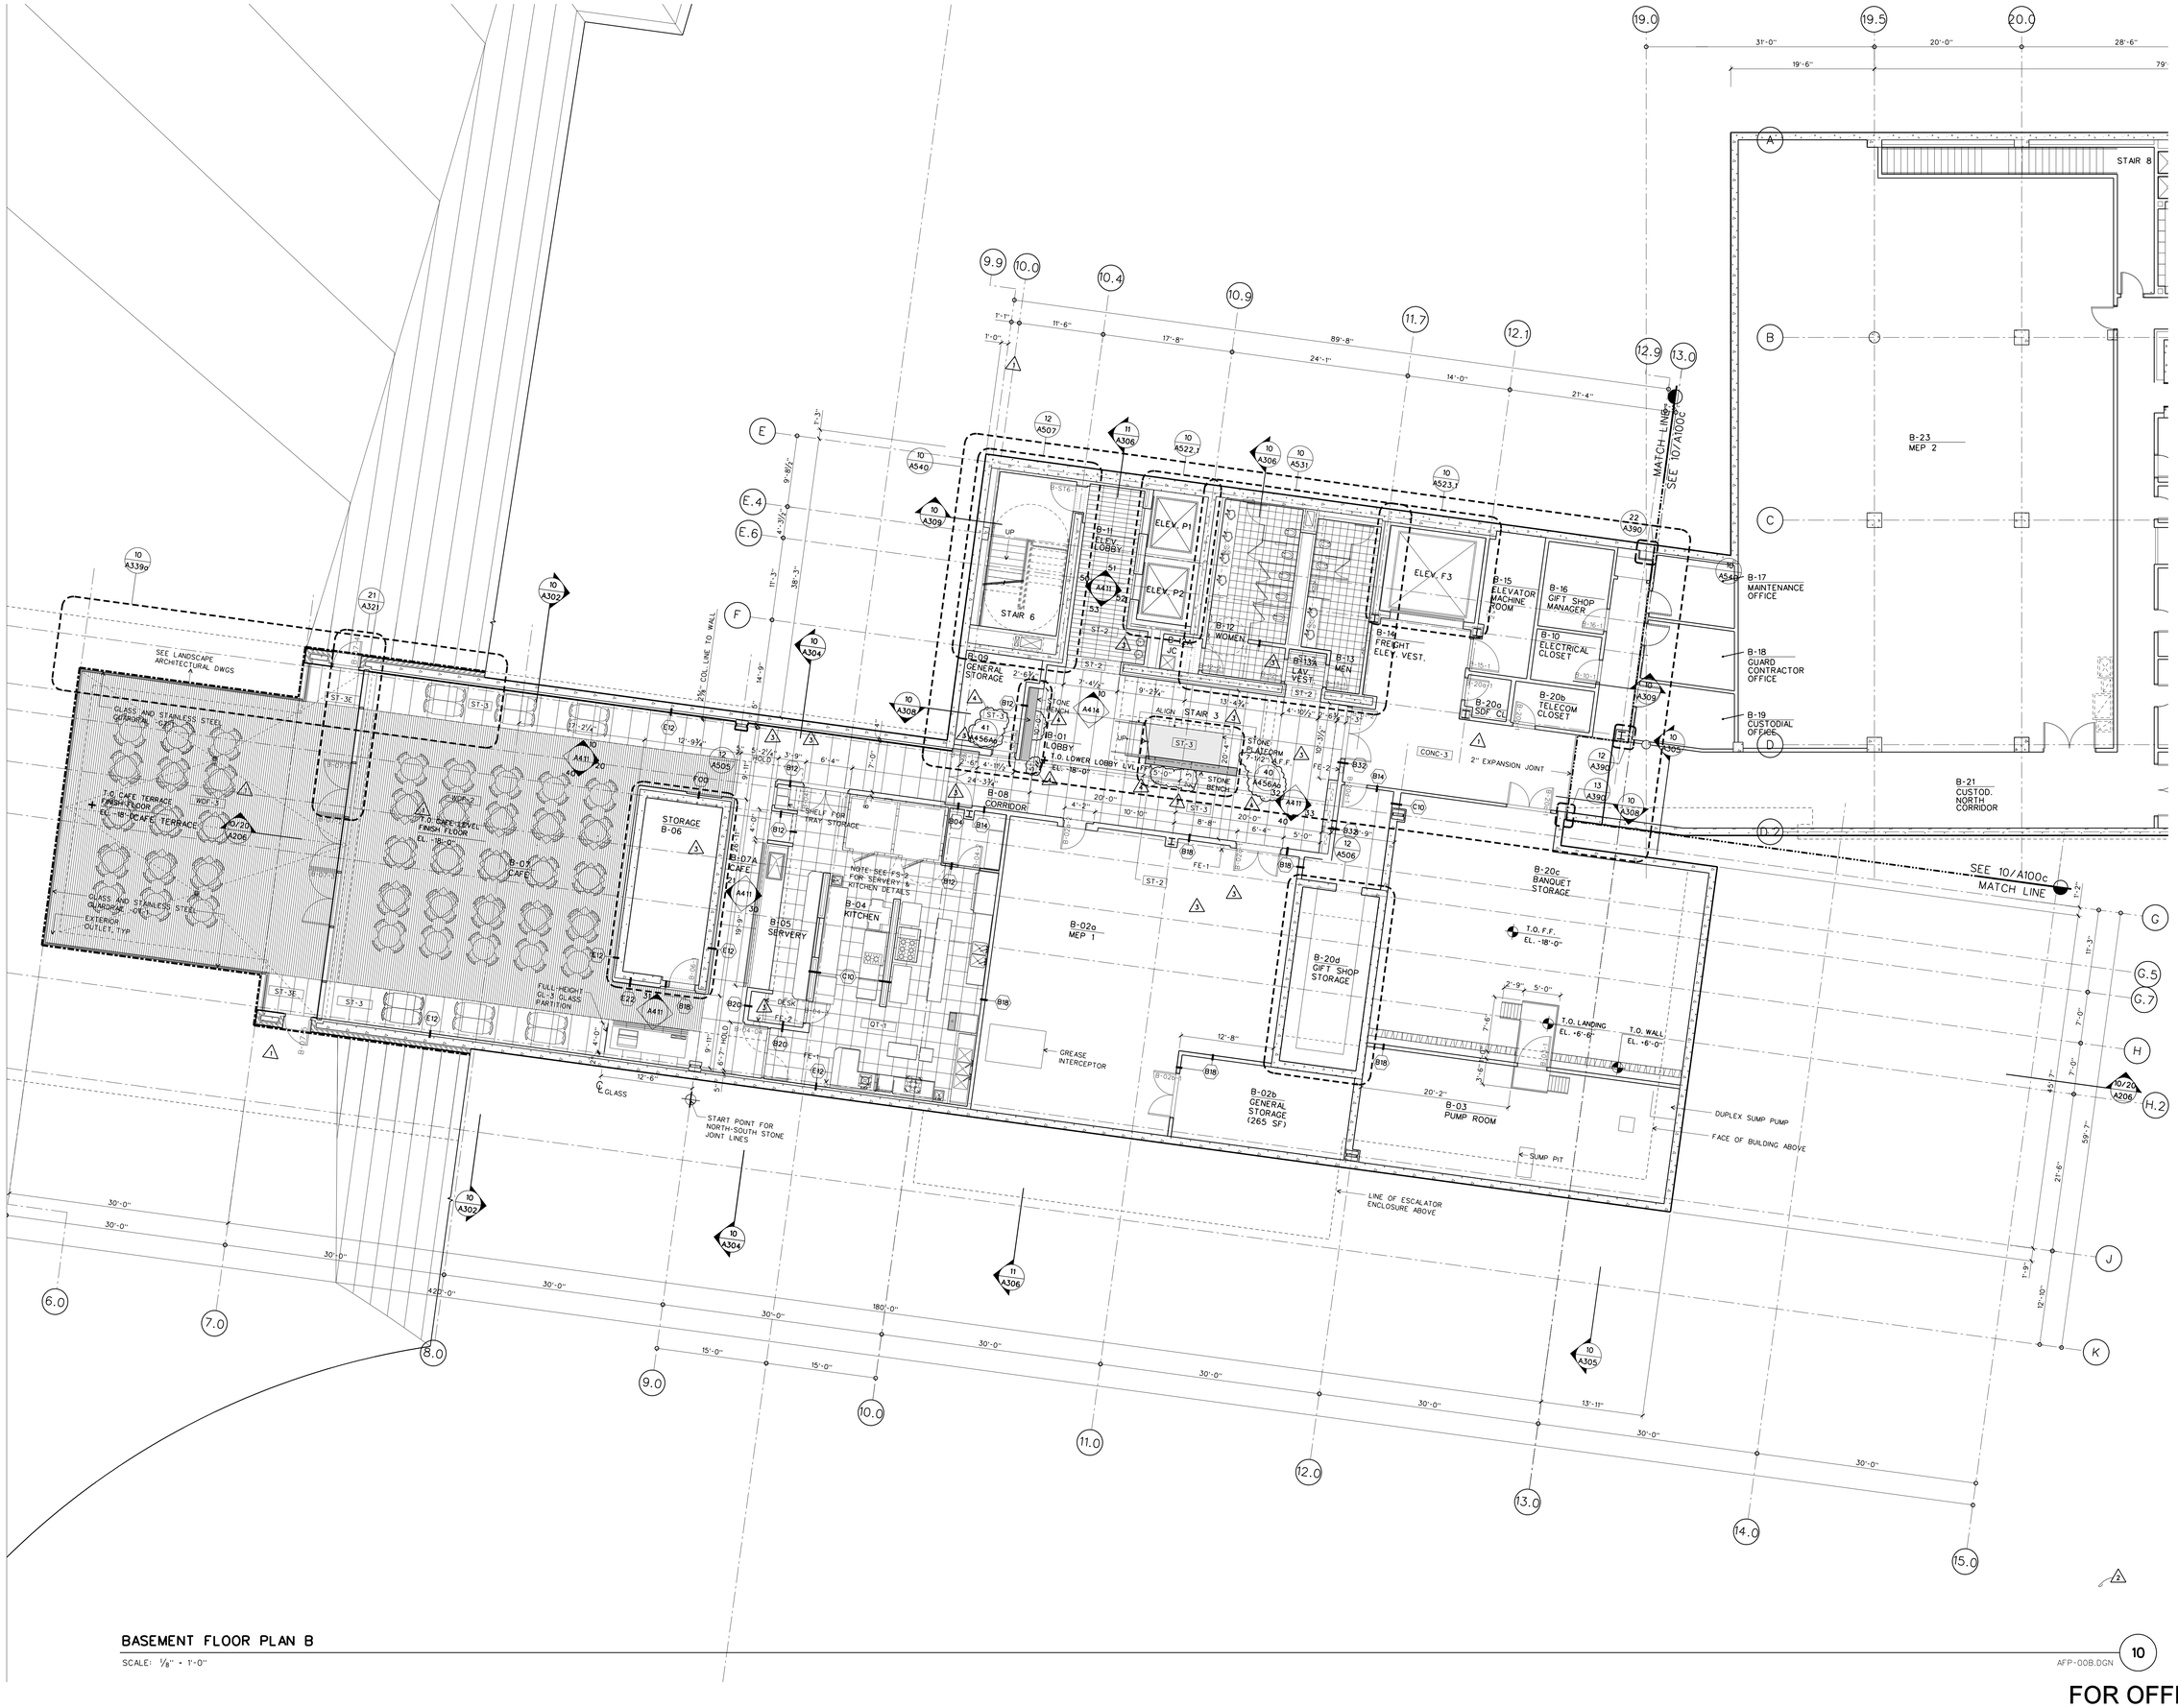

BASEMENT FLOOR PLAN B

SCALE: 1/8" = 1'-0"

AFP-00B.DGN

10

FOR OFFICIAL USE ONLY

WILLIAM J. CLINTON PRESIDENTIAL CENTER

LITTLE ROCK, ARKANSAS

Architect

POLSHEK PARTNERSHIP LLP
320 West 13th Street
New York, New York 10014
212.807.7171

Coordinating Architects

POLK STANLEY YEARY ARCHITECTS Ltd
700 South Schiller Street
Little Rock, Arkansas 72201
501.378.0878

WITSELL EVANS RASCO
901 West Third Street
Little Rock, Arkansas 72201
501.374.5300

WOODS CARADINE ARCHITECTS
2200 South Main Street
Little Rock, Arkansas 72206
501.374.4060

Landscape Architects

HARGREAVES ASSOCIATES
118 Magazine Street
Cambridge, Massachusettes 02139
617.661.0070

LANDSCAPE ARCHITECTURE, Inc.
2300 Cottondale Lane Suite 202
Little Rock, Arkansas 72202
501.374.5610

Structural Engineer

LESLIE E. ROBERTSON ASSOC., RLLP
30 Broad Street, 47th Floor
New York, New York 10004
212.750.9000

MEP Engineers

FLACK + KURTZ Inc.
475 Fifth Avenue
New York, New York 10017
212.532.9600

CROMWELL ARCHITECTS ENGINEERS
101 South Spring Street
Little Rock, Arkansas 72201
501.372.2900

Curtainwall Consultant

R. A. HEINTGES ARCHITECTS
126 Fifth Avenue, 9th Floor
New York, New York 10011
212.652-2966

Seal

Issue	Date
2 ASI #25	12/19/03
1 ASI #23	09/12/03
2 ASI #20	06/06/03
1 Addendum #2	11/15/02
100% Construction Documents	09/27/02
90% Progress Printing	08/30/02
100% Struct./ CD Progress	07/01/02
Bridge Bldg. Substructure	06/14/02
100% Steel & Concrete CD & Architectural CD Progress	05/15/02
100% Design Development	03/01/02

Job No. 9908

Scale 1/8" = 1'-0"


Date September 27, 2002

Title

BASEMENT LEVEL PARTIAL PLAN

Sheet No.

A100b

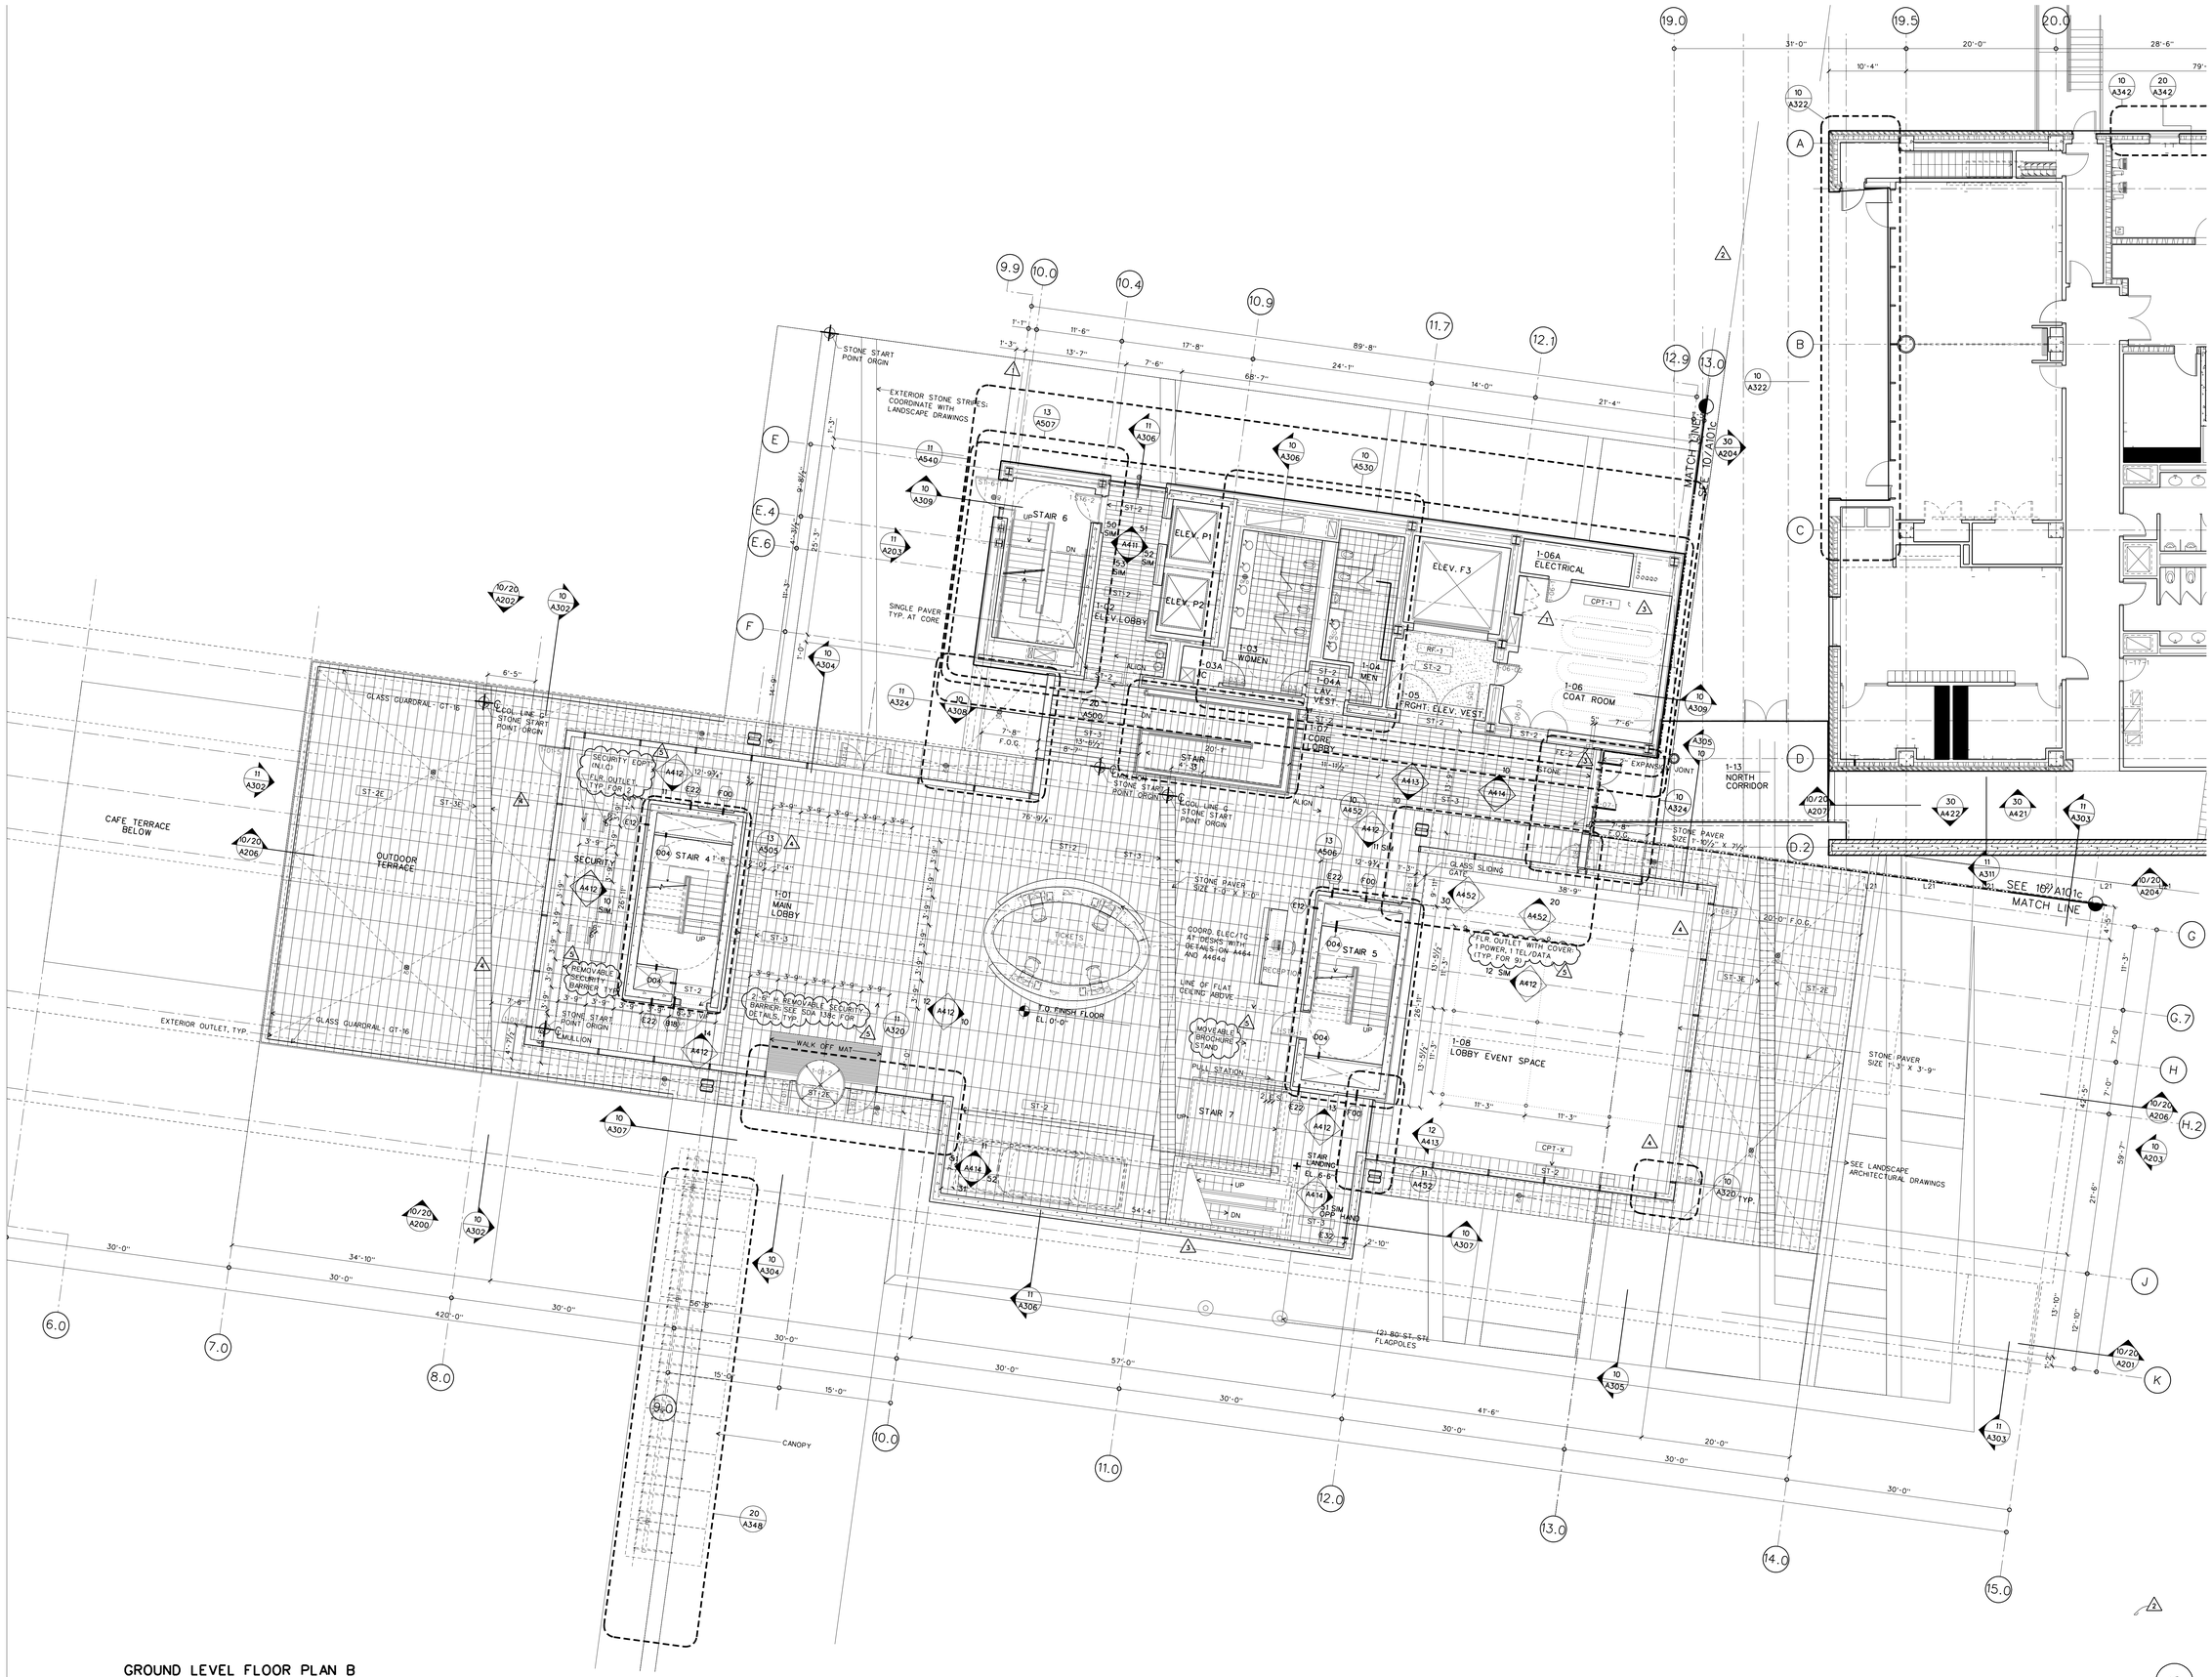

GROUND LEVEL FLOOR PLAN B

SCALE: 1/8" - 1'-0"

AFP-01.DGN

10

FOR OFFICIAL USE ONLY

WILLIAM J. CLINTON PRESIDENTIAL CENTER

LITTLE ROCK, ARKANSAS

Architect

POLSHEK PARTNERSHIP LLP
320 West 13th Street
New York, New York 10014
212.807.7171

Coordinating Architects

POLK STANLEY YEARY ARCHITECTS Ltd
700 South Schiller Street
Little Rock, Arkansas 72201
501.378.0878

WITSELL EVANS RASCO
901 West Third Street
Little Rock, Arkansas 72201
501.374.5300

WOODS CARADINE ARCHITECTS
2200 South Main Street
Little Rock, Arkansas 72206
501.374.4060

Landscape Architects

HARGREAVES ASSOCIATES
118 Magazine Street
Cambridge, Massachusettes 02139
617.661.0070

LANDSCAPE ARCHITECTURE, Inc.
2300 Cottondale Lane Suite 202
Little Rock, Arkansas 72202
501.374.5610

Structural Engineer

LESLIE E. ROBERTSON ASSOC., RLLP
30 Bread Street, 47th Floor
New York, New York 10004
212.750.9000

MEP Engineers

FLACK + KURTZ Inc.
475 Fifth Avenue
New York, New York 10017
212.532.9600

CROMWELL ARCHITECTS ENGINEERS
101 South Spring Street
Little Rock, Arkansas 72201
501.372.2900

Curtainwall Consultant

R. A. HEINTGES ARCHITECTS
126 Fifth Avenue, 9th Floor
New York, New York 10011
212.652-2966

Seal

	Issue	Date
2	ASI #38	08/14/04
1	ASI #25	12/19/03
1	ASI #23	09/12/03
1	ASI #20	06/06/03
1	Addendum #2	11/15/02
	100% Construction Documents	09/27/02
	90% Progress Printing	08/30/02
	100% Struct./ CD Progress	07/01/02
	Bridge Bldg. Substructure	06/14/02
	100% Steel & Concrete CD & Architectural CD Progress	05/15/02
	100% Design Development	03/01/02

Job No. 9908

Scale 1/8" = 1'-0"


Date September 27, 2002

Title

GROUND LEVEL PARTIAL PLAN

Sheet No.

A101b

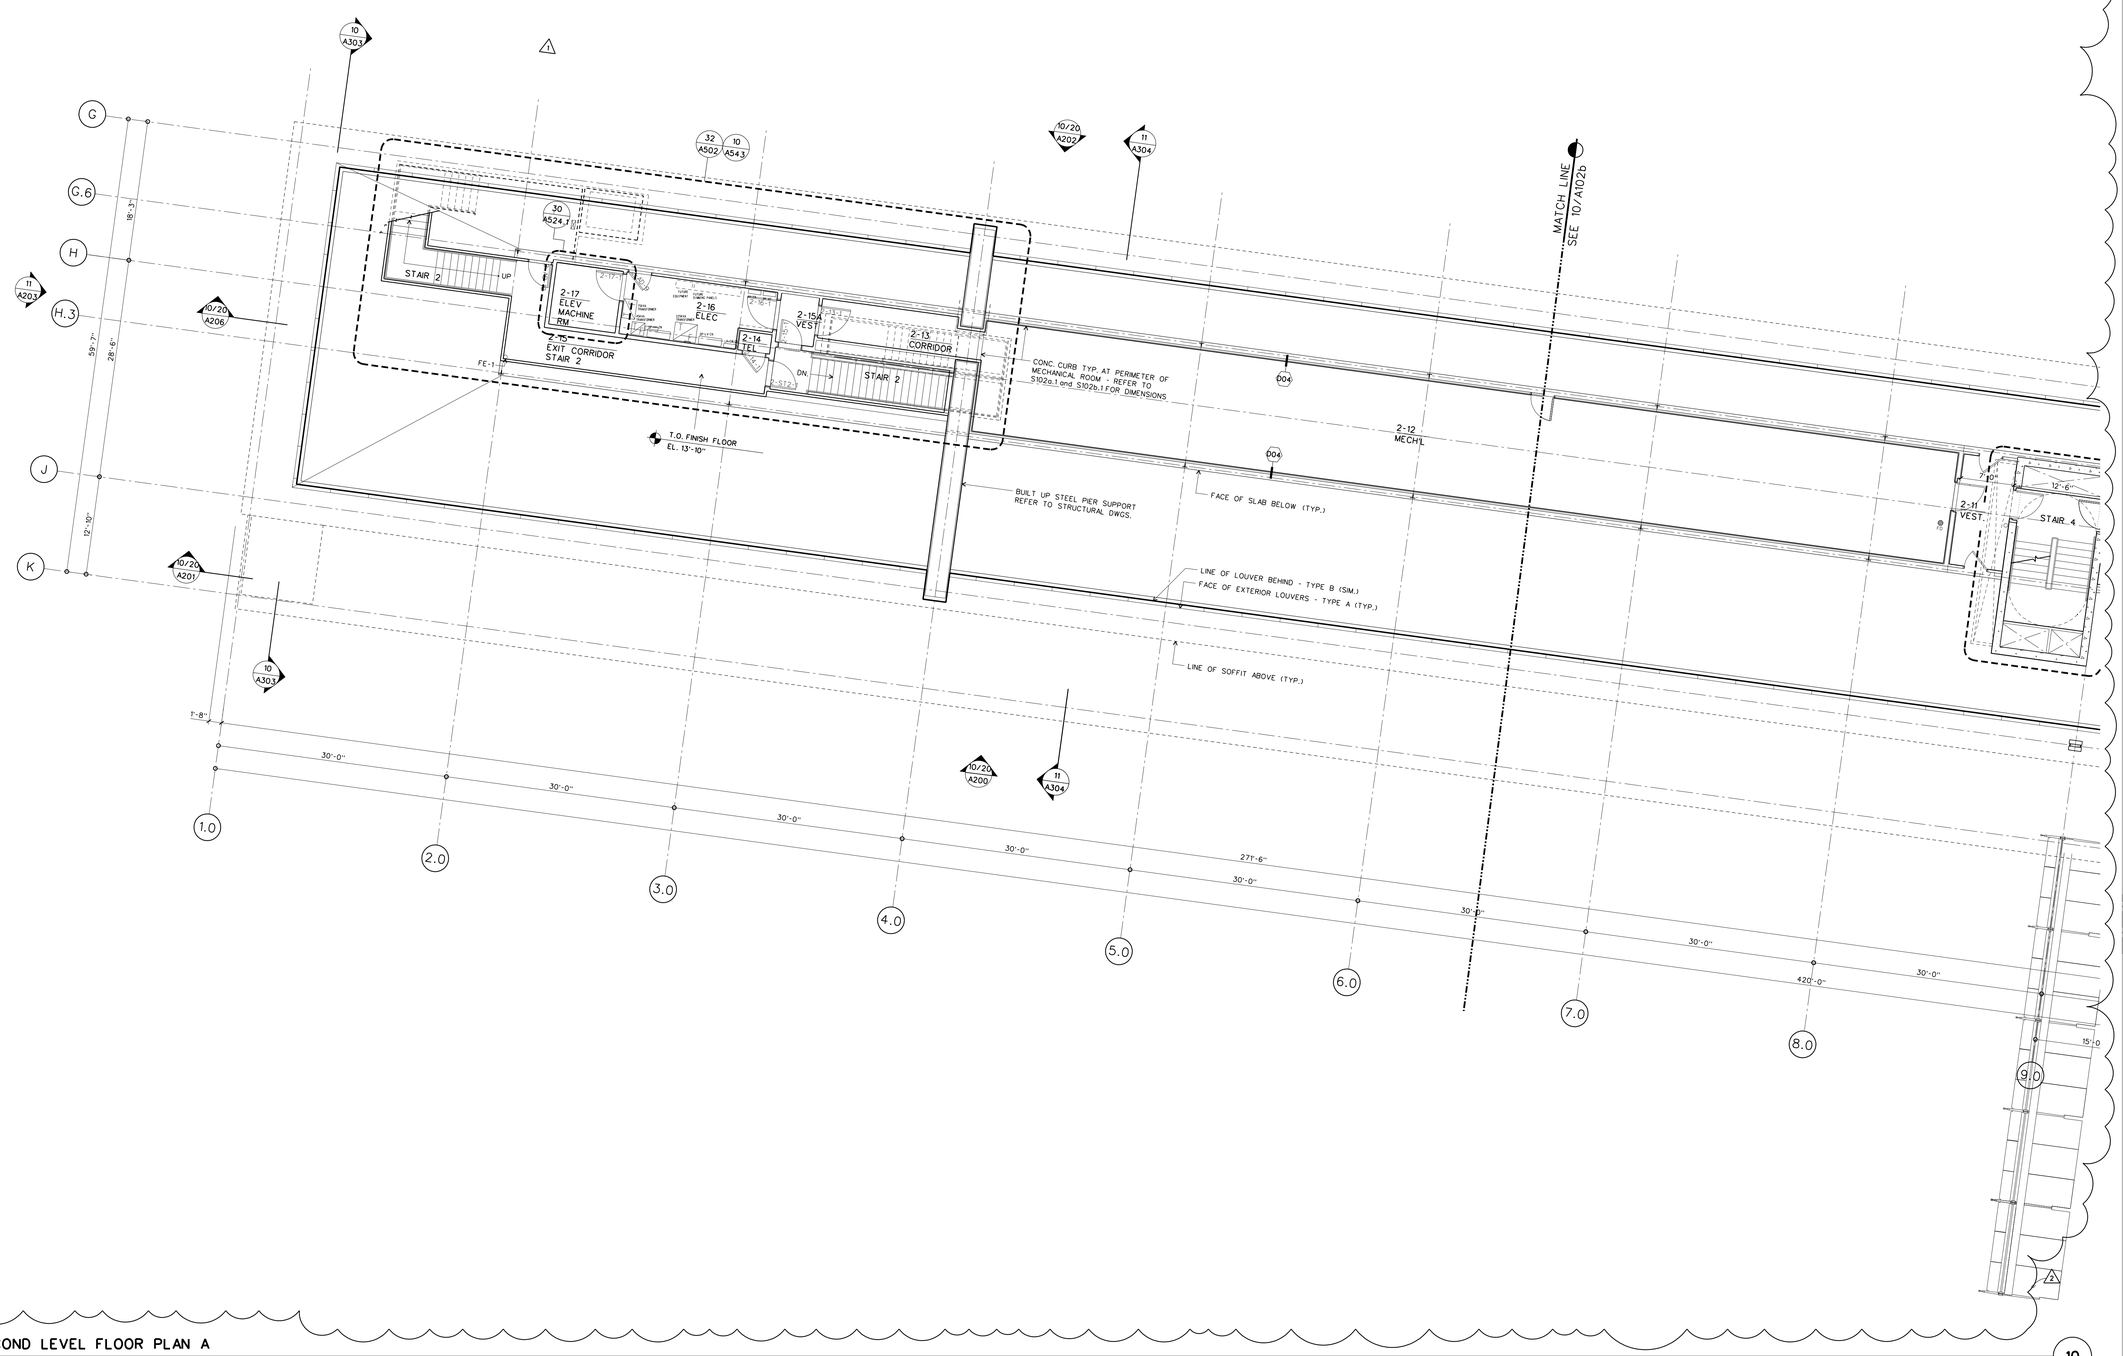

SECOND LEVEL FLOOR PLAN A

SCALE: 1/8" = 1'-0"

AFP-02.DGN

10

WILLIAM J. CLINTON PRESIDENTIAL CENTER

LITTLE ROCK, ARKANSAS

Architect

POLSHEK PARTNERSHIP LLP
320 West 13th Street
New York, New York 10014
212.807.7171

Coordinating Architects

POLK STANLEY YEARY ARCHITECTS Ltd
700 South Schiller Street
Little Rock, Arkansas 72201
501.378.0878

WITSELL EVANS RASCO
901 West Third Street
Little Rock, Arkansas 72201
501.374.5300

WOODS CARADINE ARCHITECTS
2200 South Main Street
Little Rock, Arkansas 72206
501.374.4060

Landscape Architects

HARGREAVES ASSOCIATES
118 Magazine Street
Cambridge, Massachusettes 02139
617.661.0070

LANDSCAPE ARCHITECTURE, Inc.
2300 Cottondale Lane Suite 202
Little Rock, Arkansas 72202
501.374.5610

Structural Engineer

LESLIE E. ROBERTSON ASSOC., RLLP
30 Broad Street, 47th Floor
New York, New York 10004
212.750.9000

MEP Engineers

FLACK + KURTZ Inc.
475 Fifth Avenue
New York, New York 10017
212.532.9600

CROMWELL ARCHITECTS ENGINEERS
101 South Spring Street
Little Rock, Arkansas 72201
501.372.2900

Curtainwall Consultant

R. A. HEINTGES ARCHITECTS
126 Fifth Avenue, 9th Floor
New York, New York 10011
212.652-2966

Seal

Issue	Date
2 ASI #20	06/06/02
1 Addendum #2	11/15/02
100% Construction Documents	09/27/02
90% Progress Printing	08/30/02
100% Struct./ CD Progress	07/01/02
100% Steel & Concrete CD	05/15/02
& Architectural CD Progress	
100% Design Development	03/01/02

Job No. 9908

Scale 1/8" = 1'-0"


Date September 27, 2002

Title

SECOND LEVEL PARTIAL PLAN

Sheet No. A102a

FOR OFFICIAL USE ONLY

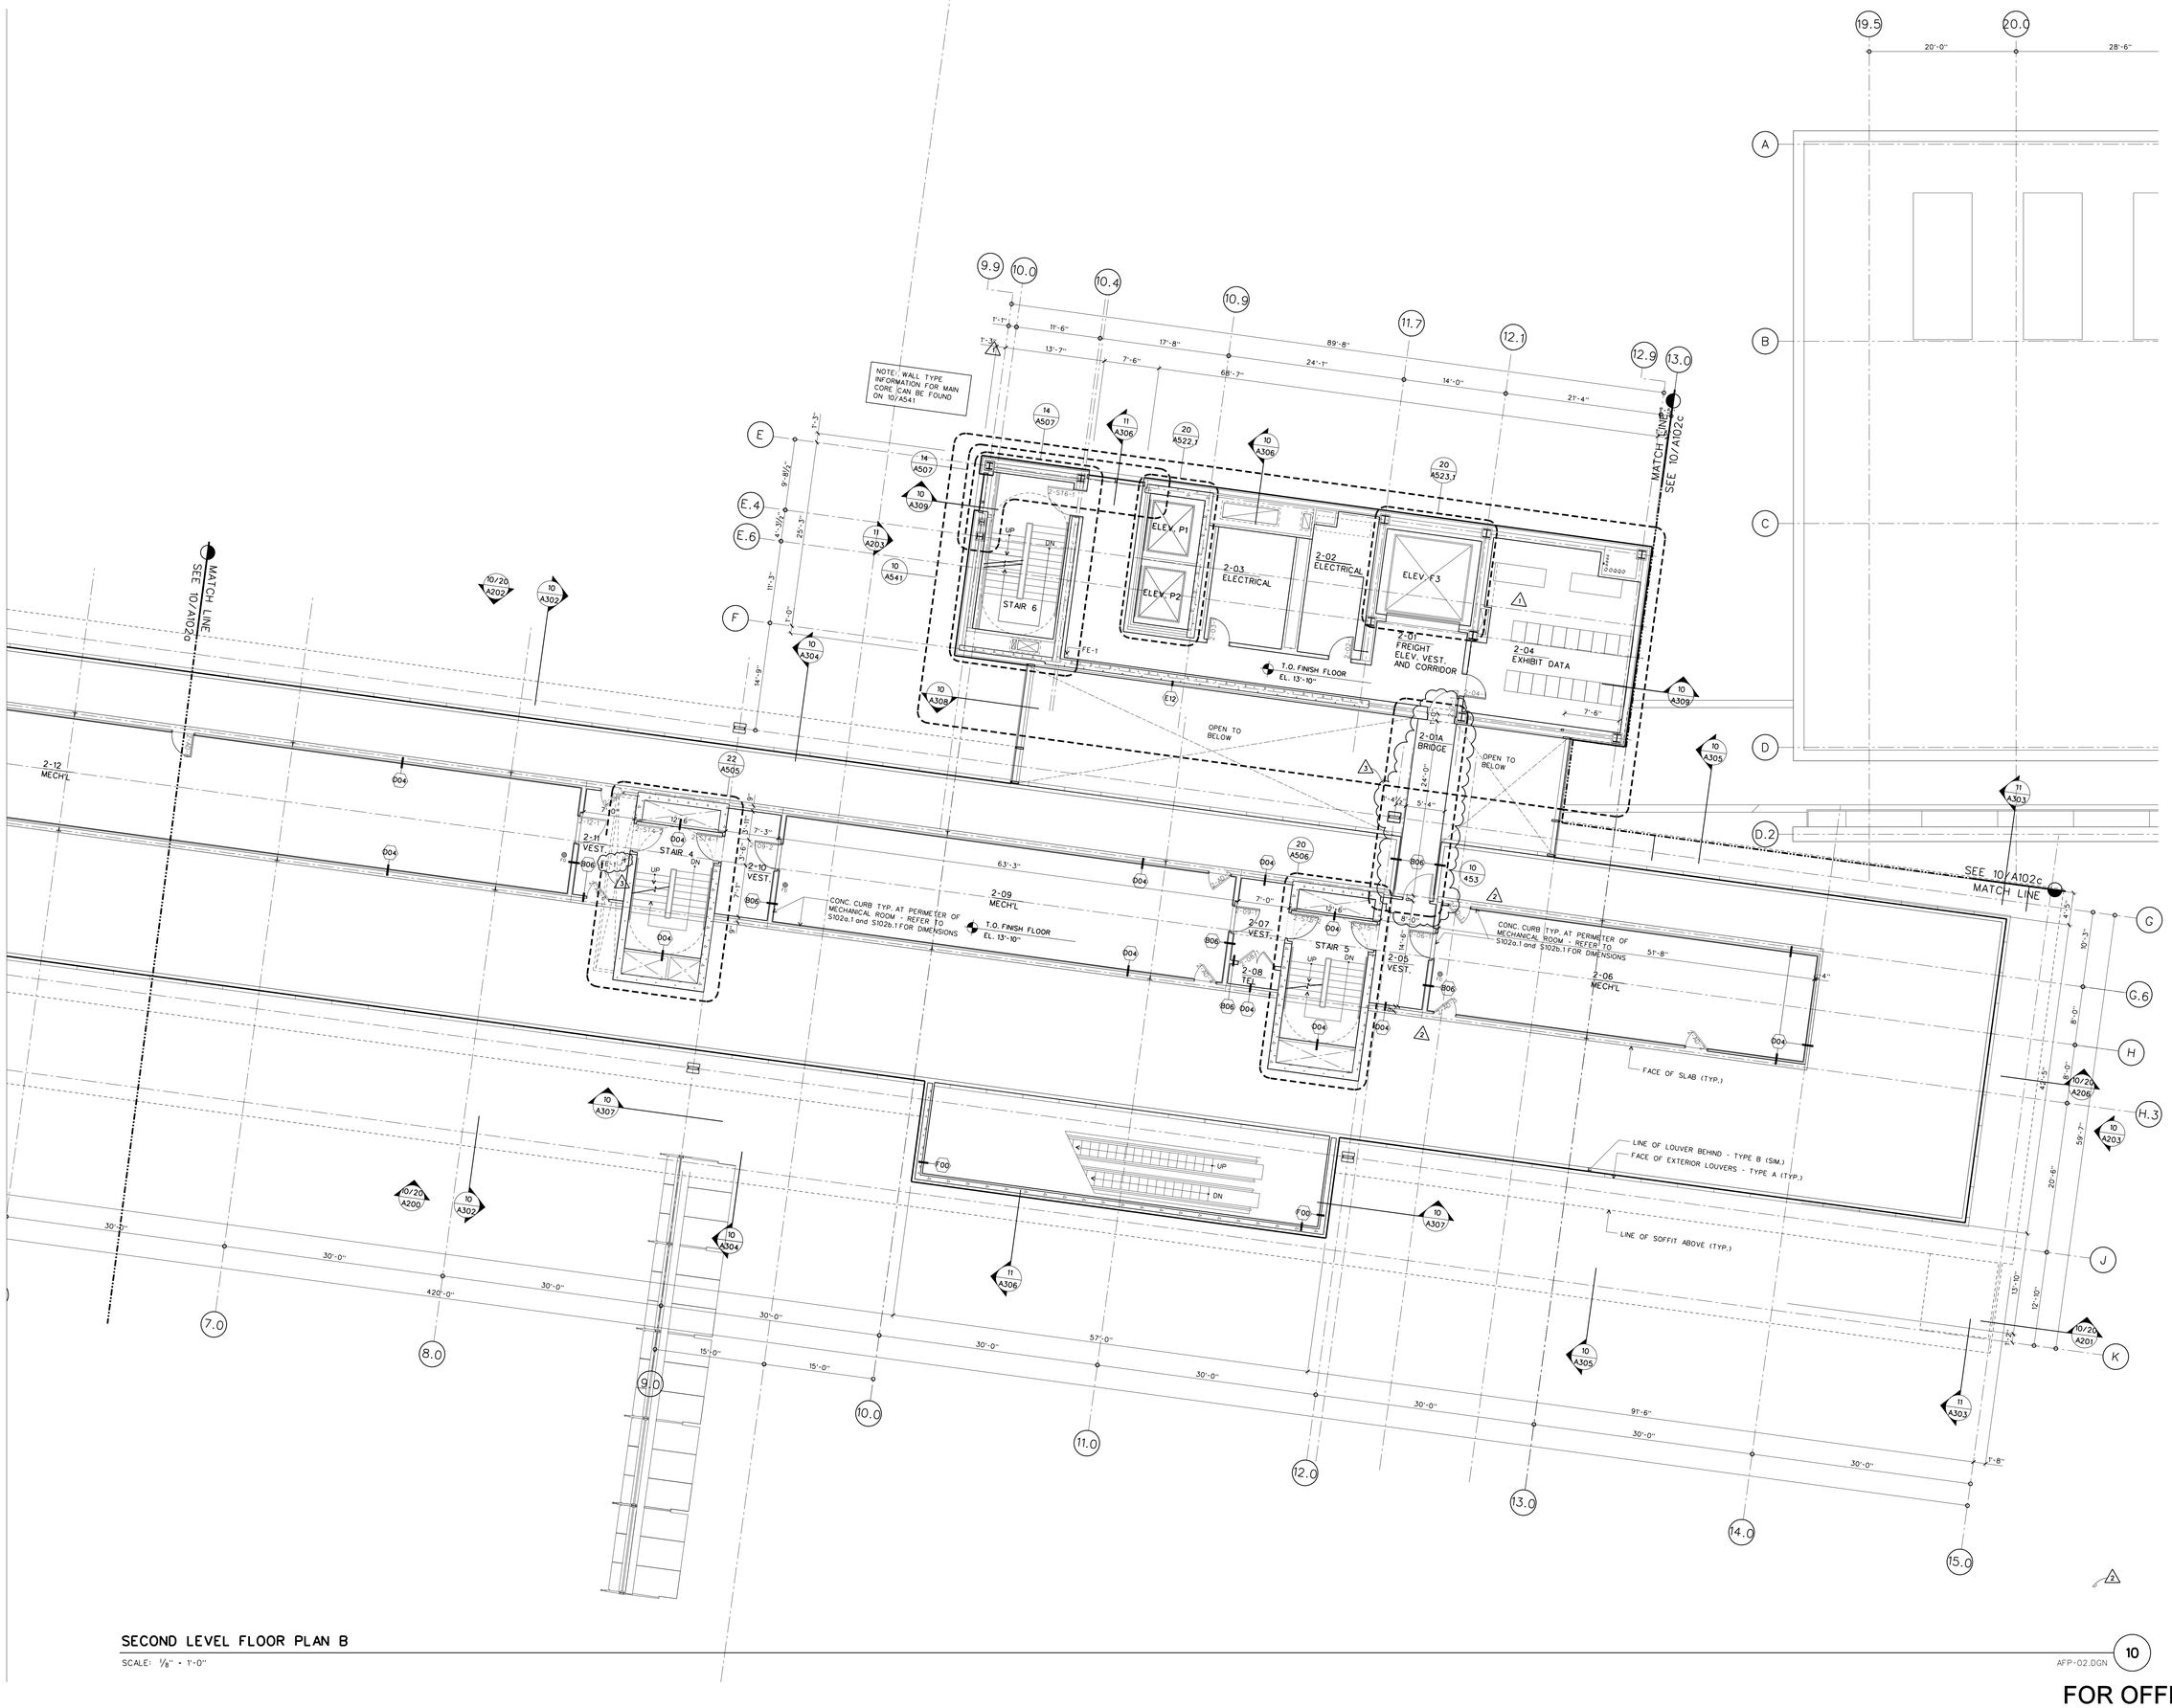

SECOND LEVEL FLOOR PLAN B

SCALE: 1/8" = 1'-0"

AFP-02.DGN

10

FOR OFFICIAL USE ONLY

WILLIAM J. CLINTON PRESIDENTIAL CENTER

LITTLE ROCK, ARKANSAS

Architect

POLSHEK PARTNERSHIP LLP
320 West 13th Street
New York, New York 10014
212.807.7171

Coordinating Architects

POLK STANLEY YEARY ARCHITECTS Ltd
700 South Schiller Street
Little Rock, Arkansas 72201
501.378.0878

WITSELL EVANS RASCO
901 West Third Street
Little Rock, Arkansas 72201
501.374.5300

WOODS CARADINE ARCHITECTS
2200 South Main Street
Little Rock, Arkansas 72206
501.374.4060

Landscape Architects

HARGREAVES ASSOCIATES
118 Magazine Street
Cambridge, Massachusettes 02139
617.661.0070

LANDSCAPE ARCHITECTURE, Inc.
2300 Cottondale Lane Suite 202
Little Rock, Arkansas 72202
501.374.5610

Structural Engineer

LESLIE E. ROBERTSON ASSOC., RLLP
30 Broad Street, 47th Floor
New York, New York 10004
212.750.9000

MEP Engineers

FLACK + KURTZ Inc.
475 Fifth Avenue
New York, New York 10017
212.532.9600

CROMWELL ARCHITECTS ENGINEERS
101 South Spring Street
Little Rock, Arkansas 72201
501.372.2900

Curtainwall Consultant

R. A. HEINTGES ARCHITECTS
126 Fifth Avenue, 9th Floor
New York, New York 10011
212.852-2966

Seal

Issue	Date
3 ASI #25	12/19/03
2 ASI #20	06/06/03
1 Addendum #2	11/15/02
100% Construction Documents	09/27/02
90% Progress Printing	08/30/02
100% Struct./ CD Progress	07/01/02
100% Steel & Concrete CD & Architectural CD Progress	05/15/02
100% Design Development	03/01/02

Job No. 9908

Scale 1/8" = 1'-0"


Date September 27, 2002

Title

SECOND LEVEL PARTIAL PLAN

Sheet No.

A102b

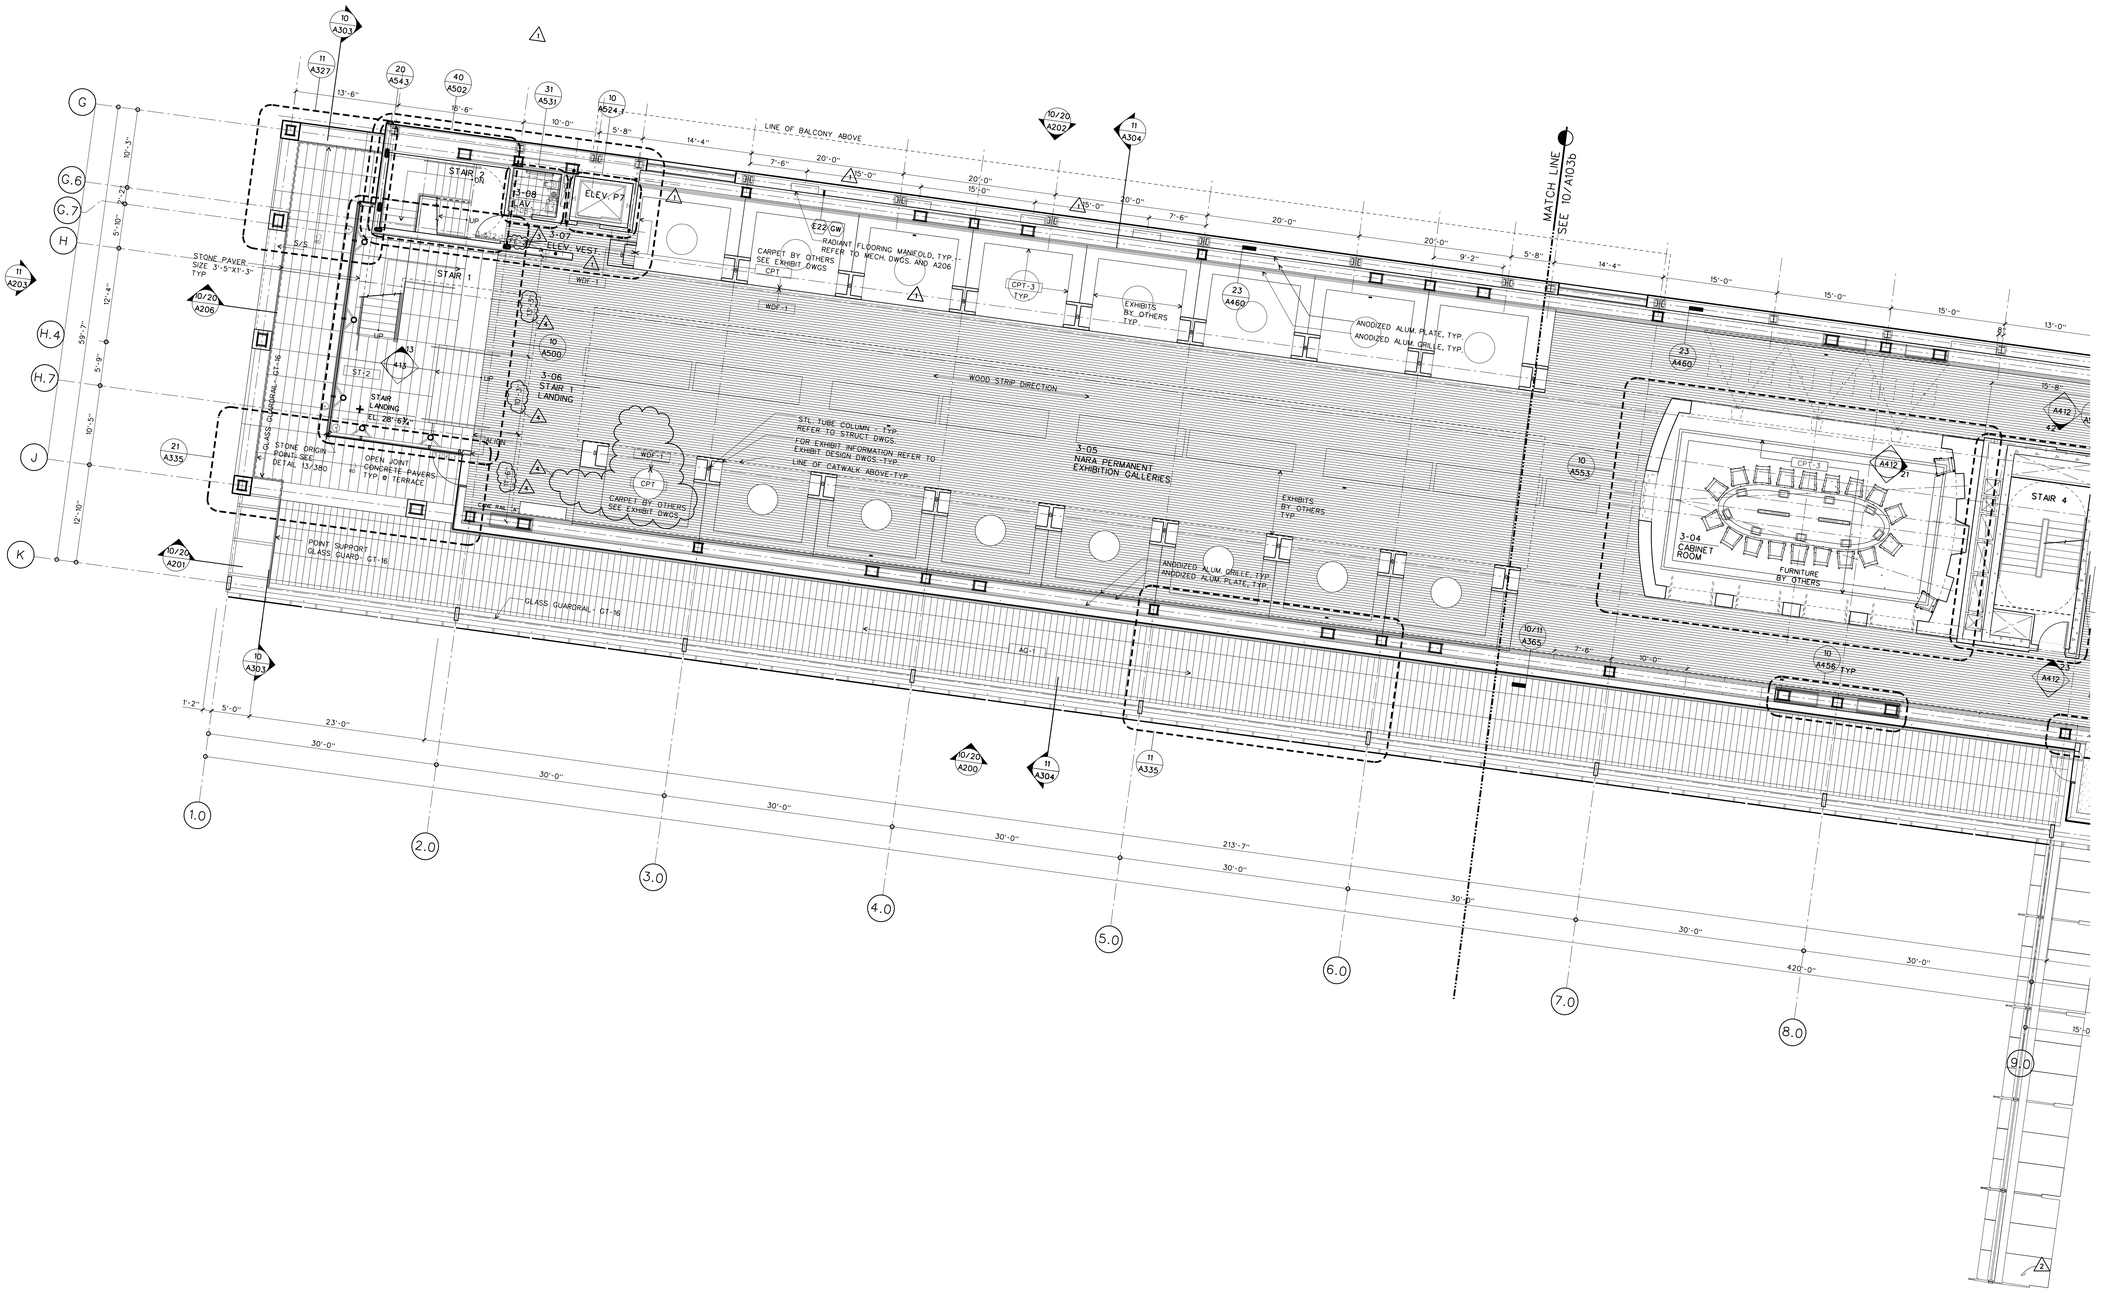

MUSEUM LOWER LEVEL FLOOR PLAN A

SCALE: 1/8" = 1'-0"

AFP-03.DGN 10

FOR OFFICIAL USE ONLY

WILLIAM J. CLINTON PRESIDENTIAL CENTER

LITTLE ROCK, ARKANSAS

Architect

POLSHEK PARTNERSHIP LLP
320 West 13th Street
New York, New York 10014
212.807.7171

Coordinating Architects

POLK STANLEY YEARY ARCHITECTS Ltd
700 South Schiller Street
Little Rock, Arkansas 72201
501.378.0878

WITSELL EVANS RASCO
901 West Third Street
Little Rock, Arkansas 72201
501.374.5300

WOODS CARADINE ARCHITECTS
2200 South Main Street
Little Rock, Arkansas 72206
501.374.4060

Landscape Architects

HARGREAVES ASSOCIATES
118 Magazine Street
Cambridge, Massachusettes 02139
617.661.0070

LANDSCAPE ARCHITECTURE, Inc.
2300 Cottondale Lane Suite 202
Little Rock, Arkansas 72202
501.374.5610

Structural Engineer

LESLIE E. ROBERTSON ASSOC., RLLP
30 Broad Street, 47th Floor
New York, New York 10004
212.750.9000

MEP Engineers

FLACK + KURTZ Inc.
475 Fifth Avenue
New York, New York 10017
212.532.9600

CROMWELL ARCHITECTS ENGINEERS
101 South Spring Street
Little Rock, Arkansas 72201
501.372.2900

Curtainwall Consultant

R. A. HEINTGES ARCHITECTS
126 Fifth Avenue, 9th Floor
New York, New York 10011
212.652-2966

Seal

Issue	Date
4 ASI #24	10/24/03
3 ASI #23	09/12/03
2 ASI #20	06/06/03
1 Addendum #2	11/15/02
100% Construction Documents	09/27/02
90% Progress Printing	08/30/02
100% Struct./ CD Progress	07/01/02
100% Steel & Concrete CD	05/15/02
& Architectural CD Progress	
100% Design Development	03/01/02


Job No. 9908

Scale 1/8" = 1'-0"

Date September 27, 2002

Title
MUSEUM
LOWER LEVEL
PARTIAL PLAN

Sheet No.
A103a

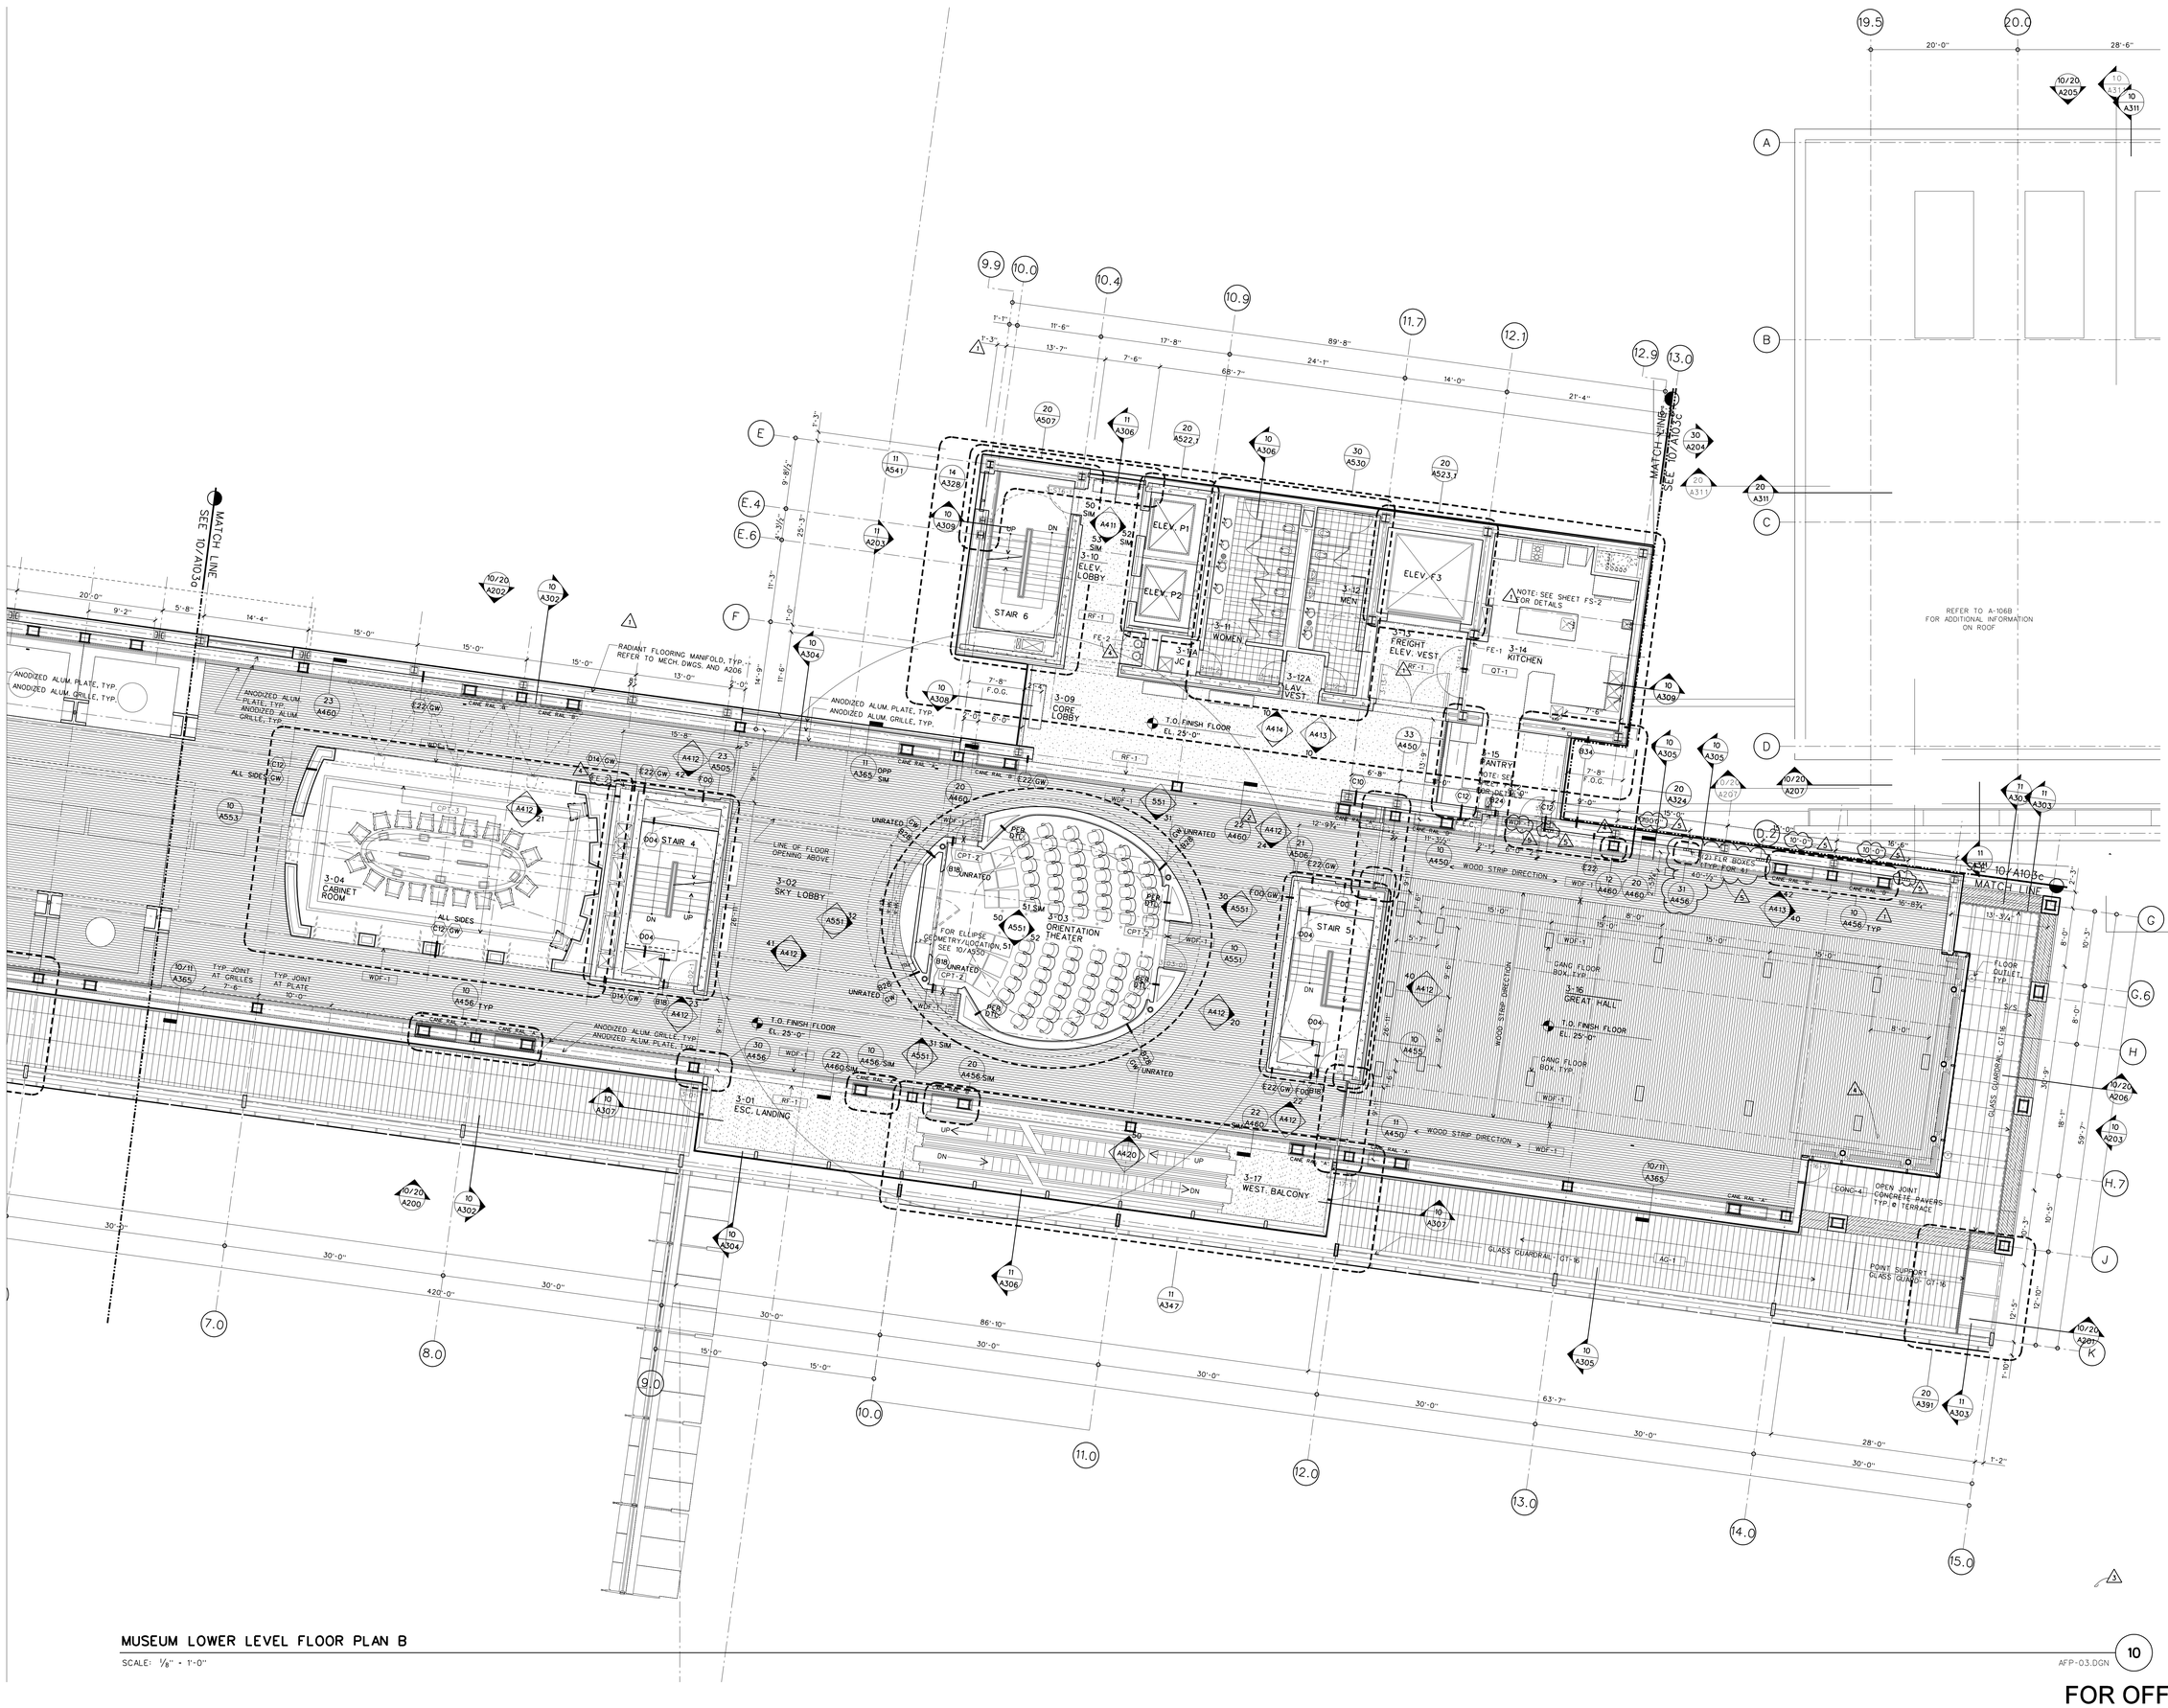

MUSEUM LOWER LEVEL FLOOR PLAN B

SCALE: 1/8" = 1'-0"

AFP-03.DGN

10

WILLIAM J. CLINTON PRESIDENTIAL CENTER

LITTLE ROCK, ARKANSAS

Architect

POLSHEK PARTNERSHIP LLP
320 West 13th Street
New York, New York 10014
212.807.7171

Coordinating Architects

POLK STANLEY YEARY ARCHITECTS Ltd
700 South Schiller Street
Little Rock, Arkansas 72201
501.378.0878

WITSELL EVANS RASCO
901 West Third Street
Little Rock, Arkansas 72201
501.374.5300

WOODS CARADINE ARCHITECTS
2200 South Main Street
Little Rock, Arkansas 72206
501.374.4060

Landscape Architects

HARGREAVES ASSOCIATES
118 Magazine Street
Cambridge, Massachusettes 02139
617.661.0070

LANDSCAPE ARCHITECTURE, Inc.
2300 Cottondale Lane Suite 202
Little Rock, Arkansas 72202
501.374.5610

Structural Engineer

LESLIE E. ROBERTSON ASSOC., RLLP
30 Broad Street, 47th Floor
New York, New York 10004
212.750.9000

MEP Engineers

FLACK + KURTZ Inc.
475 Fifth Avenue
New York, New York 10017
212.532.9600

CROMWELL ARCHITECTS ENGINEERS
101 South Spring Street
Little Rock, Arkansas 72201
501.372.2900

Curtainwall Consultant

R. A. HEINTGES ARCHITECTS
126 Fifth Avenue, 9th Floor
New York, New York 10011
212.852-2966

Seal

2	ASI #24	10/24/03
1	ASI #23	09/12/03
3	ASI #20	06/06/03
2	ASI #	01/08/02
1	Addendum #2	11/15/02
	100% Construction Documents	09/27/02
	90% Progress Printing	08/30/02
	100% Struct./ CD Progress	07/01/02
	100% Steel & Concrete CD & Architectural CD Progress	05/15/02
	100% Design Development	03/01/02
	Issue	Date

Job No. 9908


Scale 1/8" = 1'-0"

Date September 27, 2002

Title
MUSEUM
LOWER LEVEL
PARTIAL PLAN

Sheet No.
A103b

FOR OFFICIAL USE ONLY

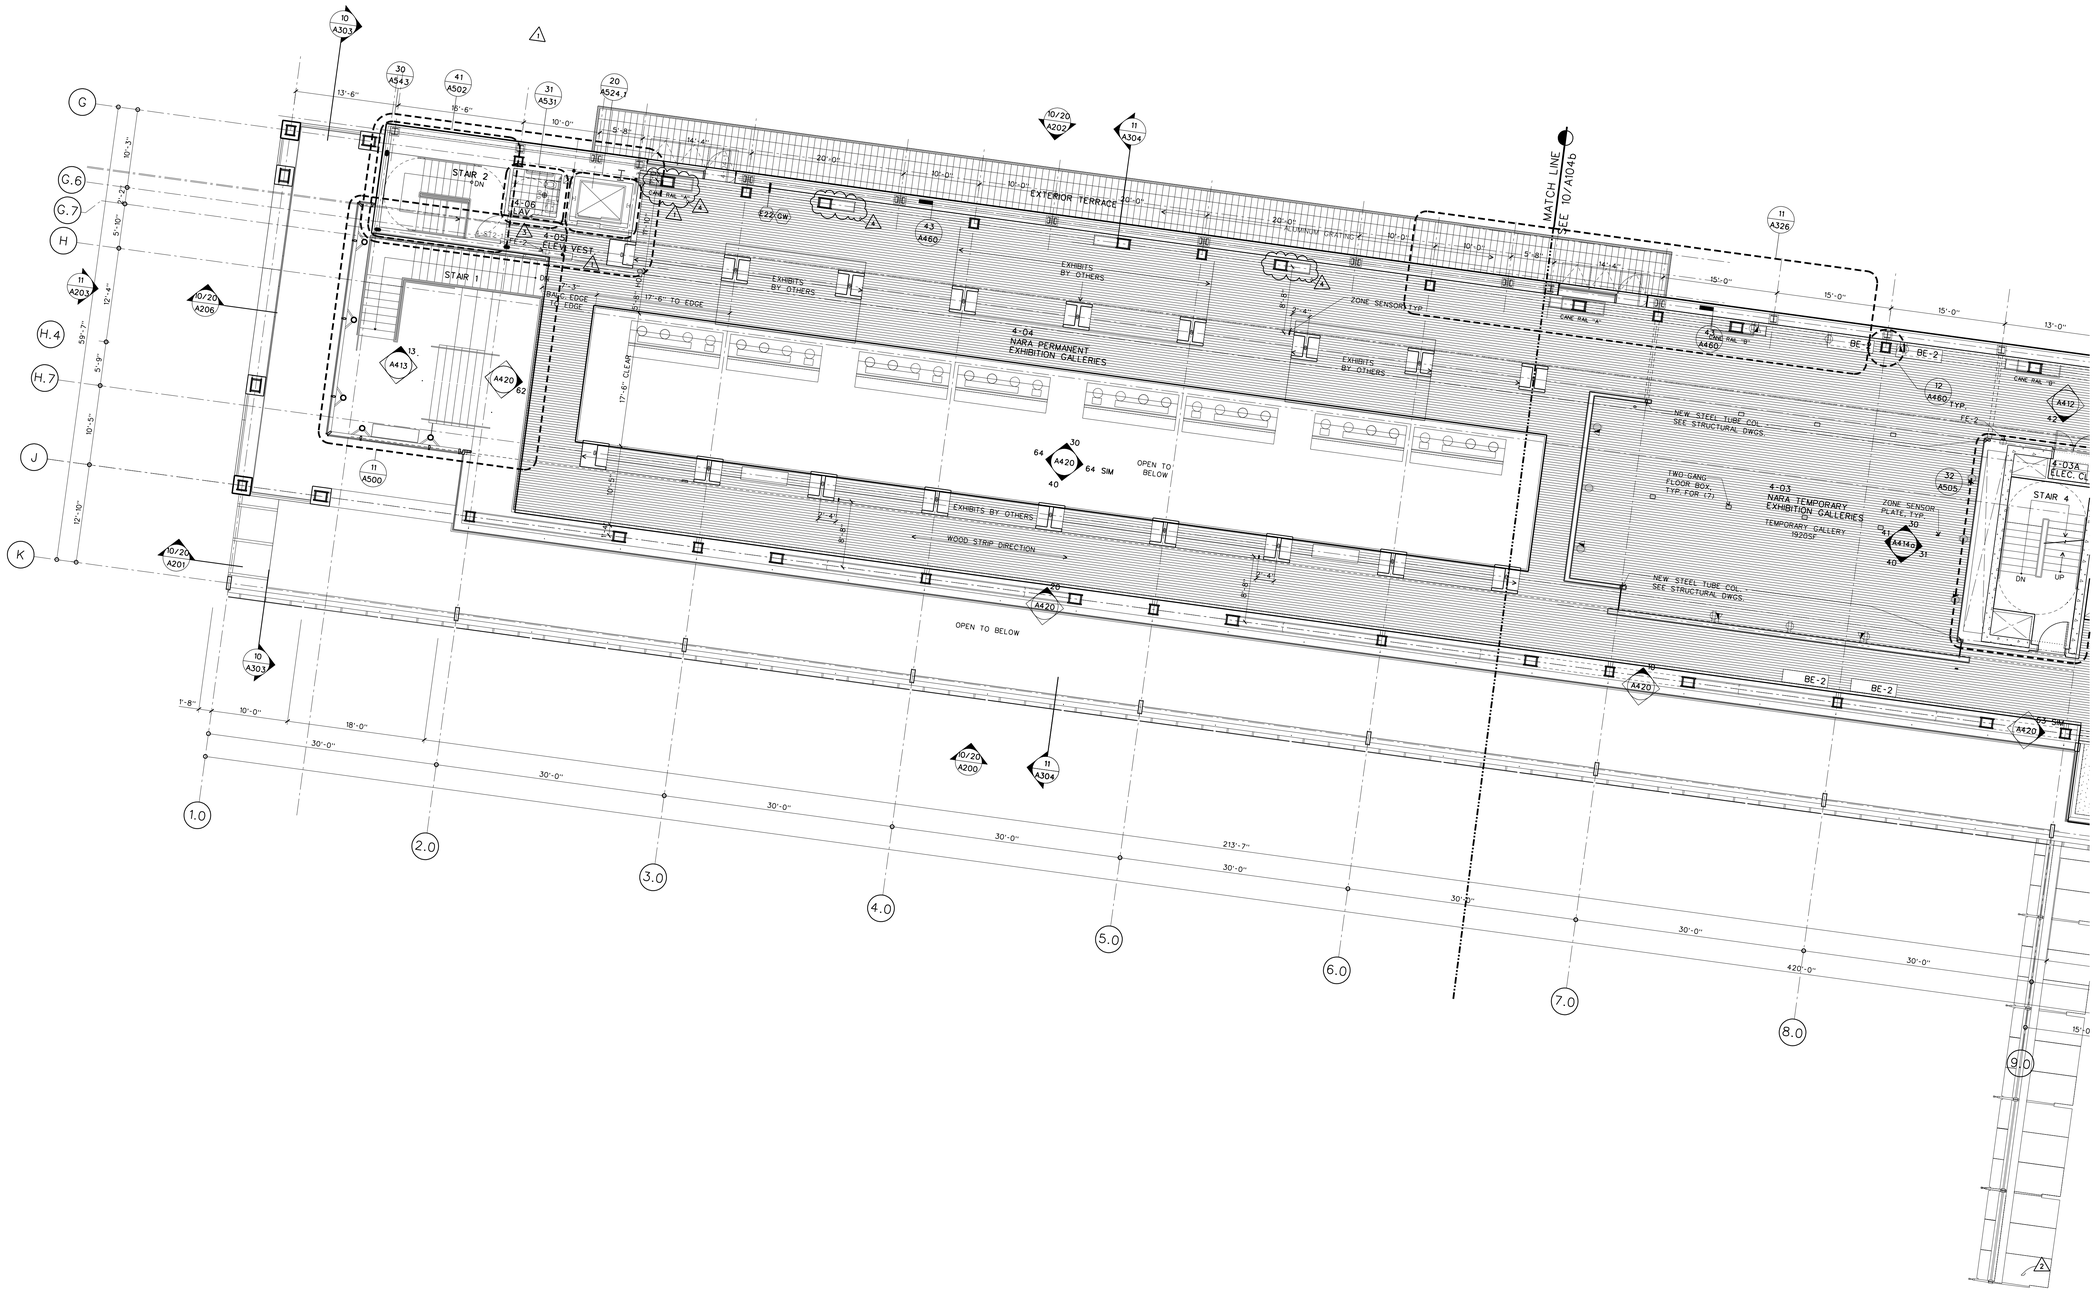

MUSEUM UPPER LEVEL FLOOR PLAN A

SCALE: 1/8" = 1'-0"

AFP-04.DGN

10

WILLIAM J. CLINTON PRESIDENTIAL CENTER

LITTLE ROCK, ARKANSAS

Architect

POLSHEK PARTNERSHIP LLP
320 West 13th Street
New York, New York 10014
212.807.7171

Coordinating Architects

POLK STANLEY YEARY ARCHITECTS Ltd
700 South Schiller Street
Little Rock, Arkansas 72201
501.378.0878

WITSELL EVANS RASCO
901 West Third Street
Little Rock, Arkansas 72201
501.374.5300

WOODS CARADINE ARCHITECTS
2200 South Main Street
Little Rock, Arkansas 72206
501.374.4060

Landscape Architects

HARGREAVES ASSOCIATES
118 Magazine Street
Cambridge, Massachusettes 02139
617.661.0070

LANDSCAPE ARCHITECTURE, Inc.
2300 Cottondale Lane Suite 202
Little Rock, Arkansas 72202
501.374.5610

Structural Engineer

LESLIE E. ROBERTSON ASSOC., RLLP
30 Broad Street, 47th Floor
New York, New York 10004
212.750.9000

MEP Engineers

FLACK + KURTZ Inc.
475 Fifth Avenue
New York, New York 10017
212.532.9600

CROMWELL ARCHITECTS ENGINEERS
101 South Spring Street
Little Rock, Arkansas 72201
501.372.2900

Curtainwall Consultant

R. A. HEINTGES ARCHITECTS
126 Fifth Avenue, 9th Floor
New York, New York 10011
212.652-2966

Seal

	Issue	Date
4	ASI #24	10/24/03
3	ASI #23	09/12/03
2	ASI #20	06/06/03
1	Addendum #2	11/15/02
	100% Construction Documents	09/27/02
	90% Progress Printing	08/30/02
	100% Struct./ CD Progress	07/01/02
	100% Steel & Concrete CD	05/15/02
	& Architectural CD Progress	
	100% Design Development	03/01/02

Job No. 9908

Scale 1/8" = 1'-0"

Date September 27, 2002


Title

MUSEUM
UPPER LEVEL
PARTIAL PLAN

Sheet No.

A104a

FOR OFFICIAL USE ONLY

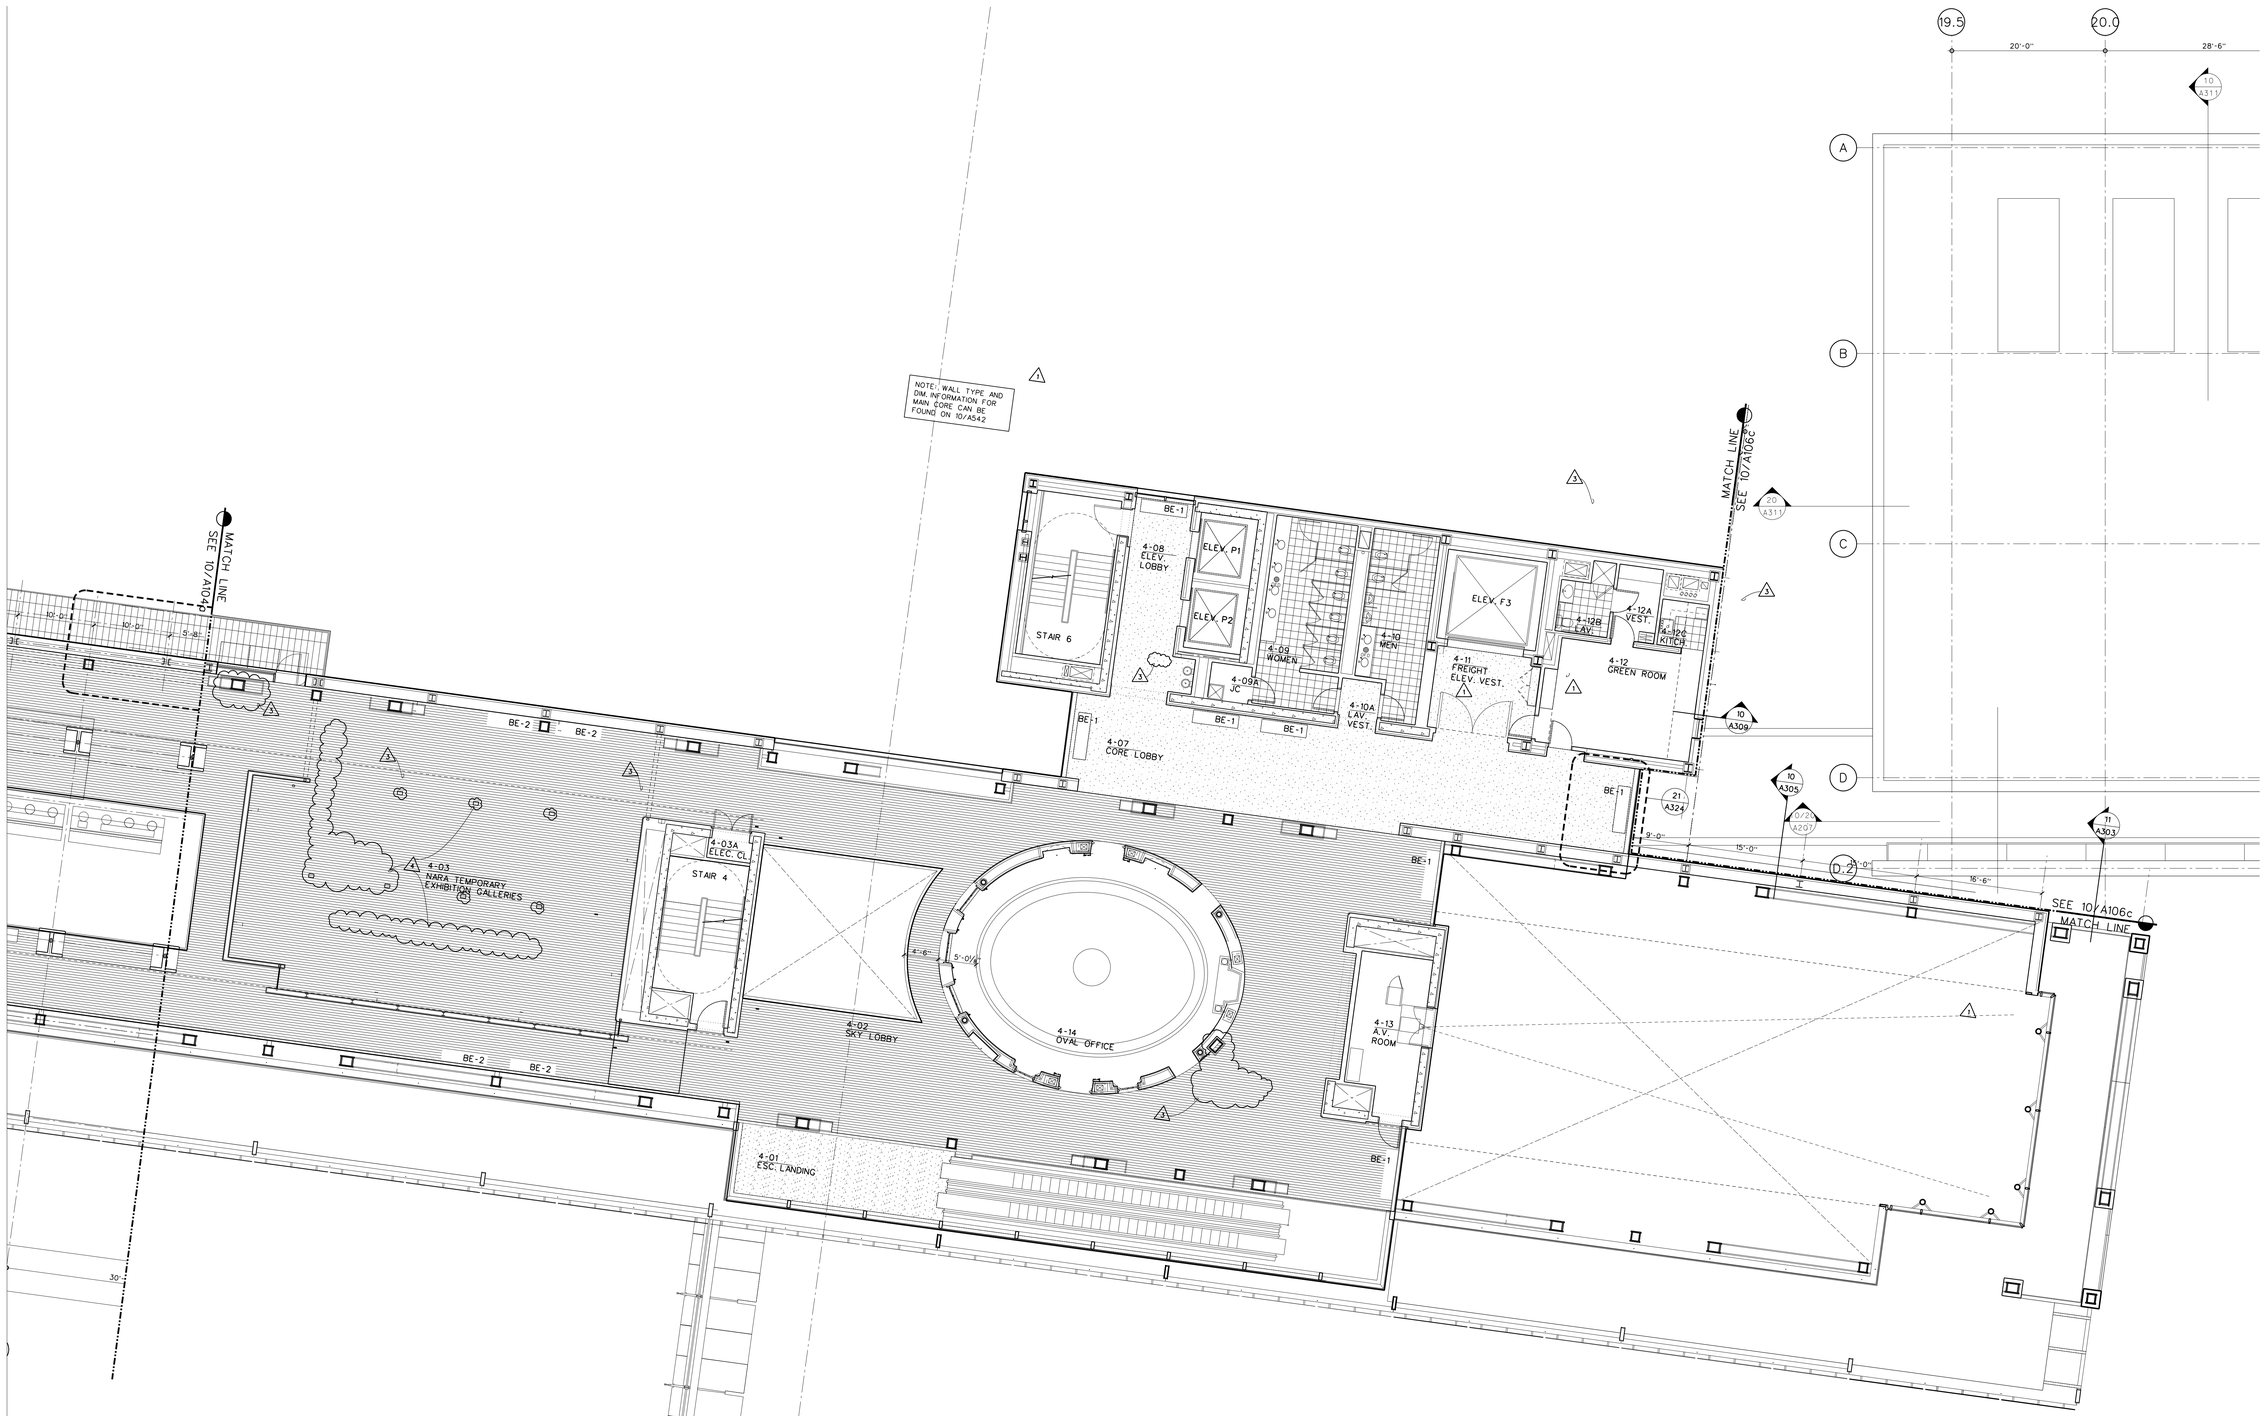

MUSEUM UPPER LEVEL FLOOR PLAN B

SCALE: 1/8" = 1'-0"

AFP-04.DGN

10

FOR OFFICIAL USE ONLY

WILLIAM J. CLINTON PRESIDENTIAL CENTER

LITTLE ROCK, ARKANSAS

Architect

POLSHEK PARTNERSHIP LLP
320 West 13th Street
New York, New York 10014
212.807.7171

Coordinating Architects

POLK STANLEY YEARY ARCHITECTS Ltd
700 South Schiller Street
Little Rock, Arkansas 72201
501.378.0878

WITSELL EVANS RASCO
901 West Third Street
Little Rock, Arkansas 72201
501.374.5300

WOODS CARADINE ARCHITECTS
2200 South Main Street
Little Rock, Arkansas 72206
501.374.4060

Landscape Architects

HARGREAVES ASSOCIATES
118 Magazine Street
Cambridge, Massachusettes 02139
617.661.0070

LANDSCAPE ARCHITECTURE, Inc.
2300 Cottondale Lane Suite 202
Little Rock, Arkansas 72202
501.374.5610

Structural Engineer

LESLIE E. ROBERTSON ASSOC., RLLP
30 Bread Street, 47th Floor
New York, New York 10004
212.750.9000

MEP Engineers

FLACK + KURTZ Inc.
475 Fifth Avenue
New York, New York 10017
212.532.9600

CROMWELL ARCHITECTS ENGINEERS
101 South Spring Street
Little Rock, Arkansas 72201
501.372.2900

Curtainwall Consultant

R. A. HEINTGES ARCHITECTS
126 Fifth Avenue, 9th Floor
New York, New York 10011
212.852-2966

Seal

	Issue	Date
4	ASI #24	10/24/03
3	ASI #23	09/12/03
2	ASI #20	08/06/03
1	Addendum #2	11/15/02
	100% Construction Documents	09/27/02
	90% Progress Printing	08/30/02
	100% Struct./ CD Progress	07/01/02
	100% Steel & Concrete CD & Architectural CD Progress	05/15/02
	100% Design Development	03/01/02


Job No.
9908

Scale
1/8" = 1'-0"

Date
September 27, 2002

Title
MUSEUM
UPPER LEVEL
PARTIAL PLAN

Sheet No.
A104b

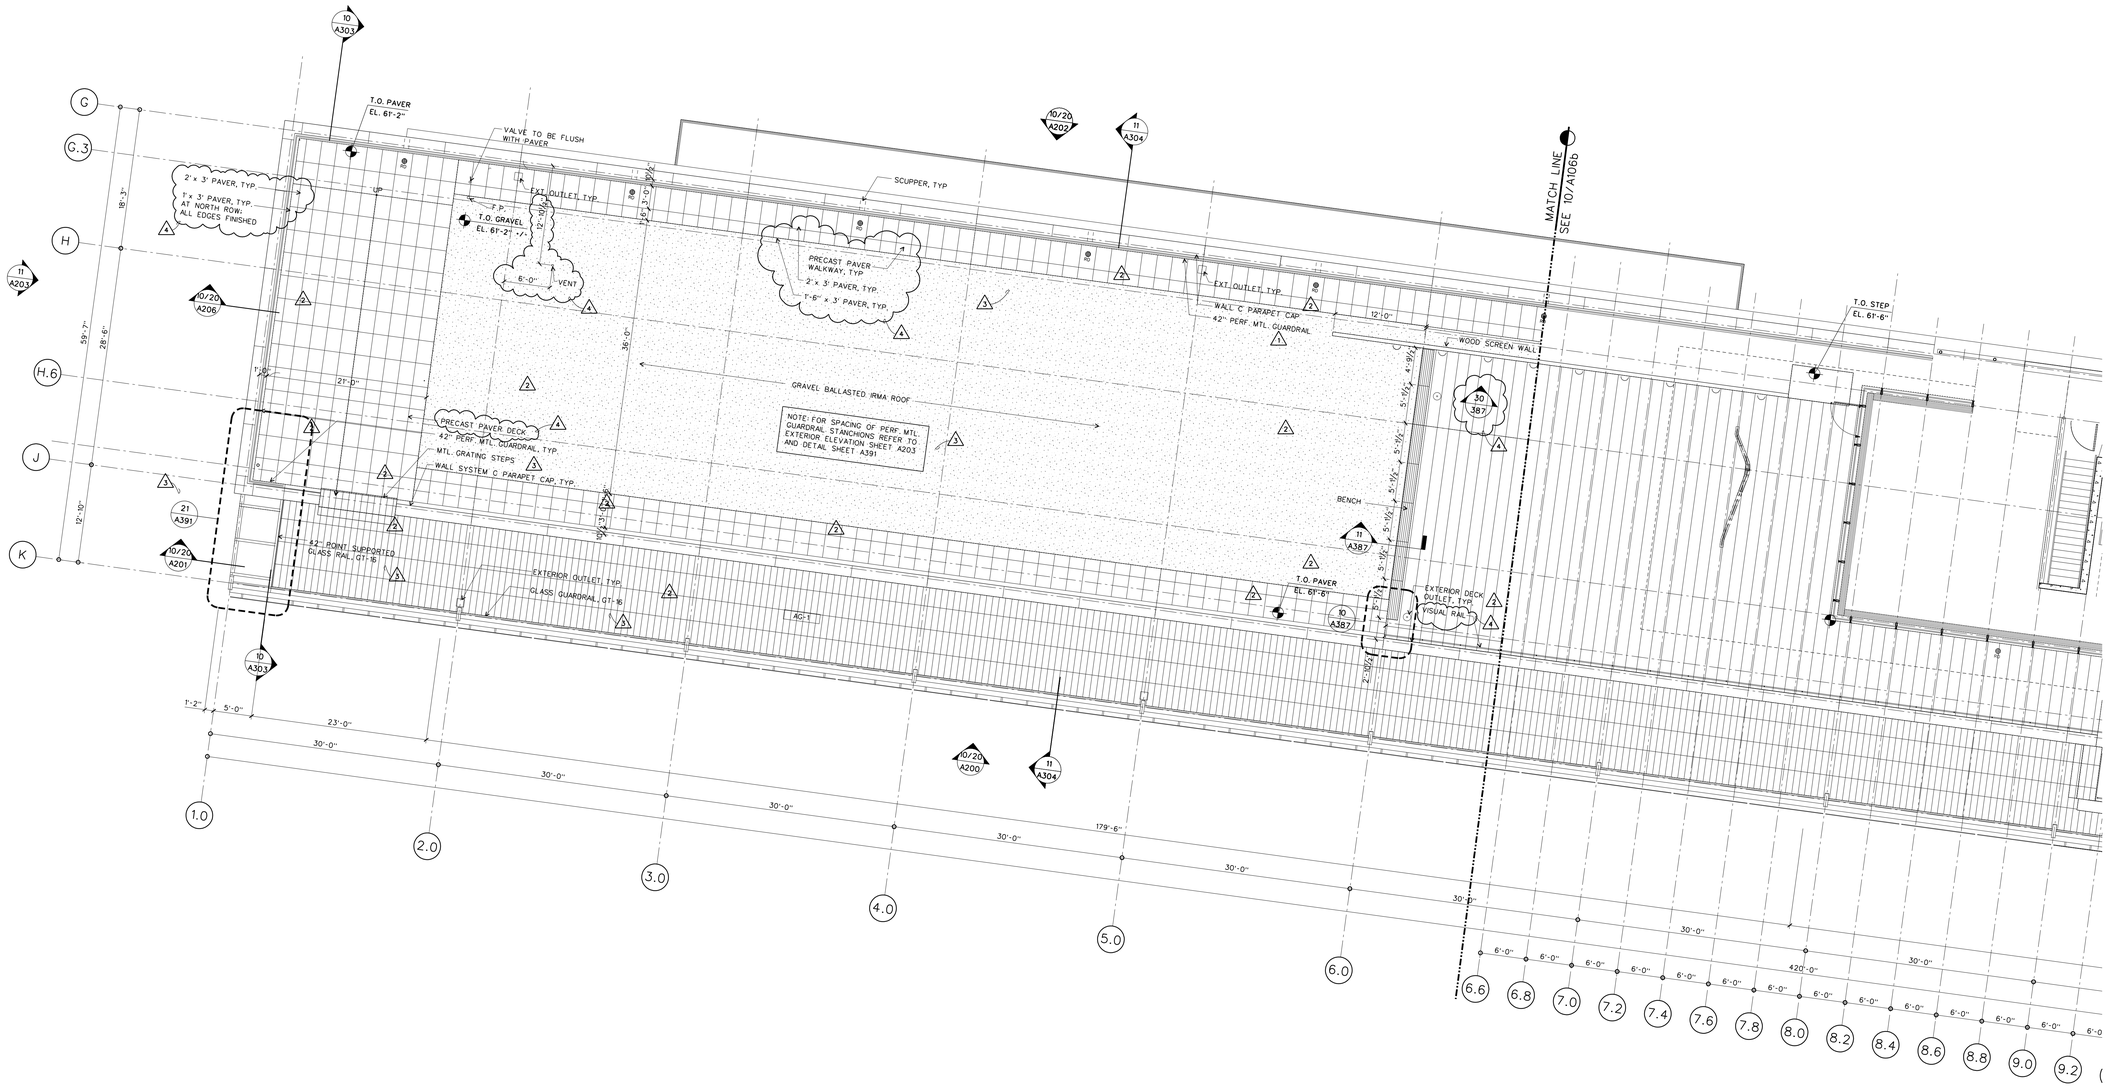

ROOF PLAN A

SCALE: 1/8" = 1'-0"

AFP-05.DGN

10

WILLIAM J. CLINTON PRESIDENTIAL CENTER

LITTLE ROCK, ARKANSAS

Architect

POLSHEK PARTNERSHIP LLP
320 West 13th Street
New York, New York 10014
212.807.7171

Coordinating Architects

POLK STANLEY YEARY ARCHITECTS Ltd
700 South Schiller Street
Little Rock, Arkansas 72201
501.378.0878

WITSELL EVANS RASCO
901 West Third Street
Little Rock, Arkansas 72201
501.374.5300

WOODS CARADINE ARCHITECTS
2200 South Main Street
Little Rock, Arkansas 72206
501.374.4060

Landscape Architects

HARGREAVES ASSOCIATES
118 Magazine Street
Cambridge, Massachusettes 02139
617.661.0070

LANDSCAPE ARCHITECTURE, Inc.
2300 Cottondale Lane Suite 202
Little Rock, Arkansas 72202
501.374.5610

Structural Engineer

LESLIE E. ROBERTSON ASSOC., RLLP
30 Broad Street, 47th Floor
New York, New York 10004
212.750.9000

MEP Engineers

FLACK + KURTZ Inc.
475 Fifth Avenue
New York, New York 10017
212.532.9600

CROMWELL ARCHITECTS ENGINEERS
101 South Spring Street
Little Rock, Arkansas 72201
501.372.2900

Curtainwall Consultant

R. A. HEINTGES ARCHITECTS
126 Fifth Avenue, 9th Floor
New York, New York 10011
212.652-2966

Seal

	Issue	Date
4	ASI #36	06/25/04
3	ASI #20	05/30/03
2	ASI #18	04/18/03
1	Addendum #2	11/15/02
	100% Construction Documents	09/27/02
	90% Progress Printing	08/30/02
	100% Struct./ CD Progress	07/01/02
	100% Steel & Concrete CD & Architectural CD Progress	05/15/02
	100% Design Development	03/01/02

Job No. 9908

Scale 1/8" = 1'-0"

Date September 27, 2002

Title

EXECUTIVE LEVEL PARTIAL PLAN

Sheet No.

A105a

FOR OFFICIAL USE ONLY

9.9 | 10.0 | 22 A507 | 10.4 | 11 A306 | 20 A522.1 | 10.9 | 10 A306 | 11.7 | 11.7

E | E.4 | E.6 | F

1'-3" | 9'-8½" | 4'-3½" | 24'-9" | 11'-3" | 1'-0" | 12'-0" | 14'-9"

14 A328 | 10 A309 | 11 A203 | 10 A302 | 10/20 A202 | 10 A304 | 23 A324 | 20 A203 | 10 A308 | 20 A327 | 22 A507 | 12 A324 | 11 A325

5-ST6-1 | UP | DN | STAIR 6 | ELEV. P1 | ELEV. P2 | T.O. FINISH FLOOR EL. 62'-1" | 5-01 ELEV. LOBBY | 5-01-1 | 5-02 CORRIDOR | 5-02-1 | F00 | 5-04 COAT RM | 5-04-1 | 1-50-1 | 5-20 LAV. | OFD | 5-05 STORAGE | 5-03 ELCT. CL | 5102-2 | 5-05-1 | 5-05 MECHANICAL ROOM | 5-07 LAV. | 5-07-1 | 5-08 FOYER | 7'-8" F.O.G. | 5-07 | 5-06 SECRET SERVICE | CPT-1A | 5-09 LAV. | DEMONSTRATION GREEN ROOF | RD | SCUPPER TYP.

T.O. STEP EL. 61'-6" | '-0" | ST-4 | WD | OVAL | 5-10 GALLERY | ALIGN F.O.G. | 12'-0" | 10'-0" | 8'-0" | 11'-9¼" | 10'-2¾" | 10'-0" | 10'-2¾" | 5'-9¼" | 4'-0" | 10'-0" | 24'-0" | 2¾" | 6" | 5'-2" | 5'-8" | 1'-2" | 11'-4"

FE-3 | B10 | ST4-1 | DR-NMBR | 3'-4" | 2'-11¼" | 4'-2½" | 2'-7" | 2'-11¼" | 19'-2" | DN | STAIR 4 | 5-17 KITCHEN | E10 | B12 | 3'-0" | A505 | B22 | 7¼" | 12'-9" VIF | 3'-4" | 2'-11¼" | 6'-10½" | T.O. FINISH FLOOR EL. 62'-1"

LINE OF CEILING ABOVE | 8'-0" | 5-16 LIBRARY | F3 | F2 | F1 | 2'-5" | 6'-0" | 15'-10" | 1'-0" | 5½" | 2'-1½" | SKYLIGHT ABOVE | FOR ELLIPSE GEOMETRY/ LOCATION, SEE 10/A550 | 5-16-5 | 5-16-3

5-12 BATH | 5-12-1 | 5-11 BEDROOM 2 | 5-15 BATH | 5-12-2 | 1'-4" | B12 | 6'-3" | 4'-0" | 4'-10" | 10'-0" | 6" | 5-14 BEDROOM 1 | 5-14-1 | L73 TYP. FOR | CANOPY SUPPORT | WD DECK | EXTERIOR DECK OUTLET, TYP

5-19 LIVING ROOM

5-18 DINING ROOM

LINE OF CANOPY ABOVE

WDF-3

VISUAL RAIL; REFER TO 24/A387 FOR ELEVATION, TYP. 80'-0" (5'-0" BAYS)

VISUAL RAIL; REFER TO 24/A387 FOR ELEVATION, TYP. 35'-0" (5'-0" BAYS)

T.O. FINISH FLOOR EL. 62'-1"

10 A302 | 10/20 200 | 10 A304 | 11 A306 | 11 A325

WILLIAM J. CLINTON PRESIDENTIAL CENTER

LITTLE ROCK, ARKANSAS

Architect

POLSHEK PARTNERSHIP LLP
320 West 13th Street
New York, New York 10014
212.807.7171

Coordinating Architects

POLK STANLEY YEARY ARCHITECTS Ltd
700 South Schiller Street
Little Rock, Arkansas 72201
501.378.0878

WITSELL EVANS RASCO
901 West Third Street
Little Rock, Arkansas 72201
501.374.5300

WOODS CARADINE ARCHITECTS
2200 South Main Street
Little Rock, Arkansas 72206
501.374.4060

Landscape Architects

HARGREAVES ASSOCIATES
118 Magazine Street
Cambridge, Massachusettes 02139
617.661.0070

LANDSCAPE ARCHITECTURE, Inc.
2300 Cottondale Lane Suite 202
Little Rock, Arkansas 72202
501.374.5610

Structural Engineer

LESLIE E. ROBERTSON ASSOC., RLLP
30 Broad Street, 47th Floor
New York, New York 10004
212.750.9000

MEP Engineers

FLACK + KURTZ Inc.
475 Fifth Avenue
New York, New York 10017
212.532.9600

CROMWELL ARCHITECTS ENGINEERS
101 South Spring Street
Little Rock, Arkansas 72201
501.372.2900

Curtainwall Consultant

R. A. HEINTGES ARCHITECTS
126 Fifth Avenue, 9th Floor
New York, New York 10011
212.652-2966

Seal

Issue | Date

Job No. 9908

Scale 1/4" = 1'-0"

Date September 27, 2002


Title

EXECUTIV LEVEL PATIAL PLAN

Sheet No.

A105c

FOR OFFICIAL USE ONLY

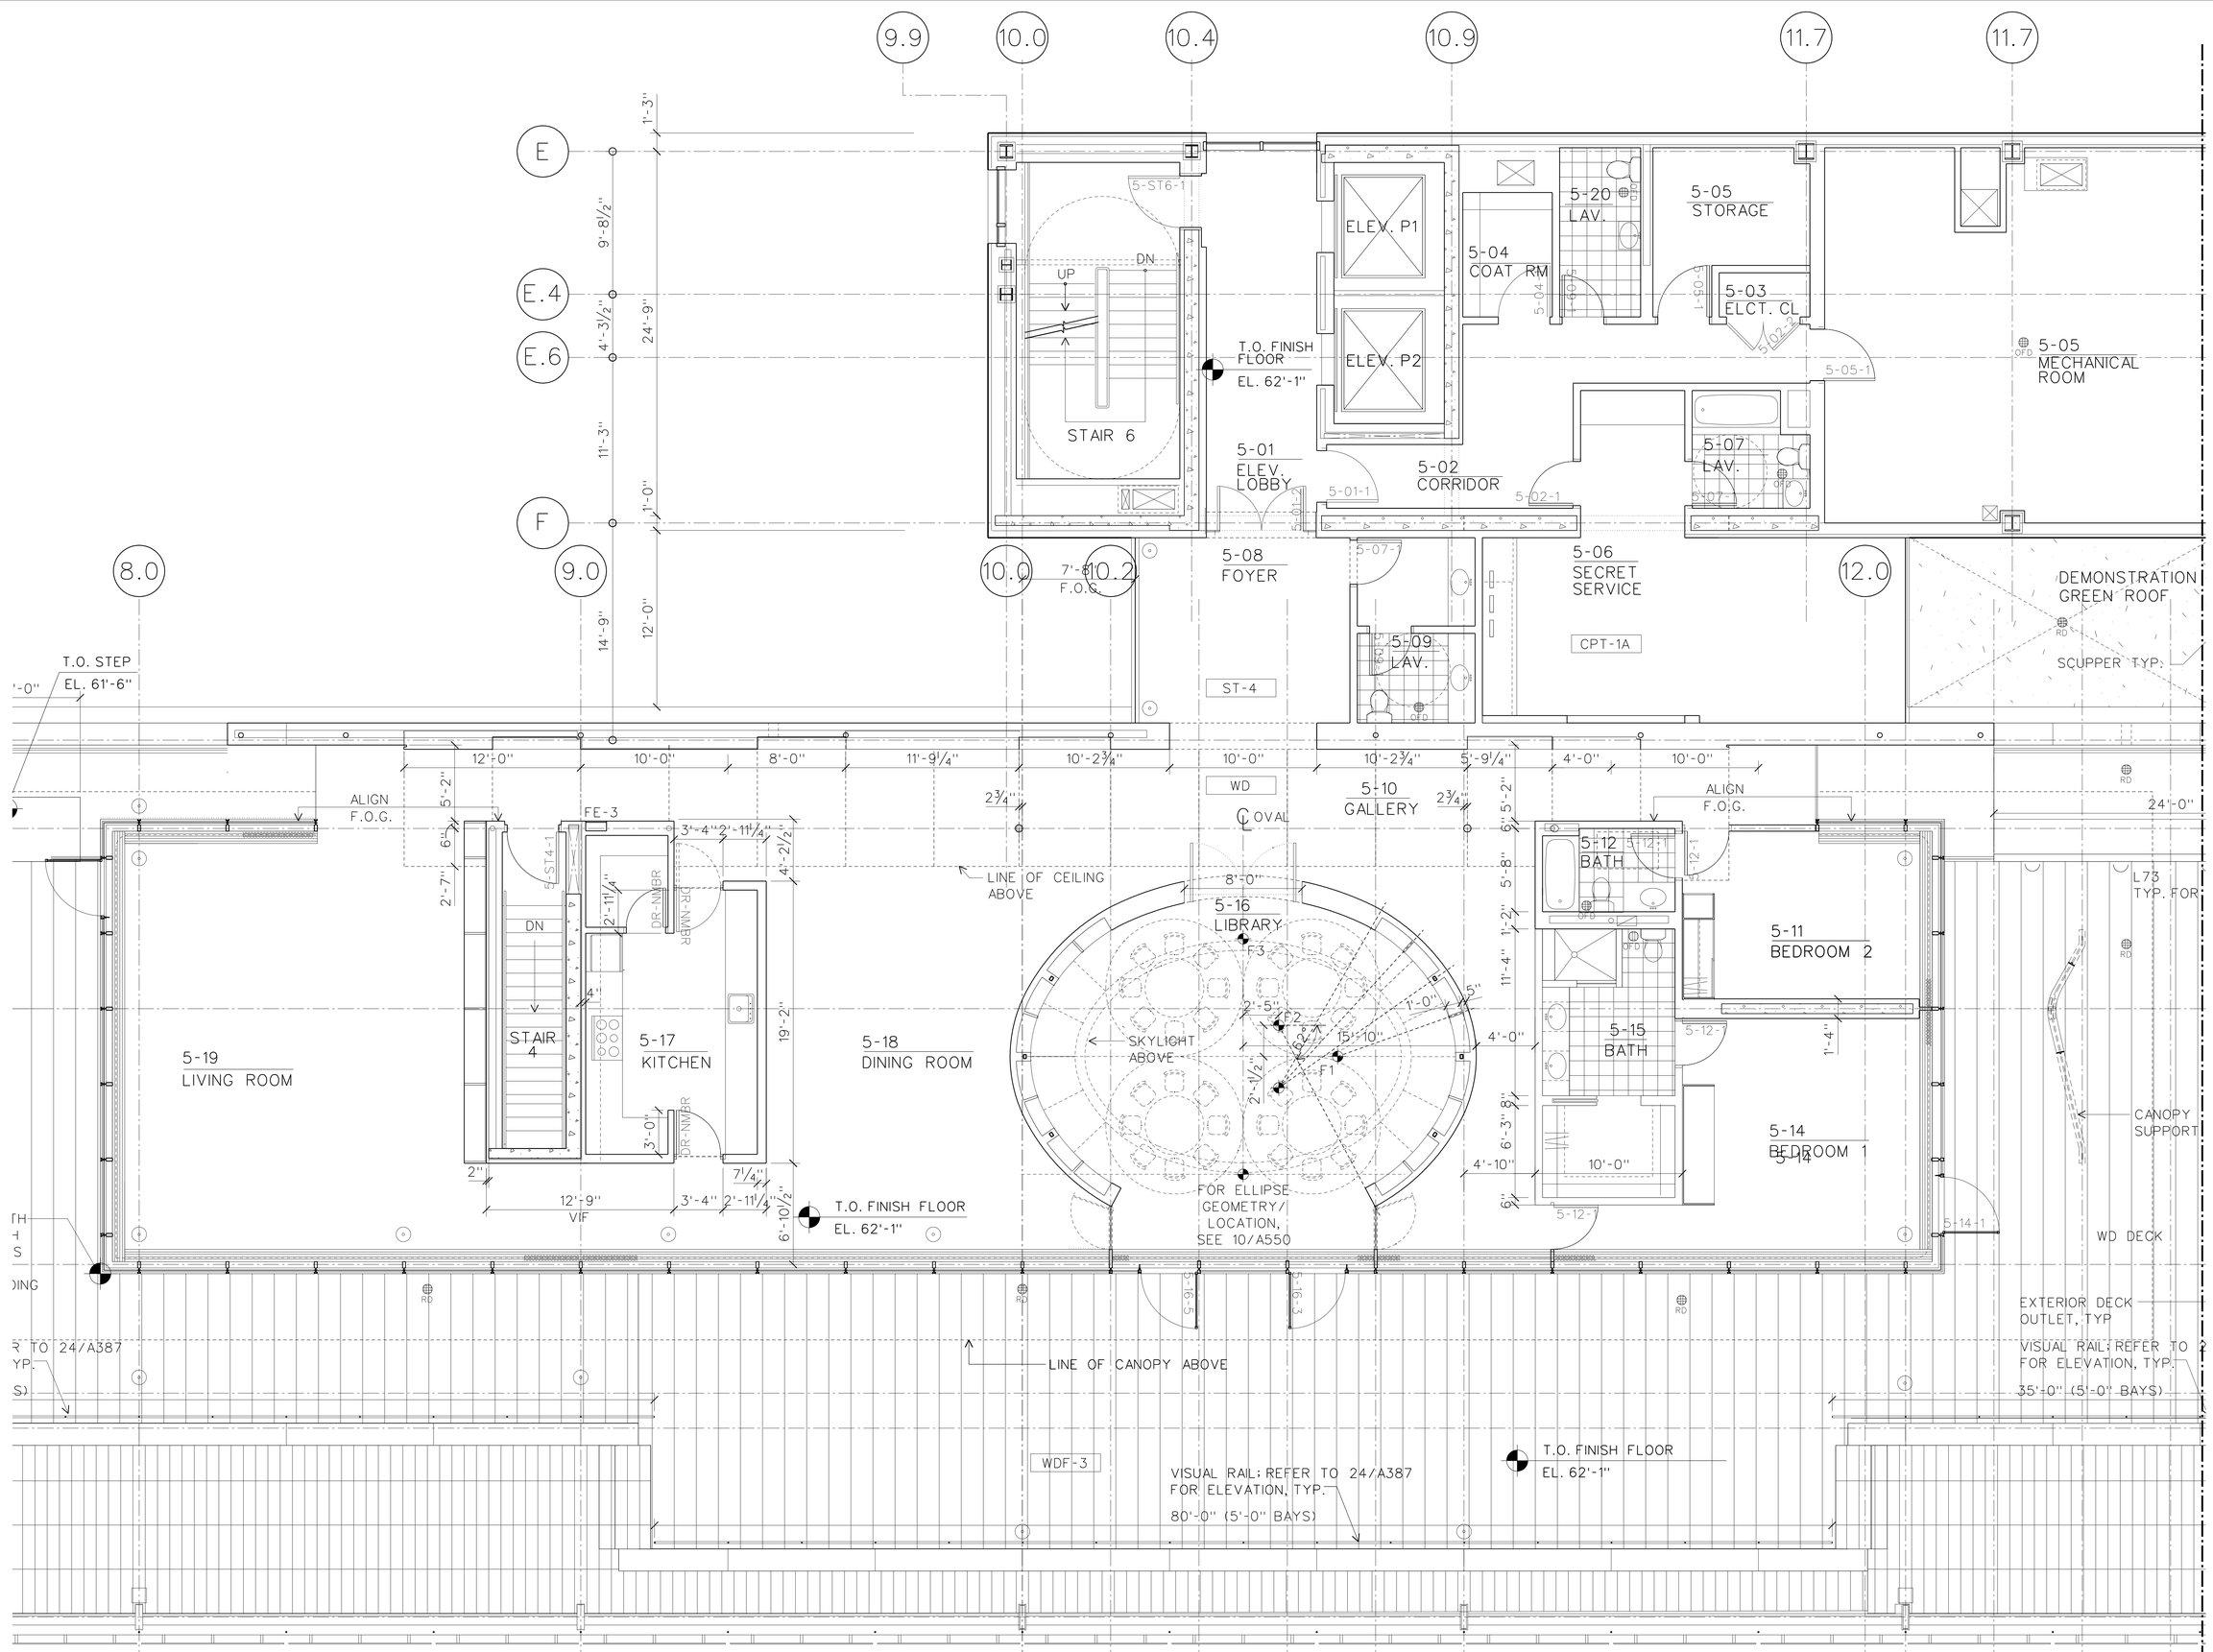

WILLIAM J. CLINTON PRESIDENTIAL CENTER

LITTLE ROCK, ARKANSAS

Architect

POLSHEK PARTNERSHIP LLP
320 West 13th Street
New York, New York 10014
212.807.7171

Coordinating Architects

POLK STANLEY YEARY ARCHITECTS Ltd
700 South Schiller Street
Little Rock, Arkansas 72201
501.378.0878

WITSELL EVANS RASCO
901 West Third Street
Little Rock, Arkansas 72201
501.374.5300

WOODS CARADINE ARCHITECTS
2200 South Main Street
Little Rock, Arkansas 72206
501.374.4060

Landscape Architects

HARGREAVES ASSOCIATES
118 Magazine Street
Cambridge, Massachusettes 02139
617.661.0070

LANDSCAPE ARCHITECTURE, Inc.
2300 Cottondale Lane Suite 202
Little Rock, Arkansas 72202
501.374.5610

Structural Engineer

LESLIE E. ROBERTSON ASSOC., RLLP
30 Broad Street, 47th Floor
New York, New York 10004
212.750.9000

MEP Engineers

FLACK + KURTZ Inc.
475 Fifth Avenue
New York, New York 10017
212.532.9600

CROMWELL ARCHITECTS ENGINEERS
101 South Spring Street
Little Rock, Arkansas 72201
501.372.2900

Curtainwall Consultant

R. A. HEINTGES ARCHITECTS
126 Fifth Avenue, 9th Floor
New York, New York 10011
212.652-2966

Seal

Issue Date

Job No. 9908

Scale 1/4" = 1'-0"

Date September 27, 2002


Title

EXECUTIV LEVEL PATIAL PLAN

Sheet No.

A105c

FOR OFFICIAL USE ONLY

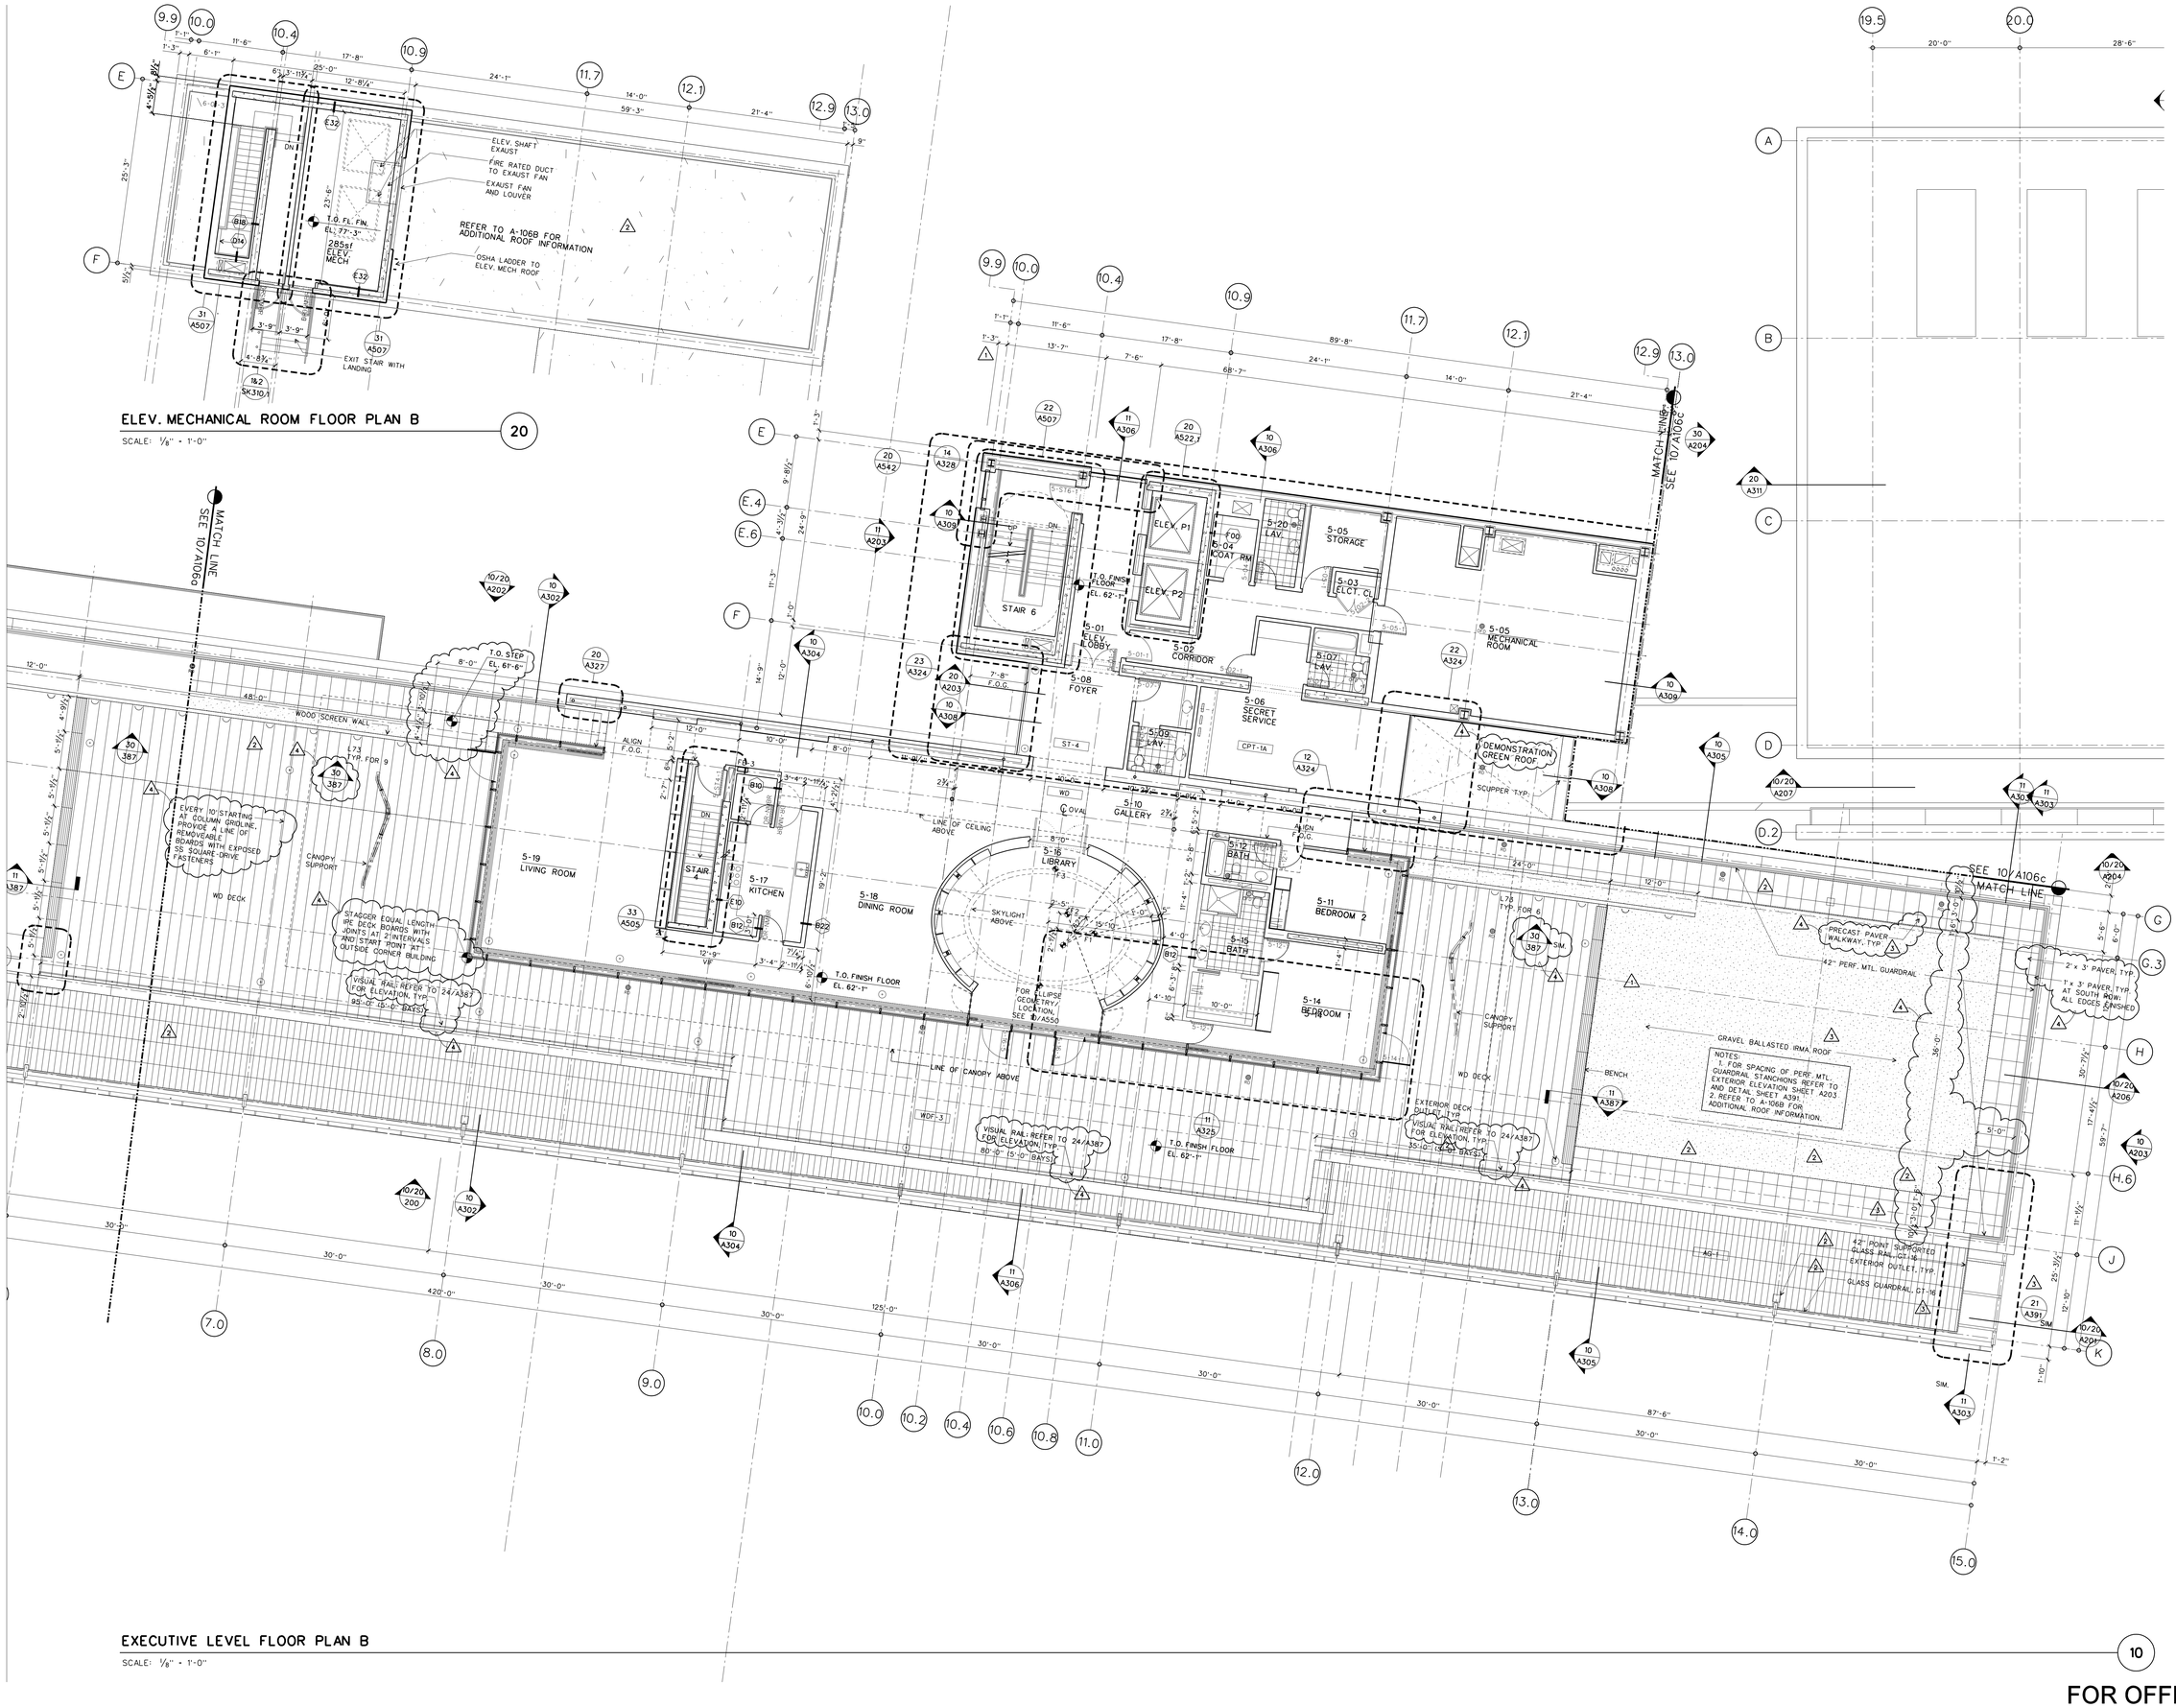

WILLIAM J. CLINTON PRESIDENTIAL CENTER

LITTLE ROCK, ARKANSAS

Architect

POLSHEK PARTNERSHIP LLP
320 West 13th Street
New York, New York 10014
212.807.7171

Coordinating Architects

POLK STANLEY YEARY ARCHITECTS Ltd
700 South Schiller Street
Little Rock, Arkansas 72201
501.378.0878

WITSELL EVANS RASCO
901 West Third Street
Little Rock, Arkansas 72201
501.374.5300

WOODS CARADINE ARCHITECTS
2200 South Main Street
Little Rock, Arkansas 72206
501.374.4060

Landscape Architects

HARGREAVES ASSOCIATES
118 Magazine Street
Cambridge, Massachusettes 02139
617.661.0070

LANDSCAPE ARCHITECTURE, Inc.
2300 Cottondale Lane Suite 202
Little Rock, Arkansas 72202
501.374.5610

Structural Engineer

LESLIE E. ROBERTSON ASSOC., RLLP
30 Broad Street, 47th Floor
New York, New York 10004
212.750.9000

MEP Engineers

FLACK + KURTZ Inc.
475 Fifth Avenue
New York, New York 10017
212.532.9600

CROMWELL ARCHITECTS ENGINEERS
101 South Spring Street
Little Rock, Arkansas 72201
501.372.2900

Curtainwall Consultant

R. A. HEINTGES ARCHITECTS
126 Fifth Avenue, 9th Floor
New York, New York 10011
212.652-2966

Seal

4	ASI #36	06/25/04
3	ASI #20	05/30/03
2	ASI #18	04/18/03
1	Addendum #2	11/15/02
	100% Construction Documents	09/27/02
	90% Progress Printing	08/30/02
	100% Struct./ CD Progress	07/01/02
	100% Steel & Concrete CD	05/15/02
	& Architectural CD Progress	
	100% Design Development	03/01/02
	Issue	Date

Job No. 9908

Scale 1/8" = 1'-0"

Date September 27, 2002


Title

EXECUTIVE LEVEL PARTIAL PLAN

Sheet No.

A105b

FOR OFFICIAL USE ONLY

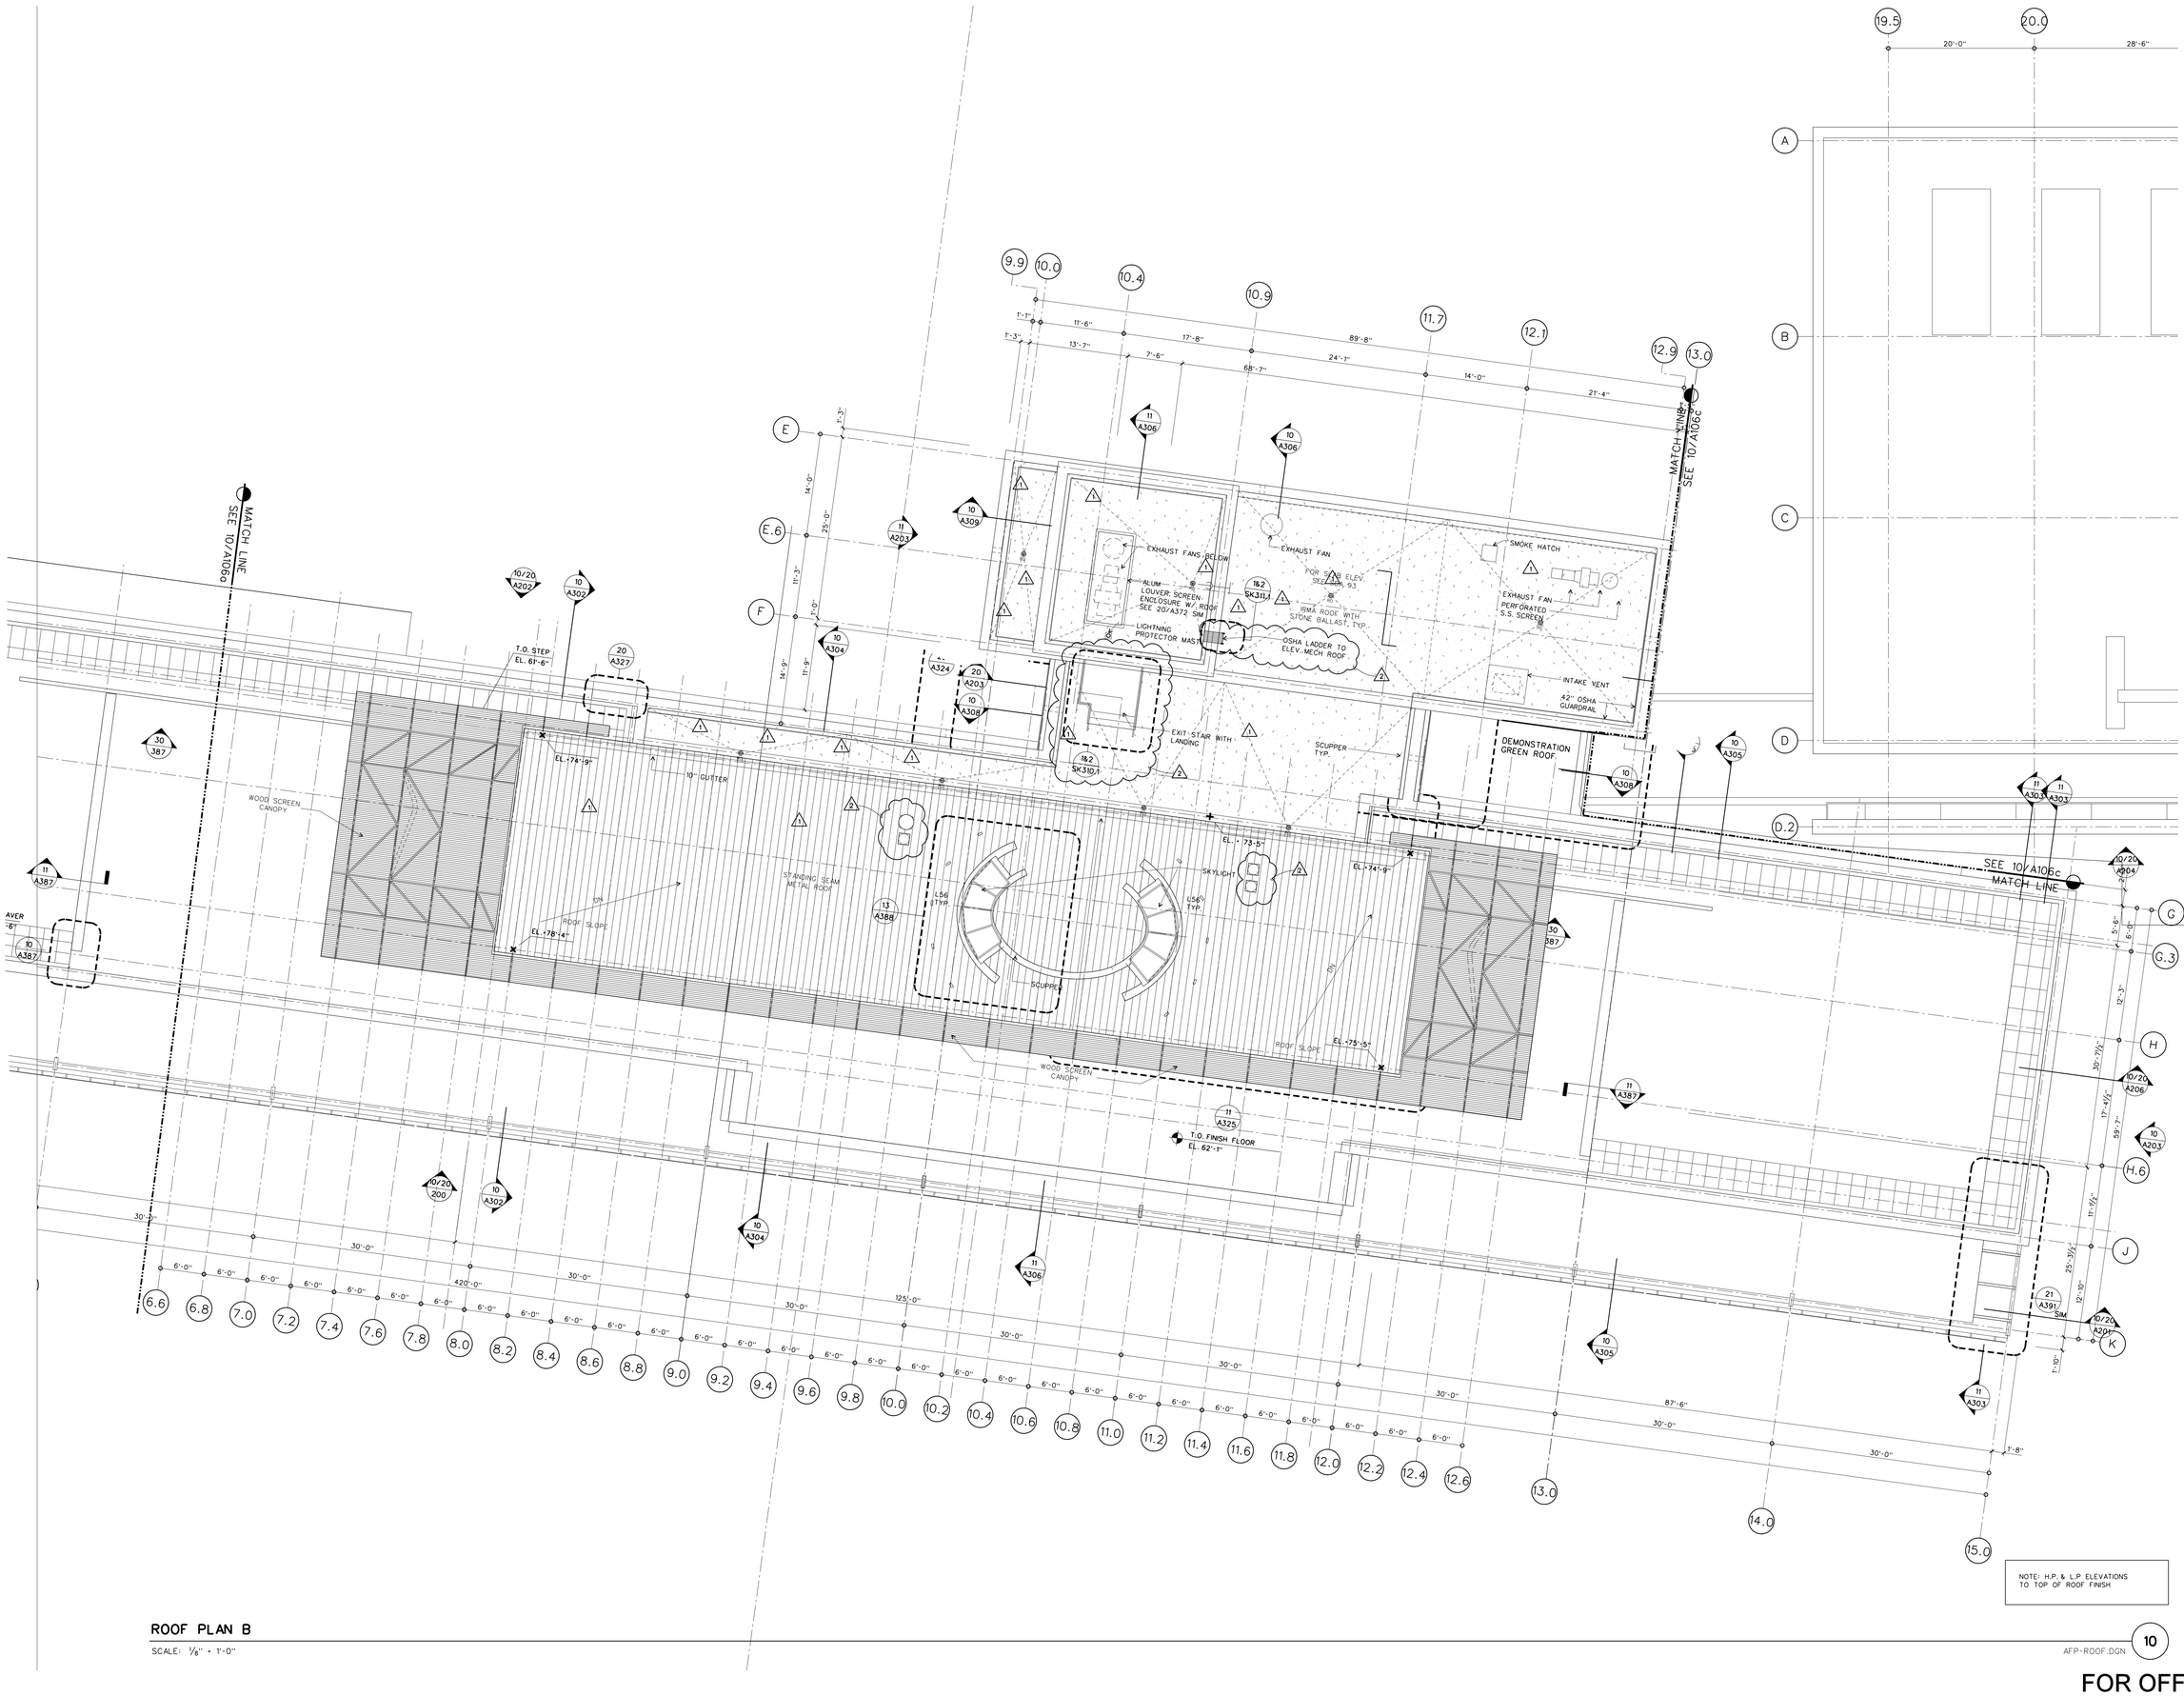

ROOF PLAN B

SCALE: 1/8" = 1'-0"

AFP-ROOF.DGN

10

WILLIAM J. CLINTON PRESIDENTIAL CENTER

LITTLE ROCK, ARKANSAS

Architect

POLSHEK PARTNERSHIP LLP
320 West 13th Street
New York, New York 10014
212.807.7171

Coordinating Architects

POLK STANLEY YEARY ARCHITECTS Ltd
700 South Schiller Street
Little Rock, Arkansas 72201
501.378.0878

WITSELL EVANS RASCO
901 West Third Street
Little Rock, Arkansas 72201
501.374.5300

WOODS CARADINE ARCHITECTS
2200 South Main Street
Little Rock, Arkansas 72206
501.374.4060

Landscape Architects

HARGREAVES ASSOCIATES
118 Magazine Street
Cambridge, Massachusettes 02139
617.661.0070

LANDSCAPE ARCHITECTURE, Inc.
2300 Cottondale Lane Suite 202
Little Rock, Arkansas 72202
501.374.5610

Structural Engineer

LESLIE E. ROBERTSON ASSOC., RLLP
30 Broad Street, 47th Floor
New York, New York 10004
212.750.9000

MEP Engineers

FLACK + KURTZ Inc.
475 Fifth Avenue
New York, New York 10017
212.532.9600


CROMWELL ARCHITECTS ENGINEERS
101 South Spring Street
Little Rock, Arkansas 72201
501.372.2900

Curtainwall Consultant

R. A. HEINTGES ARCHITECTS
126 Fifth Avenue, 9th Floor
New York, New York 10011
212.652-2966

Seal

Issue	Date
2 ASI #22	8/01/03
1 ASI #18	04/18/03
100% Construction Documents	09/27/02
90% Progress Printing	08/30/02
100% Struct./ CD Progress	07/01/02
100% Steel & Concrete CD & Architectural CD Progress	05/15/02
100% Design Development	03/01/02

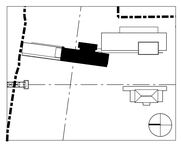

Job No. 9908

Scale 1/8" = 1'-0"

Date September 27, 2002


Title

ROOF PARTIAL PLAN

Sheet No.

A106b

FOR OFFICIAL USE ONLY

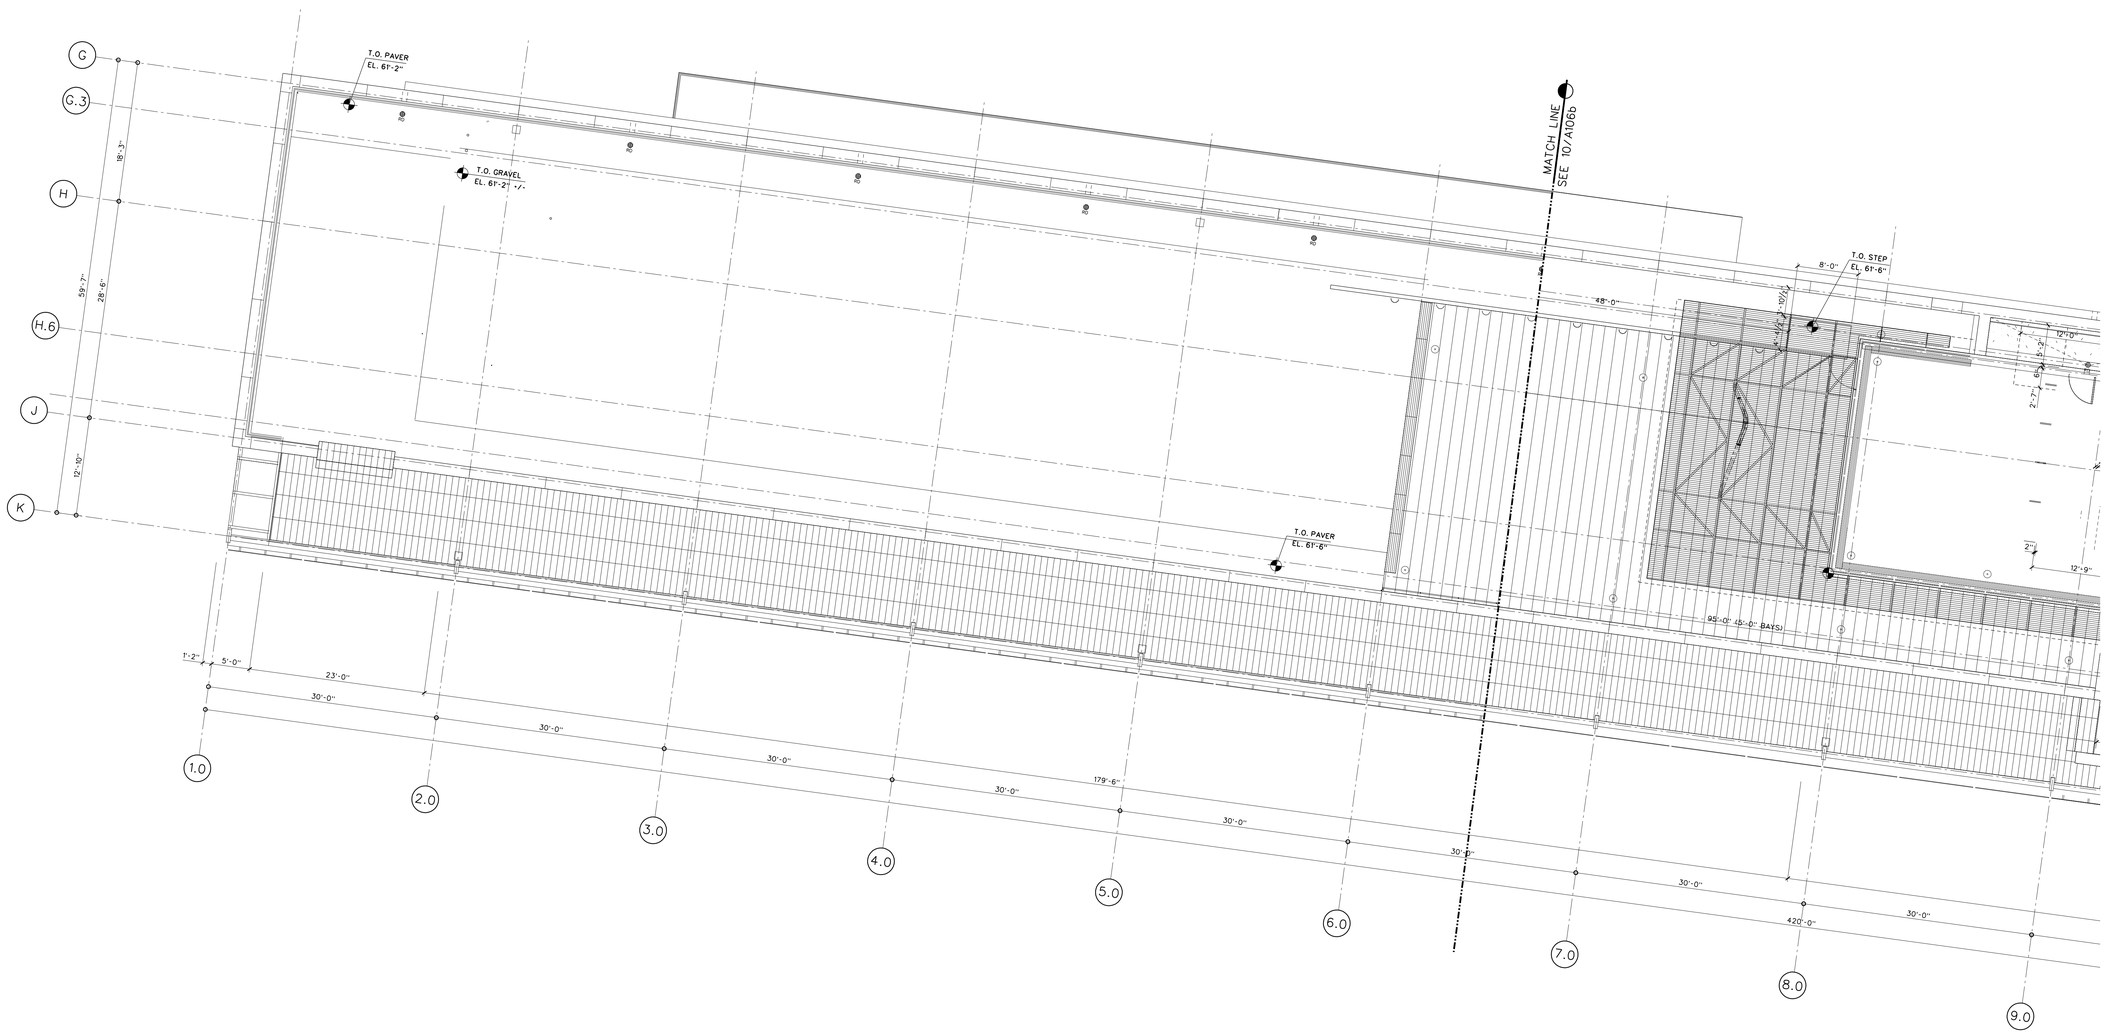

ROOF PLAN A

SCALE: 1/8" = 1'-0"

AFP-05.DGN

10

WILLIAM J. CLINTON PRESIDENTIAL CENTER

LITTLE ROCK, ARKANSAS

Architect

POLSHEK PARTNERSHIP LLP
320 West 13th Street
New York, New York 10014
212.807.7171

Coordinating Architects

POLK STANLEY YEARY ARCHITECTS Ltd
700 South Schiller Street
Little Rock, Arkansas 72201
501.378.0878

WITSELL EVANS RASCO
901 West Third Street
Little Rock, Arkansas 72201
501.374.5300

WOODS CARADINE ARCHITECTS
2200 South Main Street
Little Rock, Arkansas 72206
501.374.4060

Landscape Architects

HARGREAVES ASSOCIATES
118 Magazine Street
Cambridge, Massachusettes 02139
617.661.0070

LANDSCAPE ARCHITECTURE, Inc.
2300 Cottondale Lane Suite 202
Little Rock, Arkansas 72202
501.374.5610

Structural Engineer

LESLIE E. ROBERTSON ASSOC., RLLP
30 Broad Street, 47th Floor
New York, New York 10004
212.750.9000

MEP Engineers

FLACK + KURTZ Inc.
475 Fifth Avenue
New York, New York 10017
212.532.9600

CROMWELL ARCHITECTS ENGINEERS
101 South Spring Street
Little Rock, Arkansas 72201
501.372.2900

Curtainwall Consultant

R. A. HEINTGES ARCHITECTS
126 Fifth Avenue, 9th Floor
New York, New York 10011
212.652-2966

Seal

Issue	Date
Addendum #2	11/15/02
100% Construction Documents	09/27/02
90% Progress Printing	08/30/02
100% Struct./ CD Progress	07/01/02
100% Steel & Concrete CD	05/15/02
& Architectural CD Progress	
100% Design Development	03/01/02

Job No.
9908


Scale
1/8" = 1'-0"

Date
September 27, 2002

Title
EXECUTIVE LEVEL LANDSCAPE ROOF PARTIAL PLAN

Sheet No.
A107a

FOR OFFICIAL USE ONLY

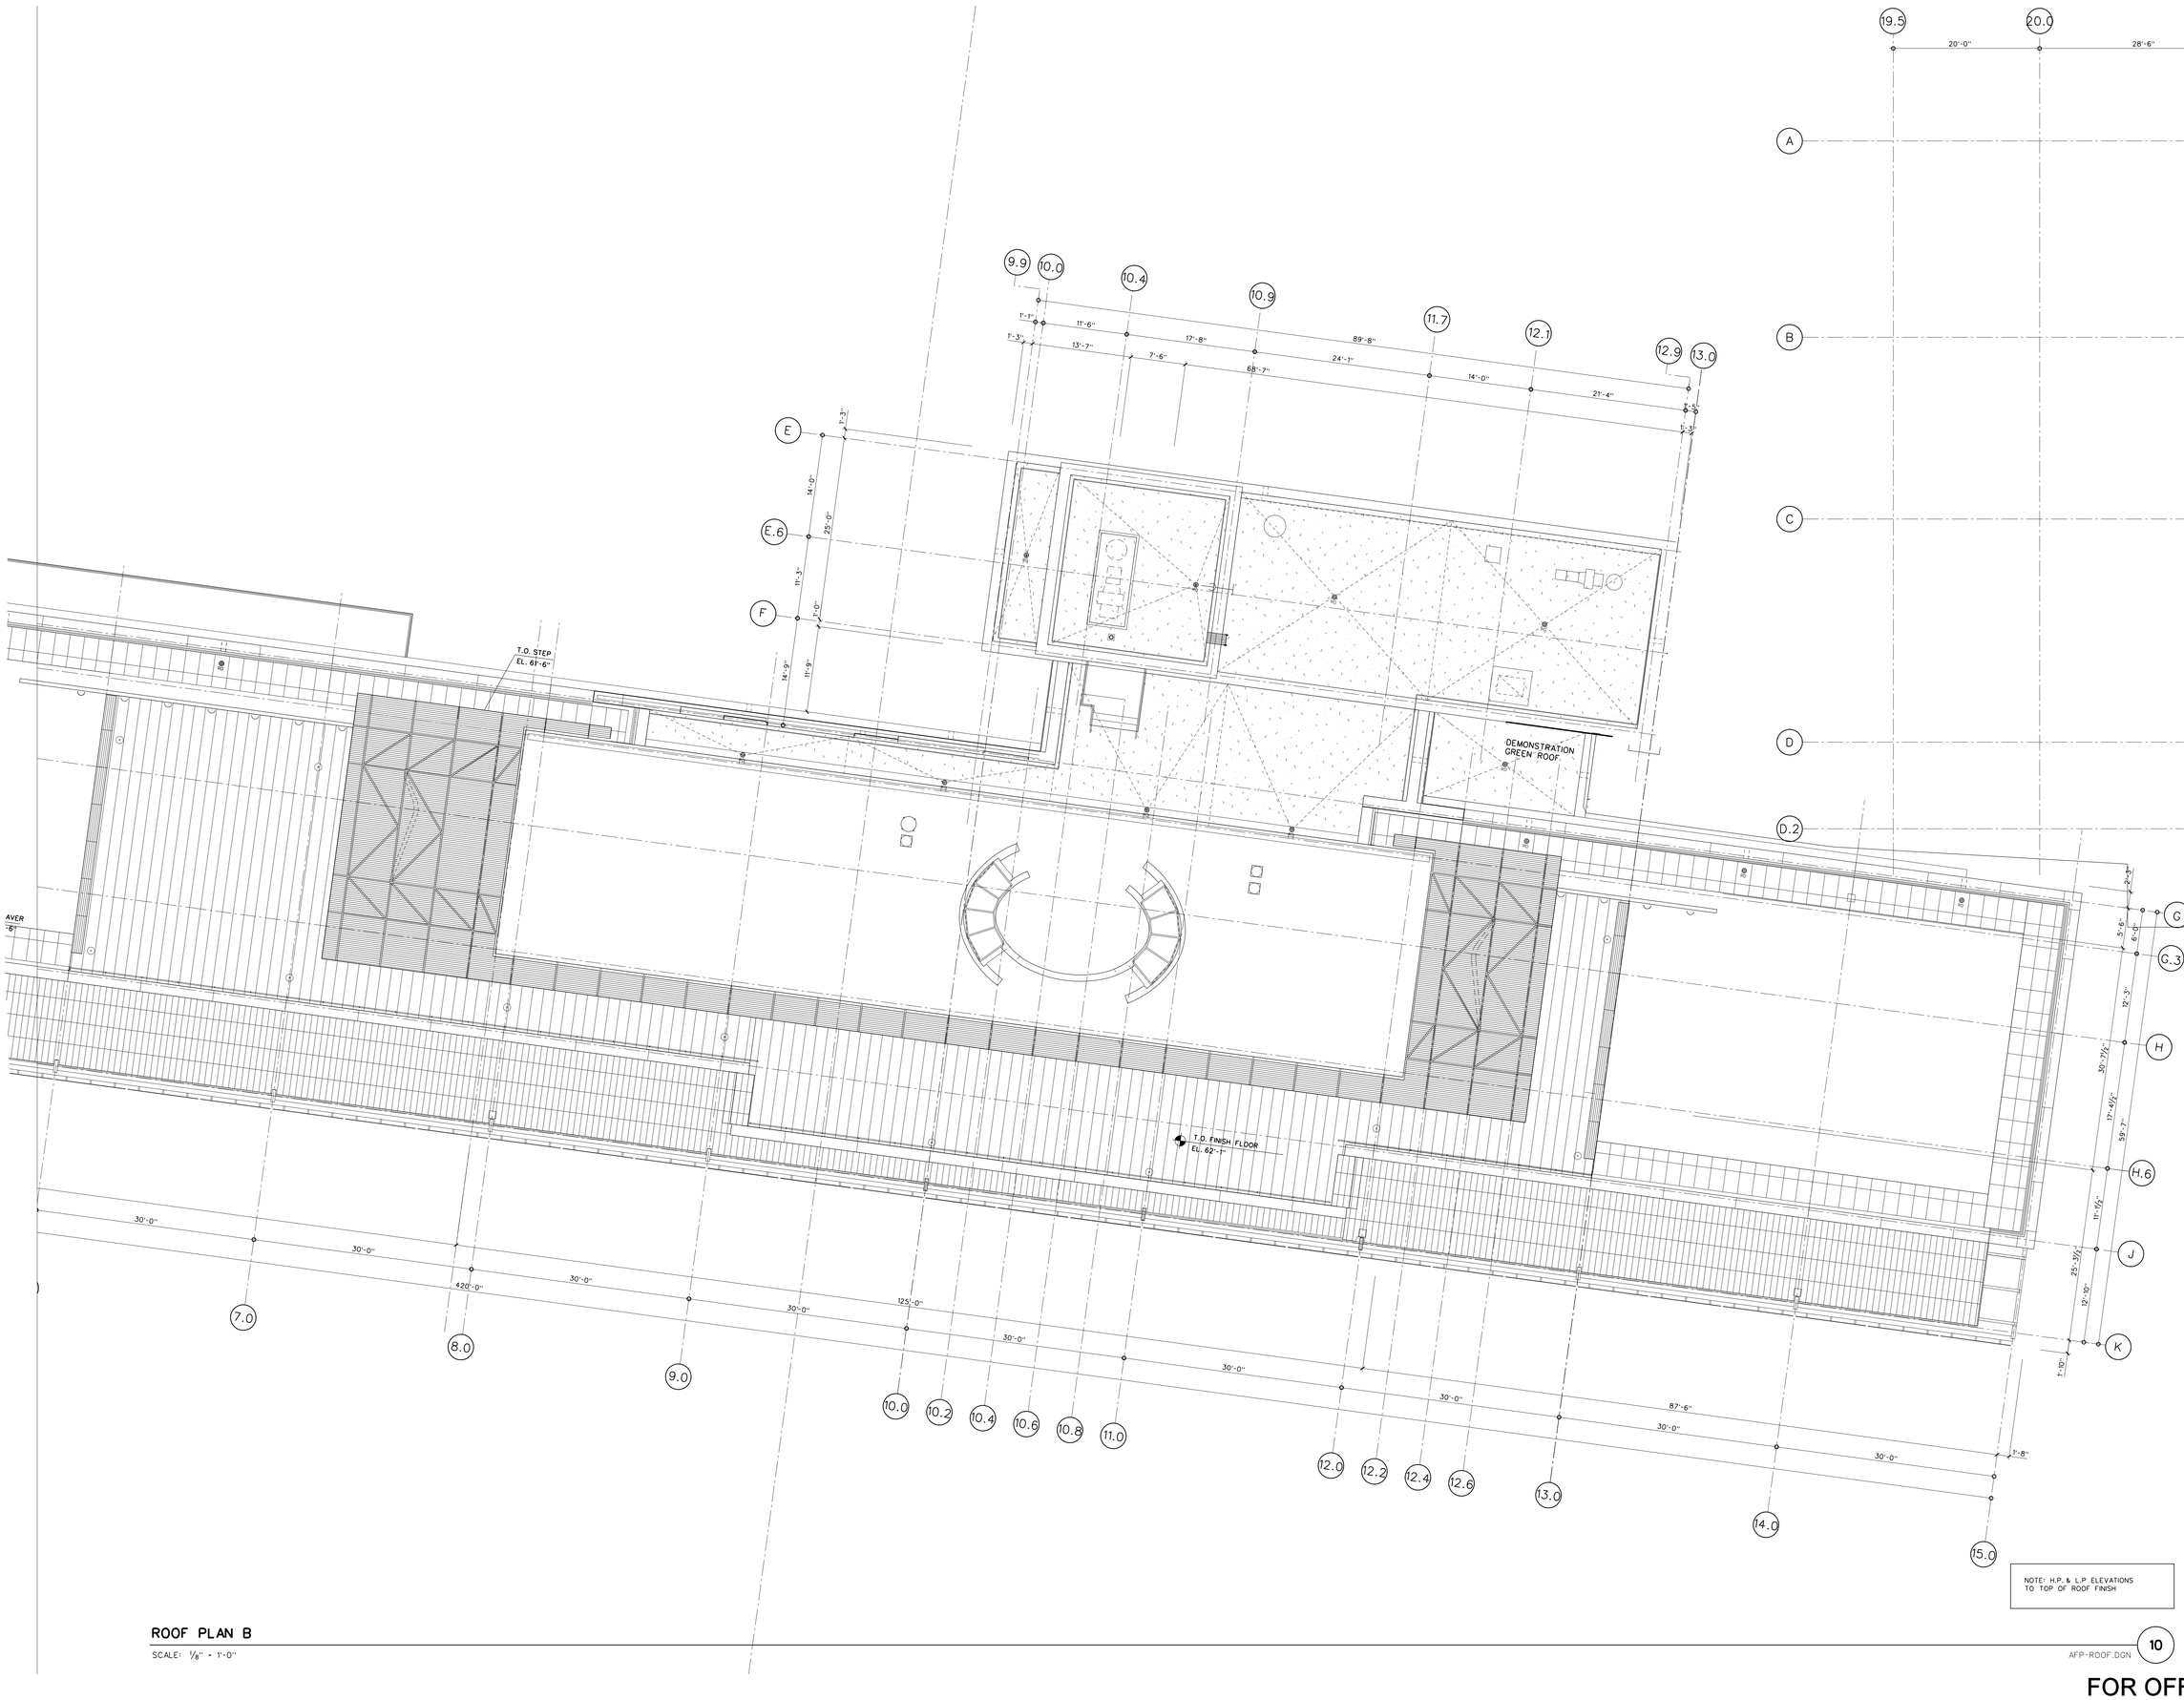

ROOF PLAN B

SCALE: 1/8" = 1'-0"

AFP-ROOF.DGN

10

WILLIAM J. CLINTON PRESIDENTIAL CENTER

LITTLE ROCK, ARKANSAS

Architect

POLSHEK PARTNERSHIP LLP
320 West 13th Street
New York, New York 10014
212.807.7171

Coordinating Architects

POLK STANLEY YEARY ARCHITECTS Ltd
700 South Schiller Street
Little Rock, Arkansas 72201
501.378.0878

WITSELL EVANS RASCO
901 West Third Street
Little Rock, Arkansas 72201
501.374.5300

WOODS CARADINE ARCHITECTS
2200 South Main Street
Little Rock, Arkansas 72206
501.374.4060

Landscape Architects

HARGREAVES ASSOCIATES
118 Magazine Street
Cambridge, Massachusettes 02139
617.661.0070

LANDSCAPE ARCHITECTURE, Inc.
2300 Cottondale Lane Suite 202
Little Rock, Arkansas 72202
501.374.5610

Structural Engineer

LESLIE E. ROBERTSON ASSOC., RLLP
30 Broad Street, 47th Floor
New York, New York 10004
212.750.9000

MEP Engineers

FLACK + KURTZ Inc.
475 Fifth Avenue
New York, New York 10017
212.532.9600

CROMWELL ARCHITECTS ENGINEERS
101 South Spring Street
Little Rock, Arkansas 72201
501.372.2900

Curtainwall Consultant

R. A. HEINTGES ARCHITECTS
126 Fifth Avenue, 9th Floor
New York, New York 10011
212.652-2966

Seal

Issue	Date
100% Construction Documents	09/27/02
90% Progress Printing	08/30/02
100% Struct./ CD Progress	07/01/02
100% Steel & Concrete CD & Architectural CD Progress	05/15/02
100% Design Development	03/01/02

Job No. 9908

Scale 1/8" = 1'-0"

Date September 27, 2002


Title

ROOF LANDSCAPE PARTIAL PLAN

Sheet No.

A107b

FOR OFFICIAL USE ONLY

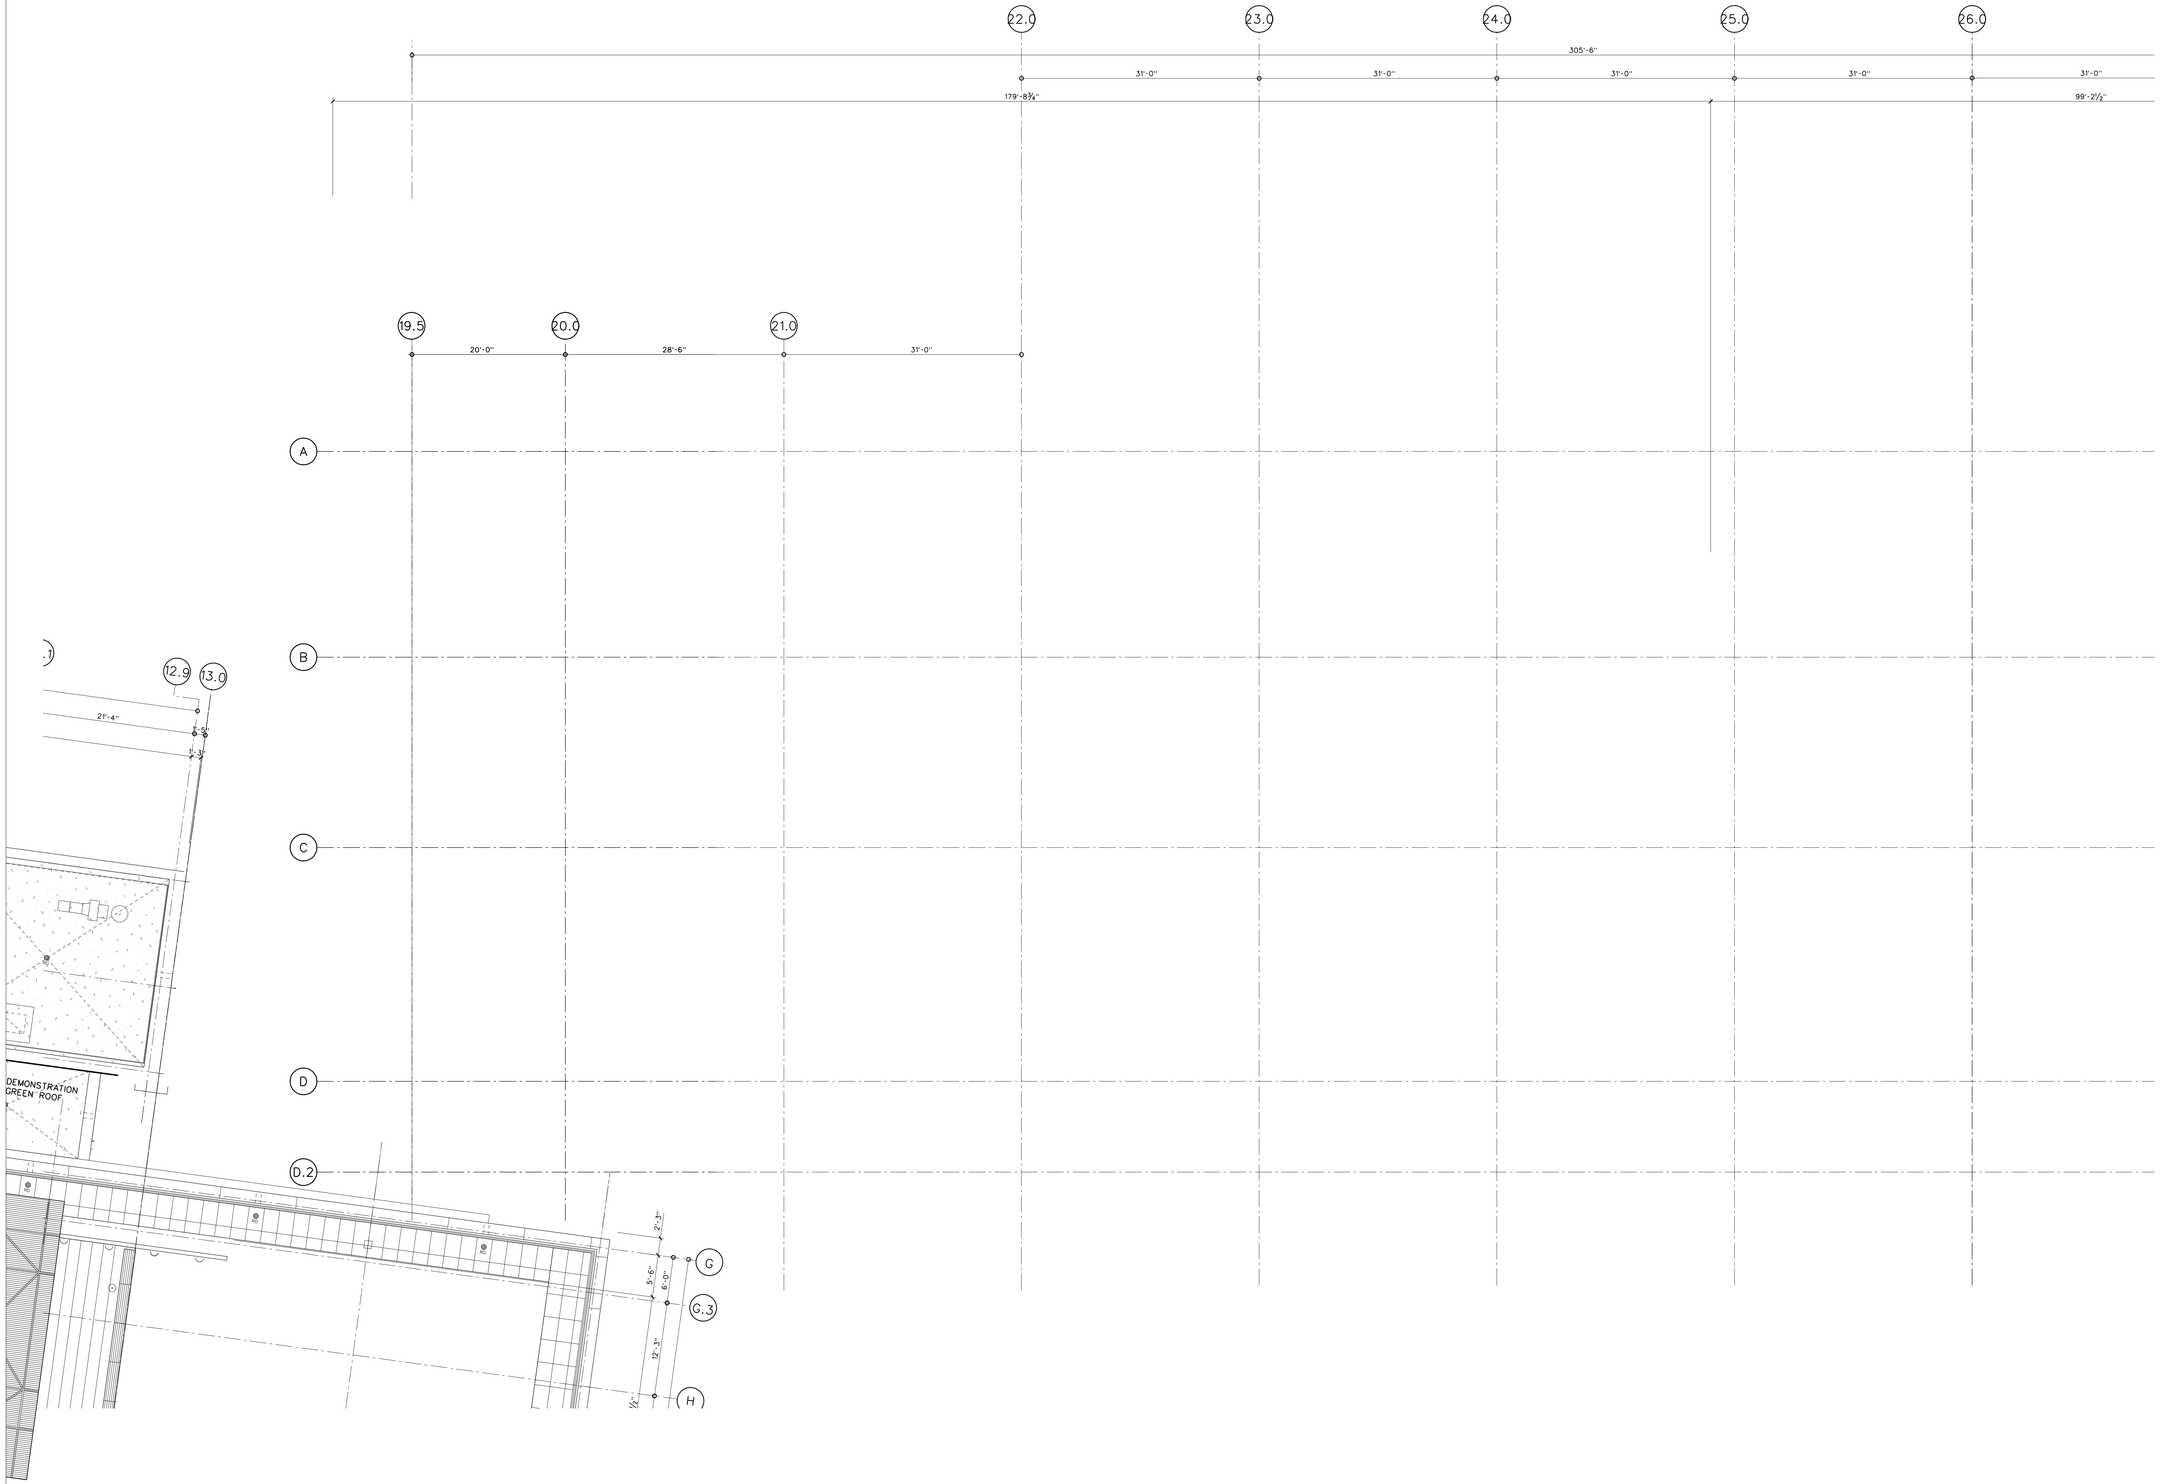

NOTE: H.P. & L.P. ELEVATIONS TO TOP OF ROOF FINISH

ROOF PLAN B

SCALE: 1/8" = 1'-0"

AFP-ROOF.DGN 10

FOR OFFICIAL USE ONLY

WILLIAM J. CLINTON PRESIDENTIAL CENTER

LITTLE ROCK, ARKANSAS

Architect

POLSHEK PARTNERSHIP LLP
320 West 13th Street
New York, New York 10014
212.807.7171

Coordinating Architects

POLK STANLEY YEARY ARCHITECTS Ltd
700 South Schiller Street
Little Rock, Arkansas 72201
501.378.0878

WITSELL EVANS RASCO
901 West Third Street
Little Rock, Arkansas 72201
501.374.5300

WOODS CARADINE ARCHITECTS
2200 South Main Street
Little Rock, Arkansas 72206
501.374.4060

Landscape Architects

HARGREAVES ASSOCIATES
118 Magazine Street
Cambridge, Massachusettes 02139
617.661.0070

LANDSCAPE ARCHITECTURE, Inc.
2300 Cottondale Lane Suite 202
Little Rock, Arkansas 72202
501.374.5610

Structural Engineer

LESLIE E. ROBERTSON ASSOC., RLLP
30 Broad Street, 47th Floor
New York, New York 10004
212.750.9000

MEP Engineers

FLACK + KURTZ Inc.
475 Fifth Avenue
New York, New York 10017
212.532.9600


CROMWELL ARCHITECTS ENGINEERS
101 South Spring Street
Little Rock, Arkansas 72201
501.372.2900

Curtainwall Consultant

R. A. HEINTGES ARCHITECTS
126 Fifth Avenue, 9th Floor
New York, New York 10011
212.652-2966

Seal

Issue	Date
100% Construction Documents	09/27/02
90% Progress Printing	08/30/02
100% Struct./ CD Progress	07/01/02
100% Steel & Concrete CD & Architectural CD Progress	05/15/02
100% Design Development	03/01/02

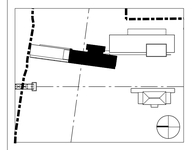

Job No. 9908

Scale 1/8" = 1'-0"


Date September 27, 2002

Title

ROOF LANDSCAPE PARTIAL PLAN

Sheet No.


A107c

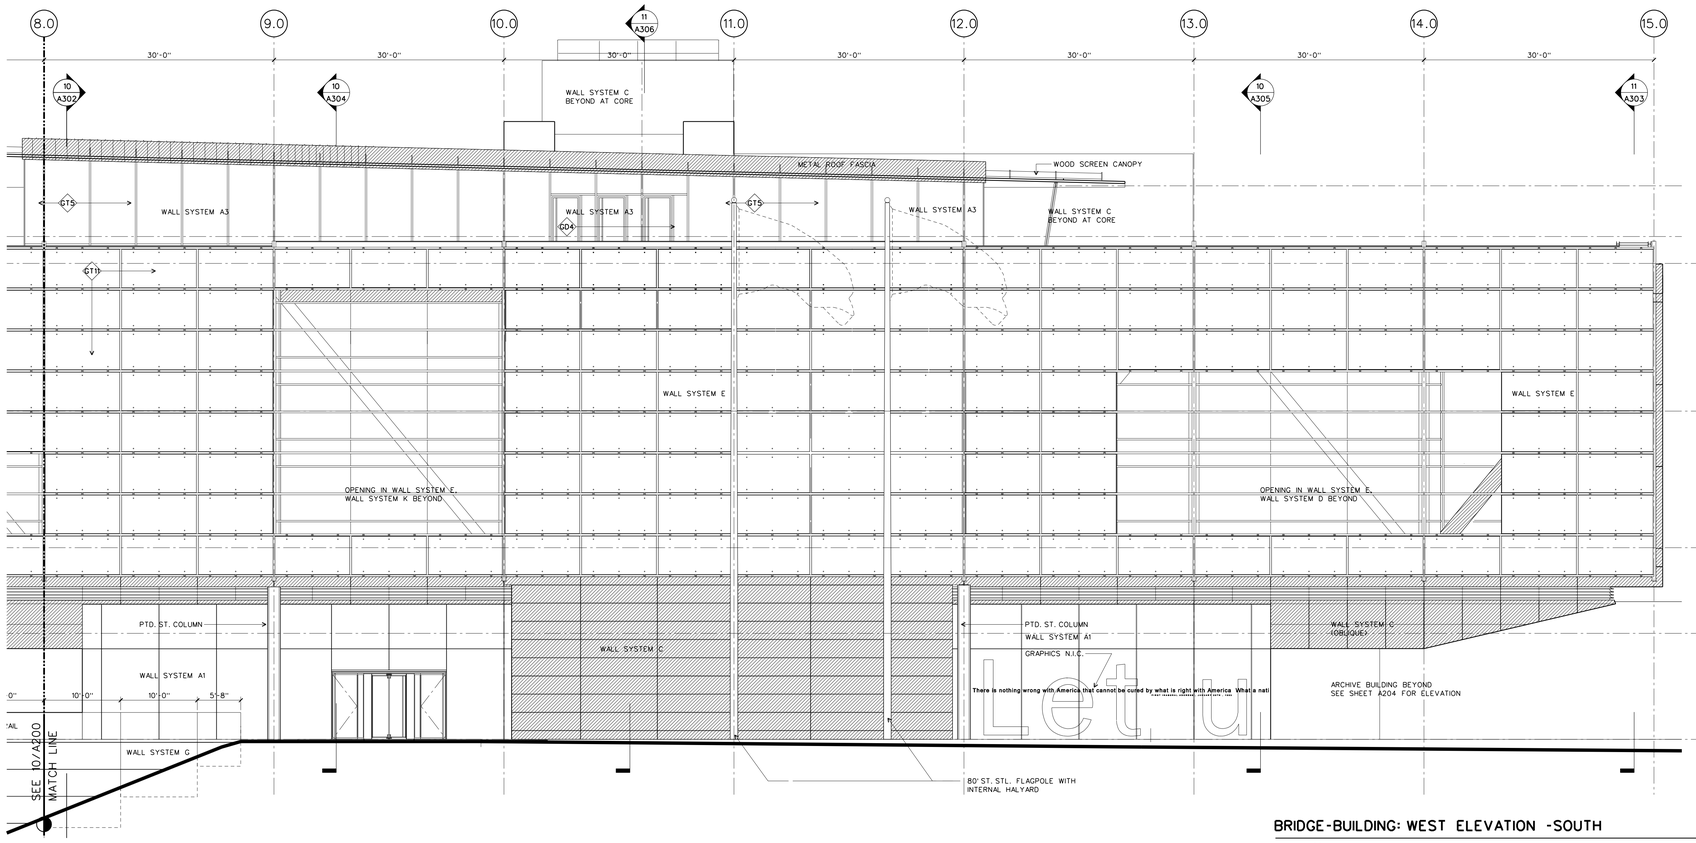

BRIDGE-BUILDING: WEST ELEVATION -SOUTH

SCALE: 1/8" = 1'-0"

20

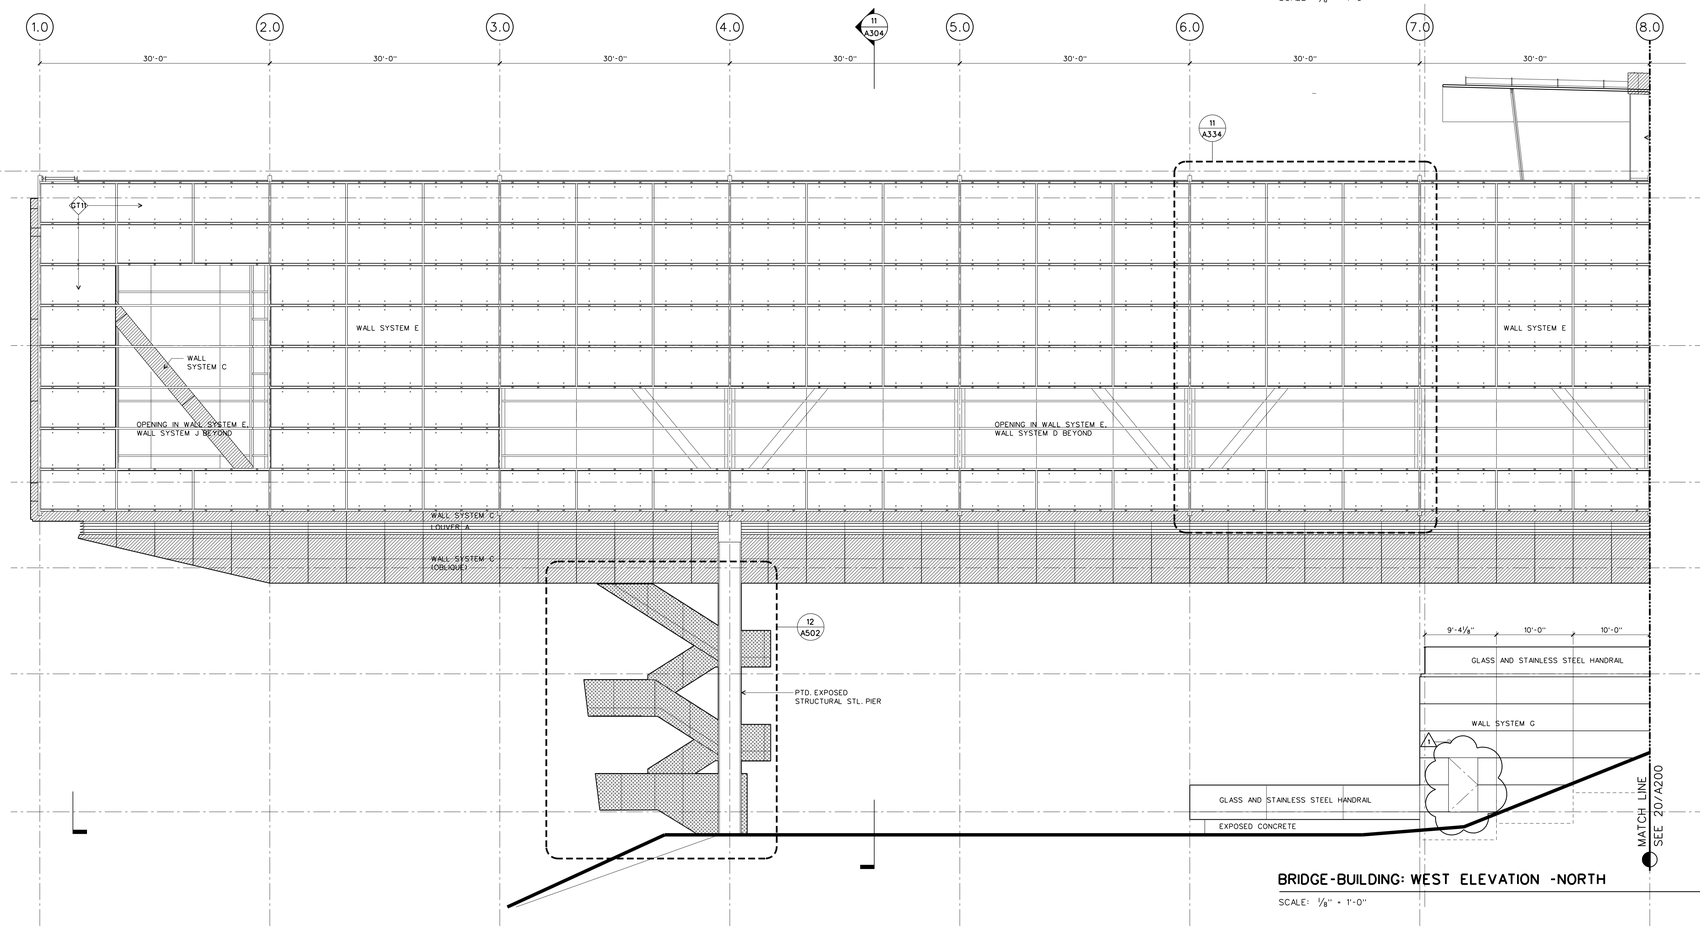

BRIDGE-BUILDING: WEST ELEVATION -NORTH

SCALE: 1/8" = 1'-0"

10

b-elv-w

WILLIAM J. CLINTON PRESIDENTIAL CENTER

LITTLE ROCK, ARKANSAS

Architect

POLSHEK PARTNERSHIP LLP
320 West 13th Street
New York, New York 10014
212.807.7171

Coordinating Architects

POLK STANLEY YEARY ARCHITECTS Ltd
700 South Schiller Street
Little Rock, Arkansas 72201
501.378.0878

WITSELL EVANS RASCO
901 West Third Street
Little Rock, Arkansas 72201
501.374.5300

WOODS CARADINE ARCHITECTS
2200 South Main Street
Little Rock, Arkansas 72206
501.374.4060

Landscape Architects

HARGREAVES ASSOCIATES
118 Magazine Street
Cambridge, Massachusettes 02139
617.661.0070

LANDSCAPE ARCHITECTURE, Inc.
2300 Cottondale Lane Suite 202
Little Rock, Arkansas 72202
501.374.5610

Structural Engineer

LESLIE E. ROBERTSON ASSOC., RLLP
30 Broad Street, 47th Floor
New York, New York 10004
212.750.9000

MEP Engineers

FLACK + KURTZ Inc.
475 Fifth Avenue
New York, New York 10017
212.532.9600


CROMWELL ARCHITECTS ENGINEERS
101 South Spring Street
Little Rock, Arkansas 72201
501.372.2900

Curtainwall Consultant

R. A. HEINTGES ARCHITECTS
126 Fifth Avenue, 9th Floor
New York, New York 10011
212.652-2966

Seal

Issue	Date
1 Addendum #2	11/15/02
100% Construction Documents	09/27/02
90% Progress Printing	08/30/02
100% Struct./ CD Progress	07/01/02
Bridge Bldg. Substructure	06/14/02
100% Steel & Concrete CD & Architectural CD Progress	05/15/02
100% Design Development	03/01/02

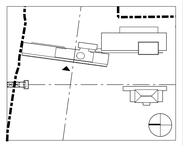

Job No. 9908

Scale 1/8" = 1'-0"

Date September 27, 2002

Title

MUSEUM BUILDING WEST ELEVATION


Sheet No.

A200

There is nothing wrong with America that cannot be cured by what is right with America. What a nati

Let us

FOR OFFICIAL USE ONLY

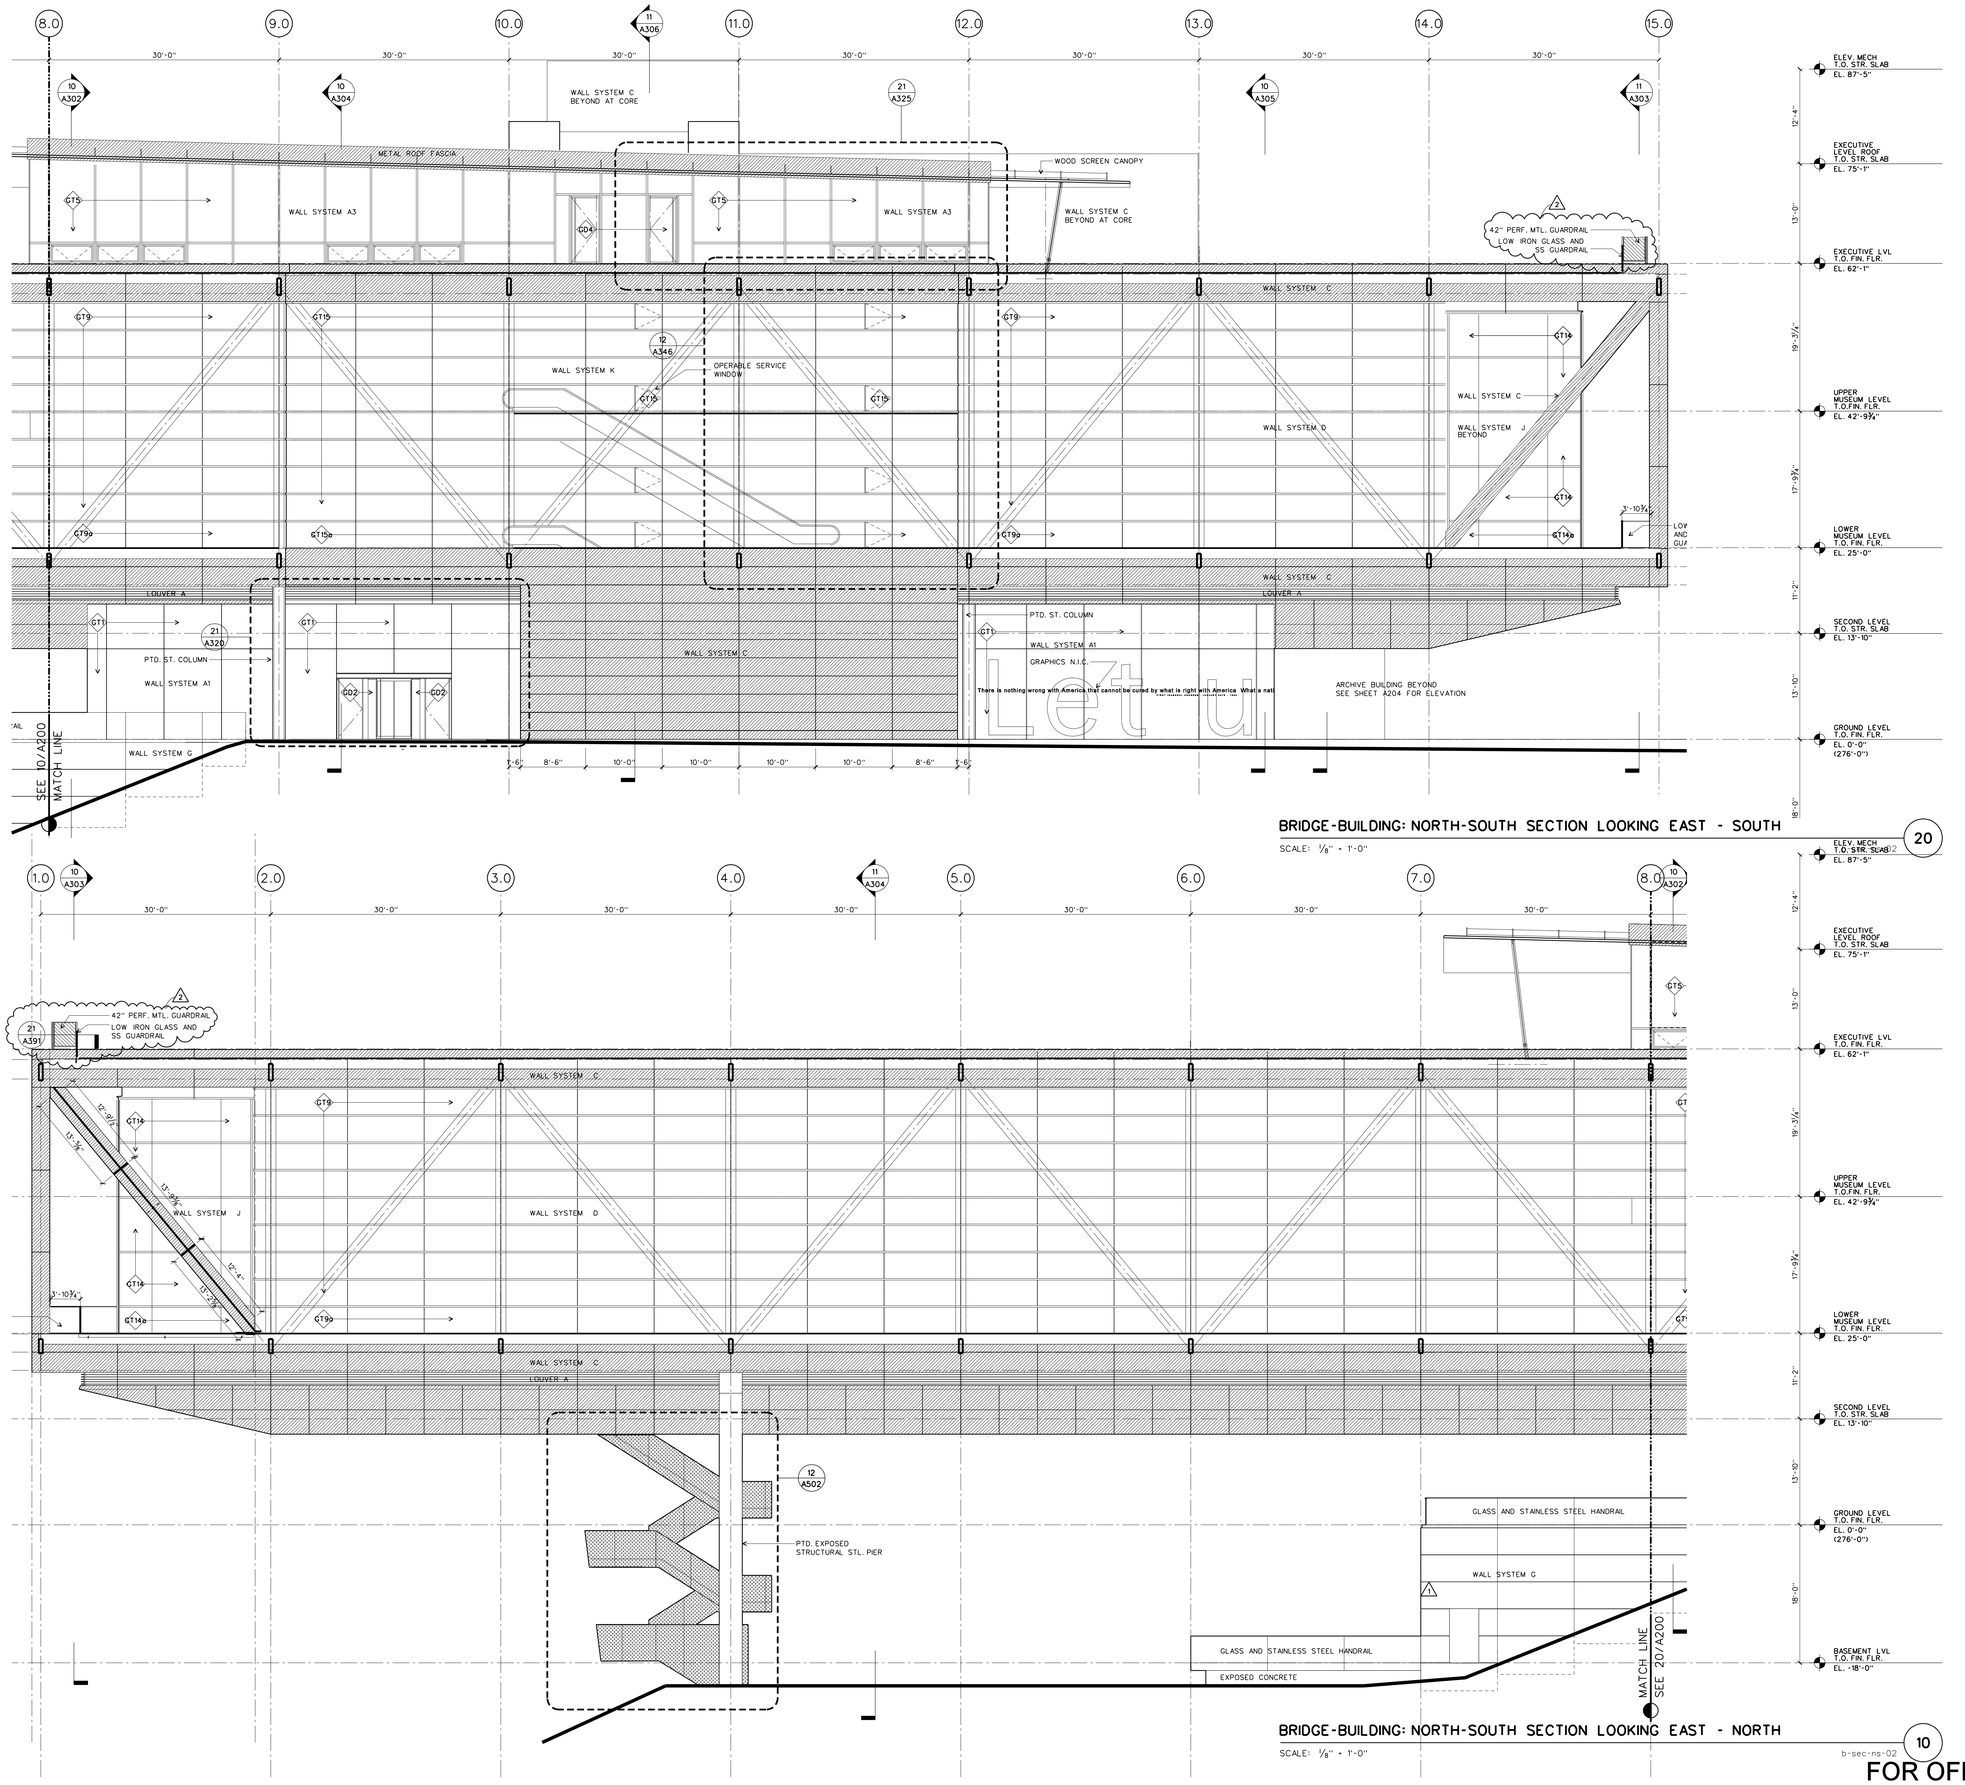

BRIDGE-BUILDING: NORTH-SOUTH SECTION LOOKING EAST - SOUTH

SCALE: 1/8" = 1'-0"

20

BRIDGE-BUILDING: NORTH-SOUTH SECTION LOOKING EAST - NORTH

SCALE: 1/8" = 1'-0"

b-sec-ns-02

10

Let us

WILLIAM J. CLINTON PRESIDENTIAL CENTER

LITTLE ROCK, ARKANSAS

Architect

POLSHEK PARTNERSHIP LLP
320 West 13th Street
New York, New York 10014
212.807.7171

Coordinating Architects

POLK STANLEY YEARY ARCHITECTS Ltd
700 South Schiller Street
Little Rock, Arkansas 72201
501.378.0878

WITSELL EVANS RASCO
901 West Third Street
Little Rock, Arkansas 72201
501.374.5300

WOODS CARADINE ARCHITECTS
2200 South Main Street
Little Rock, Arkansas 72206
501.374.4060

Landscape Architects

HARGREAVES ASSOCIATES
118 Magazine Street
Cambridge, Massachusettes 02139
617.661.0070

LANDSCAPE ARCHITECTURE, Inc.
2300 Cottondale Lane Suite 202
Little Rock, Arkansas 72202
501.374.5610

Structural Engineer

LESLIE E. ROBERTSON ASSOC., RLLP
30 Broad Street, 47th Floor
New York, New York 10004
212.750.9000

MEP Engineers

FLACK + KURTZ Inc.
475 Fifth Avenue
New York, New York 10017
212.532.9600

CROMWELL ARCHITECTS ENGINEERS
101 South Spring Street
Little Rock, Arkansas 72201
501.372.2900

Curtainwall Consultant

R. A. HEINTGES ARCHITECTS
126 Fifth Avenue, 9th Floor
New York, New York 10011
212.652-2966

Seal

	Issue	Date
2	ASI #20	06/06/03
1	Addendum #2	11/15/02
	90% Progress Printing	08/30/02
	100% Struct./ CD Progress	07/01/02
	100% Steel & Concrete CD & Architectural CD Progress	05/15/02
	100% Design Development	03/01/02

Job No.
9908

Scale
1/8" = 1'-0"

Date
September 27, 2002


Title

MUSEUM BUILDING
WEST ELEVATION

Sheet No.

A201


FOR OFFICIAL USE ONLY

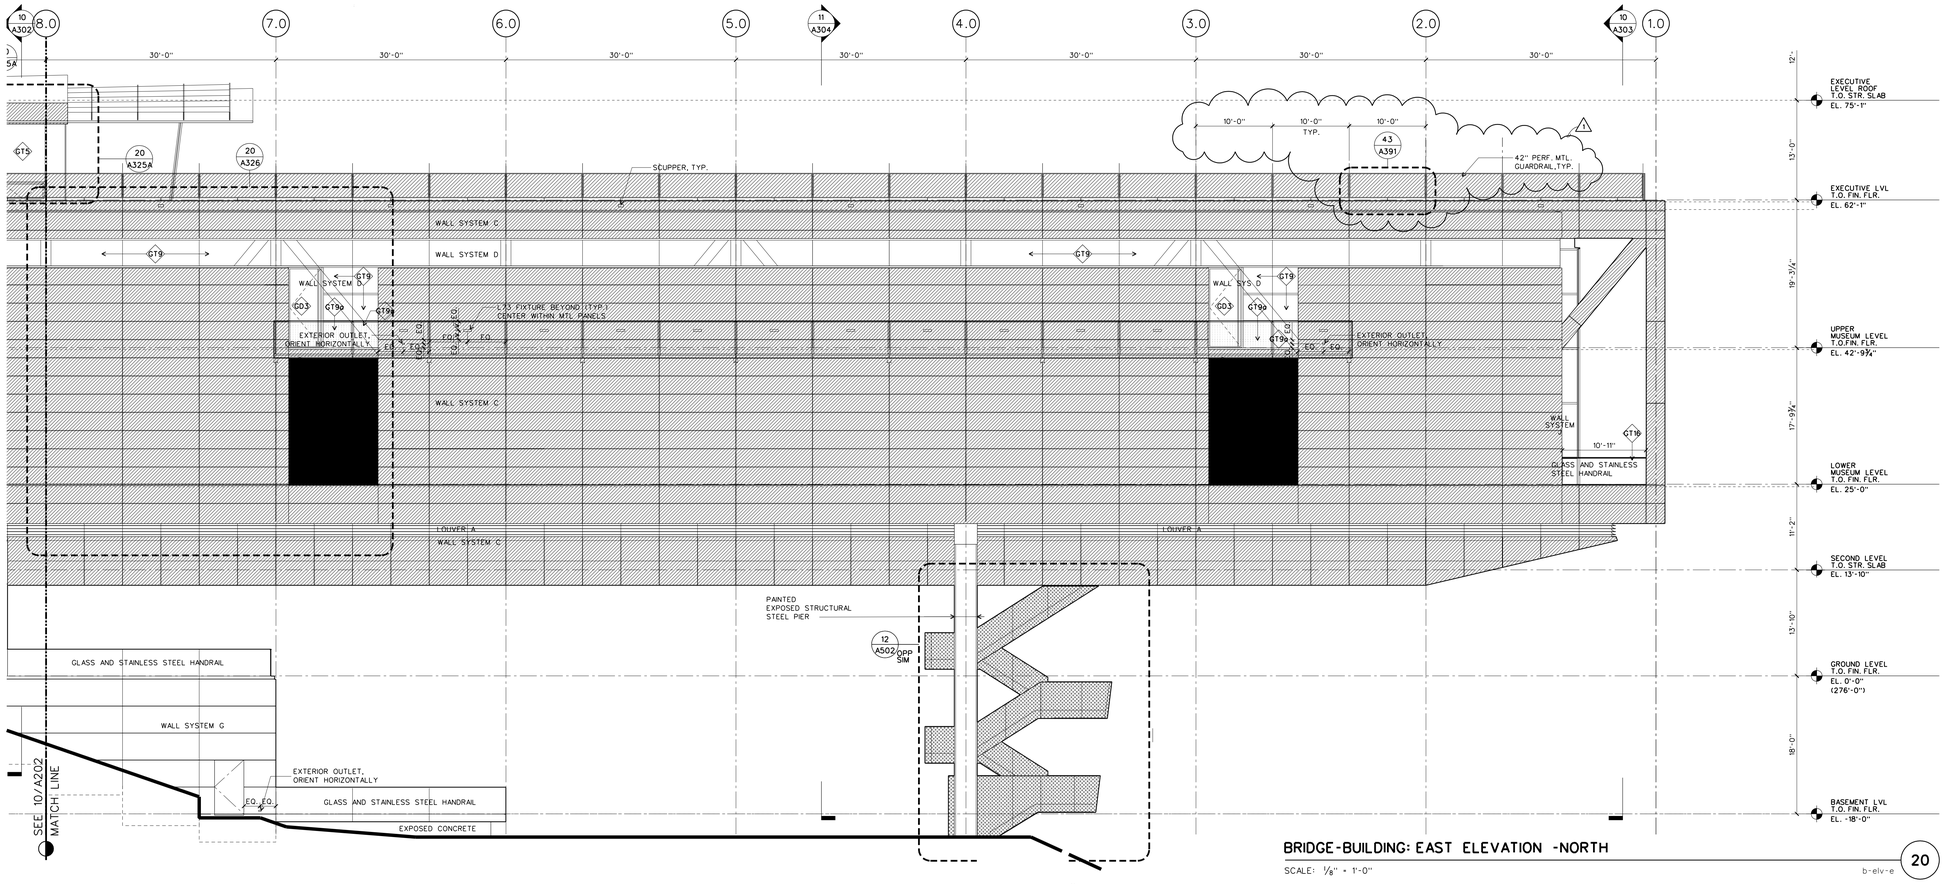

BRIDGE-BUILDING: EAST ELEVATION -NORTH

SCALE: 1/8" = 1'-0"

b-elv-e 20

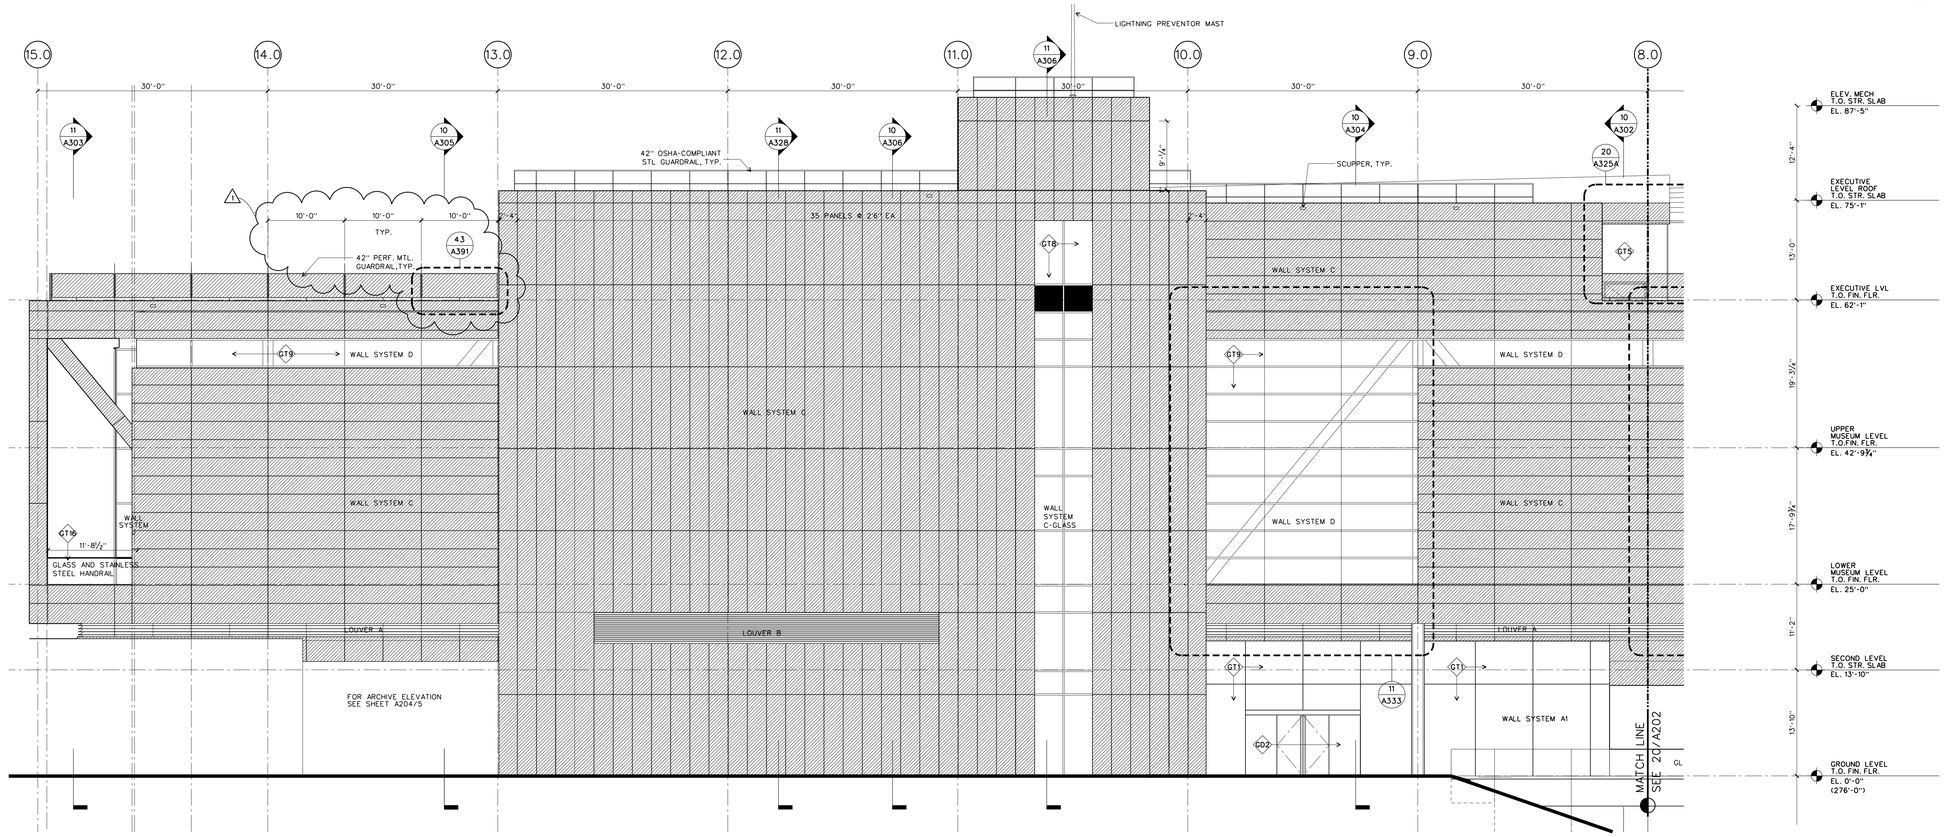

BRIDGE-BUILDING: EAST ELEVATION -SOUTH

SCALE: 1/8" = 1'-0"

b-elv-e 10

FOR OFFICIAL USE ONLY

WILLIAM J. CLINTON PRESIDENTIAL CENTER

LITTLE ROCK, ARKANSAS

Architect

POLSHEK PARTNERSHIP LLP
320 West 13th Street
New York, New York 10014
212.807.7171

Coordinating Architects

POLK STANLEY YEARY ARCHITECTS Ltd
700 South Schiller Street
Little Rock, Arkansas 72201
501.378.0878

WITSELL EVANS RASCO
901 West Third Street
Little Rock, Arkansas 72201
501.374.5300

WOODS CARADINE ARCHITECTS
2200 South Main Street
Little Rock, Arkansas 72206
501.374.4060

Landscape Architects

HARGREAVES ASSOCIATES
118 Magazine Street
Cambridge, Massachusettes 02139
617.661.0070

LANDSCAPE ARCHITECTURE, Inc.
2300 Cottondale Lane Suite 202
Little Rock, Arkansas 72202
501.374.5610

Structural Engineer

LESLIE E. ROBERTSON ASSOC., RLLP
30 Broad Street, 47th Floor
New York, New York 10004
212.750.9000

MEP Engineers

FLACK + KURTZ Inc.
475 Fifth Avenue
New York, New York 10017
212.532.9600


CROMWELL ARCHITECTS ENGINEERS
101 South Spring Street
Little Rock, Arkansas 72201
501.372.2900

Curtainwall Consultant

R. A. HEINTGES ARCHITECTS
126 Fifth Avenue, 9th Floor
New York, New York 10011
212.652-2966

Seal

Issue	Date
1 ASI #20	06/06/03
100% Construction Documents	09/27/02
90% Progress Printing	08/30/02
100% Struct./ CD Progress	07/01/02
Bridge Bldg. Substructure	06/14/02
100% Steel & Concrete CD & Architectural CD Progress	05/15/02
100% Design Development	03/01/02

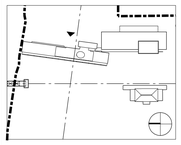

Job No. 9908

Scale 1/8" = 1'-0"


Date September 27, 2002

Title

MUSEUM BUILDING EAST ELEVATION

Sheet No.


A202

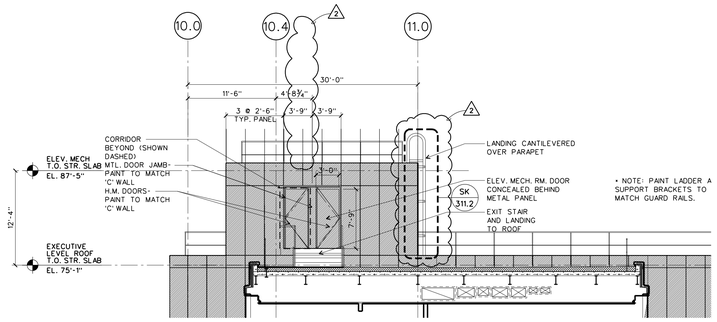

BRIDGE-BUILDING: WEST ELEVATION OF ELEVATOR MECHANICAL ROOM (PARTIAL)

SCALE: 1/8" = 1'-0"


b-sect-ns08 20

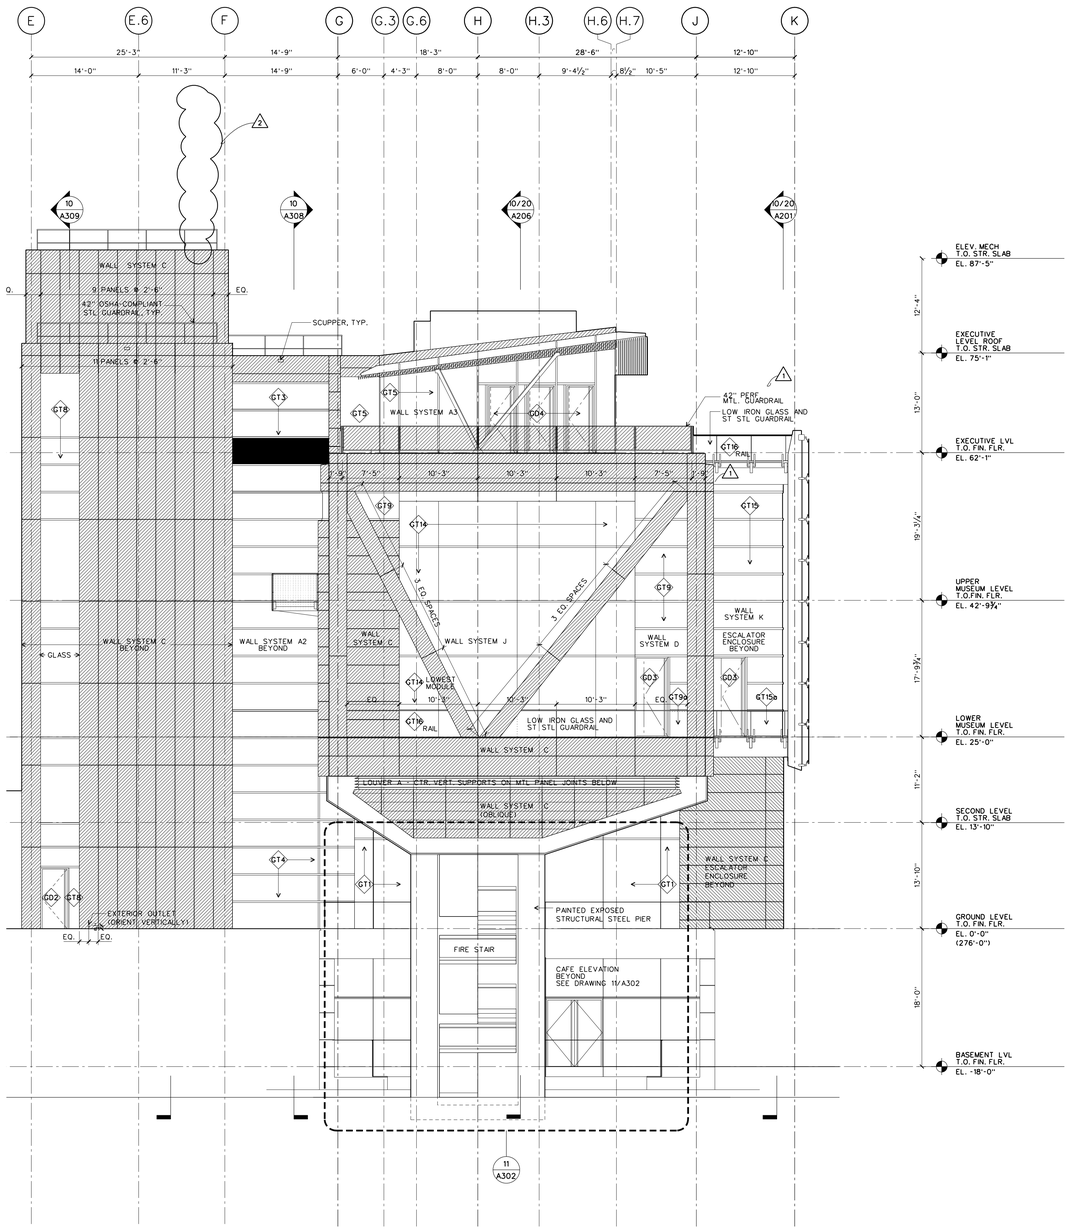

BRIDGE-BUILDING: NORTH ELEVATION

SCALE: 1/8" = 1'-0"

b-elv-n 11

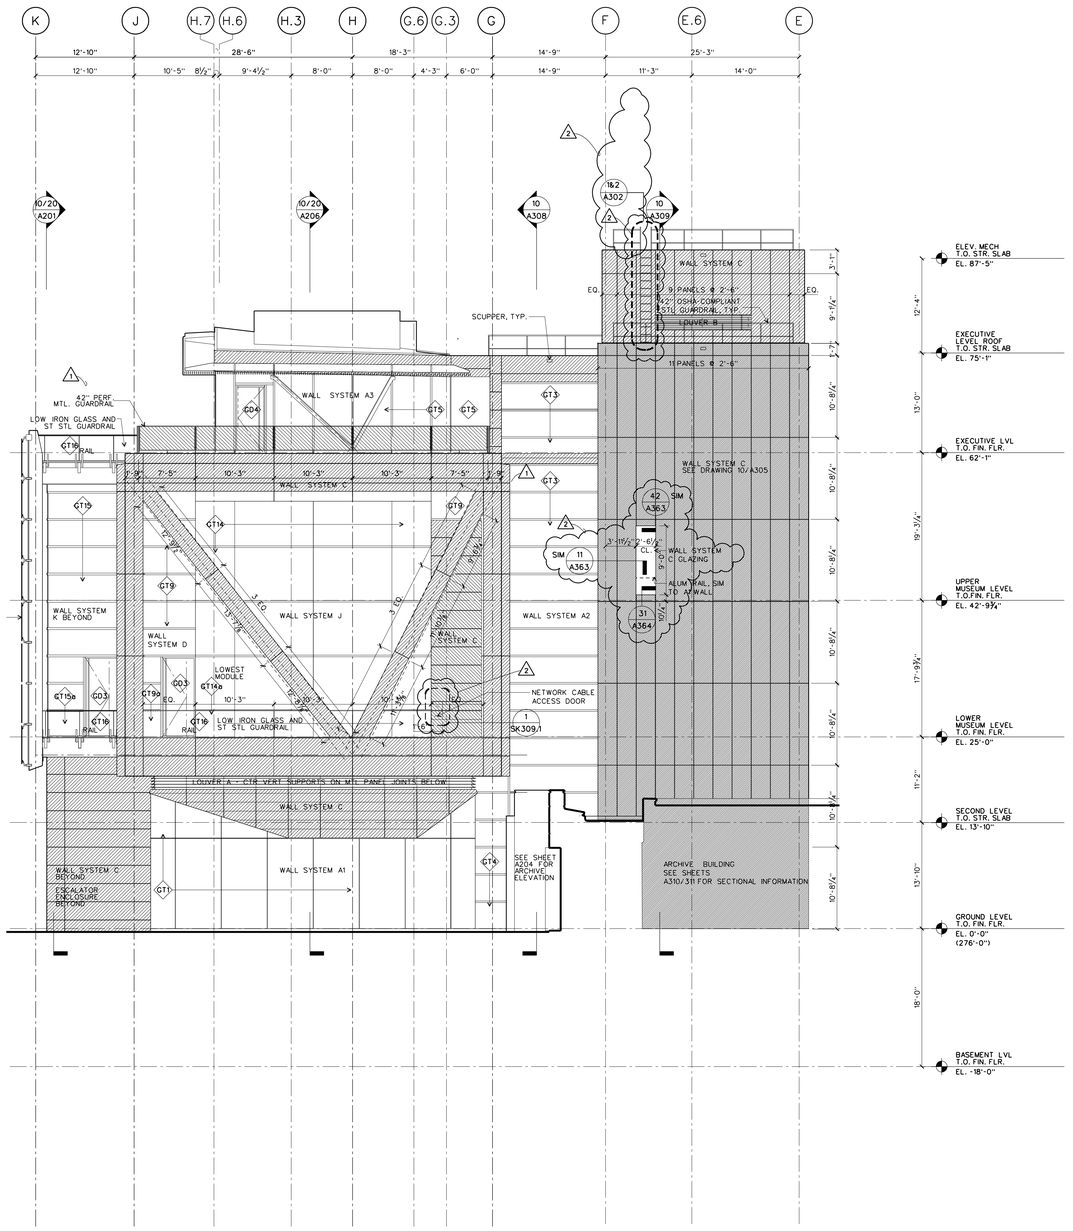

BRIDGE-BUILDING: SOUTH ELEVATION

SCALE: 1/8" = 1'-0"

b-elv-s 10

WILLIAM J. CLINTON PRESIDENTIAL CENTER

LITTLE ROCK, ARKANSAS

Architect

POLSHEK PARTNERSHIP LLP
320 West 13th Street
New York, New York 10014
212.807.7171

Coordinating Architects

POLK STANLEY YEARY ARCHITECTS Ltd
700 South Schiller Street
Little Rock, Arkansas 72201
501.378.0878

WITSELL EVANS RASCO
901 West Third Street
Little Rock, Arkansas 72201
501.374.5300

WOODS CARADINE ARCHITECTS
2200 South Main Street
Little Rock, Arkansas 72206
501.374.4060

Landscape Architects

HARGREAVES ASSOCIATES
118 Magazine Street
Cambridge, Massachusettes 02139
617.661.0070

LANDSCAPE ARCHITECTURE, Inc.
2300 Cottondale Lane Suite 202
Little Rock, Arkansas 72202
501.374.5610

Structural Engineer

LESLIE E. ROBERTSON ASSOC., RLLP
30 Broad Street, 47th Floor
New York, New York 10004
212.750.9000

MEP Engineers

FLACK + KURTZ Inc.
475 Fifth Avenue
New York, New York 10017
212.532.9600


CROMWELL ARCHITECTS ENGINEERS
101 South Spring Street
Little Rock, Arkansas 72201
501.372.2900

Curtainwall Consultant

R. A. HEINTGES ARCHITECTS
126 Fifth Avenue, 9th Floor
New York, New York 10011
212.652-2966

Seal

Issue	Date
2 ASI #23	09/12/03
1 ASI #20	06/06/03
100% Construction Documents	09/27/02
90% Progress Printing	08/30/02
100% Struct./ CD Progress	07/01/02
Bridge Bldg. Substructure	06/14/02
100% Steel & Concrete CD & Architectural CD Progress	05/15/02
100% Design Development	03/01/02

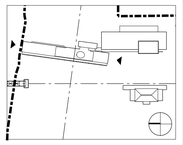

Job No. 9908

Scale 1/8" = 1'-0"

Date September 27, 2002


Title

MUSEUM BUILDING NORTH AND SOUTH ELEVATIONS

Sheet No.

A203

FOR OFFICIAL USE ONLY

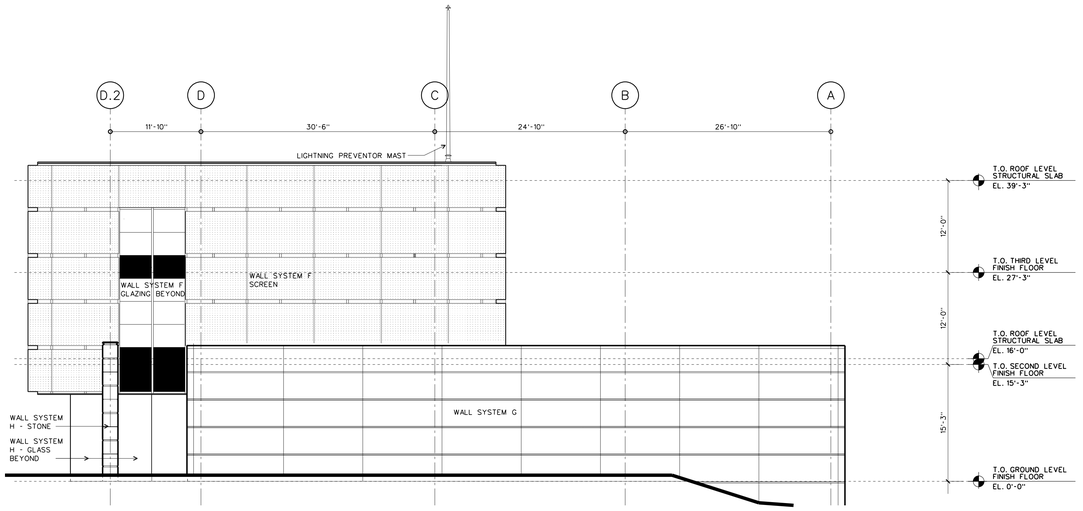


ARCHIVE-BUILDING: SOUTH ELEVATION

SCALE: 1/8" = 1'-0"

a-elv-s

31

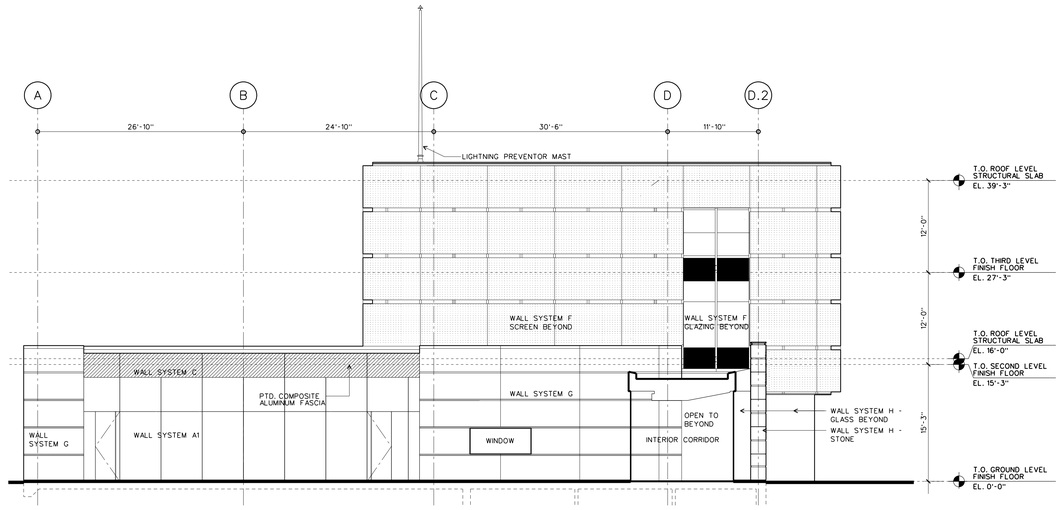


ARCHIVE-BUILDING: NORTH ELEVATION

SCALE: 1/8" = 1'-0"

a-elv-n

30

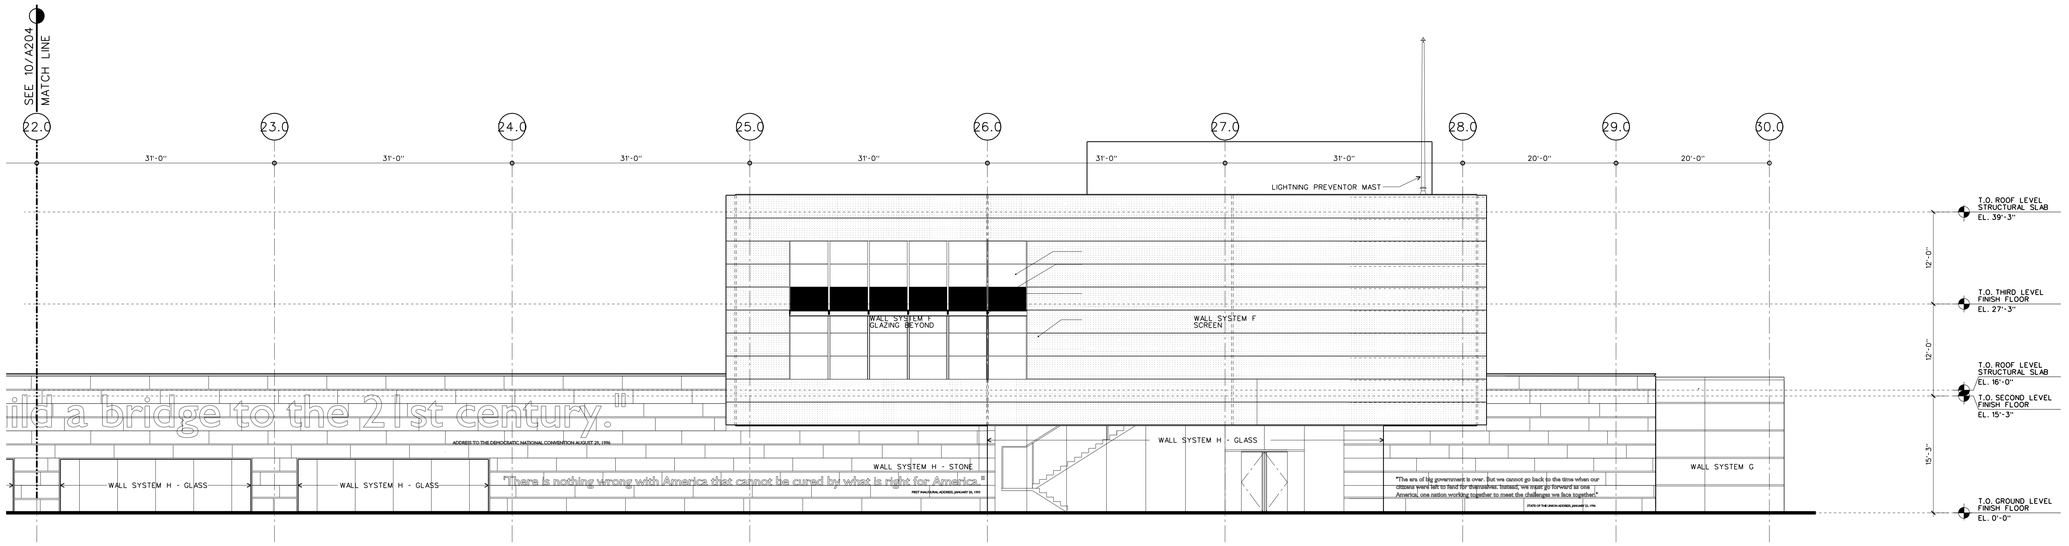


ARCHIVE-BUILDING: PARTIAL WEST ELEVATION

SCALE: 1/8" = 1'-0"

a-elv-w

20

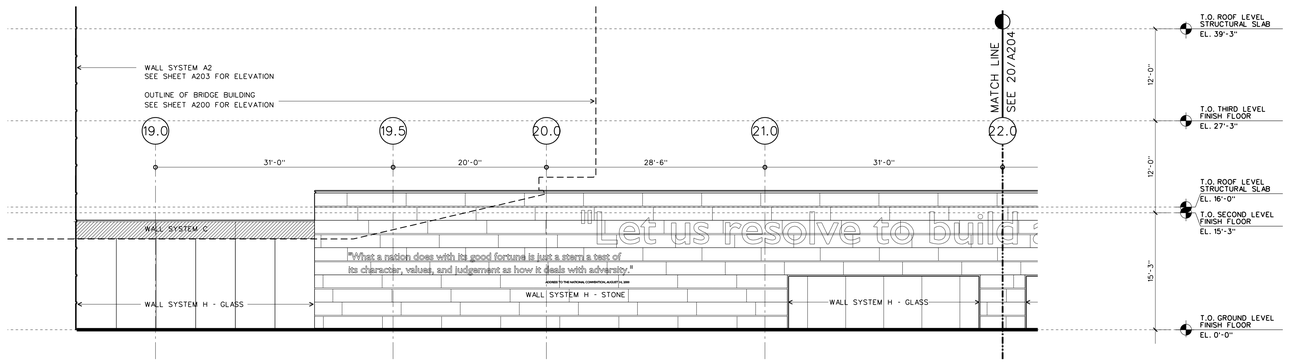

ARCHIVE-BUILDING: PARTIAL WEST ELEVATION

SCALE: 1/8" = 1'-0"

a-elv-e

10

WILLIAM J. CLINTON PRESIDENTIAL CENTER

LITTLE ROCK, ARKANSAS

Architect

POLSHEK PARTNERSHIP LLP
320 West 13th Street
New York, New York 10014
212.807.7171

Coordinating Architects

POLK STANLEY YEARY ARCHITECTS Ltd
700 South Schiller Street
Little Rock, Arkansas 72201
501.378.0878

WITSELL EVANS RASCO
901 West Third Street
Little Rock, Arkansas 72201
501.374.5300

WOODS CARADINE ARCHITECTS
2200 South Main Street
Little Rock, Arkansas 72206
501.374.4060

Landscape Architects

HARGREAVES ASSOCIATES
118 Magazine Street
Cambridge, Massachusettes 02139
617.661.0070

LANDSCAPE ARCHITECTURE, Inc.
2300 Cottondale Lane Suite 202
Little Rock, Arkansas 72202
501.374.5610

Structural Engineer

LESLIE E. ROBERTSON ASSOC., RLLP
30 Broad Street, 47th Floor
New York, New York 10004
212.750.9000

MEP Engineers

FLACK + KURTZ Inc.
475 Fifth Avenue
New York, New York 10017
212.532.9600


CROMWELL ARCHITECTS ENGINEERS
101 South Spring Street
Little Rock, Arkansas 72201
501.372.2900

Curtainwall Consultant

R. A. HEINTGES ARCHITECTS
126 Fifth Avenue, 9th Floor
New York, New York 10011
212.652-2966

Seal

Issue	Date
100% Construction Documents	09/27/02
90% Progress Printing	08/30/02
ASI #05	08/20/02
100% Struct./ CD Progress	07/01/02
Bridge Bldg. Substructure	06/14/02
100% Steel & Concrete CD & Architectural CD Progress	05/15/02
100% Design Development	03/01/02

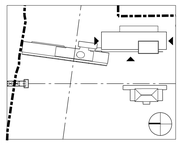

Job No. 9908

Scale 1/8" = 1'-0"

Date September 27, 2002


Title

ARCHIVE BUILDING ELEVATIONS

Sheet No.

A204

FOR OFFICIAL USE ONLY

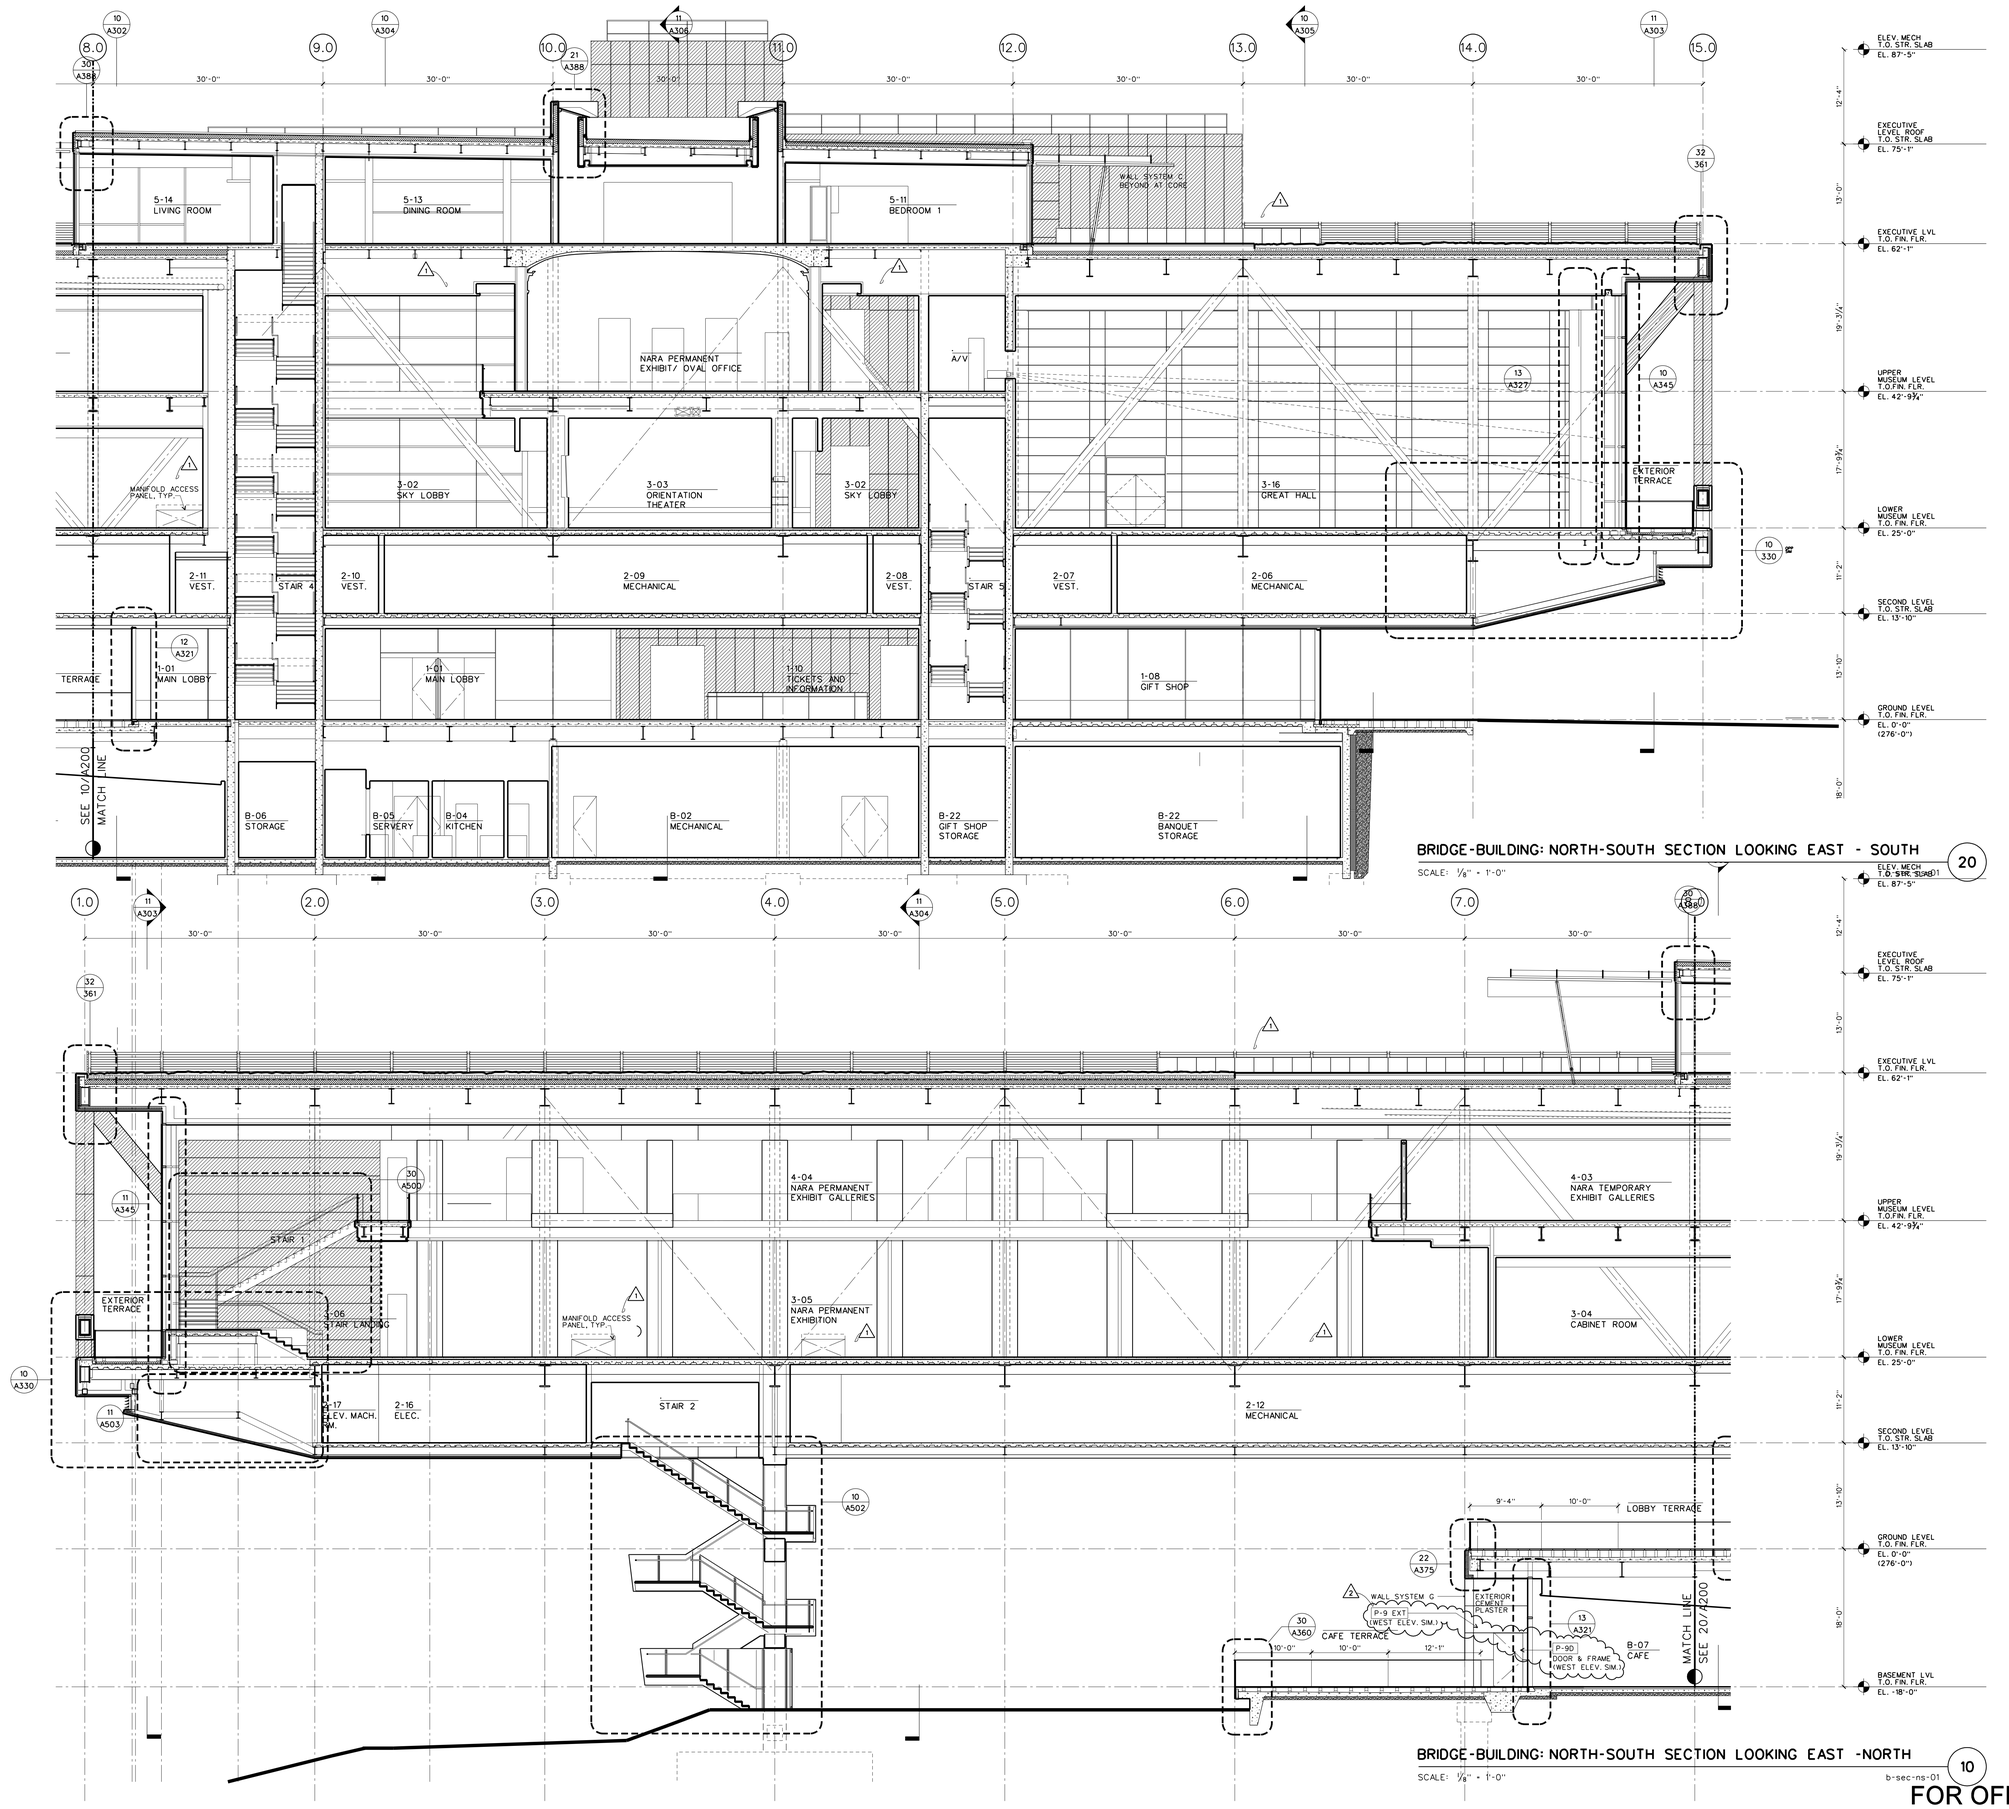

BRIDGE-BUILDING: NORTH-SOUTH SECTION LOOKING EAST - SOUTH 20

SCALE: 1/8" = 1'-0"

BRIDGE-BUILDING: NORTH-SOUTH SECTION LOOKING EAST -NORTH 10

SCALE: 1/8" = 1'-0"

b-sec-ns-01

WILLIAM J. CLINTON PRESIDENTIAL CENTER

LITTLE ROCK, ARKANSAS

Architect

POLSHEK PARTNERSHIP LLP
320 West 13th Street
New York, New York 10014
212.807.7171

Coordinating Architects

POLK STANLEY YEARY ARCHITECTS Ltd
700 South Schiller Street
Little Rock, Arkansas 72201
501.378.0878

WITSELL EVANS RASCO
901 West Third Street
Little Rock, Arkansas 72201
501.374.5300

WOODS CARADINE ARCHITECTS
2200 South Main Street
Little Rock, Arkansas 72206
501.374.4060

Landscape Architects

HARGREAVES ASSOCIATES
118 Magazine Street
Cambridge, Massachusettes 02139
617.661.0070

LANDSCAPE ARCHITECTURE, Inc.
2300 Cottondale Lane Suite 202
Little Rock, Arkansas 72202
501.374.5610

Structural Engineer

LESLIE E. ROBERTSON ASSOC., RLLP
30 Broad Street, 47th Floor
New York, New York 10004
212.750.9000

MEP Engineers

FLACK + KURTZ Inc.
475 Fifth Avenue
New York, New York 10017
212.532.9600

CROMWELL ARCHITECTS ENGINEERS
101 South Spring Street
Little Rock, Arkansas 72201
501.372.2900

Curtainwall Consultant

R. A. HEINTGES ARCHITECTS
126 Fifth Avenue, 9th Floor
New York, New York 10011
212.652-2966

Seal

	Issue	Date
2	ASI #23	09/12/03
1	Addendum #2	11/15/02
	100% Construction Documents	09/27/02
	90% Progress Printing	08/30/02
	100% Struct./ CD Progress	07/01/02
	Bridge Bldg. Substructure	06/14/02
	100% Steel & Concrete CD & Architectural CD Progress	05/15/02
	100% Design Development	03/01/02

Job No. 9908

Scale 1/8" = 1'-0"

Date September 27, 2002


Title

MUSEUM BUILDING LONGITUDINAL SECTION

Sheet No.

A206

FOR OFFICIAL USE ONLY

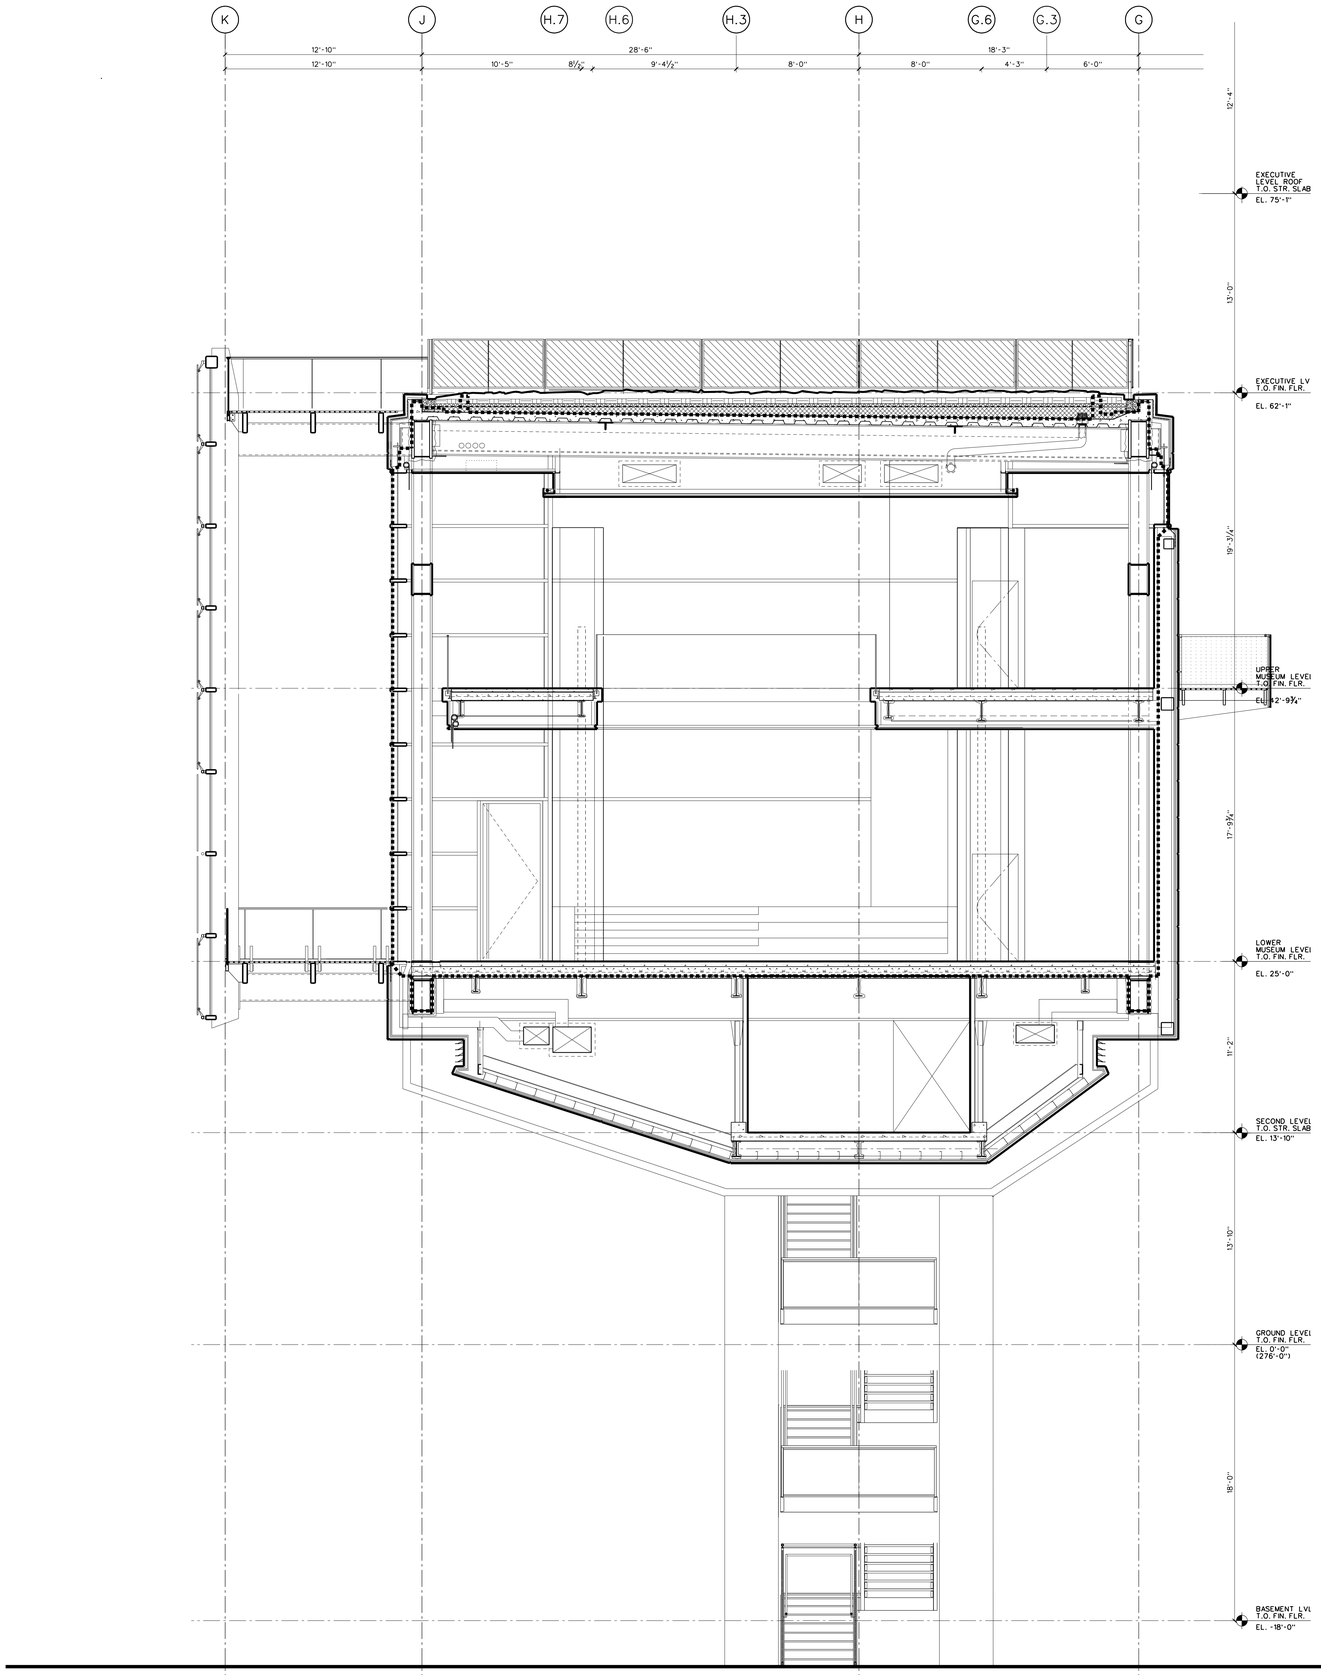

BRIDGE BUILDING: DETAIL SECTION EAST-WEST LOOKING NORTH THROUGH SKY LOBBY

SCALE: ¼" = 1'-0"

10

BASE\ELEV\B-SECT-EW05

WILLIAM J. CLINTON PRESIDENTIAL CENTER

LITTLE ROCK, ARKANSAS

Architect

POLSHEK PARTNERSHIP LLP
320 West 13th Street
New York, New York 10014
212.807.7171

Coordinating Architects

POLK STANLEY YEARY ARCHITECTS Ltd
700 South Schiller Street
Little Rock, Arkansas 72201
501.378.0878

WITSELL EVANS RASCO
901 West Third Street
Little Rock, Arkansas 72201
501.374.5300

WOODS CARADINE ARCHITECTS
2200 South Main Street
Little Rock, Arkansas 72206
501.374.4060

Landscape Architects

HARGREAVES ASSOCIATES
118 Magazine Street
Cambridge, Massachusettes 02139
617.661.0070

LANDSCAPE ARCHITECTURE, Inc.
2300 Cottondale Lane Suite 202
Little Rock, Arkansas 72202
501.374.5610

Structural Engineer

LESLIE E. ROBERTSON ASSOC., RLLP
30 Bread Street, 47th Floor
New York, New York 10004
212.750.9000

MEP Engineers

FLACK + KURTZ Inc.
475 Fifth Avenue
New York, New York 10017
212.532.9600


CROMWELL ARCHITECTS ENGINEERS
101 South Spring Street
Little Rock, Arkansas 72201
501.372.2900

Curtainwall Consultant

R. A. HEINTGES ARCHITECTS
126 Fifth Avenue, 9th Floor
New York, New York 10011
212.852-2966

Seal

Issue	Date
100% Construction Documents	09/27/02
90% Progress Printing	08/30/02
ASI #05	08/20/02
100% Struct./ CD Progress	07/01/02
Bridge Bldg. Substructure	06/14/02
100% Steel & Concrete CD	05/15/02
& Architectural CD Progress	
100% Design Development	03/01/02

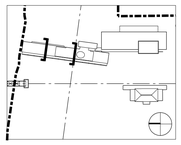

Job No. 9908

Scale 1/4" = 1'-0"

Date September 27, 2002


Title

BRIDGE BUILDING SECTIONS

Sheet No.

A300

FOR OFFICIAL USE ONLY

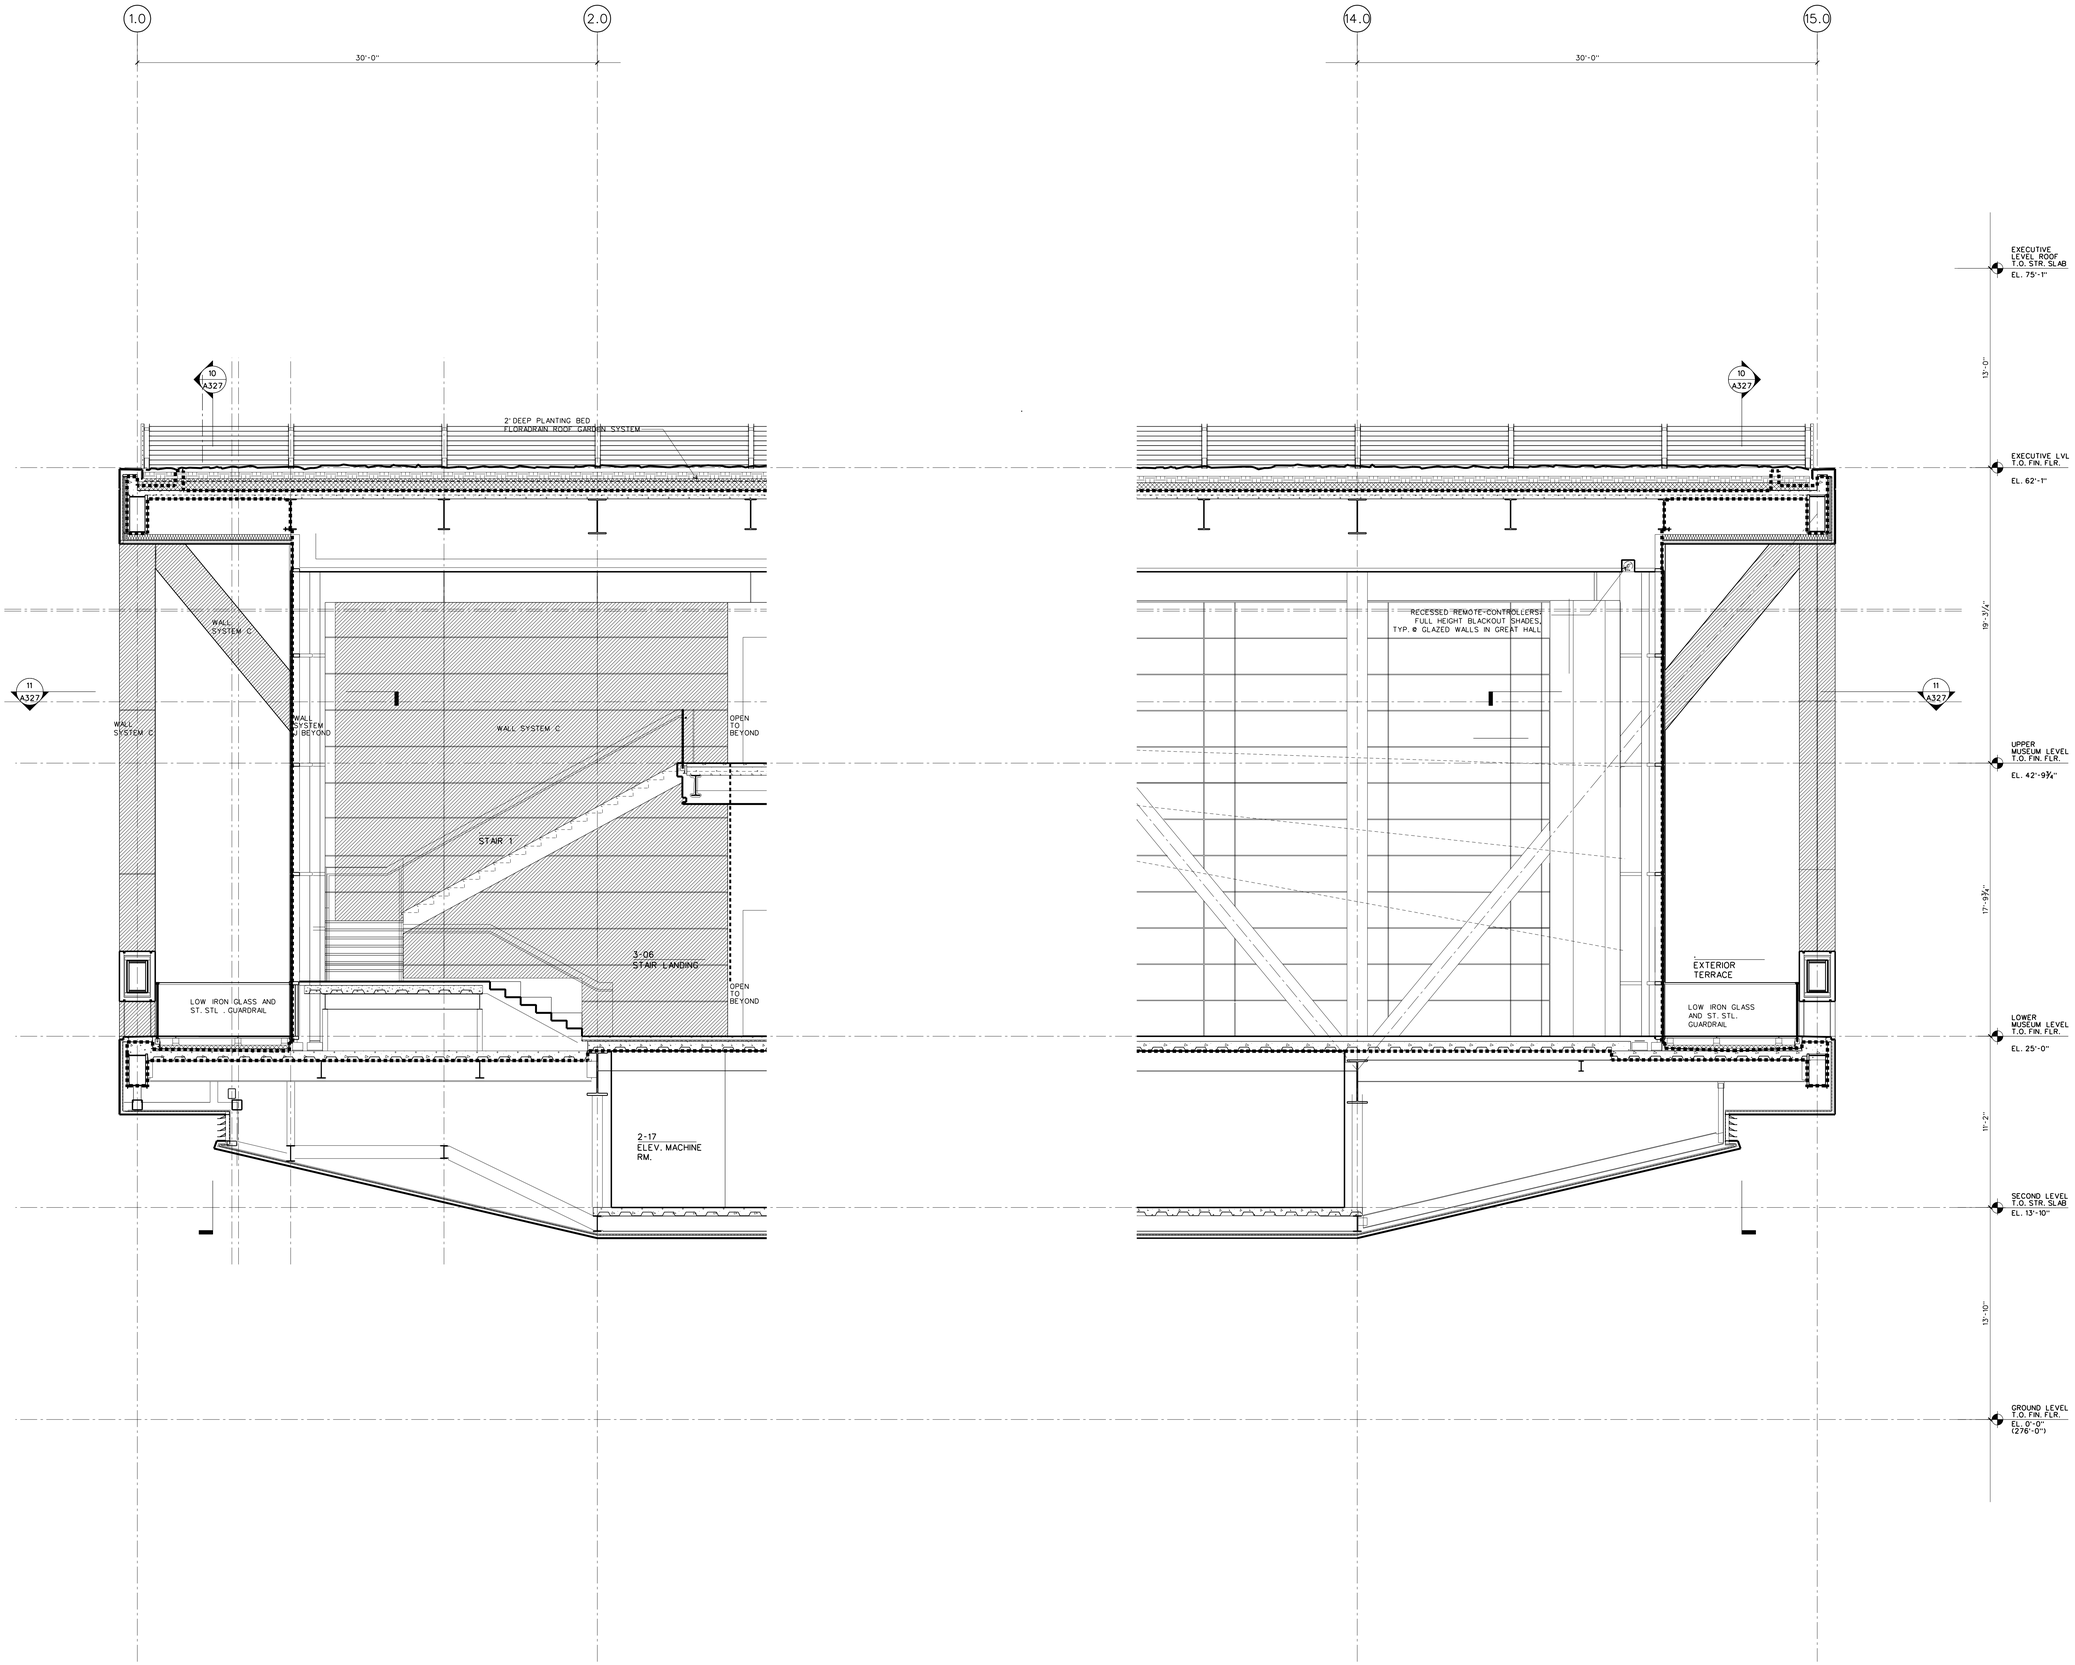

BRIDGE BUILDING: DETAIL SECTION NORTH-SOUTH LOOKING EAST AT MUSEUM

SCALE: 1/4" = 1'-0"

B-SECT-NS01 11

BRIDGE BUILDING: DETAIL SECTION NORTH-SOUTH LOOKING EAST AT GREAT HALL

SCALE: 1/4" = 1'-0"

B-SECT-NS01 10

WILLIAM J. CLINTON PRESIDENTIAL CENTER

LITTLE ROCK, ARKANSAS

Architect

POLSHEK PARTNERSHIP LLP
320 West 13th Street
New York, New York 10014
212.807.7171

Coordinating Architects

POLK STANLEY YEARY ARCHITECTS Ltd
700 South Schiller Street
Little Rock, Arkansas 72201
501.378.0878

WITSELL EVANS RASCO
901 West Third Street
Little Rock, Arkansas 72201
501.374.5300

WOODS CARADINE ARCHITECTS
2200 South Main Street
Little Rock, Arkansas 72206
501.374.4060

Landscape Architects

HARGREAVES ASSOCIATES
118 Magazine Street
Cambridge, Massachusettes 02139
617.661.0070

LANDSCAPE ARCHITECTURE, Inc.
2300 Cottondale Lane Suite 202
Little Rock, Arkansas 72202
501.374.5610

Structural Engineer

LESLIE E. ROBERTSON ASSOC., RLLP
30 Broad Street, 47th Floor
New York, New York 10004
212.750.9000

MEP Engineers

FLACK + KURTZ Inc.
475 Fifth Avenue
New York, New York 10017
212.532.9600


CROMWELL ARCHITECTS ENGINEERS
101 South Spring Street
Little Rock, Arkansas 72201
501.372.2900

Curtainwall Consultant

R. A. HEINTGES ARCHITECTS
126 Fifth Avenue, 9th Floor
New York, New York 10011
212.652-2966

Seal

Issue	Date
100% Construction Documents	09/27/02
90% Progress Printing	08/30/02
ASI #05	08/20/02
100% Struct./ CD Progress	07/01/02
Bridge Bldg. Substructure	06/14/02
100% Steel & Concrete CD & Architectural CD Progress	05/15/02
100% Design Development	03/01/02

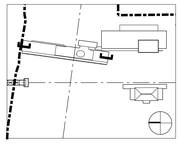

Job No. 9908

Scale 1/4" = 1'-0"

Date September 27, 2002


Title

BRIDGE BUILDING PARTIAL SECTION

Sheet No.

A301

FOR OFFICIAL USE ONLY

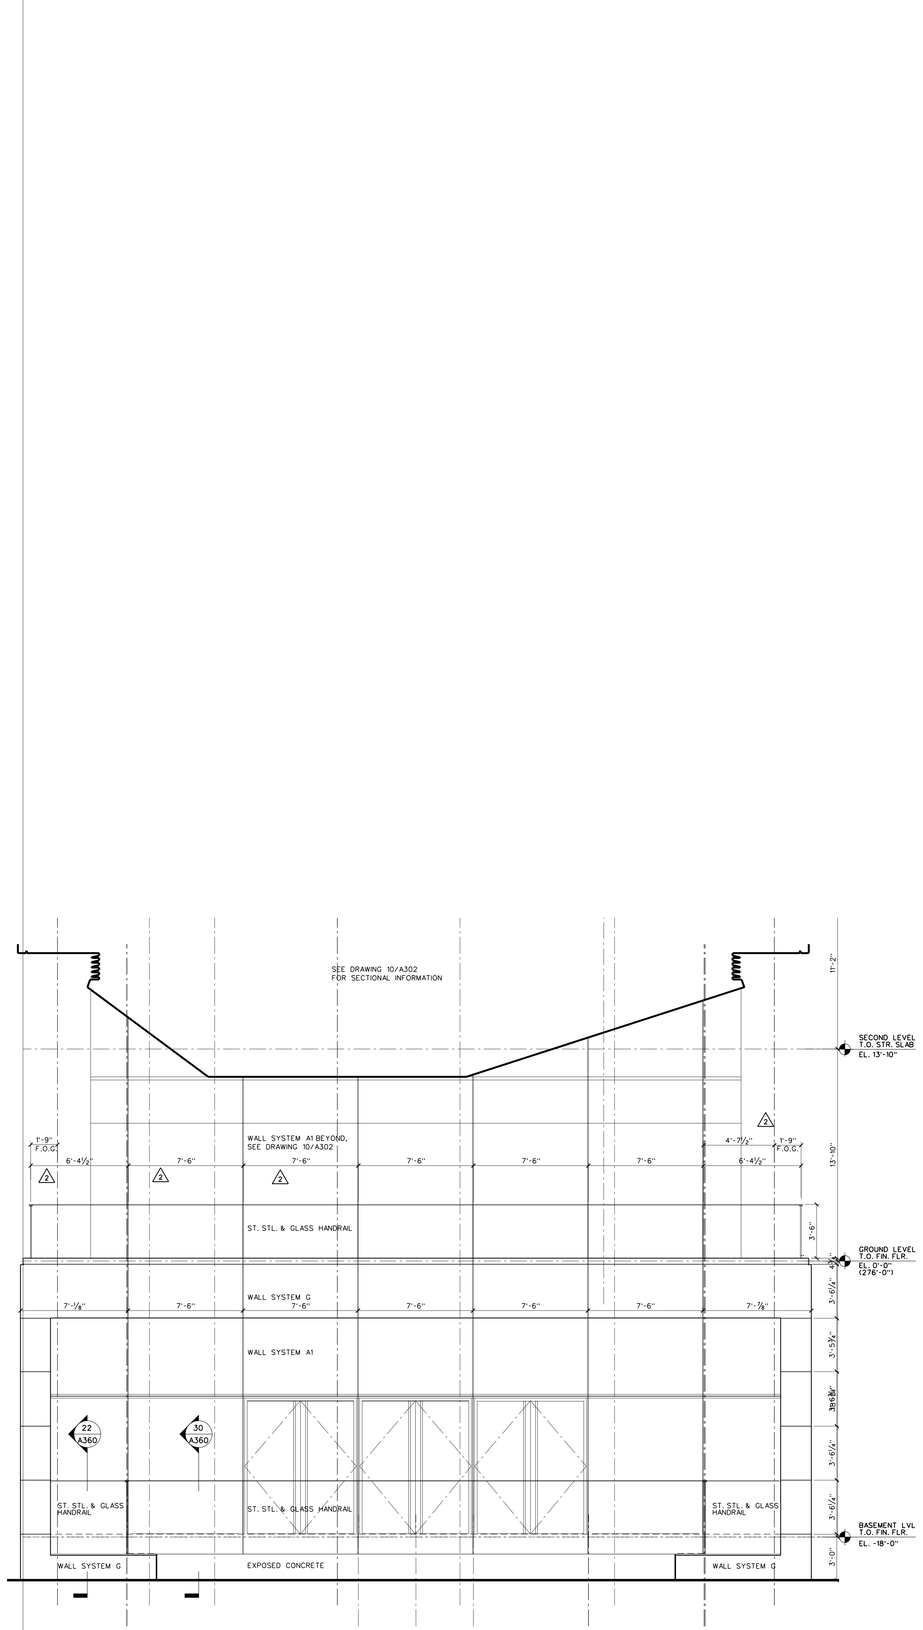


BRIDGE BUILDING: DETAIL SECTION EAST-WEST LOOKING SOUTH AT CAFE ELEVATION

SCALE: 1/4" = 1'-0"

B-SECT-EW08

11

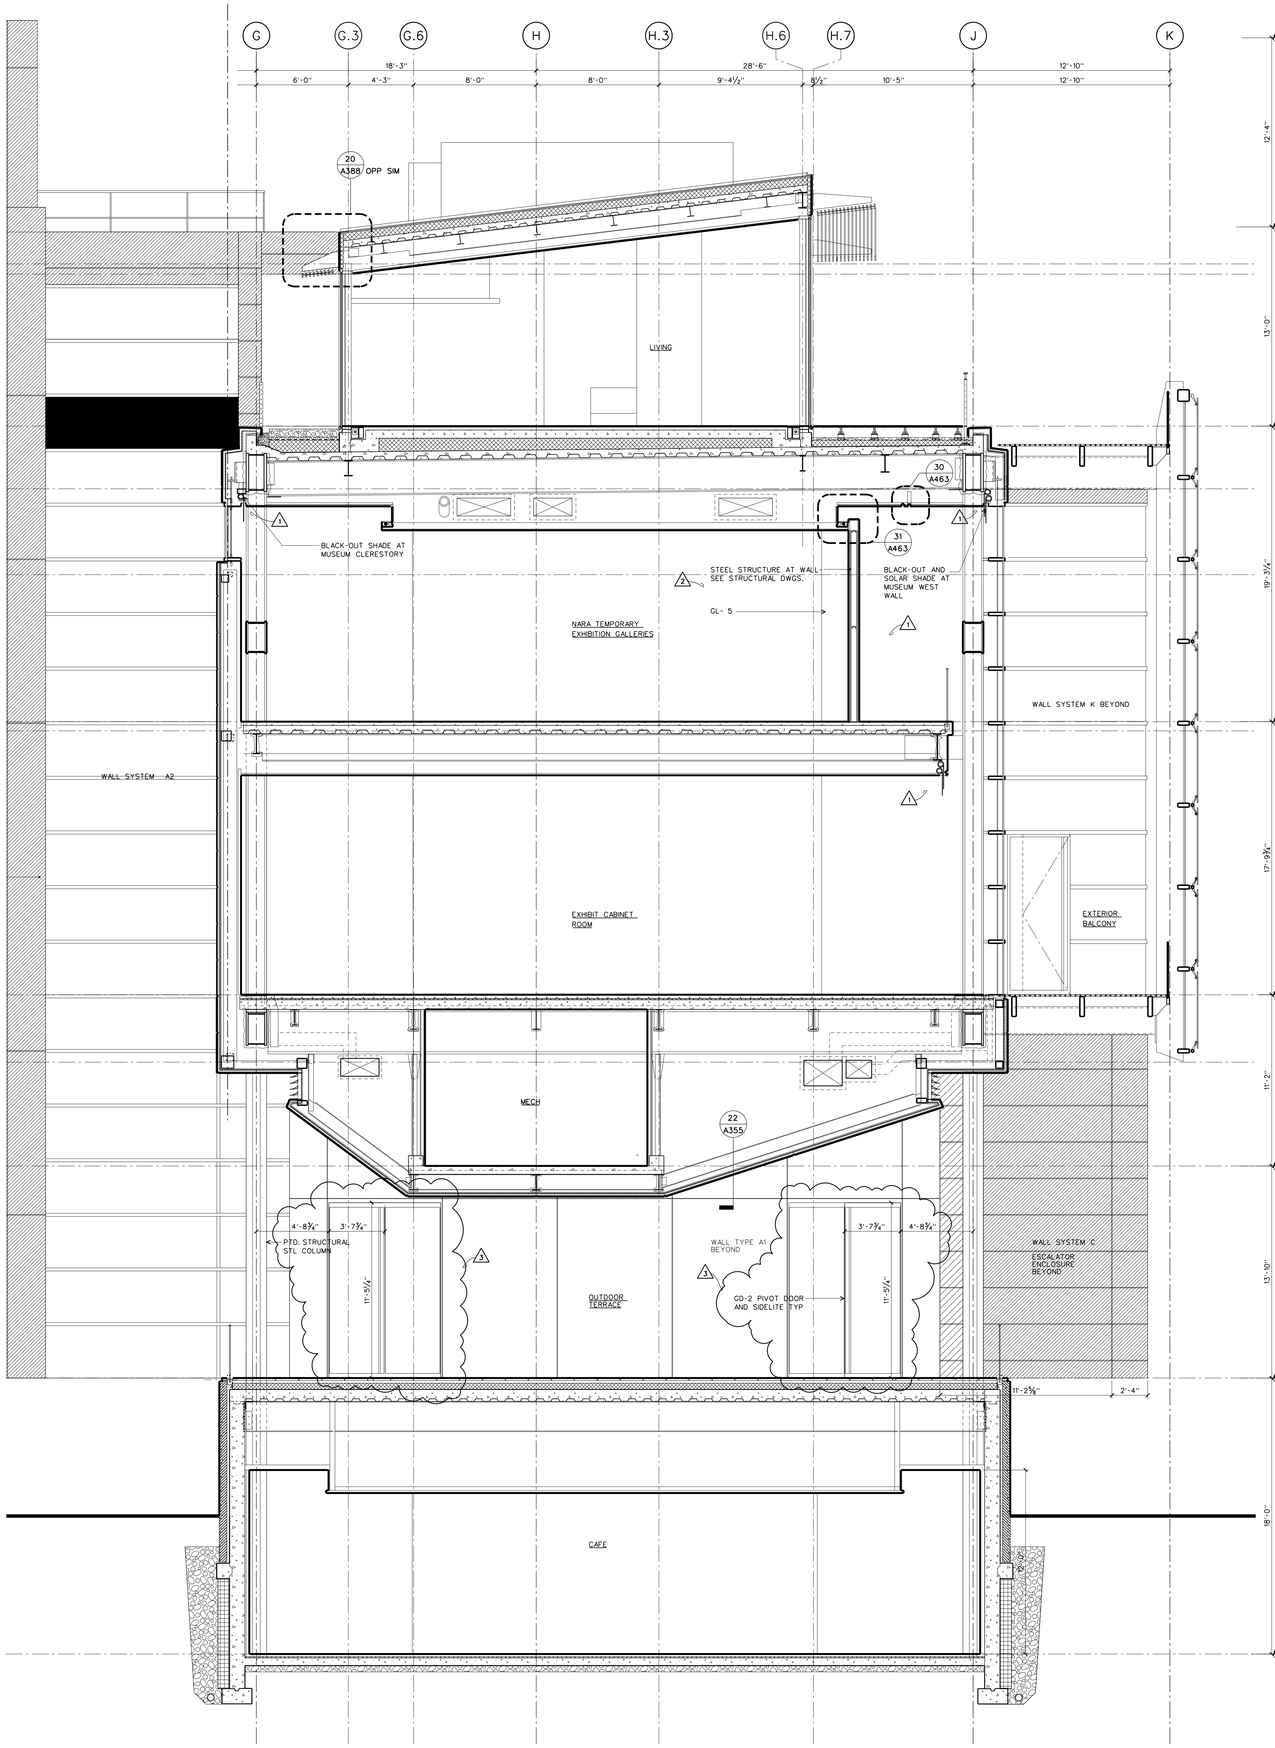

BRIDGE BUILDING: DETAIL SECTION EAST-WEST LOOKING SOUTH THROUGH TEMPORARY GALLERY

SCALE: 1/4" = 1'-0"

B-SECT-EW02

10

WILLIAM J. CLINTON PRESIDENTIAL CENTER

LITTLE ROCK, ARKANSAS

Architect

POLSHEK PARTNERSHIP LLP
320 West 13th Street
New York, New York 10014
212.807.7171

Coordinating Architects

POLK STANLEY YEARY ARCHITECTS Ltd
700 South Schiller Street
Little Rock, Arkansas 72201
501.378.0878

WITSELL EVANS RASCO
901 West Third Street
Little Rock, Arkansas 72201
501.374.5300

WOODS CARADINE ARCHITECTS
2200 South Main Street
Little Rock, Arkansas 72206
501.374.4060

Landscape Architects

HARGREAVES ASSOCIATES
118 Magazine Street
Cambridge, Massachusettes 02139
617.661.0070

LANDSCAPE ARCHITECTURE, Inc.
2300 Cottondale Lane Suite 202
Little Rock, Arkansas 72202
501.374.5610

Structural Engineer

LESLIE E. ROBERTSON ASSOC., RLLP
30 Broad Street, 47th Floor
New York, New York 10004
212.750.9000

MEP Engineers

FLACK + KURTZ Inc.
475 Fifth Avenue
New York, New York 10017
212.532.9600


CROMWELL ARCHITECTS ENGINEERS
101 South Spring Street
Little Rock, Arkansas 72201
501.372.2900

Curtainwall Consultant

R. A. HEINTGES ARCHITECTS
126 Fifth Avenue, 9th Floor
New York, New York 10011
212.652-2966

Seal

Issue	Date
3 ASI #25	12/19/03
2 ASI #23	09/12/03
1 Addendum #2	11/15/02
100% Construction Documents	09/27/02
90% Progress Printing	08/30/02
100% Struct./ CD Progress	07/01/02
Bridge Bldg. Substructure	06/14/02
100% Steel & Concrete CD	05/15/02
& Architectural CD Progress	
100% Design Development	03/01/02

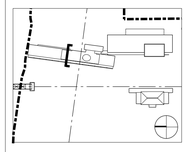

Job No. 9908

Scale 1/4" = 1'-0"

Date September 27, 2002


Title

MUSEUM BUILDING SECTIONS

Sheet No.

A302

FOR OFFICIAL USE ONLY

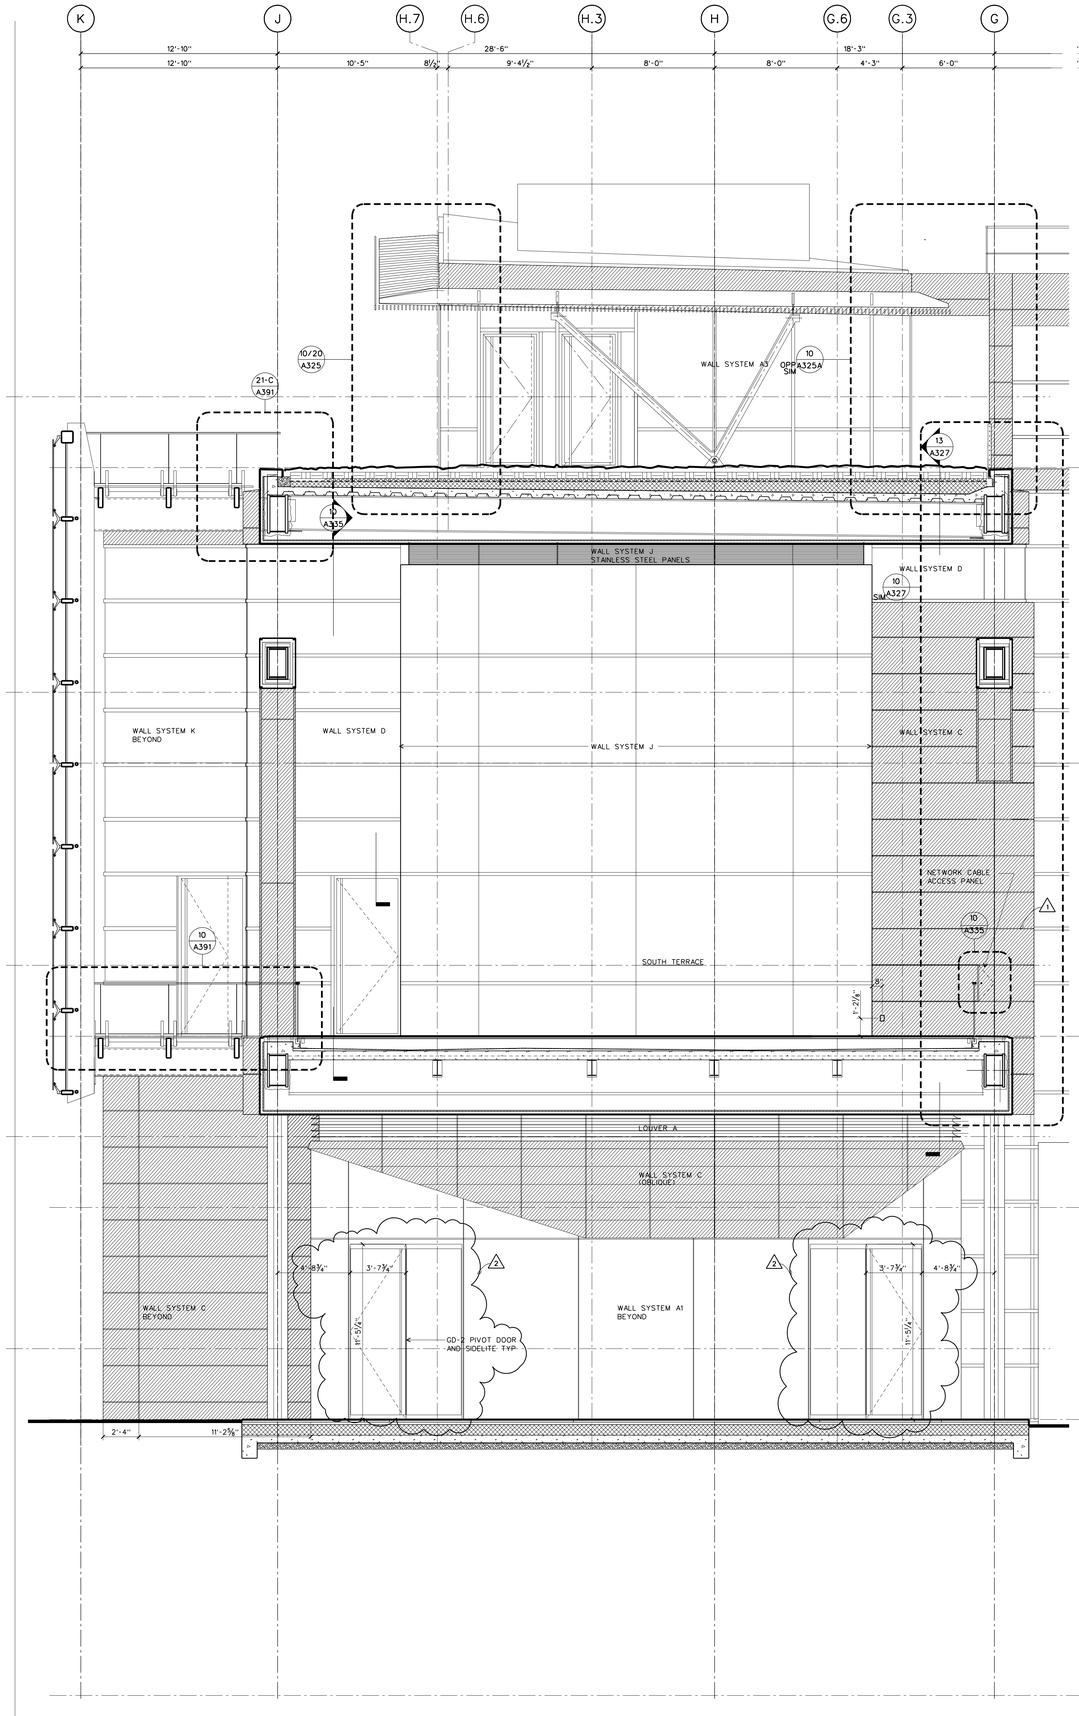


BRIDGE BUILDING: DETAIL SECTION EAST-WEST LOOKING NORTH THROUGH SOUTH END

SCALE: ¼" = 1'-0"

B-SECT-EW07

11

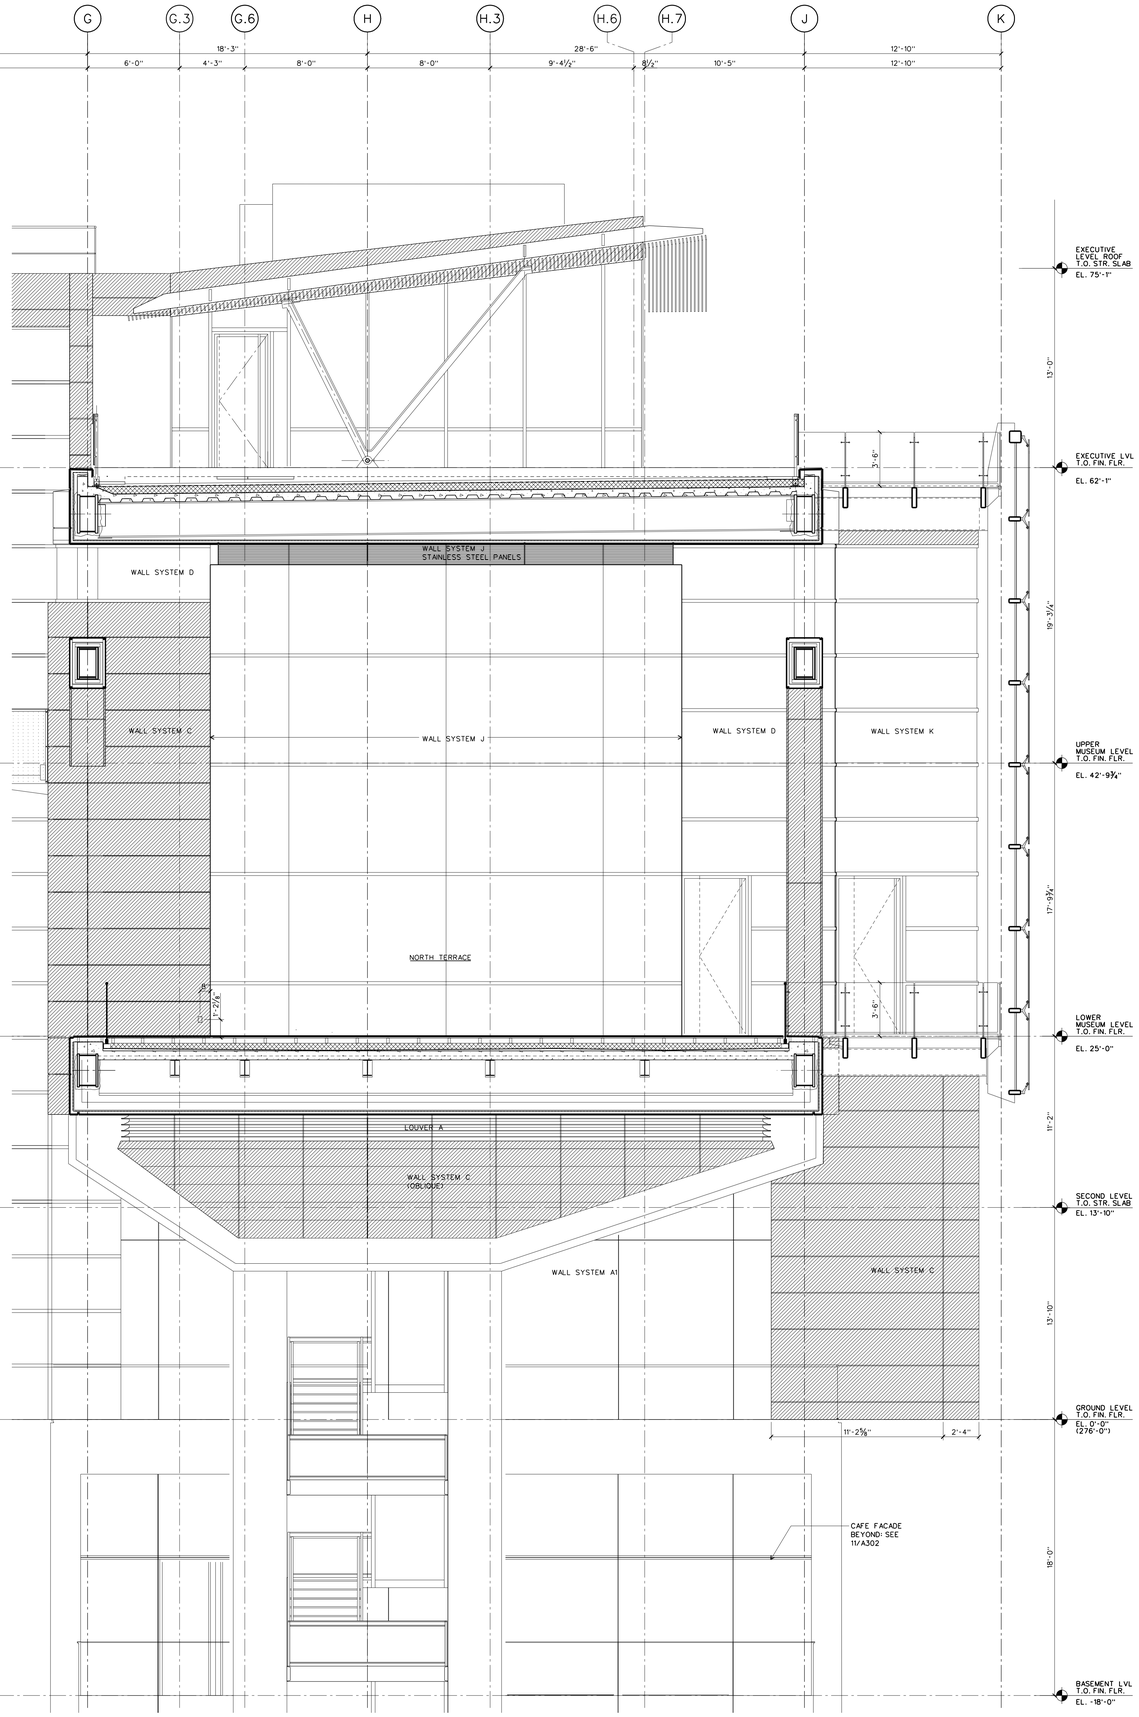

BRIDGE BUILDING: DETAIL SECTION EAST-WEST LOOKING SOUTH THROUGH NORTH END

SCALE: ¼" = 1'-0"

B-SECT-EW06

10

WILLIAM J. CLINTON PRESIDENTIAL CENTER

LITTLE ROCK, ARKANSAS

Architect

POLSHEK PARTNERSHIP LLP
320 West 13th Street
New York, New York 10014
212.807.7171

Coordinating Architects

POLK STANLEY YEARY ARCHITECTS Ltd
700 South Schiller Street
Little Rock, Arkansas 72201
501.378.0878

WITSELL EVANS RASCO
901 West Third Street
Little Rock, Arkansas 72201
501.374.5300

WOODS CARADINE ARCHITECTS
2200 South Main Street
Little Rock, Arkansas 72206
501.374.4060

Landscape Architects

HARGREAVES ASSOCIATES
118 Magazine Street
Cambridge, Massachusettes 02139
617.661.0070

LANDSCAPE ARCHITECTURE, Inc.
2300 Cottondale Lane Suite 202
Little Rock, Arkansas 72202
501.374.5610

Structural Engineer

LESLIE E. ROBERTSON ASSOC., RLLP
30 Broad Street, 47th Floor
New York, New York 10004
212.750.9000

MEP Engineers

FLACK + KURTZ Inc.
475 Fifth Avenue
New York, New York 10017
212.532.9600


CROMWELL ARCHITECTS ENGINEERS
101 South Spring Street
Little Rock, Arkansas 72201
501.372.2900

Curtainwall Consultant

R. A. HEINTGES ARCHITECTS
126 Fifth Avenue, 9th Floor
New York, New York 10011
212.652-2966

Seal

Issue	Date
2 ASI # 25	12/19/03
1 ASI # 22	08/01/03
100% Construction Documents	09/27/02
90% Progress Printing	08/30/02
100% Struct./ CD Progress	07/01/02
100% Steel & Concrete CD	05/15/02
& Architectural CD Progress	
100% Design Development	03/01/02

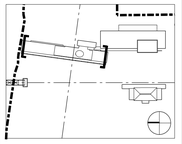

Job No. 9908

Scale 1/4" = 1'-0"

Date September 27, 2002


Title

MUSEUM BUILDING SECTIONS

Sheet No.

A303

FOR OFFICIAL USE ONLY

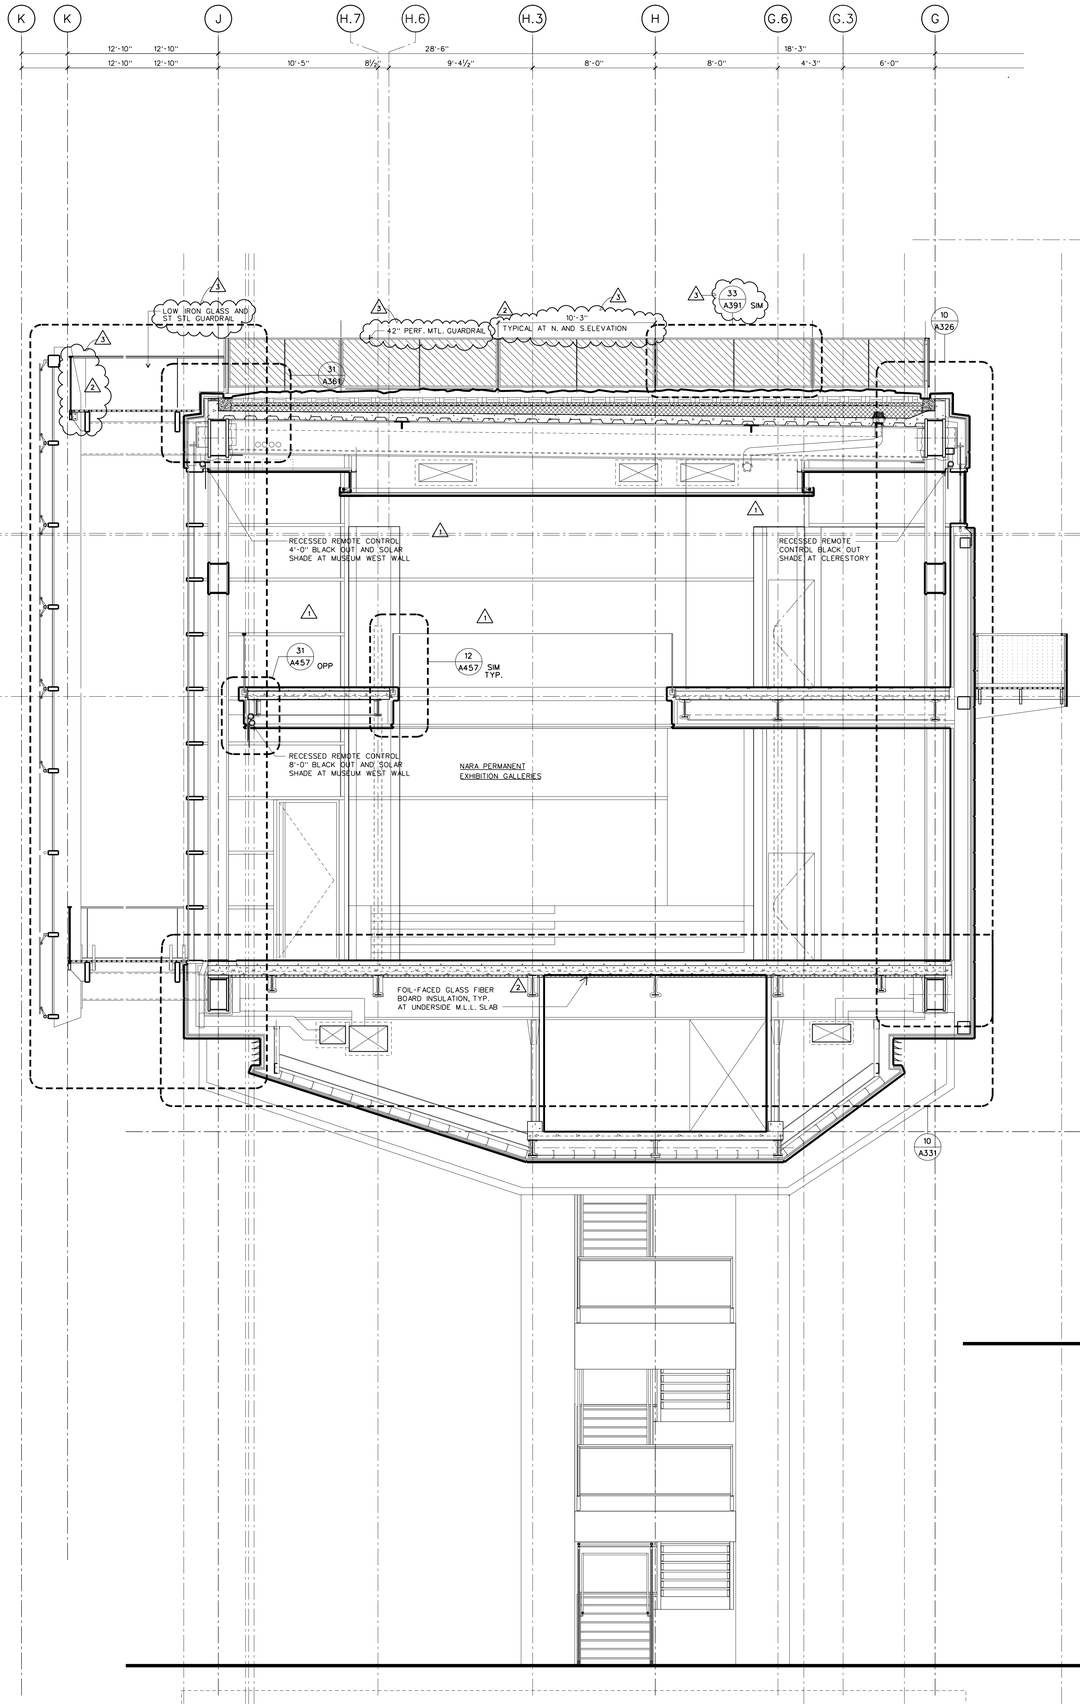


BRIDGE BUILDING: DETAIL SECTION EAST-WEST LOOKING NORTH THROUGH MUSEUM

SCALE: 1/4" = 1'-0"

B-SECT-EW01

11

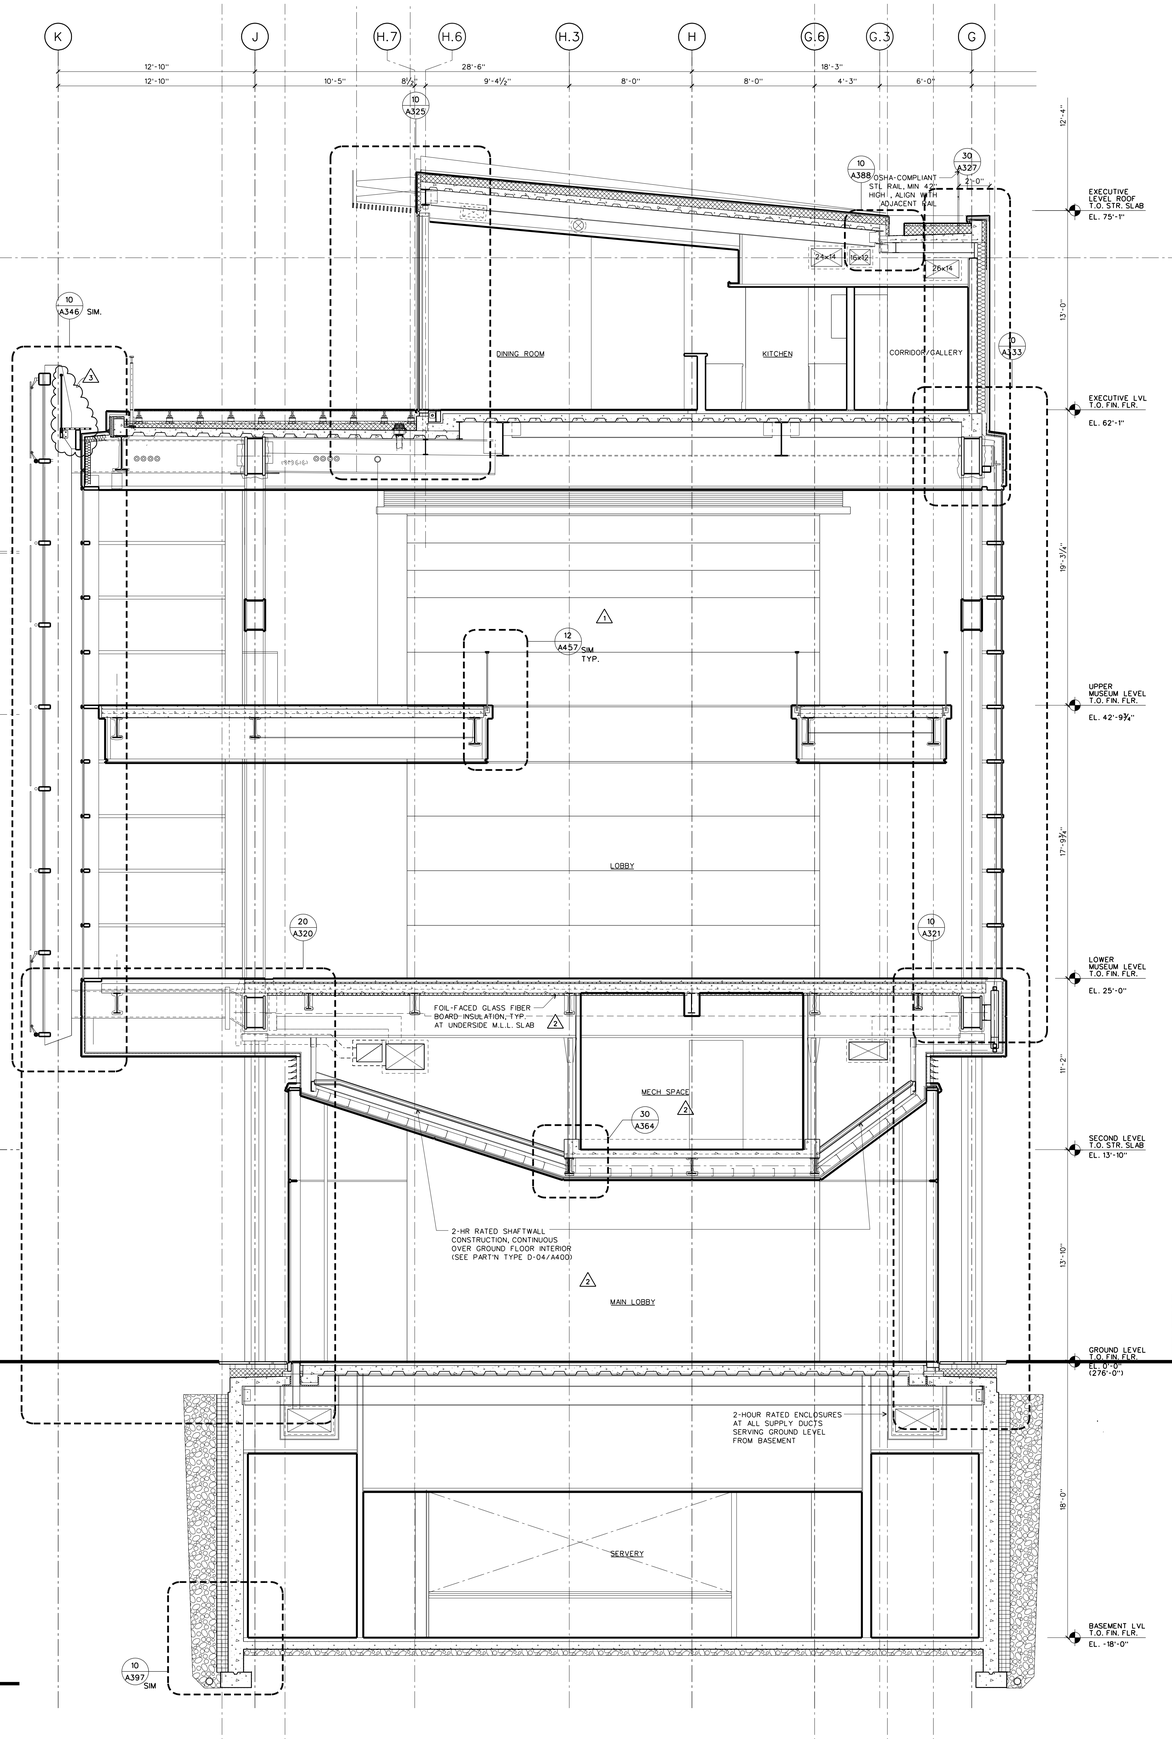

BRIDGE BUILDING: DETAIL SECTION EAST-WEST LOOKING NORTH THROUGH SKY LOBBY

SCALE: 1/4" = 1'-0"

BASE\ELEV\B-SECT-EW05

10

WILLIAM J. CLINTON PRESIDENTIAL CENTER

LITTLE ROCK, ARKANSAS

Architect

POLSHEK PARTNERSHIP LLP
320 West 13th Street
New York, New York 10014
212.807.7171

Coordinating Architects

POLK STANLEY YEARY ARCHITECTS Ltd
700 South Schiller Street
Little Rock, Arkansas 72201
501.378.0878

WITSELL EVANS RASCO
901 West Third Street
Little Rock, Arkansas 72201
501.374.5300

WOODS CARADINE ARCHITECTS
2200 South Main Street
Little Rock, Arkansas 72206
501.374.4060

Landscape Architects

HARGREAVES ASSOCIATES
118 Magazine Street
Cambridge, Massachusettes 02139
617.661.0070

LANDSCAPE ARCHITECTURE, Inc.
2300 Cottondale Lane Suite 202
Little Rock, Arkansas 72202
501.374.5610

Structural Engineer

LESLIE E. ROBERTSON ASSOC., RLLP
30 Broad Street, 47th Floor
New York, New York 10004
212.750.9000

MEP Engineers

FLACK + KURTZ Inc.
475 Fifth Avenue
New York, New York 10017
212.532.9600


CROMWELL ARCHITECTS ENGINEERS
101 South Spring Street
Little Rock, Arkansas 72201
501.372.2900

Curtainwall Consultant

R. A. HEINTGES ARCHITECTS
126 Fifth Avenue, 9th Floor
New York, New York 10011
212.652-2966

Seal

Issue	Date
3 ASI #20	06/06/03
2 ASI #18	04/18/03
1 Addendum #2	11/15/02
100% Construction Documents	09/27/02
90% Progress Printing	08/30/02
100% Struct./ CD Progress	07/01/02
Bridge Bldg. Substructure	06/14/02
100% Steel & Concrete CD & Architectural CD Progress	05/15/02
100% Design Development	03/01/02

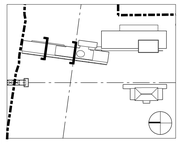

Job No. 9908

Scale 1/4" = 1'-0"

Date September 27, 2002


Title

MUSEUM BUILDING SECTIONS

Sheet No.

A304

FOR OFFICIAL USE ONLY

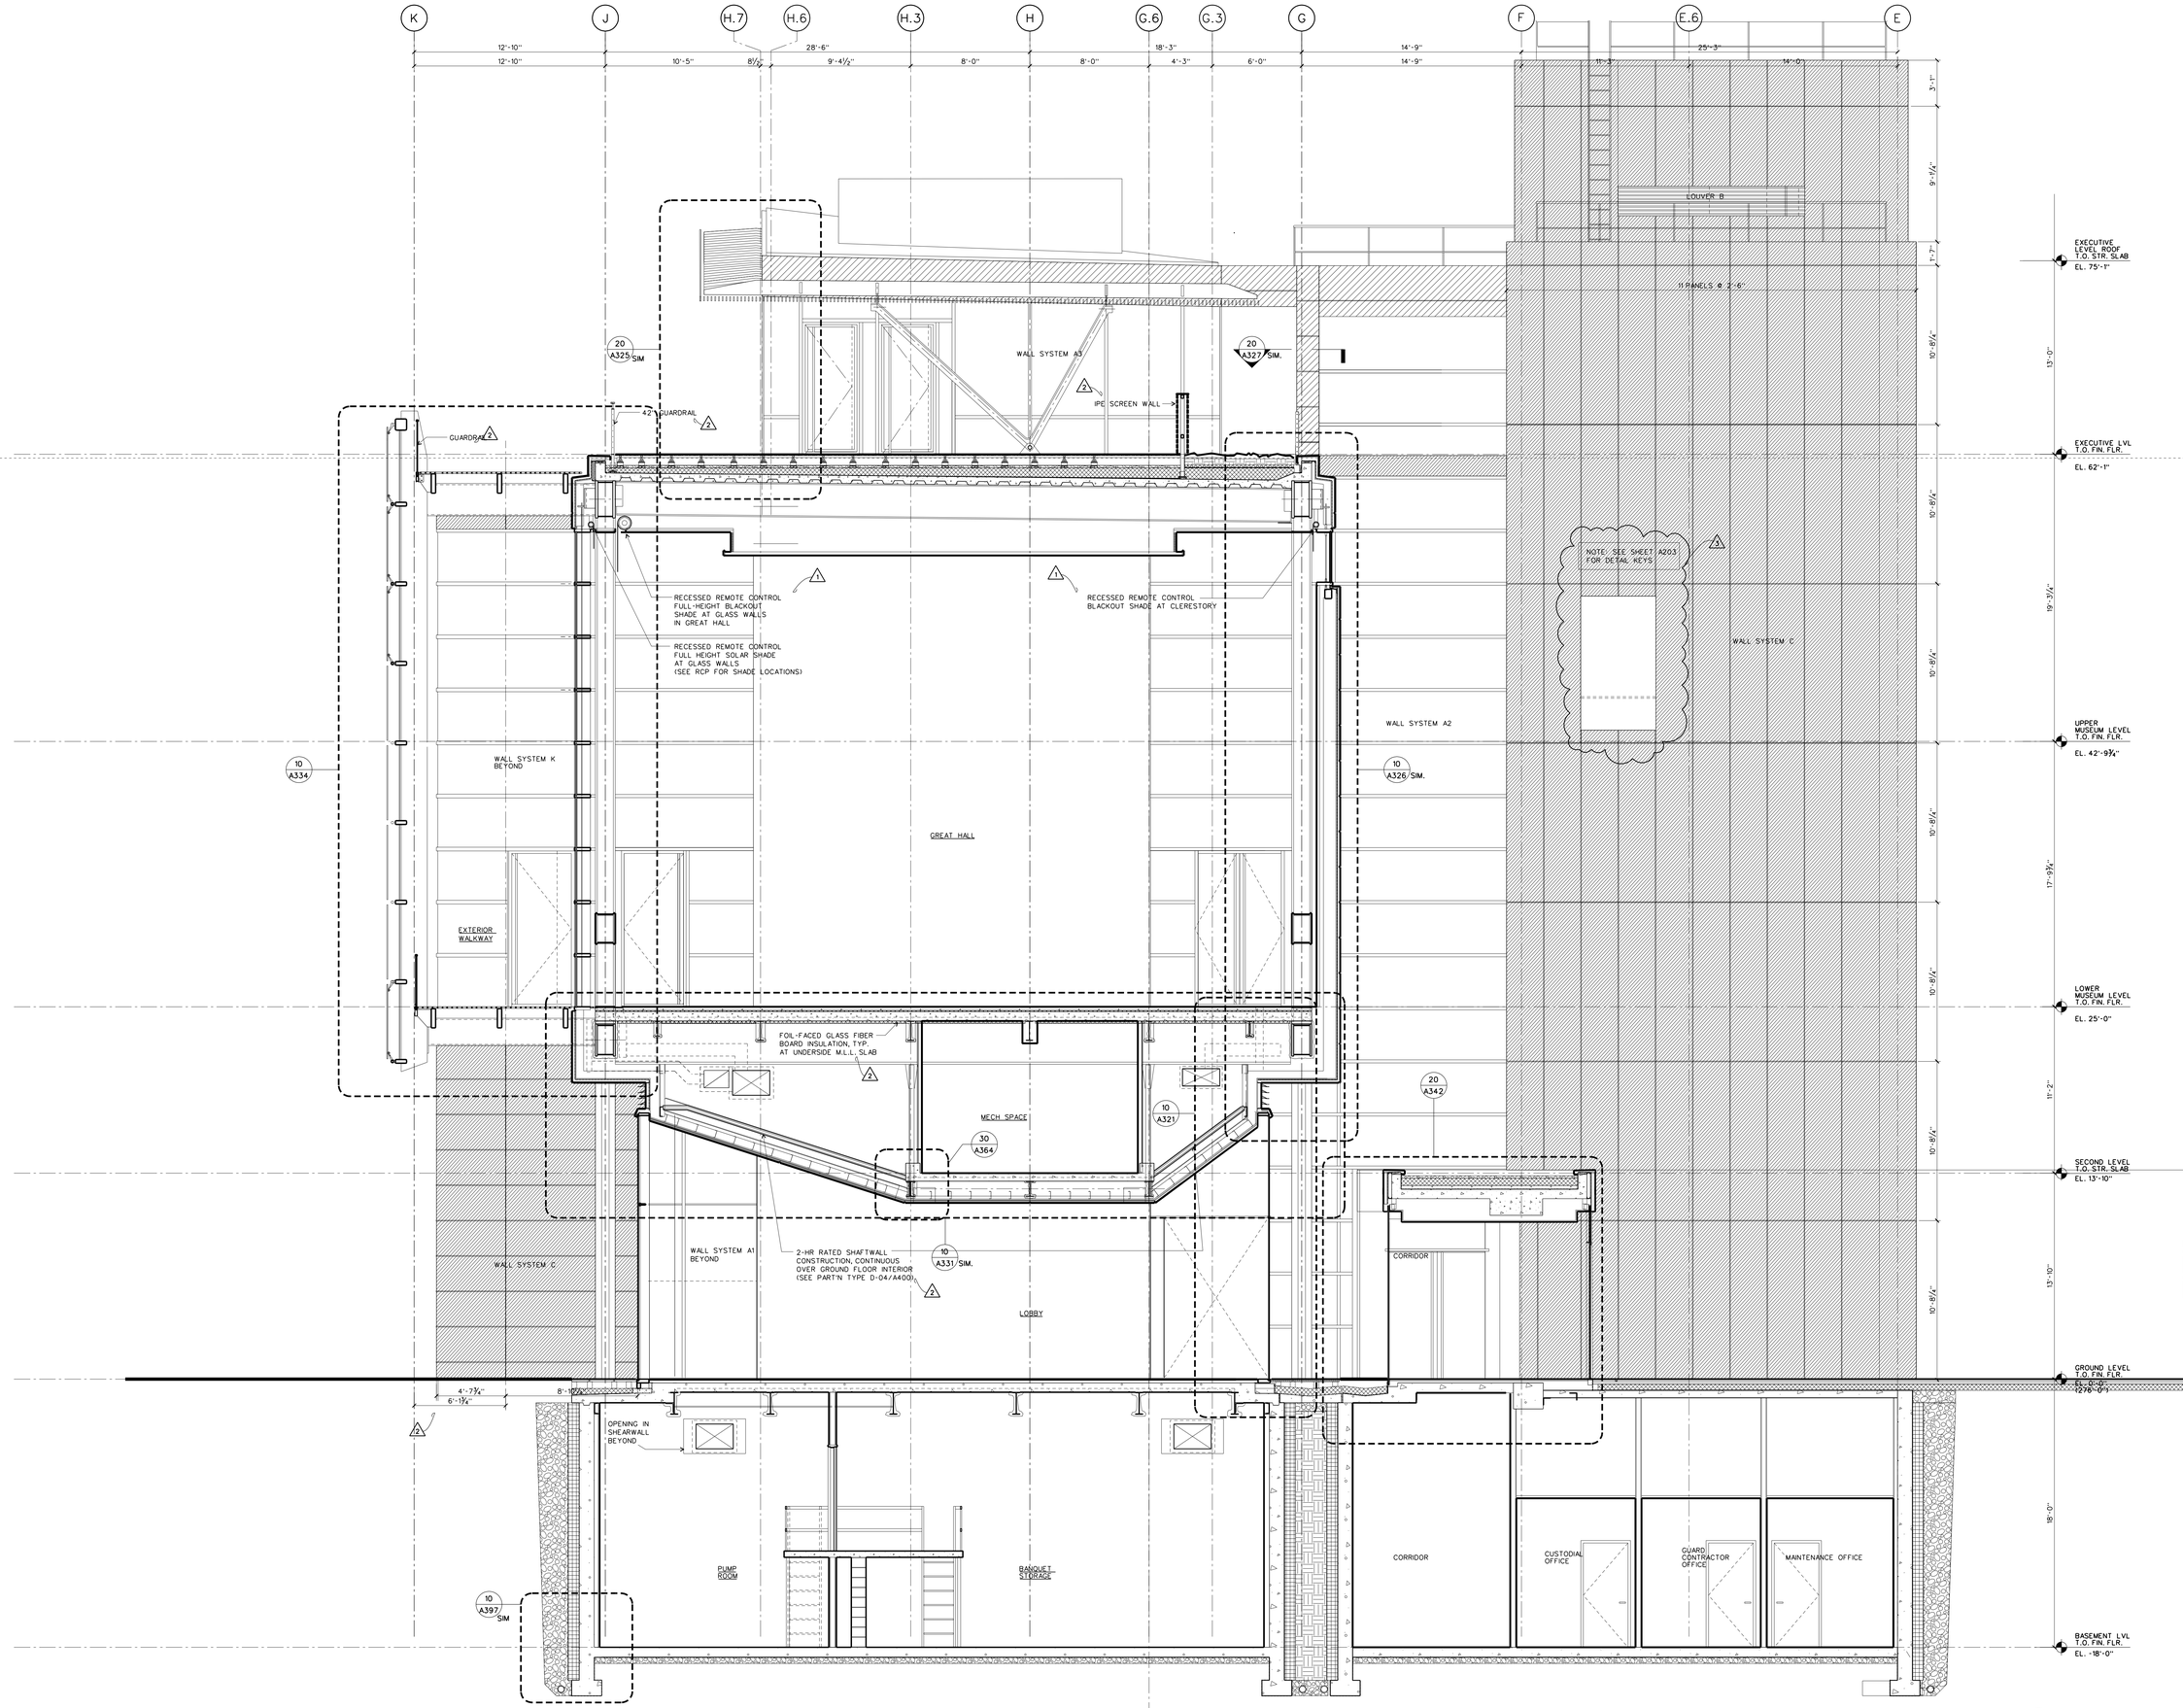

BRIDGE BUILDING: DETAIL SECTION EAST-WEST LOOKING NORTH THROUGH GREAT HALL

SCALE: 1/4" = 1'-0"

B-SECT-EW04

10

FOR OFFICIAL USE ONLY

WILLIAM J. CLINTON PRESIDENTIAL CENTER

LITTLE ROCK, ARKANSAS

Architect

POLSHEK PARTNERSHIP LLP
320 West 13th Street
New York, New York 10014
212.807.7171

Coordinating Architects

POLK STANLEY YEARY ARCHITECTS Ltd
700 South Schiller Street
Little Rock, Arkansas 72201
501.378.0878

WITSELL EVANS RASCO
901 West Third Street
Little Rock, Arkansas 72201
501.374.5300

WOODS CARADINE ARCHITECTS
2200 South Main Street
Little Rock, Arkansas 72206
501.374.4060

Landscape Architects

HARGREAVES ASSOCIATES
118 Magazine Street
Cambridge, Massachusettes 02139
617.661.0070

LANDSCAPE ARCHITECTURE, Inc.
2300 Cottondale Lane Suite 202
Little Rock, Arkansas 72202
501.374.5610

Structural Engineer

LESLIE E. ROBERTSON ASSOC., RLLP
30 Broad Street, 47th Floor
New York, New York 10004
212.750.9000

MEP Engineers

FLACK + KURTZ Inc.
475 Fifth Avenue
New York, New York 10017
212.532.9600

CROMWELL ARCHITECTS ENGINEERS
101 South Spring Street
Little Rock, Arkansas 72201
501.372.2900

Curtainwall Consultant

R. A. HEINTGES ARCHITECTS
126 Fifth Avenue, 9th Floor
New York, New York 10011
212.652-2966

Seal

Issue	Date
3 ASI #23	09/12/03
2 ASI #18	04/18/03
1 Addendum #2	11/15/02
100% Construction Documents	09/27/02
90% Progress Printing	08/30/02
100% Struct./ CD Progress	07/01/02
Bridge Bldg. Substructure	06/14/02
100% Steel & Concrete CD & Architectural CD Progress	05/15/02
100% Design Development	03/01/02


Job No.
9908

Scale
1/4" = 1'-0"

Date
September 27, 2002

Title
MUSEUM BUILDING SECTIONS

Sheet No.
A305

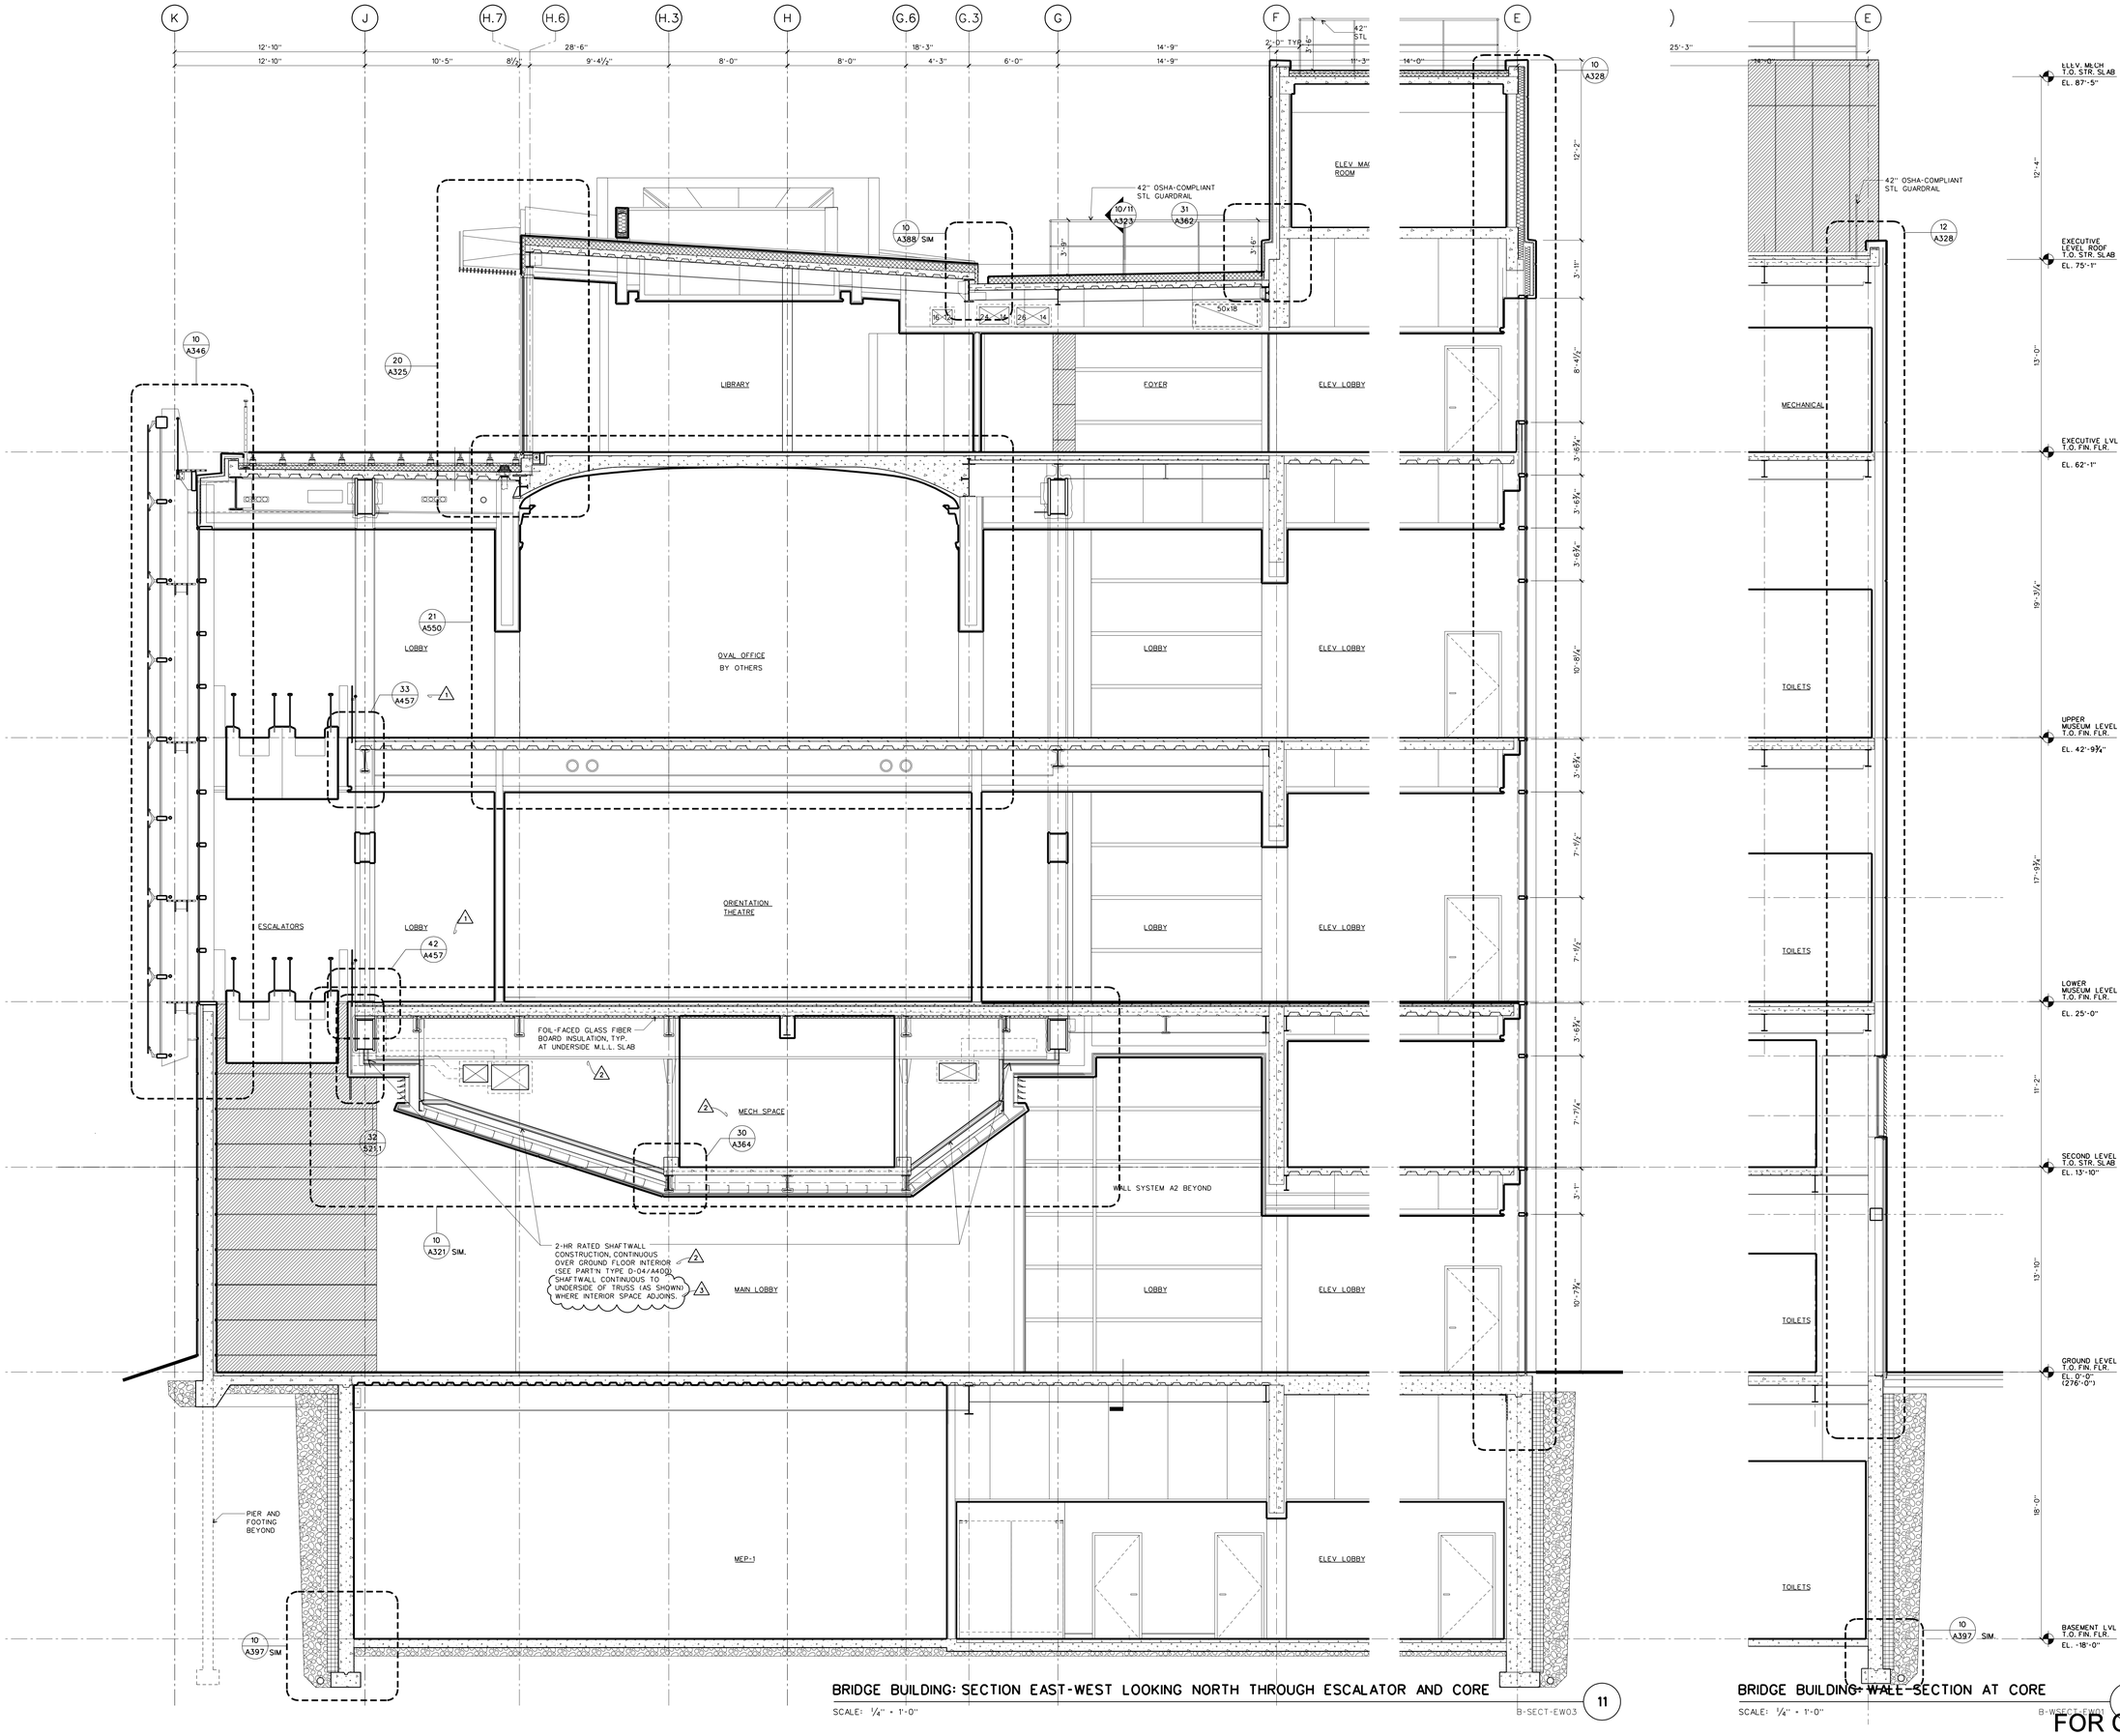

BRIDGE BUILDING: SECTION EAST-WEST LOOKING NORTH THROUGH ESCALATOR AND CORE

SCALE: ¼" = 1'-0"

B-SECT-EW03

11

BRIDGE BUILDING: WALL SECTION AT CORE

SCALE: ¼" = 1'-0"

B-WSECT-EW01

10

WILLIAM J. CLINTON PRESIDENTIAL CENTER

LITTLE ROCK, ARKANSAS

Architect

POLSHEK PARTNERSHIP LLP
320 West 13th Street
New York, New York 10014
212.807.7171

Coordinating Architects

POLK STANLEY YEARY ARCHITECTS Ltd
700 South Schiller Street
Little Rock, Arkansas 72201
501.378.0878

WITSELL EVANS RASCO
901 West Third Street
Little Rock, Arkansas 72201
501.374.5300

WOODS CARADINE ARCHITECTS
2200 South Main Street
Little Rock, Arkansas 72206
501.374.4060

Landscape Architects

HARGREAVES ASSOCIATES
118 Magazine Street
Cambridge, Massachusettes 02139
617.661.0070

LANDSCAPE ARCHITECTURE, Inc.
2300 Cottondale Lane Suite 202
Little Rock, Arkansas 72202
501.374.5610

Structural Engineer

LESLIE E. ROBERTSON ASSOC., RLLP
30 Broad Street, 47th Floor
New York, New York 10004
212.750.9000

MEP Engineers

FLACK + KURTZ Inc.
475 Fifth Avenue
New York, New York 10017
212.532.9600

CROMWELL ARCHITECTS ENGINEERS
101 South Spring Street
Little Rock, Arkansas 72201
501.372.2900

Curtainwall Consultant

R. A. HEINTGES ARCHITECTS
126 Fifth Avenue, 9th Floor
New York, New York 10011
212.652-2966

Seal

Issue	Date
3 AS1 #19	05/07/03
2 AS1 #18	04/18/03
1 Addendum #2	11/15/02
100% Construction Documents	09/27/02
90% Progress Printing	08/30/02
100% Struct./ CD Progress	07/01/02
Bridge Bldg. Substructure	06/14/02
100% Steel & Concrete CD & Architectural CD Progress	05/15/02
100% Design Development	03/01/02



Job No. 9908

Scale 1/4" = 1'-0"

Date September 27, 2002


Title

MUSEUM BUILDING SECTION

Sheet No.

A306

FOR OFFICIAL USE ONLY

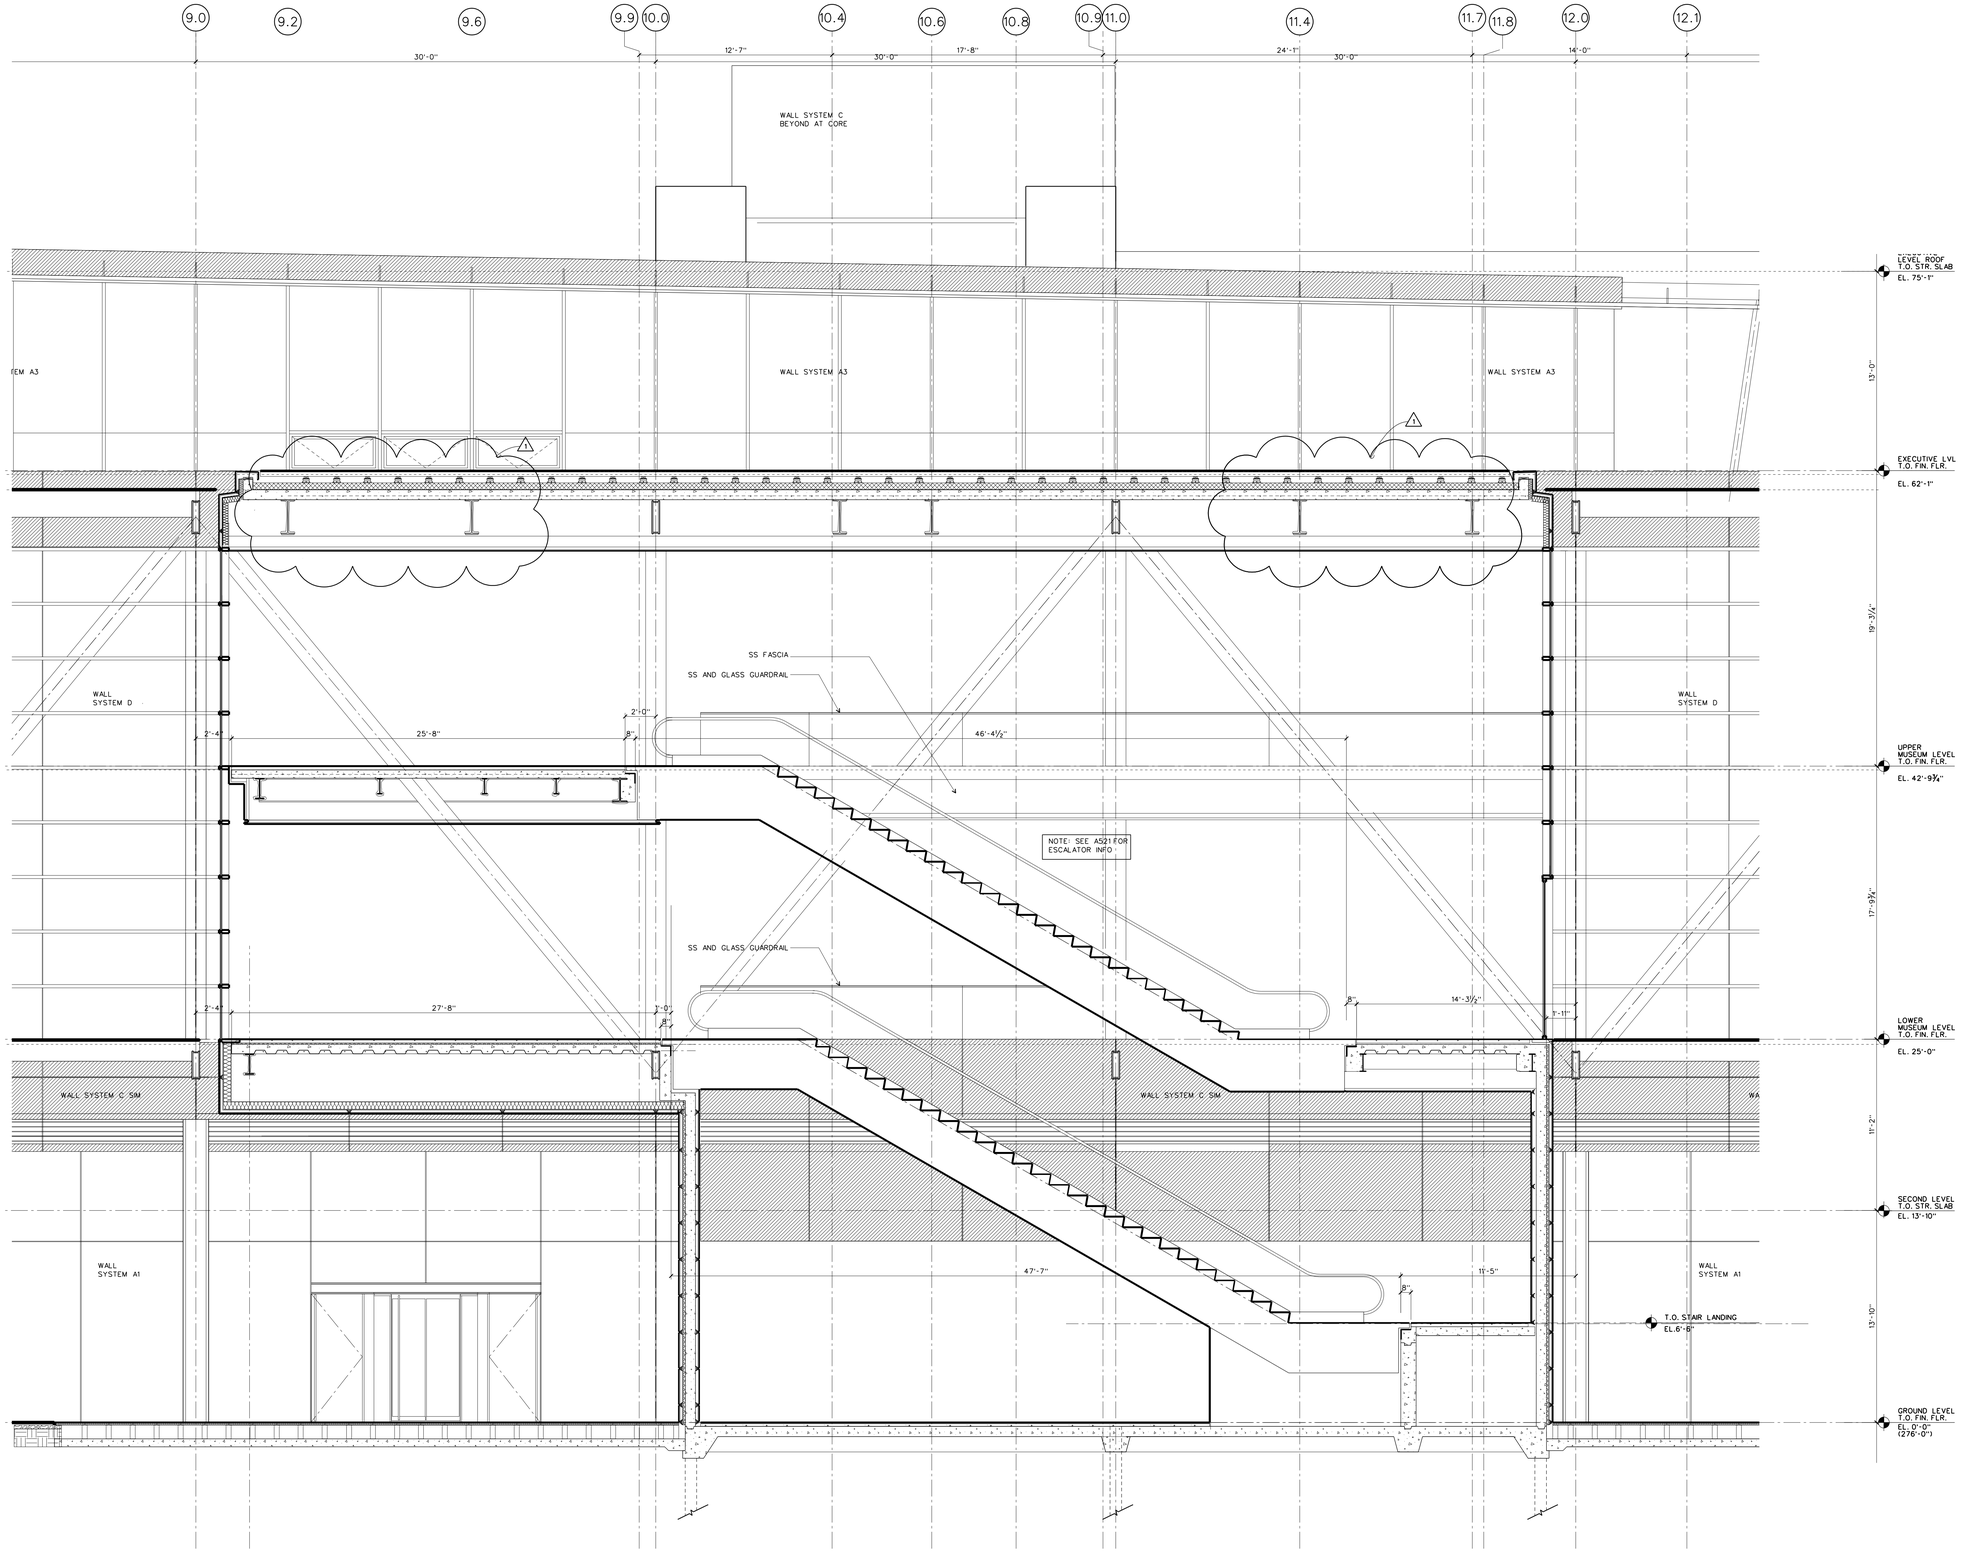

BRIDGE BUILDING: NORTH-SOUTH SECTION THROUGH ESCALATOR LOOKING EAST

SCALE: ¼" = 1'-0"

b-sect-ns06

10

FOR OFFICIAL USE ONLY

WILLIAM J. CLINTON PRESIDENTIAL CENTER

LITTLE ROCK, ARKANSAS

Architect

POLSHEK PARTNERSHIP LLP
320 West 13th Street
New York, New York 10014
212.807.7171

Coordinating Architects

POLK STANLEY YEARY ARCHITECTS Ltd
700 South Schiller Street
Little Rock, Arkansas 72201
501.378.0878

WITSELL EVANS RASCO
901 West Third Street
Little Rock, Arkansas 72201
501.374.5300

WOODS CARADINE ARCHITECTS
2200 South Main Street
Little Rock, Arkansas 72206
501.374.4060

Landscape Architects

HARGREAVES ASSOCIATES
118 Magazine Street
Cambridge, Massachusettes 02139
617.661.0070

LANDSCAPE ARCHITECTURE, Inc.
2300 Cottondale Lane Suite 202
Little Rock, Arkansas 72202
501.374.5610

Structural Engineer

LESLIE E. ROBERTSON ASSOC., RLLP
30 Broad Street, 47th Floor
New York, New York 10004
212.750.9000

MEP Engineers

FLACK + KURTZ Inc.
475 Fifth Avenue
New York, New York 10017
212.532.9600


CROMWELL ARCHITECTS ENGINEERS
101 South Spring Street
Little Rock, Arkansas 72201
501.372.2900

Curtainwall Consultant

R. A. HEINTGES ARCHITECTS
126 Fifth Avenue, 9th Floor
New York, New York 10011
212.852-2966

Seal

Issue	Date
1 Addendum #2	11/15/02
100% Construction Documents	09/27/02
90% Progress Printing	08/30/02
100% Struct./ CD Progress	07/01/02
Bridge Bldg. Substructure	06/14/02
100% Steel & Concrete CD & Architectural CD Progress	05/15/02
100% Design Development	03/01/02

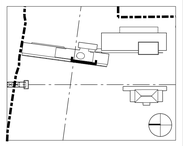

Job No. 9908

Scale 1/4" = 1'-0"


Date September 27, 2002

Title

MUSEUM BUILDING SECTION

Sheet No.

A307

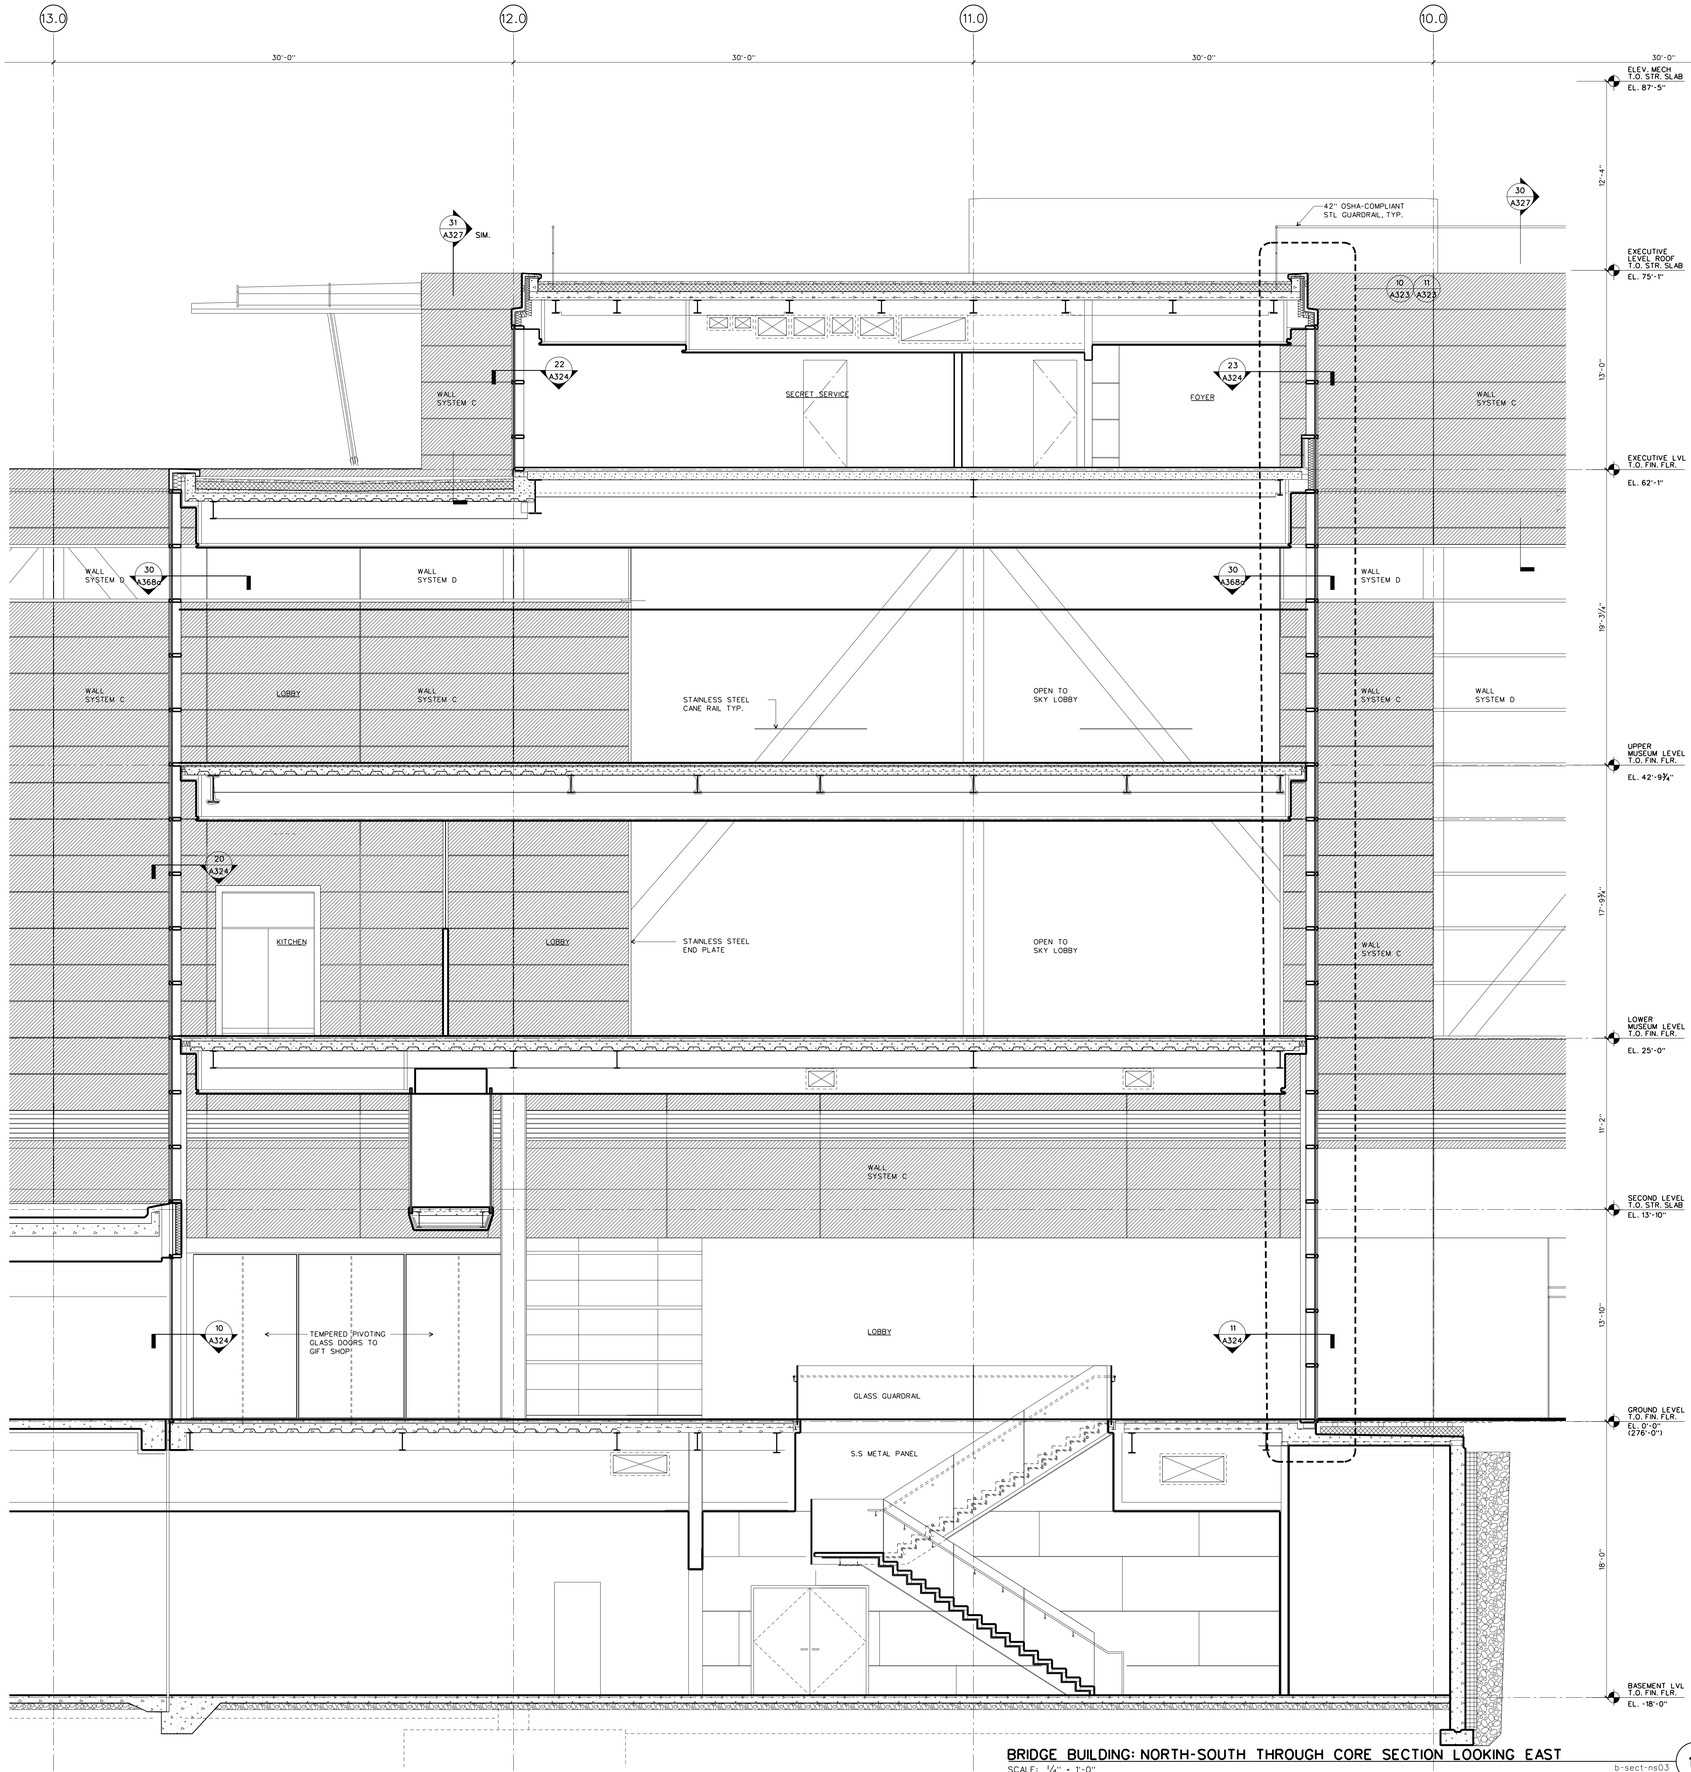

BRIDGE BUILDING: NORTH-SOUTH THROUGH CORE SECTION LOOKING EAST

SCALE: ¼" = 1'-0"

b-sect-ns03

10

WILLIAM J. CLINTON PRESIDENTIAL CENTER

LITTLE ROCK, ARKANSAS

Architect

POLSHEK PARTNERSHIP LLP
320 West 13th Street
New York, New York 10014
212.807.7171

Coordinating Architects

POLK STANLEY YEARY ARCHITECTS Ltd
700 South Schiller Street
Little Rock, Arkansas 72201
501.378.0878

WITSELL EVANS RASCO
901 West Third Street
Little Rock, Arkansas 72201
501.374.5300

WOODS CARADINE ARCHITECTS
2200 South Main Street
Little Rock, Arkansas 72206
501.374.4060

Landscape Architects

HARGREAVES ASSOCIATES
118 Magazine Street
Cambridge, Massachusettes 02139
617.661.0070

LANDSCAPE ARCHITECTURE, Inc.
2300 Cottondale Lane Suite 202
Little Rock, Arkansas 72202
501.374.5610

Structural Engineer

LESLIE E. ROBERTSON ASSOC., RLLP
30 Broad Street, 47th Floor
New York, New York 10004
212.750.9000

MEP Engineers

FLACK + KURTZ Inc.
475 Fifth Avenue
New York, New York 10017
212.532.9600


CROMWELL ARCHITECTS ENGINEERS
101 South Spring Street
Little Rock, Arkansas 72201
501.372.2900

Curtainwall Consultant

R. A. HEINTGES ARCHITECTS
126 Fifth Avenue, 9th Floor
New York, New York 10011
212.652-2966

Seal

Issue	Date
1 Addendum #2	11/15/02
100% Construction Documents	09/27/02
90% Progress Printing	08/30/02
100% Struct./ CD Progress	07/01/02
Bridge Bldg. Substructure	06/14/02
100% Steel & Concrete CD & Architectural CD Progress	05/15/02
100% Design Development	03/01/02

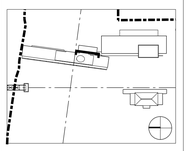

Job No. 9908

Scale 1/4" = 1'-0"

Date September 27, 2002


Title

MUSEUM BUILDING SECTION

Sheet No.

A308

FOR OFFICIAL USE ONLY

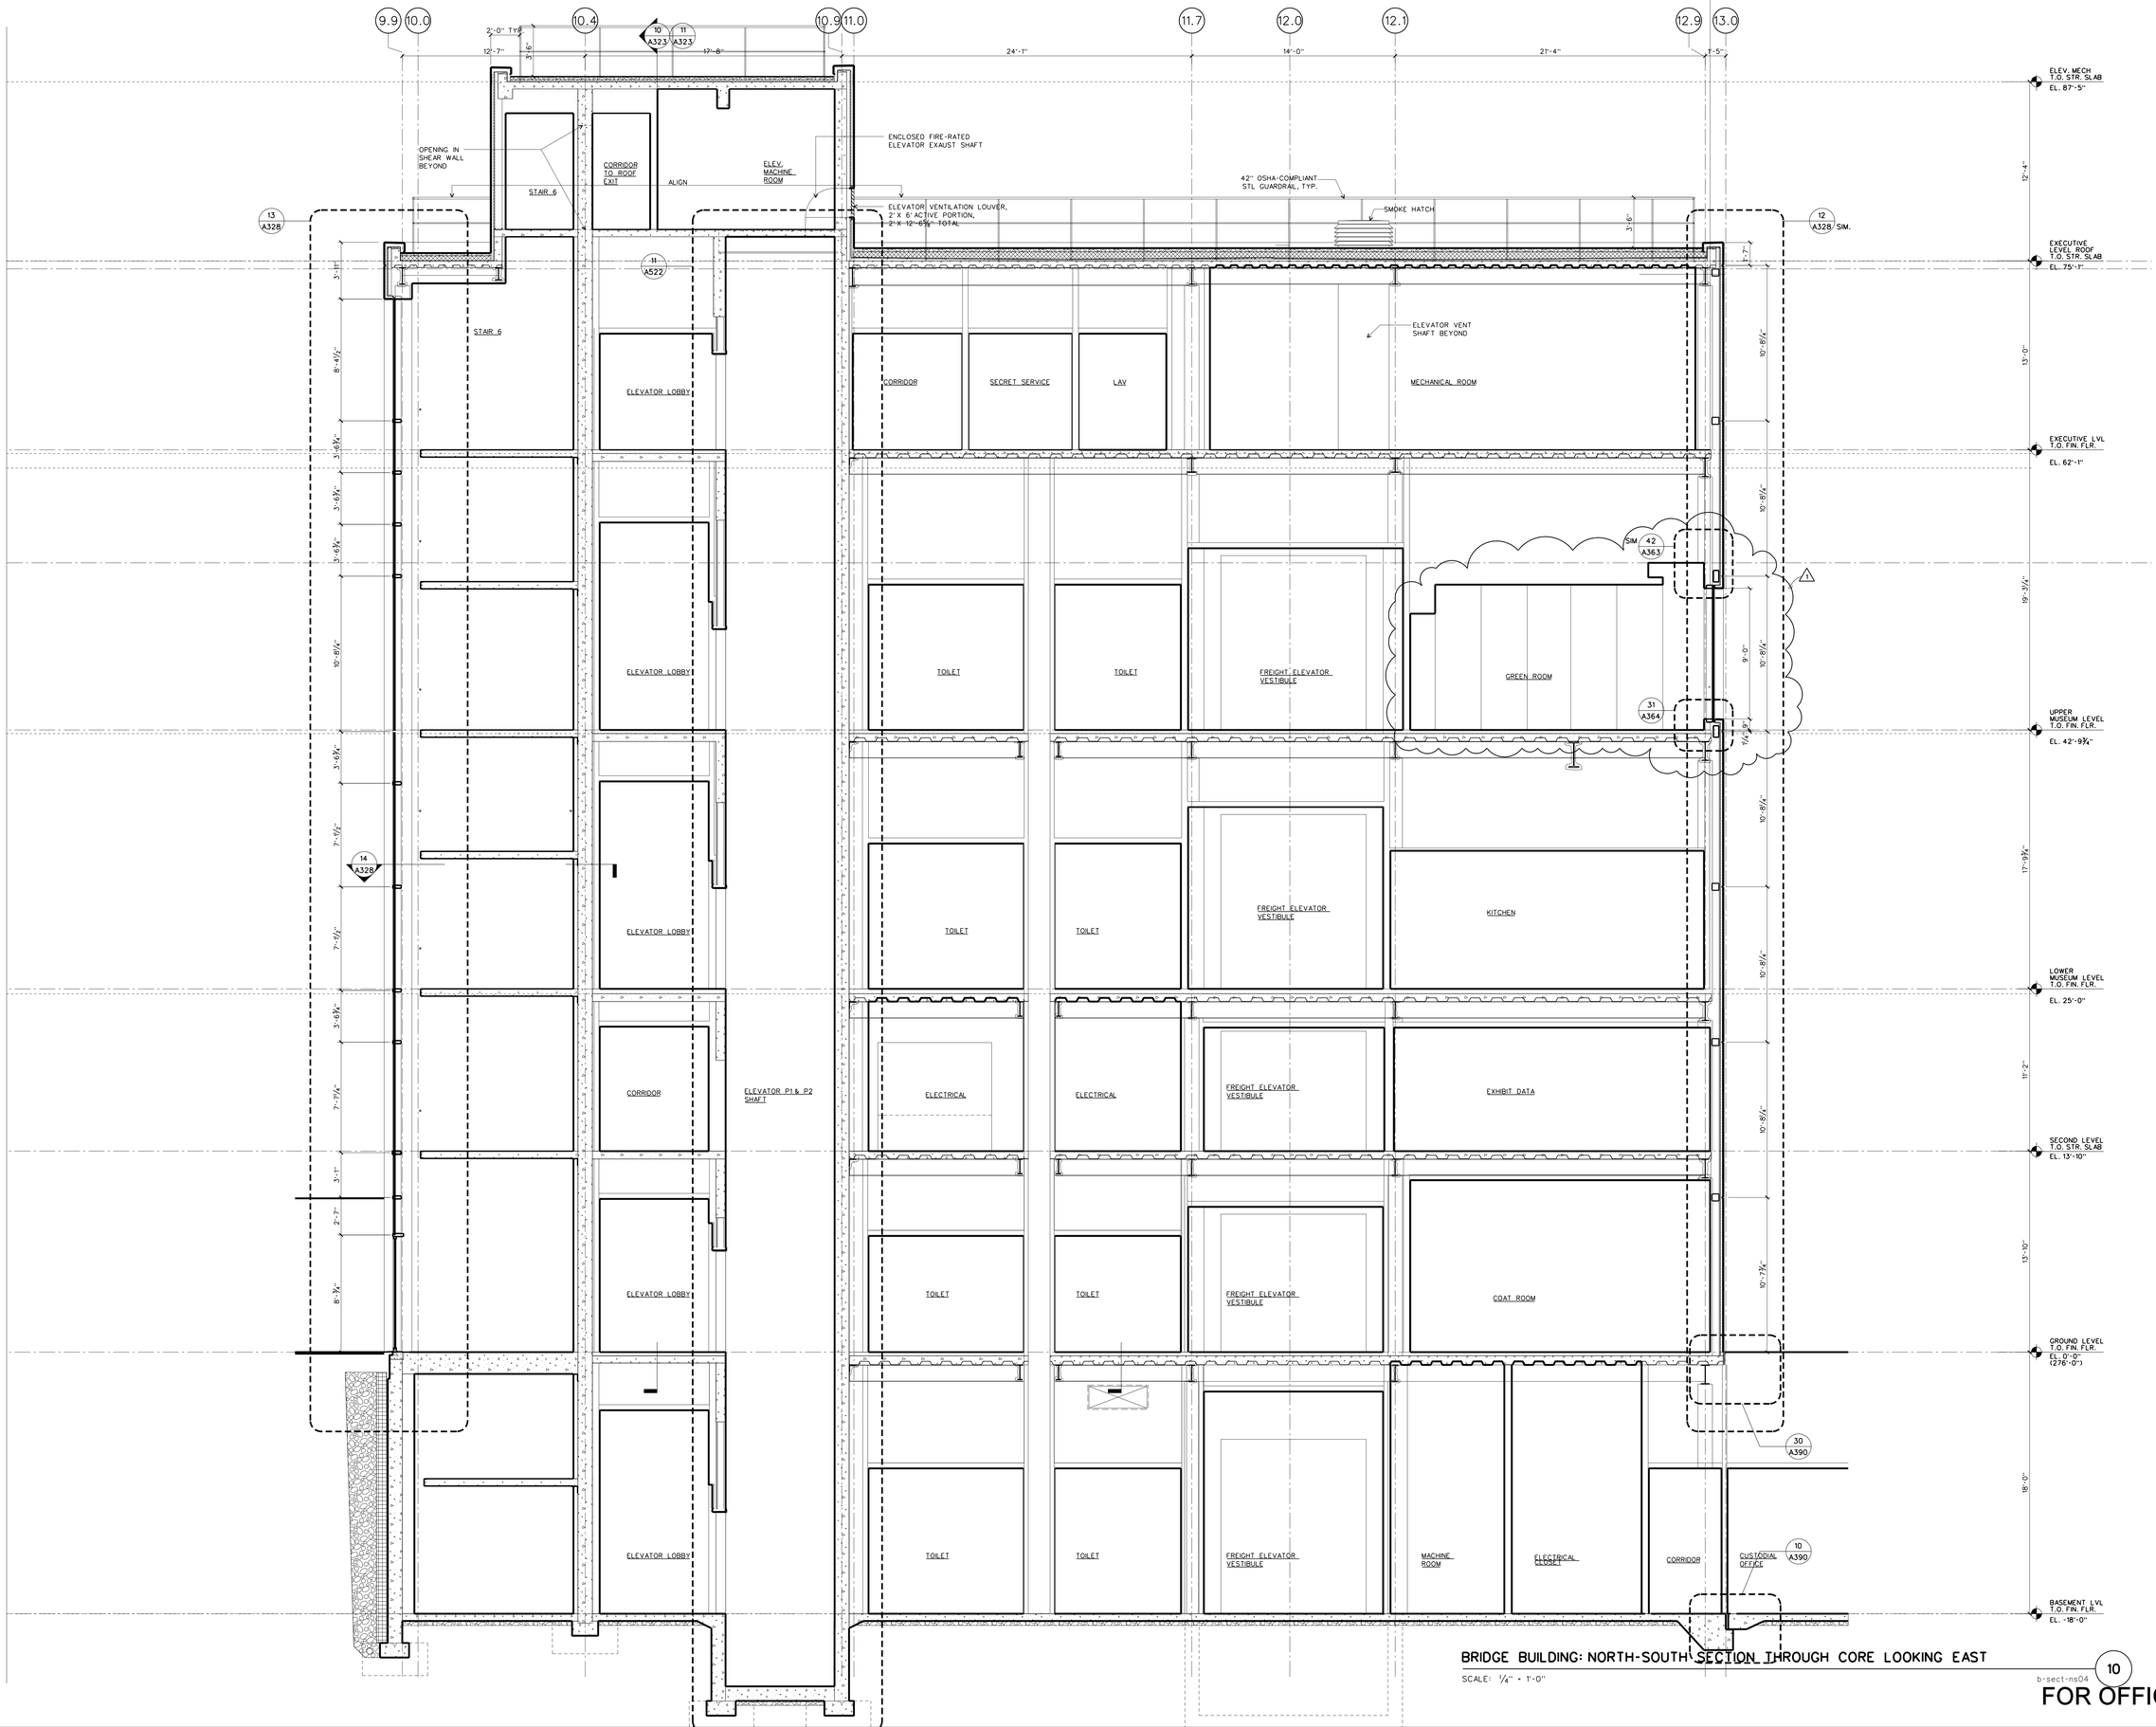

BRIDGE BUILDING: NORTH-SOUTH SECTION THROUGH CORE LOOKING EAST

SCALE: 1/4" = 1'-0"

b-sect-ns04

10

FOR OFFICIAL USE ONLY

WILLIAM J. CLINTON PRESIDENTIAL CENTER

LITTLE ROCK, ARKANSAS

Architect

POLSHEK PARTNERSHIP LLP
320 West 13th Street
New York, New York 10014
212.807.7171

Coordinating Architects

POLK STANLEY YEARY ARCHITECTS Ltd
700 South Schiller Street
Little Rock, Arkansas 72201
501.378.0878

WITSELL EVANS RASCO
901 West Third Street
Little Rock, Arkansas 72201
501.374.5300

WOODS CARADINE ARCHITECTS
2200 South Main Street
Little Rock, Arkansas 72206
501.374.4060

Landscape Architects

HARGREAVES ASSOCIATES
118 Magazine Street
Cambridge, Massachusettes 02139
617.661.0070

LANDSCAPE ARCHITECTURE, Inc.
2300 Cottondale Lane Suite 202
Little Rock, Arkansas 72202
501.374.5610

Structural Engineer

LESLIE E. ROBERTSON ASSOC., RLLP
30 Broad Street, 47th Floor
New York, New York 10004
212.750.9000

MEP Engineers

FLACK + KURTZ Inc.
475 Fifth Avenue
New York, New York 10017
212.532.9600


CROMWELL ARCHITECTS ENGINEERS
101 South Spring Street
Little Rock, Arkansas 72201
501.372.2900

Curtainwall Consultant

R. A. HEINTGES ARCHITECTS
126 Fifth Avenue, 9th Floor
New York, New York 10011
212.652-2966

Seal

Issue	Date
1 ASI #23	09/12/03
100% Construction Documents	09/27/02
90% Progress Printing	08/30/02
100% Struct./ CD Progress	07/01/02
Bridge Bldg. Substructure	06/14/02
100% Steel & Concrete CD	05/15/02
& Architectural CD Progress	
100% Design Development	03/01/02

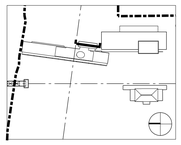

Job No. 9908

Scale 1/4" = 1'-0"


Date September 27, 2002

Title

MUSEUM BUILDING: SECTION

Sheet No.


A309

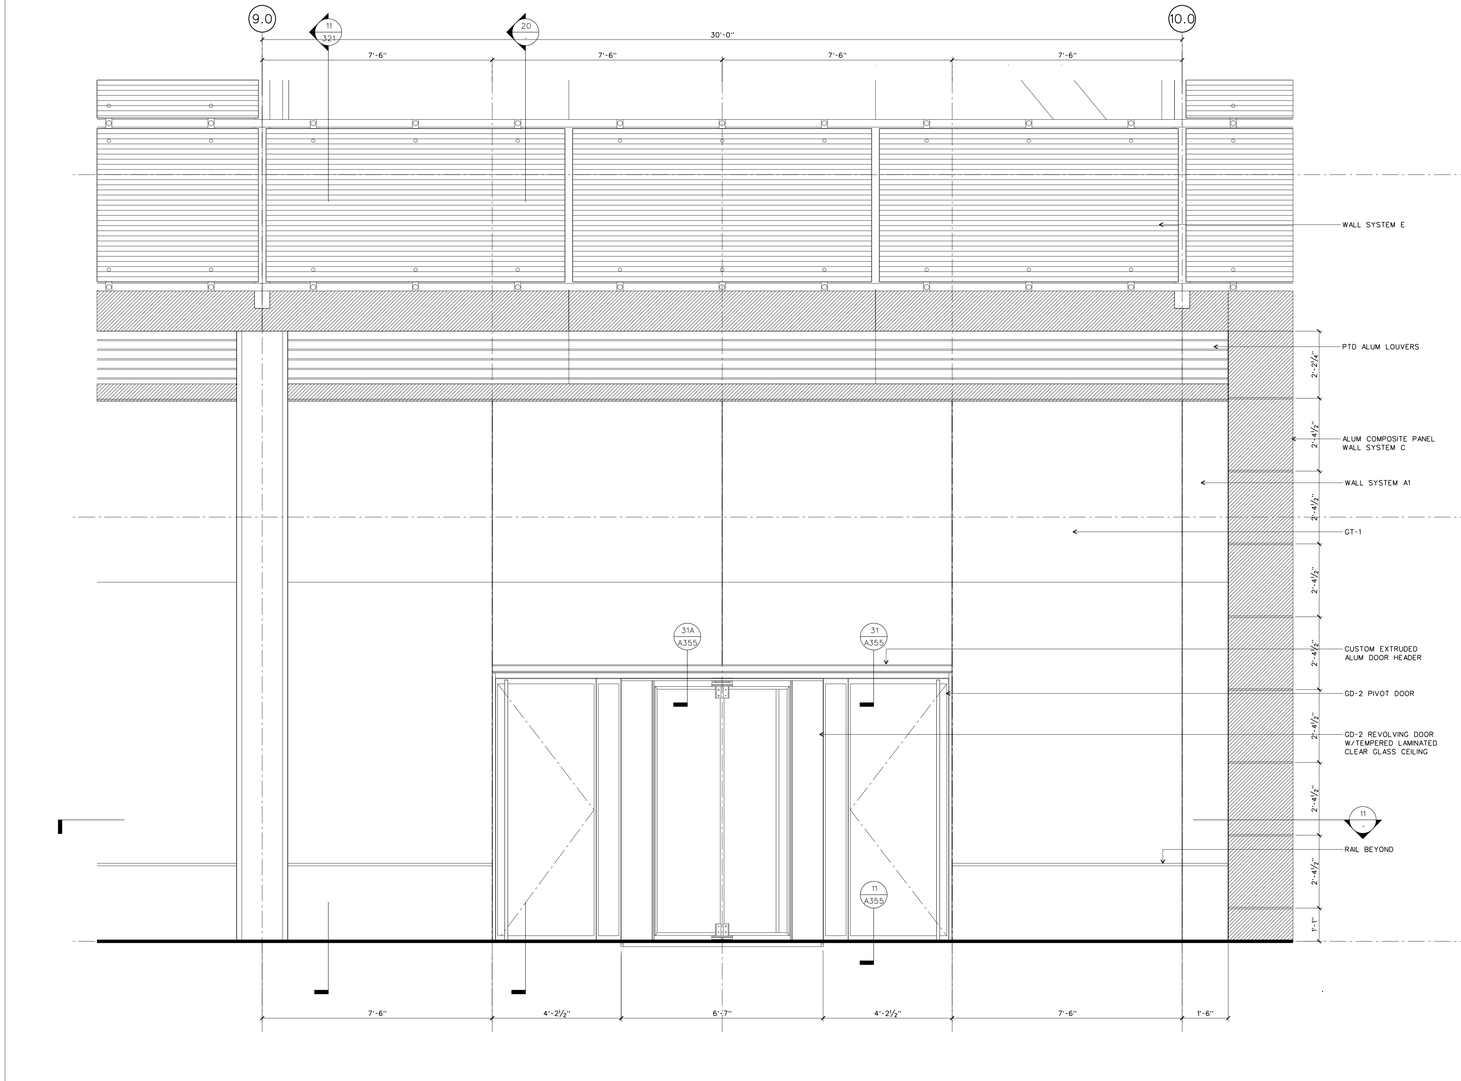

WALL SYSTEM A1: ELEVATION AT ENTRY

SCALE: ½" = 1'-0"


DETAILS/DTL-CWA 21

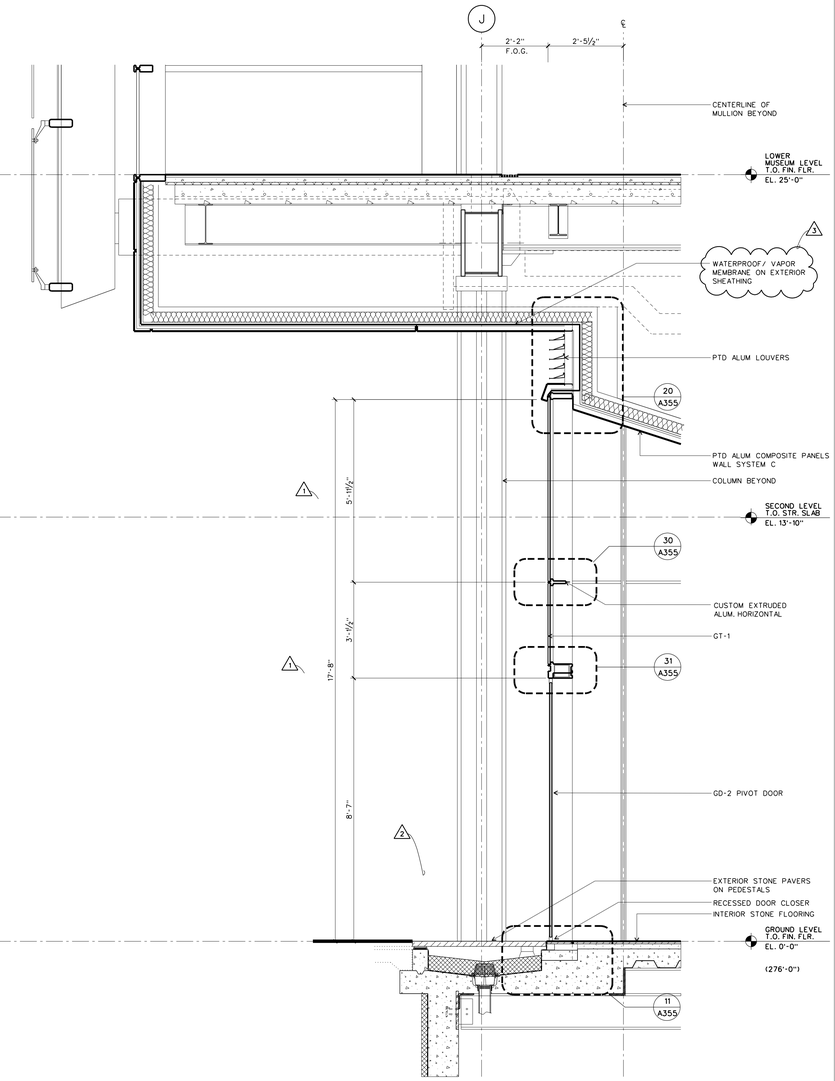

WALL SYSTEM A1: WALL SECTION AT ENTRY

SCALE: ½" = 1'-0"


DETAILS/DTL-CWA 20

 

WALL SYSTEM A1: PLAN SECTION AT ENTRY

SCALE: ½" = 1'-0"

DETAILS/DTL-CWA 11

 

WALL SYSTEM A1: PLAN SECTION AT LOBBY CORNER

SCALE: ½" = 1'-0"

DETAILS/DTL-CWA 10

WILLIAM J. CLINTON PRESIDENTIAL CENTER

LITTLE ROCK, ARKANSAS

Architect

POLSHEK PARTNERSHIP LLP
320 West 13th Street
New York, New York 10014
212.807.7171

Coordinating Architects

POLK STANLEY YEARY ARCHITECTS Ltd
700 South Schiller Street
Little Rock, Arkansas 72201
501.378.0878

WITSELL EVANS RASCO
901 West Third Street
Little Rock, Arkansas 72201
501.374.5300

WOODS CARADINE ARCHITECTS
2200 South Main Street
Little Rock, Arkansas 72206
501.374.4060

Landscape Architects

HARGREAVES ASSOCIATES
118 Magazine Street
Cambridge, Massachusettes 02139
617.661.0070

LANDSCAPE ARCHITECTURE, Inc.
2300 Cottondale Lane Suite 202
Little Rock, Arkansas 72202
501.374.5610

Structural Engineer

LESLIE E. ROBERTSON ASSOC., RLLP
30 Broad Street, 47th Floor
New York, New York 10004
212.750.9000

MEP Engineers

FLACK + KURTZ Inc.
475 Fifth Avenue
New York, New York 10017
212.532.9600


CROMWELL ARCHITECTS ENGINEERS
101 South Spring Street
Little Rock, Arkansas 72201
501.372.2900

Curtainwall Consultant

R. A. HEINTGES ARCHITECTS
126 Fifth Avenue, 9th Floor
New York, New York 10011
212.652-2966

Seal

	Issue	Date
1	ASI #22	08/01/03
2	100% Construction Documents	09/27/02
1	90% Progress Printing	08/30/02
	100% Struct./ CD Progress	07/01/02
	Bridge Bldg. Substructure	06/14/02
	100% Design Development	03/01/02

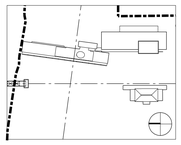

Job No. 9908

Scale 1/2" = 1'-0"

Date September 27, 2002


Title

WALL SYSTEM A1: PLANS, ELEVATION AND SECTION

Sheet No.


A320

FOR OFFICIAL USE ONLY

 


WALL SYSTEM A1: PLAN SECTION AT CAFE

SCALE: ½" = 1'-0" DETAILS/DTL-CWA2 21

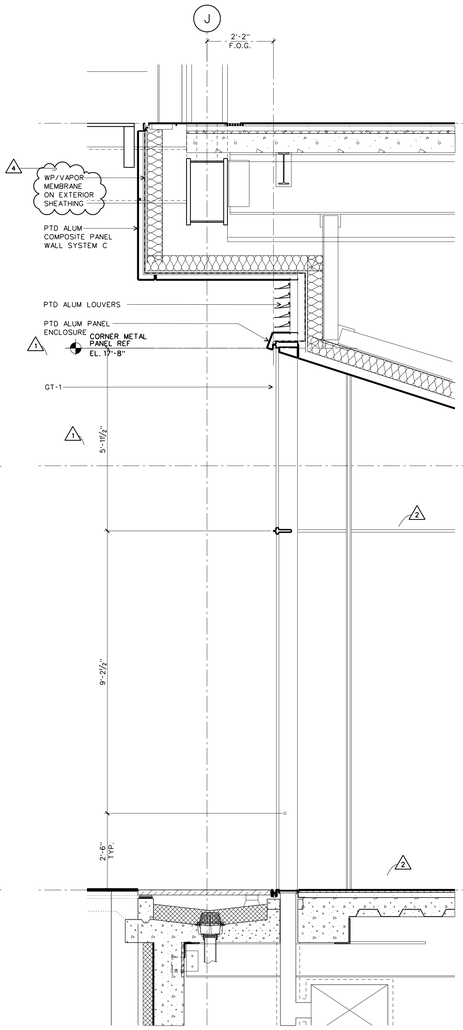


WALL SYSTEM A1: WALL SECTION AT LOBBY, TYP

SCALE: ½" = 1'-0" DETAILS/DTL-CWA2 11

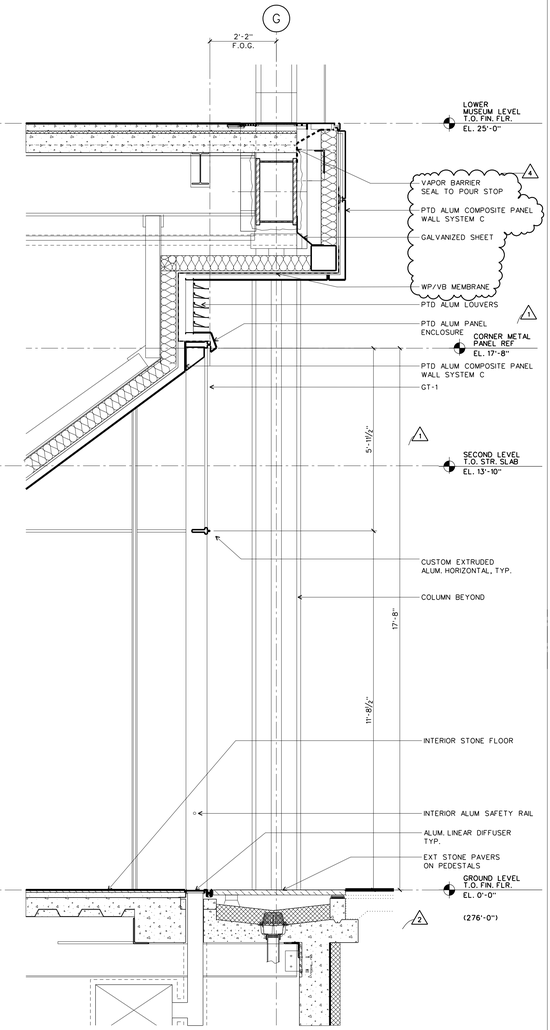


WALL SYSTEM A1: WALL SECTION AT LOBBY EAST ELEV

SCALE: ½" = 1'-0" DETAILS/DTL-CWA2 10

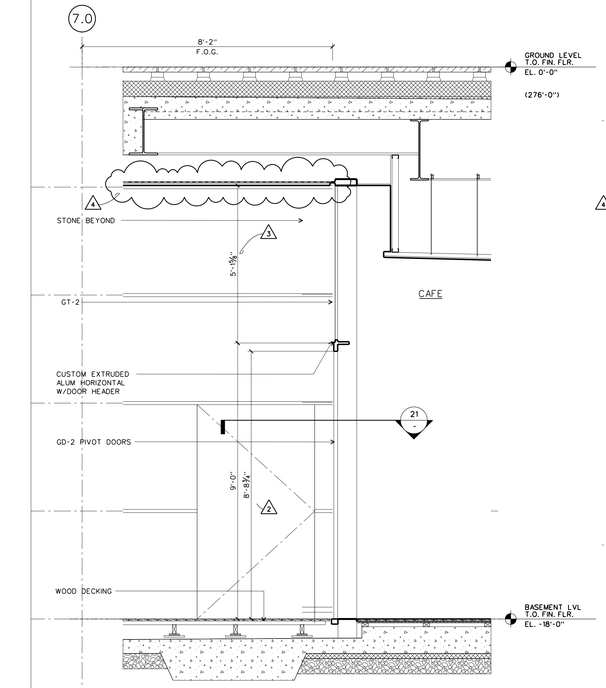

WALL SYSTEM A1: WALL SECTION AT CAFE, TYP

SCALE: ½" = 1'-0" DETAILS/DTL-CWA2 13

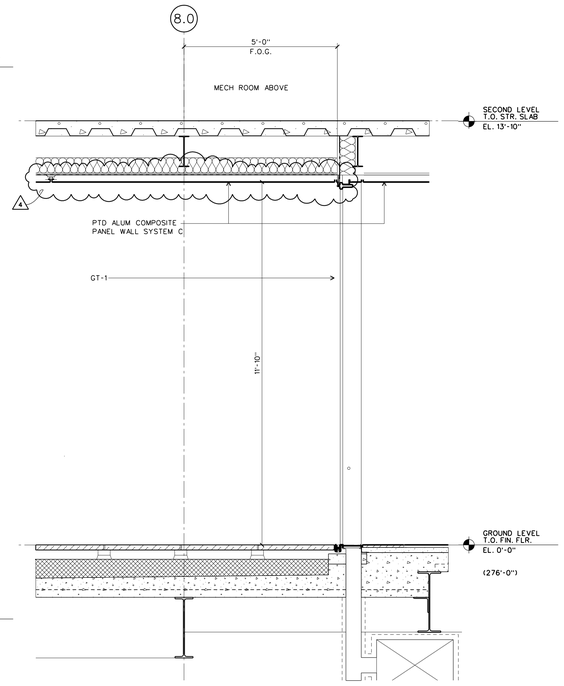

WALL SYSTEM A1: WALL SECTION AT LOBBY, NORTH ELEV

SCALE: ½" = 1'-0" DETAILS/DTL-CWA2 12

WILLIAM J. CLINTON PRESIDENTIAL CENTER

LITTLE ROCK, ARKANSAS

Architect

POLSHEK PARTNERSHIP LLP
320 West 13th Street
New York, New York 10014
212.807.7171

Coordinating Architects

POLK STANLEY YEARY ARCHITECTS Ltd
700 South Schiller Street
Little Rock, Arkansas 72201
501.378.0878

WITSELL EVANS RASCO
901 West Third Street
Little Rock, Arkansas 72201
501.374.5300

WOODS CARADINE ARCHITECTS
2200 South Main Street
Little Rock, Arkansas 72206
501.374.4060

Landscape Architects

HARGREAVES ASSOCIATES
118 Magazine Street
Cambridge, Massachusettes 02139
617.661.0070

LANDSCAPE ARCHITECTURE, Inc.
2300 Cottondale Lane Suite 202
Little Rock, Arkansas 72202
501.374.5610

Structural Engineer

LESLIE E. ROBERTSON ASSOC., RLLP
30 Broad Street, 47th Floor
New York, New York 10004
212.750.9000

MEP Engineers

FLACK + KURTZ Inc.
475 Fifth Avenue
New York, New York 10017
212.532.9600


CROMWELL ARCHITECTS ENGINEERS
101 South Spring Street
Little Rock, Arkansas 72201
501.372.2900

Curtainwall Consultant

R. A. HEINTGES ARCHITECTS
126 Fifth Avenue, 9th Floor
New York, New York 10011
212.652-2966

Seal

Issue	Date
4 ASI #22	08/01/03
3 Addendum #2	11/15/02
2 100% Construction Documents	09/27/02
1 90% Progress Printing	08/30/02
100% Struct./ CD Progress	07/01/02
Bridge Bldg. Substructure	06/14/02
100% Design Development	03/01/02

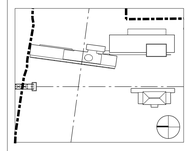

Job No. 9908

Scale 1/2" = 1'-0"

Date September 27, 2002


Title

WALL SYSTEM A1: PLANS AND SECTIONS

Sheet No.


A321

FOR OFFICIAL USE ONLY

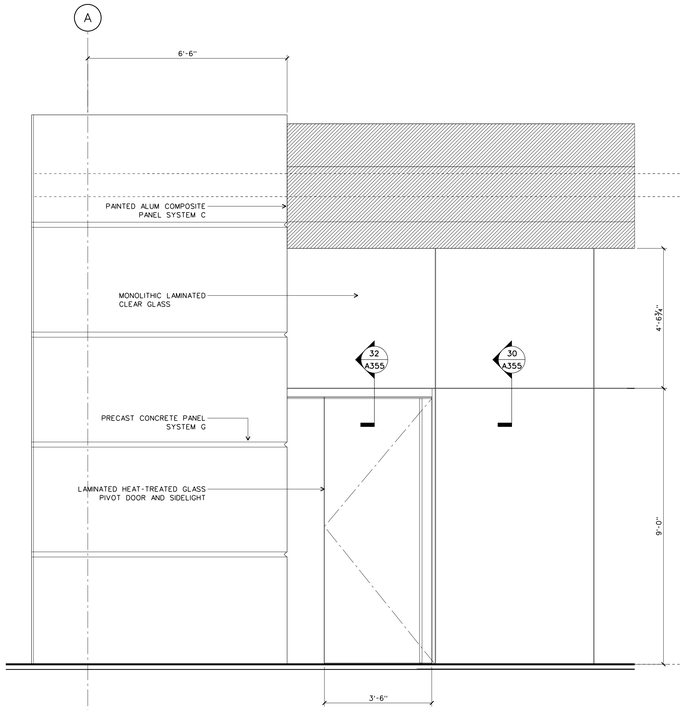


WALL SYSTEM A1: PARTIAL ELEVATIONS AT CLASSROOMS

SCALE: ½" = 1'-0" DETAILS/DTL-CWA3 22

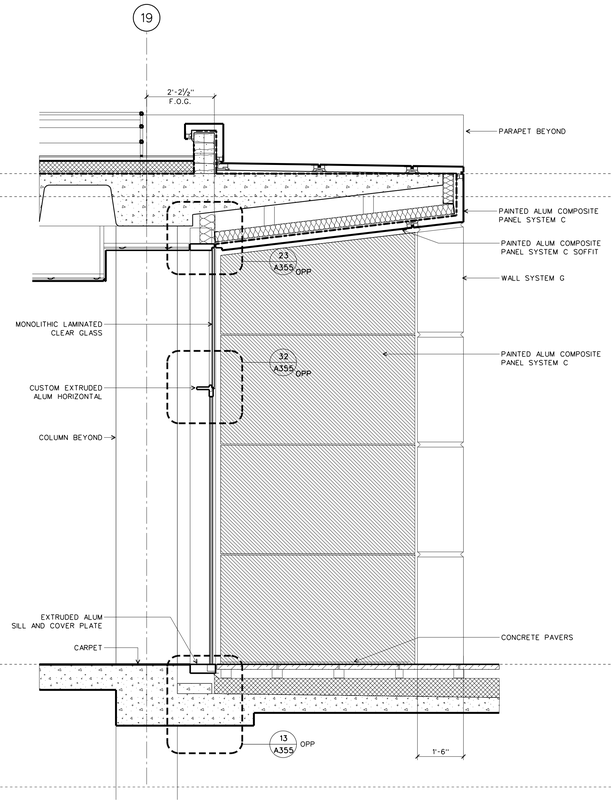


WALL SYSTEM A1: WALL SECTION THRU DOOR AT CLASSROOMS

SCALE: ½" = 1'-0" DETAILS/DTL-CWA3 21

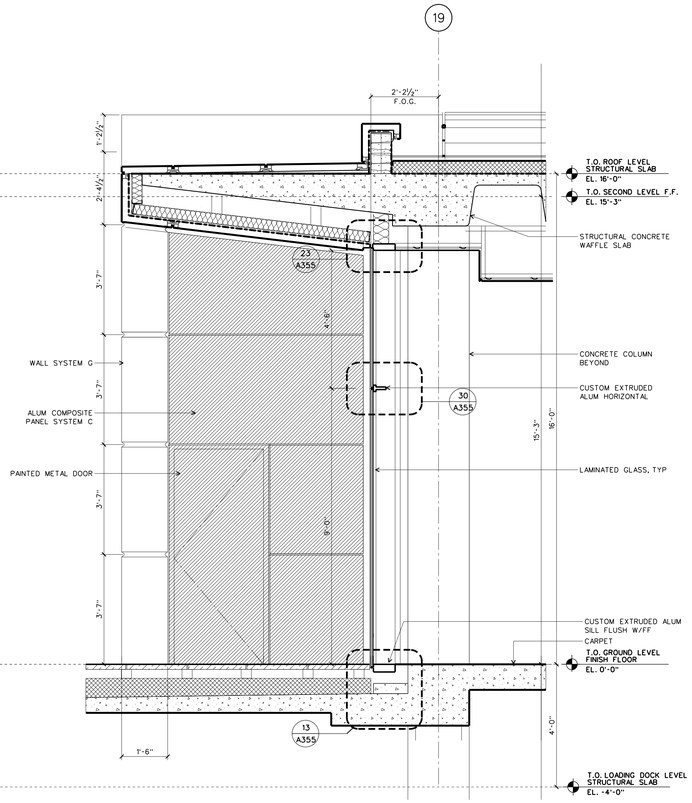

WALL SYSTEM A1: WALL SECTION AT CLASSROOMS

SCALE: ½" = 1'-0" DETAILS/DTL-CWA3 20

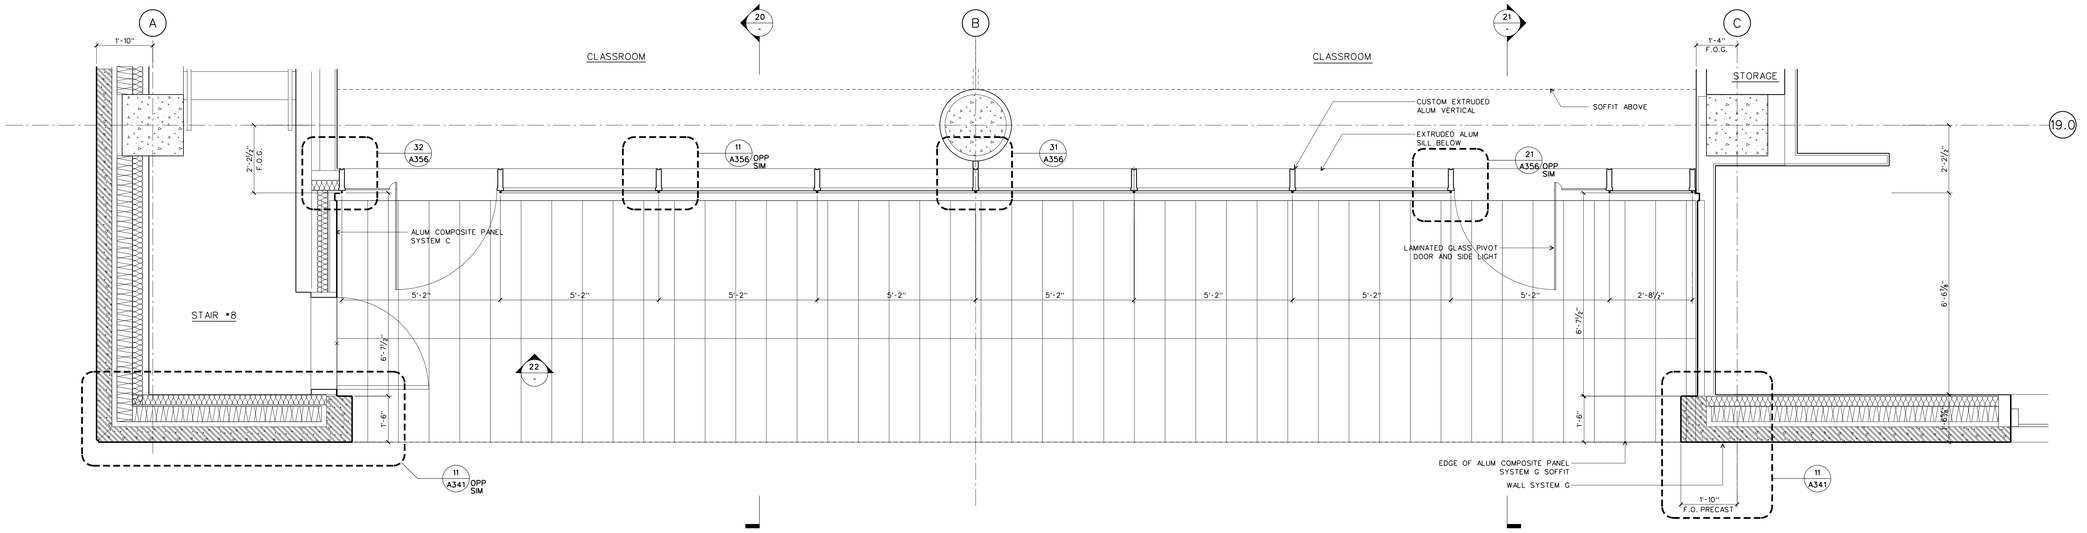

WALL SYSTEM A1/G: PLAN SECTION AT CLASSROOM

SCALE: ½" = 1'-0" DETAILS/DTL-CWA3 10

WILLIAM J. CLINTON PRESIDENTIAL CENTER

LITTLE ROCK, ARKANSAS

Architect

POLSHEK PARTNERSHIP LLP
320 West 13th Street
New York, New York 10014
212.807.7171

Coordinating Architects

POLK STANLEY YEARY ARCHITECTS Ltd
700 South Schiller Street
Little Rock, Arkansas 72201
501.378.0878

WITSELL EVANS RASCO
901 West Third Street
Little Rock, Arkansas 72201
501.374.5300

WOODS CARADINE ARCHITECTS
2200 South Main Street
Little Rock, Arkansas 72206
501.374.4060

Landscape Architects

HARGREAVES ASSOCIATES
118 Magazine Street
Cambridge, Massachusettes 02139
617.661.0070

LANDSCAPE ARCHITECTURE, Inc.
2300 Cottondale Lane Suite 202
Little Rock, Arkansas 72202
501.374.5610

Structural Engineer

LESLIE E. ROBERTSON ASSOC., RLLP
30 Broad Street, 47th Floor
New York, New York 10004
212.750.9000

MEP Engineers

FLACK + KURTZ Inc.
475 Fifth Avenue
New York, New York 10017
212.532.9600


CROMWELL ARCHITECTS ENGINEERS
101 South Spring Street
Little Rock, Arkansas 72201
501.372.2900

Curtainwall Consultant

R. A. HEINTGES ARCHITECTS
126 Fifth Avenue, 9th Floor
New York, New York 10011
212.652-2966

Seal

Issue	Date
100% Construction Documents	09/27/02
90% Progress Printing	08/30/02
ASI #05	08/20/02
100% Struct./ CD Progress	07/01/02
Bridge Bldg. Substructure	06/14/02
100% Steel & Concrete CD & Architectural CD Progress	05/15/02
100% Design Development	03/01/02

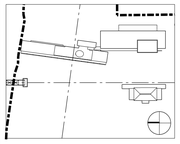

Job No. 9908


Scale 1/2" = 1'-0"

Date September 27, 2002

Title WALL SYSTEM A1: PLANS, ELEVATION AND SECTIONS


Sheet No. A322

FOR OFFICIAL USE ONLY

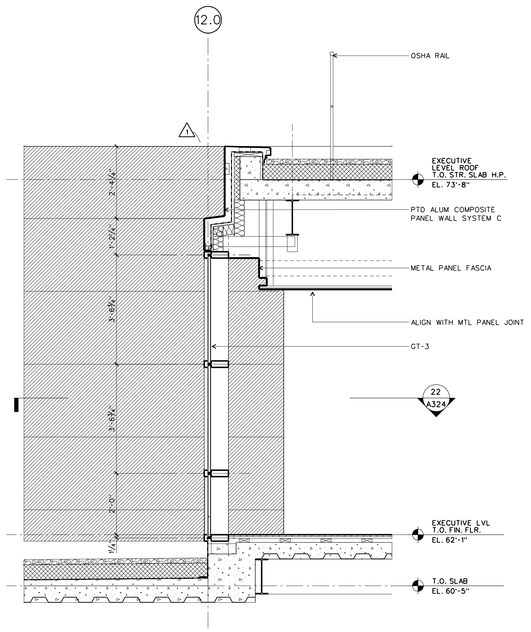


WALL SYSTEM A2: WALL SECTION AT NECK, EXEC SOUTH

SCALE: ½" = 1'-0" DETAILS/DTL-CWA4 23

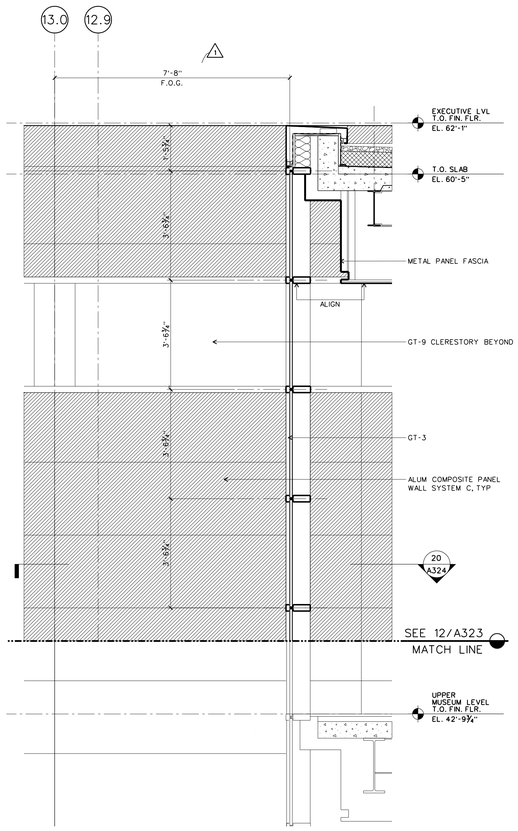


WALL SYSTEM A2: WALL SECTION AT NECK, SOUTH

SCALE: ½" = 1'-0" DETAILS/DTL-CWA4 13

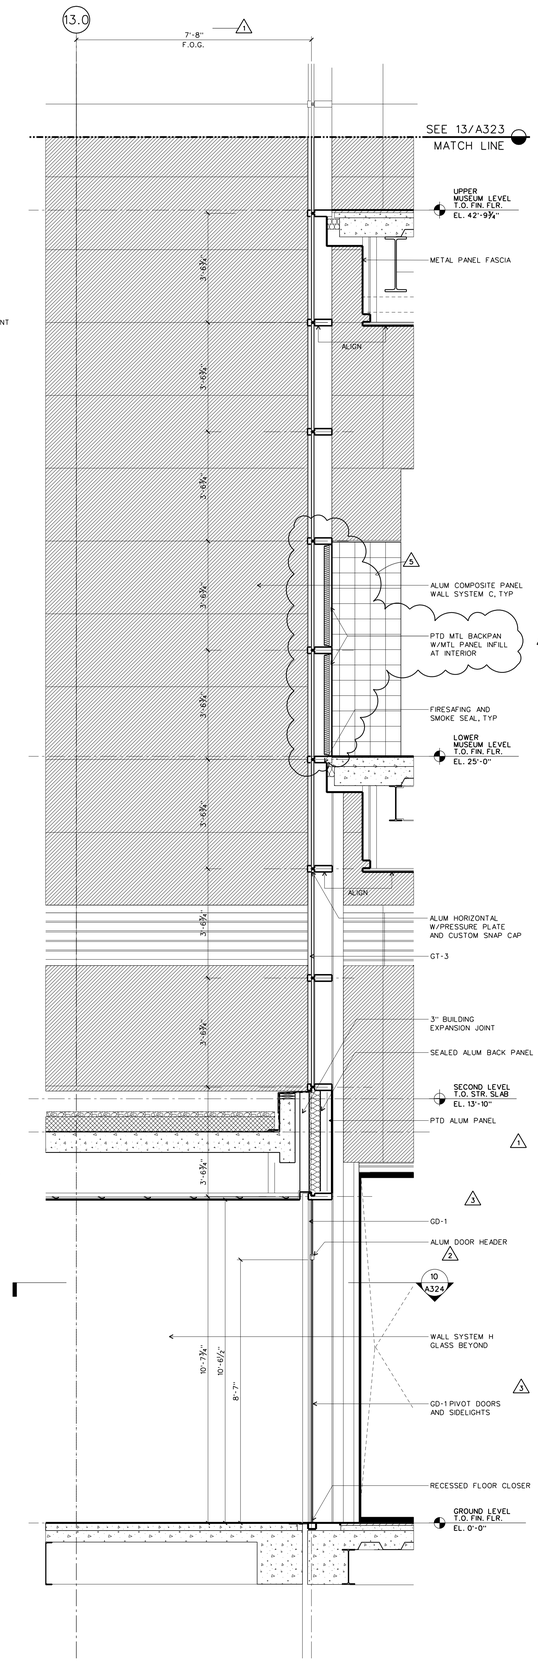


WALL SYSTEM A2: WALL SECTION AT NECK, SOUTH

SCALE: ½" = 1'-0" DETAILS/DTL-CWA4 12

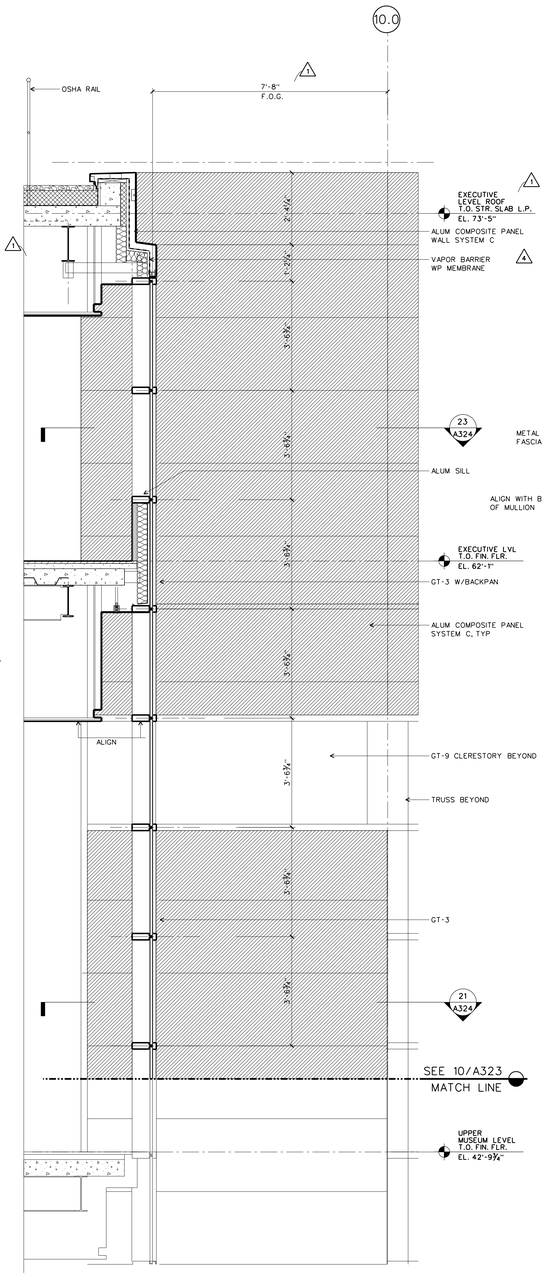

WALL SYSTEM A2: WALL SECTION AT NECK, NORTH

SCALE: ½" = 1'-0" DETAILS/DTL-CWA4 11

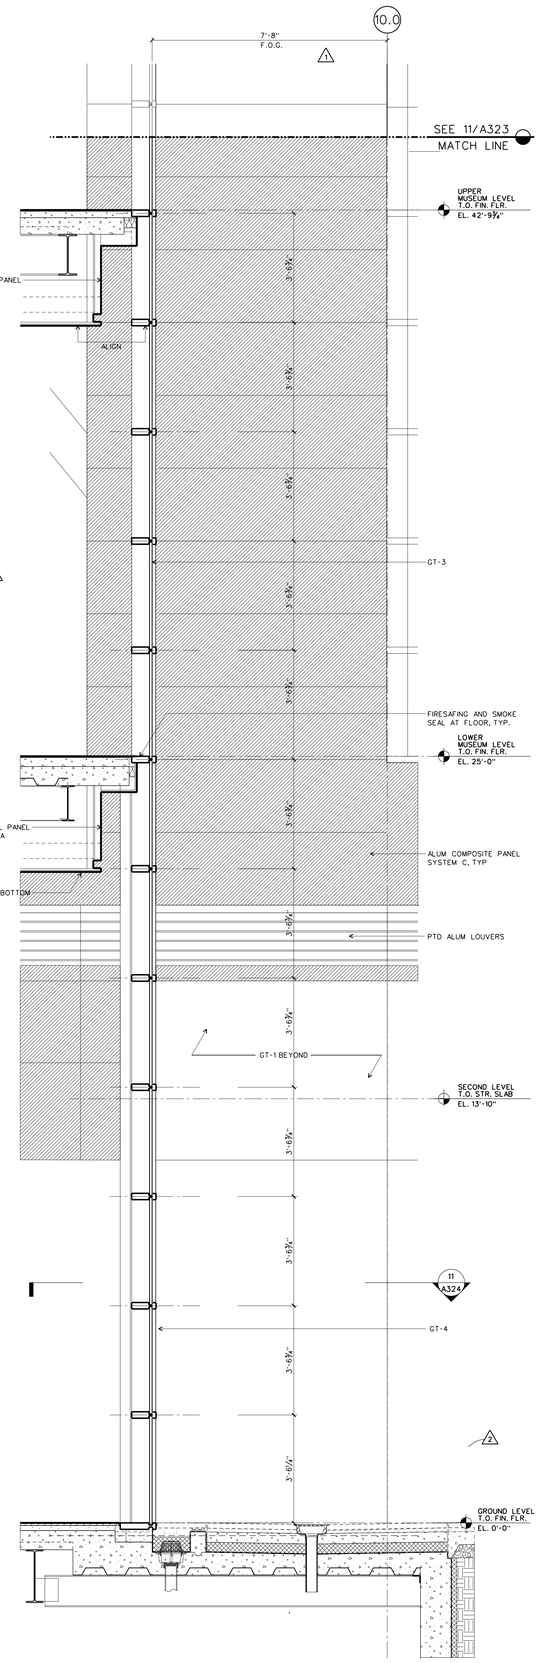

WALL SYSTEM A2: WALL SECTION AT NECK, NORTH

SCALE: ½" = 1'-0" DETAILS/DTL-CWA4 10

WILLIAM J. CLINTON PRESIDENTIAL CENTER

LITTLE ROCK, ARKANSAS

Architect

POLSHEK PARTNERSHIP LLP
320 West 13th Street
New York, New York 10014
212.807.7171

Coordinating Architects

POLK STANLEY YEARY ARCHITECTS Ltd
700 South Schiller Street
Little Rock, Arkansas 72201
501.378.0878

WITSELL EVANS RASCO
901 West Third Street
Little Rock, Arkansas 72201
501.374.5300

WOODS CARADINE ARCHITECTS
2200 South Main Street
Little Rock, Arkansas 72206
501.374.4060

Landscape Architects

HARGREAVES ASSOCIATES
118 Magazine Street
Cambridge, Massachusettes 02139
617.661.0070

LANDSCAPE ARCHITECTURE, Inc.
2300 Cottondale Lane Suite 202
Little Rock, Arkansas 72202
501.374.5610

Structural Engineer

LESLIE E. ROBERTSON ASSOC., RLLP
30 Broad Street, 47th Floor
New York, New York 10004
212.750.9000

MEP Engineers

FLACK + KURTZ Inc.
475 Fifth Avenue
New York, New York 10017
212.532.9600


CROMWELL ARCHITECTS ENGINEERS
101 South Spring Street
Little Rock, Arkansas 72201
501.372.2900

Curtainwall Consultant

R. A. HEINTGES ARCHITECTS
126 Fifth Avenue, 9th Floor
New York, New York 10011
212.652-2966

Seal

Issue	Date
5 ASI #26	01/16/04
4 ASI #22	08/01/03
3 Addendum #2	11/15/02
2 100% Construction Documents	09/27/02
1 90% Progress Printing	08/30/02
100% Struct./ CD Progress	07/01/02
Bridge Bldg. Substructure	06/14/02
100% Design Development	03/01/02

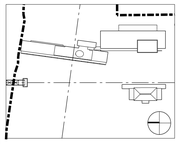

Job No. 9908

Scale 1/2" = 1'-0"

Date September 27, 2002


Title

WALL SYSTEM A2 SECTIONS

Sheet No.


A323

FOR OFFICIAL USE ONLY

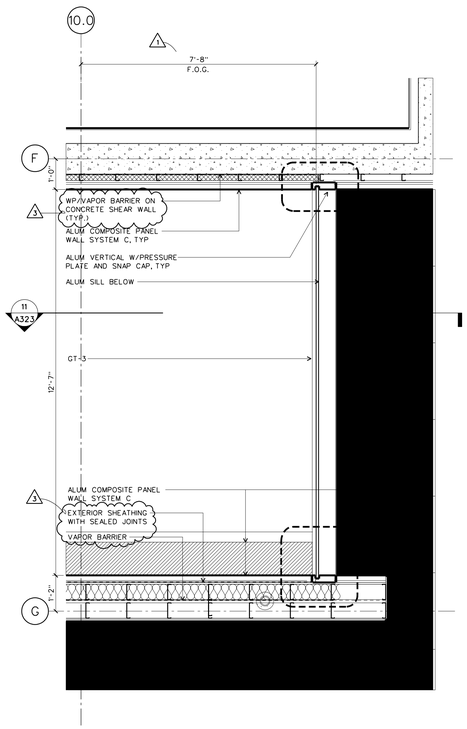


WALL SYSTEM A2: PLAN AT EXECUTIVE LEVEL 23

SCALE: ½" = 1'-0" DETAILS/DTL-CWA5

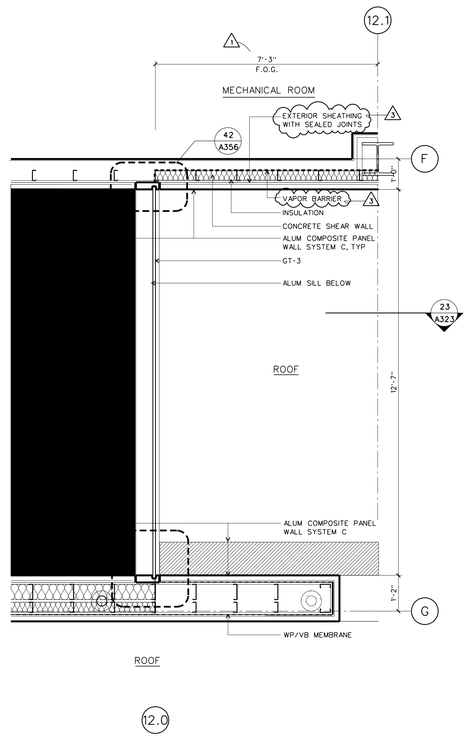


WALL SYSTEM A2: PLAN AT EXECUTIVE LEVEL 22

SCALE: ½" = 1'-0" DETAILS/DTL-CWA5

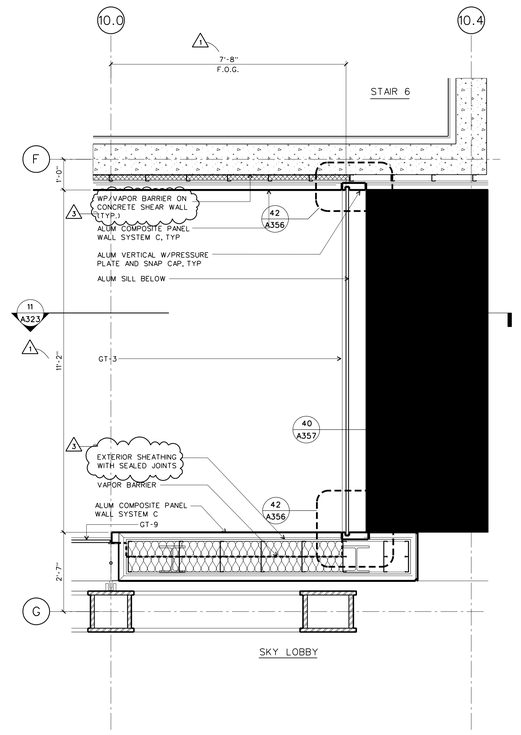


WALL SYSTEM A2: PLAN AT UPPER MUSEUM LEVEL 21

SCALE: ½" = 1'-0" DETAILS/DTL-CWA5

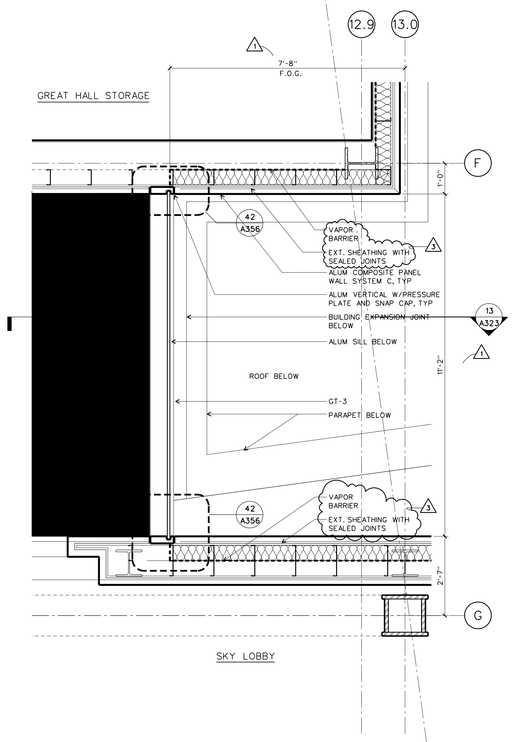


WALL SYSTEM A2: PLAN AT UPPER MUSEUM LEVEL 20

SCALE: ½" = 1'-0" DETAILS/DTL-CWA5

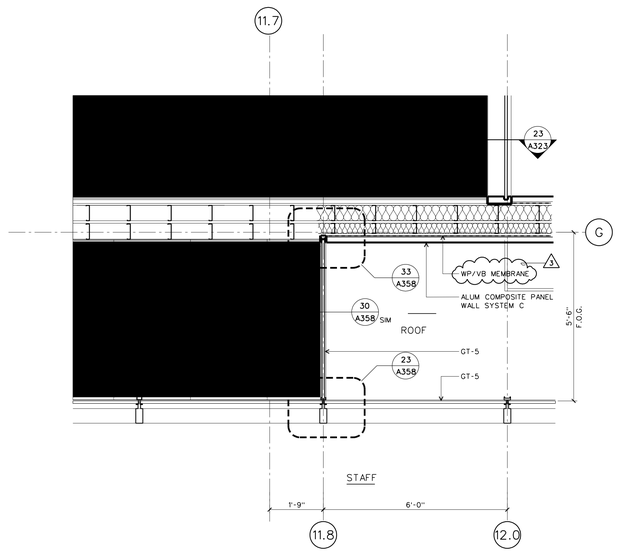


WALL SYSTEM A3: PLAN AT EXECUTIVE LEVEL 12

SCALE: ½" = 1'-0" DETAILS/DTL-CWA5

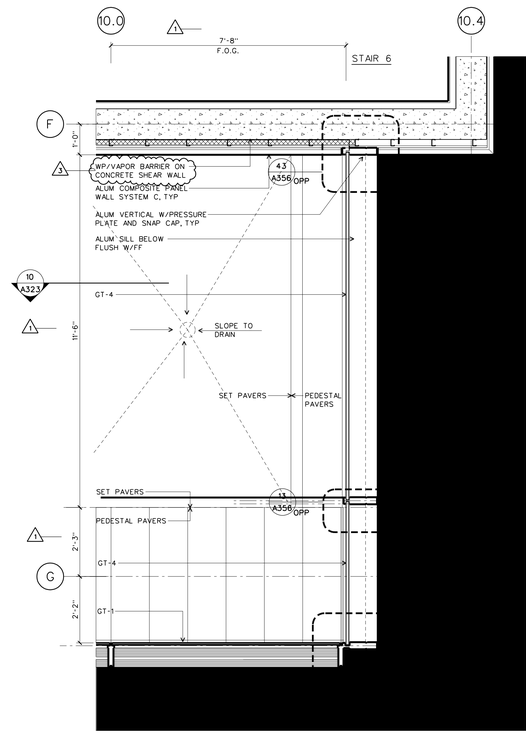

WALL SYSTEM A2: PLAN AT GROUND LEVEL 11

SCALE: ½" = 1'-0" DETAILS/DTL-CWA5

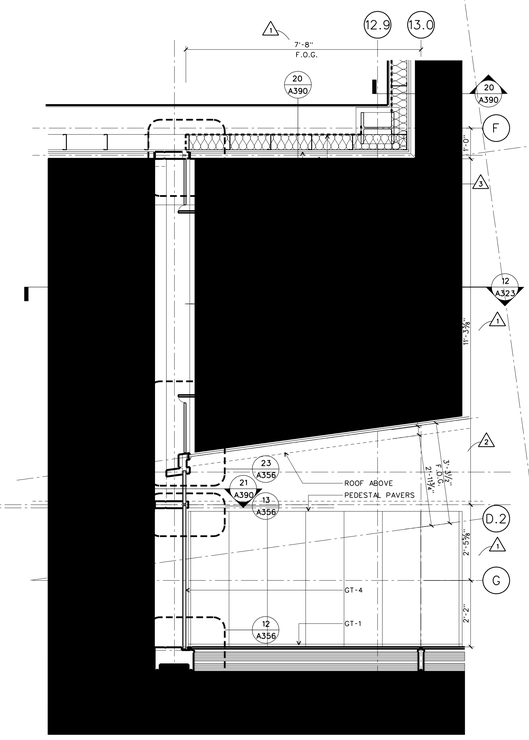

WALL SYSTEM A2: PLAN AT GROUND LEVEL 10

SCALE: ½" = 1'-0" DETAILS/DTL-CWA5

FOR OFFICIAL USE ONLY

WILLIAM J. CLINTON PRESIDENTIAL CENTER

LITTLE ROCK, ARKANSAS

Architect

POLSHEK PARTNERSHIP LLP
320 West 13th Street
New York, New York 10014
212.807.7171

Coordinating Architects

POLK STANLEY YEARY ARCHITECTS Ltd
700 South Schiller Street
Little Rock, Arkansas 72201
501.378.0878

WITSELL EVANS RASCO
901 West Third Street
Little Rock, Arkansas 72201
501.374.5300

WOODS CARADINE ARCHITECTS
2200 South Main Street
Little Rock, Arkansas 72206
501.374.4060

Landscape Architects

HARGREAVES ASSOCIATES
118 Magazine Street
Cambridge, Massachusettes 02139
617.661.0070

LANDSCAPE ARCHITECTURE, Inc.
2300 Cottondale Lane Suite 202
Little Rock, Arkansas 72202
501.374.5610

Structural Engineer

LESLIE E. ROBERTSON ASSOC., RLLP
30 Broad Street, 47th Floor
New York, New York 10004
212.750.9000

MEP Engineers

FLACK + KURTZ Inc.
475 Fifth Avenue
New York, New York 10017
212.532.9600


CROMWELL ARCHITECTS ENGINEERS
101 South Spring Street
Little Rock, Arkansas 72201
501.372.2900

Curtainwall Consultant

R. A. HEINTGES ARCHITECTS
126 Fifth Avenue, 9th Floor
New York, New York 10011
212.652-2966

Seal

	Issue	Date
4	ASI #22	08/01/03
3	100% Construction Documents	09/27/02
2	90% Progress Printing	08/30/02
	100% Struct./ CD Progress	07/01/02
	Bridge Bldg. Substructure	06/14/02
	100% Design Development	03/01/02

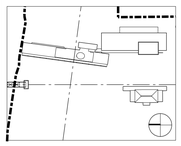

Job No. 9908

Scale 1/2" = 1'-0"


Date September 27, 2002

Title

WALL SYSTEM A2 AND A3: PLANS

Sheet No.


A324

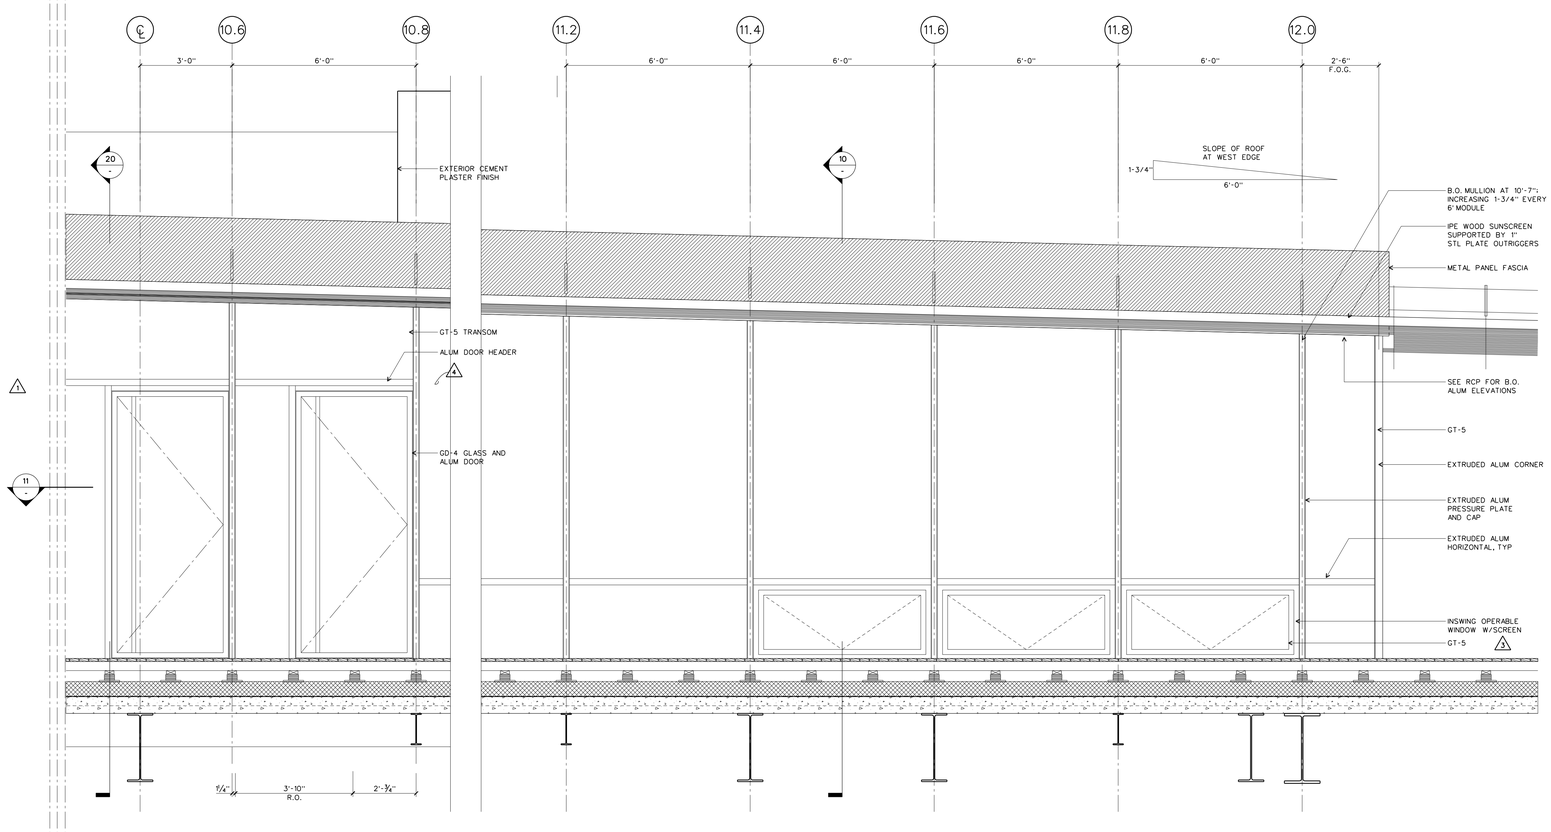

WALL SYSTEM A3: ELEVATION AT SOUTHWEST CORNER

SCALE: 1/2" = 1'-0"


DETAILS/DTL-CWA6 21

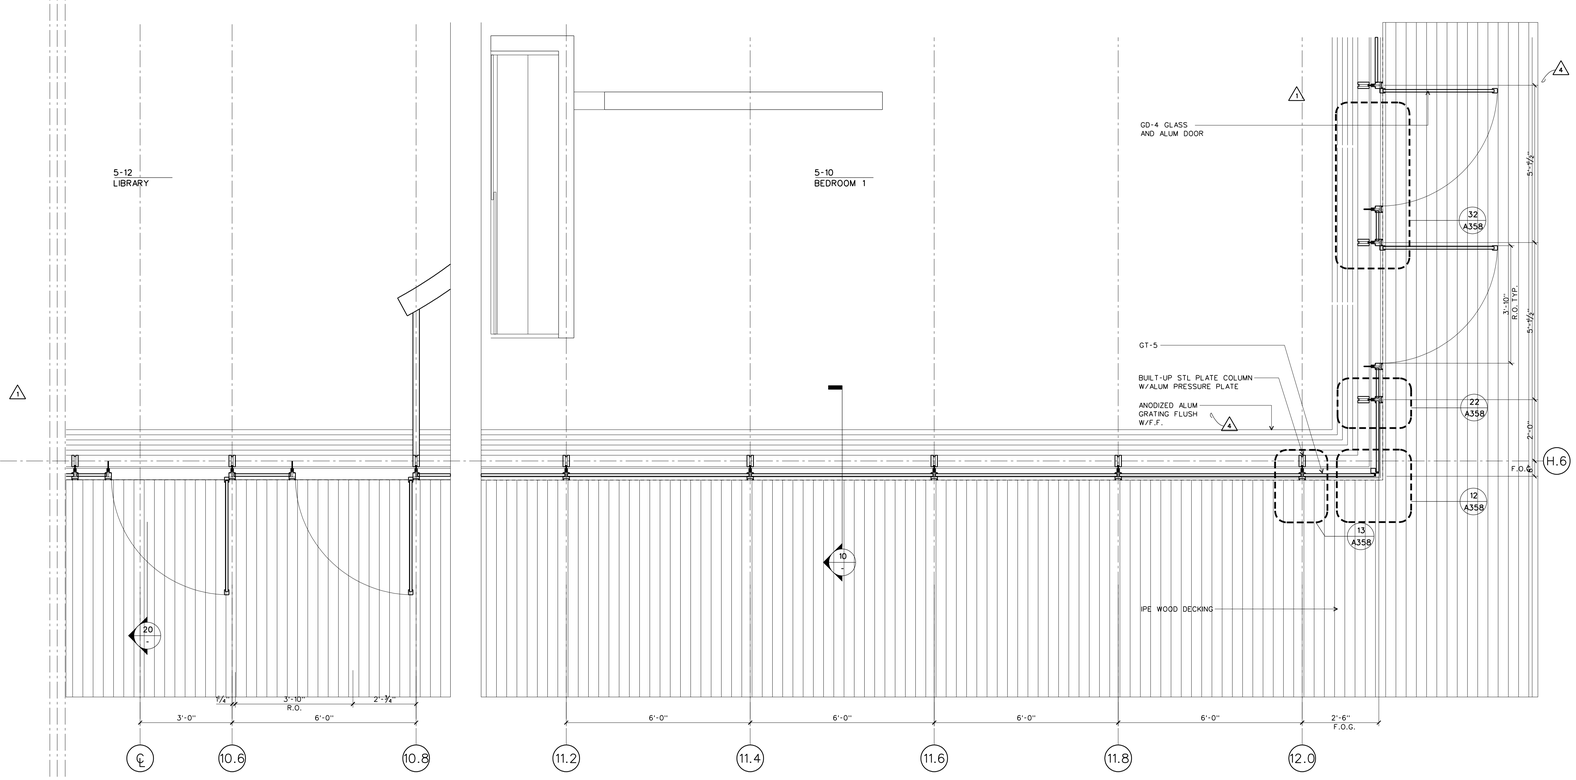

WALL SYSTEM A3: PLAN SECTION AT SOUTHWEST CORNER

SCALE: 1/2" = 1'-0"


DETAILS/DTL-CWA6 11

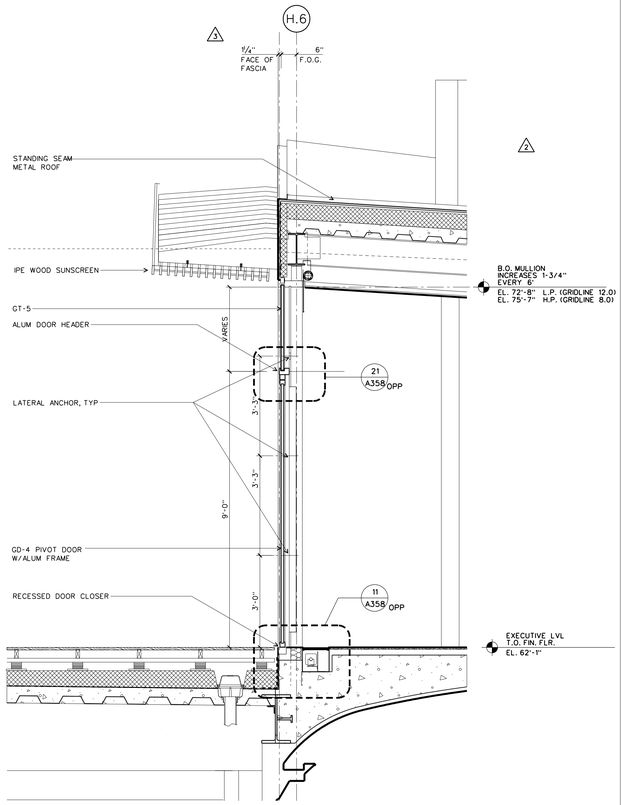

WALL SYSTEM A3: WALL SECTION THRU OVAL

SCALE: 1/2" = 1'-0"

DETAILS/DTL-CWA6 20

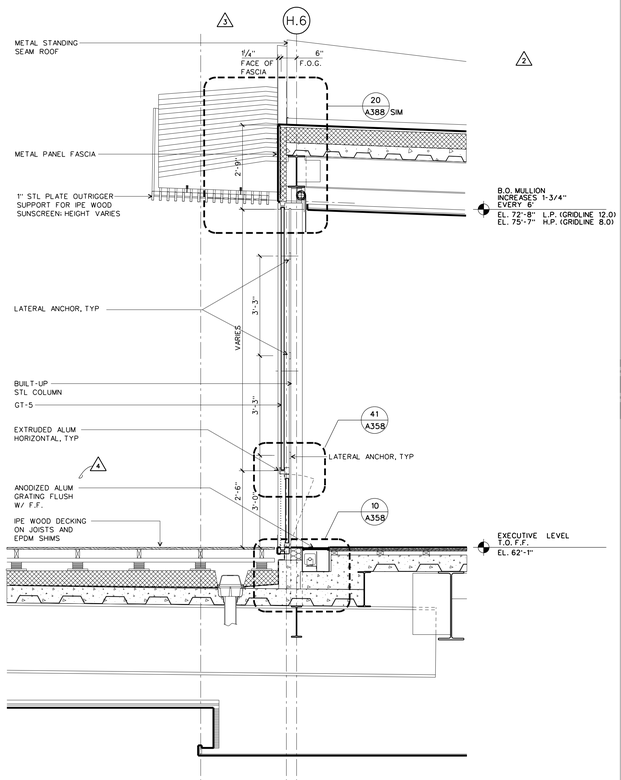

WALL SYSTEM A3: WALL SECTION, TYP

SCALE: 1/2" = 1'-0"

DETAILS/DTL-CWA6 10

WILLIAM J. CLINTON PRESIDENTIAL CENTER

LITTLE ROCK, ARKANSAS

Architect

POLSHEK PARTNERSHIP LLP
320 West 13th Street
New York, New York 10014
212.807.7171

Coordinating Architects

POLK STANLEY YEARY ARCHITECTS Ltd
700 South Schiller Street
Little Rock, Arkansas 72201
501.378.0878

WITSELL EVANS RASCO
901 West Third Street
Little Rock, Arkansas 72201
501.374.5300

WOODS CARADINE ARCHITECTS
2200 South Main Street
Little Rock, Arkansas 72206
501.374.4060

Landscape Architects

HARGREAVES ASSOCIATES
118 Magazine Street
Cambridge, Massachusettes 02139
617.661.0070

LANDSCAPE ARCHITECTURE, Inc.
2300 Cottondale Lane Suite 202
Little Rock, Arkansas 72202
501.374.5610

Structural Engineer

LESLIE E. ROBERTSON ASSOC., RLLP
30 Broad Street, 47th Floor
New York, New York 10004
212.750.9000

MEP Engineers

FLACK + KURTZ Inc.
475 Fifth Avenue
New York, New York 10017
212.532.9600


CROMWELL ARCHITECTS ENGINEERS
101 South Spring Street
Little Rock, Arkansas 72201
501.372.2900

Curtainwall Consultant

R. A. HEINTGES ARCHITECTS
126 Fifth Avenue, 9th Floor
New York, New York 10011
212.652-2966

Seal

	Issue	Date
4	ASI #20	05/30/03
3	Addendum #2	11/15/02
2	100% Construction Documents	09/27/02
1	90% Progress Printing	08/30/02
	100% Struct./ CD Progress	07/01/02
	100% Design Development	03/01/02

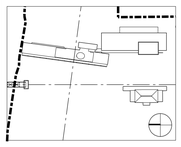

Job No. 9908

Scale 1/2" = 1'-0"

Date September 27, 2002


Title

WALL SYSTEM A3 PLAN, ELEVATION, AND SECTIONS

Sheet No.

A325


FOR OFFICIAL USE ONLY

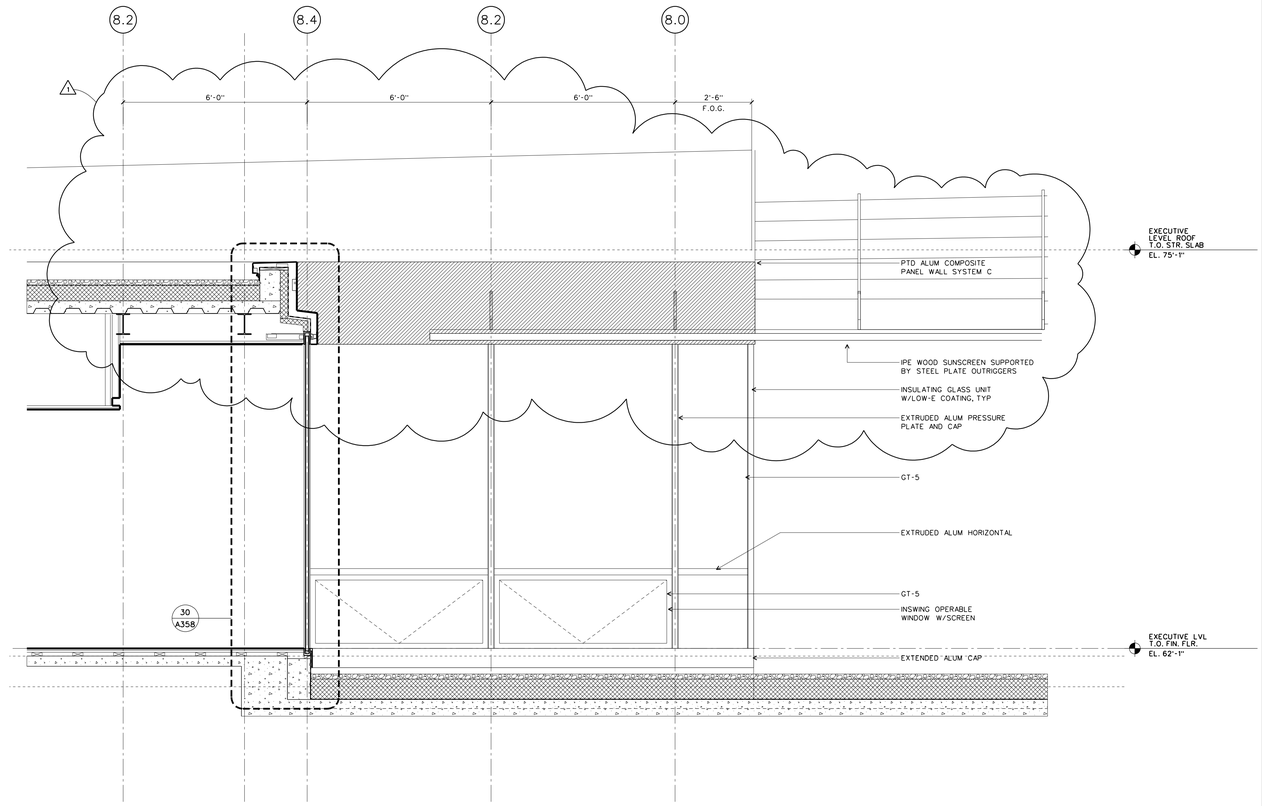

WALL SYSTEM A3: EAST ELEVATION AT NORTH CORNER AND SECTION THROUGH GALLERY

SCALE: ½" = 1'-0"

DETAILS/DTL-CWA7 20

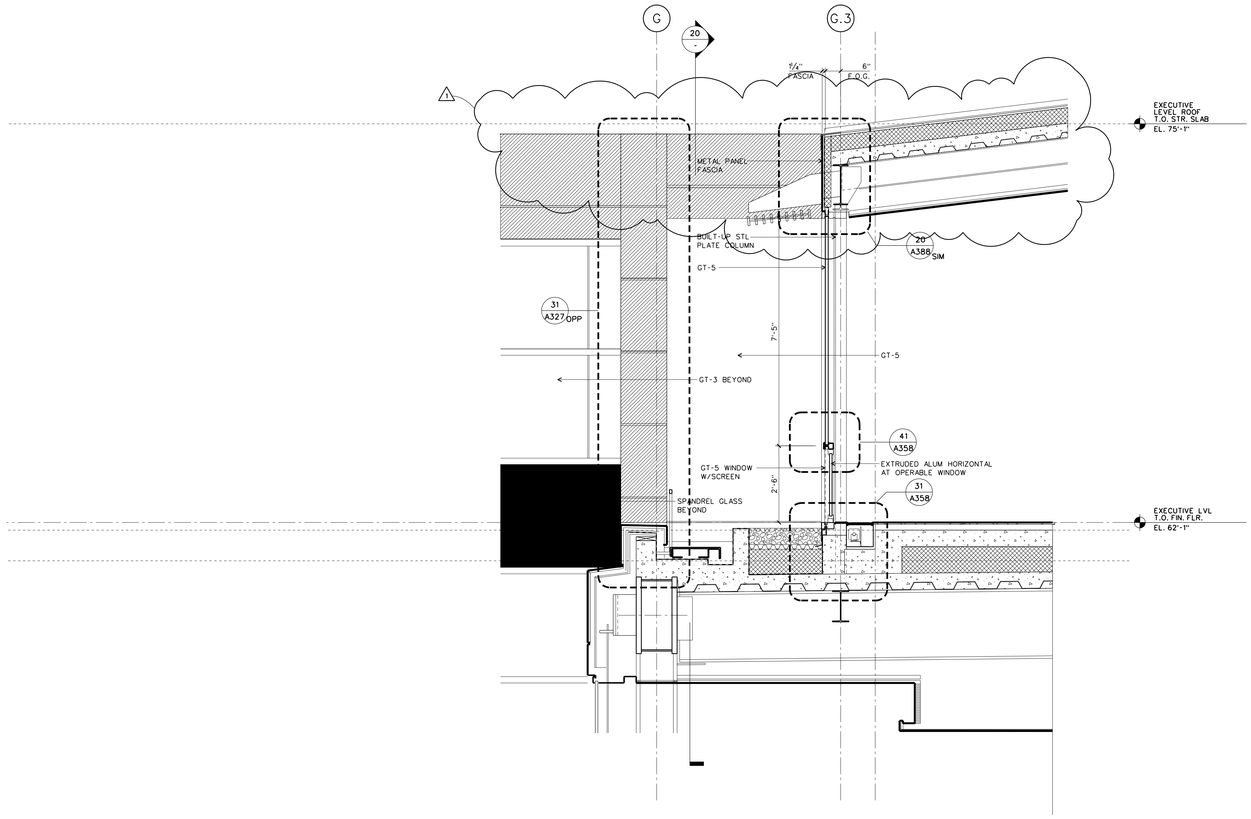

WALL SYSTEM A3: WALL SECTION THRU WINDOW

SCALE: ½" = 1'-0"

DETAILS/DTL-CWA7 10

WILLIAM J. CLINTON PRESIDENTIAL CENTER

LITTLE ROCK, ARKANSAS

Architect

POLSHEK PARTNERSHIP LLP
320 West 13th Street
New York, New York 10014
212.807.7171

Coordinating Architects

POLK STANLEY YEARY ARCHITECTS Ltd
700 South Schiller Street
Little Rock, Arkansas 72201
501.378.0878

WITSELL EVANS RASCO
901 West Third Street
Little Rock, Arkansas 72201
501.374.5300

WOODS CARADINE ARCHITECTS
2200 South Main Street
Little Rock, Arkansas 72206
501.374.4060

Landscape Architects

HARGREAVES ASSOCIATES
118 Magazine Street
Cambridge, Massachusettes 02139
617.661.0070

LANDSCAPE ARCHITECTURE, Inc.
2300 Cottondale Lane Suite 202
Little Rock, Arkansas 72202
501.374.5610

Structural Engineer

LESLIE E. ROBERTSON ASSOC., RLLP
30 Broad Street, 47th Floor
New York, New York 10004
212.750.9000

MEP Engineers

FLACK + KURTZ Inc.
475 Fifth Avenue
New York, New York 10017
212.532.9600


CROMWELL ARCHITECTS ENGINEERS
101 South Spring Street
Little Rock, Arkansas 72201
501.372.2900

Curtainwall Consultant

R. A. HEINTGES ARCHITECTS
126 Fifth Avenue, 9th Floor
New York, New York 10011
212.652-2966

Seal

	Issue	Date
1	100% Construction Documents	09/27/02
	100% Struct./ CD Progress	07/01/02
	100% Design Development	03/01/02

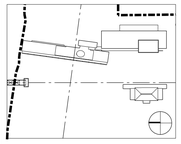

Job No.
9908


Scale
1-1/2" = 1'-0"

Date
September 27, 2002

Title
WALL SYSTEM A3
ELEVATION AND
SECTIONS


Sheet No.
A325a

FOR OFFICIAL USE ONLY

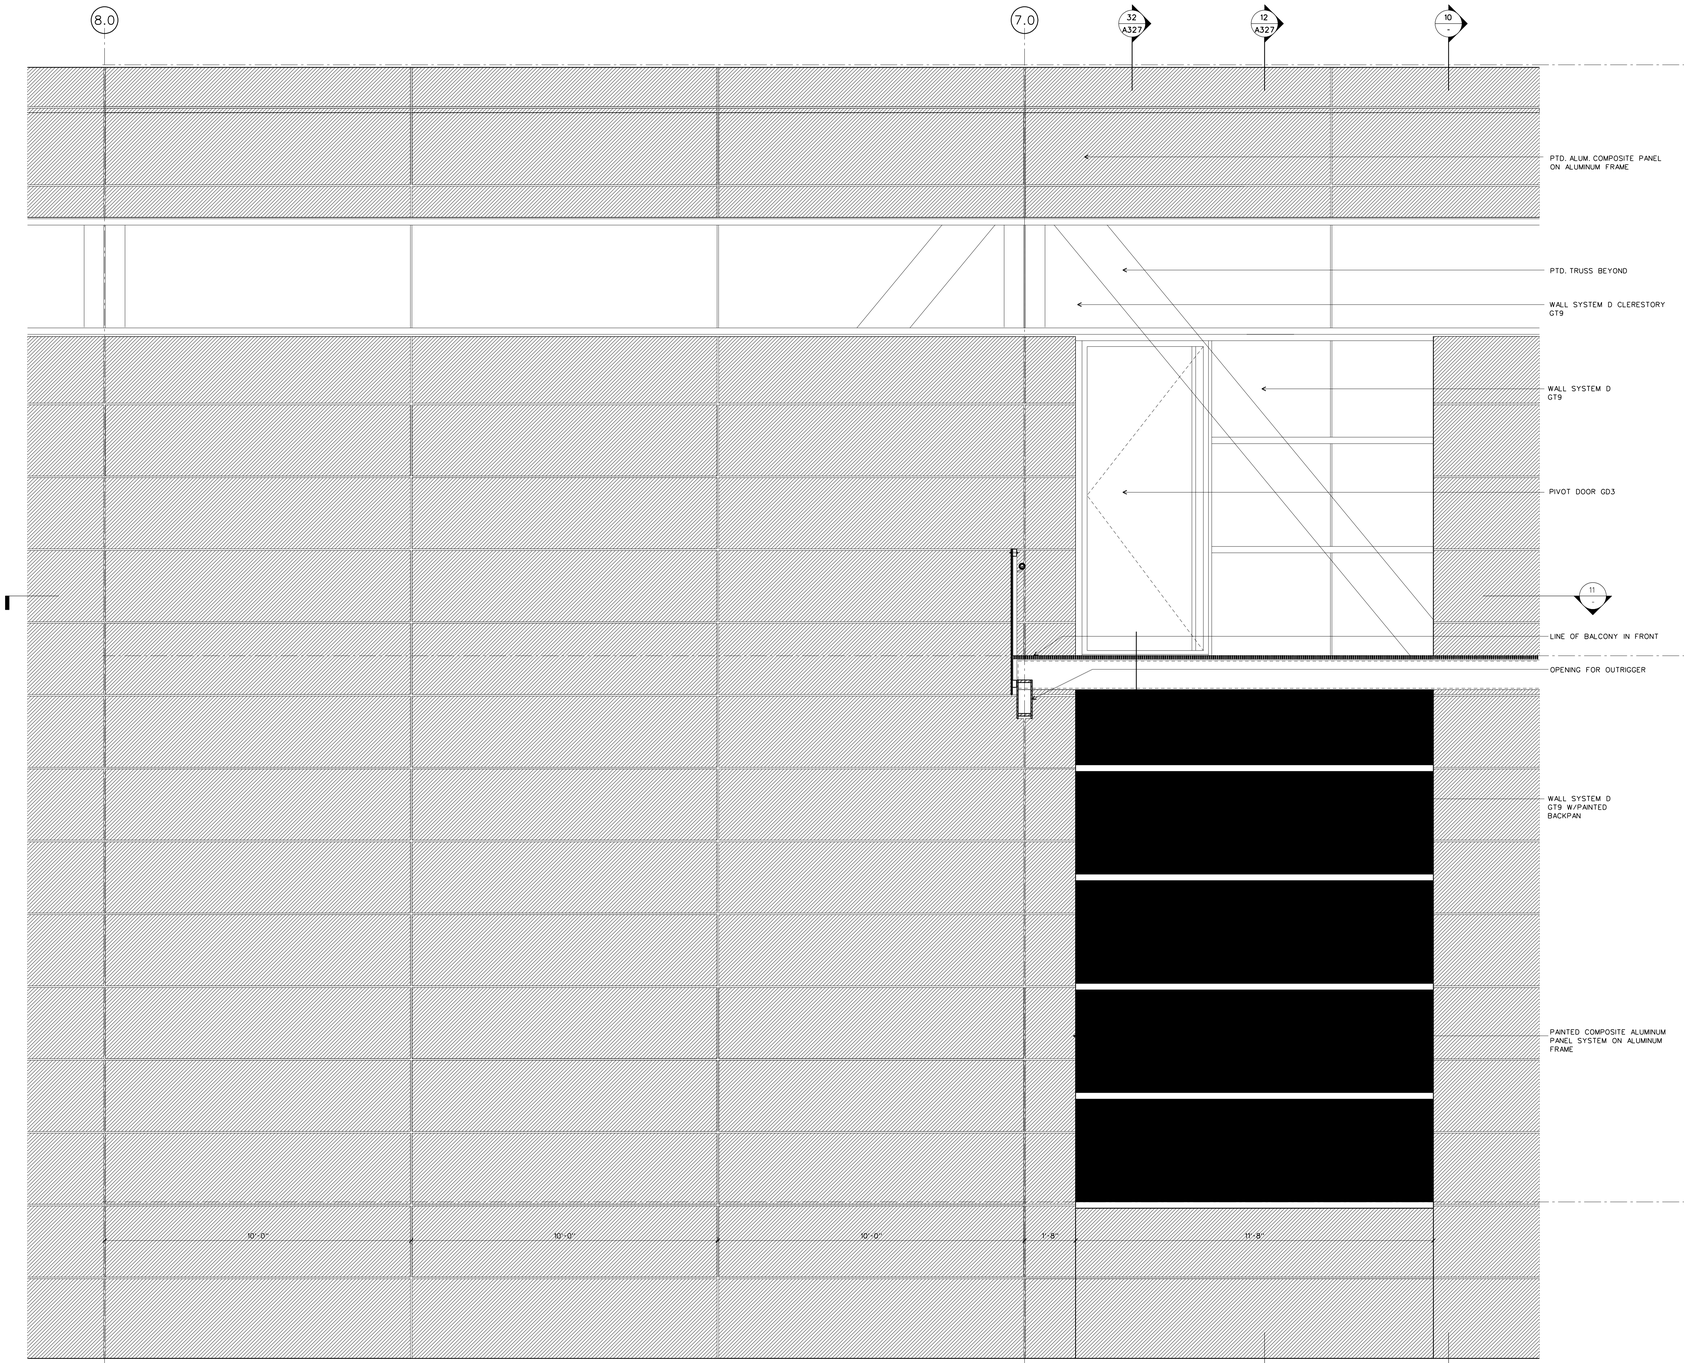


WALL SYSTEM C: ELEVATION


SCALE: 1/2" = 1'-0"

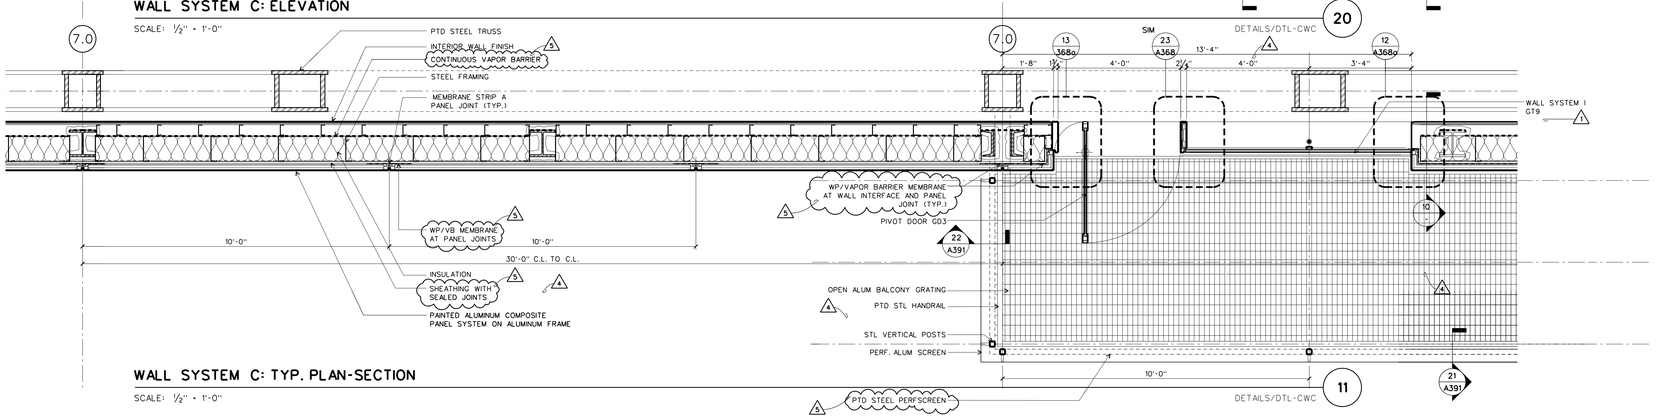

WALL SYSTEM C: TYP. PLAN-SECTION

SCALE: 1/2" = 1'-0"

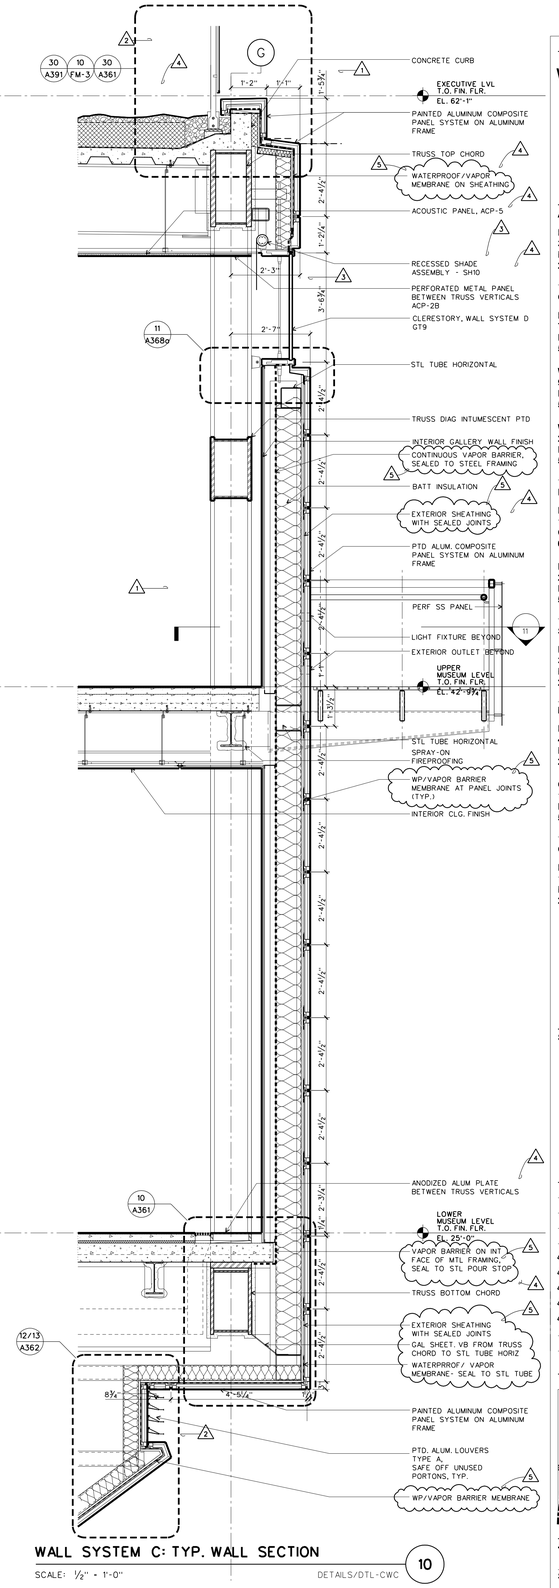
30
A391
10
FM-3
30
A361
G
1'-2"
1'-1"
CONCRETE CURB
EXECUTIVE LVL T.O. FIN. FLR. EL. 62'-1"
PAINTED ALUMINUM COMPOSITE PANEL SYSTEM ON ALUMINUM FRAME
TRUSS TOP CHORD
WATERPROOF/VAPOR MEMBRANE ON SHEATHING
ACOUSTIC PANEL, ACP-5
RECESSED SHADE ASSEMBLY - SH10
PERFORATED METAL PANEL BETWEEN TRUSS VERTICALS ACP-2B
CLERESTORY, WALL SYSTEM D GT9
11
A368
STL TUBE HORIZONTAL
TRUSS DIAG INTUMESCENT PTD
INTERIOR GALLERY WALL FINISH
CONTINUOUS VAPOR BARRIER, SEALED TO STEEL FRAMING
BATT INSULATION
EXTERIOR SHEATHING WITH SEALED JOINTS
PTD ALUM. COMPOSITE PANEL SYSTEM ON ALUMINUM FRAME
PERF SS PANEL
LIGHT FIXTURE BEYOND
EXTERIOR OUTLET BEYOND
UPPER MUSEUM LEVEL T.O. FIN. FLR. EL. 42'-9 1/2"
STL TUBE HORIZONTAL
SPRAY-ON FIREPROOFING
WP/VAPOR BARRIER MEMBRANE AT PANEL JOINTS (TYP.)
INTERIOR CLG. FINISH
2'-4 1/2"
1'-2 3/4"
2'-3"
3'-6 3/4"
2'-7"
2'-4 1/2"
2'-4 1/2"
2'-4 1/2"
2'-4 1/2"
2'-4 1/2"
2'-4 1/2"
2'-3 1/4"
2'-4 1/2"
1'-5 1/2"
2'-4 1/2"
2'-4 1/2"
2'-4 1/2"
2'-4 1/2"
2'-4

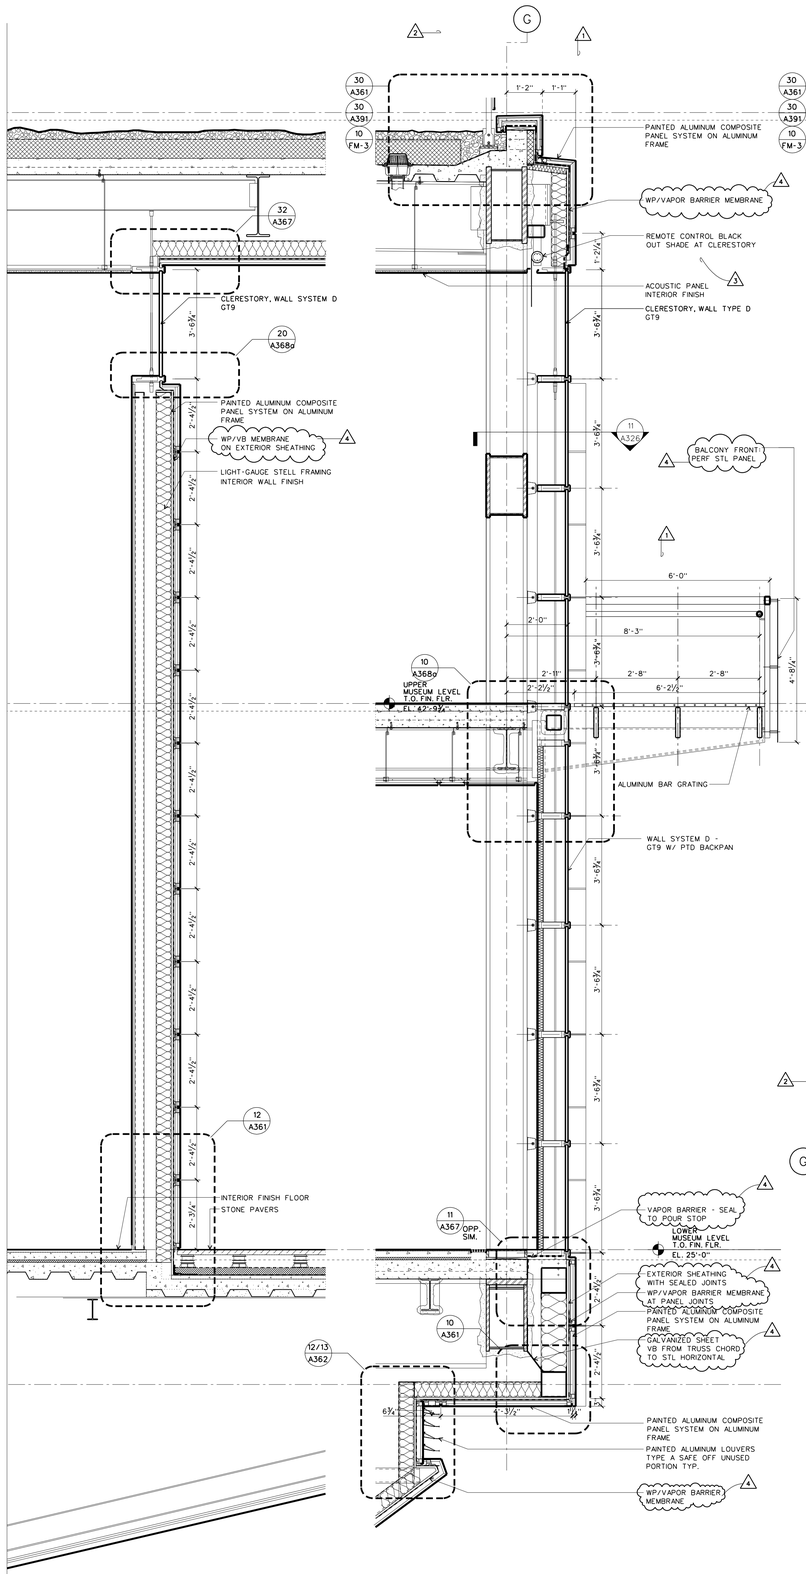


WALL SYSTEM C: WALL SECTION @ SOUTH RETURNING WALL

SCALE: ½" = 1'-0" DETAILS/DTL-CWC2 13


WALL SYSTEM C: WALL SECTION @ BALCONY

SCALE: ½" = 1'-0" DETAILS/DTL-CWC2 12

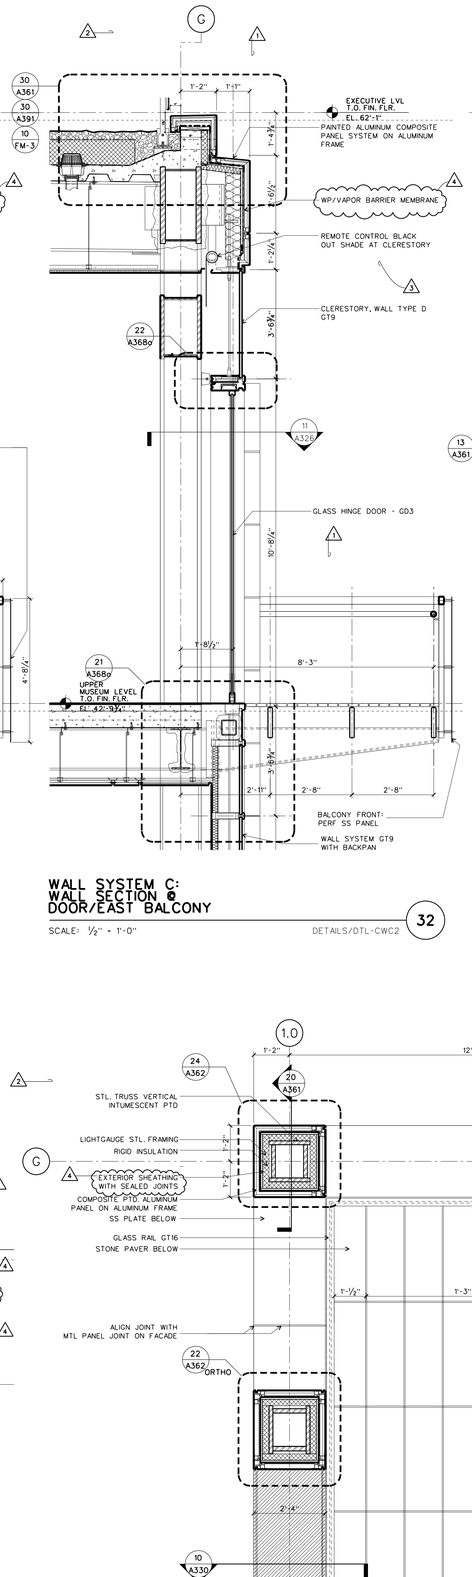

WALL SYSTEM C: WALL SECTION @ DOOR/EAST BALCONY

SCALE: ½" = 1'-0" DETAILS/DTL-CWC2 32

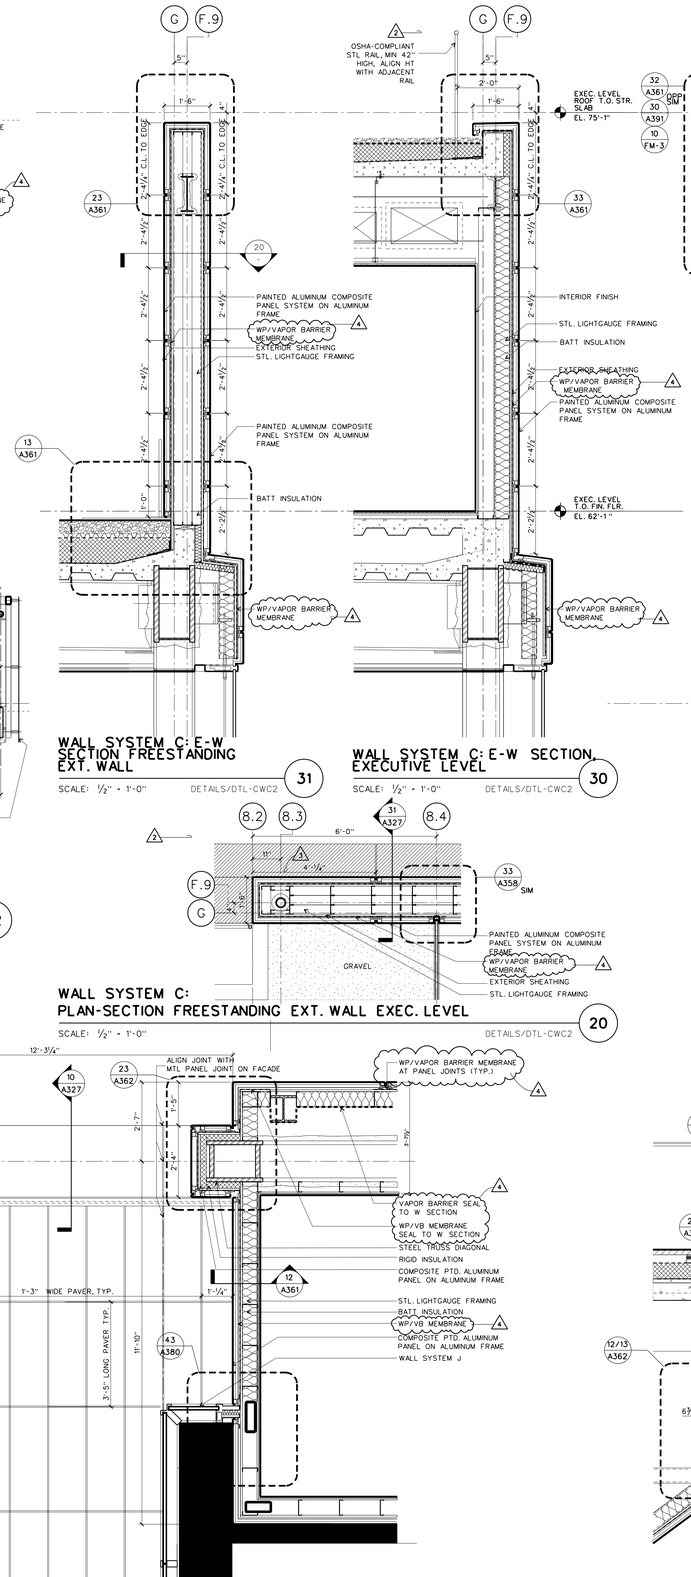

WALL SYSTEM C: E-W SECTION FREESTANDING EXT. WALL


SCALE: ½" = 1'-0" DETAILS/DTL-CWC2 31

WALL SYSTEM C: E-W SECTION, EXECUTIVE LEVEL

SCALE: ½" = 1'-0" DETAILS/DTL-CWC2 30


WALL SYSTEM C: PLAN-SECTION FREESTANDING EXT. WALL EXEC. LEVEL

SCALE: ½" = 1'-0" DETAILS/DTL-CWC2 20

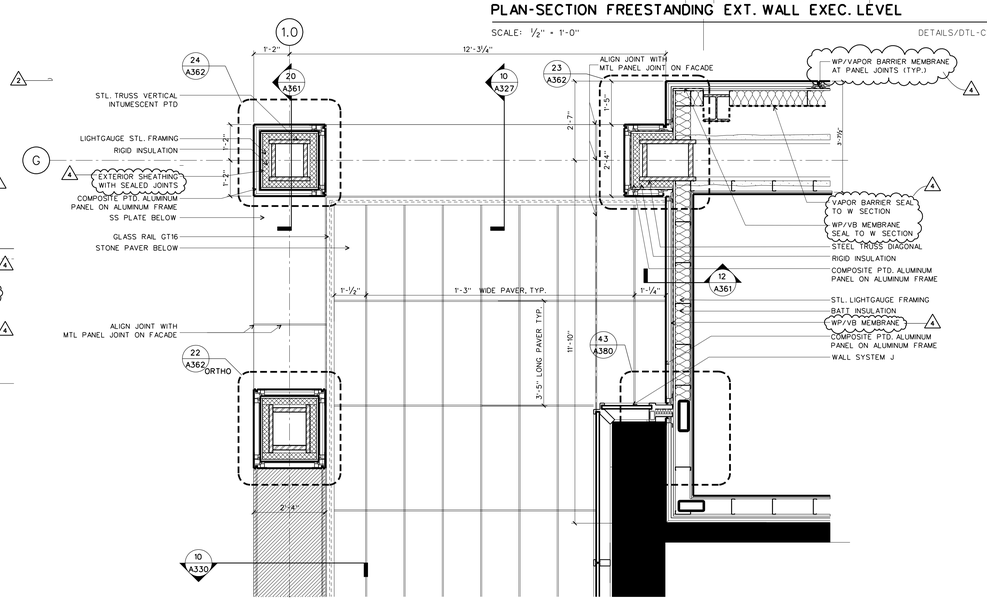

WALL SYSTEM C: WALL SECTION @ WINDOW/BALCONY

SCALE: ½" = 1'-0" DETAILS/DTL-CWC2 11

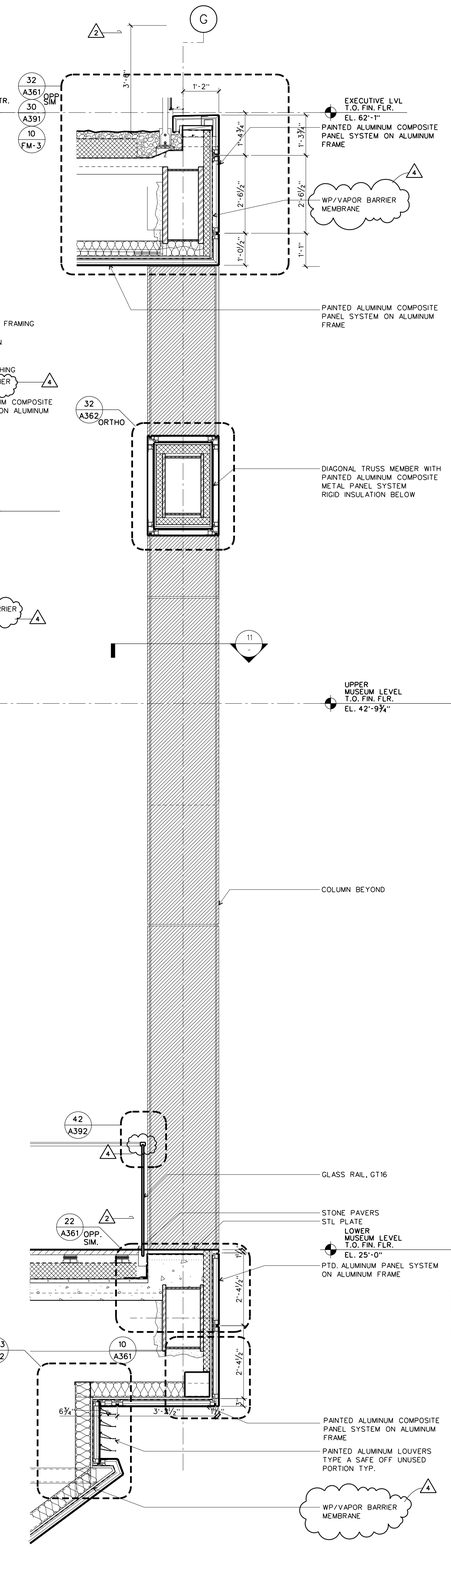

WALL SYSTEM C: WALL SECTION @ COLUMN COVER

SCALE: ½" = 1'-0" DETAILS/DTL-CWC2 10

WILLIAM J. CLINTON PRESIDENTIAL CENTER

LITTLE ROCK, ARKANSAS

Architect

POLSHEK PARTNERSHIP LLP
320 West 13th Street
New York, New York 10014
212.807.7171

Coordinating Architects

POLK STANLEY YEARY ARCHITECTS Ltd
700 South Schiller Street
Little Rock, Arkansas 72201
501.378.0878

WITSELL EVANS RASCO
901 West Third Street
Little Rock, Arkansas 72201
501.374.5300

WOODS CARADINE ARCHITECTS
2200 South Main Street
Little Rock, Arkansas 72206
501.374.4060

Landscape Architects

HARGREAVES ASSOCIATES
118 Magazine Street
Cambridge, Massachusettes 02139
617.661.0070

LANDSCAPE ARCHITECTURE, Inc.
2300 Cottondale Lane Suite 202
Little Rock, Arkansas 72202
501.374.5610

Structural Engineer

LESLIE E. ROBERTSON ASSOC., RLLP
30 Broad Street, 47th Floor
New York, New York 10004
212.750.9000

MEP Engineers

FLACK + KURTZ Inc.
475 Fifth Avenue
New York, New York 10017
212.532.9600

CROMWELL ARCHITECTS ENGINEERS
101 South Spring Street
Little Rock, Arkansas 72201
501.372.2900

Curtainwall Consultant

R. A. HEINTGES ARCHITECTS
126 Fifth Avenue, 9th Floor
New York, New York 10011
212.652-2966

Seal

Issue	Date
1 ASI #22	08/01/03
2 Addendum #2	11/15/02
3 100% Construction Documents	09/27/02
4 90% Progress Printing	08/30/02
100% Struct./ CD Progress	07/01/02
100% Design Development	03/01/02

Job No. 9908

Scale 1/2" = 1'-0"

Date September 27, 2002


Title

WALL SYSTEM C: PLANS AND SECTIONS

Sheet No.


A327

FOR OFFICIAL USE ONLY

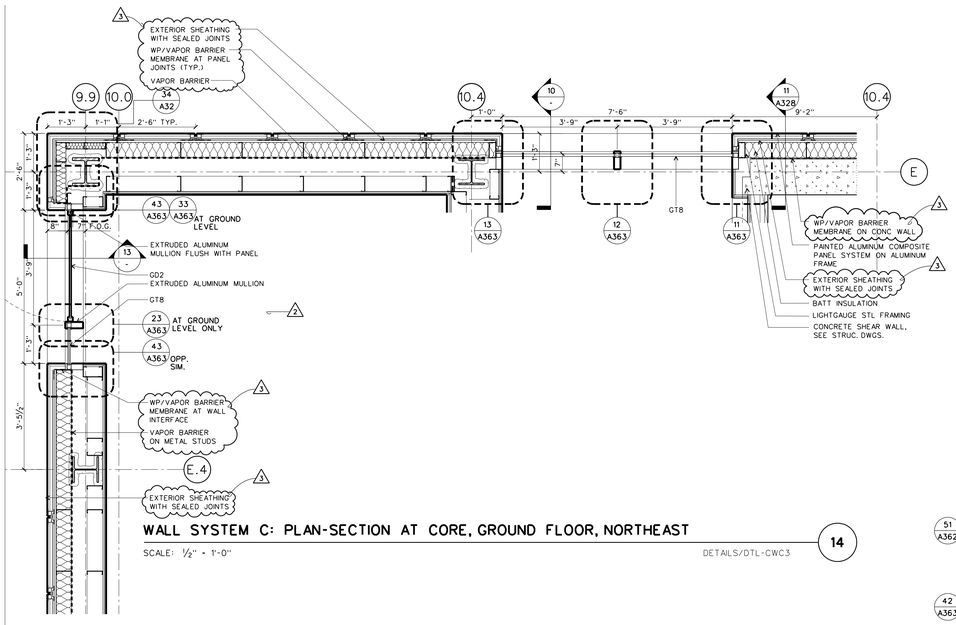

WALL SYSTEM C: PLAN-SECTION AT CORE, GROUND FLOOR, NORTHEAST

SCALE: 1/2" = 1'-0" DETAILS/DTL-CWC3 — 14

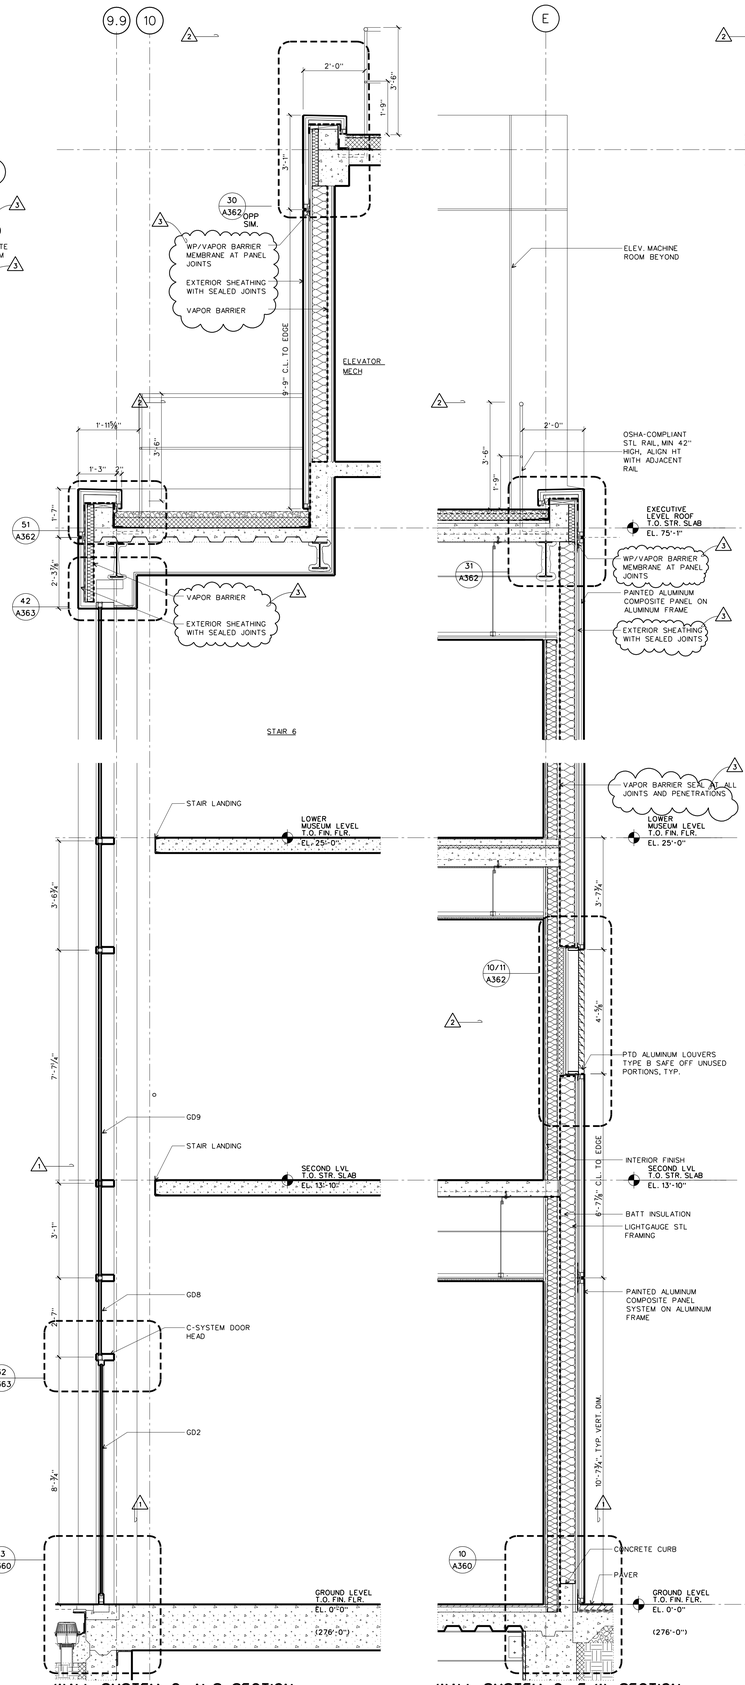


WALL SYSTEM C: N-S SECTION, CORE BUILDING, AT GLAZING

SCALE: 1/2" = 1'-0" DETAILS/DTL-CWC3 — 13

WALL SYSTEM C: E-W SECTION CORE BDG. AT MTL. PANEL

SCALE: 1/2" = 1'-0" DETAILS/DTL-CWC3 — 12

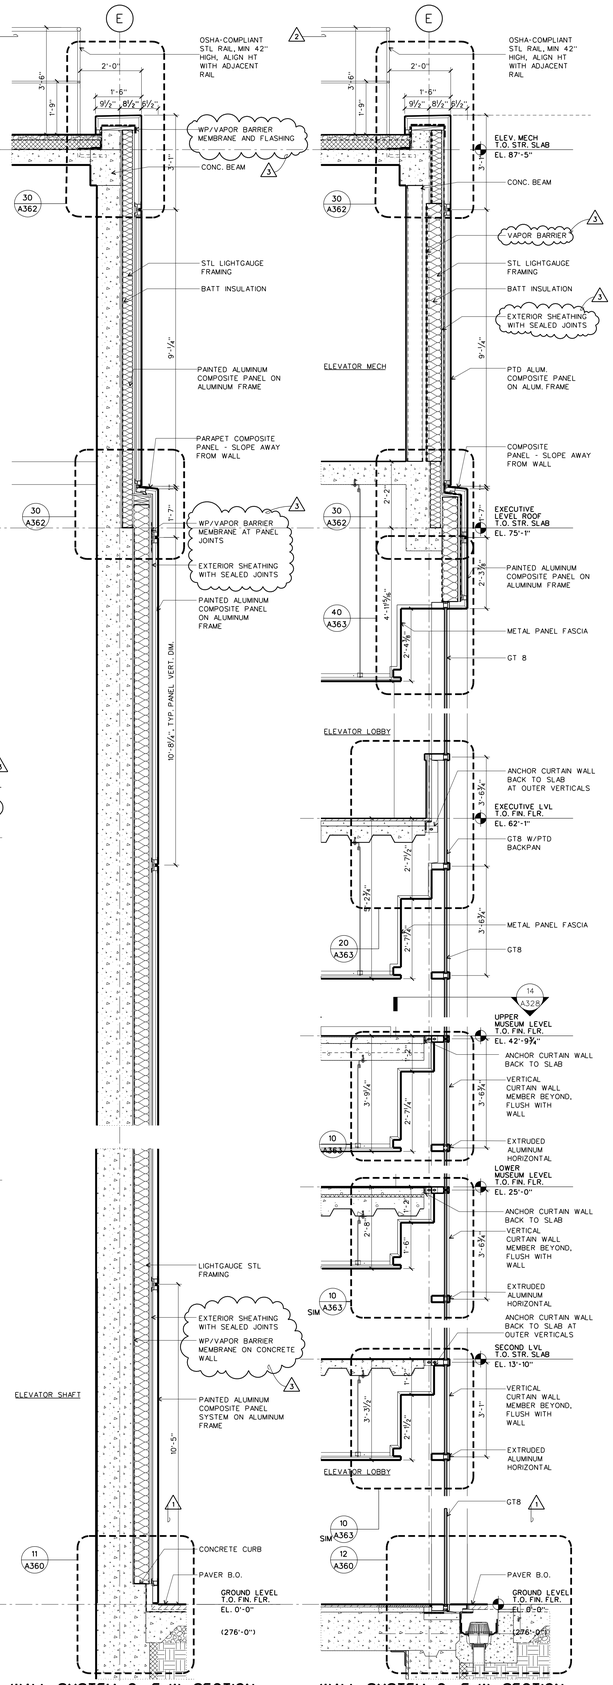

WALL SYSTEM C: E-W SECTION CORE BLDG. AT SHEAR WALL

SCALE: 1/2" = 1'-0" DETAILS/DTL-CWC3 — 11

WALL SYSTEM C: E-W SECTION CORE BLDG. AT GLAZING

SCALE: 1/2" = 1'-0" DETAILS/DTL-CWC3 — 10

WILLIAM J. CLINTON PRESIDENTIAL CENTER

LITTLE ROCK, ARKANSAS

Architect

POLSHEK PARTNERSHIP LLP
320 West 13th Street
New York, New York 10014
212.807.7171

Coordinating Architects

POLK STANLEY YEARY ARCHITECTS Ltd
700 South Schiller Street
Little Rock, Arkansas 72201
501.378.0878

WITSELL EVANS RASCO
901 West Third Street
Little Rock, Arkansas 72201
501.374.5300

WOODS CARADINE ARCHITECTS
2200 South Main Street
Little Rock, Arkansas 72206
501.374.4060

Landscape Architects

HARGREAVES ASSOCIATES
118 Magazine Street
Cambridge, Massachusettes 02139
617.661.0070

LANDSCAPE ARCHITECTURE, Inc.
2300 Cottondale Lane Suite 202
Little Rock, Arkansas 72202
501.374.5610

Structural Engineer

LESLIE E. ROBERTSON ASSOC., RLLP
30 Broad Street, 47th Floor
New York, New York 10004
212.750.9000

MEP Engineers

FLACK + KURTZ Inc.
475 Fifth Avenue
New York, New York 10017
212.532.9600


CROMWELL ARCHITECTS ENGINEERS
101 South Spring Street
Little Rock, Arkansas 72201
501.372.2900

Curtainwall Consultant

R. A. HEINTGES ARCHITECTS
126 Fifth Avenue, 9th Floor
New York, New York 10011
212.652-2966

Seal

Issue	Date
3 ASI #22	08/01/03
2 100% Construction Documents	09/27/02
1 90% Progress Printing	08/30/02
100% Struct./ CD Progress	07/01/02
Bridge Bldg. Substructure	06/14/02
100% Design Development	03/01/02

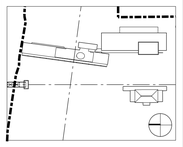

Job No. 9908

Scale 1/2" = 1'-0"

Date September 27, 2002


Title

WALL SYSTEM C
PLAN AND SECTIONS

Sheet No.

A328

FOR OFFICIAL USE ONLY

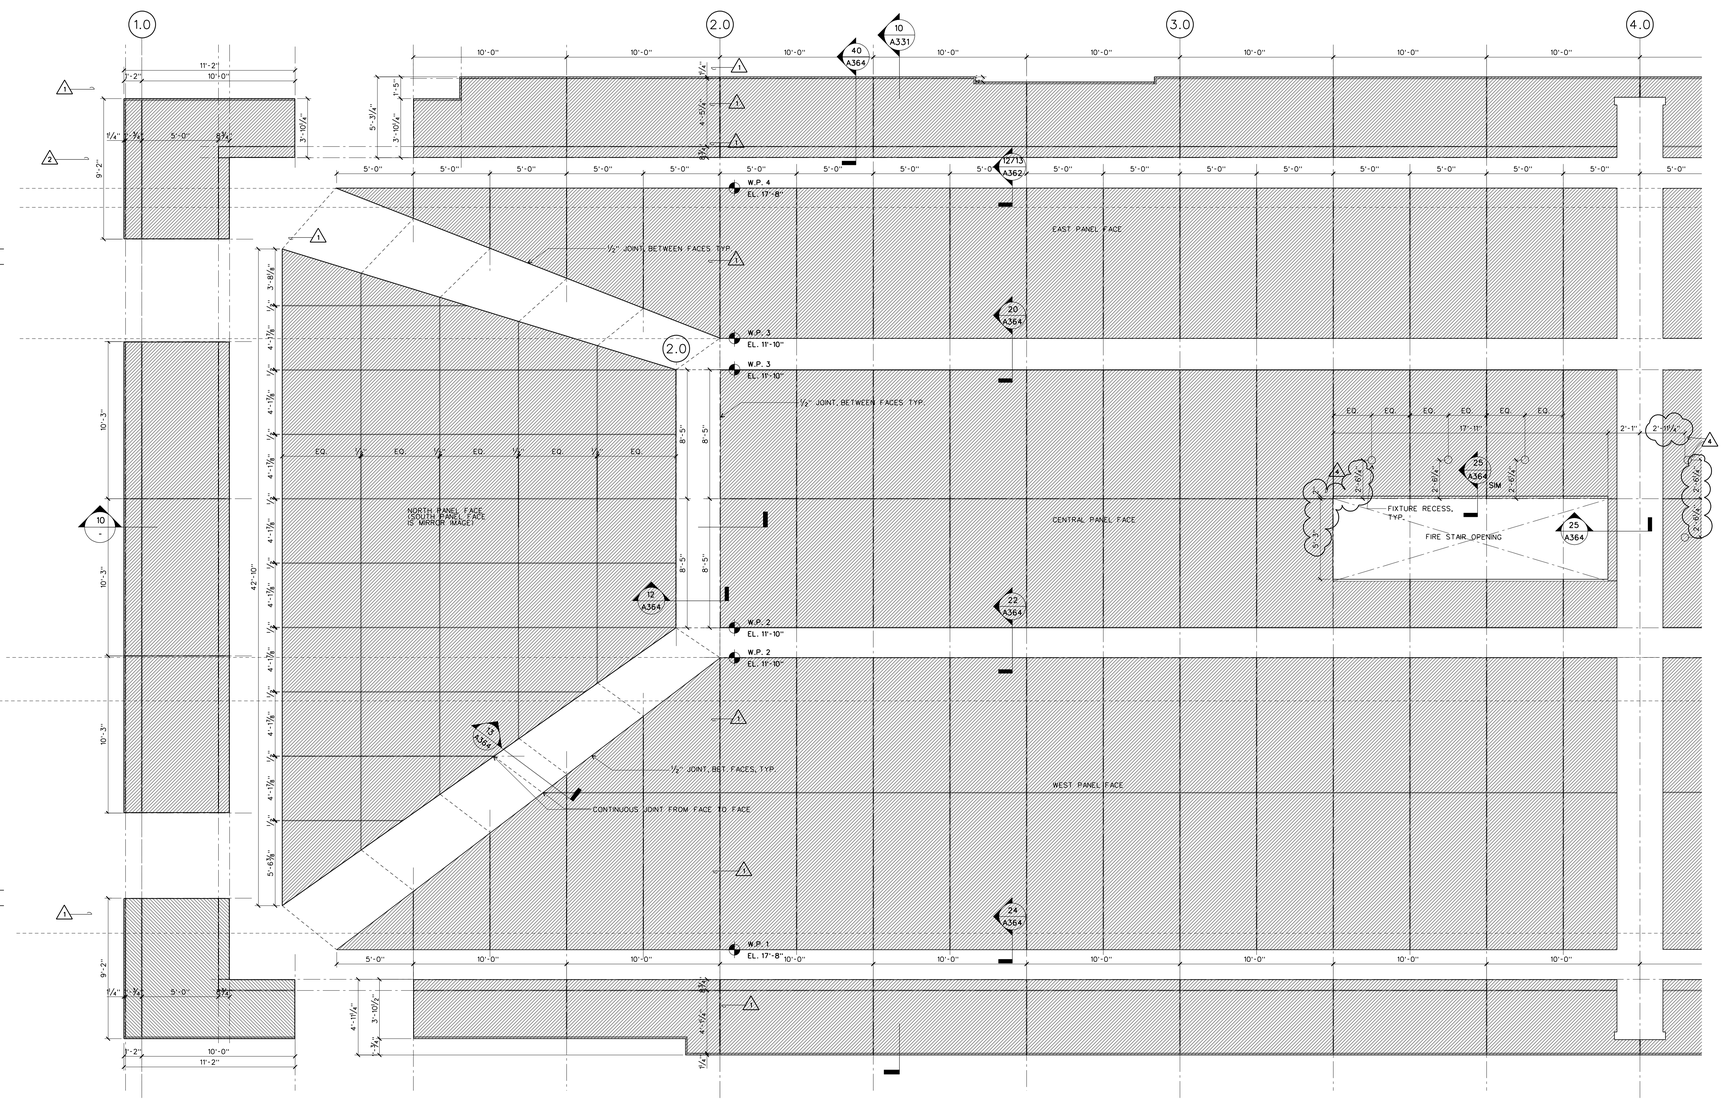

WALL SYSTEM C: DEVELOPED UNDERSIDE PLAN AT NORTH END OF BRIDGE


SCALE: 1/4" = 1'-0"

DETAILS/DTL-CWC4 — 21

WALL SYSTEM C: DEVELOPED UNDERSIDE PLAN AT NORTH END OF LOBBY

SCALE: 1/4" = 1'-0"

RCP-DEVEL-01 — 20

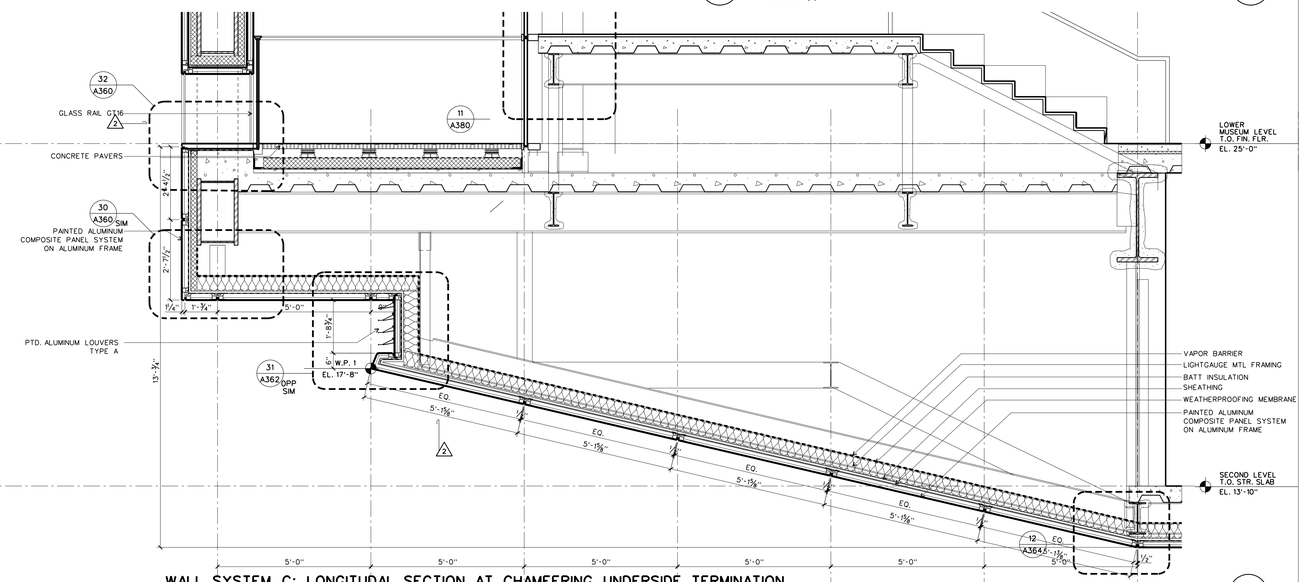

WALL SYSTEM C: LONGITUDAL SECTION AT CHAMFERING UNDERSIDE TERMINATION

SCALE: 1/2" = 1'-0"

DETAILS/DTL-CWC5 — 10

WILLIAM J. CLINTON PRESIDENTIAL CENTER

LITTLE ROCK, ARKANSAS

Architect

POLSHEK PARTNERSHIP LLP
320 West 13th Street
New York, New York 10014
212.807.7171

Coordinating Architects

POLK STANLEY YEARY ARCHITECTS Ltd
700 South Schiller Street
Little Rock, Arkansas 72201
501.378.0878

WITSELL EVANS RASCO
901 West Third Street
Little Rock, Arkansas 72201
501.374.5300

WOODS CARADINE ARCHITECTS
2200 South Main Street
Little Rock, Arkansas 72206
501.374.4060

Landscape Architects

HARGREAVES ASSOCIATES
118 Magazine Street
Cambridge, Massachusettes 02139
617.661.0070

LANDSCAPE ARCHITECTURE, Inc.
2300 Cottondale Lane Suite 202
Little Rock, Arkansas 72202
501.374.5610

Structural Engineer

LESLIE E. ROBERTSON ASSOC., RLLP
30 Broad Street, 47th Floor
New York, New York 10004
212.750.9000

MEP Engineers

FLACK + KURTZ Inc.
475 Fifth Avenue
New York, New York 10017
212.532.9600

CROMWELL ARCHITECTS ENGINEERS
101 South Spring Street
Little Rock, Arkansas 72201
501.372.2900

Curtainwall Consultant

R. A. HEINTGES ARCHITECTS
126 Fifth Avenue, 9th Floor
New York, New York 10011
212.652-2966

Seal

Issue	Date
4 ASI #29	03/05/04
3 ASI #23	09/12/03
2 100% Construction Documents	09/27/02
1 90% Progress Printing	08/30/02
100% Struct./ CD Progress*	07/01/02

*New sheet / former A330 now A331

Job No. 9908


Scale AS NOTED

Date September 27, 2002

Title
WALL SYSTEM C: SECTION AND DEVELOPED RCP

Sheet No.
A330


FOR OFFICIAL USE ONLY

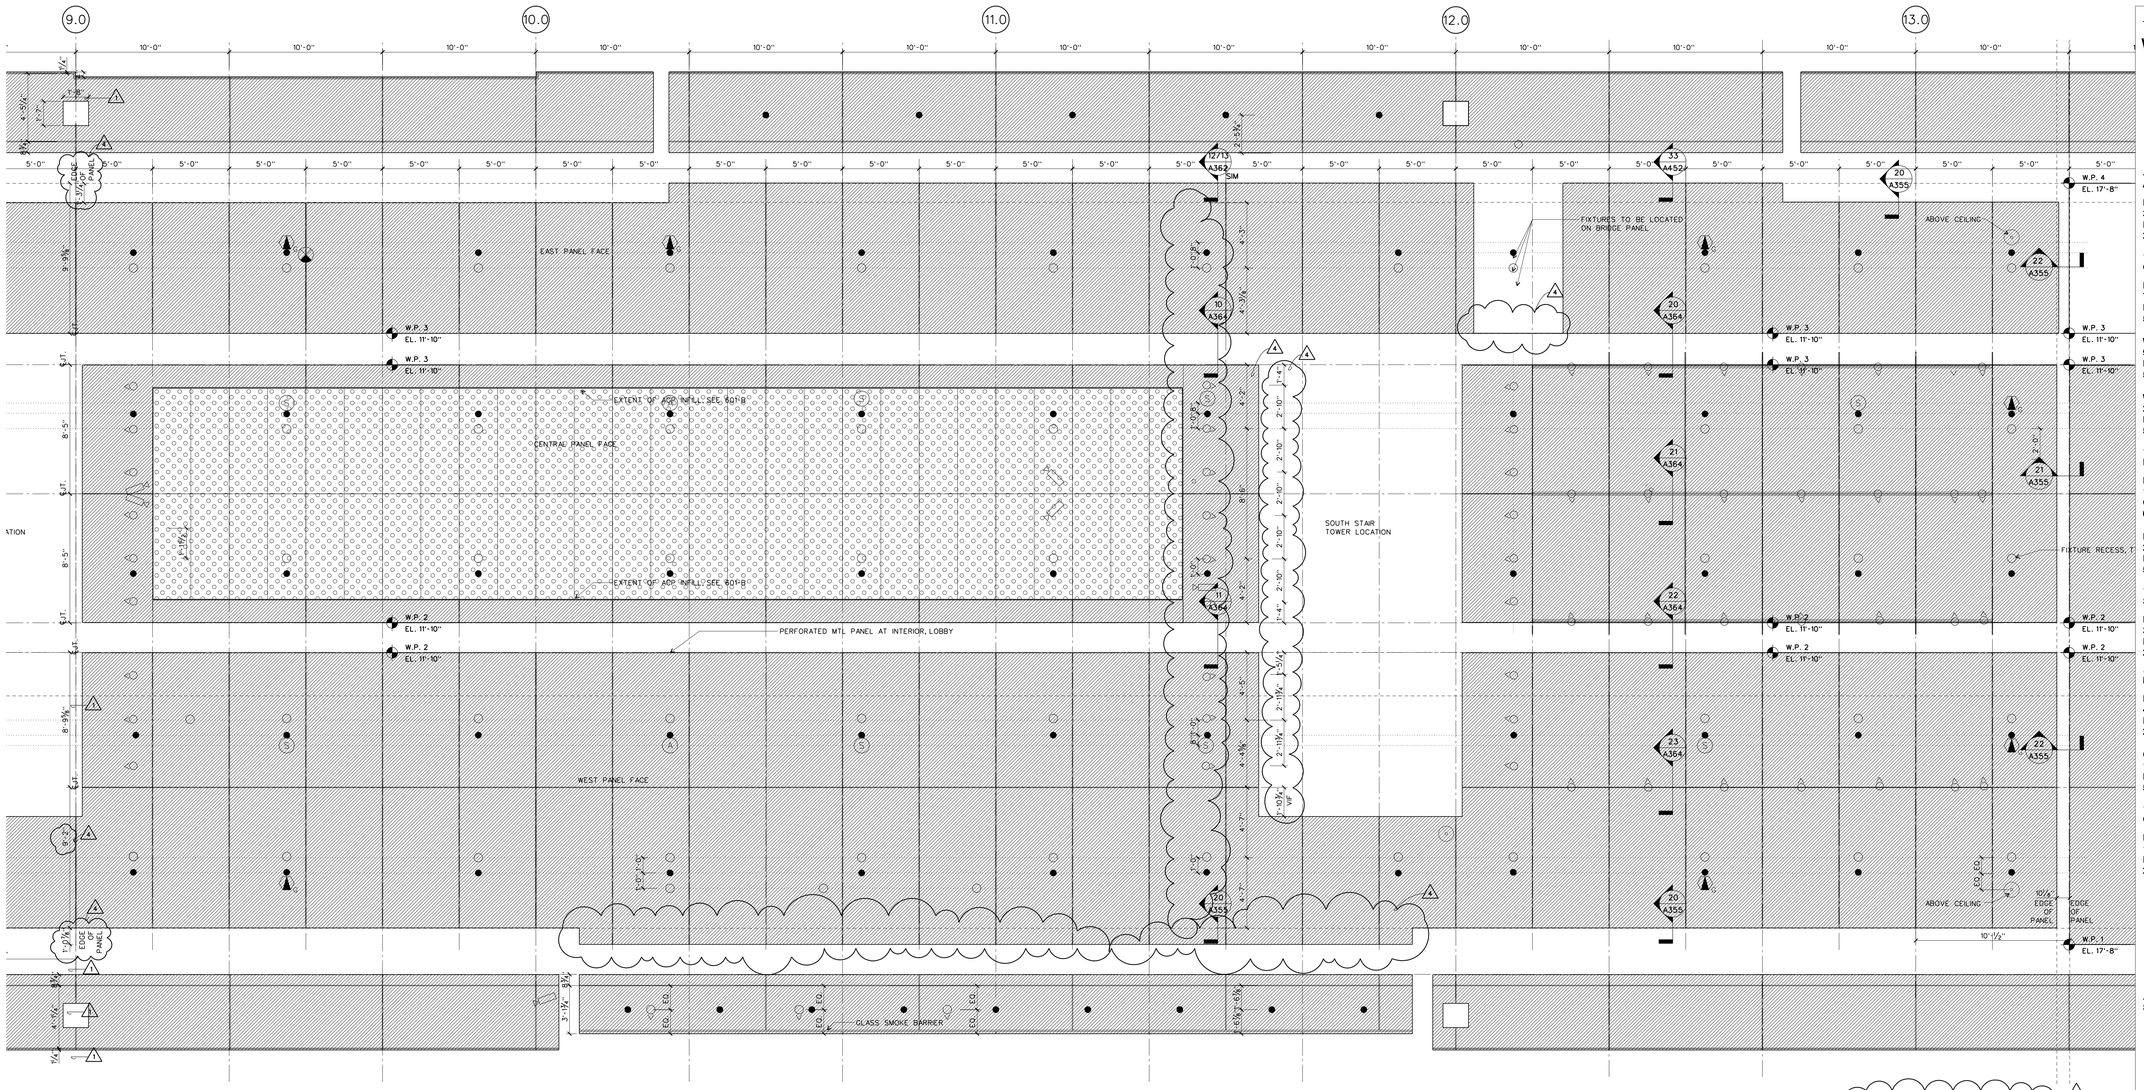

WALL SYSTEM C: DEVELOPED UNDERSIDE PLAN AT LOBBY

SCALE: 1/4" = 1'-0"

RCP-DEVEL-01 20

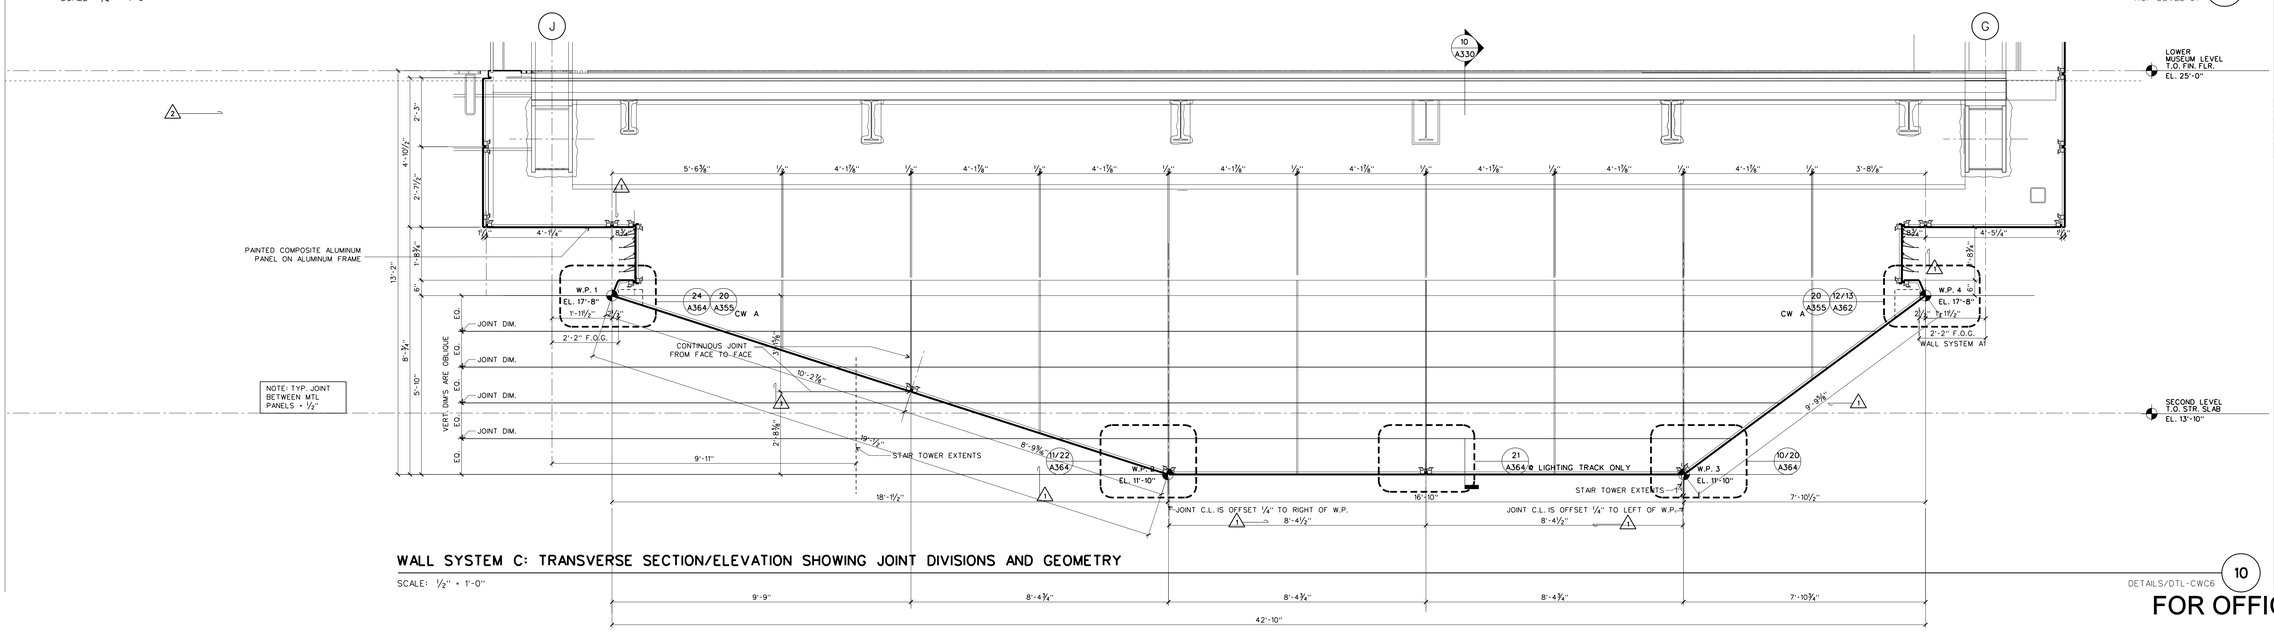

WALL SYSTEM C: TRANSVERSE SECTION/ELEVATION SHOWING JOINT DIVISIONS AND GEOMETRY

SCALE: 1/2" = 1'-0"

DETAILS/DTL-CWC6 10

FOR OFFICIAL USE ONLY

WILLIAM J. CLINTON PRESIDENTIAL CENTER

LITTLE ROCK, ARKANSAS

Architect

POLSHEK PARTNERSHIP LLP
320 West 13th Street
New York, New York 10014
212.807.7171

Coordinating Architects

POLK STANLEY YEARY ARCHITECTS Ltd
700 South Schiller Street
Little Rock, Arkansas 72201
501.378.0878

WITSELL EVANS RASCO
901 West Third Street
Little Rock, Arkansas 72201
501.374.5300

WOODS CARADINE ARCHITECTS
2200 South Main Street
Little Rock, Arkansas 72206
501.374.4060

Landscape Architects

HARGREAVES ASSOCIATES
118 Magazine Street
Cambridge, Massachusettes 02139
617.661.0070

LANDSCAPE ARCHITECTURE, Inc.
2300 Cottondale Lane Suite 202
Little Rock, Arkansas 72202
501.374.5610

Structural Engineer

LESLIE E. ROBERTSON ASSOC., RLLP
30 Broad Street, 47th Floor
New York, New York 10004
212.750.9000

MEP Engineers

FLACK + KURTZ Inc.
475 Fifth Avenue
New York, New York 10017
212.532.9600

CROMWELL ARCHITECTS ENGINEERS
101 South Spring Street
Little Rock, Arkansas 72201
501.372.2900

Curtainwall Consultant

R. A. HEINTGES ARCHITECTS
126 Fifth Avenue, 9th Floor
New York, New York 10011
212.652-2966

Seal

Issue	Date
100% Construction Documents	09/27/02
90% Progress Printing	08/30/02
ASI #005	08/20/02
AGC Struct./ CD Progress	09/02/02
Bidding Documents	08/24/02
90% Progress Printing CD	08/30/02
AGC Struct./ CD Progress	07/01/02
100% Design Development*	03/01/02

*Originally Issued as A330


Job No. 9908

Scale AS NOTED

Date September 27, 2002

Title WALL SYSTEM C TWO DIMENSIONAL DEVELOPED ROOF


Sheet No. A330

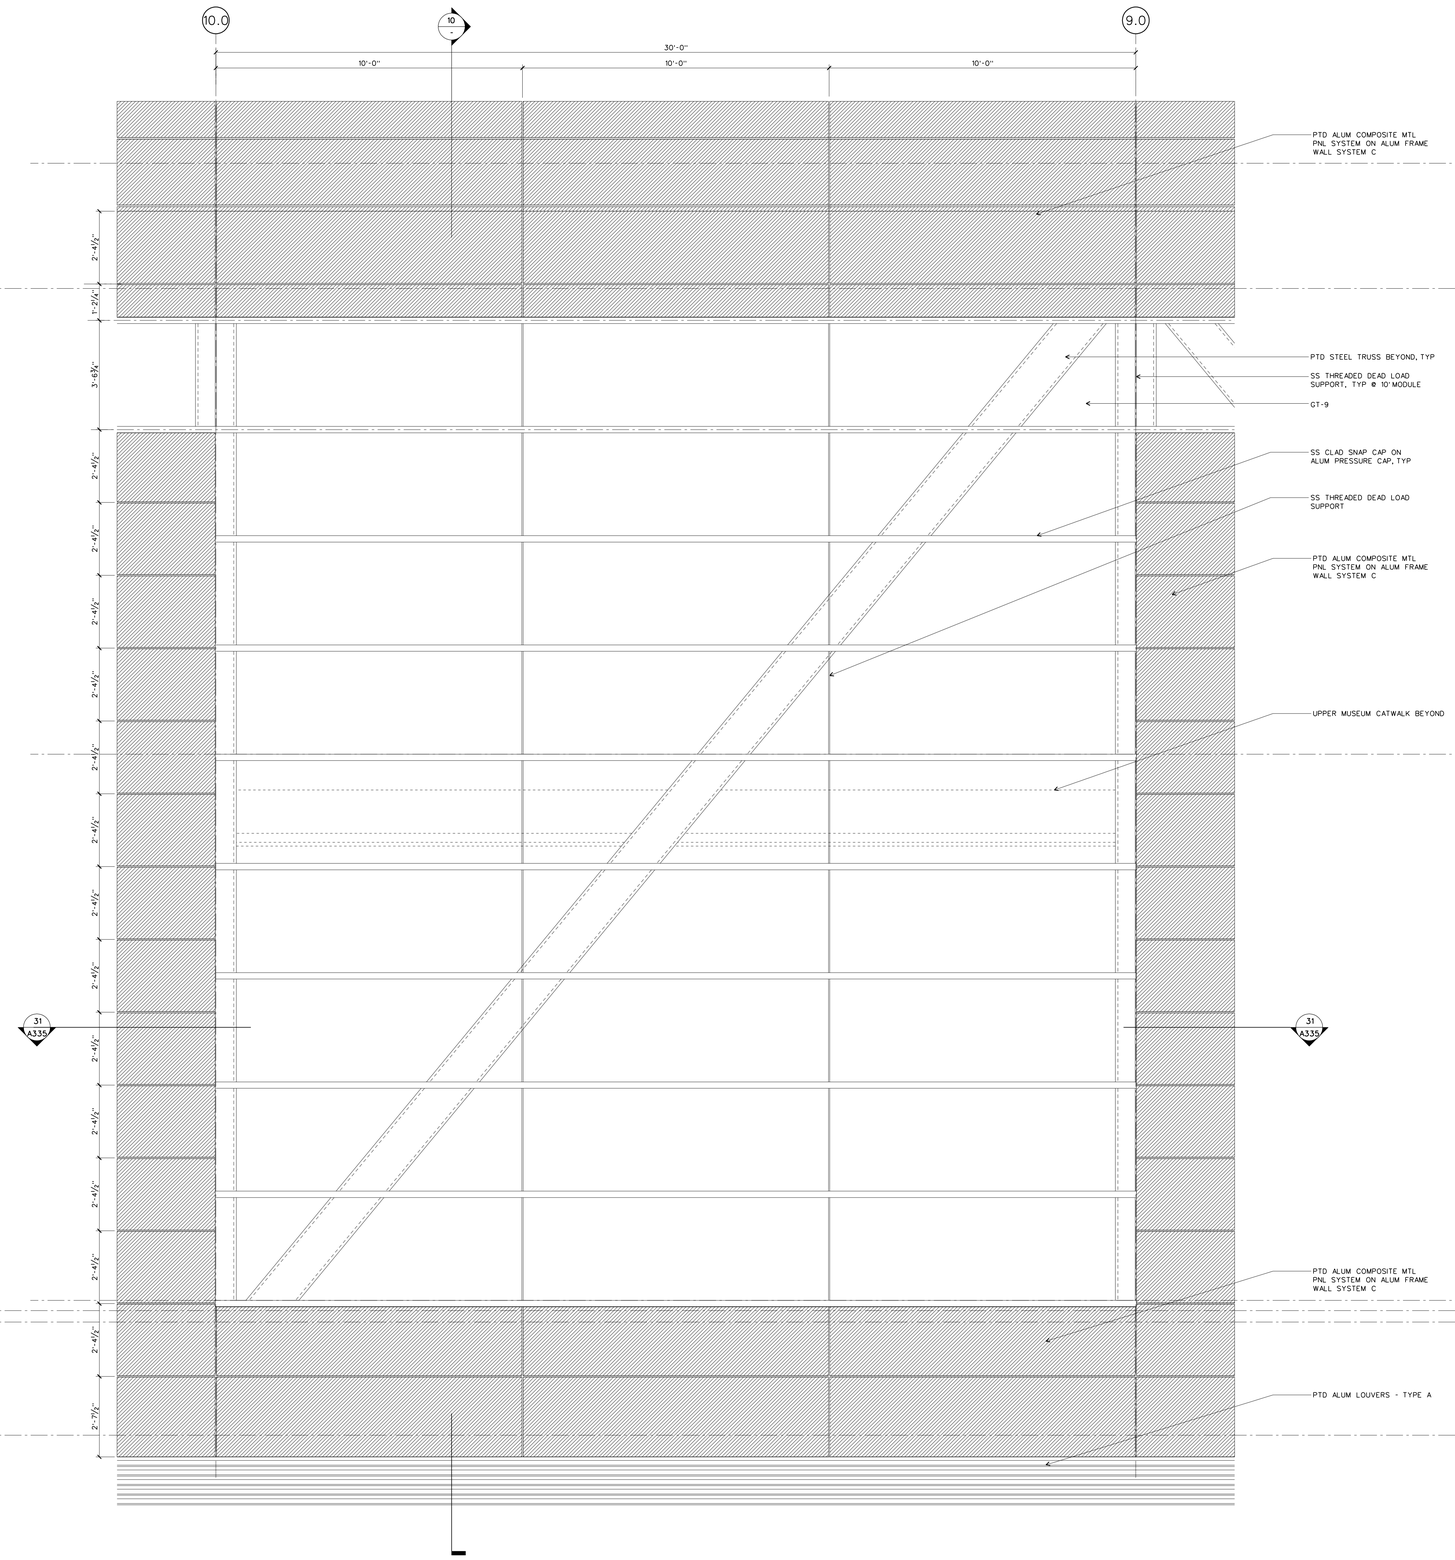

WALL SYSTEM D: ELEVATION AT EAST FACADE

SCALE: ½" = 1'-0"

DETAILS/DTL-CWD-E 11

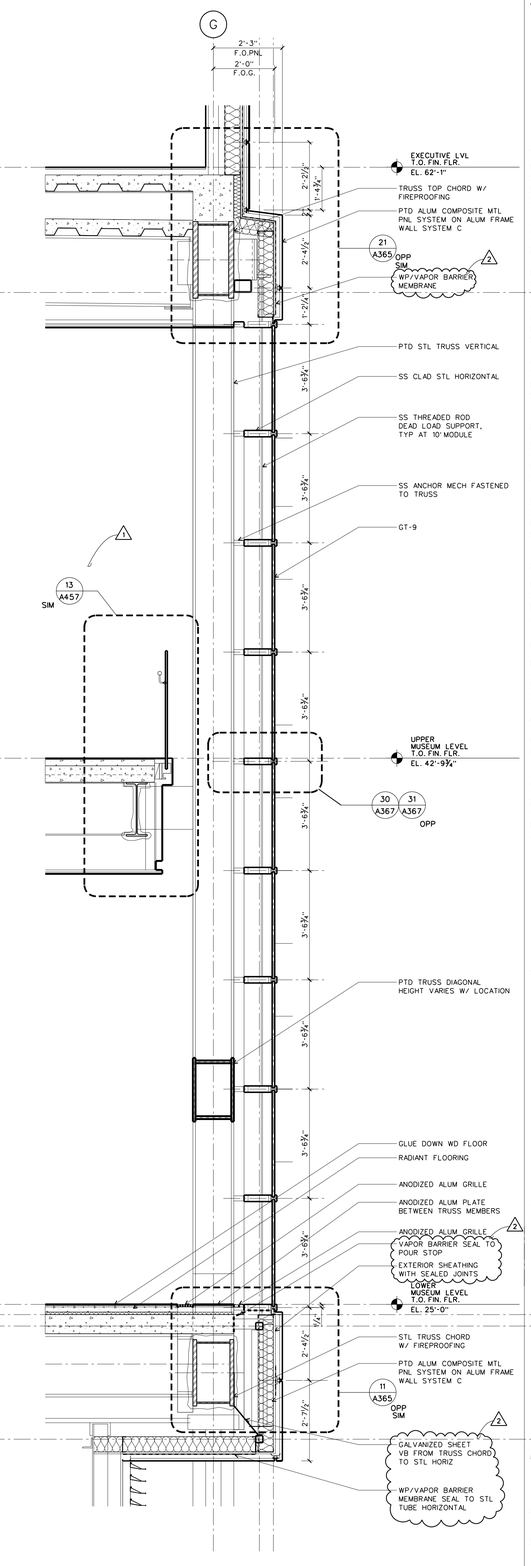

WALL SYSTEM D: WALL SECTION AT EAST FACADE

SCALE: ½" = 1'-0"

DETAILS/DTL-CWD-E 10

WILLIAM J. CLINTON PRESIDENTIAL CENTER

LITTLE ROCK, ARKANSAS

Architect

POLSHEK PARTNERSHIP LLP
320 West 13th Street
New York, New York 10014
212.807.7171

Coordinating Architects

POLK STANLEY YEARY ARCHITECTS Ltd
700 South Schiller Street
Little Rock, Arkansas 72201
501.378.0878

WITSELL EVANS RASCO
901 West Third Street
Little Rock, Arkansas 72201
501.374.5300

WOODS CARADINE ARCHITECTS
2200 South Main Street
Little Rock, Arkansas 72206
501.374.4060

Landscape Architects

HARGREAVES ASSOCIATES
118 Magazine Street
Cambridge, Massachusettes 02139
617.661.0070

LANDSCAPE ARCHITECTURE, Inc.
2300 Cottondale Lane Suite 202
Little Rock, Arkansas 72202
501.374.5610

Structural Engineer

LESLIE E. ROBERTSON ASSOC., RLLP
30 Broad Street, 47th Floor
New York, New York 10004
212.750.9000

MEP Engineers

FLACK + KURTZ Inc.
475 Fifth Avenue
New York, New York 10017
212.532.9600


CROMWELL ARCHITECTS ENGINEERS
101 South Spring Street
Little Rock, Arkansas 72201
501.372.2900

Curtainwall Consultant

R. A. HEINTGES ARCHITECTS
126 Fifth Avenue, 9th Floor
New York, New York 10011
212.652-2966

Seal

Issue	Date
2 ASI #22	08/01/03
1 Addendum #2	11/15/02
100% Construction Documents	09/27/02
90% Progress Printing	08/30/02
100% Struct./ CD Progress	07/01/02
100% Design Development	03/01/02

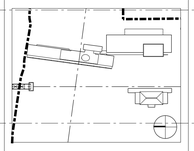

Job No. 9908

Scale 1/2" = 1'-0"

Date September 27, 2002


Title


WALL SYSTEM D: ELEVATION AND SECTION

Sheet No.

A333

FOR OFFICIAL USE ONLY

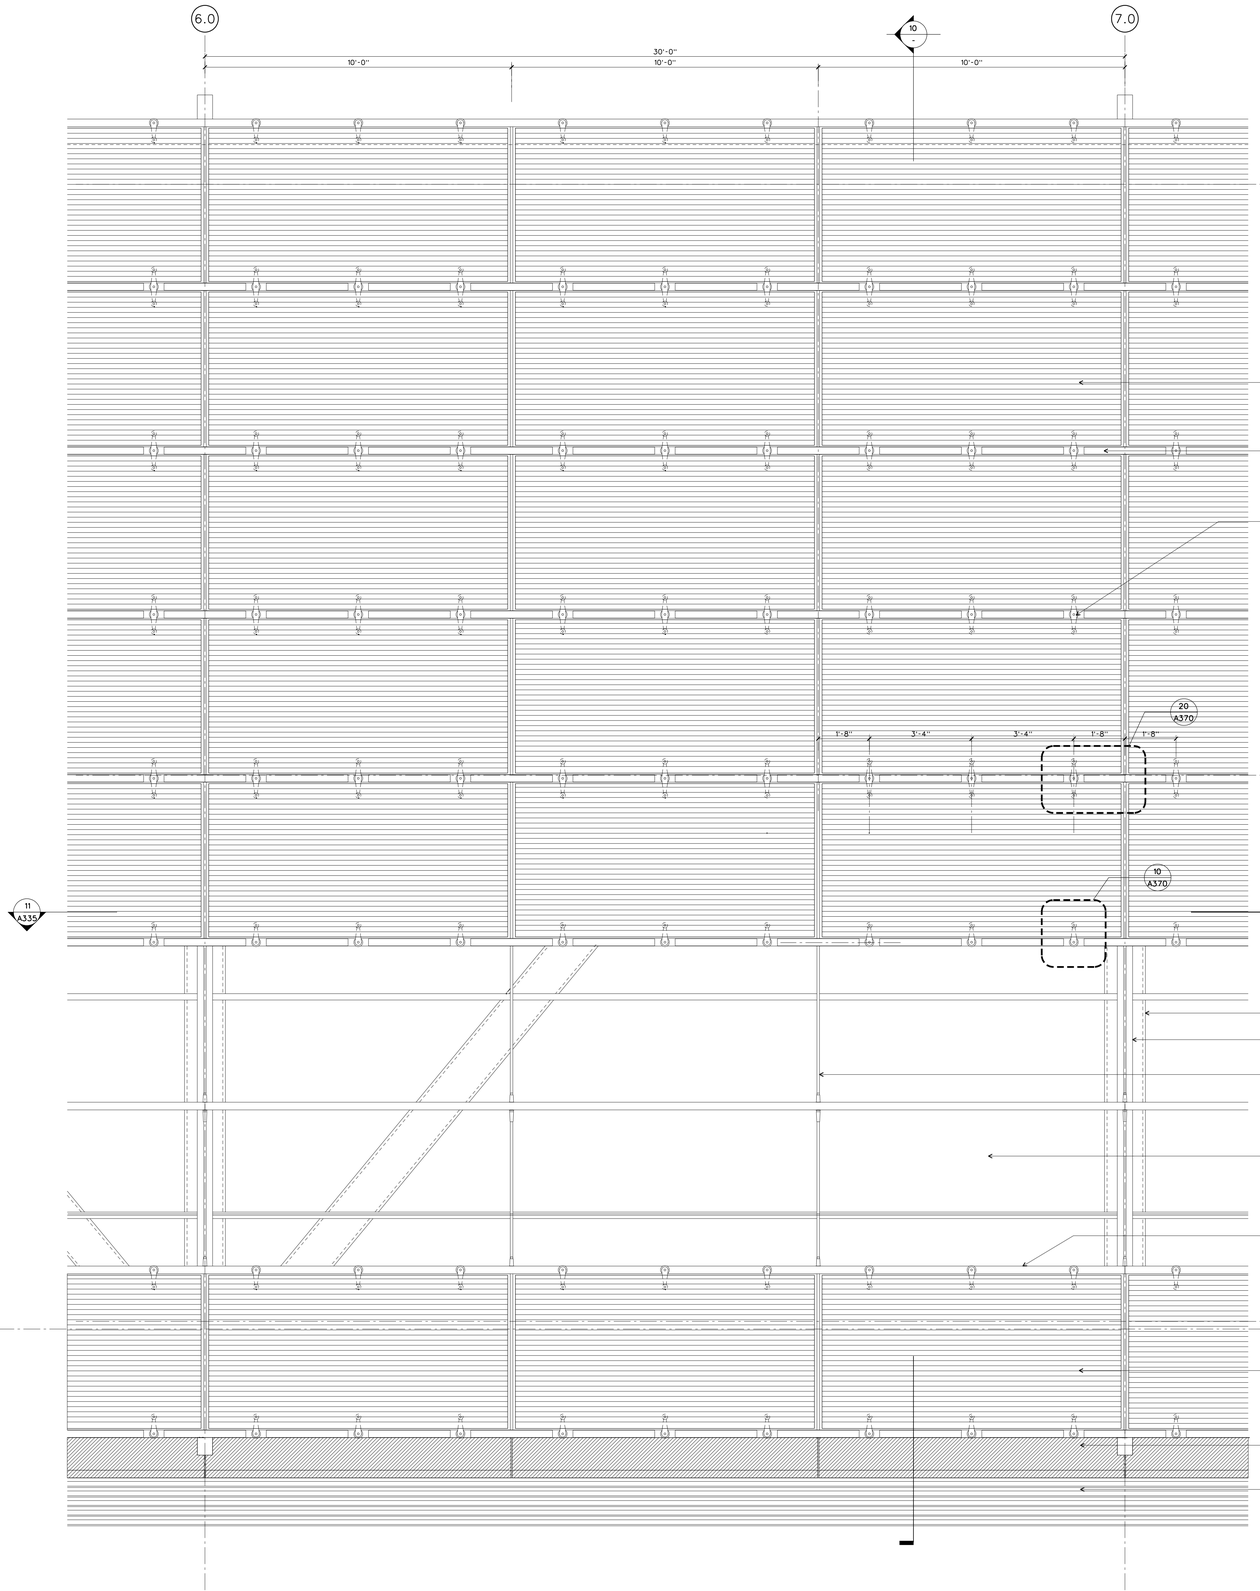

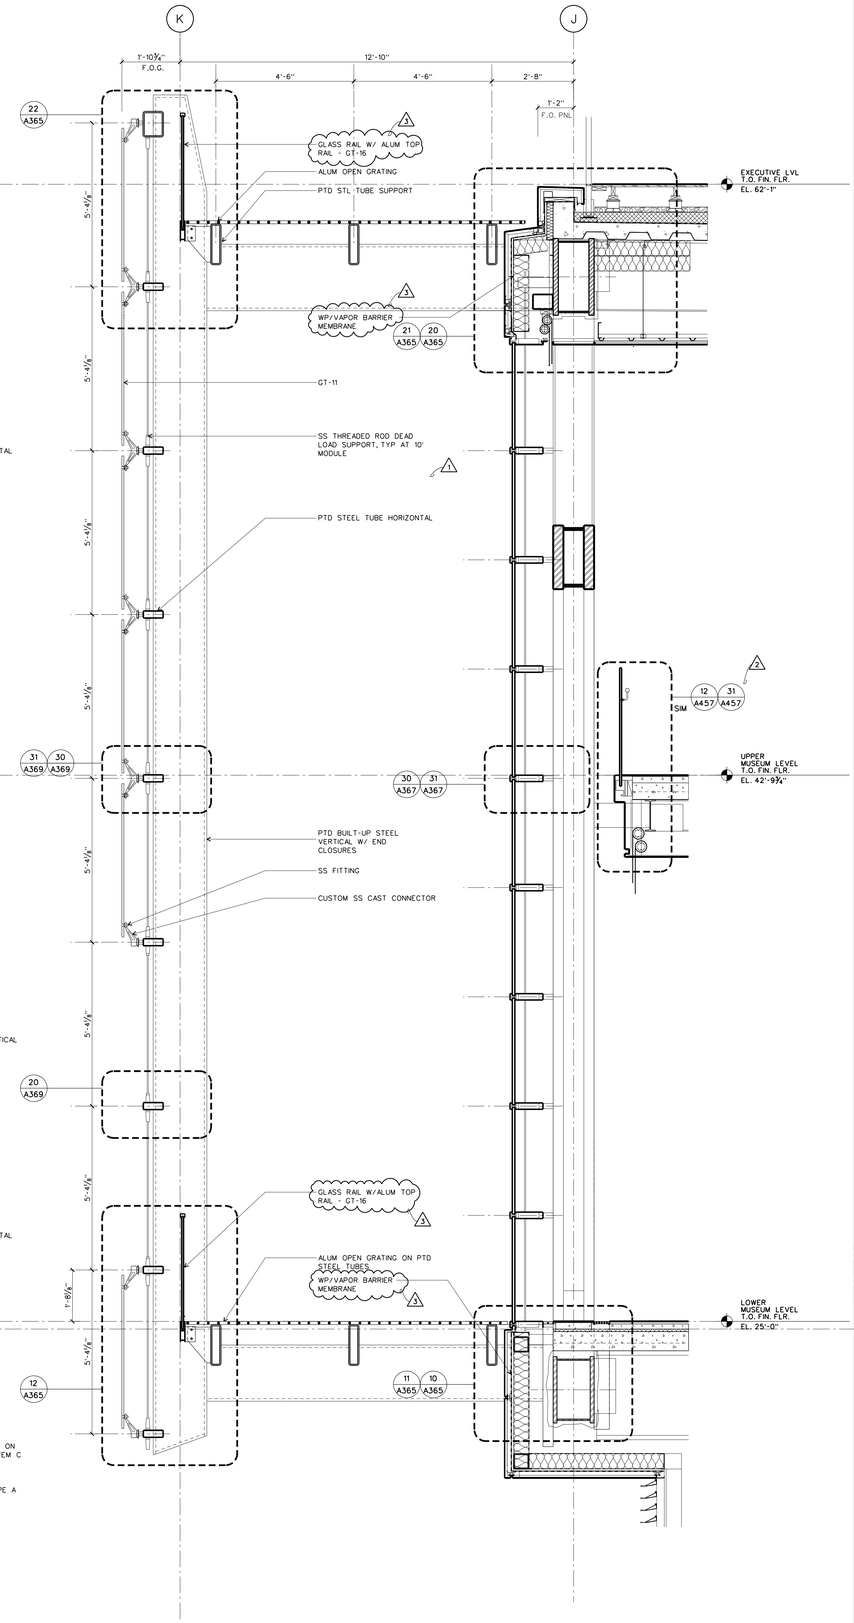

WALL SYSTEM E: ELEVATION AT TYPICAL BAY

SCALE: ½" = 1'-0"

DETAILS/DTL-CWD/E2 — 11

WALL SYSTEM D/E: TYPICAL WALL SECTION

SCALE: ½" = 1'-0"

DETAILS/DTL-CWD/E2 — 10

WILLIAM J. CLINTON PRESIDENTIAL CENTER

LITTLE ROCK, ARKANSAS

Architect

POLSHEK PARTNERSHIP LLP
320 West 13th Street
New York, New York 10014
212.807.7171

Coordinating Architects

POLK STANLEY YEARY ARCHITECTS Ltd
700 South Schiller Street
Little Rock, Arkansas 72201
501.378.0878

WITSELL EVANS RASCO
901 West Third Street
Little Rock, Arkansas 72201
501.374.5300

WOODS CARADINE ARCHITECTS
2200 South Main Street
Little Rock, Arkansas 72206
501.374.4060

Landscape Architects

HARGREAVES ASSOCIATES
118 Magazine Street
Cambridge, Massachusettes 02139
617.661.0070

LANDSCAPE ARCHITECTURE, Inc.
2300 Cottondale Lane Suite 202
Little Rock, Arkansas 72202
501.374.5610

Structural Engineer

LESLIE E. ROBERTSON ASSOC., RLLP
30 Broad Street, 47th Floor
New York, New York 10004
212.750.9000

MEP Engineers

FLACK + KURTZ Inc.
475 Fifth Avenue
New York, New York 10017
212.532.9600


CROMWELL ARCHITECTS ENGINEERS
101 South Spring Street
Little Rock, Arkansas 72201
501.372.2900

Curtainwall Consultant

R. A. HEINTGES ARCHITECTS
126 Fifth Avenue, 9th Floor
New York, New York 10011
212.652-2966

Seal

3	ASI #22	08/01/03
2	Addendum #2	11/15/02
1	100% Construction Documents	09/27/02
	90% Progress Printing	08/30/02
	100% Struct./ CD Progress	07/01/02
	100% Design Development	03/01/02
	Issue	Date

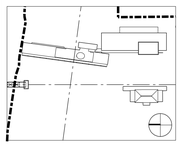

Job No. 9908

Scale 1/2" = 1'-0"

Date September 27, 2002


Title

WALL SYSTEM D + E: ELEVATION AND SECTION

Sheet No.

A334


FOR OFFICIAL USE ONLY

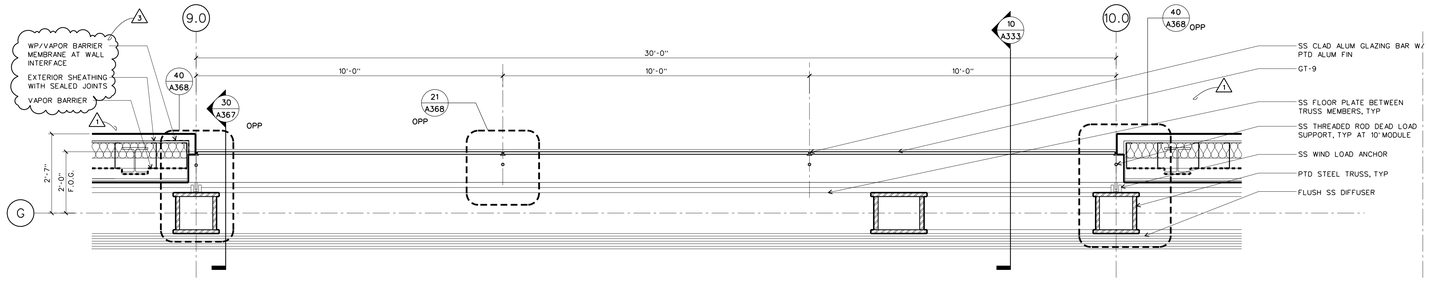

WALL SYSTEM D: PLAN SECTION AT EAST WALL

SCALE: ½" = 1'-0"


DETAILS/DTL-CWD/E3 — 31

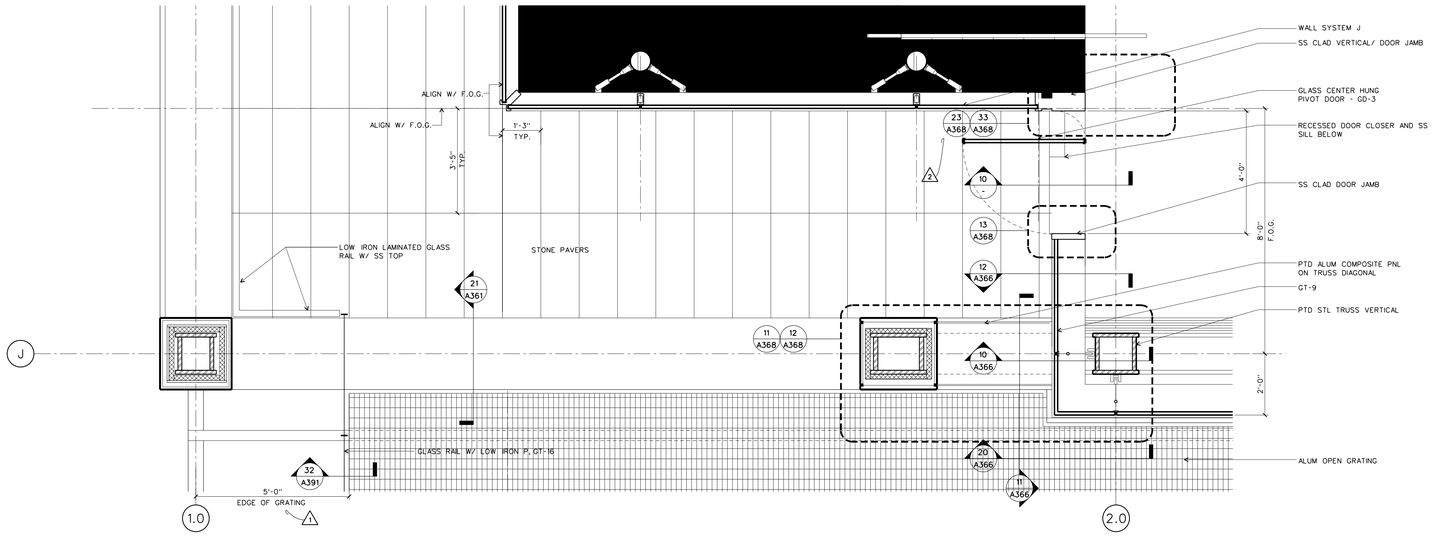

WALL SYSTEM D: PLAN SECTION AT NORTH CORNER

SCALE: ½" = 1'-0"


DETAILS/DTL-CWD/E3 — 21

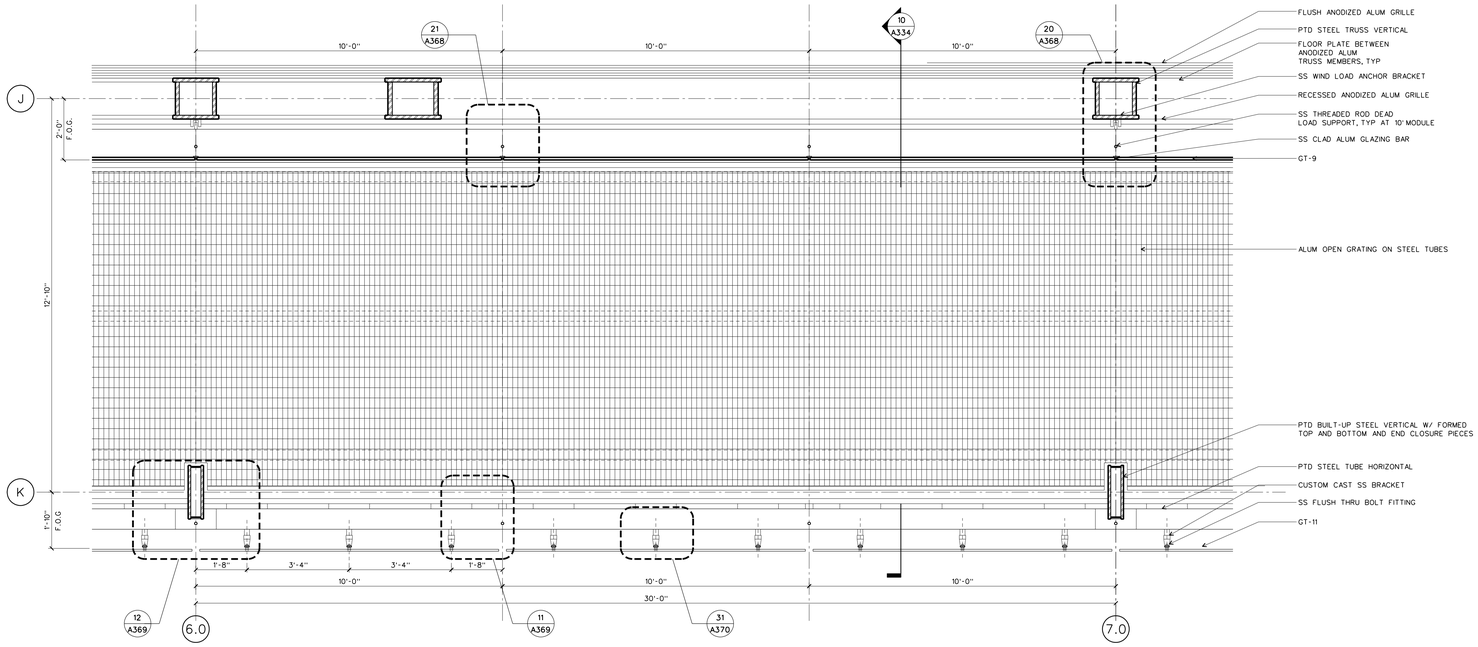

WALL SYSTEM D/E: PLAN SECTION TYPICAL BAY

SCALE: ½" = 1'-0"

DETAILS/DTL-CWD/E3 — 11

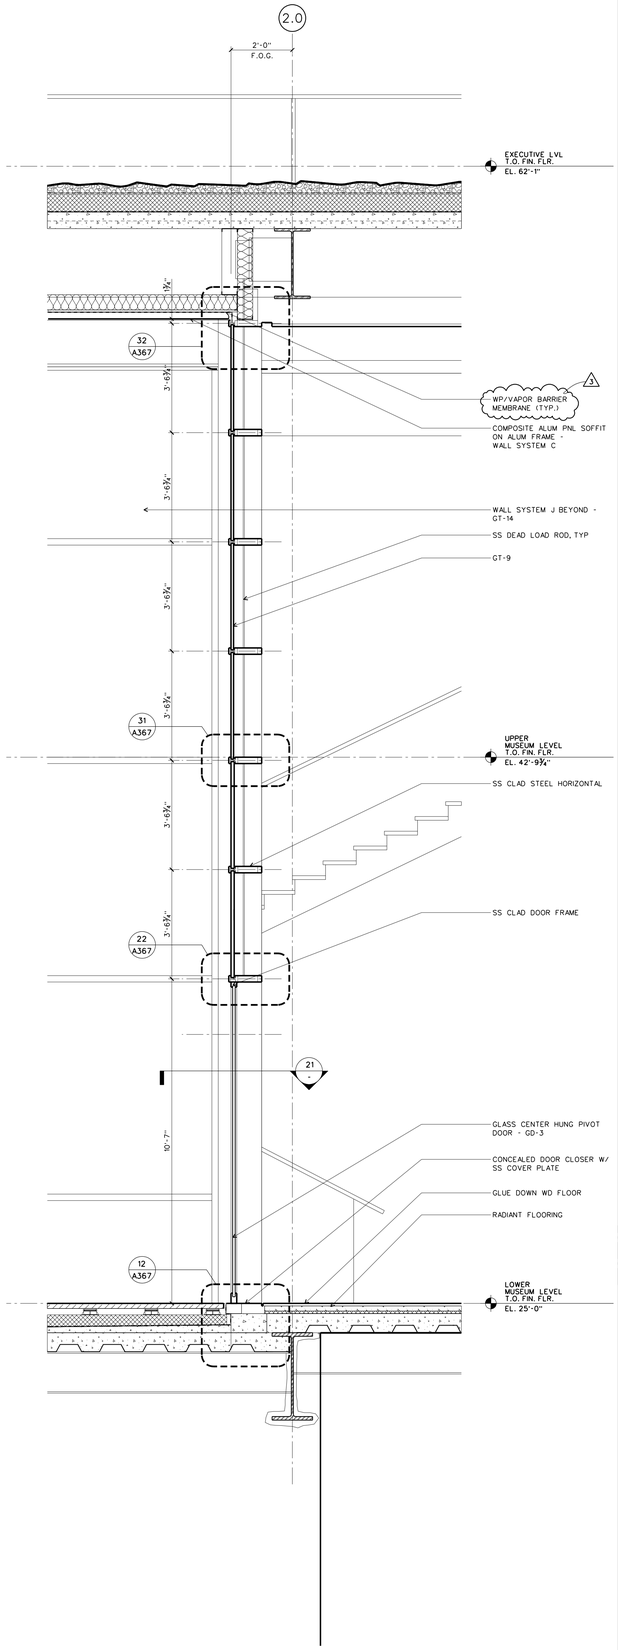

WALL SYSTEM D: WALL SECTION AT NORTH END

SCALE: ½" = 1'-0"

DETAILS/DTL-CWD/E3 — 10

WILLIAM J. CLINTON PRESIDENTIAL CENTER

LITTLE ROCK, ARKANSAS

Architect

POLSHEK PARTNERSHIP LLP
320 West 13th Street
New York, New York 10014
212.807.7171

Coordinating Architects

POLK STANLEY YEARY ARCHITECTS Ltd
700 South Schiller Street
Little Rock, Arkansas 72201
501.378.0878

WITSELL EVANS RASCO
901 West Third Street
Little Rock, Arkansas 72201
501.374.5300

WOODS CARADINE ARCHITECTS
2200 South Main Street
Little Rock, Arkansas 72206
501.374.4060

Landscape Architects

HARGREAVES ASSOCIATES
118 Magazine Street
Cambridge, Massachusettes 02139
617.661.0070

LANDSCAPE ARCHITECTURE, Inc.
2300 Cottondale Lane Suite 202
Little Rock, Arkansas 72202
501.374.5610

Structural Engineer

LESLIE E. ROBERTSON ASSOC., RLLP
30 Broad Street, 47th Floor
New York, New York 10004
212.750.9000

MEP Engineers

FLACK + KURTZ Inc.
475 Fifth Avenue
New York, New York 10017
212.532.9600


CROMWELL ARCHITECTS ENGINEERS
101 South Spring Street
Little Rock, Arkansas 72201
501.372.2900

Curtainwall Consultant

R. A. HEINTGES ARCHITECTS
126 Fifth Avenue, 9th Floor
New York, New York 10011
212.652-2966

Seal

Issue	Date
3 ASI #22	08/01/03
2 Addendum #2	11/15/02
100% Construction Documents	09/27/02
1 90% Progress Printing	08/30/02
100% Struct./ CD Progress	07/01/02
100% Design Development	03/01/02

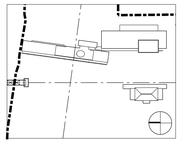

Job No. 9908

Scale 1/2" = 1'-0"

Date September 27, 2002


Title

WALL SYSTEM D + E PLANS AND SECTION

Sheet No.

A335


FOR OFFICIAL USE ONLY

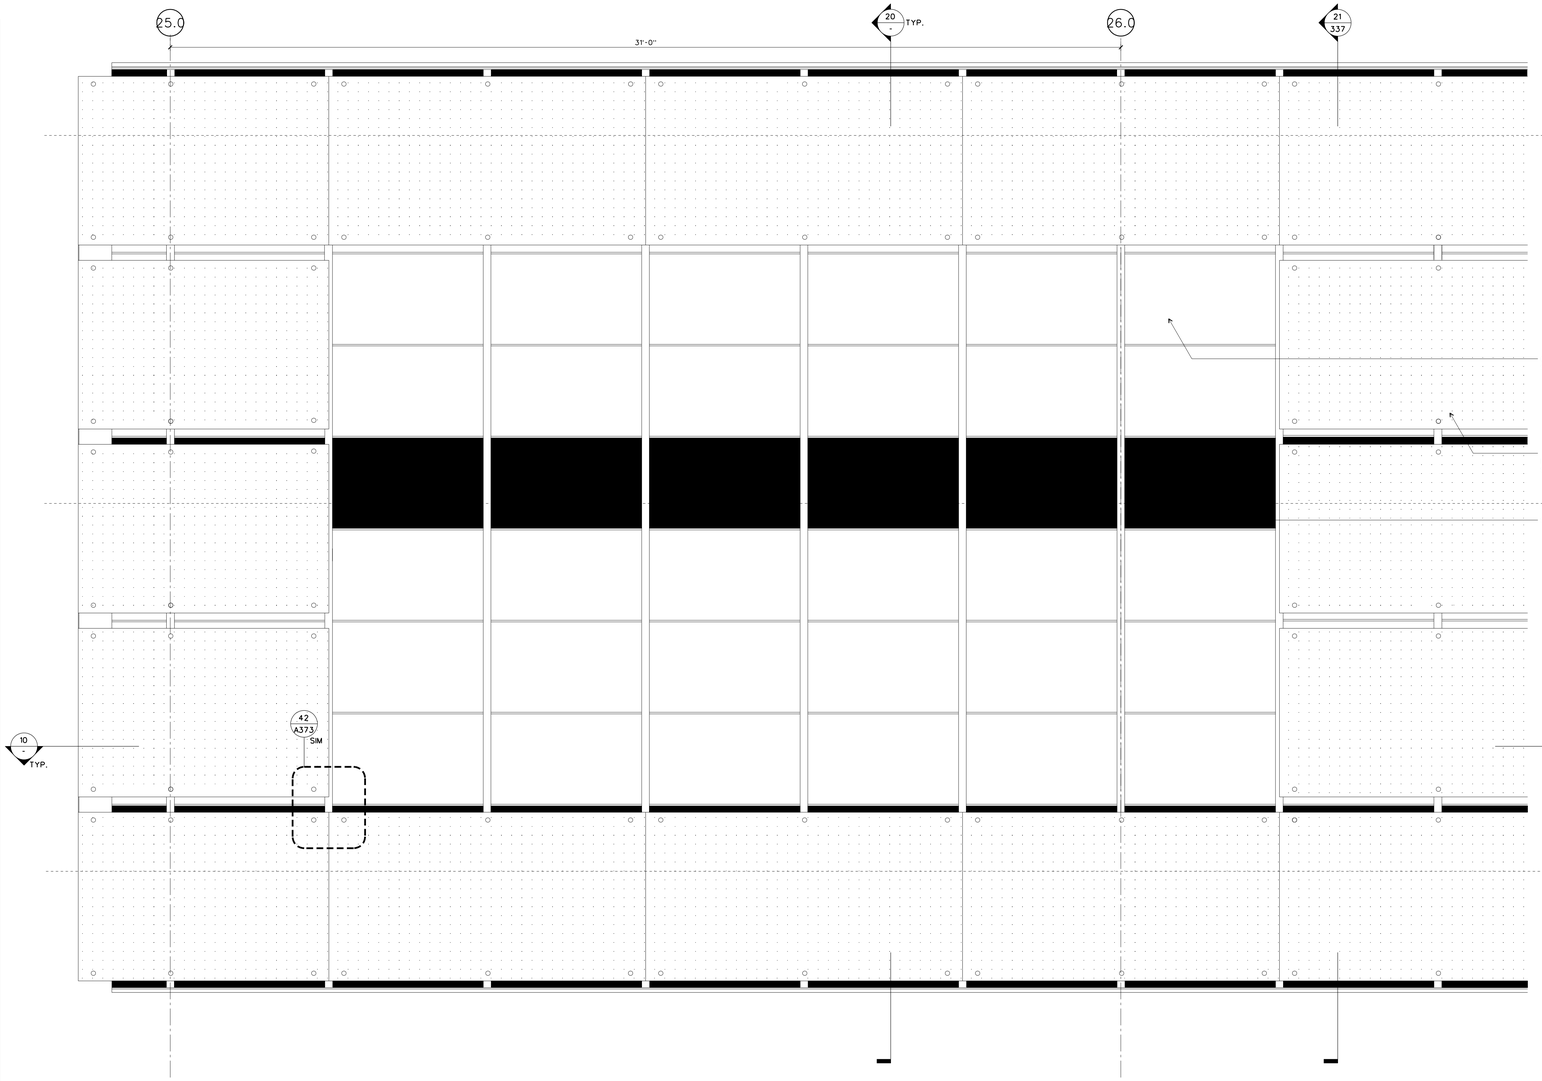

WALL SYSTEM F: PARTIAL ELEVATION AT OPENING IN SCREEN

SCALE: ½" = 1'-0"


DETAILS/DTL-CWF2 21

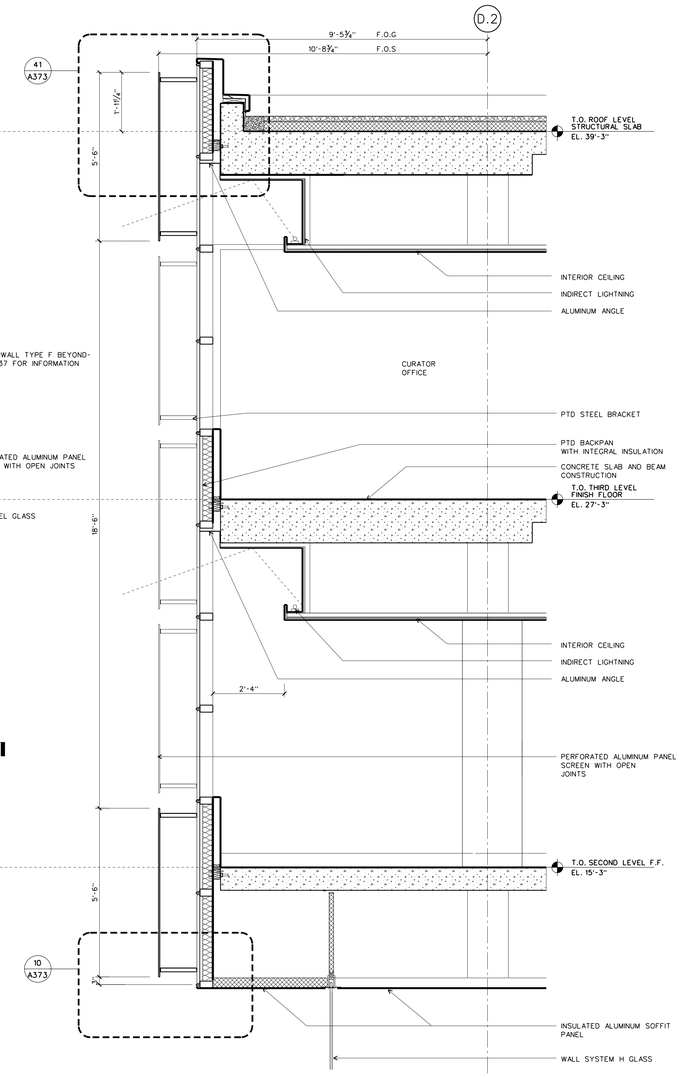

WALL SYSTEM F: WALL SECTION AT OPENING IN SCREEN

SCALE: ½" = 1'-0"

DETAILS/DTL-CWF2 20

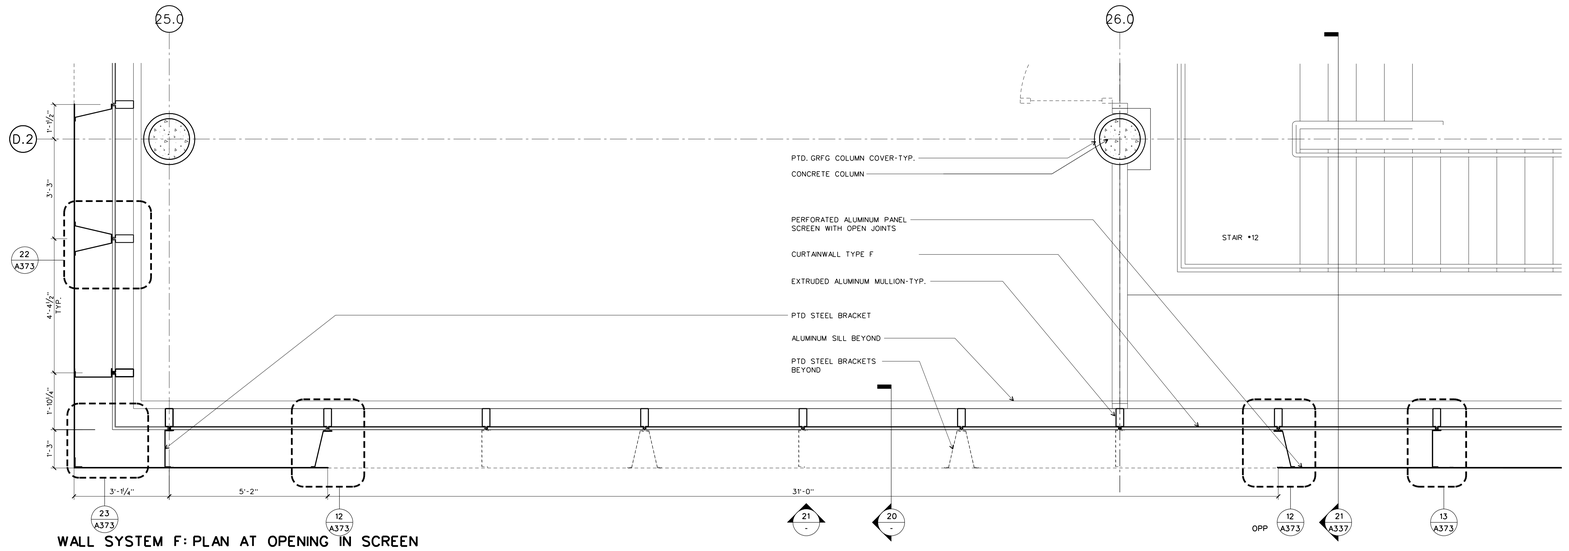

WALL SYSTEM F: PLAN AT OPENING IN SCREEN

SCALE: ½" = 1'-0"

DETAILS/DTL-CWF2 11

WILLIAM J. CLINTON PRESIDENTIAL CENTER

LITTLE ROCK, ARKANSAS

Architect

POLSHEK PARTNERSHIP LLP
320 West 13th Street
New York, New York 10014
212.807.7171

Coordinating Architects

POLK STANLEY YEARY ARCHITECTS Ltd
700 South Schiller Street
Little Rock, Arkansas 72201
501.378.0878

WITSELL EVANS RASCO
901 West Third Street
Little Rock, Arkansas 72201
501.374.5300

WOODS CARADINE ARCHITECTS
2200 South Main Street
Little Rock, Arkansas 72206
501.374.4060

Landscape Architects

HARGREAVES ASSOCIATES
118 Magazine Street
Cambridge, Massachusettes 02139
617.661.0070

LANDSCAPE ARCHITECTURE, Inc.
2300 Cottondale Lane Suite 202
Little Rock, Arkansas 72202
501.374.5610

Structural Engineer

LESLIE E. ROBERTSON ASSOC., RLLP
30 Broad Street, 47th Floor
New York, New York 10004
212.750.9000

MEP Engineers

FLACK + KURTZ Inc.
475 Fifth Avenue
New York, New York 10017
212.532.9600


CROMWELL ARCHITECTS ENGINEERS
101 South Spring Street
Little Rock, Arkansas 72201
501.372.2900

Curtainwall Consultant

R. A. HEINTGES ARCHITECTS
126 Fifth Avenue, 9th Floor
New York, New York 10011
212.652-2966

Seal

Issue	Date
100% Construction Documents	09/27/02
90% Progress Printing	08/30/02
100% Design Development	03/01/02

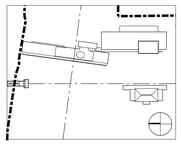

Job No. 9908

Scale 1/2" = 1'-0"

Date September 27, 2002


Title

WALL SYSTEM F: PLAN, ELEVATION AND SECTION

Sheet No.


A336

FOR OFFICIAL USE ONLY

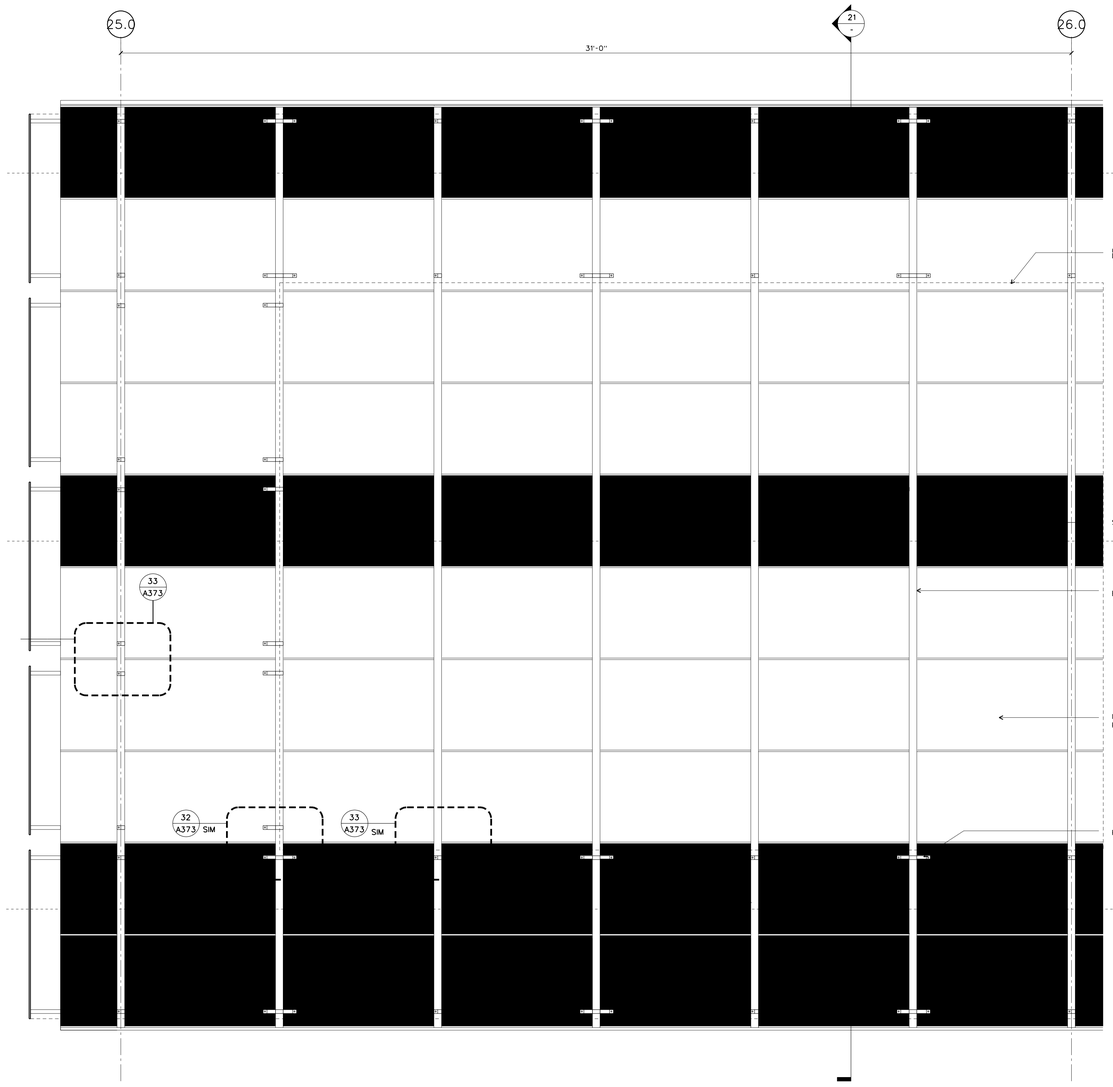

WALL SYSTEM F: PARTIAL ELEVATION AT TYPICAL BAY - GLASS

SCALE: ½" = 1'-0" DETAILS/DTL-CWF3 22

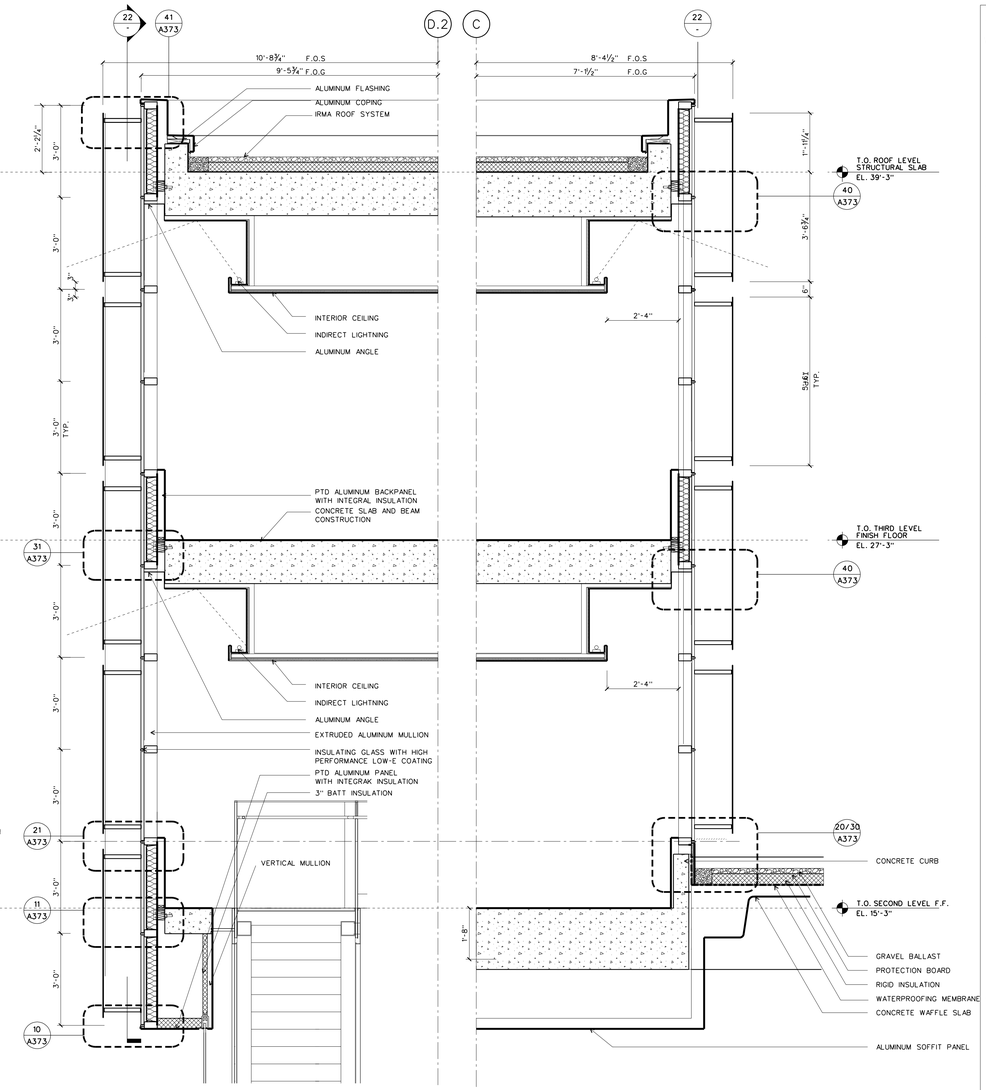

WALL SYSTEM F: TYPICAL WALL SECTION

SCALE: ½" = 1'-0" DETAILS/DTL-CWF3 21

WALL SYSTEM F:
TYPICAL WALL SECTION AT ARCHIVE ROOF

SCALE: ½" = 1'-0" DETAILS/DTL-CWF3 20

WILLIAM J. CLINTON PRESIDENTIAL CENTER

LITTLE ROCK, ARKANSAS

Architect

POLSHEK PARTNERSHIP LLP
320 West 13th Street
New York, New York 10014
212.807.7171

Coordinating Architects

POLK STANLEY YEARY ARCHITECTS Ltd
700 South Schiller Street
Little Rock, Arkansas 72201
501.378.0878

WITSELL EVANS RASCO
901 West Third Street
Little Rock, Arkansas 72201
501.374.5300

WOODS CARADINE ARCHITECTS
2200 South Main Street
Little Rock, Arkansas 72206
501.374.4060

Landscape Architects

HARGREAVES ASSOCIATES
118 Magazine Street
Cambridge, Massachusettes 02139
617.661.0070

LANDSCAPE ARCHITECTURE, Inc.
2300 Cottondale Lane Suite 202
Little Rock, Arkansas 72202
501.374.5610

Structural Engineer

LESLIE E. ROBERTSON ASSOC., RLLP
30 Broad Street, 47th Floor
New York, New York 10004
212.750.9000

MEP Engineers

FLACK + KURTZ Inc.
475 Fifth Avenue
New York, New York 10017
212.532.9600


CROMWELL ARCHITECTS ENGINEERS
101 South Spring Street
Little Rock, Arkansas 72201
501.372.2900

Curtainwall Consultant

R. A. HEINTGES ARCHITECTS
126 Fifth Avenue, 9th Floor
New York, New York 10011
212.652-2966

Seal

Issue	Date
100% Construction Documents	09/27/02
90% Progress Printing	08/30/02
ASI #05	08/20/02
100% Struct./ CD Progress	07/01/02
Bridge Bldg. Substructure	06/14/02
100% Steel & Concrete CD	05/15/02
& Architectural CD Progress	
100% Design Development	03/01/02

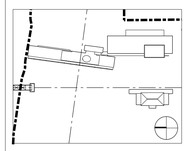

Job No. 9908

Scale 1/2" = 1'-0"

Date September 27, 2002


Title

WALL SYSTEM F:
PLANS, ELEVATION
AND SECTION

Sheet No.


A337

FOR OFFICIAL USE ONLY

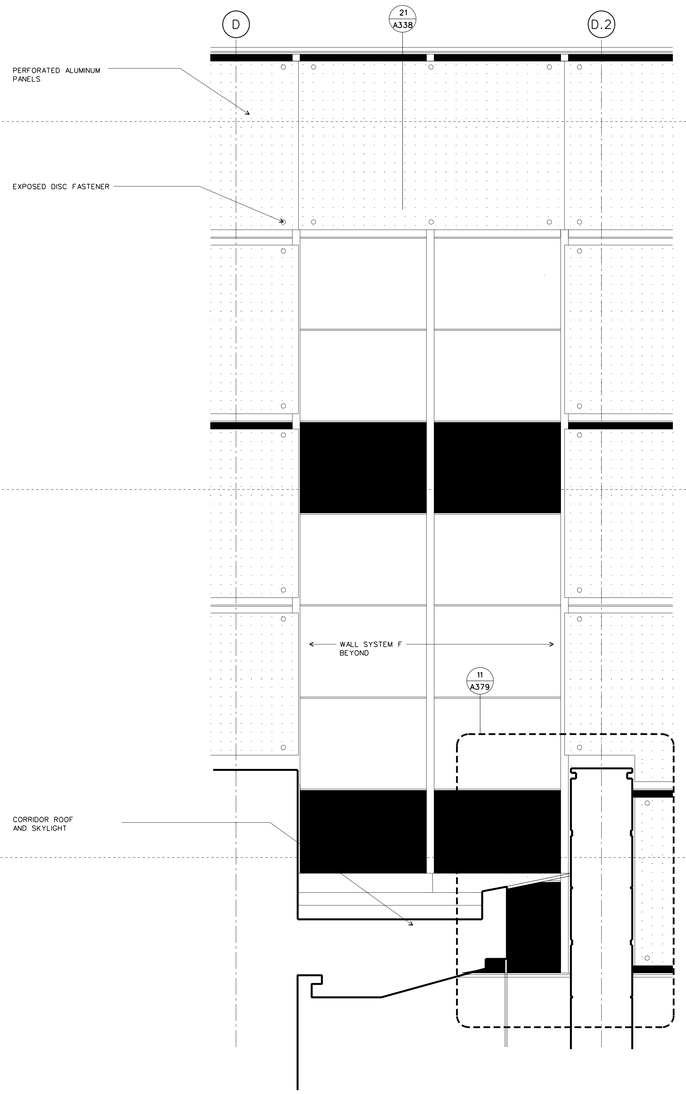


WALL SYSTEM F: PARTIAL NORTH ELEVATION - SCREEN 22

SCALE: ½" = 1'-0" DETAILS/DTL-CWF4

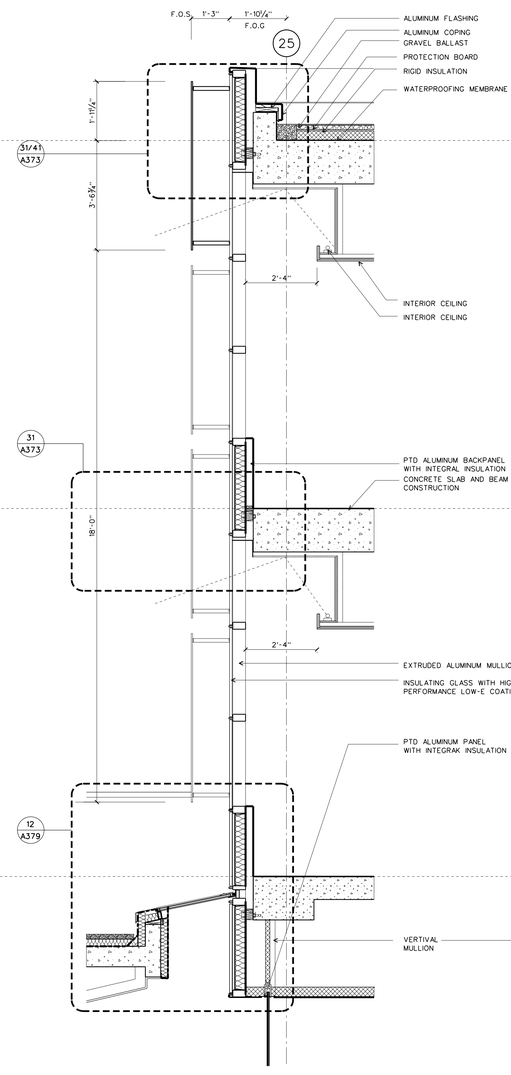


WALL SYSTEM F:WALL SECTION AT NORTH ELEVATION 21

SCALE: ½" = 1'-0" DETAILS/DTL-CWF4

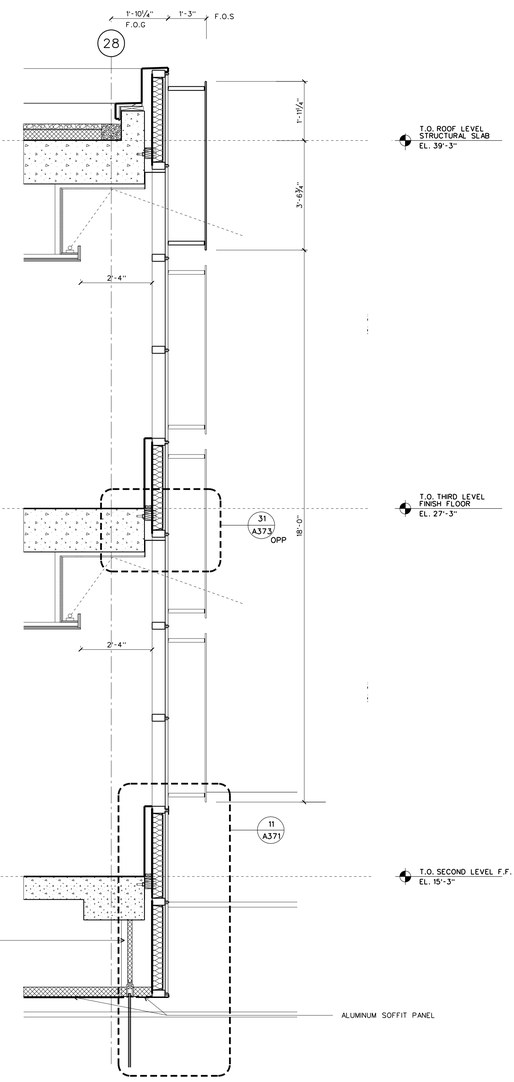


WALL SYSTEM F:WALL SECTION AT SOUTH ELEVATION 20

SCALE: ½" = 1'-0" DETAILS/DTL-CWF4

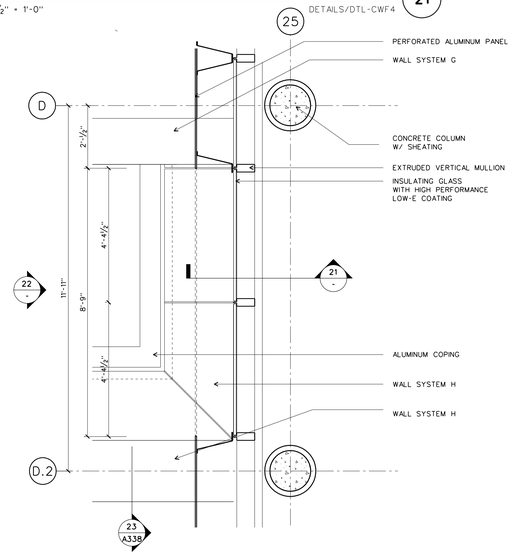

WALL SYSTEM F: PARTIAL PLAN AT NORTH ELEVATION 11

SCALE: ½" = 1'-0" DETAILS/DTL-CWF4

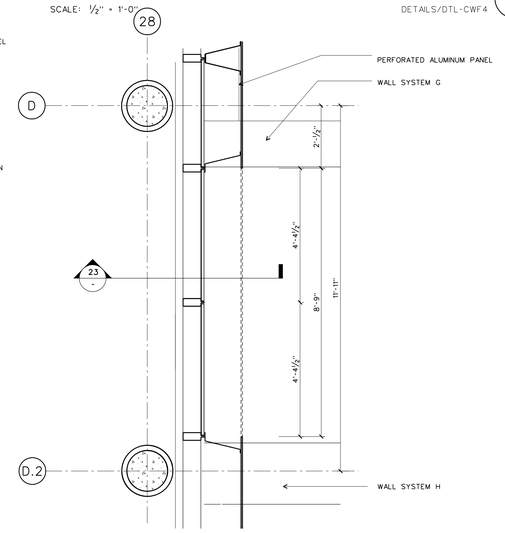

WALL SYSTEM F: PARTIAL PLAN AT SOUTH ELEVATION 10

SCALE: ½" = 1'-0" DETAILS/DTL-CWF4

WILLIAM J. CLINTON PRESIDENTIAL CENTER

LITTLE ROCK, ARKANSAS

Architect

POLSHEK PARTNERSHIP LLP
320 West 13th Street
New York, New York 10014
212.807.7171

Coordinating Architects

POLK STANLEY YEARY ARCHITECTS Ltd
700 South Schiller Street
Little Rock, Arkansas 72201
501.378.0878

WITSELL EVANS RASCO
901 West Third Street
Little Rock, Arkansas 72201
501.374.5300

WOODS CARADINE ARCHITECTS
2200 South Main Street
Little Rock, Arkansas 72206
501.374.4060

Landscape Architects

HARGREAVES ASSOCIATES
118 Magazine Street
Cambridge, Massachusettes 02139
617.661.0070

LANDSCAPE ARCHITECTURE, Inc.
2300 Cottondale Lane Suite 202
Little Rock, Arkansas 72202
501.374.5610

Structural Engineer

LESLIE E. ROBERTSON ASSOC., RLLP
30 Broad Street, 47th Floor
New York, New York 10004
212.750.9000

MEP Engineers

FLACK + KURTZ Inc.
475 Fifth Avenue
New York, New York 10017
212.532.9600


CROMWELL ARCHITECTS ENGINEERS
101 South Spring Street
Little Rock, Arkansas 72201
501.372.2900

Curtainwall Consultant

R. A. HEINTGES ARCHITECTS
126 Fifth Avenue, 9th Floor
New York, New York 10011
212.652-2966

Seal

Issue	Date
100% Construction Documents	09/27/02
90% Progress Printing	08/30/02
ASI #05	08/20/02
100% Struct./ CD Progress	07/01/02
Bridge Bldg. Substructure	06/14/02
100% Steel & Concrete CD & Architectural CD Progress	05/15/02
100% Design Development	03/01/02

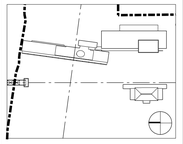

Job No. 9908

Scale 1/2" = 1'-0"

Date September 27, 2002


Title

WALL SYSTEM F: PLANS, ELEVATION AND SECTIONS

Sheet No.


A338

FOR OFFICIAL USE ONLY

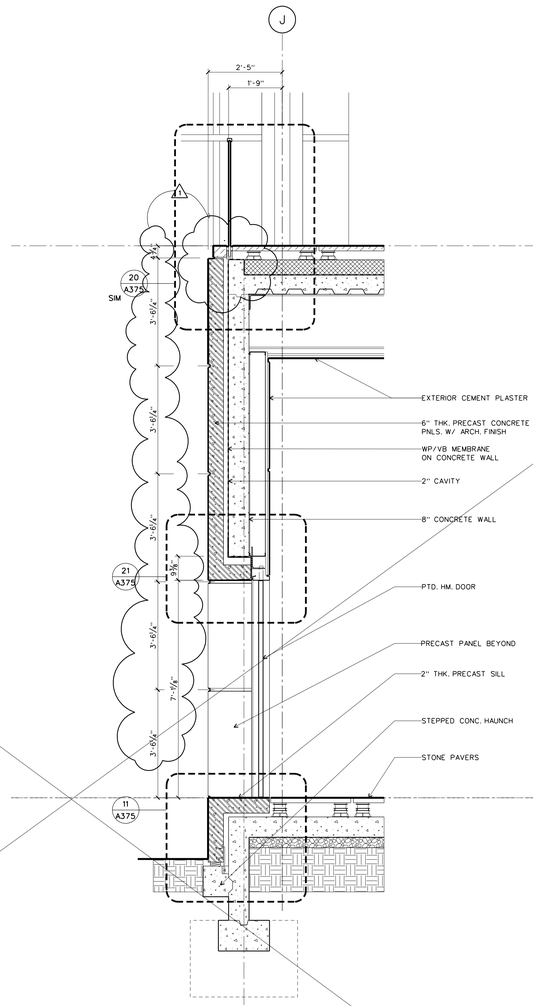


WALL SYSTEM G: SECTION AT CAFE

SCALE: ½" = 1'-0" DTL-CWG1 21

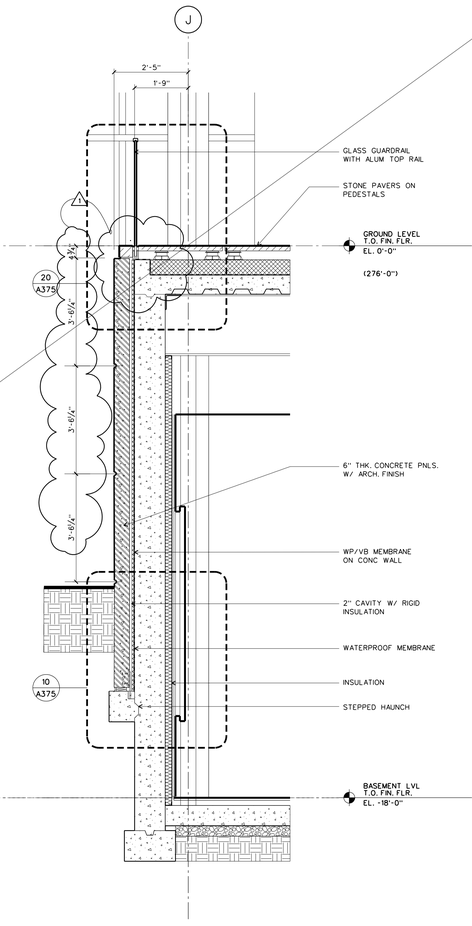

WALL SYSTEM G: SECTION AT CAFE

SCALE: ½" = 1'-0" DTL-CWG1 20

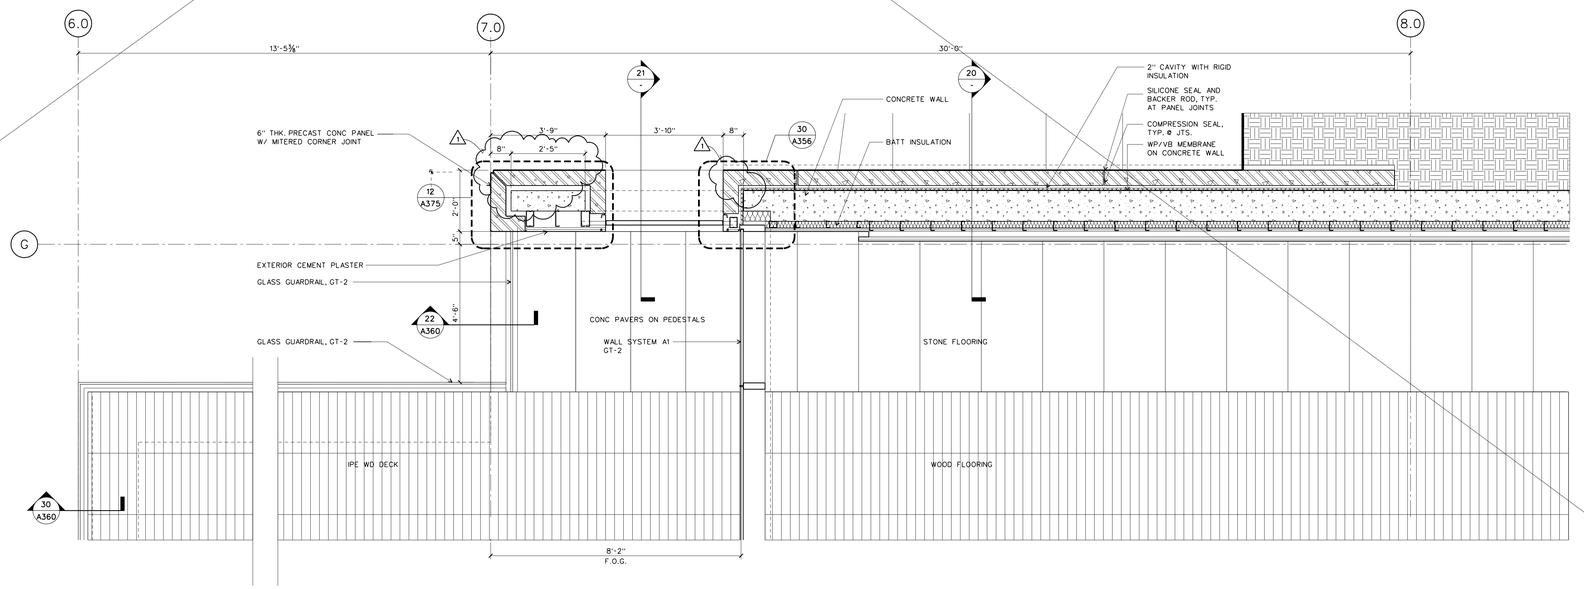

WALL SYSTEM G: PLAN AT CAFE WEST WALL

SCALE: ½" = 1'-0" DETAILS/DTL-CWG1 10

WILLIAM J. CLINTON PRESIDENTIAL CENTER

LITTLE ROCK, ARKANSAS

Architect

POLSHEK PARTNERSHIP LLP
320 West 13th Street
New York, New York 10014
212.807.7171

Coordinating Architects

POLK STANLEY YEARY ARCHITECTS Ltd
700 South Schiller Street
Little Rock, Arkansas 72201
501.378.0878

WITSELL EVANS RASCO
901 West Third Street
Little Rock, Arkansas 72201
501.374.5300

WOODS CARADINE ARCHITECTS
2200 South Main Street
Little Rock, Arkansas 72206
501.374.4060

Landscape Architects

HARGREAVES ASSOCIATES
118 Magazine Street
Cambridge, Massachusettes 02139
617.661.0070

LANDSCAPE ARCHITECTURE, Inc.
2300 Cottondale Lane Suite 202
Little Rock, Arkansas 72202
501.374.5610

Structural Engineer

LESLIE E. ROBERTSON ASSOC., RLLP
30 Broad Street, 47th Floor
New York, New York 10004
212.750.9000

MEP Engineers

FLACK + KURTZ Inc.
475 Fifth Avenue
New York, New York 10017
212.532.9600


CROMWELL ARCHITECTS ENGINEERS
101 South Spring Street
Little Rock, Arkansas 72201
501.372.2900

Curtainwall Consultant

R. A. HEINTGES ARCHITECTS
126 Fifth Avenue, 9th Floor
New York, New York 10011
212.652-2966

Seal

Issue	Date
1 100% Construction Documents	09/27/02
100% Struct./ CD Progress	07/01/02
Bridge Bldg. Substructure	06/14/02

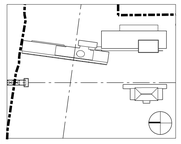

Job No. 9908

Scale 1/2" = 1'-0"

Date September 27, 2002


Title

WALL SYSTEM G: PLAN, ELEVATION AND SECTIONS

Sheet No.

A339a

FOR OFFICIAL USE ONLY

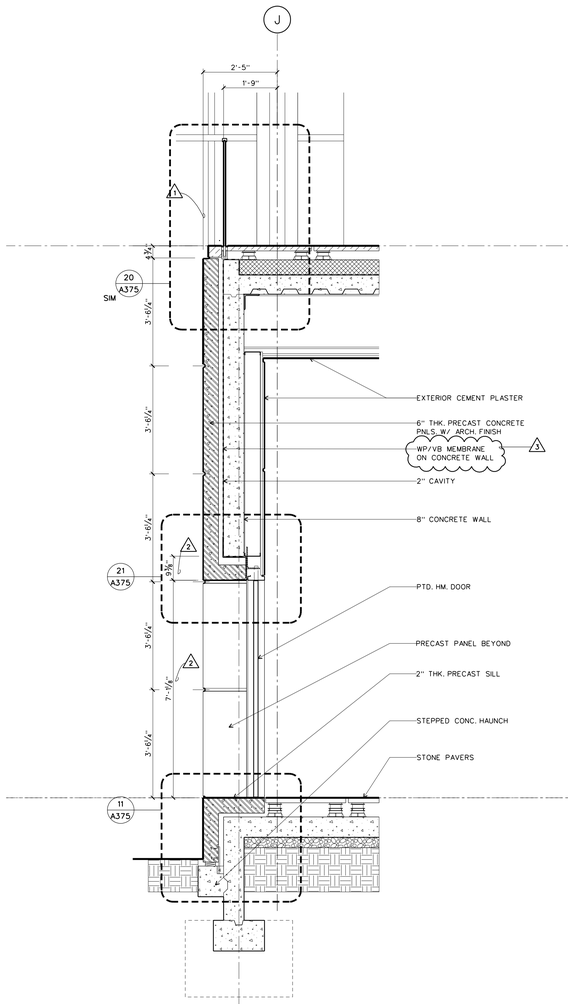


WALL SYSTEM G: SECTION AT CAFE

SCALE: ½" = 1'-0"

DTL-CWG1

21

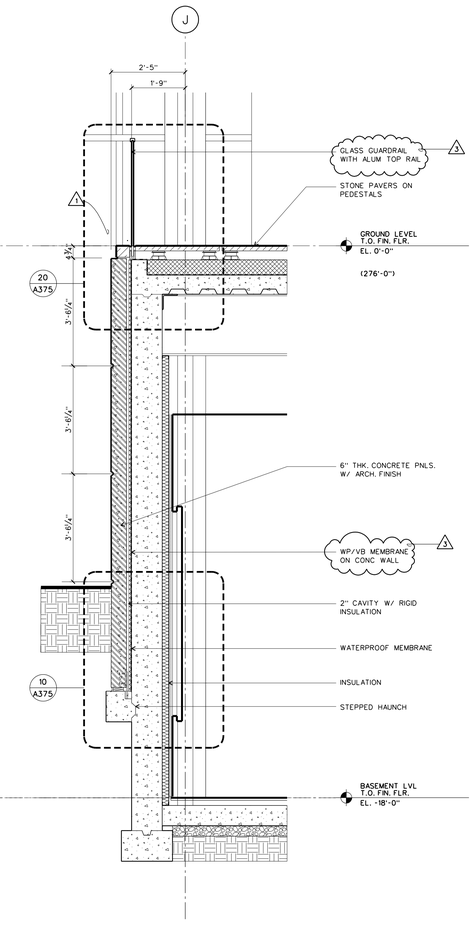


WALL SYSTEM G: SECTION AT CAFE

SCALE: ½" = 1'-0"

DTL-CWG1

20

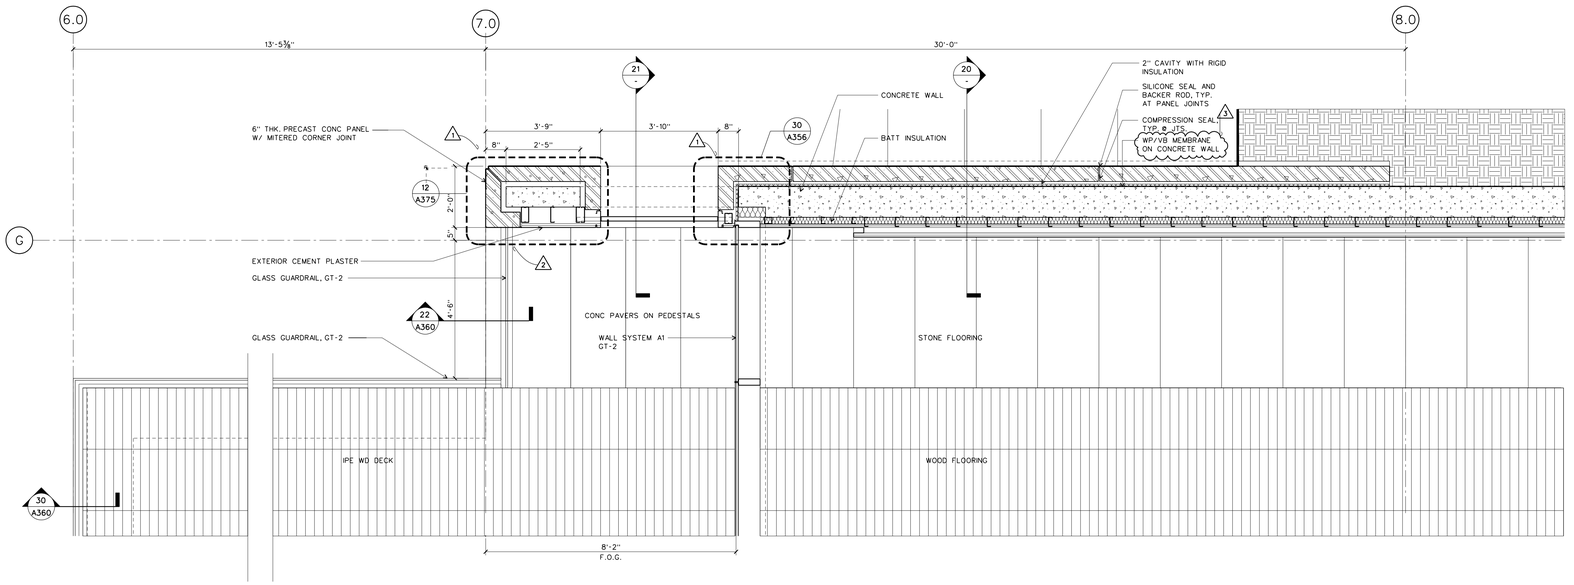

WALL SYSTEM G: PLAN AT CAFE WEST WALL

SCALE: ½" = 1'-0"

DETAILS/DTL-CWG1

10

WILLIAM J. CLINTON PRESIDENTIAL CENTER

LITTLE ROCK, ARKANSAS

Architect

POLSHEK PARTNERSHIP LLP
320 West 13th Street
New York, New York 10014
212.807.7171

Coordinating Architects

POLK STANLEY YEARY ARCHITECTS Ltd
700 South Schiller Street
Little Rock, Arkansas 72201
501.378.0878

WITSELL EVANS RASCO
901 West Third Street
Little Rock, Arkansas 72201
501.374.5300

WOODS CARADINE ARCHITECTS
2200 South Main Street
Little Rock, Arkansas 72206
501.374.4060

Landscape Architects

HARGREAVES ASSOCIATES
118 Magazine Street
Cambridge, Massachusettes 02139
617.661.0070

LANDSCAPE ARCHITECTURE, Inc.
2300 Cottondale Lane Suite 202
Little Rock, Arkansas 72202
501.374.5610

Structural Engineer

LESLIE E. ROBERTSON ASSOC., RLLP
30 Broad Street, 47th Floor
New York, New York 10004
212.750.9000

MEP Engineers

FLACK + KURTZ Inc.
475 Fifth Avenue
New York, New York 10017
212.532.9600


CROMWELL ARCHITECTS ENGINEERS
101 South Spring Street
Little Rock, Arkansas 72201
501.372.2900

Curtainwall Consultant

R. A. HEINTGES ARCHITECTS
126 Fifth Avenue, 9th Floor
New York, New York 10011
212.652-2966

Seal

Issue	Date
3 ASI #22	08/01/03
2 Addendum #2	11/15/02
1 100% Construction Documents	09/27/02
100% Struct./ CD Progress	07/01/02
Bridge Bldg. Substructure	06/14/02

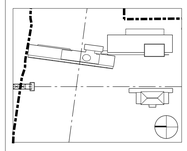

Job No.
9908


Scale
1/2" = 1'-0"

Date
September 27, 2002

Title
WALL SYSTEM G: PLAN, ELEVATION AND SECTIONS

Sheet No.
A339a

FOR OFFICIAL USE ONLY

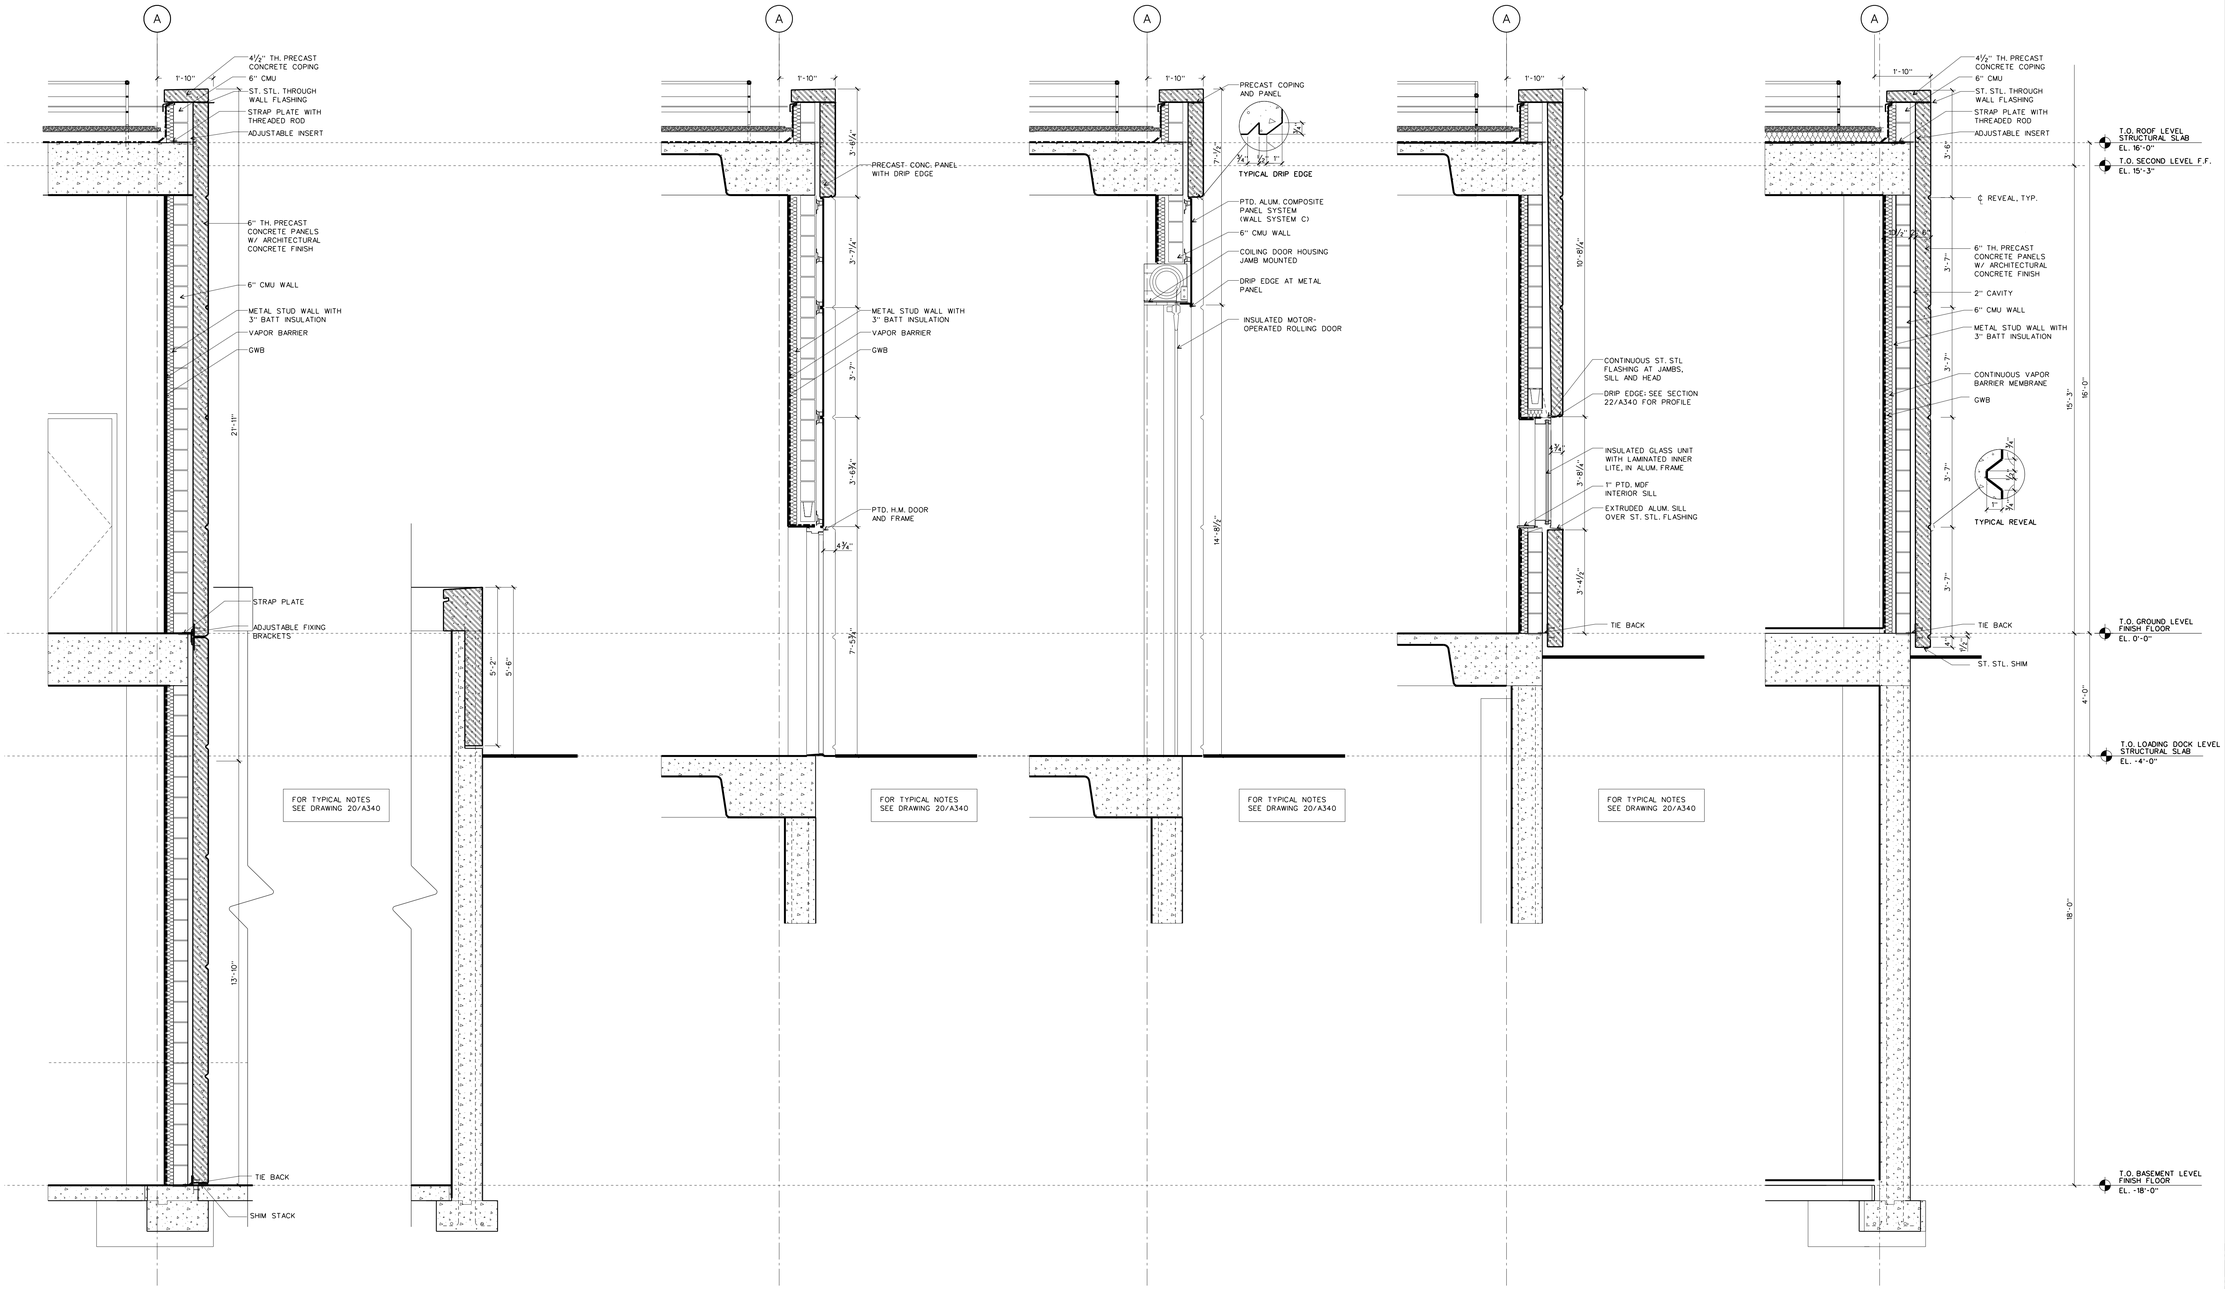

WALL SYSTEM G: WALL SECTION AT MECHANICAL YARD

SCALE: ½" = 1'-0" DETAILS/DTL-CWG 24

WALL SYSTEM G: WALL SECTION AT DOOR

SCALE: ½" = 1'-0" DETAILS/DTL-CWG 23

WALL SYSTEM G: WALL SECTION AT LOADING DOCK


SCALE: ½" = 1'-0" DETAILS/DTL-CWG 22

WALL SYSTEM G: WALL SECTION AT WINDOW

SCALE: ½" = 1'-0" DETAILS/DTL-CWG 21

WALL SYSTEM G: TYPICAL WALL SECTION

SCALE: ½" = 1'-0" DETAILS/DTL-CWG 20

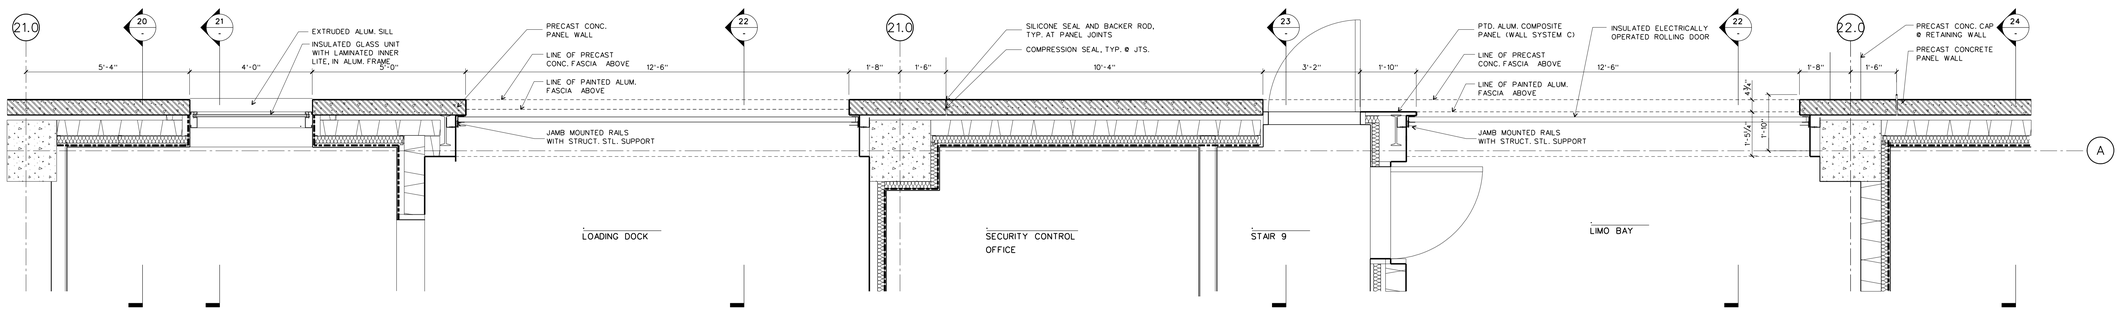

WALL SYSTEM G: PLAN AT NON-NARA LOADING DOCKS

SCALE: ½" = 1'-0" DETAILS/DTL-CWG 10

WILLIAM J. CLINTON PRESIDENTIAL CENTER

LITTLE ROCK, ARKANSAS

Architect

POLSHEK PARTNERSHIP LLP
320 West 13th Street
New York, New York 10014
212.807.7171

Coordinating Architects

POLK STANLEY YEARY ARCHITECTS Ltd
700 South Schiller Street
Little Rock, Arkansas 72201
501.378.0878

WITSELL EVANS RASCO
901 West Third Street
Little Rock, Arkansas 72201
501.374.5300

WOODS CARADINE ARCHITECTS
2200 South Main Street
Little Rock, Arkansas 72206
501.374.4060

Landscape Architects

HARGREAVES ASSOCIATES
118 Magazine Street
Cambridge, Massachusettes 02139
617.661.0070

LANDSCAPE ARCHITECTURE, Inc.
2300 Cottondale Lane Suite 202
Little Rock, Arkansas 72202
501.374.5610

Structural Engineer

LESLIE E. ROBERTSON ASSOC., RLLP
30 Broad Street, 47th Floor
New York, New York 10004
212.750.9000

MEP Engineers

FLACK + KURTZ Inc.
475 Fifth Avenue
New York, New York 10017
212.532.9600

CROMWELL ARCHITECTS ENGINEERS
101 South Spring Street
Little Rock, Arkansas 72201
501.372.2900

Curtainwall Consultant

R. A. HEINTGES ARCHITECTS
126 Fifth Avenue, 9th Floor
New York, New York 10011
212.652-2966

Seal

Issue	Date
100% Construction Documents	09/27/02
90% Progress Printing	08/30/02
ASI #05	08/20/02
100% Struct./ CD Progress	07/01/02
Bridge Bldg. Substructure	06/14/02
100% Steel & Concrete CD & Architectural CD Progress	05/15/02
100% Design Development	03/01/02

Job No. 9908

Scale 1/2" = 1'-0"

Date September 27, 2002


Title

WALL SYSTEM G: PLAN, ELEVATION AND SECTIONS

Sheet No.


A340

FOR OFFICIAL USE ONLY

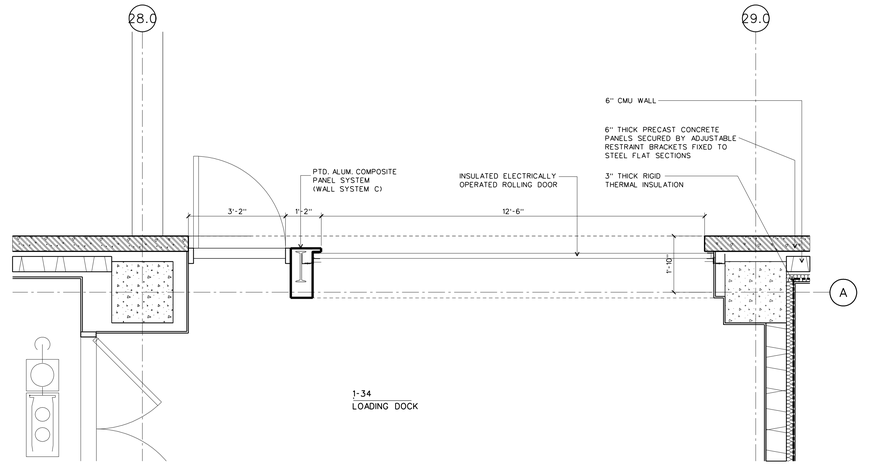


WALL SYSTEM G: PARTIAL PLAN AT NARA LOADING DOCK

SCALE: ½" = 1'-0" DETAILS/DTL-CWG3 **30**

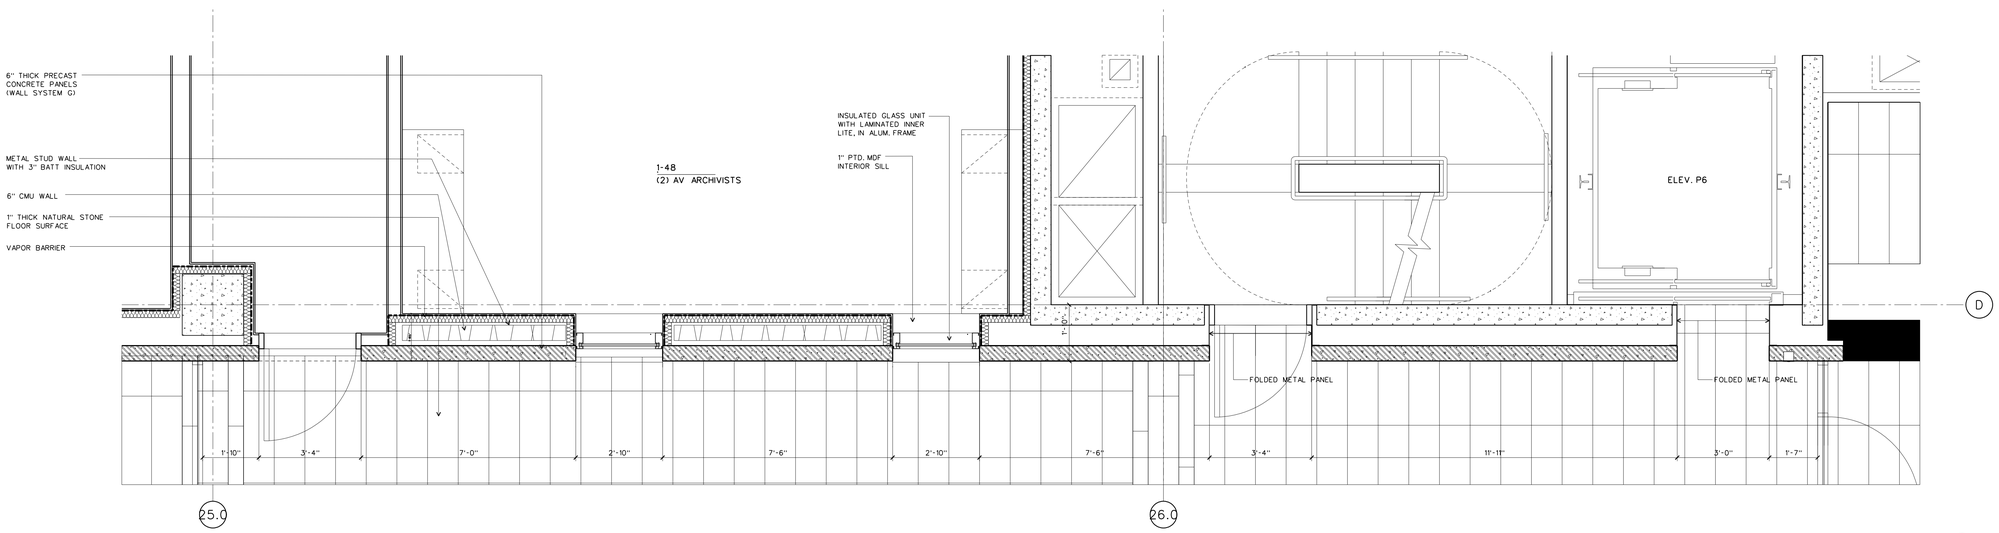


WALL SYSTEM G: PARTIAL PLAN AT ARCHIVE OFFICE LOBBY

SCALE: ½" = 1'-0" DETAILS/DTL-CWG3 **20**

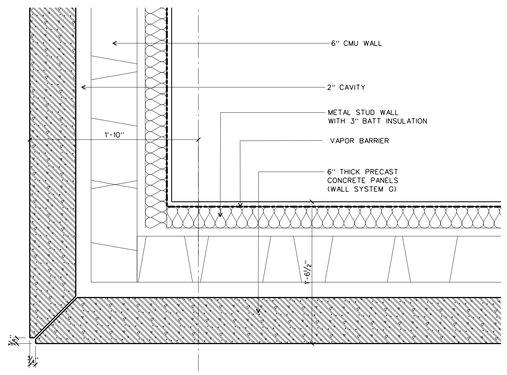


WALL SYSTEM G: TYPICAL CORNER

SCALE: 1½" = 1'-0" DETAILS/DTL-CWG3 **12**

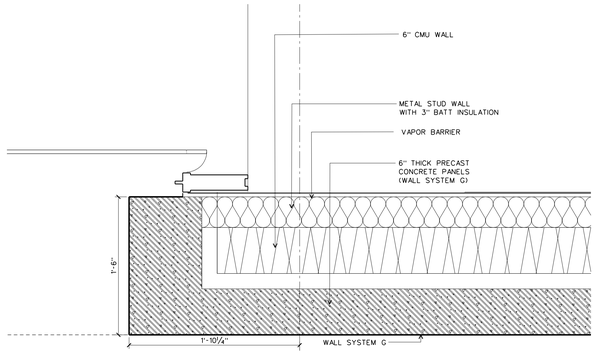

WALL SYSTEM G: PLAN DETAIL AT CLASSROOM

SCALE: 1½" = 1'-0" DETAILS/DTL-CWG3 **11**

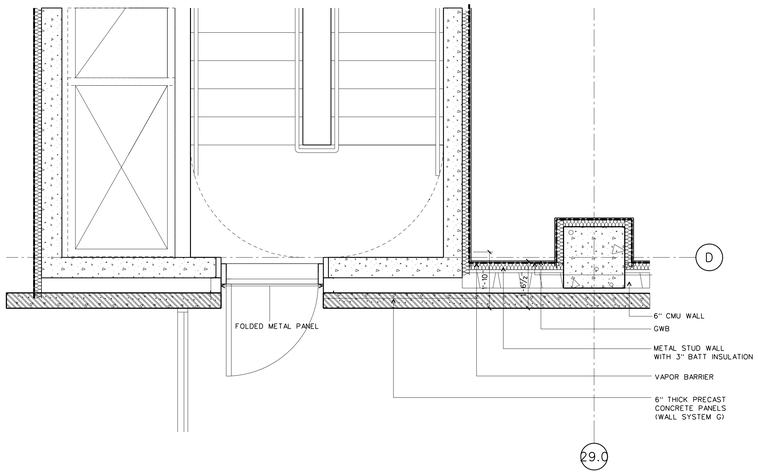

WALL SYSTEM G: PLAN DETAIL AT ARCHIVE LOBBY

SCALE: ½" = 1'-0" DETAILS/DTL-CWG3 **10**

WILLIAM J. CLINTON PRESIDENTIAL CENTER

LITTLE ROCK, ARKANSAS

Architect

POLSHEK PARTNERSHIP LLP
320 West 13th Street
New York, New York 10014
212.807.7171

Coordinating Architects

POLK STANLEY YEARY ARCHITECTS Ltd
700 South Schiller Street
Little Rock, Arkansas 72201
501.378.0878

WITSELL EVANS RASCO
901 West Third Street
Little Rock, Arkansas 72201
501.374.5300

WOODS CARADINE ARCHITECTS
2200 South Main Street
Little Rock, Arkansas 72206
501.374.4060

Landscape Architects

HARGREAVES ASSOCIATES
118 Magazine Street
Cambridge, Massachusettes 02139
617.661.0070

LANDSCAPE ARCHITECTURE, Inc.
2300 Cottondale Lane Suite 202
Little Rock, Arkansas 72202
501.374.5610

Structural Engineer

LESLIE E. ROBERTSON ASSOC., RLLP
30 Broad Street, 47th Floor
New York, New York 10004
212.750.9000

MEP Engineers

FLACK + KURTZ Inc.
475 Fifth Avenue
New York, New York 10017
212.532.9600


CROMWELL ARCHITECTS ENGINEERS
101 South Spring Street
Little Rock, Arkansas 72201
501.372.2900

Curtainwall Consultant

R. A. HEINTGES ARCHITECTS
126 Fifth Avenue, 9th Floor
New York, New York 10011
212.652-2966

Seal

Issue	Date
100% Construction Documents	09/27/02
90% Progress Printing	08/30/02
ASI #05	08/20/02
100% Struct./ CD Progress	07/01/02
Bridge Bldg. Substructure	06/14/02
100% Steel & Concrete CD & Architectural CD Progress	05/15/02
100% Design Development	03/01/02

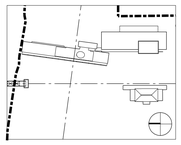

Job No. 9908

Scale 1/2" = 1'-0"

Date September 27, 2002


Title

WALL SYSTEM G: PLANS

Sheet No.


A341

FOR OFFICIAL USE ONLY

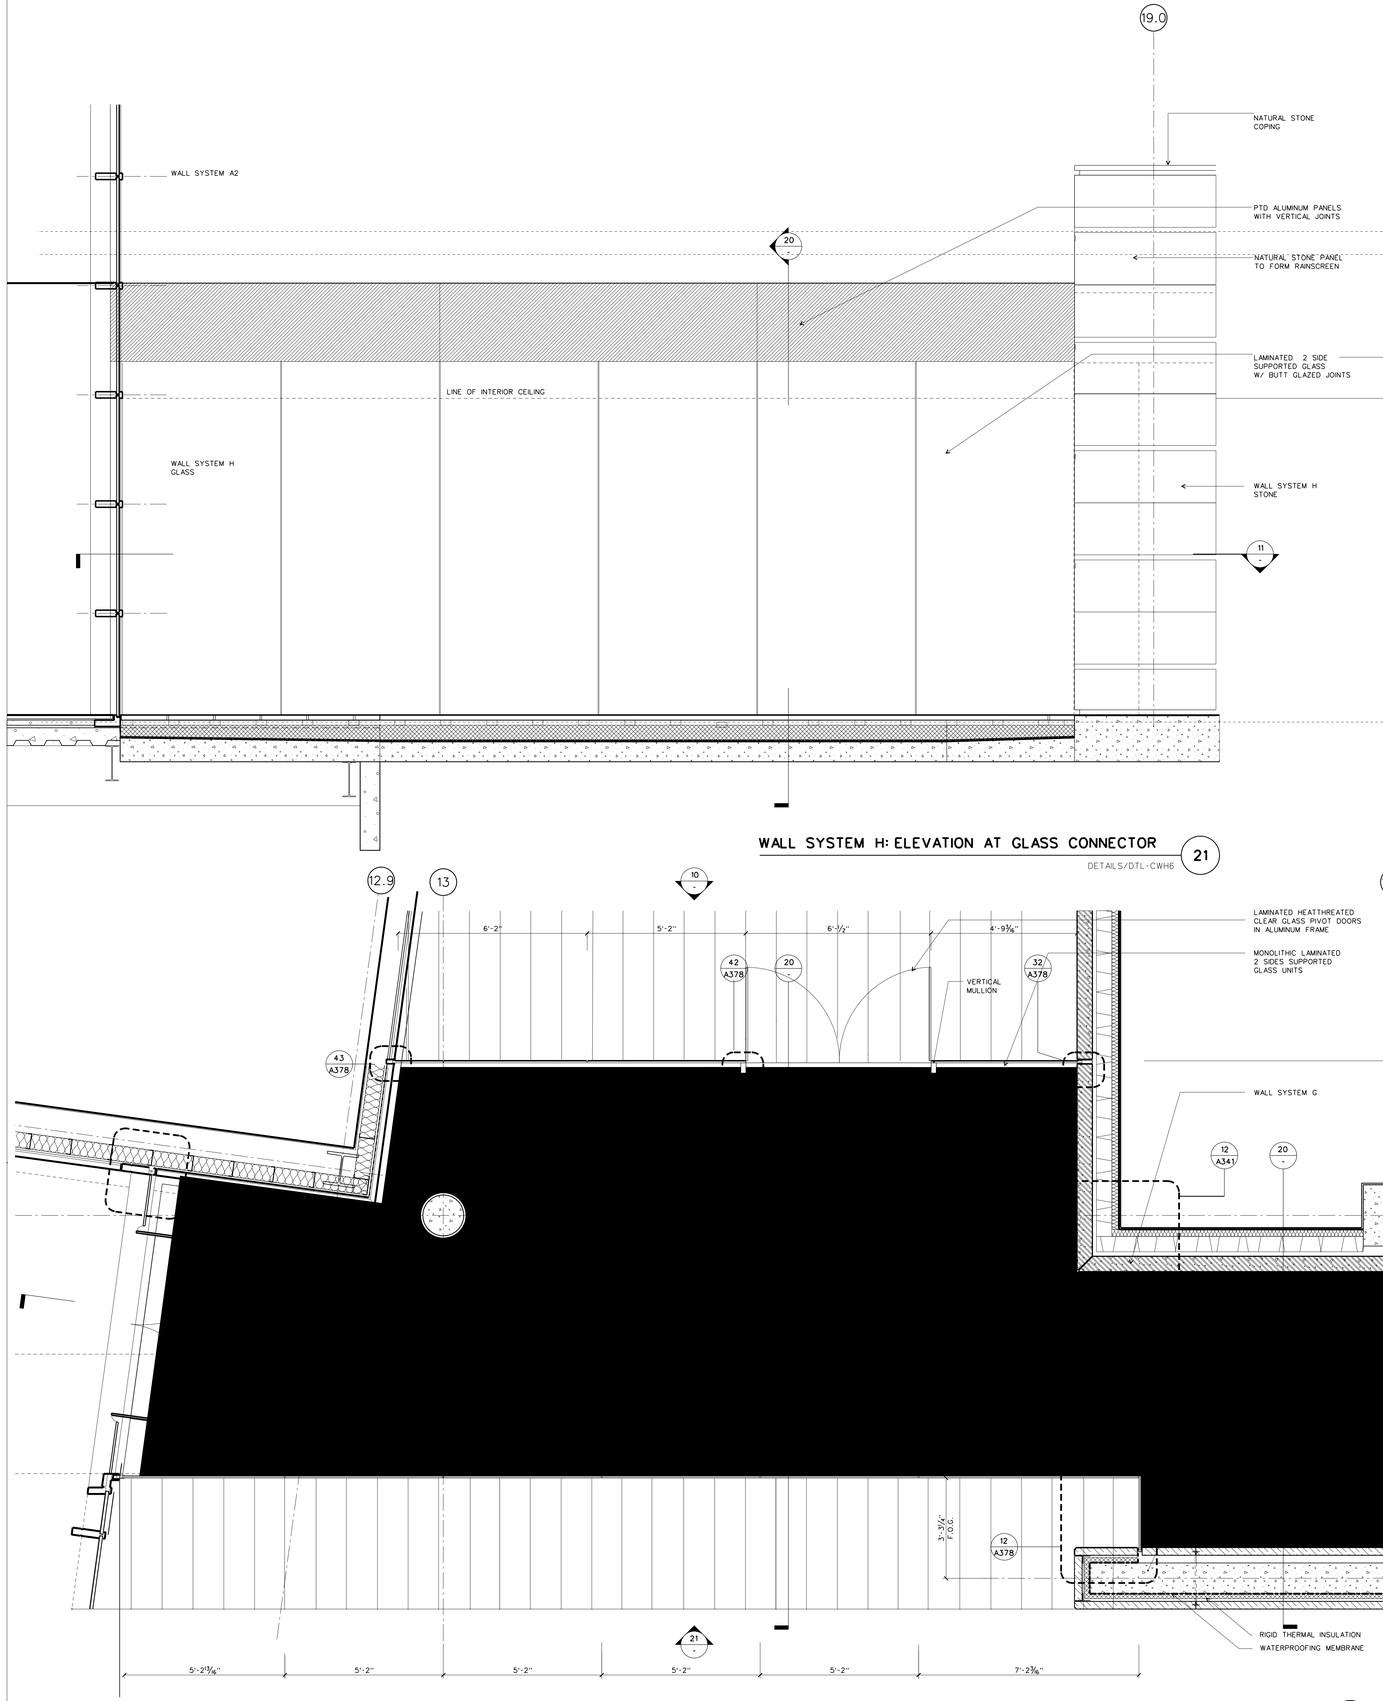

WALL SYSTEM H: ELEVATION AT GLASS CONNECTOR 21

DETAILS/DTL-CWH6

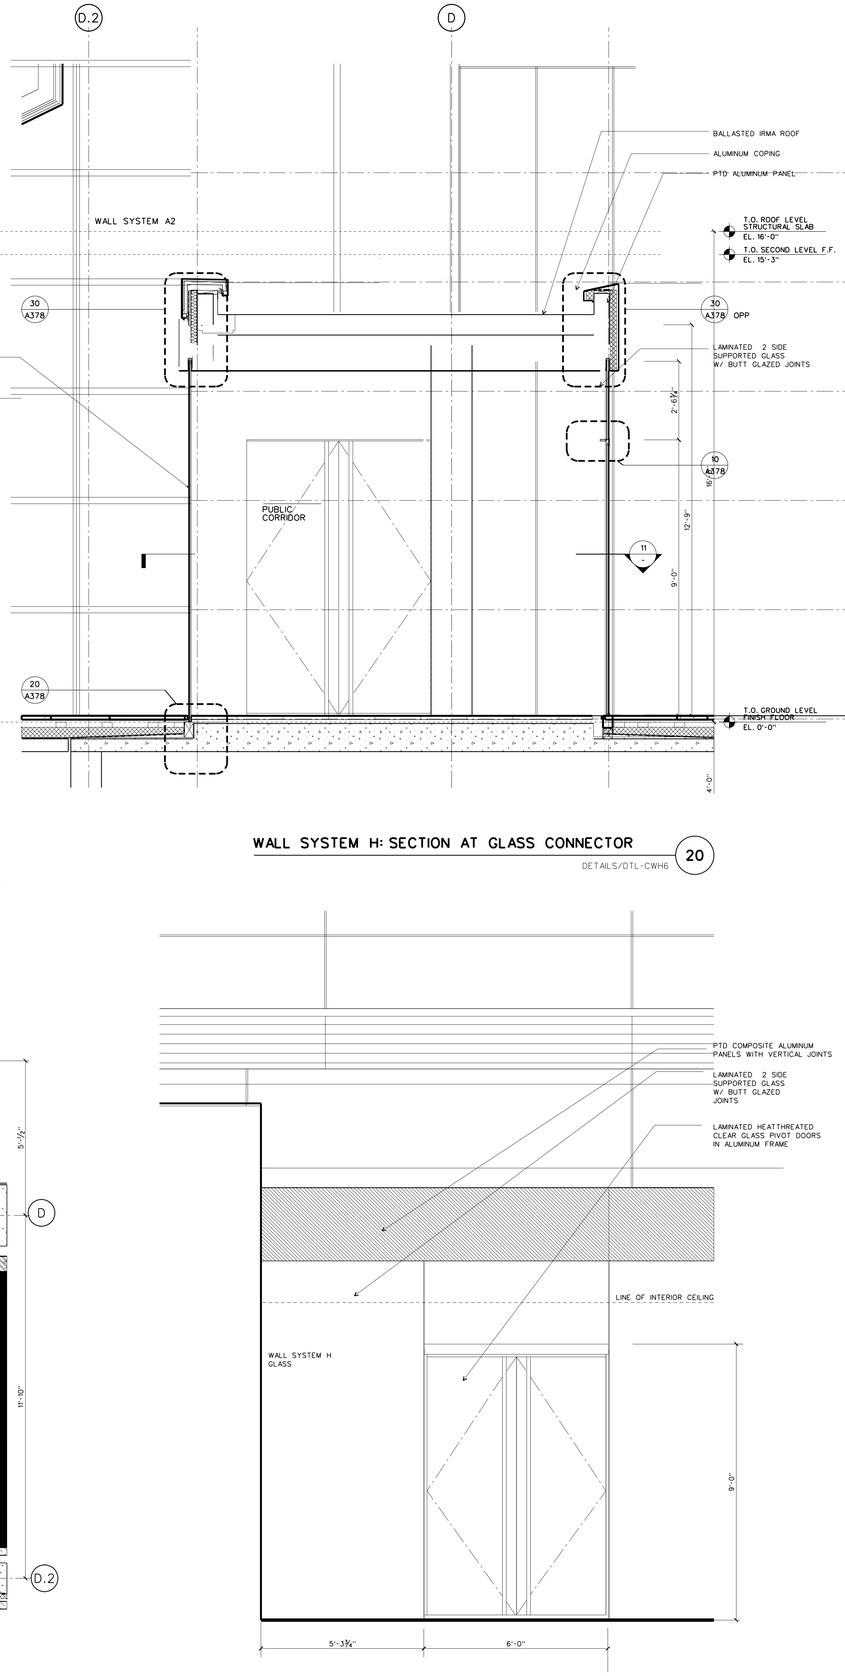

WALL SYSTEM H: SECTION AT GLASS CONNECTOR 20

DETAILS/DTL-CWH6

WALL SYSTEM H: PLAN DETAIL AT GLASS CONNECTOR 11

DETAILS/DTL-CWH6

WALL SYSTEM H: PART. CORRIDOR ELEVATION 10

DETAILS/DTL-CWH6

WILLIAM J. CLINTON PRESIDENTIAL CENTER

LITTLE ROCK, ARKANSAS

Architect

POLSHEK PARTNERSHIP LLP
320 West 13th Street
New York, New York 10014
212.807.7171

Coordinating Architects

POLK STANLEY YEARY ARCHITECTS Ltd
700 South Schiller Street
Little Rock, Arkansas 72201
501.378.0878

WITSELL EVANS RASCO
901 West Third Street
Little Rock, Arkansas 72201
501.374.5300

WOODS CARADINE ARCHITECTS
2200 South Main Street
Little Rock, Arkansas 72206
501.374.4060

Landscape Architects

HARGREAVES ASSOCIATES
118 Magazine Street
Cambridge, Massachusettes 02139
617.661.0070

LANDSCAPE ARCHITECTURE, Inc.
2300 Cottondale Lane Suite 202
Little Rock, Arkansas 72202
501.374.5610

Structural Engineer

LESLIE E. ROBERTSON ASSOC., RLLP
30 Broad Street, 47th Floor
New York, New York 10004
212.750.9000

MEP Engineers

FLACK + KURTZ Inc.
475 Fifth Avenue
New York, New York 10017
212.532.9600


CROMWELL ARCHITECTS ENGINEERS
101 South Spring Street
Little Rock, Arkansas 72201
501.372.2900

Curtainwall Consultant

R. A. HEINTGES ARCHITECTS
126 Fifth Avenue, 9th Floor
New York, New York 10011
212.652-2966

Seal

Issue	Date
100% Construction Documents	09/27/02
90% Progress Printing	08/30/02
ASI #05	08/20/02
100% Struct./ CD Progress	07/01/02
Bridge Bldg. Substructure	06/14/02
100% Steel & Concrete CD & Architectural CD Progress	05/15/02
100% Design Development	03/01/02

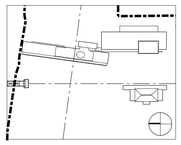

Job No. 9908

Scale 1/2" = 1'-0"

Date September 27, 2002


Title

WALL SYSTEM H: PLANS/SECTIONS AT NECK CONNECTOR

Sheet No.


A342

FOR OFFICIAL USE ONLY

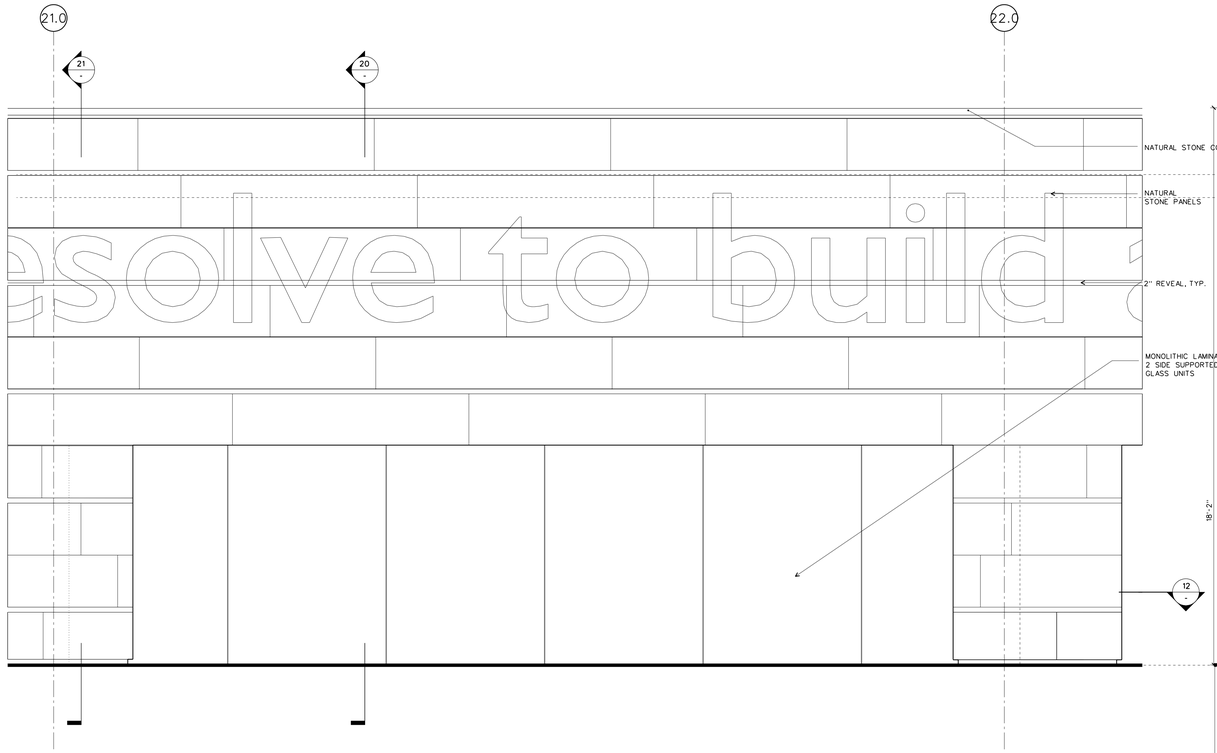


WALL SYSTEM H: PARTIAL ELEVATION AT STONE WALL OPENINGS

SCALE: 1/2" = 1'-0" — DETAILS/DTL-CWH 22

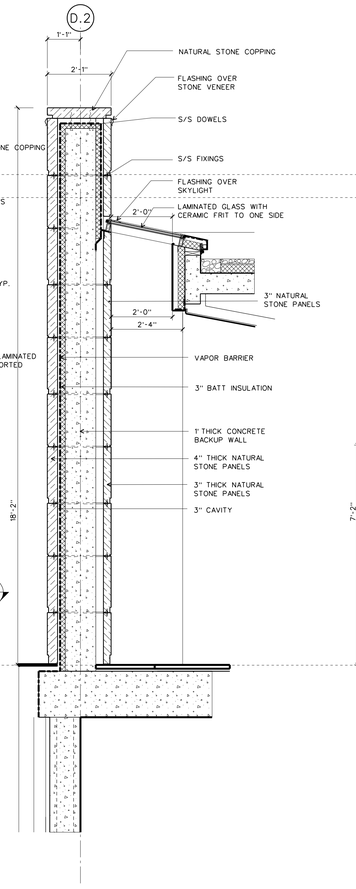


WALL SYSTEM H: TYPICAL STONE WALL SECTION

SCALE: 1/2" = 1'-0" — DETAILS/DTL-CWH 21

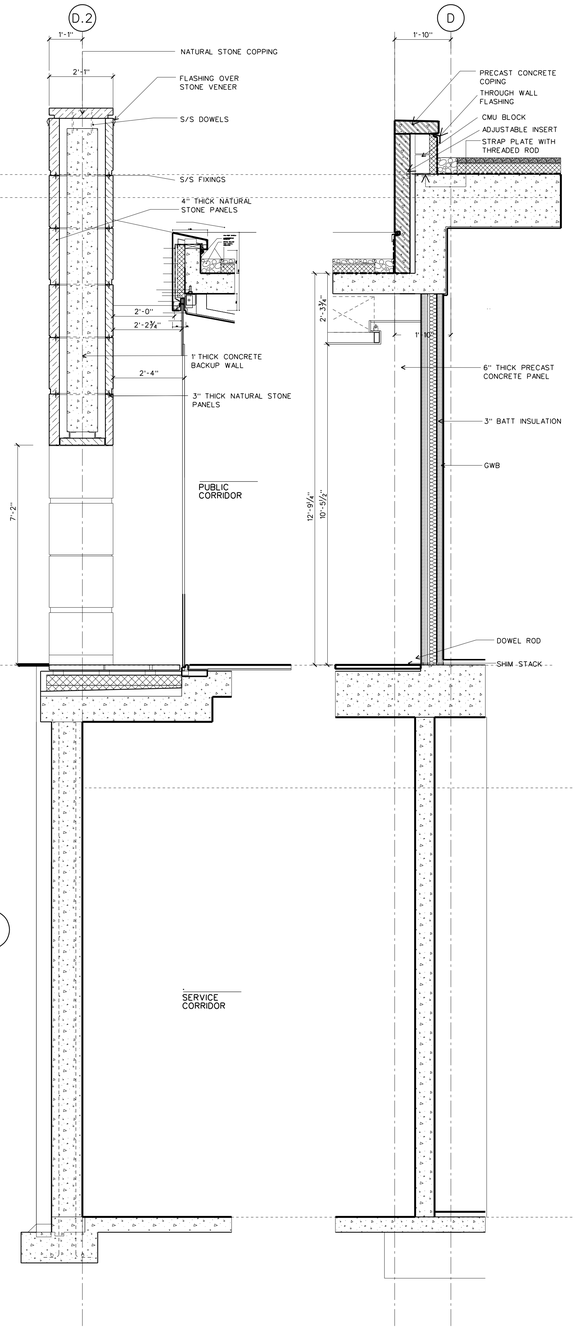

WALL SYSTEM H: TYPICAL STONE WALL SECTION

SCALE: 1/2" = 1'-0" — DETAILS/DTL-CWH 20

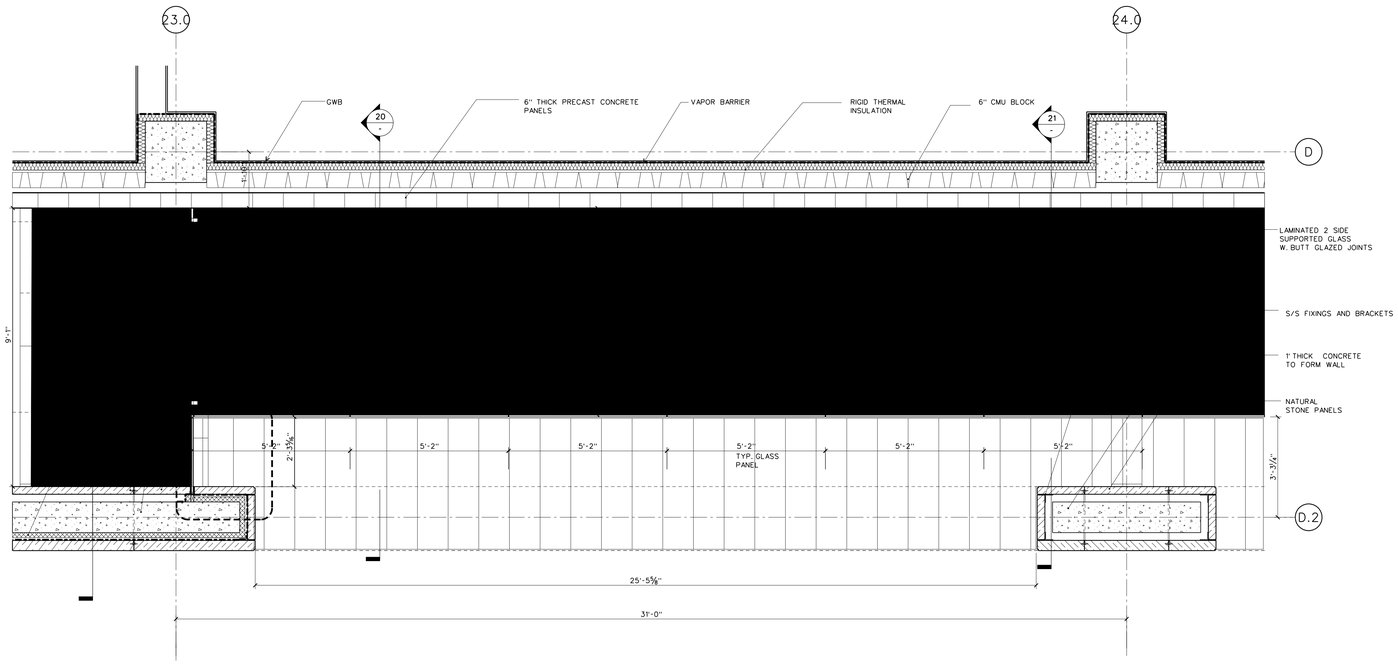

WALL SYSTEM H: PARTIAL PLAN AT STONE WALL OPENINGS

SCALE: 1/2" = 1'-0" — DETAILS/DTL-CWH 12

WILLIAM J. CLINTON PRESIDENTIAL CENTER

LITTLE ROCK, ARKANSAS

Architect

POLSHEK PARTNERSHIP LLP
320 West 13th Street
New York, New York 10014
212.807.7171

Coordinating Architects

POLK STANLEY YEARY ARCHITECTS Ltd
700 South Schiller Street
Little Rock, Arkansas 72201
501.378.0878

WITSELL EVANS RASCO
901 West Third Street
Little Rock, Arkansas 72201
501.374.5300

WOODS CARADINE ARCHITECTS
2200 South Main Street
Little Rock, Arkansas 72206
501.374.4060

Landscape Architects

HARGREAVES ASSOCIATES
118 Magazine Street
Cambridge, Massachusettes 02139
617.661.0070

LANDSCAPE ARCHITECTURE, Inc.
2300 Cottondale Lane Suite 202
Little Rock, Arkansas 72202
501.374.5610

Structural Engineer

LESLIE E. ROBERTSON ASSOC., RLLP
30 Bread Street, 47th Floor
New York, New York 10004
212.750.9000

MEP Engineers

FLACK + KURTZ Inc.
475 Fifth Avenue
New York, New York 10017
212.532.9600


CROMWELL ARCHITECTS ENGINEERS
101 South Spring Street
Little Rock, Arkansas 72201
501.372.2900

Curtainwall Consultant

R. A. HEINTGES ARCHITECTS
126 Fifth Avenue, 9th Floor
New York, New York 10011
212.652-2966

Seal

Issue	Date
100% Construction Documents	09/27/02
90% Progress Printing	08/30/02
ASI #05	08/20/02
100% Struct./ CD Progress	07/01/02
Bridge Bldg. Substructure	06/14/02
100% Steel & Concrete CD	05/15/02
& Architectural CD Progress	
100% Design Development	03/01/02

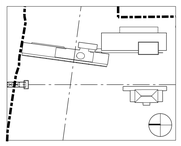

Job No.
9908


Scale
1/2" = 1'-0"

Date
September 27, 2002

Title
WALL SYSTEMS H+I: PLAN, ELEVATION AND SECTION


Sheet No.
A343

FOR OFFICIAL USE ONLY

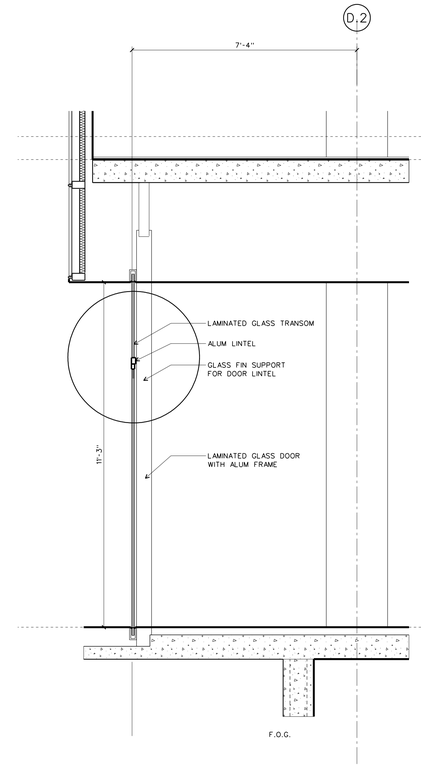


WALL SYSTEM H:
SECTION THROUGH GLASS DOOR
AT ARCHIVE-LOBBY ENTRY

DETAILS/DTL-CWH2 22

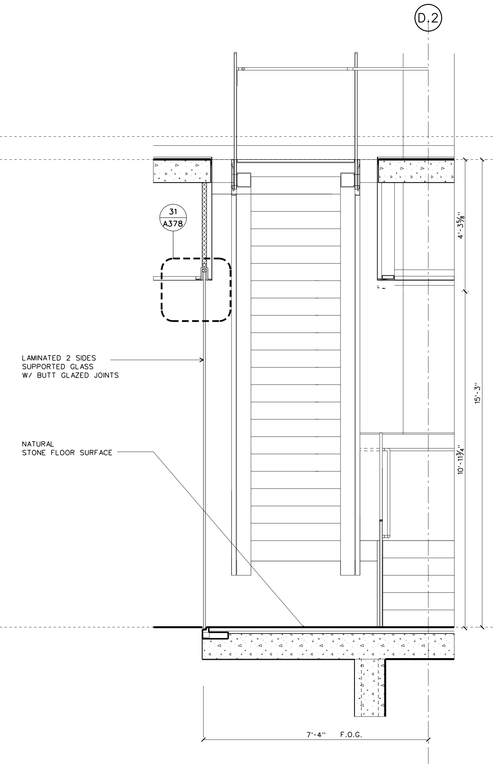


WALL SYSTEM H: SECTION THROUGH STAIR
AT ARCHIVELOBBY ENTRY

DETAILS/DTL-CWH2 21

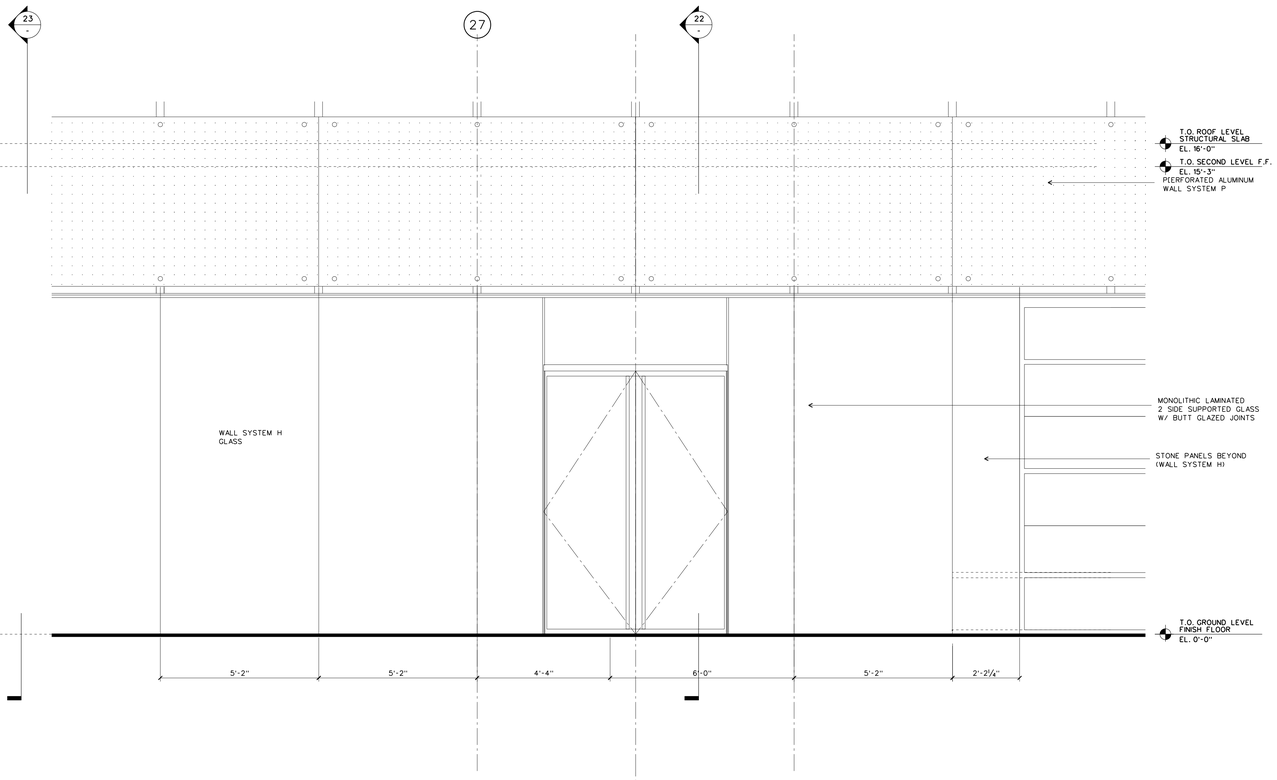


WALL SYSTEM H: PARTIAL ELEVATION WEST

DETAILS/DTL-CWH2 20

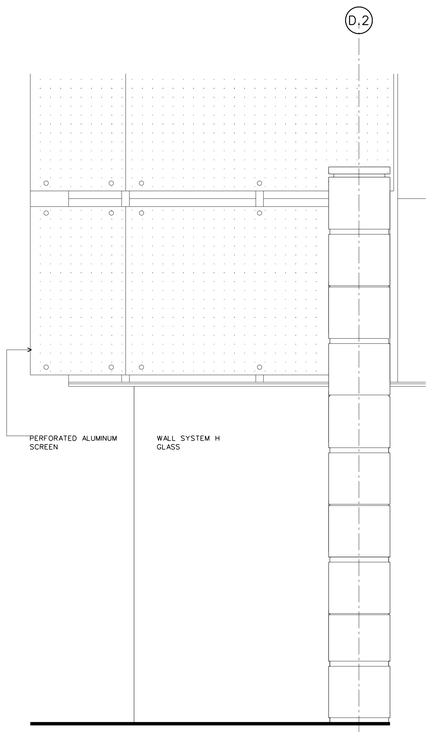

WALL SYSTEM H: PARTIAL ELEVATION SOUTH

DETAILS/DTL-CWH2 11

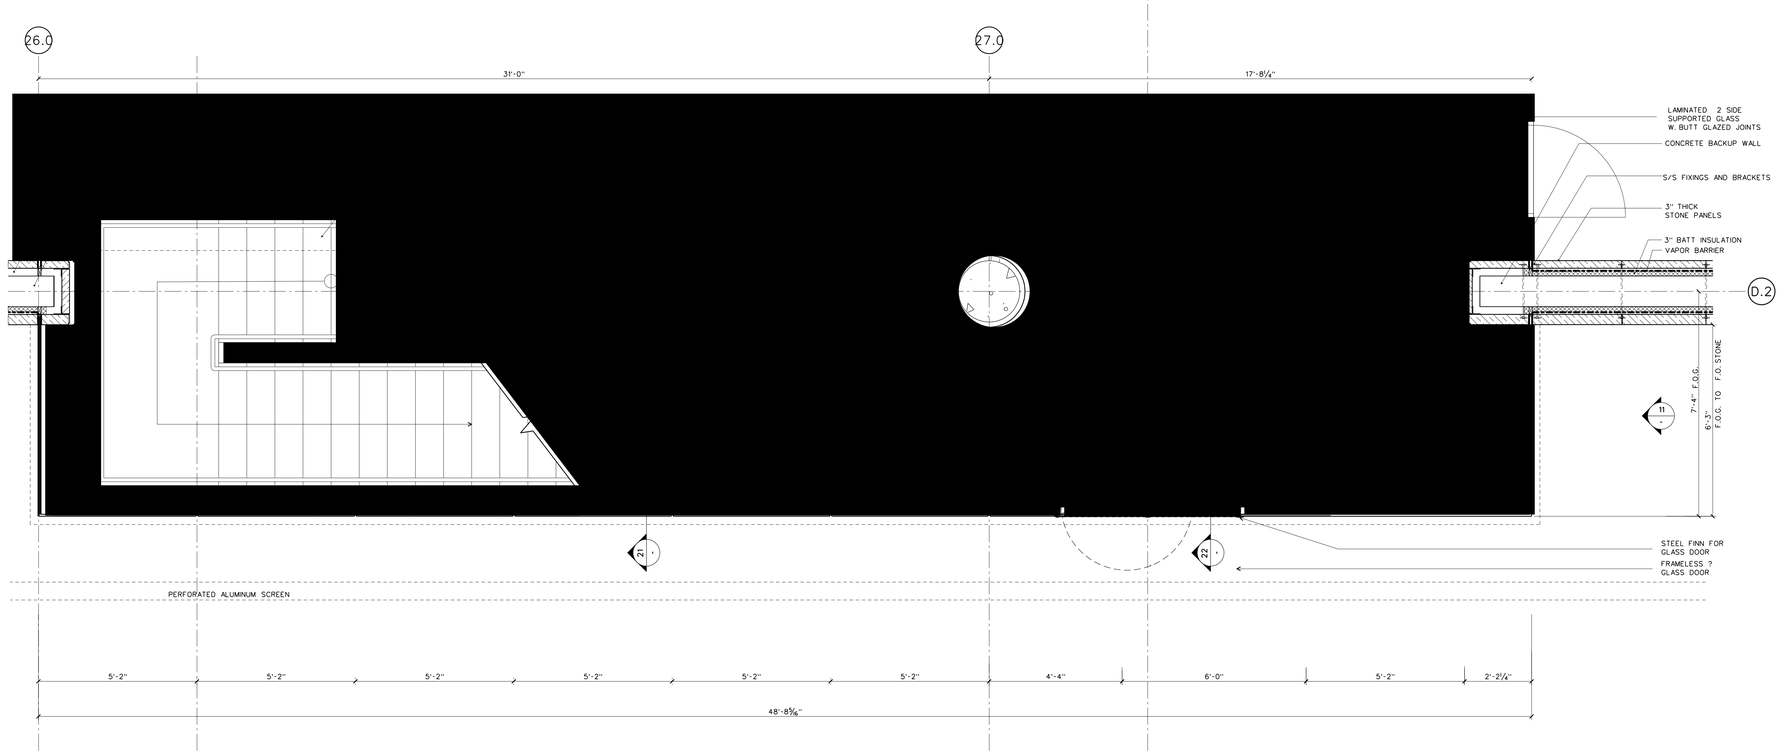

WALL SYSTEM H: PARTIAL PLAN AT ARCHIVE OFFICE LOBBY

SCALE: ½" = 1'-0"

DETAILS/DTL-CWH2 10

WILLIAM J. CLINTON PRESIDENTIAL CENTER

LITTLE ROCK, ARKANSAS

Architect

POLSHEK PARTNERSHIP LLP
320 West 13th Street
New York, New York 10014
212.807.7171

Coordinating Architects

POLK STANLEY YEARY ARCHITECTS Ltd
700 South Schiller Street
Little Rock, Arkansas 72201
501.378.0878

WITSELL EVANS RASCO
901 West Third Street
Little Rock, Arkansas 72201
501.374.5300

WOODS CARADINE ARCHITECTS
2200 South Main Street
Little Rock, Arkansas 72206
501.374.4060

Landscape Architects

HARGREAVES ASSOCIATES
118 Magazine Street
Cambridge, Massachusettes 02139
617.661.0070

LANDSCAPE ARCHITECTURE, Inc.
2300 Cottondale Lane Suite 202
Little Rock, Arkansas 72202
501.374.5610

Structural Engineer

LESLIE E. ROBERTSON ASSOC., RLLP
30 Broad Street, 47th Floor
New York, New York 10004
212.750.9000

MEP Engineers

FLACK + KURTZ Inc.
475 Fifth Avenue
New York, New York 10017
212.532.9600


CROMWELL ARCHITECTS ENGINEERS
101 South Spring Street
Little Rock, Arkansas 72201
501.372.2900

Curtainwall Consultant

R. A. HEINTGES ARCHITECTS
126 Fifth Avenue, 9th Floor
New York, New York 10011
212.652-2966

Seal

Issue	Date
100% Construction Documents	09/27/02
90% Progress Printing	08/30/02
ASI #05	08/20/02
100% Struct./ CD Progress	07/01/02
Bridge Bldg. Substructure	06/14/02
100% Steel & Concrete CD	05/15/02
& Architectural CD Progress	
100% Design Development	03/01/02

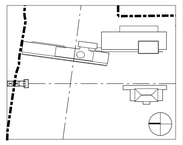

Job No.
9908


Scale
1/2" = 1'-0"

Date
September 27, 2002

Title
WALL SYSTEM H:
PLAN AND SECTIONS

Sheet No.
A344


FOR OFFICIAL USE ONLY

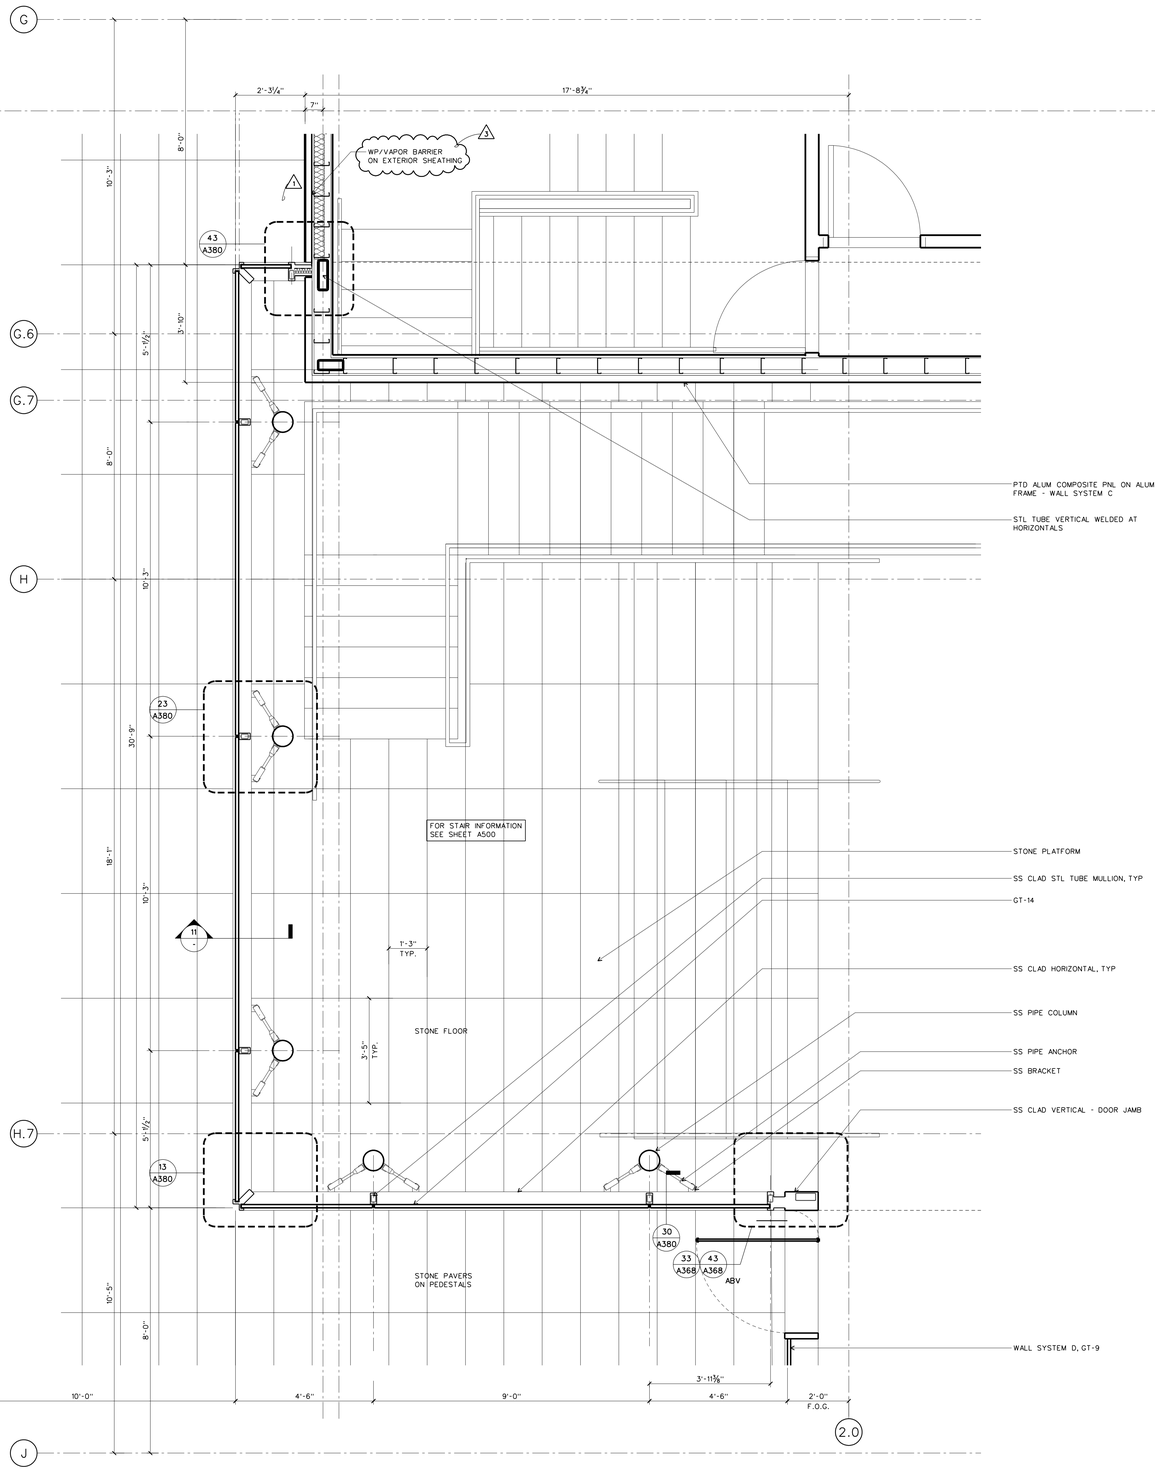

WALL SYSTEM J: PLAN SECTION AT NORTH BOX

SCALE: ½" = 1'-0"


DETAILS/DTL-CWJ 12

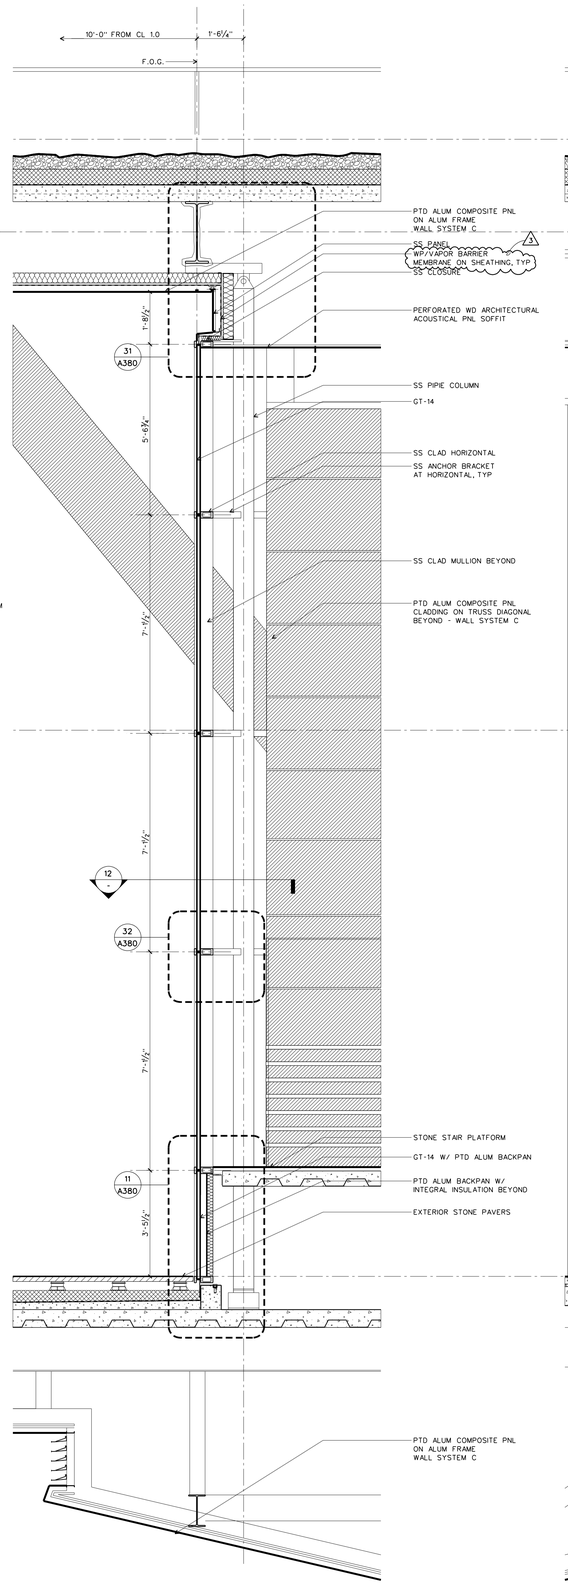

WALL SYSTEM J: WALL SECTION AT NORTH BOX

SCALE: ½" = 1'-0"

DETAILS/DTL-CWJ 11

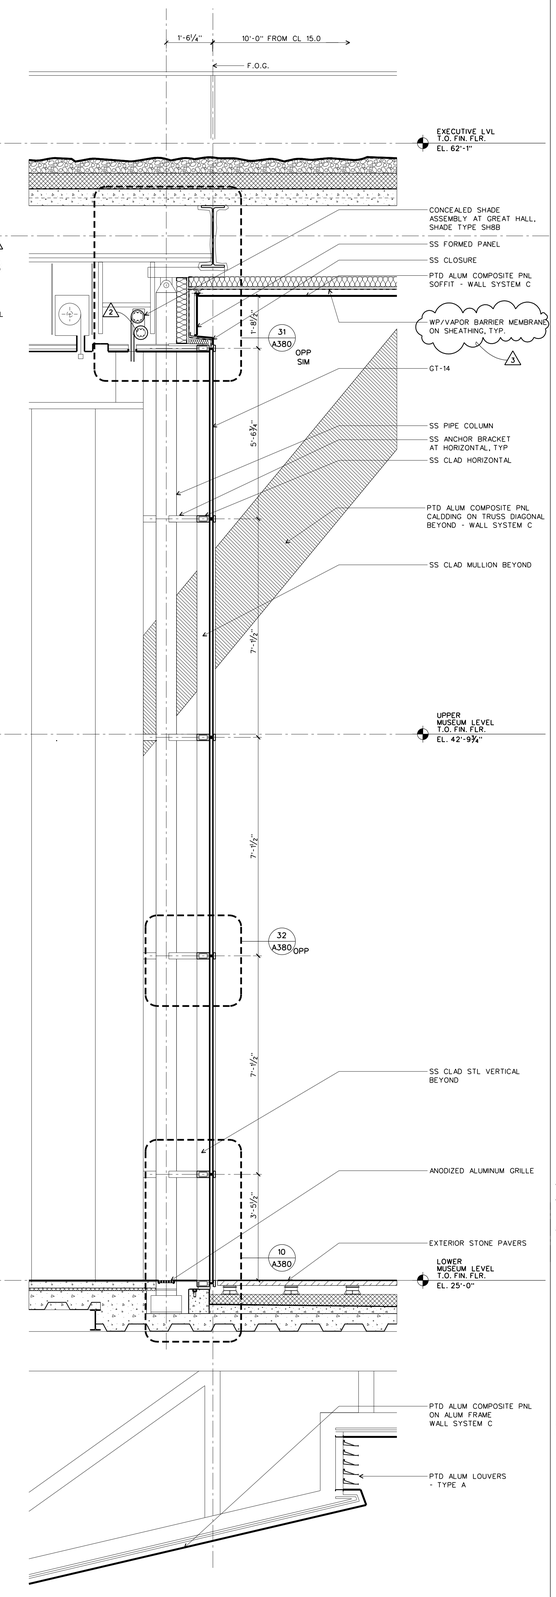

WALL SYSTEM J: WALL SECTION AT SOUTH BOX

SCALE: ½" = 1'-0"

DETAILS/DTL-CWJ 10

WILLIAM J. CLINTON PRESIDENTIAL CENTER

LITTLE ROCK, ARKANSAS

Architect

POLSHEK PARTNERSHIP LLP
320 West 13th Street
New York, New York 10014
212.807.7171

Coordinating Architects

POLK STANLEY YEARY ARCHITECTS Ltd
700 South Schiller Street
Little Rock, Arkansas 72201
501.378.0878

WITSELL EVANS RASCO
901 West Third Street
Little Rock, Arkansas 72201
501.374.5300

WOODS CARADINE ARCHITECTS
2200 South Main Street
Little Rock, Arkansas 72206
501.374.4060

Landscape Architects

HARGREAVES ASSOCIATES
118 Magazine Street
Cambridge, Massachusettes 02139
617.661.0070

LANDSCAPE ARCHITECTURE, Inc.
2300 Cottondale Lane Suite 202
Little Rock, Arkansas 72202
501.374.5610

Structural Engineer

LESLIE E. ROBERTSON ASSOC., RLLP
30 Broad Street, 47th Floor
New York, New York 10004
212.750.9000

MEP Engineers

FLACK + KURTZ Inc.
475 Fifth Avenue
New York, New York 10017
212.532.9600


CROMWELL ARCHITECTS ENGINEERS
101 South Spring Street
Little Rock, Arkansas 72201
501.372.2900

Curtainwall Consultant

R. A. HEINTGES ARCHITECTS
126 Fifth Avenue, 9th Floor
New York, New York 10011
212.652-2966

Seal

Issue	Date
3 ASI #22	08/01/03
2 Addendum #2	11/15/02
100% Construction Documents	09/27/02
1 90% Progress Printing	08/30/02
100% Struct./ CD Progress	07/01/02
100% Design Development	03/01/02

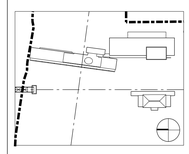

Job No. 9908

Scale 1/2" = 1'-0"

Date September 27, 2002


Title

WALL SYSTEM J
PLAN AND SECTIONS

Sheet No.

A345


FOR OFFICIAL USE ONLY

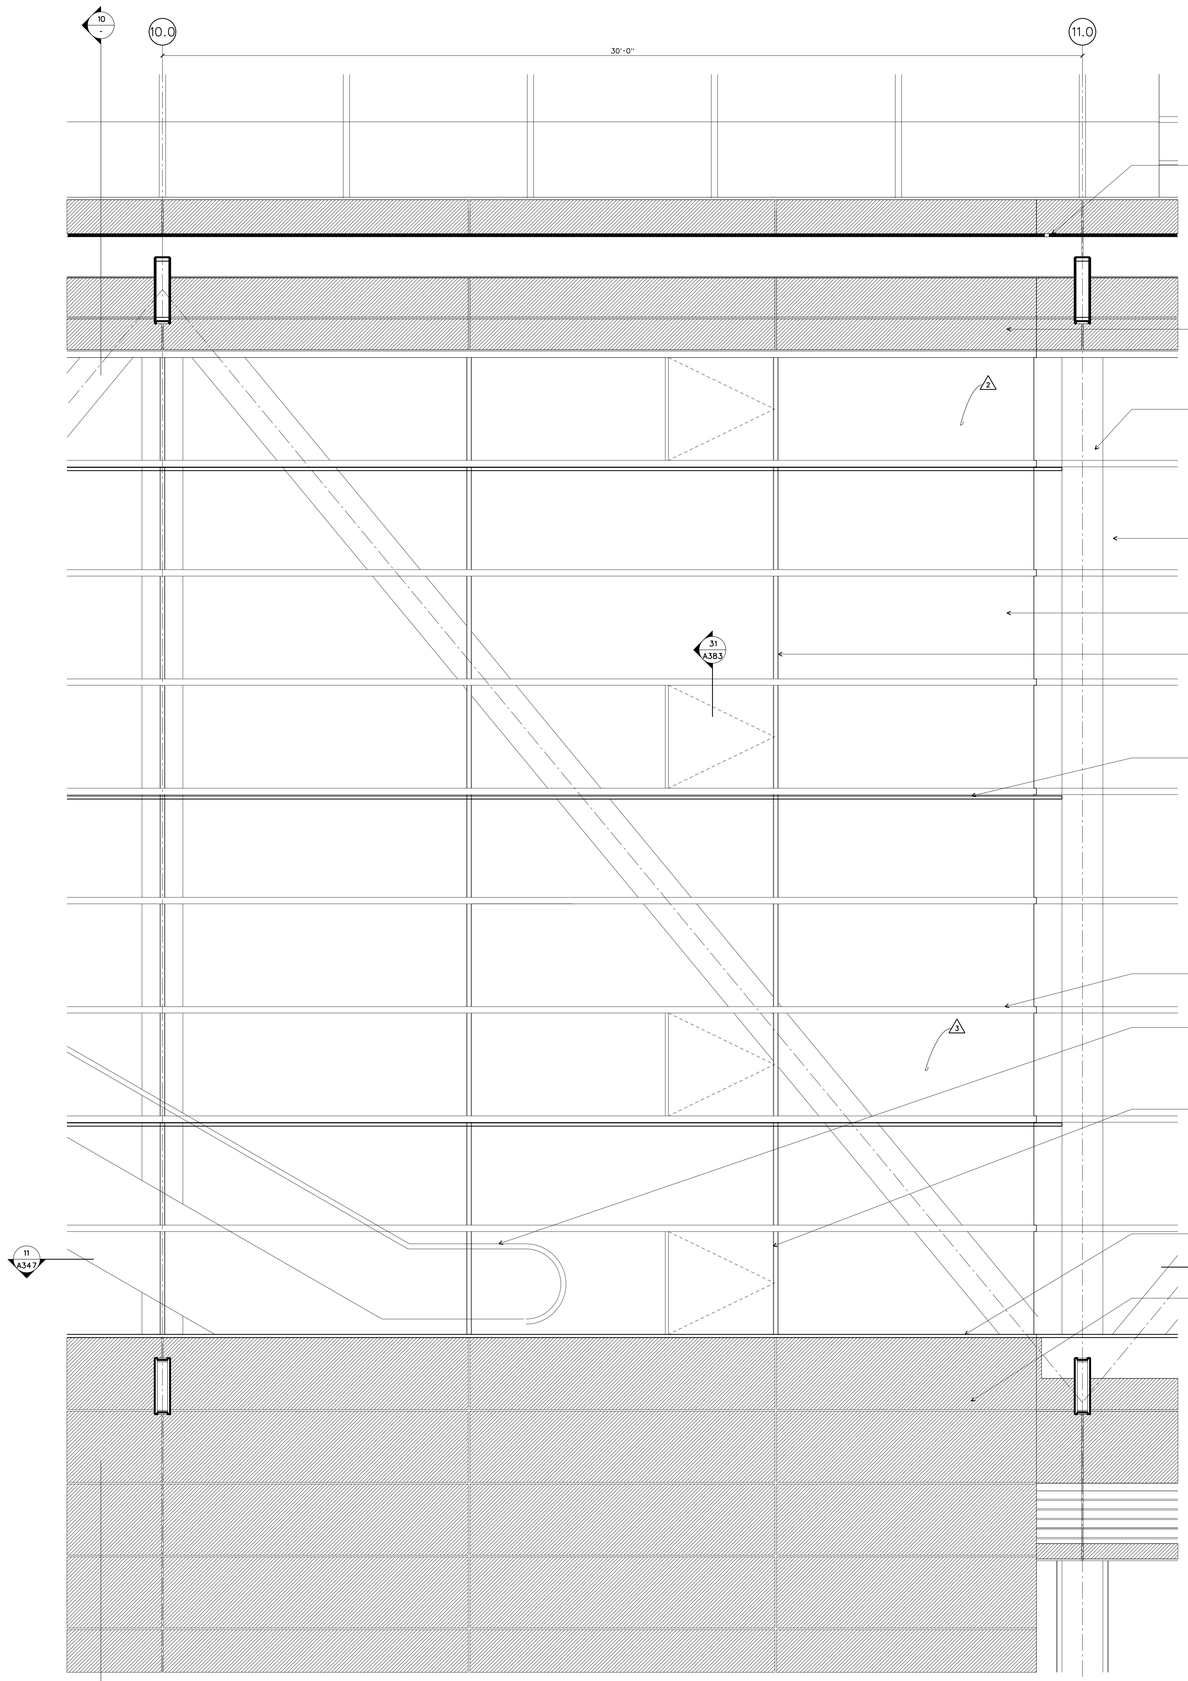

WALL SYSTEM K: ELEVATION AT TYPICAL BAY

SCALE: ½" = 1'-0"

DETAILS/DTL-CWK 12

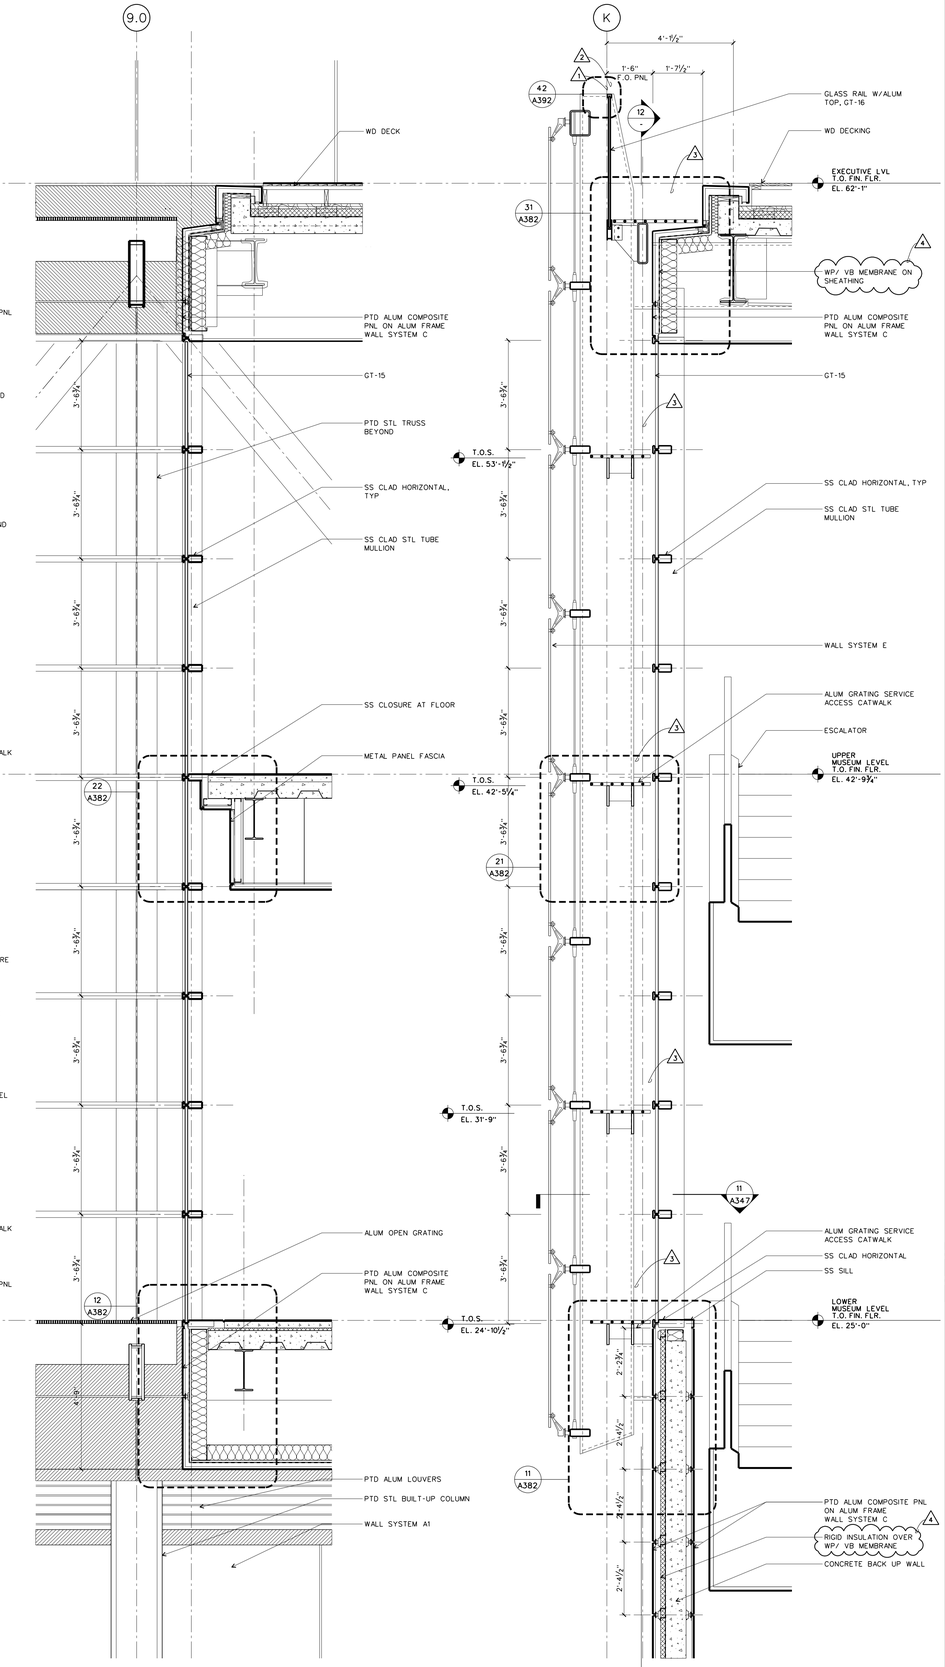

WALL SYSTEM K: WALL SECTION AT ESCALATOR

SCALE: ½" = 1'-0"

DETAILS/DTL-CWK 11

WALL SYSTEM E/K: WALL SECTION AT ESCALATOR

SCALE: ½" = 1'-0"

DETAILS/DTL-CWK 10

WILLIAM J. CLINTON PRESIDENTIAL CENTER

LITTLE ROCK, ARKANSAS

Architect

POLSHEK PARTNERSHIP LLP
320 West 13th Street
New York, New York 10014
212.807.7171

Coordinating Architects

POLK STANLEY YEARY ARCHITECTS Ltd
700 South Schiller Street
Little Rock, Arkansas 72201
501.378.0878

WITSELL EVANS RASCO
901 West Third Street
Little Rock, Arkansas 72201
501.374.5300

WOODS CARADINE ARCHITECTS
2200 South Main Street
Little Rock, Arkansas 72206
501.374.4060

Landscape Architects

HARGREAVES ASSOCIATES
118 Magazine Street
Cambridge, Massachusettes 02139
617.661.0070

LANDSCAPE ARCHITECTURE, Inc.
2300 Cottondale Lane Suite 202
Little Rock, Arkansas 72202
501.374.5610

Structural Engineer

LESLIE E. ROBERTSON ASSOC., RLLP
30 Broad Street, 47th Floor
New York, New York 10004
212.750.9000

MEP Engineers

FLACK + KURTZ Inc.
475 Fifth Avenue
New York, New York 10017
212.532.9600


CROMWELL ARCHITECTS ENGINEERS
101 South Spring Street
Little Rock, Arkansas 72201
501.372.2900

Curtainwall Consultant

R. A. HEINTGES ARCHITECTS
126 Fifth Avenue, 9th Floor
New York, New York 10011
212.652-2966

Seal

Issue	Date
4 ASI #22	08/01/03
3 ASI #12	02/07/03
2 100% Construction Documents	09/27/02
1 90% Progress Printing	08/30/02
100% Struct./ CD Progress	07/01/02
100% Design Development	03/01/02

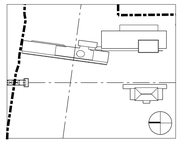

Job No. 9908

Scale 1/2" = 1'-0"

Date September 27, 2002


Title

WALL SYSTEM K + E: ELEVATION AND SECTIONS

Sheet No.

A346


FOR OFFICIAL USE ONLY

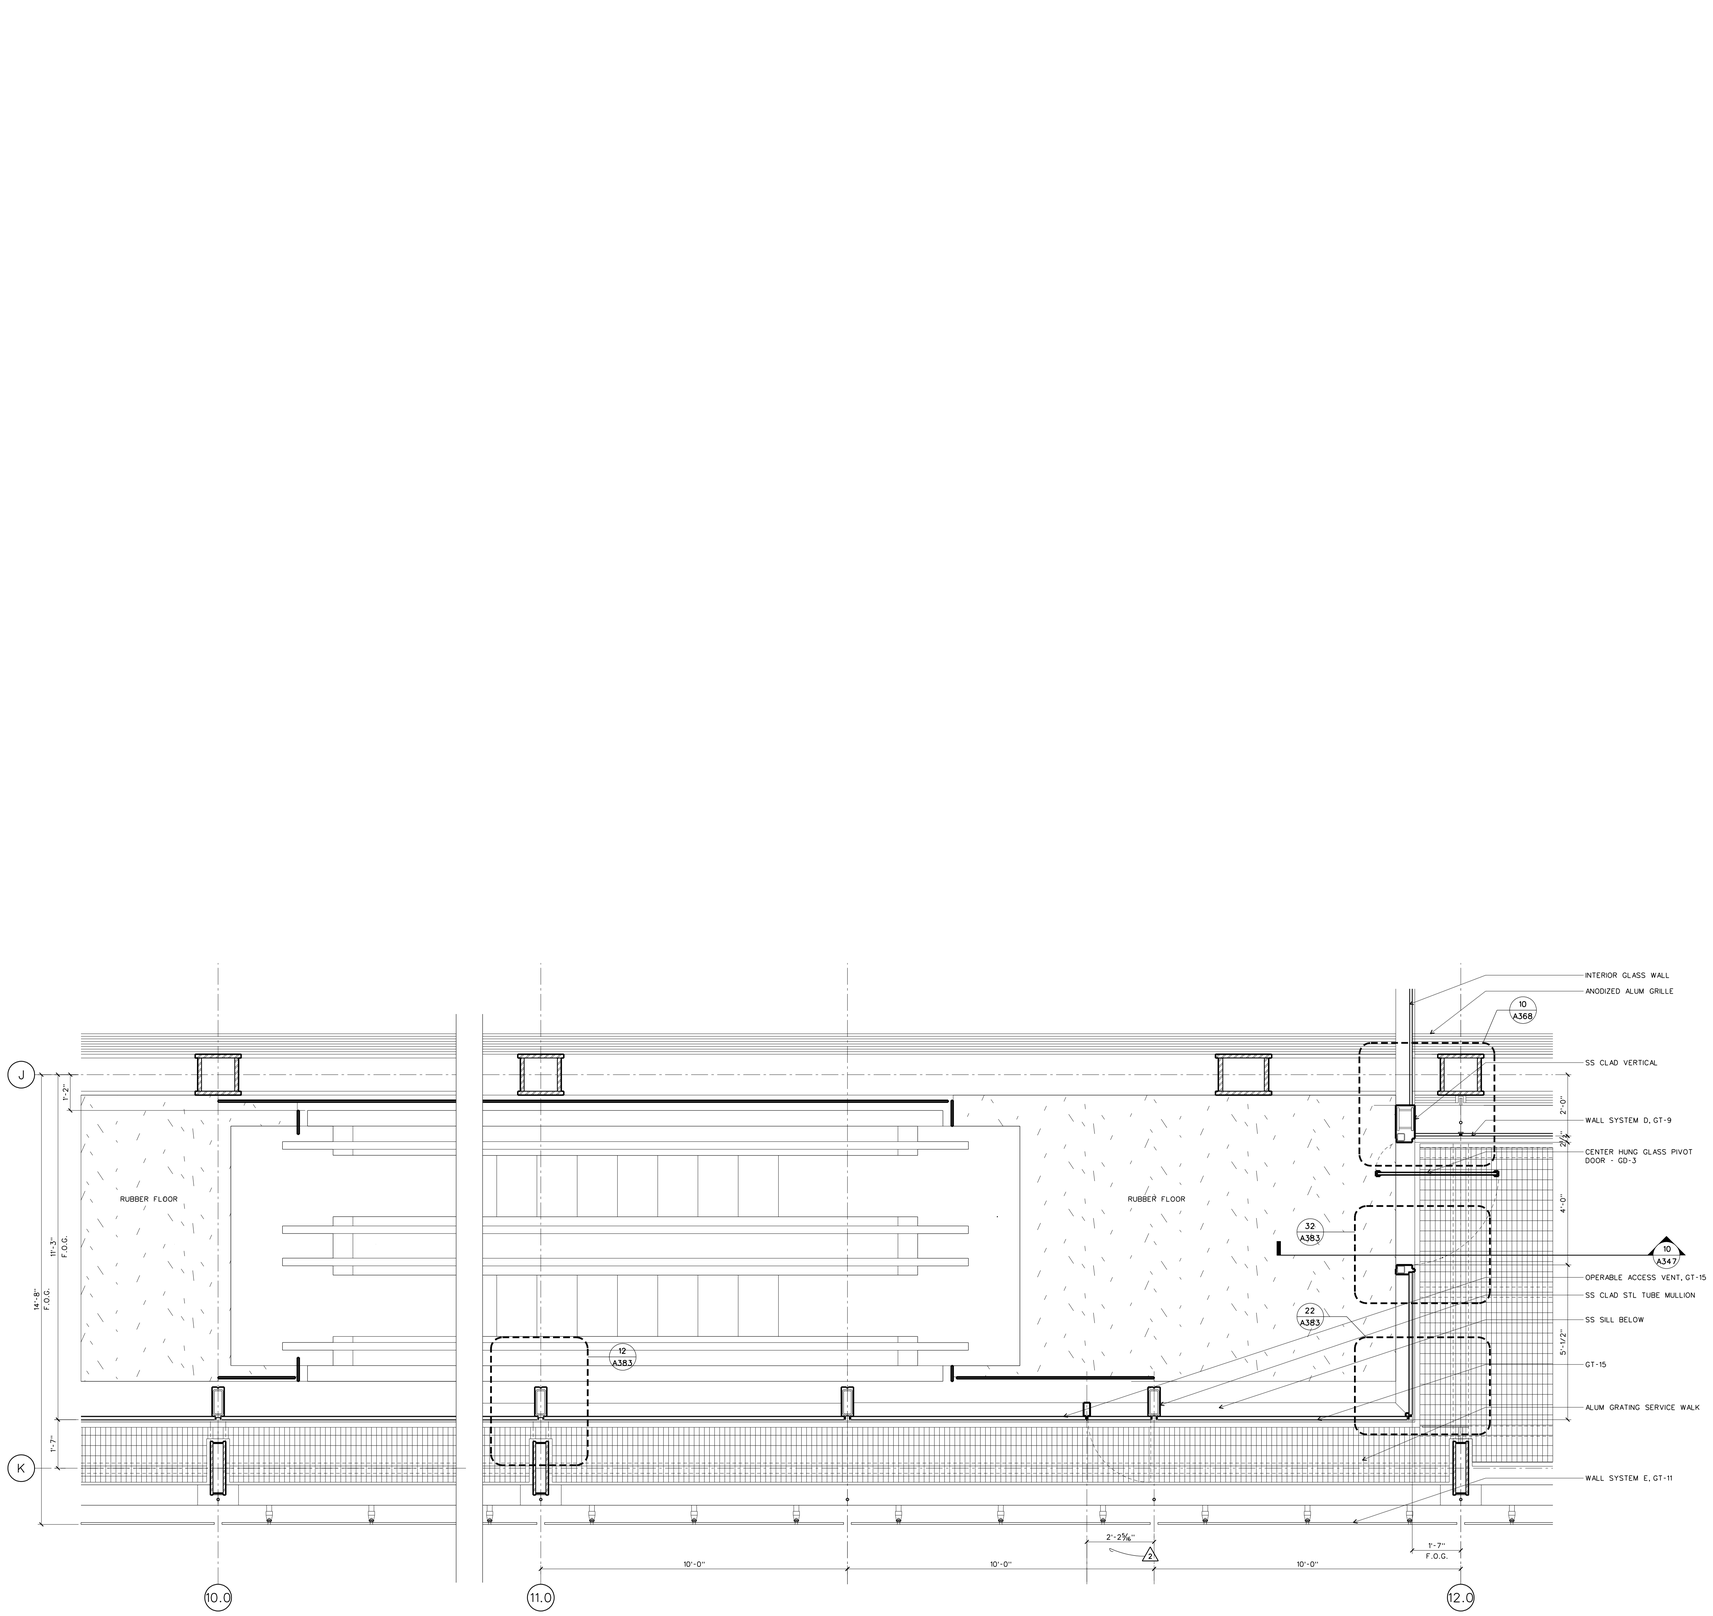

WALL SYSTEM K: PLAN SECTION AT ESCALATOR

SCALE: ½" = 1'-0"

DETAILS/DTL-CWK2 11

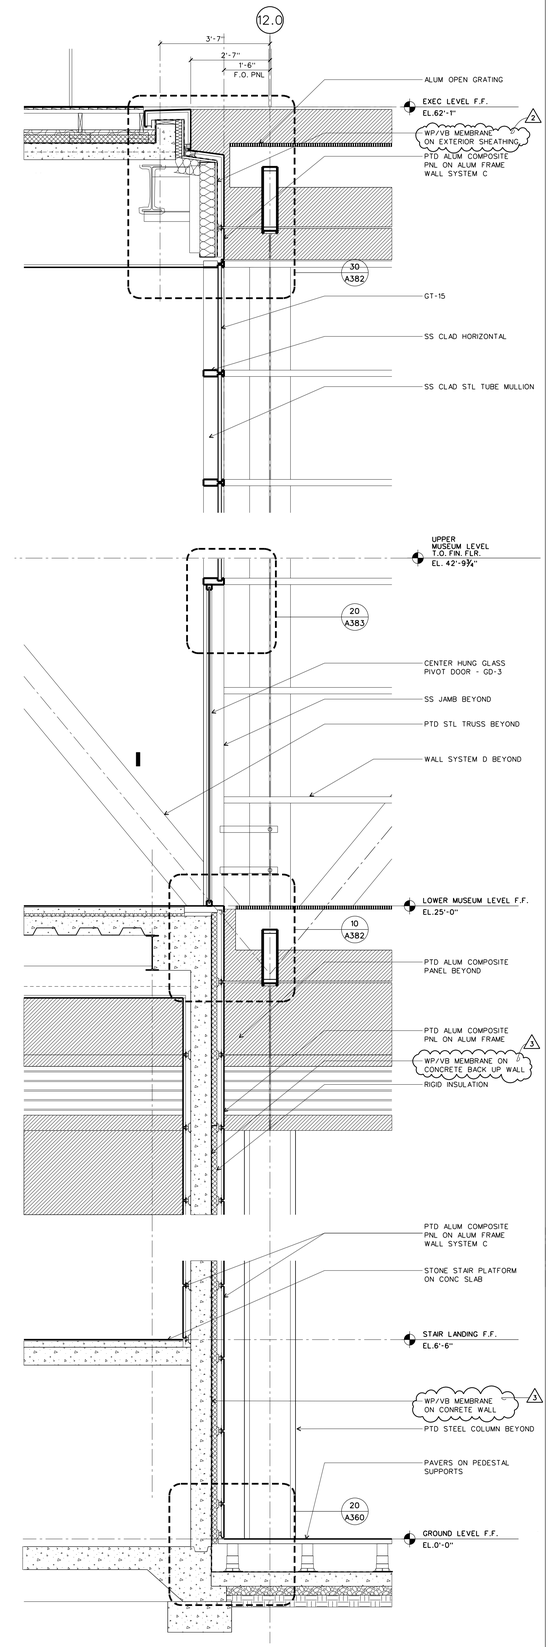

WALL SYSTEM K: WALL SECTION AT ESCALATOR

SCALE: ½" = 1'-0"

DETAILS/DTL-CWK2 10

WILLIAM J. CLINTON PRESIDENTIAL CENTER

LITTLE ROCK, ARKANSAS

Architect

POLSHEK PARTNERSHIP LLP
320 West 13th Street
New York, New York 10014
212.807.7171

Coordinating Architects

POLK STANLEY YEARY ARCHITECTS Ltd
700 South Schiller Street
Little Rock, Arkansas 72201
501.378.0878

WITSELL EVANS RASCO
901 West Third Street
Little Rock, Arkansas 72201
501.374.5300

WOODS CARADINE ARCHITECTS
2200 South Main Street
Little Rock, Arkansas 72206
501.374.4060

Landscape Architects

HARGREAVES ASSOCIATES
118 Magazine Street
Cambridge, Massachusettes 02139
617.661.0070

LANDSCAPE ARCHITECTURE, Inc.
2300 Cottondale Lane Suite 202
Little Rock, Arkansas 72202
501.374.5610

Structural Engineer

LESLIE E. ROBERTSON ASSOC., RLLP
30 Broad Street, 47th Floor
New York, New York 10004
212.750.9000

MEP Engineers

FLACK + KURTZ Inc.
475 Fifth Avenue
New York, New York 10017
212.532.9600

CROMWELL ARCHITECTS ENGINEERS
101 South Spring Street
Little Rock, Arkansas 72201
501.372.2900

Curtainwall Consultant

R. A. HEINTGES ARCHITECTS
126 Fifth Avenue, 9th Floor
New York, New York 10011
212.652-2966

Seal

3	ASI #22	08/01/03
2	Addendum #2	11/15/02
	100% Construction Documents	09/27/02
1	90% Progress Printing	08/30/02
	100% Struct./ CD Progress	07/01/02
	Bridge Bldg. Substructure	06/14/02
	100% Design Development	03/01/02
	Issue	Date

Job No. 9908

Scale 1/2" = 1'-0"

Date September 27, 2002


Title

WALL SYSTEM K: PLAN AND SECTIONS

Sheet No.

A347


FOR OFFICIAL USE ONLY

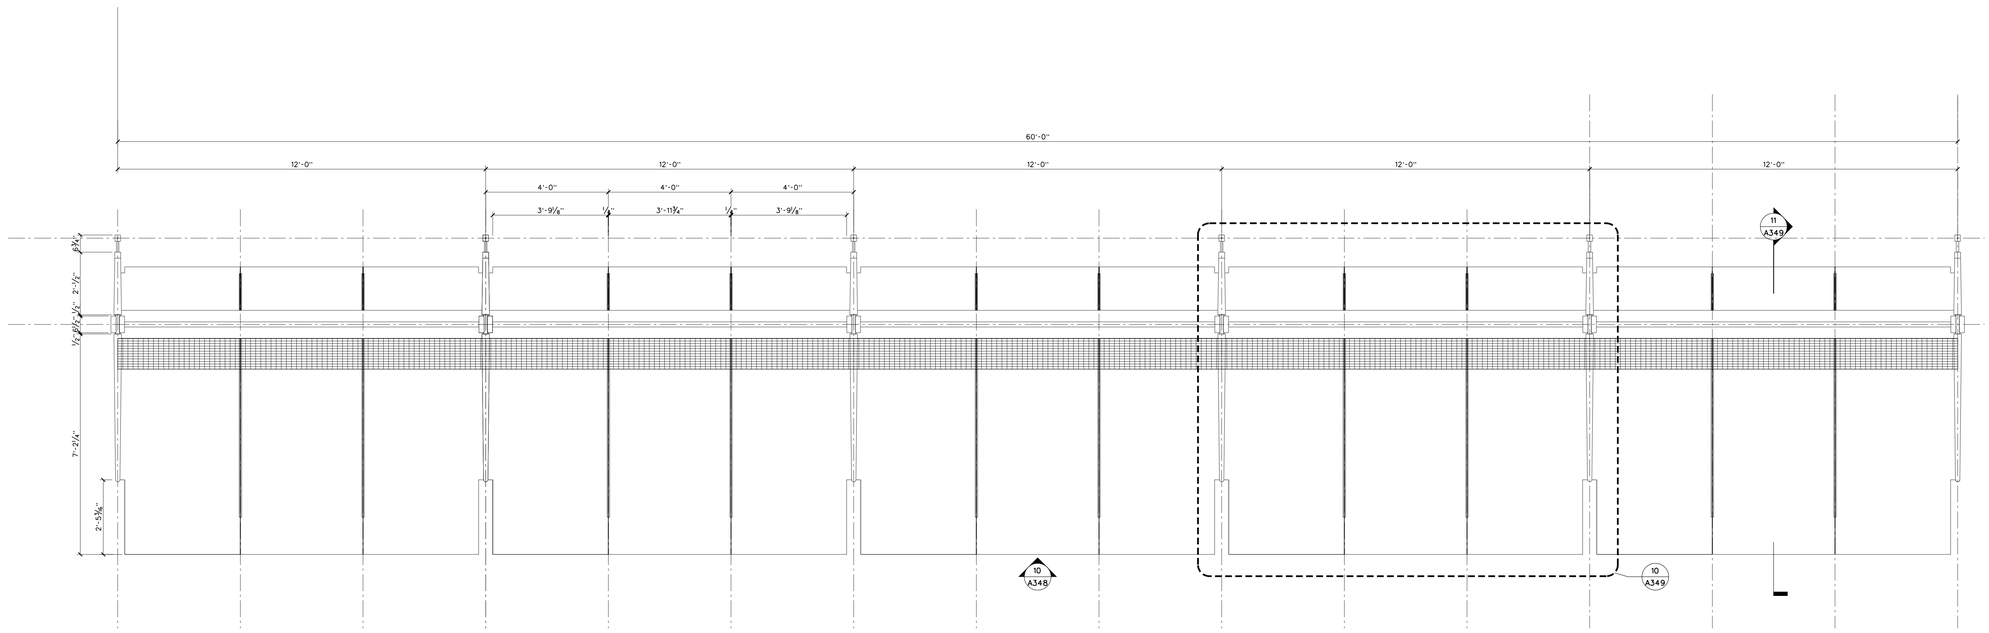

ENTRANCE CANOPY: PLAN

SCALE: ½" = 1'-0"

B-CANOPY-SECT 20

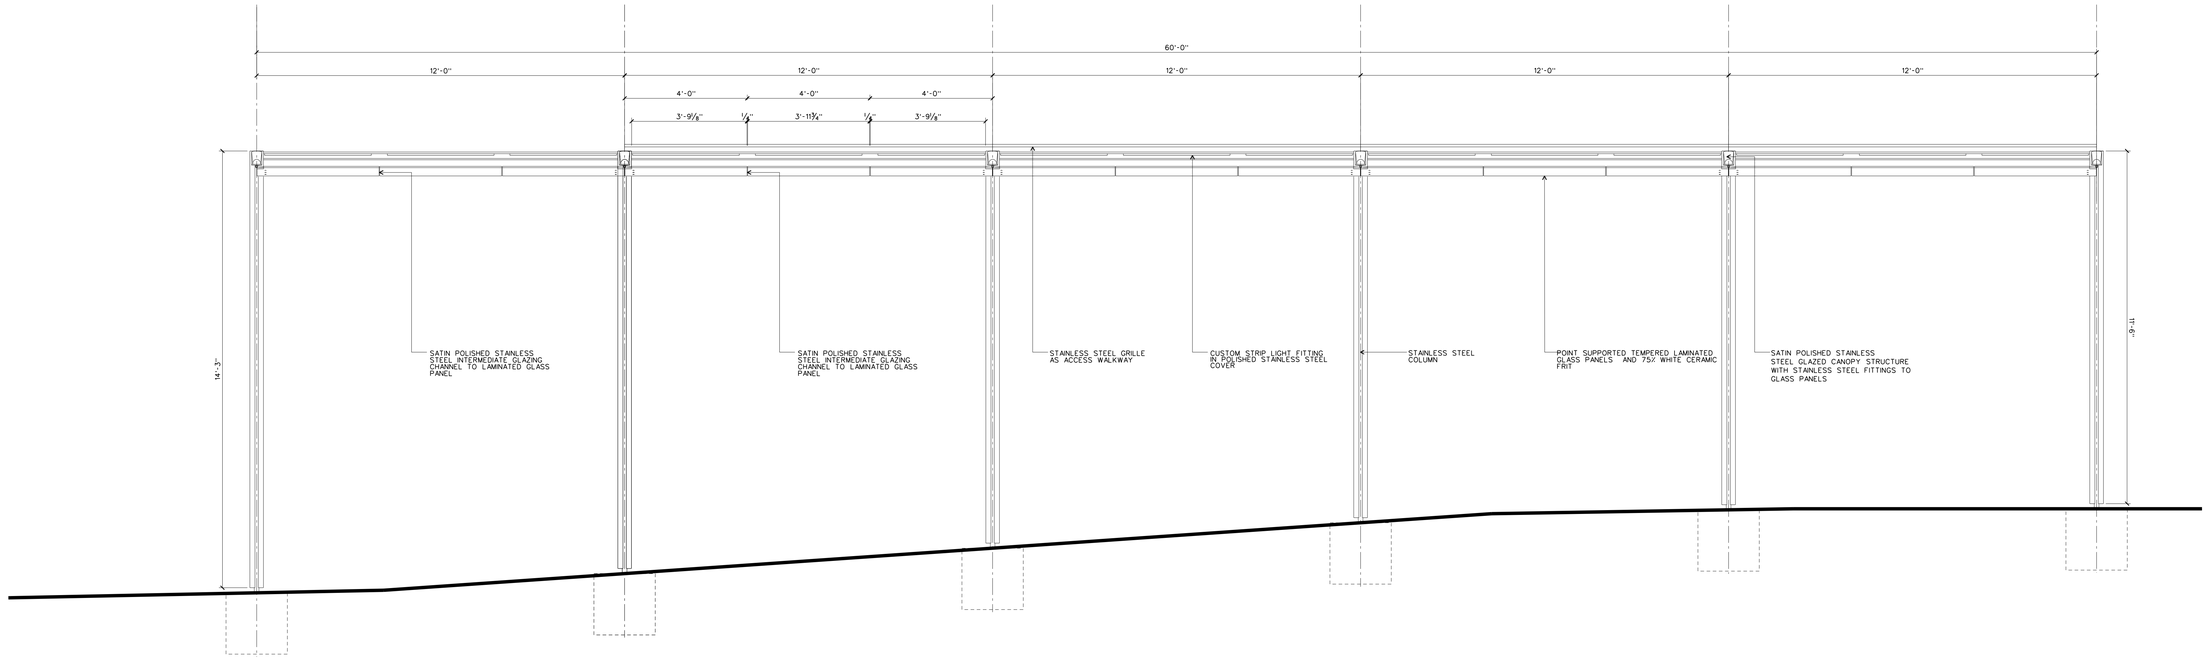

ENTRANCE CANOPY: SOUTH ELEVATION

SCALE: ½" = 1'-0"

B-CANOPY-SECT 10

WILLIAM J. CLINTON PRESIDENTIAL CENTER

LITTLE ROCK, ARKANSAS

Architect

POLSHEK PARTNERSHIP LLP
320 West 13th Street
New York, New York 10014
212.807.7171

Coordinating Architects

POLK STANLEY YEARY ARCHITECTS Ltd
700 South Schiller Street
Little Rock, Arkansas 72201
501.378.0878

WITSELL EVANS RASCO
901 West Third Street
Little Rock, Arkansas 72201
501.374.5300

WOODS CARADINE ARCHITECTS
2200 South Main Street
Little Rock, Arkansas 72206
501.374.4060

Landscape Architects

HARGREAVES ASSOCIATES
118 Magazine Street
Cambridge, Massachusettes 02139
617.661.0070

LANDSCAPE ARCHITECTURE, Inc.
2300 Cottondale Lane Suite 202
Little Rock, Arkansas 72202
501.374.5610

Structural Engineer

LESLIE E. ROBERTSON ASSOC., RLLP
30 Broad Street, 47th Floor
New York, New York 10004
212.750.9000

MEP Engineers

FLACK + KURTZ Inc.
475 Fifth Avenue
New York, New York 10017
212.532.9600


CROMWELL ARCHITECTS ENGINEERS
101 South Spring Street
Little Rock, Arkansas 72201
501.372.2900

Curtainwall Consultant

R. A. HEINTGES ARCHITECTS
126 Fifth Avenue, 9th Floor
New York, New York 10011
212.652-2966

Seal

Issue	Date
100% Construction Documents	09/27/02
90% Progress Printing	08/30/02
100% Struct./ CD Progress	07/01/02
100% Design Development	03/01/02

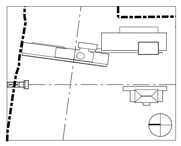

Job No. 9908

Scale 1/2" = 1'-0"

Date September 27, 2002


Title

ENTRANCE CANOPY; PLAN AND ELEVATION

Sheet No.

A348


FOR OFFICIAL USE ONLY

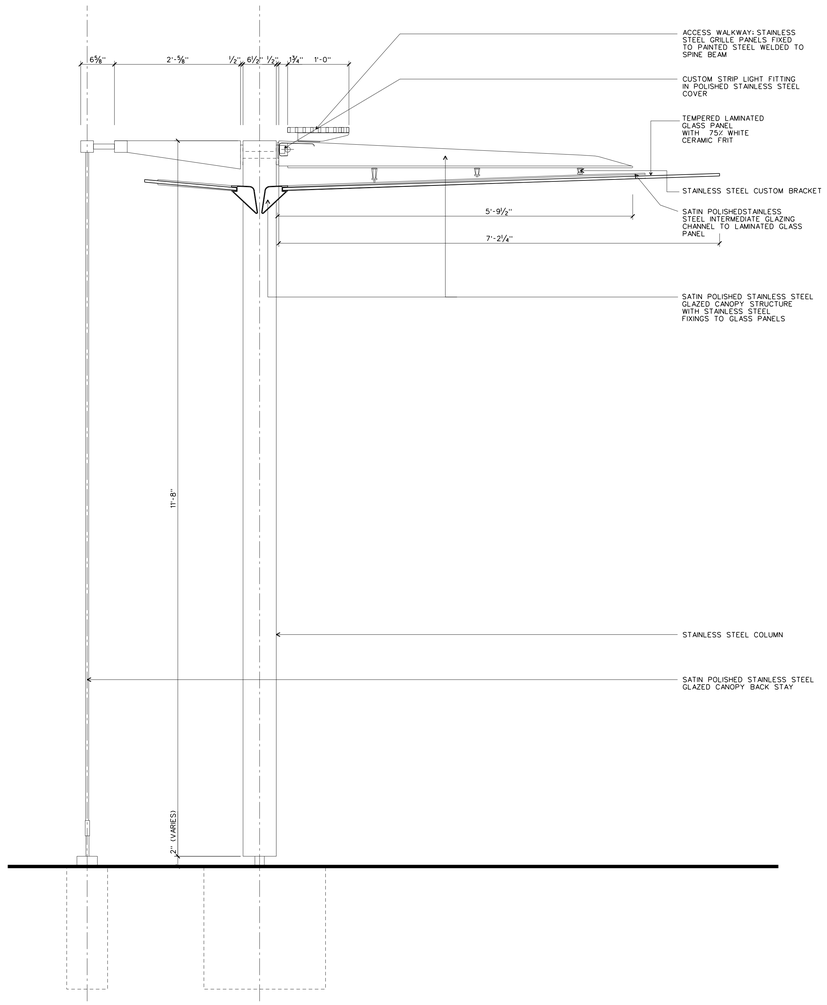

ENTRANCE CANOPY: TYPICAL SECTION

SCALE: 1" = 1'-0"

B-CANOPY-SECT 11

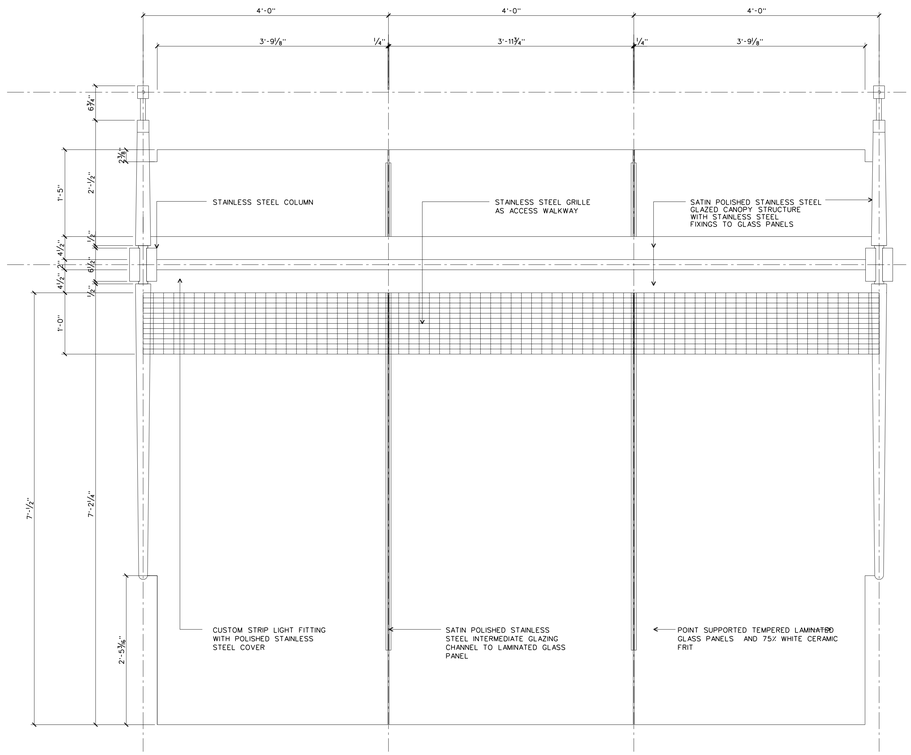

ENTRANCE CANOPY: TYPICAL CANOPY BAY PLAN

SCALE: 1" = 1'-0"

B-CANOPY-SECT 10

WILLIAM J. CLINTON PRESIDENTIAL CENTER

LITTLE ROCK, ARKANSAS

Architect

POLSHEK PARTNERSHIP LLP
320 West 13th Street
New York, New York 10014
212.807.7171

Coordinating Architects

POLK STANLEY YEARY ARCHITECTS Ltd
700 South Schiller Street
Little Rock, Arkansas 72201
501.378.0878

WITSELL EVANS RASCO
901 West Third Street
Little Rock, Arkansas 72201
501.374.5300

WOODS CARADINE ARCHITECTS
2200 South Main Street
Little Rock, Arkansas 72206
501.374.4060

Landscape Architects

HARGREAVES ASSOCIATES
118 Magazine Street
Cambridge, Massachusettes 02139
617.661.0070

LANDSCAPE ARCHITECTURE, Inc.
2300 Cottondale Lane Suite 202
Little Rock, Arkansas 72202
501.374.5610

Structural Engineer

LESLIE E. ROBERTSON ASSOC., RLLP
30 Broad Street, 47th Floor
New York, New York 10004
212.750.9000

MEP Engineers

FLACK + KURTZ Inc.
475 Fifth Avenue
New York, New York 10017
212.532.9600


CROMWELL ARCHITECTS ENGINEERS
101 South Spring Street
Little Rock, Arkansas 72201
501.372.2900

Curtainwall Consultant

R. A. HEINTGES ARCHITECTS
126 Fifth Avenue, 9th Floor
New York, New York 10011
212.652-2966

Seal

Issue	Date
100% Construction Documents	09/27/02
90% Progress Printing	08/30/02
100% Struct./ CD Progress	07/01/02
100% Design Development	03/01/02

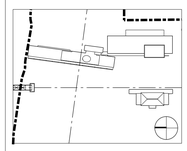

Job No.
9908


Scale
1" = 1'-0"

Date
September 27, 2002

Title
ENTRANCE CANOPY: SECTION


Sheet No.
A349

FOR OFFICIAL USE ONLY

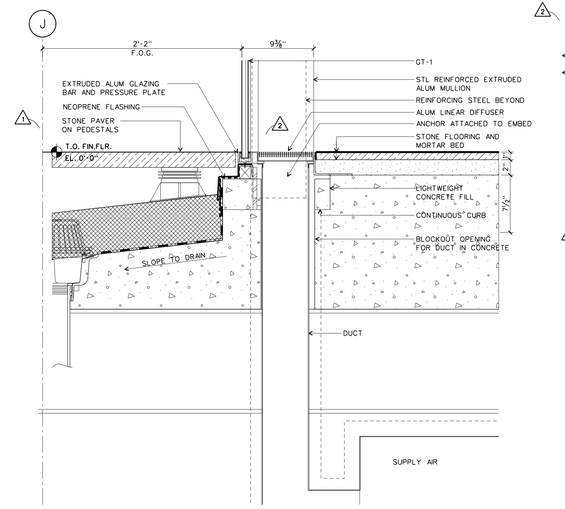


WALL SYSTEM A1: BASE SECT DETAIL AT LOBBY

SCALE: 1½" = 1'-0" D-CWA01 **33**

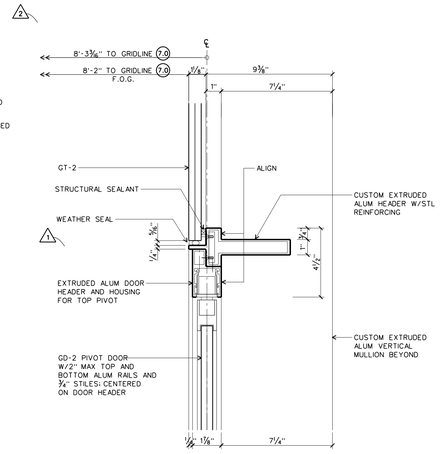


WALL SYSTEM A1: DETAIL SECTION OF CAFE DOOR HEADER

SCALE: 3" = 1'-0" D-CWA01 **32**

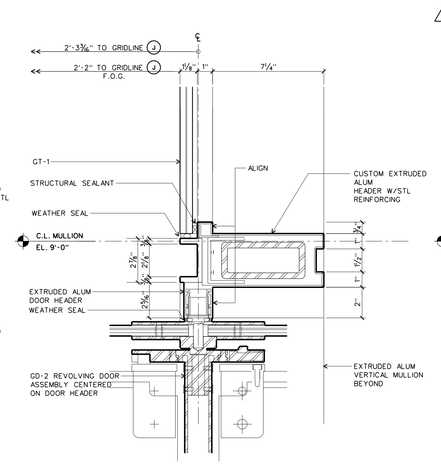


WALL SYSTEM A1: DETAIL SECTION AT LOBBY REVOLVING DOOR HEADER

SCALE: 3" = 1'-0" D-CWA01 **31A**

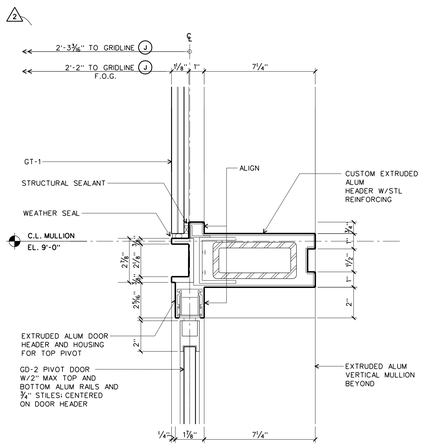


WALL SYSTEM A1: DETAIL SECTION AT LOBBY PIVOT DOOR HEADER

SCALE: 3" = 1'-0" D-CWA01 **31**

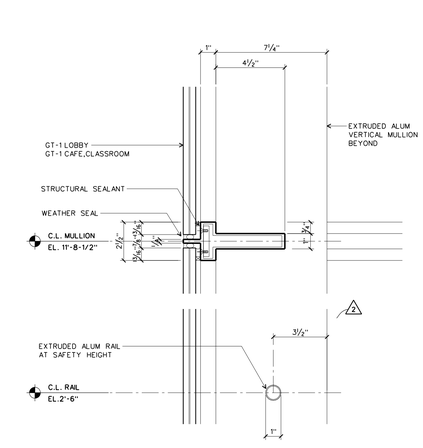


WALL SYSTEM A1: DETAIL SECTION OF HORIZONTAL

SCALE: 3" = 1'-0" D-CWA01 **30**

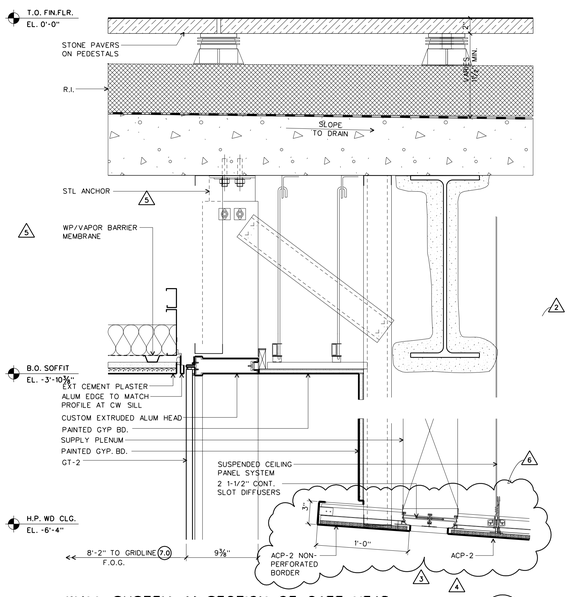


WALL SYSTEM A1: SECTION OF CAFE HEAD

SCALE: 1-1/2" = 1'-0" D-CWA01 **23**

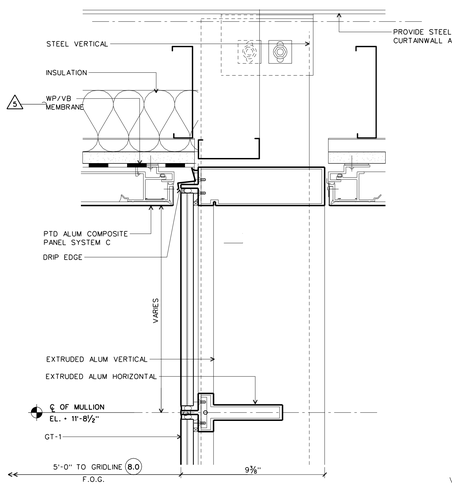


WALL SYSTEM A1: DETAIL SECTION AT SLOPED UNDERSIDE OF BELLY

SCALE: 3" = 1'-0" D-CWA01 **22**

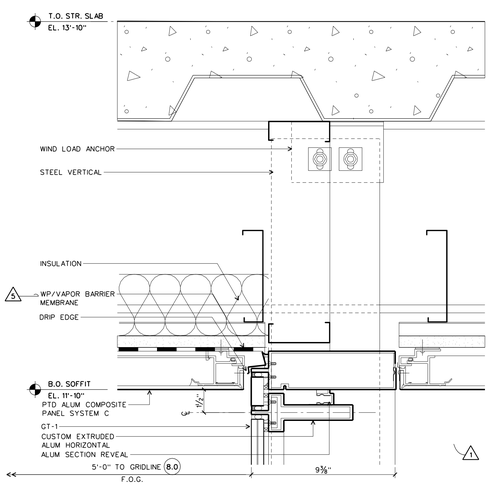


WALL SYSTEM A1: DETAIL SECTION OF HORIZONTAL MULLION UNDER BELLY

SCALE: 3" = 1'-0" D-CWA01 **21**

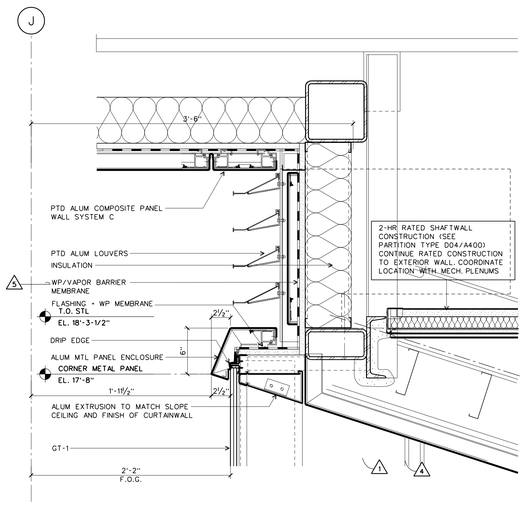


WALL SYSTEM A1: TYP HEAD SECTION DETAIL

SCALE: 1-1/2" = 1'-0" D-CWA01 **20**

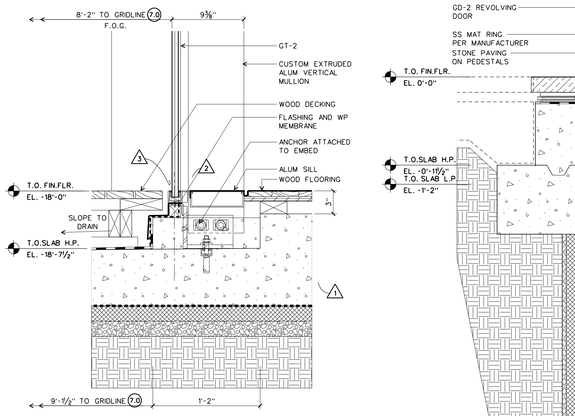


WALL SYSTEM A1: BASE DETAIL AT CAFE

SCALE: 1-1/2" = 1'-0" D-CWA01 **12**

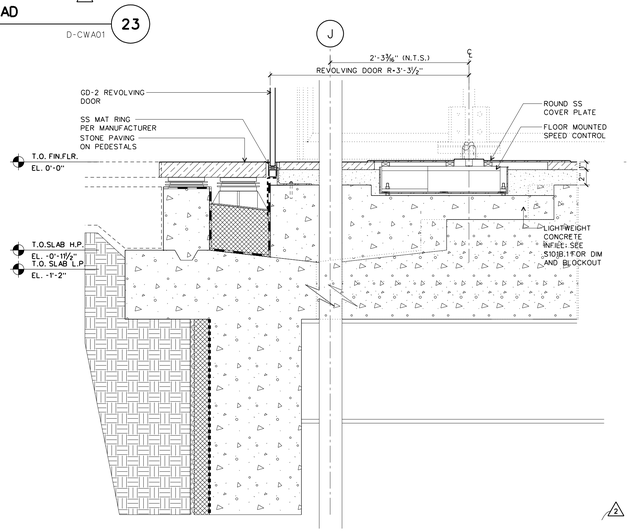


WALL SYSTEM A1: BASE DETAIL AT LOBBY REVOLVING DOOR

SCALE: 1-1/2" = 1'-0" D-CWA01 **11A**

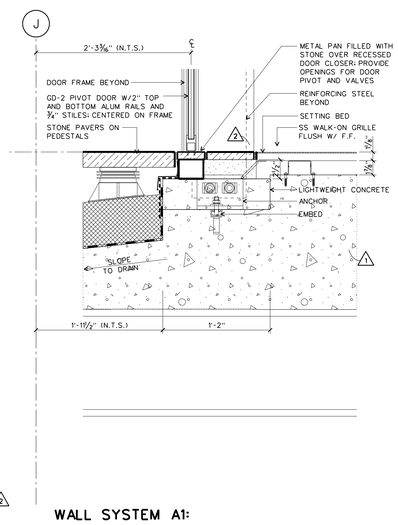

WALL SYSTEM A1: BASE DETAIL AT LOBBY PIVOT DOOR

SCALE: 1-1/2" = 1'-0" D-CWA01 **11**

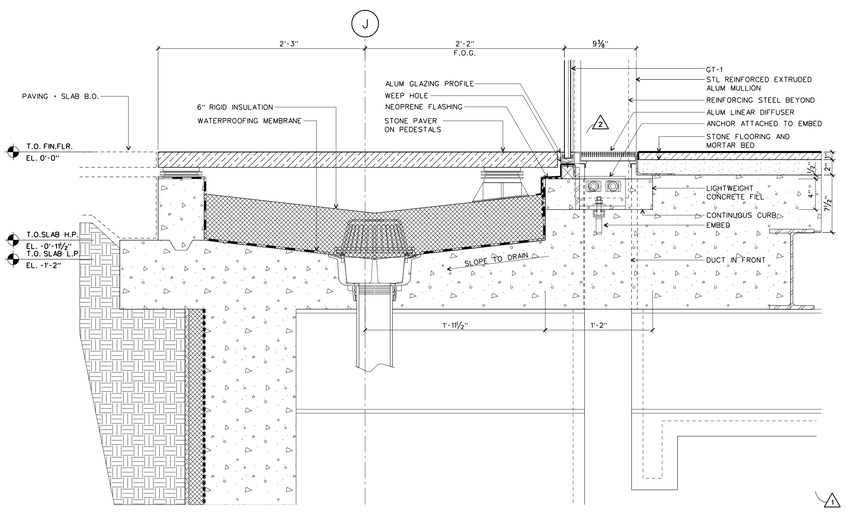

WALL SYSTEM A1: BASE SECT DETAIL AT LOBBY, TYP

SCALE: 1-1/2" = 1'-0" D-CWA01 **10**

WILLIAM J. CLINTON PRESIDENTIAL CENTER

LITTLE ROCK, ARKANSAS

Architect

POLSHEK PARTNERSHIP LLP
320 West 13th Street
New York, New York 10014
212.807.7171

Coordinating Architects

POLK STANLEY YEARY ARCHITECTS Ltd
700 South Schiller Street
Little Rock, Arkansas 72201
501.378.0878

WITSELL EVANS RASCO
901 West Third Street
Little Rock, Arkansas 72201
501.374.5300

WOODS CARADINE ARCHITECTS
2200 South Main Street
Little Rock, Arkansas 72206
501.374.4060

Landscape Architects

HARGREAVES ASSOCIATES
118 Magazine Street
Cambridge, Massachusettes 02139
617.661.0070

LANDSCAPE ARCHITECTURE, Inc.
2300 Cottondale Lane Suite 202
Little Rock, Arkansas 72202
501.374.5610

Structural Engineer

LESLIE E. ROBERTSON ASSOC., RLLP
30 Broad Street, 47th Floor
New York, New York 10004
212.750.9000

MEP Engineers

FLACK + KURTZ Inc.
475 Fifth Avenue
New York, New York 10017
212.532.9600

CROMWELL ARCHITECTS ENGINEERS
101 South Spring Street
Little Rock, Arkansas 72201
501.372.2900

Curtainwall Consultant

R. A. HEINTGES ARCHITECTS
126 Fifth Avenue, 9th Floor
New York, New York 10011
212.652-2966

Seal

Issue	Date
5 ASI #23	09/12/03
4 ASI #22	08/01/03
3 ASI #18	04/18/03
2 Addendum #2	11/15/02
1 100% Construction Documents	09/27/02
90% Progress Printing	08/30/02
100% Struct./ CD Progress	07/01/02
Bridge Bldg. Substructure	06/14/02
100% Design Development	03/01/02

Job No. 9908

Scale AS NOTED

Date September 27, 2002


Title

WALL SYSTEMS A1: SECTION DETAILS

Sheet No.


A355

FOR OFFICIAL USE ONLY

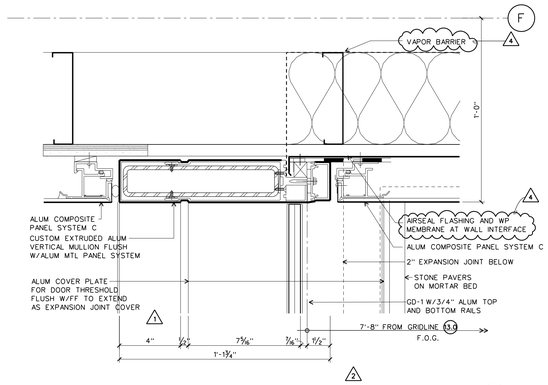


WALL SYSTEM A2: END MULLION AT SOUTH LOBBY

SCALE: 3 " = 1'-0" D-CWA02 **43**

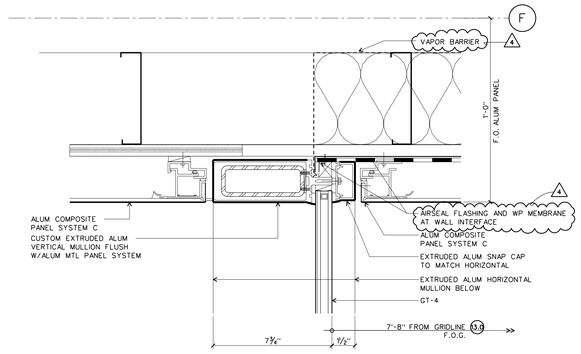


WALL SYSTEM A2: VERTICAL AT UPPER LEVELS

SCALE: 3 " = 1'-0" D-CWA02 **42**

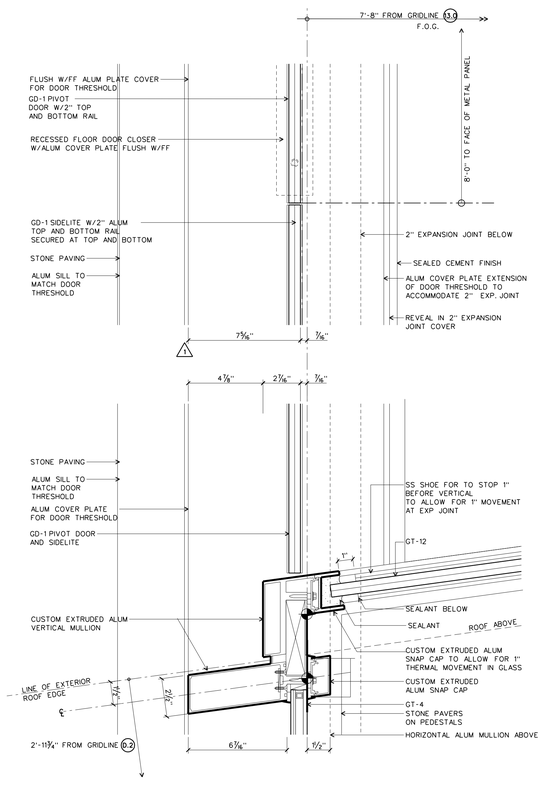


WALL SYSTEM A2: DETAIL PLAN AT EXPANSION JOINT

SCALE: 3" = 1'-0" D-CWA02 **23**

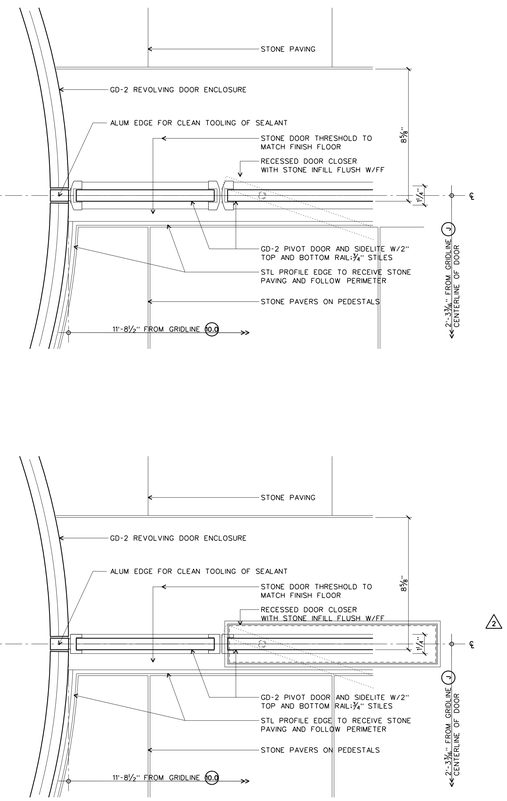


WALL SYSTEM A1: DETAIL PLAN AT REVOLVING DOOR

SCALE: 3 " = 1'-0" D-CWA02 **22**

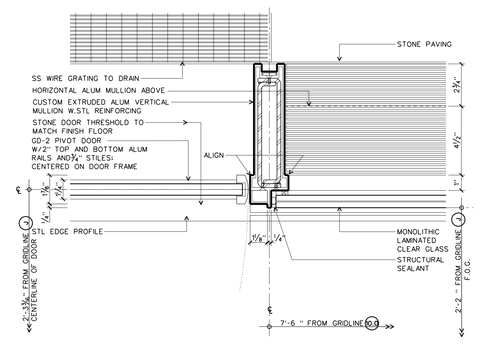

WALL SYSTEM A1: DETAIL PLAN AT LOBBY DOOR

SCALE: 3 " = 1'-0" D-CWA02 **21**

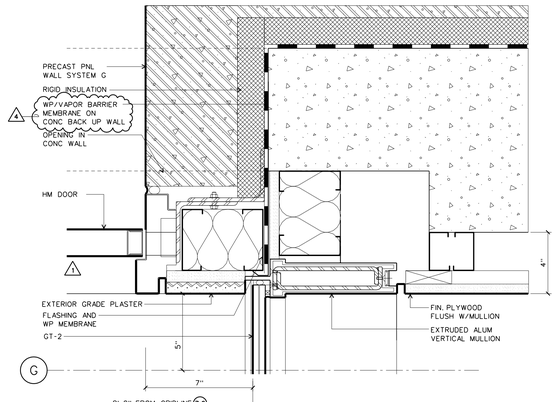

WALL SYSTEM A1: PLAN DETAIL CAFE END MULLION


SCALE: 3 " = 1'-0" D-CWA02 **30**

WALL SYSTEM A2: DETAIL PLAN VERTICAL MULLION

SCALE: 3" = 1'-0" D-CWA02 **13**


WALL SYSTEM A1: DETAIL PLAN AT REVOLVING DOOR

SCALE: 3 " = 1'-0" D-CWA02 **22**

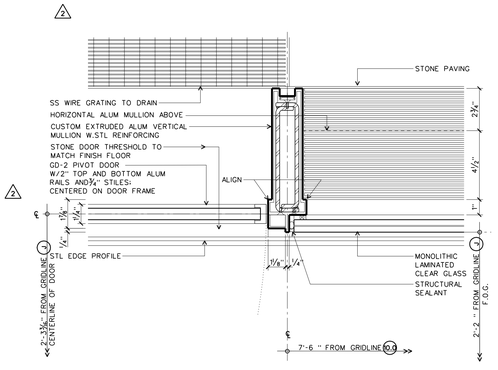


WALL SYSTEM A1: DETAIL PLAN AT LOBBY DOOR

SCALE: 3 " = 1'-0" D-CWA02 **21**

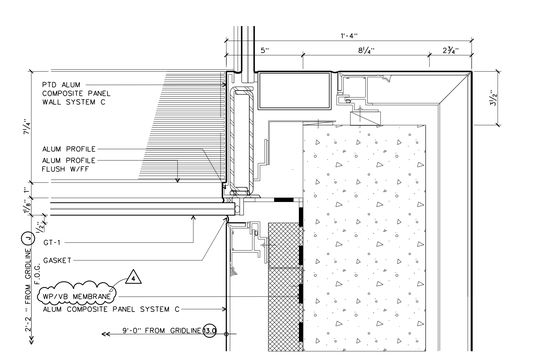


WALL SYSTEM A1: DETAIL PLAN AT ESCALATOR WALL

SCALE: 3 " = 1'-0" D-CWA02 **20**

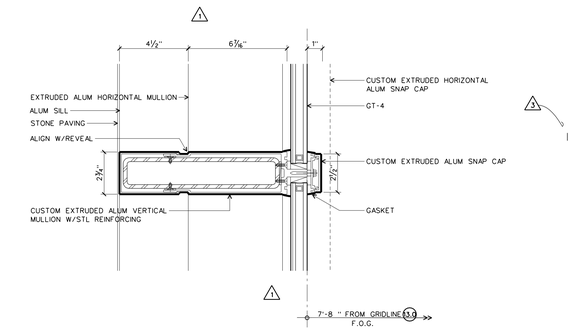


WALL SYSTEM A2: DETAIL PLAN VERTICAL MULLION

SCALE: 3" = 1'-0" D-CWA02 **13**

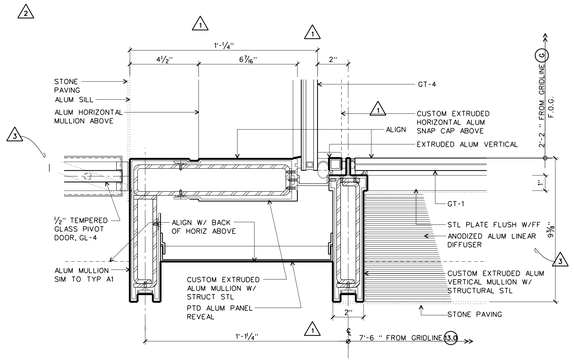


WALL SYSTEM A1/A2 : INTERFACE AT GIFTSHOP

SCALE: 3 " = 1'-0" D-CWA02 **12**

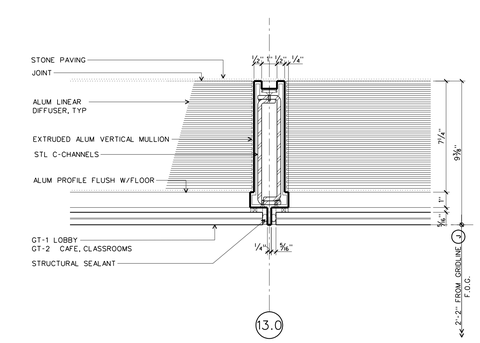

WALL SYSTEM A1: PLAN DETAIL MULLION, TYP

SCALE: 3" = 1'-0" D-CWA02 **11**

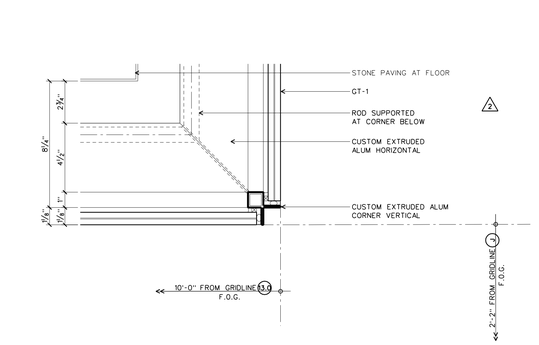

WALL SYSTEM A1: DETAIL PLAN CORNER, TYP

SCALE: 3" = 1'-0" D-CWA02 **10**

WILLIAM J. CLINTON PRESIDENTIAL CENTER

LITTLE ROCK, ARKANSAS

Architect

POLSHEK PARTNERSHIP LLP
320 West 13th Street
New York, New York 10014
212.807.7171

Coordinating Architects

POLK STANLEY YEARY ARCHITECTS Ltd
700 South Schiller Street
Little Rock, Arkansas 72201
501.378.0878

WITSELL EVANS RASCO
901 West Third Street
Little Rock, Arkansas 72201
501.374.5300

WOODS CARADINE ARCHITECTS
2200 South Main Street
Little Rock, Arkansas 72206
501.374.4060

Landscape Architects

HARGREAVES ASSOCIATES
118 Magazine Street
Cambridge, Massachusettes 02139
617.661.0070

LANDSCAPE ARCHITECTURE, Inc.
2300 Cottondale Lane Suite 202
Little Rock, Arkansas 72202
501.374.5610

Structural Engineer

LESLIE E. ROBERTSON ASSOC., RLLP
30 Broad Street, 47th Floor
New York, New York 10004
212.750.9000

MEP Engineers

FLACK + KURTZ Inc.
475 Fifth Avenue
New York, New York 10017
212.532.9600

CROMWELL ARCHITECTS ENGINEERS
101 South Spring Street
Little Rock, Arkansas 72201
501.372.2900

Curtainwall Consultant

R. A. HEINTGES ARCHITECTS
126 Fifth Avenue, 9th Floor
New York, New York 10011
212.652-2966

Seal

Issue	Date
1 ASI #22	08/01/03
1 ASI #20	06/06/03
2 100% Construction Documents	09/27/02
1 90% Progress Printing	08/30/02
100% Struct./ CD Progress	07/01/02
Bridge Bldg. Substructure	06/14/02
100% Design Development	03/01/02

Job No. 9908

Scale 3" = 1'-0"

Date September 27, 2002


Title

WALL SYSTEM A1 AND SYSTEM A2: PLAN DETAILS

Sheet No.


A356

FOR OFFICIAL USE ONLY

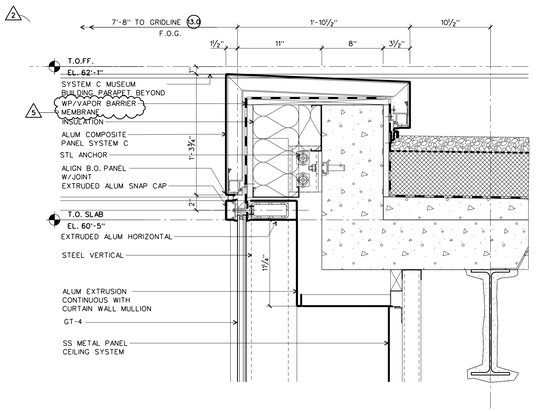


WALL SYSTEM A2: DETAIL SECTION AT SOUTH PARAPET 33

SCALE: 1-1/2 " = 1'-0" D-CWA03.3

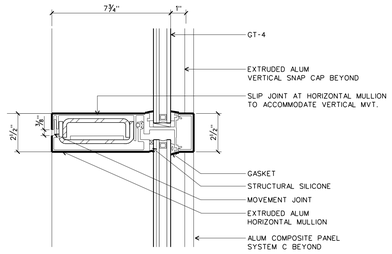


WALL SYSTEM A2: DETAIL AT STACK JOINT 40

SCALE: 3 " = 1'-0" D-CWA03.3

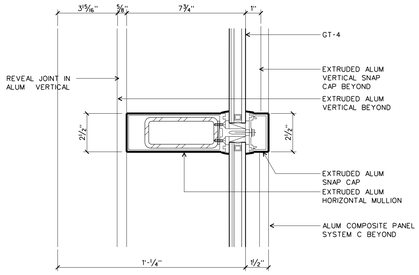


WALL SYSTEM A2: DETAIL AT HORIZONTAL 30

SCALE: 3 " = 1'-0" D-CWA03.3

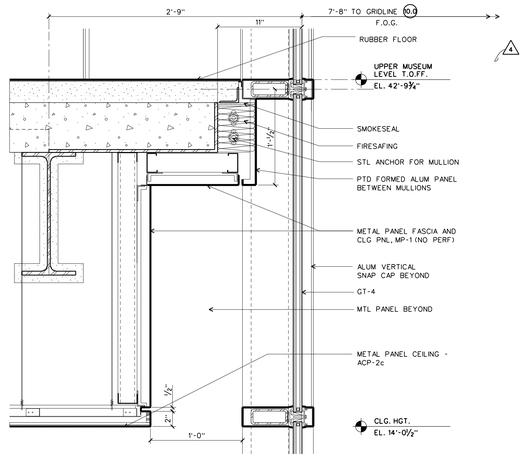


WALL SYSTEM A2: DETAIL SECTION AT UPPER MUSEUM 31

SCALE: 3 " = 1'-0" D-CWA03.3

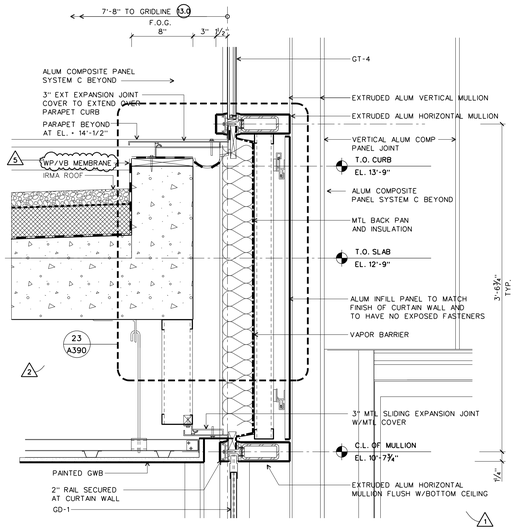


WALL SYSTEM A2: DETAIL SECTION AT SOUTH NECK 22

SCALE: 1-1/2 " = 1'-0" D-CWA03.3

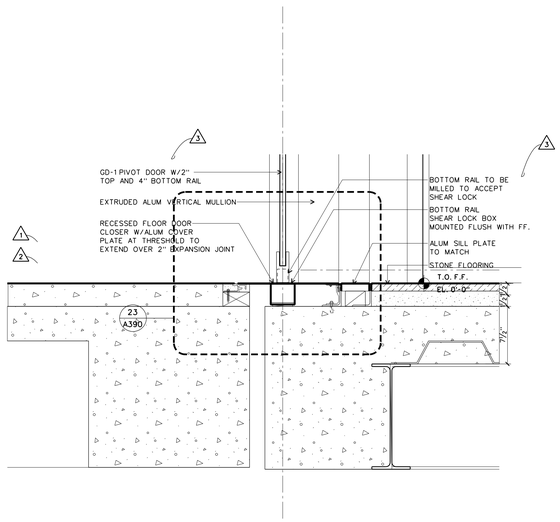


WALL SYSTEM A2: DETAIL SECTION AT SOUTH DOORS AND EXPANSION JOINT 12

SCALE: 1-1/2 " = 1'-0" D-CWA03.3

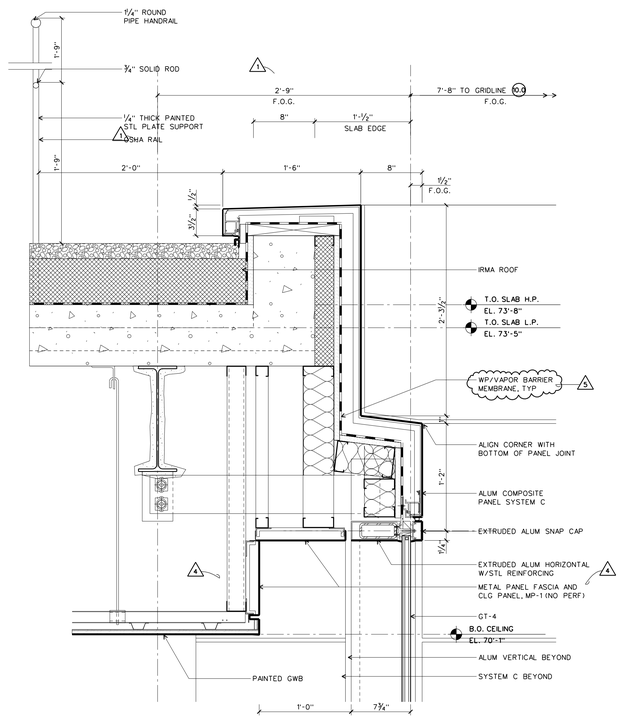


WALL SYSTEM A2: DETAIL SECTION OF PARAPET, TYP 21

SCALE: 1-1/2 " = 1'-0" D-CWA03.3

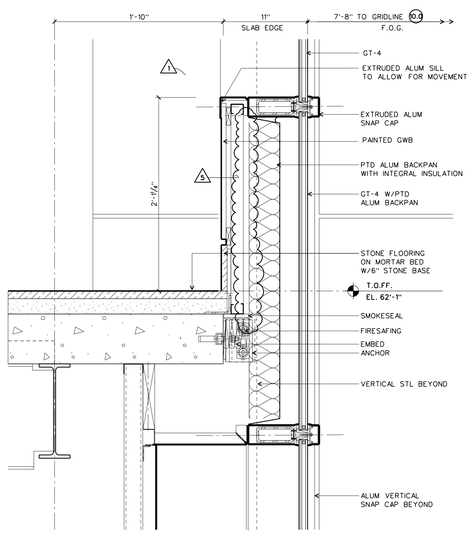


WALL SYSTEM A2: DETAIL SECTION AT EXEC LEVEL 11

SCALE: 1-1/2 " = 1'-0" D-CWA03.3

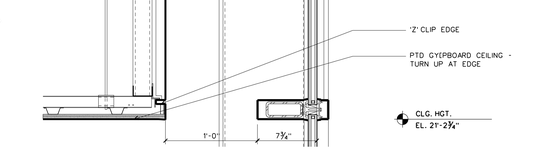

WALL SYSTEM A2: DETAIL SECTION AT LOWER MUSEUM 20

SCALE: 1-1/2 " = 1'-0" D-CWA03.3

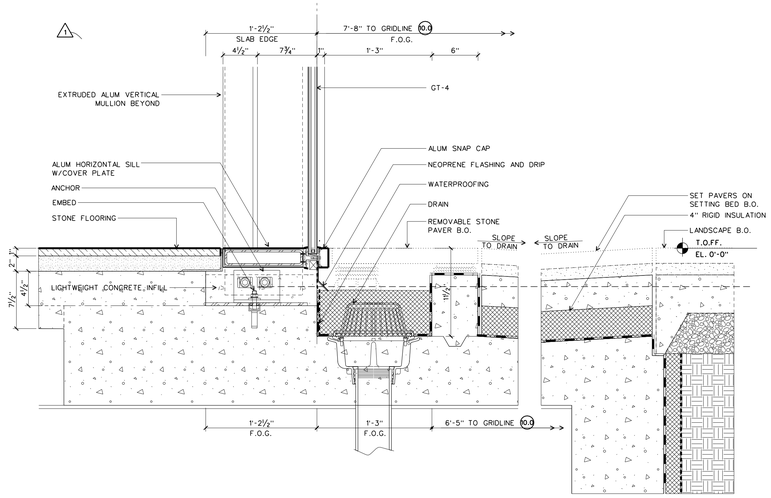

WALL SYSTEM A2: DETAIL SECTION AT GROUND FLOOR 10

SCALE: 1-1/2 " = 1'-0" D-CWA03.3

WILLIAM J. CLINTON PRESIDENTIAL CENTER

LITTLE ROCK, ARKANSAS

Architect

POLSHEK PARTNERSHIP LLP
320 West 13th Street
New York, New York 10014
212.807.7171

Coordinating Architects

POLK STANLEY YEARY ARCHITECTS Ltd
700 South Schiller Street
Little Rock, Arkansas 72201
501.378.0878

WITSELL EVANS RASCO
901 West Third Street
Little Rock, Arkansas 72201
501.374.5300

WOODS CARADINE ARCHITECTS
2200 South Main Street
Little Rock, Arkansas 72206
501.374.4060

Landscape Architects

HARGREAVES ASSOCIATES
118 Magazine Street
Cambridge, Massachusettes 02139
617.661.0070

LANDSCAPE ARCHITECTURE, Inc.
2300 Cottondale Lane Suite 202
Little Rock, Arkansas 72202
501.374.5610

Structural Engineer

LESLIE E. ROBERTSON ASSOC., RLLP
30 Broad Street, 47th Floor
New York, New York 10004
212.750.9000

MEP Engineers

FLACK + KURTZ Inc.
475 Fifth Avenue
New York, New York 10017
212.532.9600


CROMWELL ARCHITECTS ENGINEERS
101 South Spring Street
Little Rock, Arkansas 72201
501.372.2900

Curtainwall Consultant

R. A. HEINTGES ARCHITECTS
126 Fifth Avenue, 9th Floor
New York, New York 10011
212.652-2966

Seal

5	ASI #22	08/01/03
4	ASI #20	06/06/03
3	Addendum #2	11/15/02
2	100% Construction Documents	09/27/02
1	90% Progress Printing	08/30/02
	100% Struct./ CD Progress	07/01/02
	Bridge Bldg. Substructure	06/14/02
	100% Design Development	03/01/02
	Issue	Date

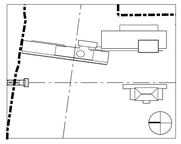

Job No. 9908

Scale AS NOTED

Date September 27, 2002


Title

WALL SYSTEMS A2 SECTION DETAILS

Sheet No.


A357

FOR OFFICIAL USE ONLY

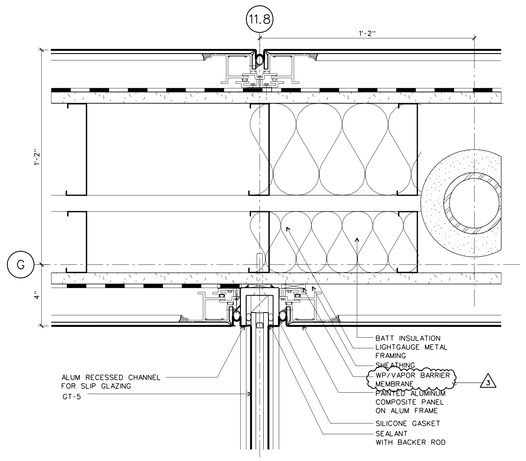


WALL SYSTEM A3: PLAN DETAIL AT END GLASS WALL 33

SCALE: 3" = 1'-0" D-CWA05

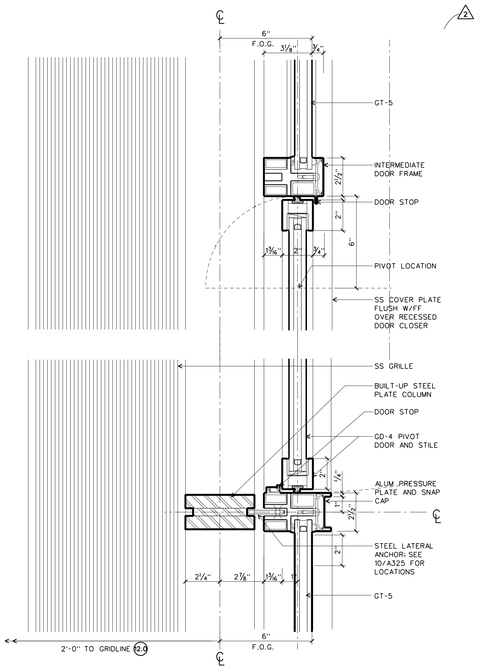


WALL SYSTEM A3:
PLAN DETAIL AT PIVOT DR AND SIDELITE 32


SCALE: 3" = 1'-0" D-CWA05

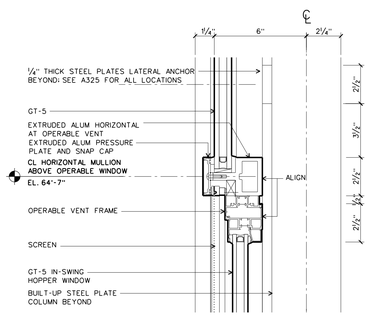

WALL SYSTEM A3: SECTION AT OPERABLE WINDOW 41


SCALE: 3" = 1'-0" D-CWA05

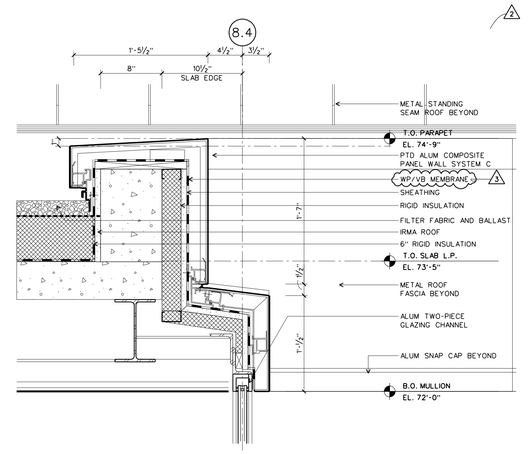

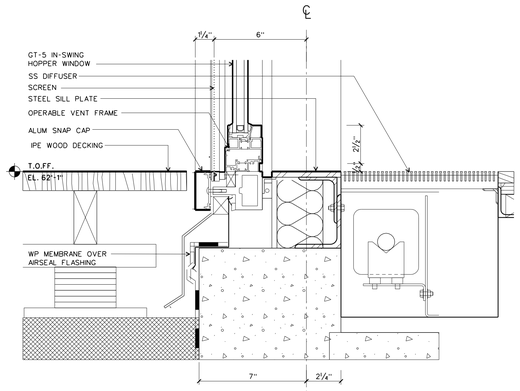


WALL SYSTEM A3: SECTION AT OPERABLE WINDOW 31

SCALE: 3" = 1'-0" D-CWA05

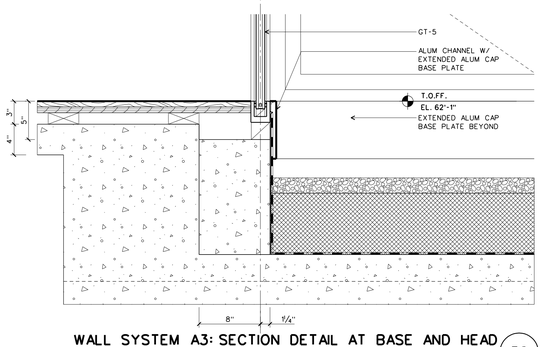


WALL SYSTEM A3: SECTION DETAIL AT BASE AND HEAD 30

SCALE: 1-1/2" = 1'-0" D-CWA04

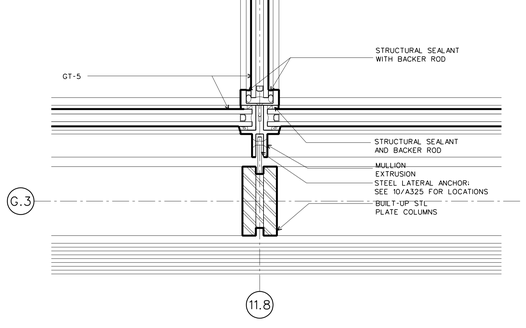


WALL SYSTEM A3: PLAN DETAIL AT END GLASS WALL 23

SCALE: 3" = 1'-0" D-CWA05

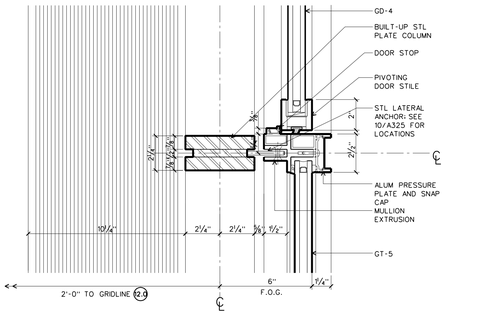


WALL SYSTEM A3: PLAN AT PIVOT DOOR 22

SCALE: 3" = 1'-0" D-CWA05

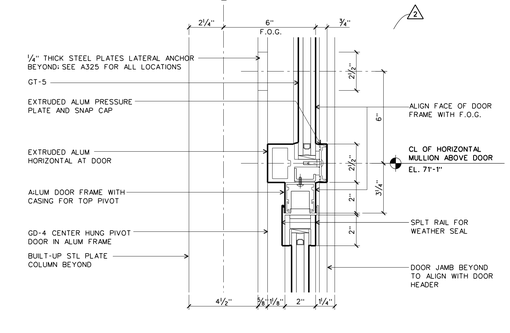


WALL SYSTEM A3: DETAIL AT PIVOT DOOR HEAD 21

SCALE: 3" = 1'-0" D-CWA04

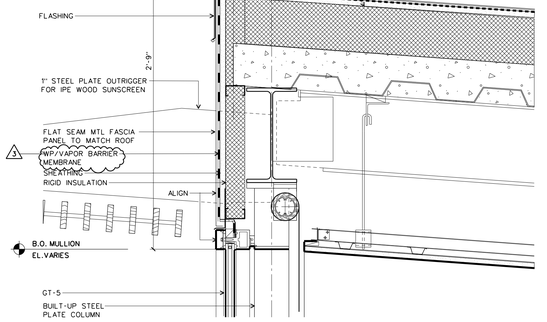


WALL SYSTEM A3: SECTION DETAIL AT HEAD TYP 20

SCALE: 1-1/2" = 1'-0" D-CWA04

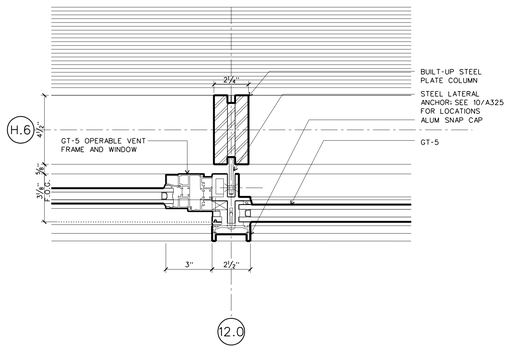


WALL SYSTEM A3: PLAN DETAIL TYP 13

SCALE: 3" = 1'-0" D-CWA05

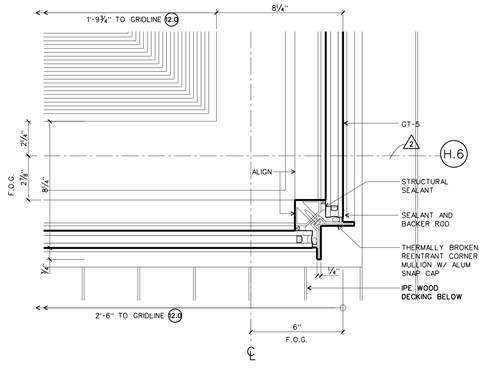


WALL SYSTEM A3: PLAN DETAIL AT TYP MULLION 12

SCALE: 3" = 1'-0" D-CWA05

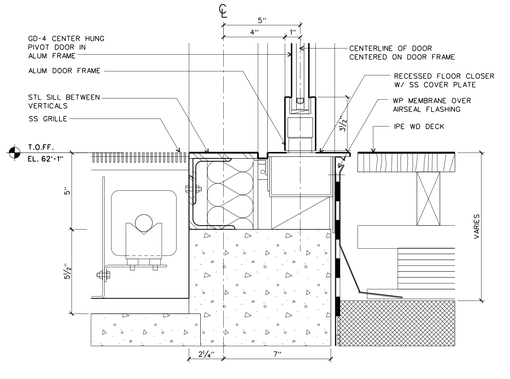

WALL SYSTEM A3: DETAIL AT PIVOT DOOR SILL 11

SCALE: 3" = 1'-0" D-CWA04

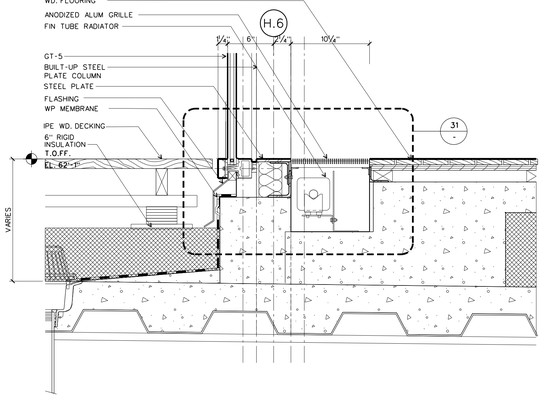

WALL SYSTEM A3: SECTION DETAIL AT TYP BASE 10

SCALE: 1-1/2" = 1'-0" D-CWA04

WILLIAM J. CLINTON PRESIDENTIAL CENTER

LITTLE ROCK, ARKANSAS

Architect

POLSHEK PARTNERSHIP LLP
320 West 13th Street
New York, New York 10014
212.807.7171

Coordinating Architects

POLK STANLEY YEARY ARCHITECTS Ltd
700 South Schiller Street
Little Rock, Arkansas 72201
501.378.0878

WITSELL EVANS RASCO
901 West Third Street
Little Rock, Arkansas 72201
501.374.5300

WOODS CARADINE ARCHITECTS
2200 South Main Street
Little Rock, Arkansas 72206
501.374.4060

Landscape Architects

HARGREAVES ASSOCIATES
118 Magazine Street
Cambridge, Massachusettes 02139
617.661.0070

LANDSCAPE ARCHITECTURE, Inc.
2300 Cottondale Lane Suite 202
Little Rock, Arkansas 72202
501.374.5610

Structural Engineer

LESLIE E. ROBERTSON ASSOC., RLLP
30 Broad Street, 47th Floor
New York, New York 10004
212.750.9000

MEP Engineers

FLACK + KURTZ Inc.
475 Fifth Avenue
New York, New York 10017
212.532.9600

CROMWELL ARCHITECTS ENGINEERS
101 South Spring Street
Little Rock, Arkansas 72201
501.372.2900

Curtainwall Consultant

R. A. HEINTGES ARCHITECTS
126 Fifth Avenue, 9th Floor
New York, New York 10011
212.652-2966

Seal

Issue	Date
3 ASI #22	08/01/03
2 ASI #20	06/06/03
1 100% Construction Documents	09/27/02
90% Progress Printing	08/30/02
100% Struct./ CD Progress	07/01/02
100% Design Development	03/01/02

Job No. 9908


Scale AS NOTED

Date September 27, 2002

Title
WALL SYSTEM A3:
SECTION AND
PLAN DETAILS

Sheet No.
A358

FOR OFFICIAL USE ONLY

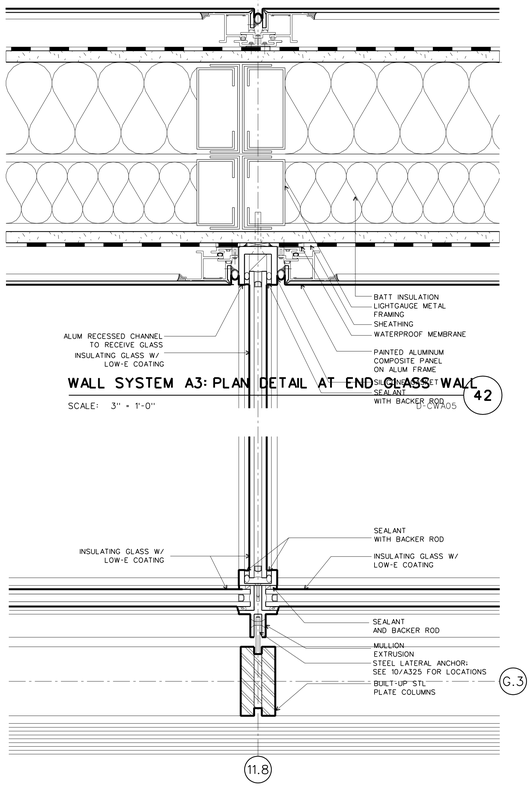

WALL SYSTEM A3: PLAN DETAIL AT END GLASS WALL 42


SCALE: 3" = 1'-0" D-CWA05

WALL SYSTEM A3: PLAN DETAIL AT END GLASS WALL 32

SCALE: 3" = 1'-0" D-CWA05


WALL SYSTEM A3: PLAN DETAIL AT SWING DOOR 31

SCALE: 3" = 1'-0" D-CWA05

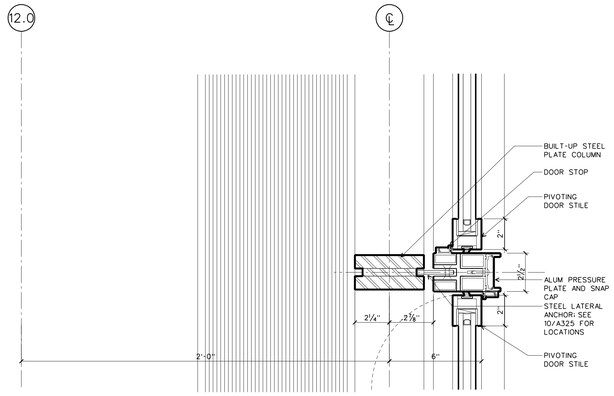


WALL SYSTEM A3: PLAN DETAIL AT PIVOT DOOR 30

SCALE: 3" = 1'-0" D-CWA05

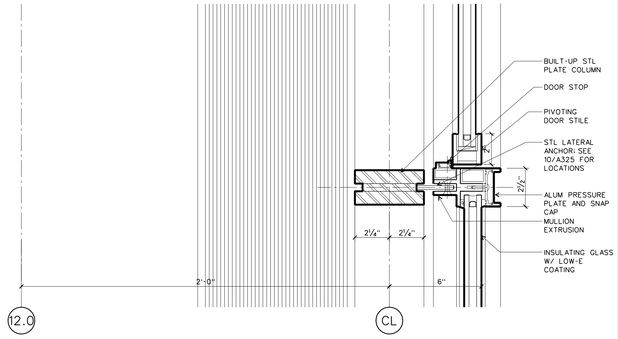


WALL SYSTEM A3: PLAN AT SWING DOOR 21

SCALE: 3" = 1'-0" D-CWA05

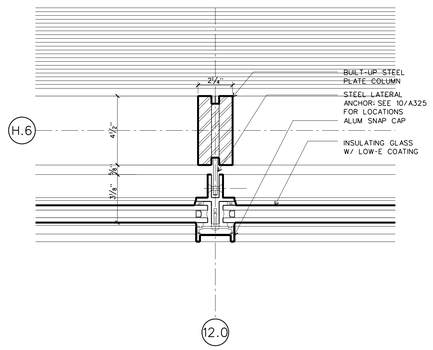

WALL SYSTEM A3: PLAN DETAIL AT PIVOT DOOR 20

SCALE: 3" = 1'-0" D-CWA05

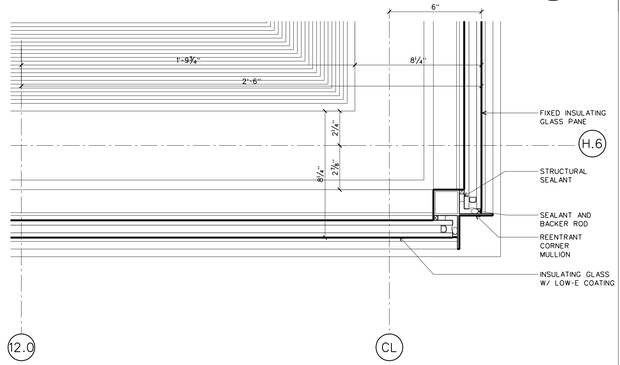

WALL SYSTEM A3: PLAN DETAIL AT TYP MULLION 11

SCALE: 3" = 1'-0" D-CWA05

WALL SYSTEM A3: PLAN DETAIL AT CORNER 10

SCALE: 3" = 1'-0" D-CWA05

WILLIAM J. CLINTON PRESIDENTIAL CENTER

LITTLE ROCK, ARKANSAS

Architect

POLSHEK PARTNERSHIP LLP
320 West 13th Street
New York, New York 10014
212.807.7171

Coordinating Architects

POLK STANLEY YEARY ARCHITECTS Ltd
700 South Schiller Street
Little Rock, Arkansas 72201
501.378.0878

WITSELL EVANS RASCO
901 West Third Street
Little Rock, Arkansas 72201
501.374.5300

WOODS CARADINE ARCHITECTS
2200 South Main Street
Little Rock, Arkansas 72206
501.374.4060

Landscape Architects

HARGREAVES ASSOCIATES
118 Magazine Street
Cambridge, Massachusettes 02139
617.661.0070

LANDSCAPE ARCHITECTURE, Inc.
2300 Cottondale Lane Suite 202
Little Rock, Arkansas 72202
501.374.5610

Structural Engineer

LESLIE E. ROBERTSON ASSOC., RLLP
30 Broad Street, 47th Floor
New York, New York 10004
212.750.9000

MEP Engineers

FLACK + KURTZ Inc.
475 Fifth Avenue
New York, New York 10017
212.532.9600


CROMWELL ARCHITECTS ENGINEERS
101 South Spring Street
Little Rock, Arkansas 72201
501.372.2900

Curtainwall Consultant

R. A. HEINTGES ARCHITECTS
126 Fifth Avenue, 9th Floor
New York, New York 10011
212.652-2966

Seal

Issue	Date
100% Construction Documents	09/27/02
90% Progress Printing	08/30/02
ASI #05	08/20/02
100% Struct./ CD Progress	07/01/02
Bridge Bldg. Substructure	06/14/02
100% Steel & Concrete CD & Architectural CD Progress	05/15/02
100% Design Development	03/01/02

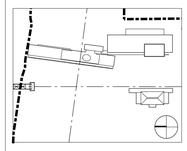

Job No. 9908

Scale 3" = 1'-0"

Date September 27, 2002


Title

WALL SYSTEM A3
DETAIL PLANS

Sheet No.

A359


FOR OFFICIAL USE ONLY

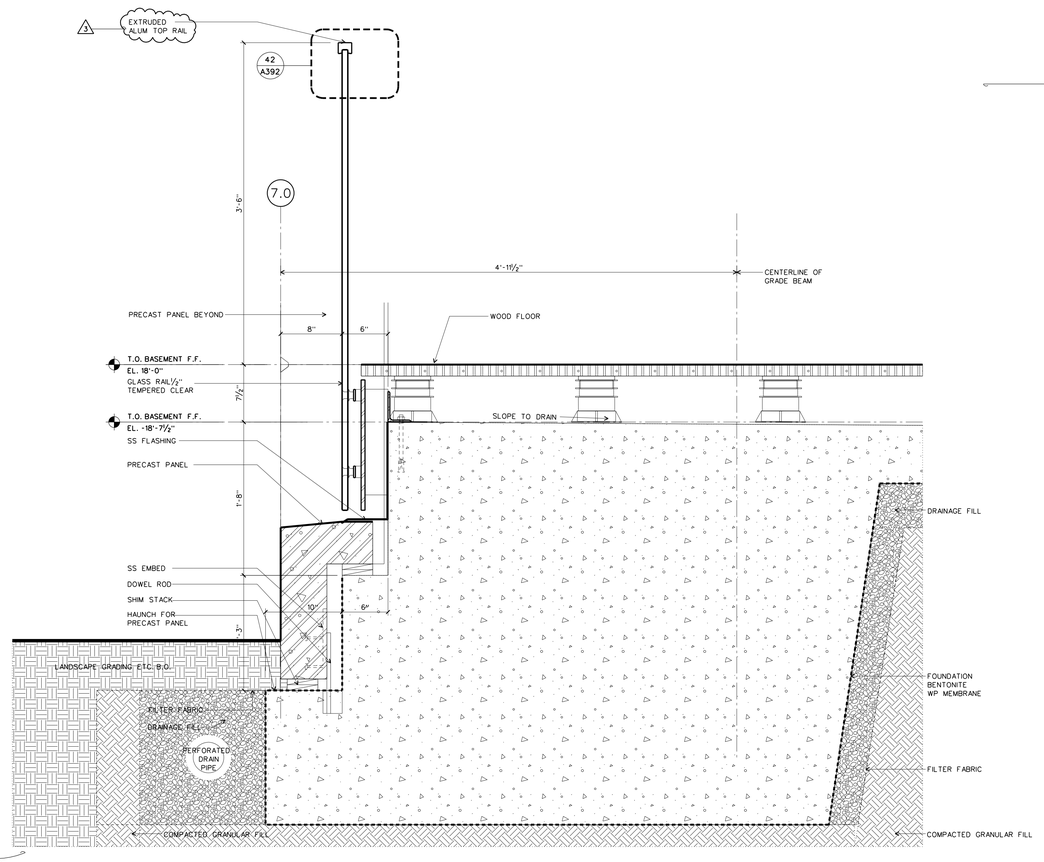

SECTION DETAIL AT CAFE TERRACE RAIL/PRECAST

SCALE: 1-1/2 " = 1'-0"


D-CWC01 **22**

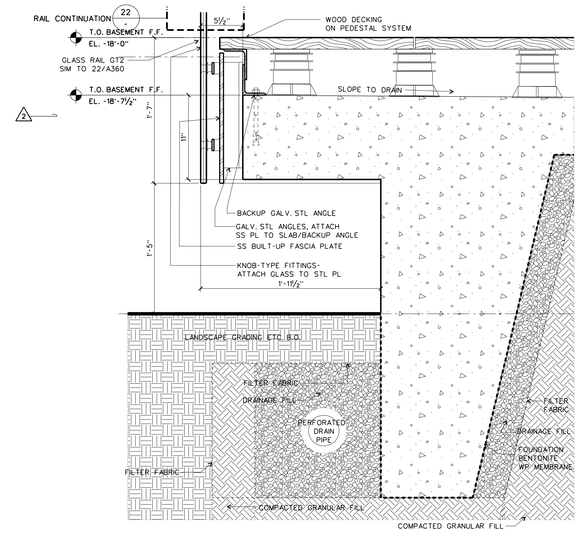

SECTION DETAIL AT CAFE TERRACE RAIL

SCALE: 1-1/2 " = 1'-0"


30

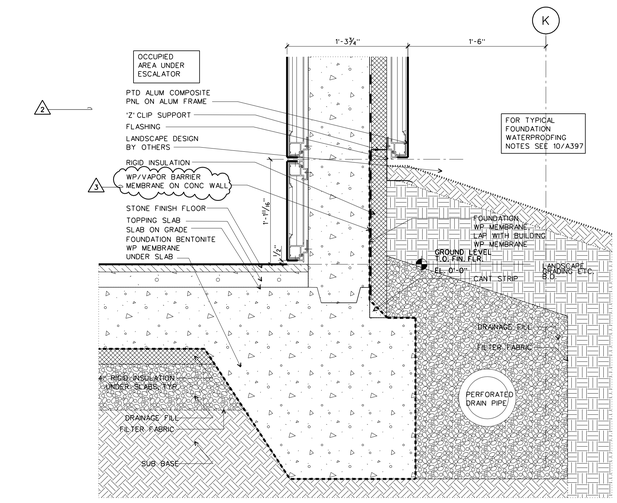

WALL SYSTEM C: DETAIL SECTION @ ESCALATOR BOX

SCALE: 1-1/2 " = 1'-0"


D-CWC01 **21**

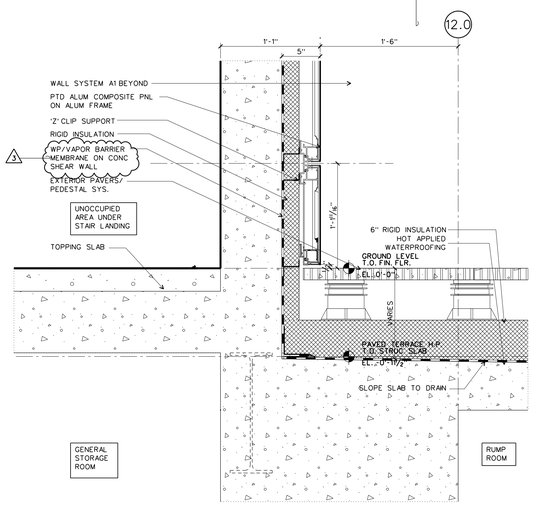

WALL SYSTEM C: DETAIL SECTION @ ESCALATOR BOX BASE (PLAZA)

SCALE: 1-1/2 " = 1'-0"


D-CWC01 **20**

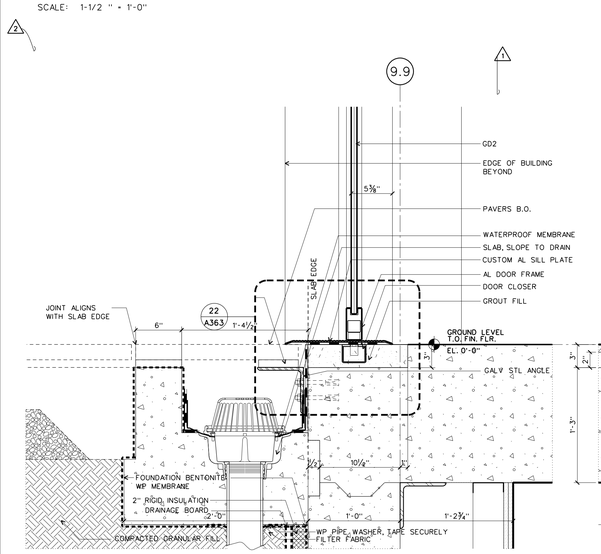

WALL SYSTEM C: DETAIL SECTION @ DOOR BASE

SCALE: 1-1/2 " = 1'-0"


D-CWC01 **13**

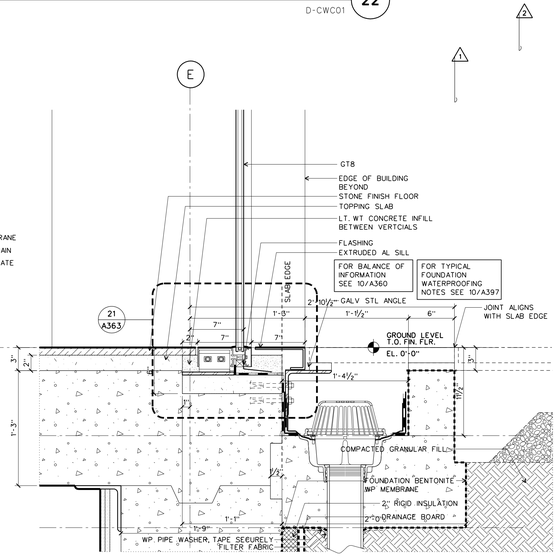

WALL SYSTEM C: DETAIL SECTION @ CORE GLAZING BASE

SCALE: 1-1/2 " = 1'-0"


D-CWC01 **12**

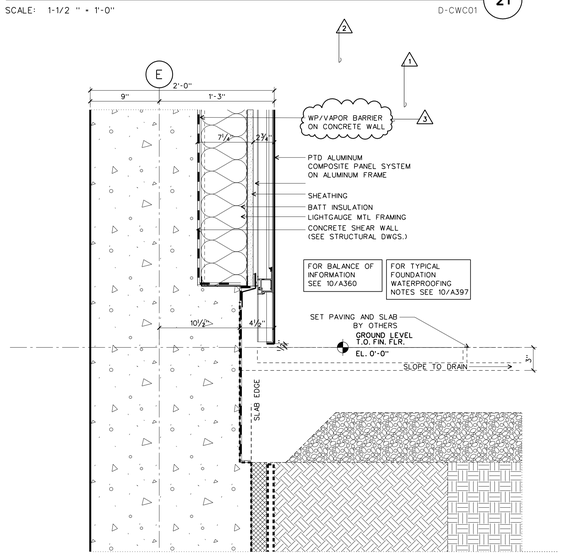

WALL SYSTEM C: DETAIL SECTION @ BASE SHEAR WALL

SCALE: 1-1/2 " = 1'-0"

D-CWC01 **11**

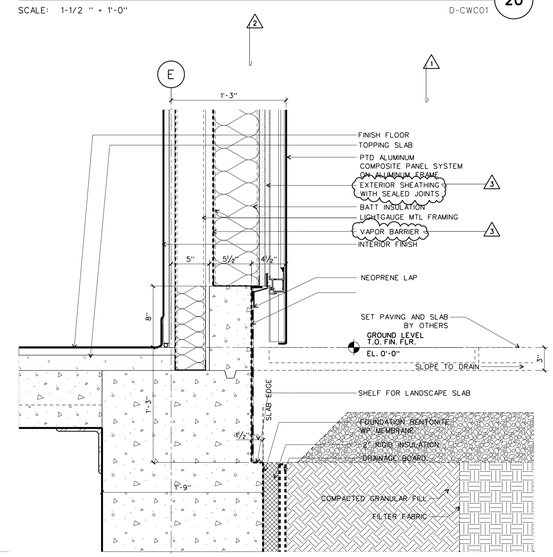

WALL SYSTEM C: TYP. DETAIL SECTION @ BASE

SCALE: 1-1/2 " = 1'-0"

D-CWC01 **10**

WILLIAM J. CLINTON PRESIDENTIAL CENTER

LITTLE ROCK, ARKANSAS

Architect

POLSHEK PARTNERSHIP LLP
320 West 13th Street
New York, New York 10014
212.807.7171

Coordinating Architects

POLK STANLEY YEARY ARCHITECTS Ltd
700 South Schiller Street
Little Rock, Arkansas 72201
501.378.0878

WITSELL EVANS RASCO
901 West Third Street
Little Rock, Arkansas 72201
501.374.5300

WOODS CARADINE ARCHITECTS
2200 South Main Street
Little Rock, Arkansas 72206
501.374.4060

Landscape Architects

HARGREAVES ASSOCIATES
118 Magazine Street
Cambridge, Massachusettes 02139
617.661.0070

LANDSCAPE ARCHITECTURE, Inc.
2300 Cottondale Lane Suite 202
Little Rock, Arkansas 72202
501.374.5610

Structural Engineer

LESLIE E. ROBERTSON ASSOC., RLLP
30 Broad Street, 47th Floor
New York, New York 10004
212.750.9000

MEP Engineers

FLACK + KURTZ Inc.
475 Fifth Avenue
New York, New York 10017
212.532.9600


CROMWELL ARCHITECTS ENGINEERS
101 South Spring Street
Little Rock, Arkansas 72201
501.372.2900

Curtainwall Consultant

R. A. HEINTGES ARCHITECTS
126 Fifth Avenue, 9th Floor
New York, New York 10011
212.652-2966

Seal

Issue	Date
1 ASI #22	08.01.03
2 100% Construction Documents	09/27/02
1 90% Progress Printing	08/30/02
100% Struct./ CD Progress	07/01/02
Bridge Bldg. Substructure	06/14/02
100% Design Development	03/01/02

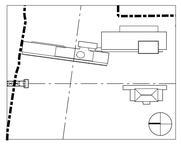

Job No. 9908

Scale 1-1/2" = 1'-0"

Date September 27, 2002


Title


WALL SYSTEM C PLAZA AND BASE DETAIL SECTIONS


Sheet No.


A360

FOR OFFICIAL USE ONLY

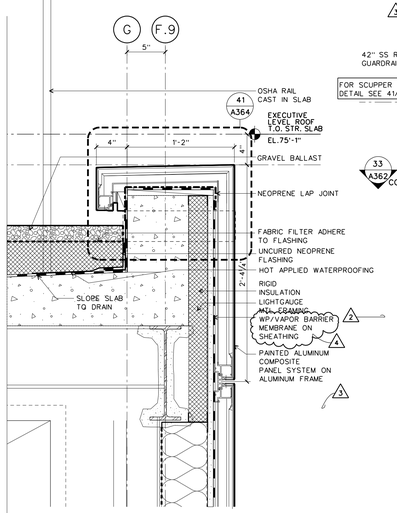

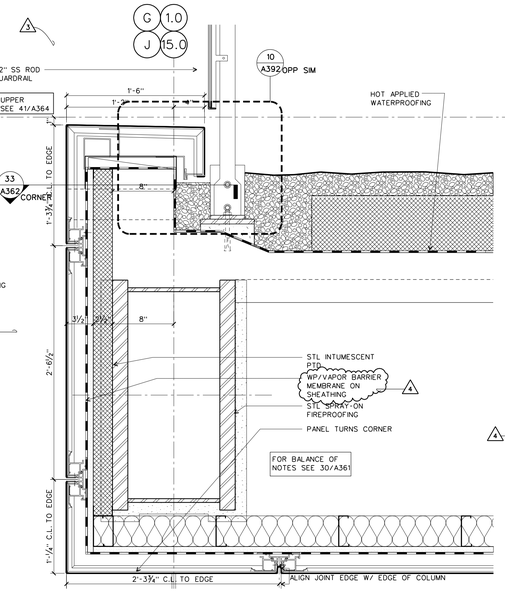


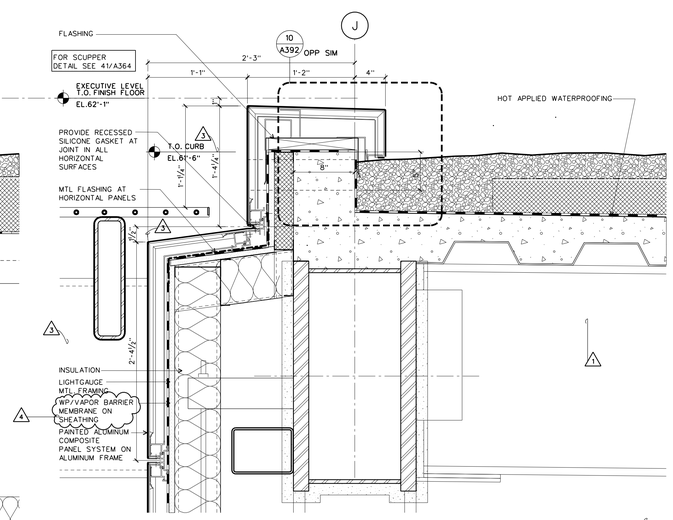

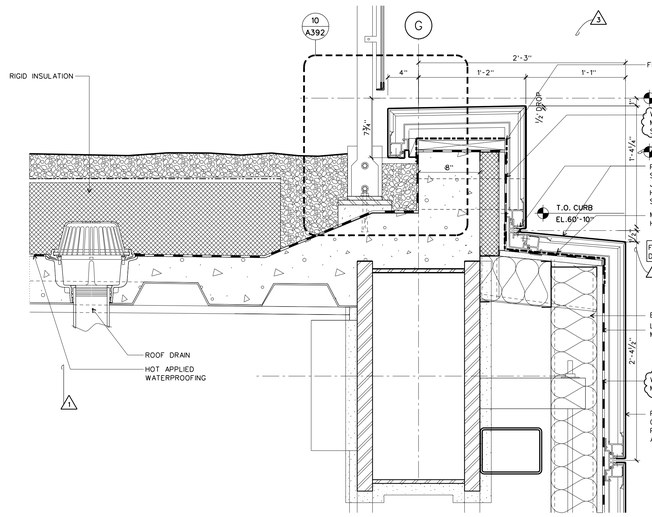


WALL SYSTEM C: DETAIL SECTION @ TOP OF WALL EXEC LEVEL

SCALE: 1-1/2 " = 1'-0" D-CWC02 **33**

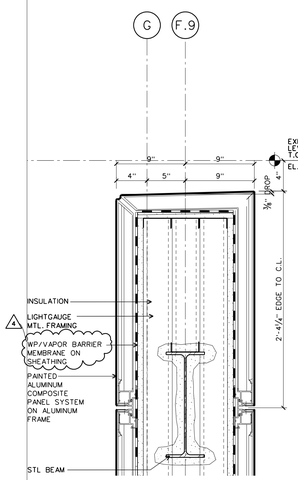

WALL SYSTEM C: DETAIL SECTION @ FREESTANDING WALL EXEC. LEVEL

SCALE: 1-1/2 " = 1'-0" D-CWC02 **23**

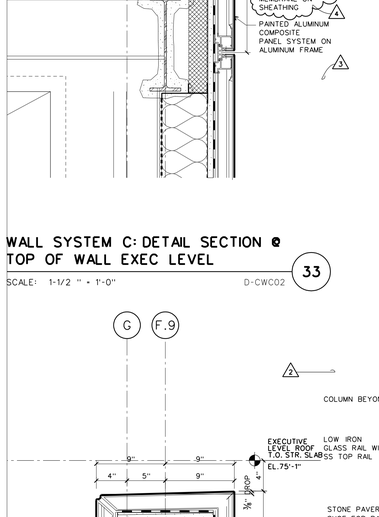


WALL SYSTEM C: DETAIL SECTION @ FREESTANDING WALL EXEC. LEVEL

SCALE: 1-1/2 " = 1'-0" D-CWC02 **13**


WALL SYSTEM C: DETAIL SECTION @ N & S ENDS OF BUILDING, UPPER EXTERIOR SOFFIT

SCALE: 1-1/2 " = 1'-0" D-CWC02 **32**

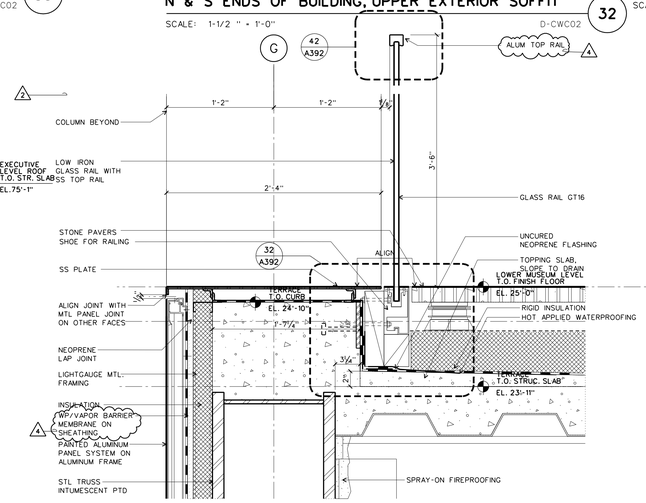

WALL SYSTEM C: DETAIL SECTION @ SECTION @ BALCONY EDGE

SCALE: 1-1/2 " = 1'-0" D-CWC02 **22**

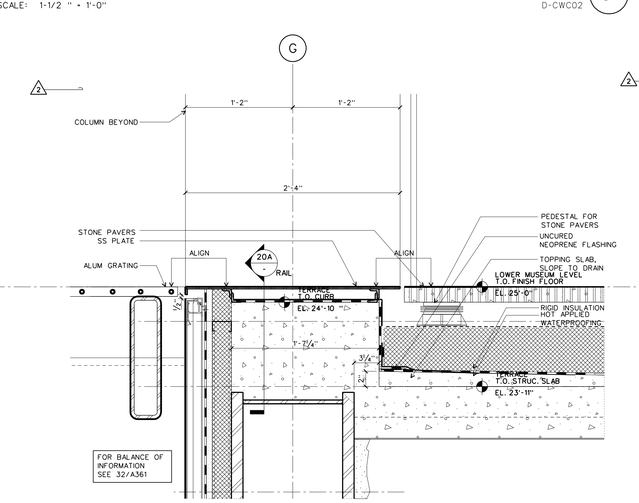


WALL SYSTEM C: DETAIL SECTION @ BALCONY/GRATING

SCALE: 1-1/2 " = 1'-0" D-CWC02 **21**

WALL SYSTEM C: DETAIL SECTION @ TYPICAL PARAPET WEST

SCALE: 1-1/2 " = 1'-0" D-CWC02 **31**

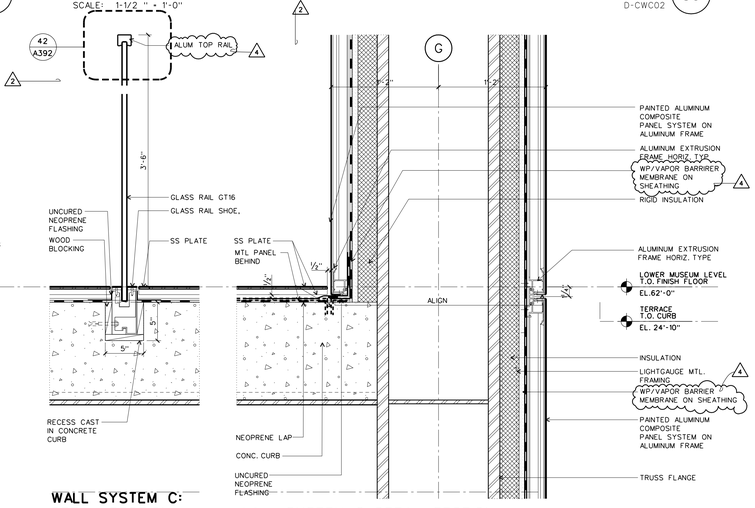

WALL SYSTEM C: DETAIL SECTION @ TYPICAL PARAPET EAST


SCALE: 1-1/2 " = 1'-0" D-CWC02 **30**

WALL SYSTEM C: DETAIL SECTION @ RAIL-CURB

SCALE: 1-1/2 " = 1'-0" D-CWC02 **20A**


WALL SYSTEM C: DETAIL SECTION @ COLUMN-BALCONY INTERSECTION

SCALE: 1-1/2 " = 1'-0" D-CWC02 **20**

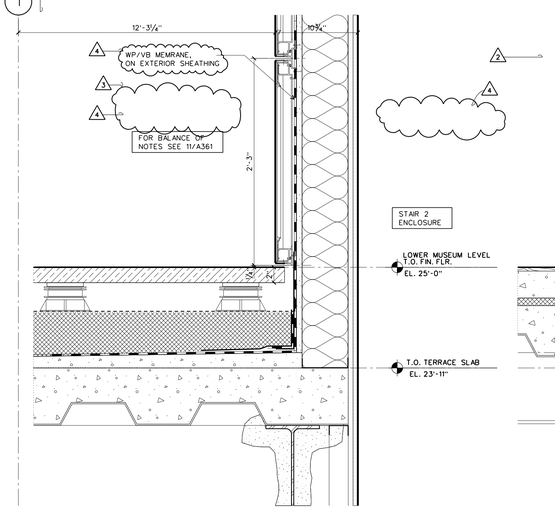


WALL SYSTEM C: DETAIL SECTION @ BALCONY-WALL INTERSECTION

SCALE: 1-1/2 " = 1'-0" D-CWC02 **12**

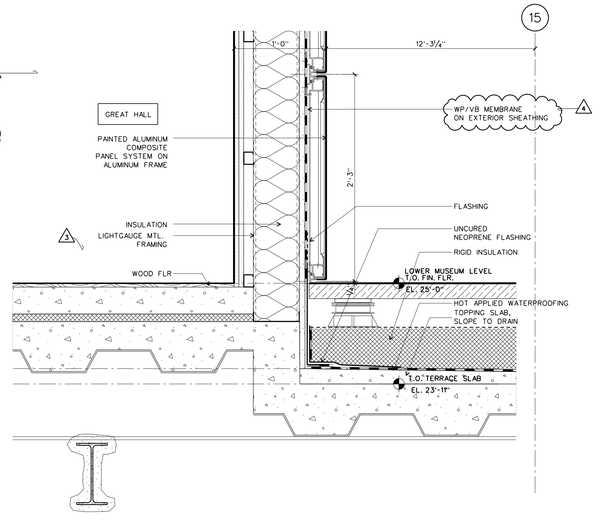

WALL SYSTEM C: DETAIL SECTION @ SOUTH/EAST GREAT HALL

SCALE: 1-1/2 " = 1'-0" D-CWC02 **11**

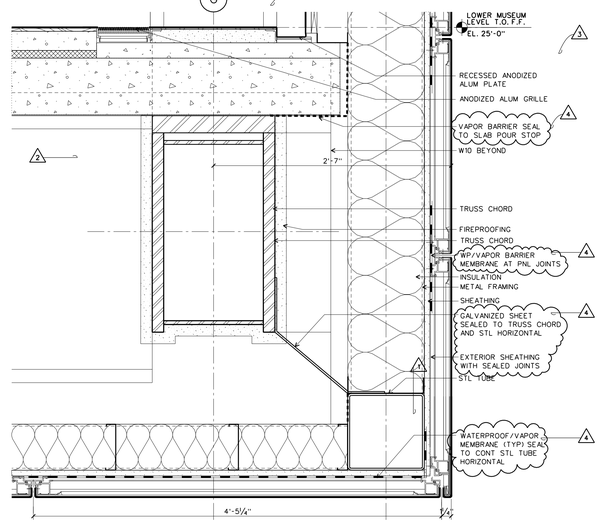

WALL SYSTEM C: DETAIL SECTION @ EAST BUILDING EDGE

SCALE: 1-1/2 " = 1'-0" D-CWC02 **10**

WILLIAM J. CLINTON PRESIDENTIAL CENTER

LITTLE ROCK, ARKANSAS

Architect

POLSHEK PARTNERSHIP LLP
320 West 13th Street
New York, New York 10014
212.807.7171

Coordinating Architects

POLK STANLEY YEARY ARCHITECTS Ltd
700 South Schiller Street
Little Rock, Arkansas 72201
501.378.0878

WITSELL EVANS RASCO
901 West Third Street
Little Rock, Arkansas 72201
501.374.5300

WOODS CARADINE ARCHITECTS
2200 South Main Street
Little Rock, Arkansas 72206
501.374.4060

Landscape Architects

HARGREAVES ASSOCIATES
118 Magazine Street
Cambridge, Massachusettes 02139
617.661.0070

LANDSCAPE ARCHITECTURE, Inc.
2300 Cottondale Lane Suite 202
Little Rock, Arkansas 72202
501.374.5610

Structural Engineer

LESLIE E. ROBERTSON ASSOC., RLLP
30 Broad Street, 47th Floor
New York, New York 10004
212.750.9000

MEP Engineers

FLACK + KURTZ Inc.
475 Fifth Avenue
New York, New York 10017
212.532.9600


CROMWELL ARCHITECTS ENGINEERS
101 South Spring Street
Little Rock, Arkansas 72201
501.372.2900

Curtainwall Consultant

R. A. HEINTGES ARCHITECTS
126 Fifth Avenue, 9th Floor
New York, New York 10011
212.652-2966

Seal

7	ASI #22	08/01/03
6	ASI #20	06/06/03
5	100% Construction Documents	09/27/02
4	90% Progress Printing	08/30/02
	100% Struct./ CD Progress	07/01/02
	Issue	Date

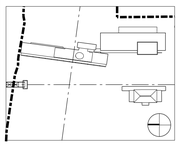

Job No. 9908

Scale 1 1/2" = 1'-0"

Date September 27, 2002


Title

WALL SYSTEM C
DETAIL SECTIONS

Sheet No.


A361

FOR OFFICIAL USE ONLY

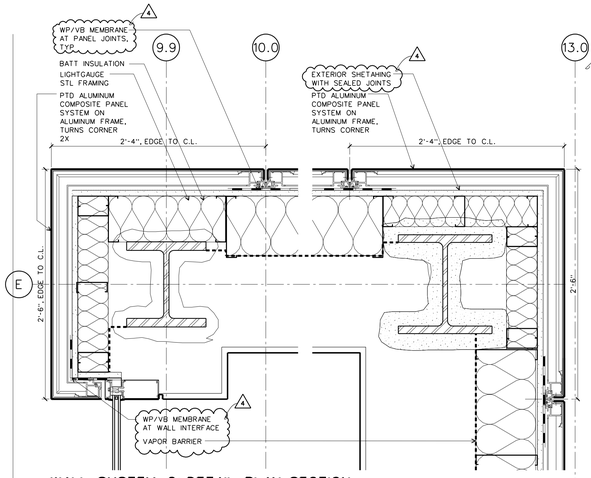


WALL SYSTEM C: DETAIL PLAN-SECTION @ CORE BUILDING, NE & SE CORNERS

SCALE: 1½" = 1'-0" D-CWC03 **34**

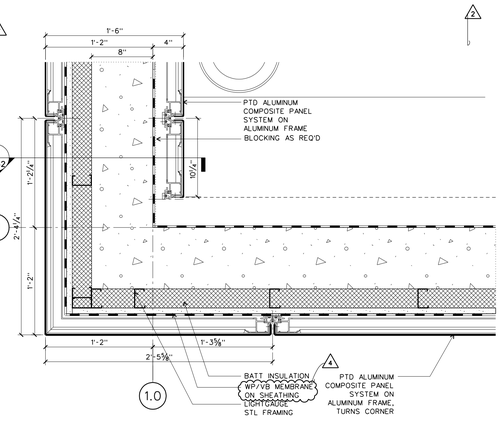


WALL SYSTEM C: DETAIL PLAN-SECTION @ PARAPET CORNER

SCALE: 1½" = 1'-0" D-CWC03 **33**

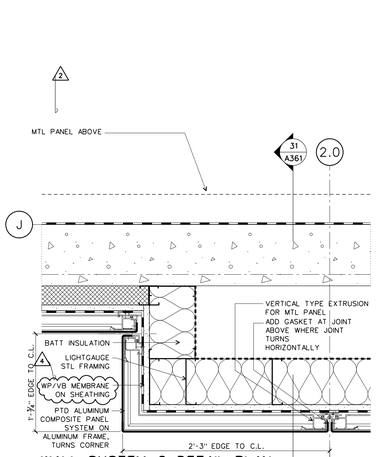


WALL SYSTEM C: DETAIL PLAN-SECTION @ PARAPET

SCALE: 1½" = 1'-0" D-CWC03 **32**

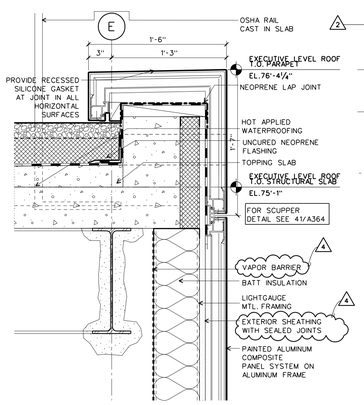


WALL SYSTEM C: DETAIL SECTION @ CORE PARAPET

SCALE: 1½" = 1'-0" D-CWC03 **31**

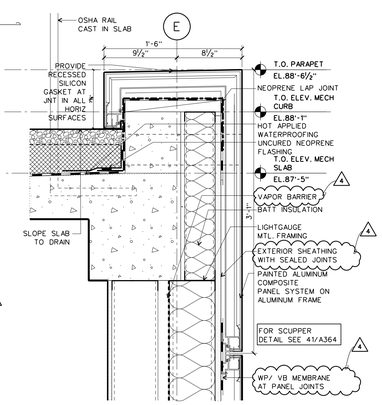


WALL SYSTEM C: DETAIL SECTION @ PARAPET ELEV. MECH

SCALE: 1½" = 1'-0" D-CWC03 **30**

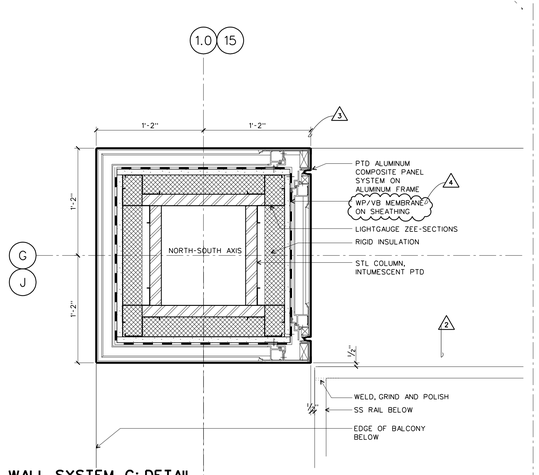


WALL SYSTEM C: DETAIL SECTION @ CORNER CLAD TRUSS

SCALE: 1½" = 1'-0" D-CWC03 **24**

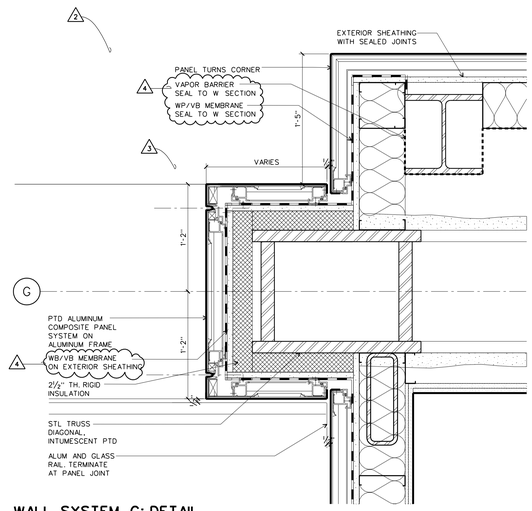


WALL SYSTEM C: DETAIL SECTION @ CORNER CLAD TRUSS

SCALE: 1½" = 1'-0" D-CWC03 **23**

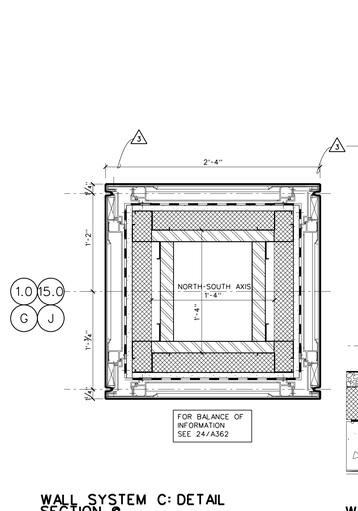


WALL SYSTEM C: DETAIL SECTION @ DIAGONAL CLAD TRUSS

SCALE: 1½" = 1'-0" D-CWC03 **22**

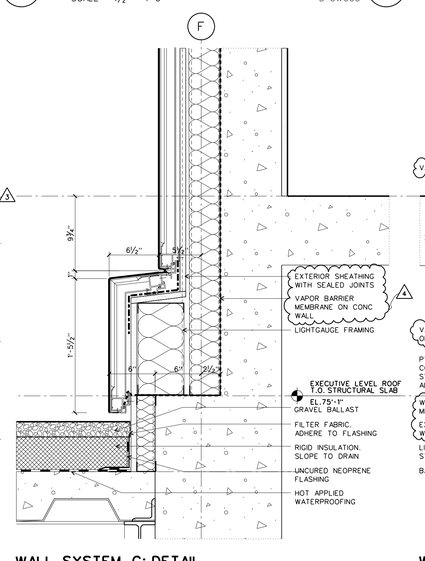


WALL SYSTEM C: DETAIL SECTION @ ELEV. MECH BASE/ROOF

SCALE: 1½" = 1'-0" D-CWC03 **21**

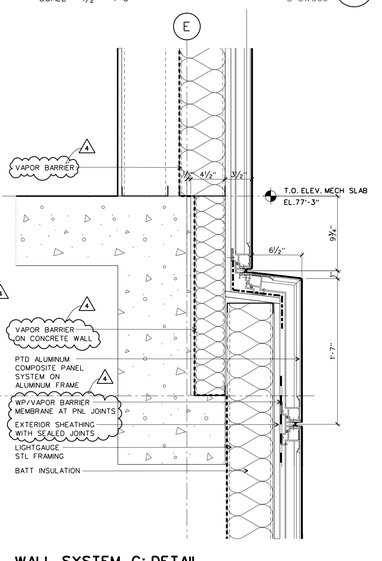


WALL SYSTEM C: DETAIL SECTION @ ELEV. MECH. BASE

SCALE: 1½" = 1'-0" D-CWC03 **20**

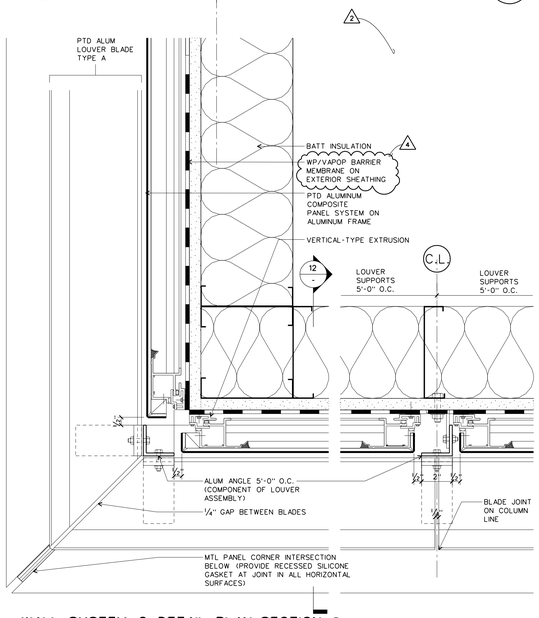


WALL SYSTEM C: DETAIL PLAN-SECTION @ LOUVER A CORNER

SCALE: 3" = 1'-0" D-CWC03 **14**

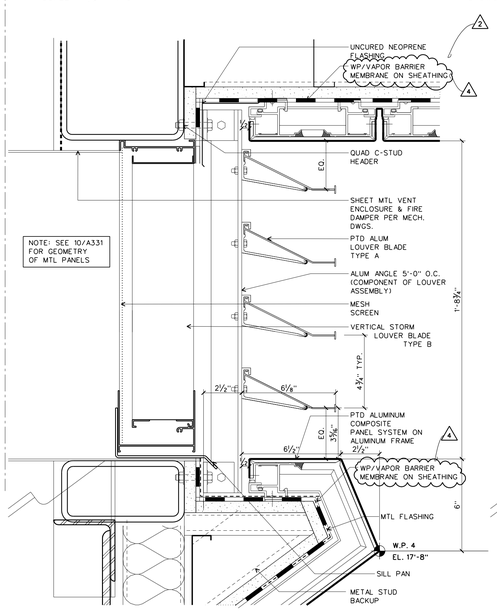


WALL SYSTEM C: DETAIL SECTION @ LOUVER A OPEN

SCALE: 3" = 1'-0" D-CWC03 **13**

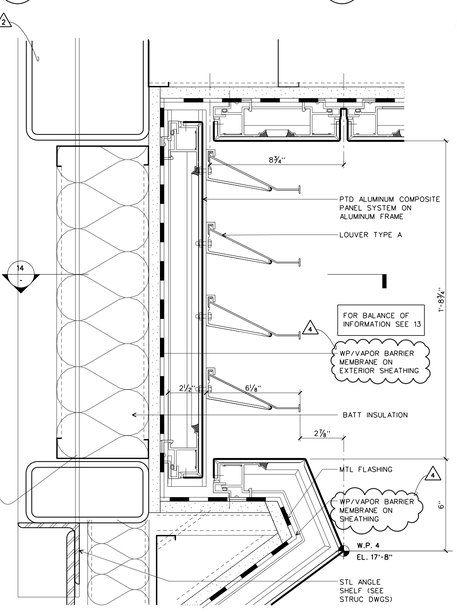


WALL SYSTEM C: DETAIL SECTION @ LOUVER A BLANKED OFF

SCALE: 3" = 1'-0" D-CWC03 **12**

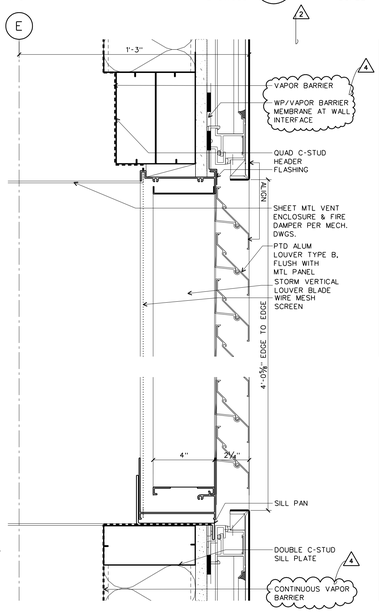

WALL SYSTEM C: DETAIL SECTION @ LOUVER B OPEN

SCALE: 3" = 1'-0" D-CWC03 **11**

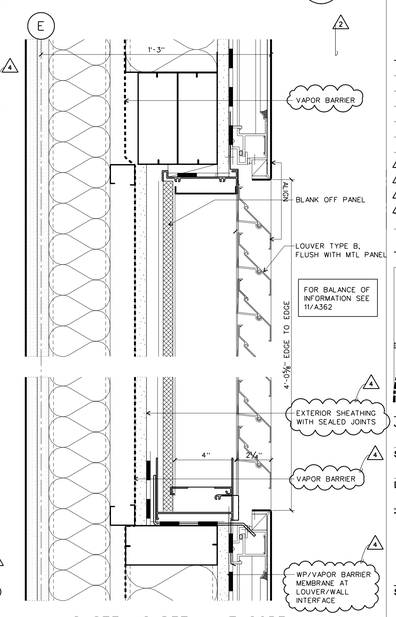

WALL SYSTEM C: DETAIL AT CORE SECTION @ LOUVER B BLANKED OFF

SCALE: 3" = 1'-0" D-CWC03 **10**

WILLIAM J. CLINTON PRESIDENTIAL CENTER

LITTLE ROCK, ARKANSAS

Architect

POLSHEK PARTNERSHIP LLP
320 West 13th Street
New York, New York 10014
212.807.7171

Coordinating Architects

POLK STANLEY YEARY ARCHITECTS Ltd
700 South Schiller Street
Little Rock, Arkansas 72201
501.378.0878

WITSELL EVANS RASCO
901 West Third Street
Little Rock, Arkansas 72201
501.374.5300

WOODS CARADINE ARCHITECTS
2200 South Main Street
Little Rock, Arkansas 72206
501.374.4060

Landscape Architects

HARGREAVES ASSOCIATES
118 Magazine Street
Cambridge, Massachusettes 02139
617.661.0070

LANDSCAPE ARCHITECTURE, Inc.
2300 Cottondale Lane Suite 202
Little Rock, Arkansas 72202
501.374.5610

Structural Engineer

LESLIE E. ROBERTSON ASSOC., RLLP
30 Broad Street, 47th Floor
New York, New York 10004
212.750.9000

MEP Engineers

FLACK + KURTZ Inc.
475 Fifth Avenue
New York, New York 10017
212.532.9600


CROMWELL ARCHITECTS ENGINEERS
101 South Spring Street
Little Rock, Arkansas 72201
501.372.2900

Curtainwall Consultant

R. A. HEINTGES ARCHITECTS
126 Fifth Avenue, 9th Floor
New York, New York 10011
212.652-2966

Seal

Issue	Date
1 ASI #22	08/01/03
1 Addendum #2	11/15/02
2 100% Construction Documents	09/27/02
1 90% Progress Printing	08/30/02
100% Struct./ CD Progress	07/01/02

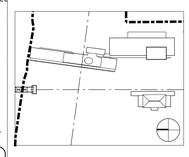

Job No. 9908


Scale AS NOTED

Date September 27, 2002

Title WALL SYSTEM C DETAIL SECTIONS AND PLANS


Sheet No. **A362**

FOR OFFICIAL USE ONLY

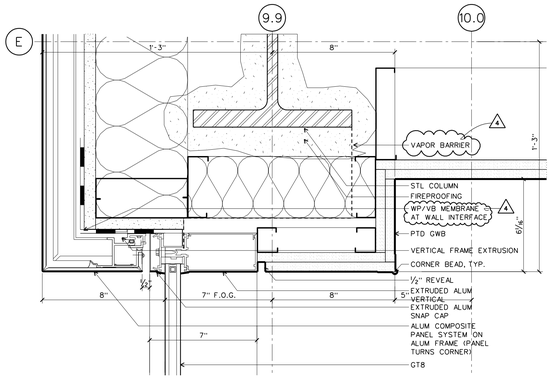


WALL SYSTEM C: DETAIL PLAN-SECTION @ CORE NORTH JAMB

SCALE: 3" = 1'-0" D-CWC04 **43**

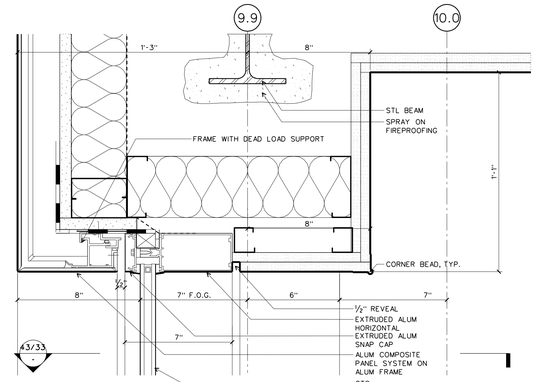


WALL SYSTEM C: DETAIL SECTION @ CORE NORTH GLAZING HEAD

SCALE: 3" = 1'-0" D-CWC04 **42**

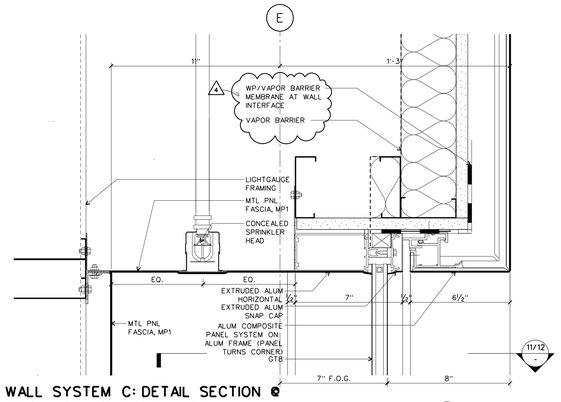


WALL SYSTEM C: DETAIL SECTION @ CORE EAST GLAZING HEAD

SCALE: 3" = 1'-0" D-CWC04 **41**

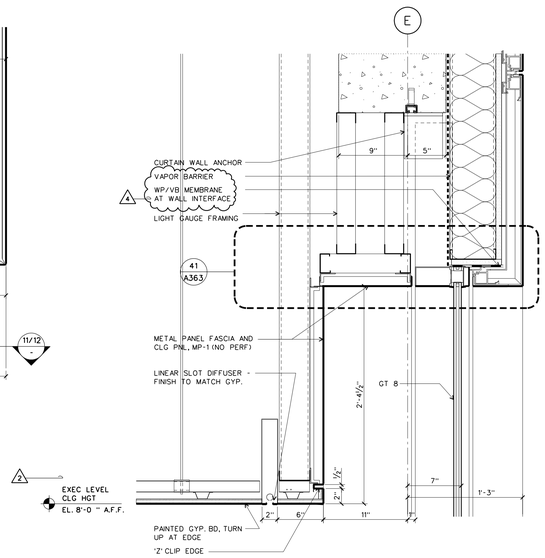


WALL SYSTEM C: HEAD DETAIL AT EXEC LEVEL

SCALE: 1½" = 1'-0" D-CWC04 **40**

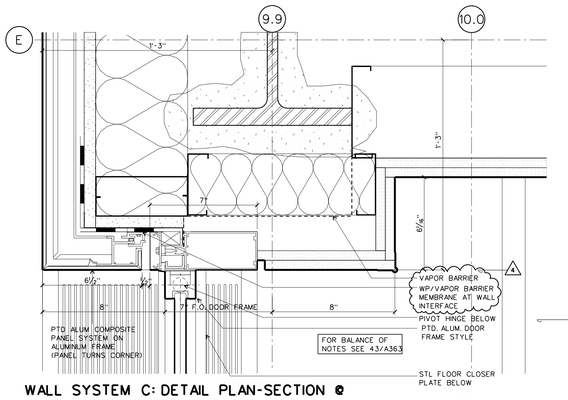


WALL SYSTEM C: DETAIL PLAN-SECTION @ CORE NORTH DOOR JAMB

SCALE: 3" = 1'-0" D-CWC04 **33**

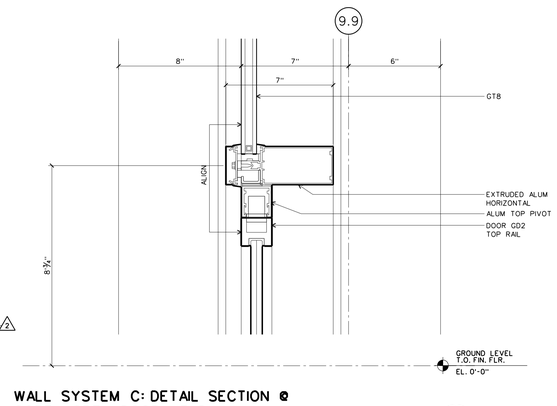


WALL SYSTEM C: DETAIL SECTION @ CORE NORTH DOOR HEAD

SCALE: 3" = 1'-0" D-CWC04 **32**

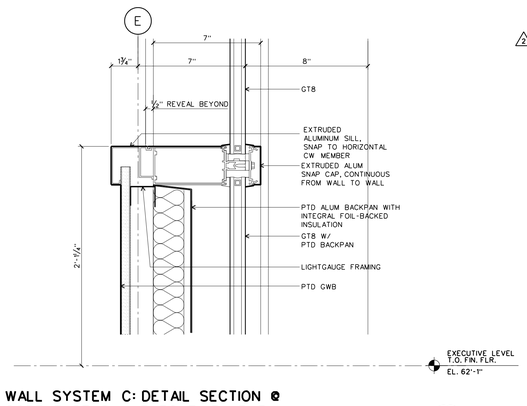


WALL SYSTEM C: DETAIL SECTION @ CORE EAST SILL, EXECUTIVE LEVEL

SCALE: 3" = 1'-0" D-CWC04 **31**

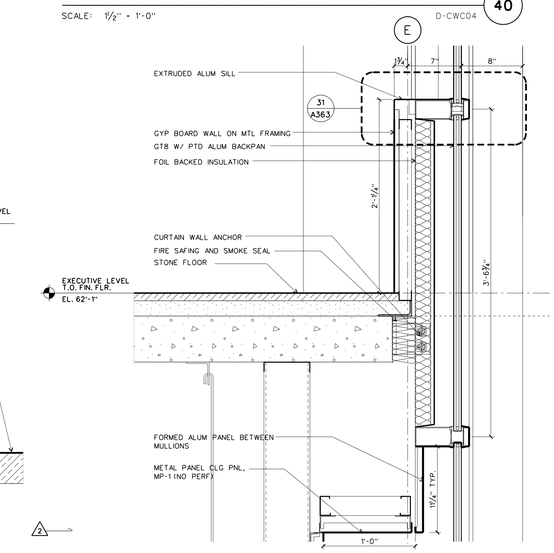


WALL SYSTEM C: SECTION CORE EAST GLAZING

SCALE: 1½" = 1'-0" D-CWC04 **20**

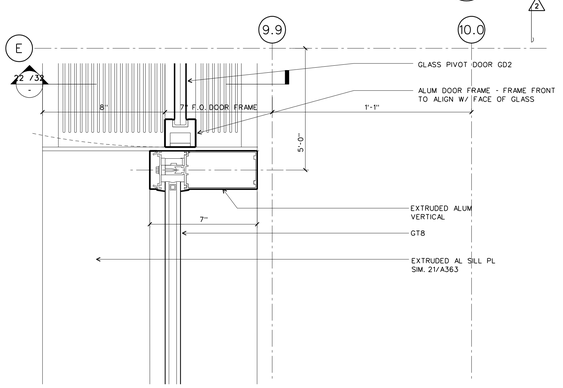


WALL SYSTEM C: DETAIL PLAN-SECTION @ CORE NORTH MULLION/DOOR JAMB

SCALE: 3" = 1'-0" D-CWC04 **23**

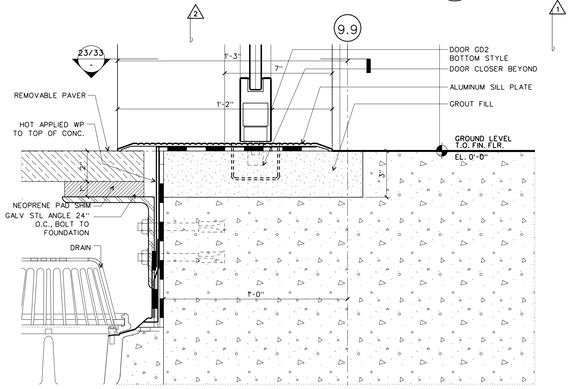


WALL SYSTEM C: DETAIL SECTION @ NORTH CORE OPENING DOOR SILL

SCALE: 3" = 1'-0" D-CWC04 **22**

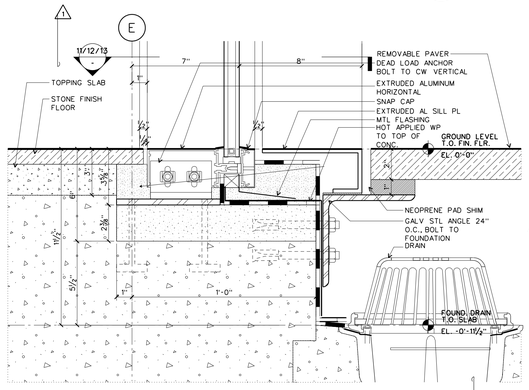


WALL SYSTEM C: DETAIL SECTION @ CORE EAST GLAZING SILL

SCALE: 3" = 1'-0" D-CWC04 **21**

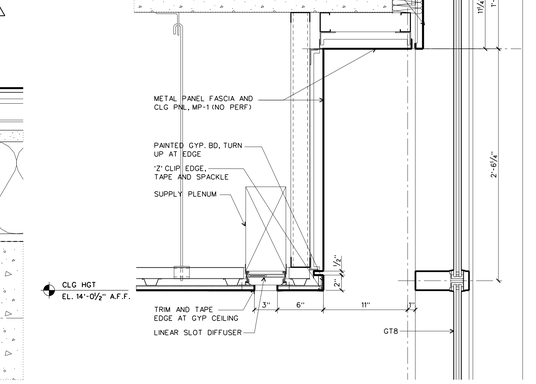


WALL SYSTEM C: SECTION AT LOWER MUS. EAST CORE

SCALE: 1½" = 1'-0" D-CWC04 **10**

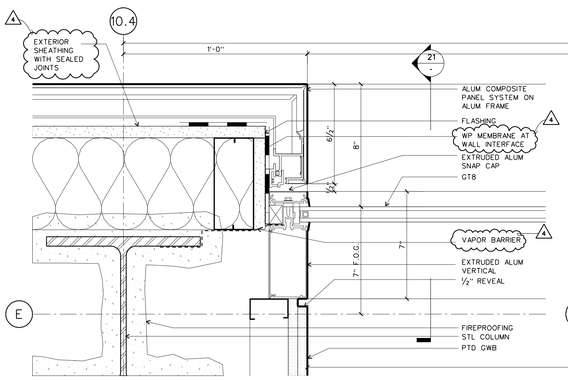


WALL SYSTEM C: DETAIL PLAN SECTION @ CORE EAST JAMB

SCALE: 3" = 1'-0" D-CWC04 **13**

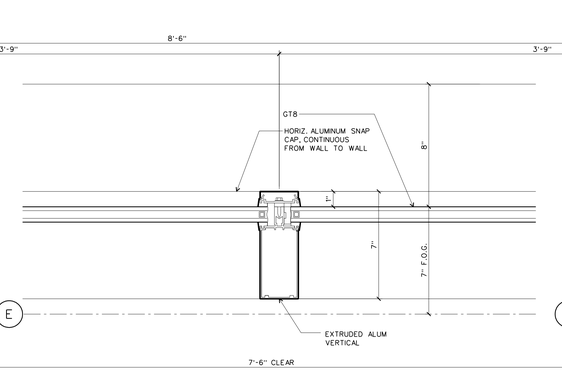

WALL SYSTEM C: DETAIL PLAN SECTION @ CORE EAST CENTRAL MULLION

SCALE: 3" = 1'-0" D-CWC04 **12**

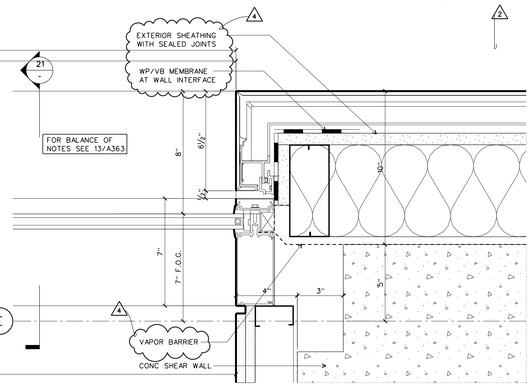

WALL SYSTEM C: DETAIL PLAN SECTION @ CORE EAST JAMB

SCALE: 3" = 1'-0" D-CWC04 **11**

WILLIAM J. CLINTON PRESIDENTIAL CENTER

LITTLE ROCK, ARKANSAS

Architect

POLSHEK PARTNERSHIP LLP
320 West 13th Street
New York, New York 10014
212.807.7171

Coordinating Architects

POLK STANLEY YEARY ARCHITECTS Ltd
700 South Schiller Street
Little Rock, Arkansas 72201
501.378.0878

WITSELL EVANS RASCO
901 West Third Street
Little Rock, Arkansas 72201
501.374.5300

WOODS CARADINE ARCHITECTS
2200 South Main Street
Little Rock, Arkansas 72206
501.374.4060

Landscape Architects

HARGREAVES ASSOCIATES
118 Magazine Street
Cambridge, Massachusettes 02139
617.661.0070

LANDSCAPE ARCHITECTURE, Inc.
2300 Cottondale Lane Suite 202
Little Rock, Arkansas 72202
501.374.5610

Structural Engineer

LESLIE E. ROBERTSON ASSOC., RLLP
30 Broad Street, 47th Floor
New York, New York 10004
212.750.9000

MEP Engineers

FLACK + KURTZ Inc.
475 Fifth Avenue
New York, New York 10017
212.532.9600

CROMWELL ARCHITECTS ENGINEERS
101 South Spring Street
Little Rock, Arkansas 72201
501.372.2900

Curtainwall Consultant

R. A. HEINTGES ARCHITECTS
126 Fifth Avenue, 9th Floor
New York, New York 10011
212.652-2966

Seal

Issue	Date
4 ASI #22	08/01/03
3 ASI #20	08/06/03
2 100% Construction Documents	09/27/02
1 90% Progress Printing	08/30/02
100% Struct./ CD Progress	07/01/02

Job No. 9908

Scale AS NOTED

Date September 27, 2002


Title

WALL SYSTEM C GLAZING DETAILS

Sheet No.


A363

FOR OFFICIAL USE ONLY

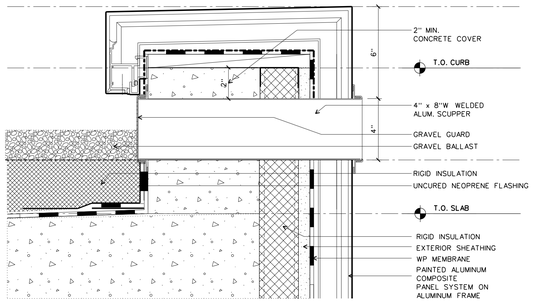


WALL SYSTEM C: GENERIC DETAIL SECTION FOR SCUPPER CONDITION

SCALE: 3" = 1'-0" D-CWC05 41

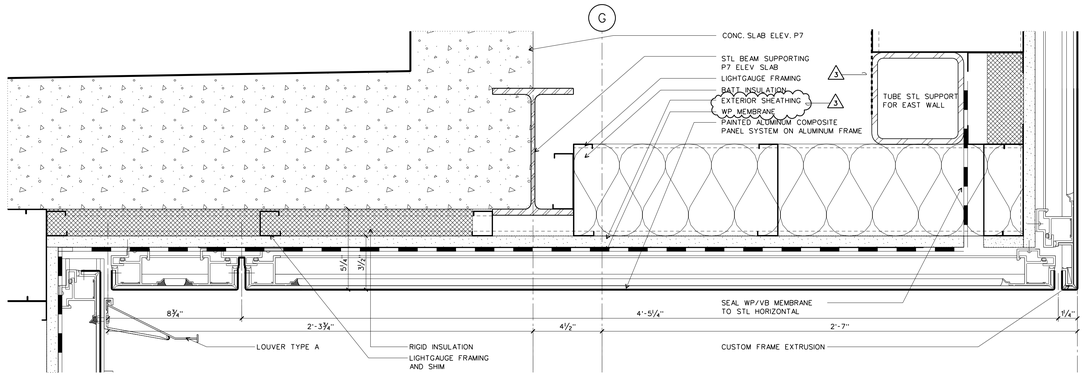


WALL SYSTEM C: SECTION DETAIL @ UNDERSIDE EAST-UNDER PE7

SCALE: 3" = 1'-0" D-CWC05 40

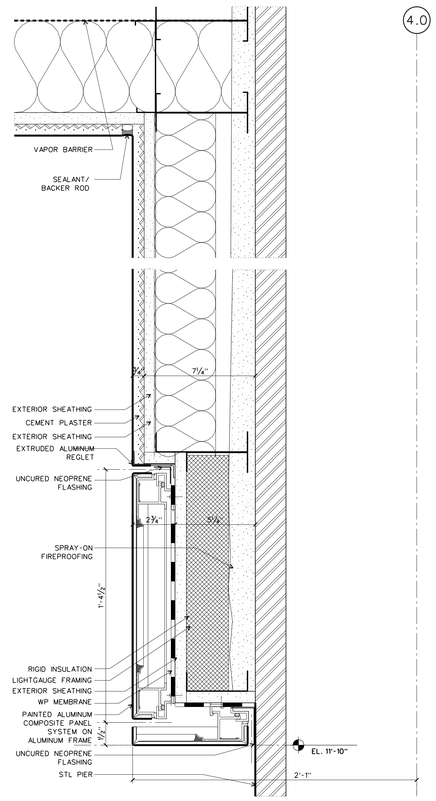


WALL SYSTEM C: DETAIL SECTION @ NORTH PIER/STAIR 2

SCALE: 3" = 1'-0" D-CWC05 25

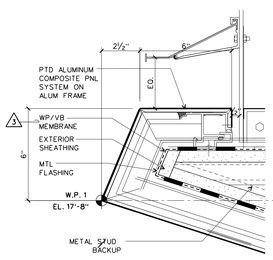


WALL SYSTEM C: SECTION DETAIL @ UNDERSIDE WEST

SCALE: 3" = 1'-0" D-CWC05 24

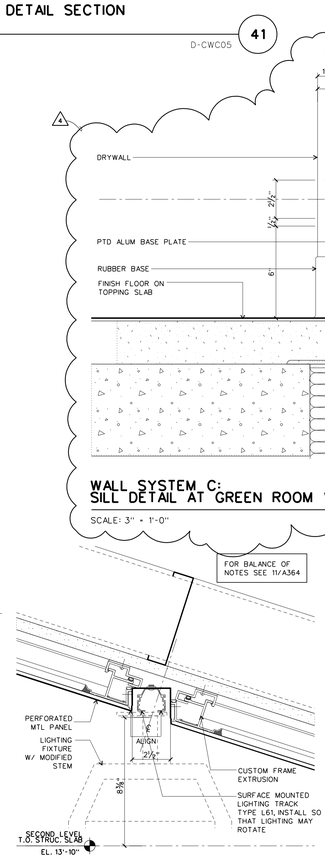


WALL SYSTEM C: SECTION DETAIL @ UNDERSIDE WEST-MID-LIGHTING

SCALE: 3" = 1'-0" D-CWC05 23

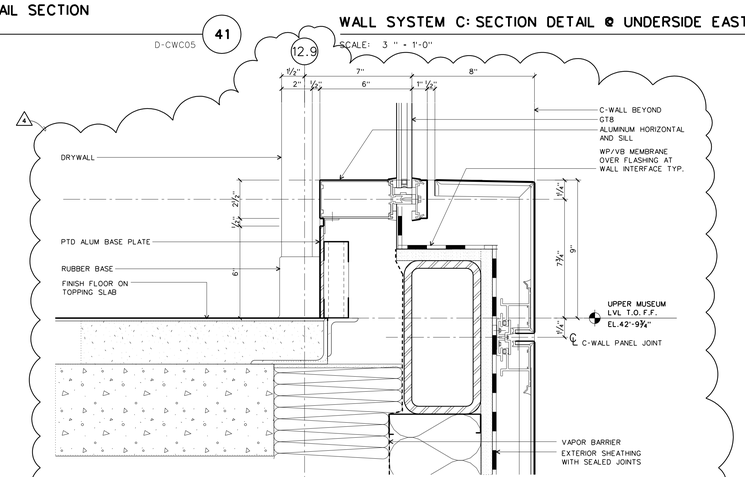


WALL SYSTEM C: SILL DETAIL AT GREEN ROOM WINDOW

SCALE: 3" = 1'-0" D-CWC05 31

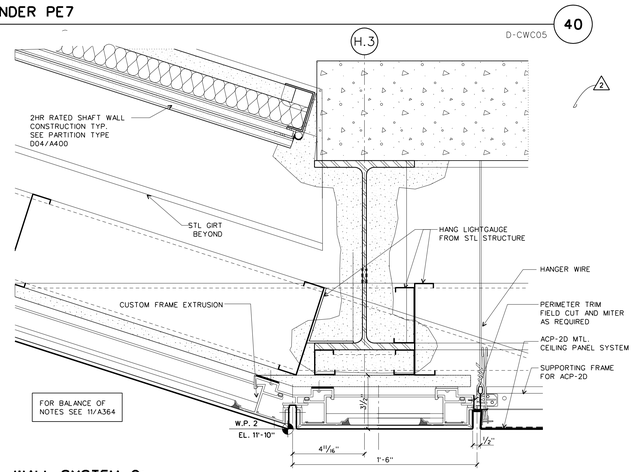


WALL SYSTEM C: SECTION DETAIL @ UNDERSIDE WEST

SCALE: 3" = 1'-0" D-CWC05 30

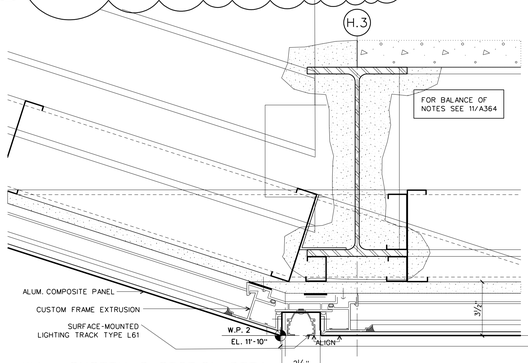


WALL SYSTEM C: SECTION DETAIL @ UNDERSIDE WEST-LIGHTING

SCALE: 3" = 1'-0" D-CWC05 22

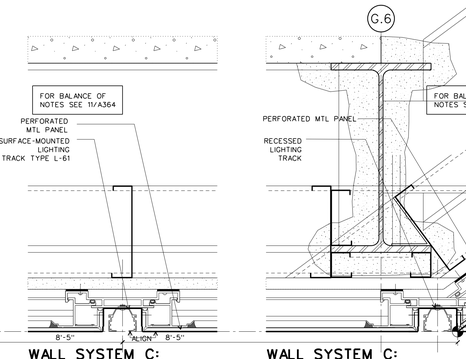


WALL SYSTEM C: SECTION DETAIL @ UNDERSIDE CTR-LIGHTING

SCALE: 3" = 1'-0" D-CWC05 21

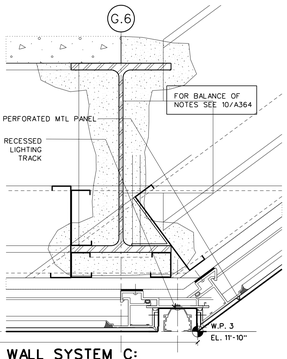


WALL SYSTEM C: SECTION DETAIL @ UNDERSIDE EAST-LIGHTING

SCALE: 3" = 1'-0" D-CWC05 20

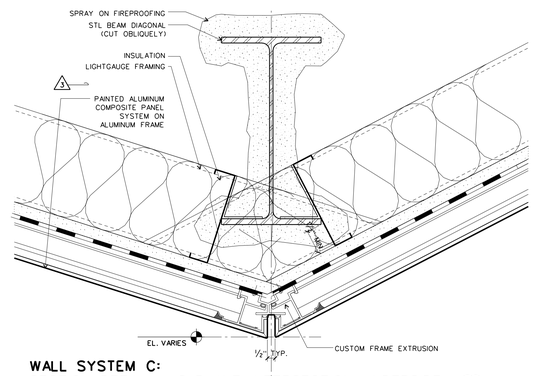


WALL SYSTEM C: SECTION DETAIL @ 2-PLANE INTERSECTION, UNDERSIDE

SCALE: 3" = 1'-0" D-CWC05 13

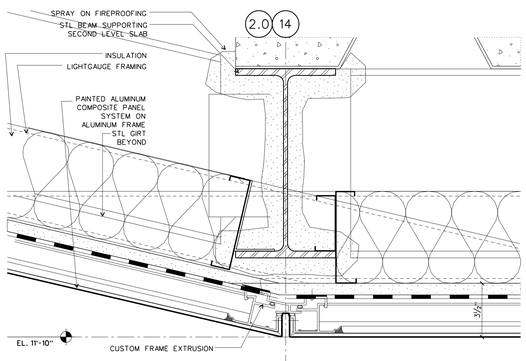


WALL SYSTEM C: SECTION DETAIL @ UNDERSIDE NORTH/SOUTH

SCALE: 3" = 1'-0" D-CWC05 12

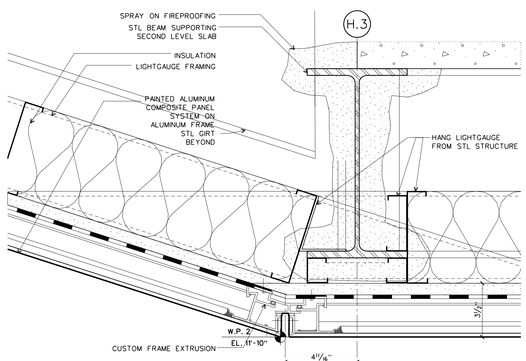

WALL SYSTEM C: SECTION DETAIL @ UNDERSIDE WEST

SCALE: 3" = 1'-0" D-CWC05 11

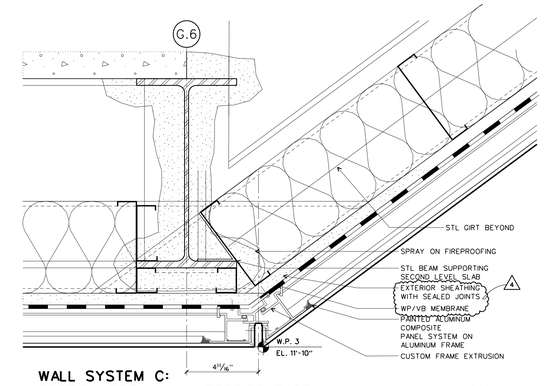

WALL SYSTEM C: SECTION DETAIL @ UNDERSIDE EAST

SCALE: 3" = 1'-0" D-CWC05 10

WILLIAM J. CLINTON PRESIDENTIAL CENTER

LITTLE ROCK, ARKANSAS

Architect

POLSHEK PARTNERSHIP LLP
320 West 13th Street
New York, New York 10014
212.807.7171

Coordinating Architects

POLK STANLEY YEARY ARCHITECTS Ltd
700 South Schiller Street
Little Rock, Arkansas 72201
501.378.0878

WITSELL EVANS RASCO
901 West Third Street
Little Rock, Arkansas 72201
501.374.5300

WOODS CARADINE ARCHITECTS
2200 South Main Street
Little Rock, Arkansas 72206
501.374.4060

Landscape Architects

HARGREAVES ASSOCIATES
118 Magazine Street
Cambridge, Massachusettes 02139
617.661.0070

LANDSCAPE ARCHITECTURE, Inc.
2300 Cottondale Lane Suite 202
Little Rock, Arkansas 72202
501.374.5610

Structural Engineer

LESLIE E. ROBERTSON ASSOC., RLLP
30 Broad Street, 47th Floor
New York, New York 10004
212.750.9000

MEP Engineers

FLACK + KURTZ Inc.
475 Fifth Avenue
New York, New York 10017
212.532.9600

CROMWELL ARCHITECTS ENGINEERS
101 South Spring Street
Little Rock, Arkansas 72201
501.372.2900


Curtainwall Consultant

R. A. HEINTGES ARCHITECTS
126 Fifth Avenue, 9th Floor
New York, New York 10011
212.652-2966

Seal

4	ASI #23	09/12/03
3	ASI #22	08/01/03
2	ASI #18	04/18/03
1	100% Construction Documents*	09/27/02
	Issue	Date

*New sheet. Former details now on A362, A363

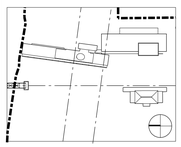

Job No. 9908

Scale 3" = 1'-0"

Date September 27, 2002


Title

WALL SYSTEM C GLAZING DETAILS

Sheet No.


A364

FOR OFFICIAL USE ONLY

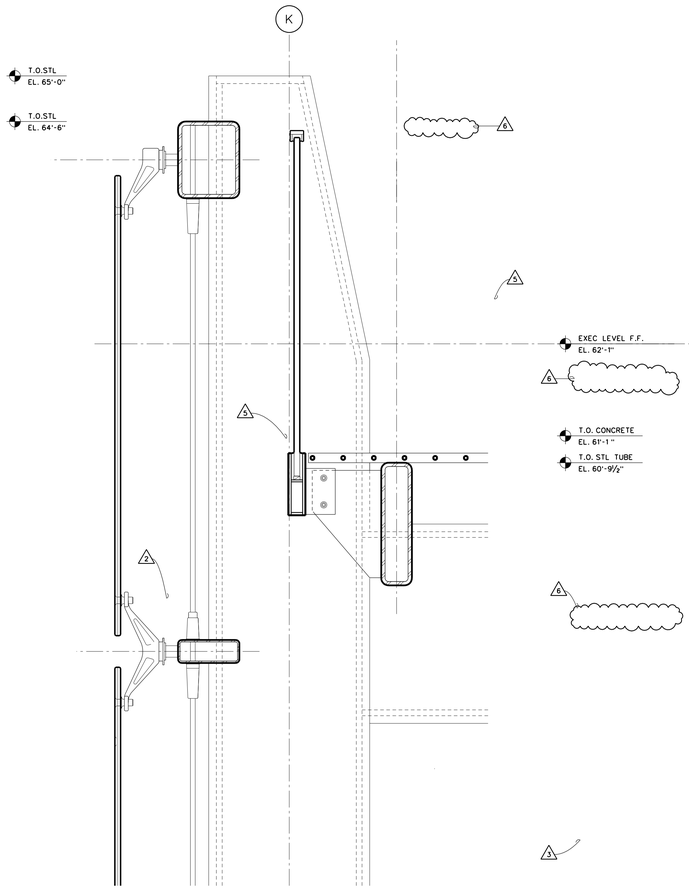


WALL SYSTEM E: DETAIL SECTION AT UPPER GRATING

SCALE: 1-1/2 " = 1'-0" D-CWDE01 22

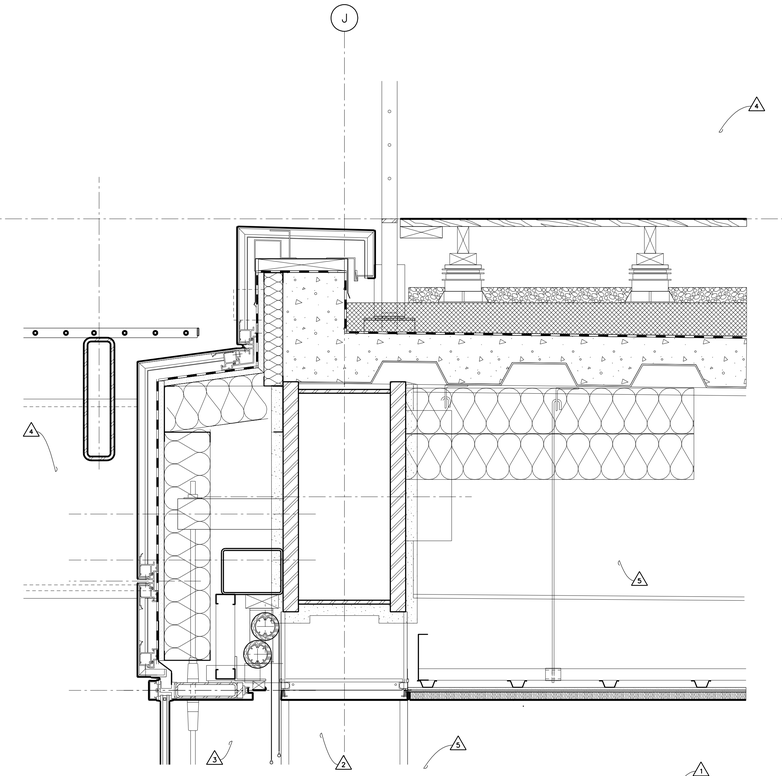


WALL SYSTEM D: DETAIL SECTION AT MUSEUM WEST HEAD

SCALE: 1-1/2 " = 1'-0" D-CWDE01 21

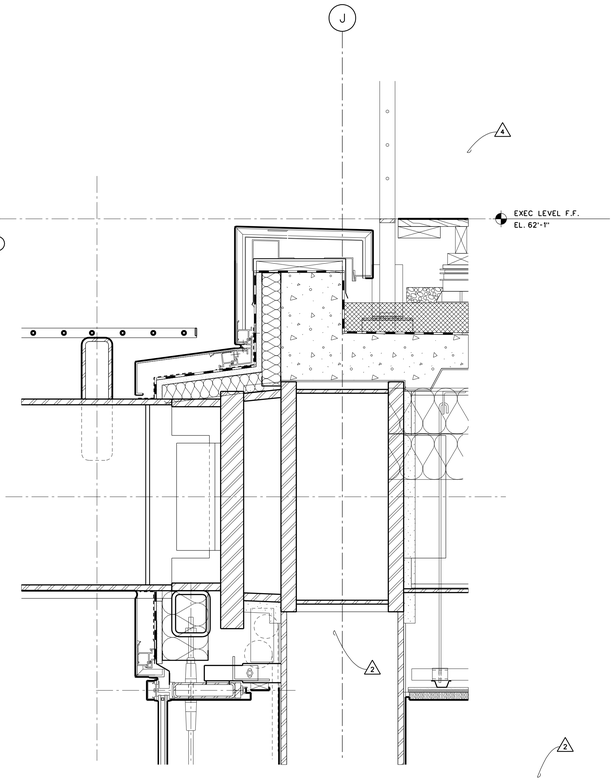


WALL SYSTEM D: SECTION AT WEST HEAD @ 30' MODULE

SCALE: 1-1/2 " = 1'-0" D-CWDE01 20

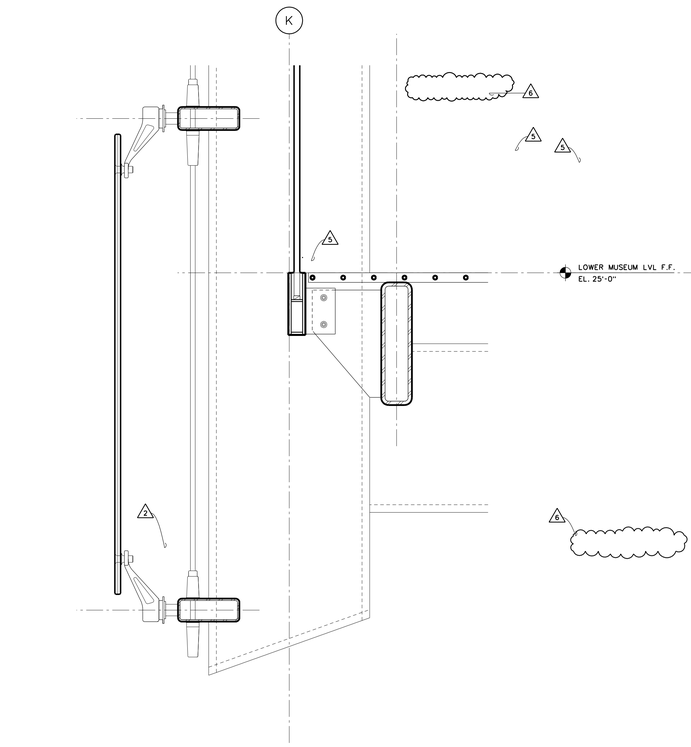


WALL SYSTEM E: DETAIL SECTION AT LOWER GRATING

SCALE: 1-1/2" = 1'-0" D-CWDE01 12

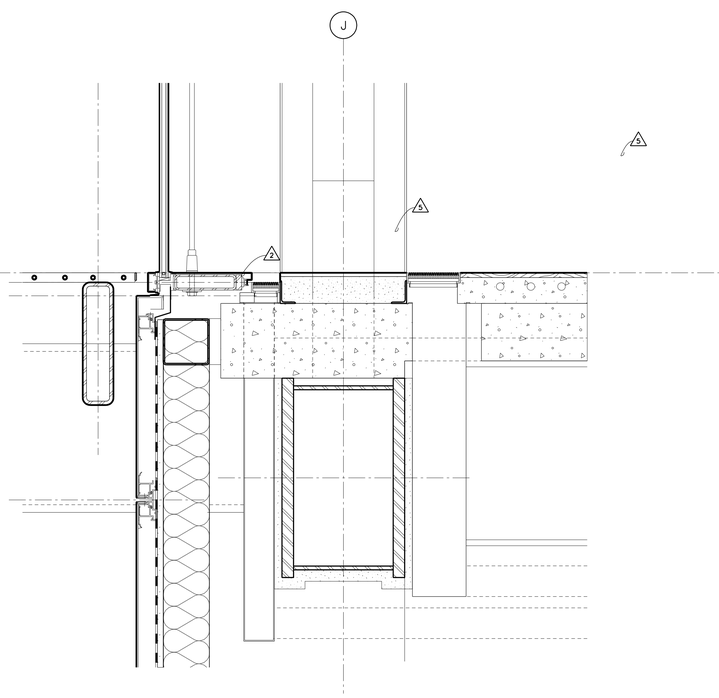

WALL SYSTEM D: DETAIL SECTION AT WEST SILL

SCALE: 1-1/2 " = 1'-0" D-CWDE01 11

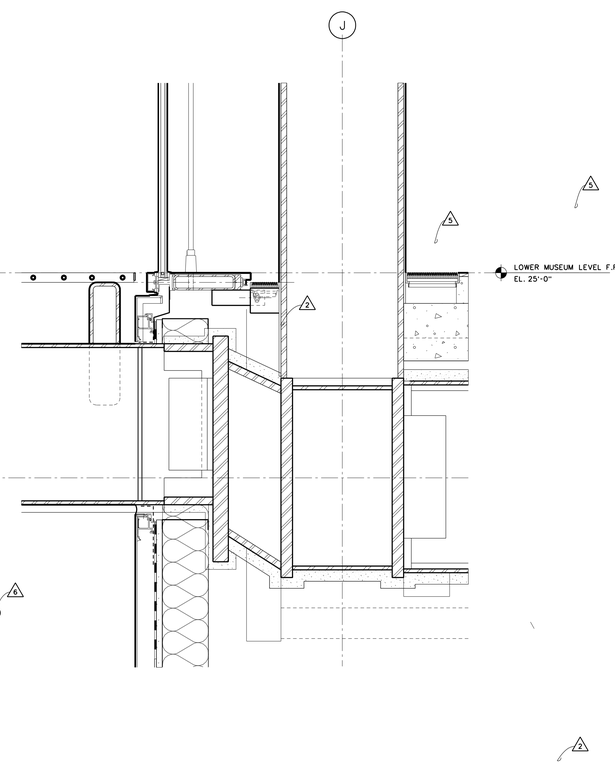

WALL SYSTEM D: SECTION AT WEST SILL @ 30' MODULE

SCALE: 1-1/2 " = 1'-0" D-CWDE01 10

WILLIAM J. CLINTON PRESIDENTIAL CENTER

LITTLE ROCK, ARKANSAS

Architect

POLSHEK PARTNERSHIP LLP
320 West 13th Street
New York, New York 10014
212.807.7171

Coordinating Architects

POLK STANLEY YEARY ARCHITECTS Ltd
700 South Schiller Street
Little Rock, Arkansas 72201
501.378.0878

WITSELL EVANS RASCO
901 West Third Street
Little Rock, Arkansas 72201
501.374.5300

WOODS CARADINE ARCHITECTS
2200 South Main Street
Little Rock, Arkansas 72206
501.374.4060

Landscape Architects

HARGREAVES ASSOCIATES
118 Magazine Street
Cambridge, Massachusettes 02139
617.661.0070

LANDSCAPE ARCHITECTURE, Inc.
2300 Cottondale Lane Suite 202
Little Rock, Arkansas 72202
501.374.5610

Structural Engineer

LESLIE E. ROBERTSON ASSOC., RLLP
30 Bread Street, 47th Floor
New York, New York 10004
212.750.9000

MEP Engineers

FLACK + KURTZ Inc.
475 Fifth Avenue
New York, New York 10017
212.532.9600


CROMWELL ARCHITECTS ENGINEERS
101 South Spring Street
Little Rock, Arkansas 72201
501.372.2900

Curtainwall Consultant

R. A. HEINTGES ARCHITECTS
126 Fifth Avenue, 9th Floor
New York, New York 10011
212.652-2966

Seal

6	ASI #22	08/01/03
5	ASI #20	06/06/03
4	ASI #19	05/07/03
3	Addendum #2	11/15/02
2	100% Construction Documents	09/27/02
1	90% Progress Printing	08/30/02
	100% Struct./ CD Progress	07/01/02
	100% Design Development	03/01/02
	Issue	Date

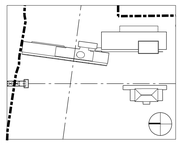

Job No.
9908


Scale
1-1/2" = 1'-0"

Date
September 27, 2002

Title
WALL SYSTEMS D AND E DETAIL SECTIONS


Sheet No.
A365

FOR OFFICIAL USE ONLY

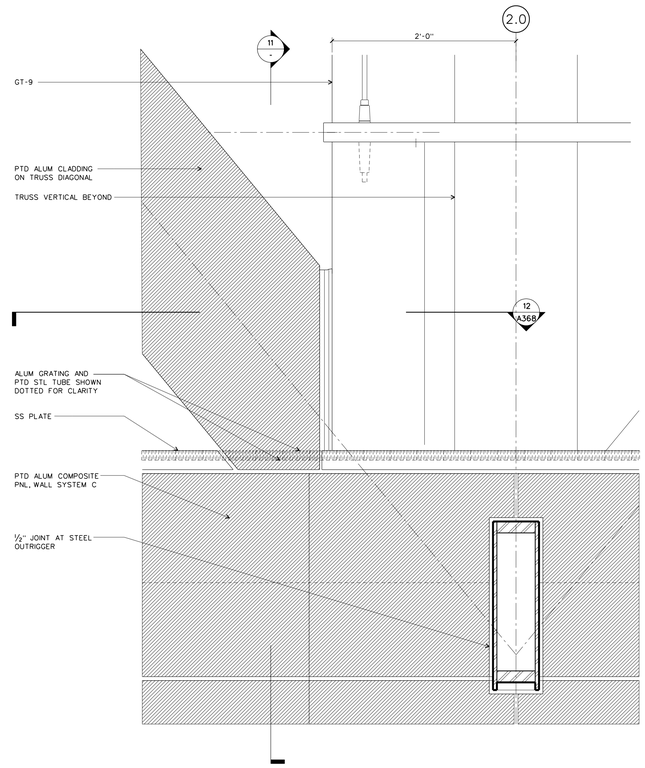


WALL SYSTEM D: ELEVATION OF SILL AT TRUSS

SCALE: 1-1/2 " = 1'-0" D-CWD01 20

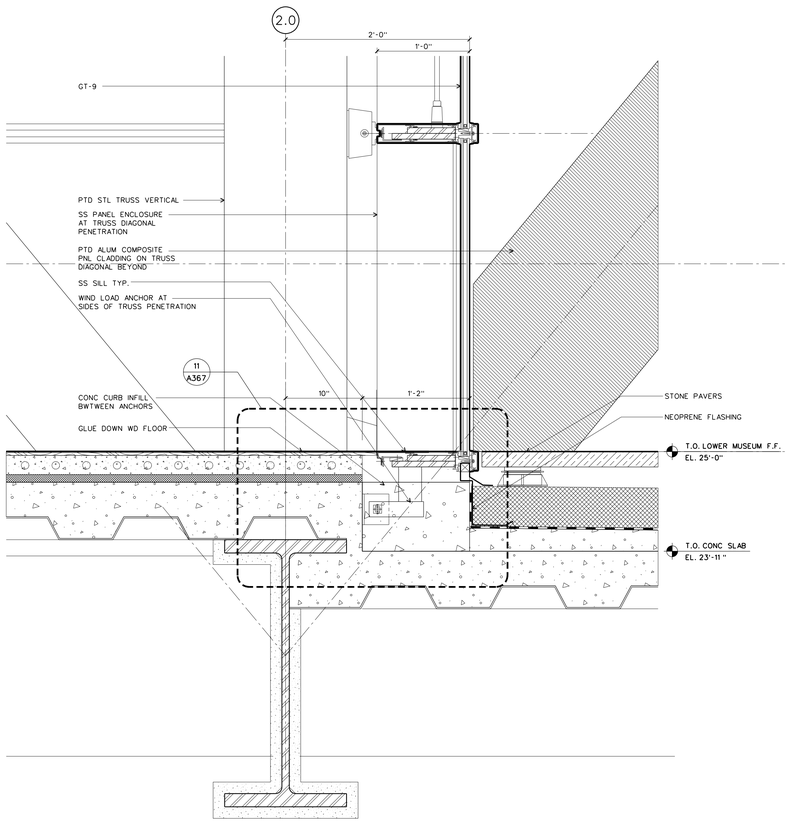


WALL SYSTEM D: SECTION OF SILL AT NORTH WALL

SCALE: 1-1/2" = 1'-0" D-CWD01 12

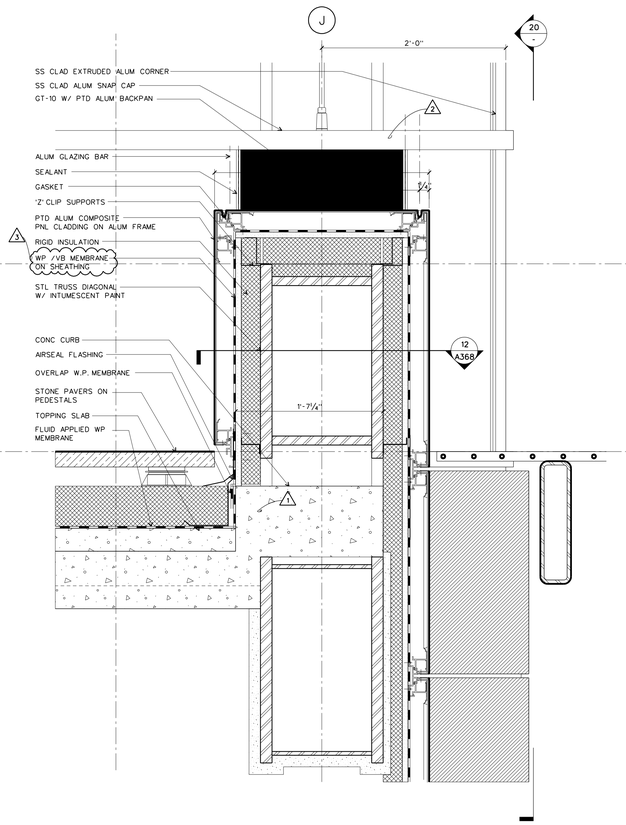

WALL SYSTEM D: SECTION AT TRUSS DIAGONAL

SCALE: 1-1/2" = 1'-0" D-CWD01 11

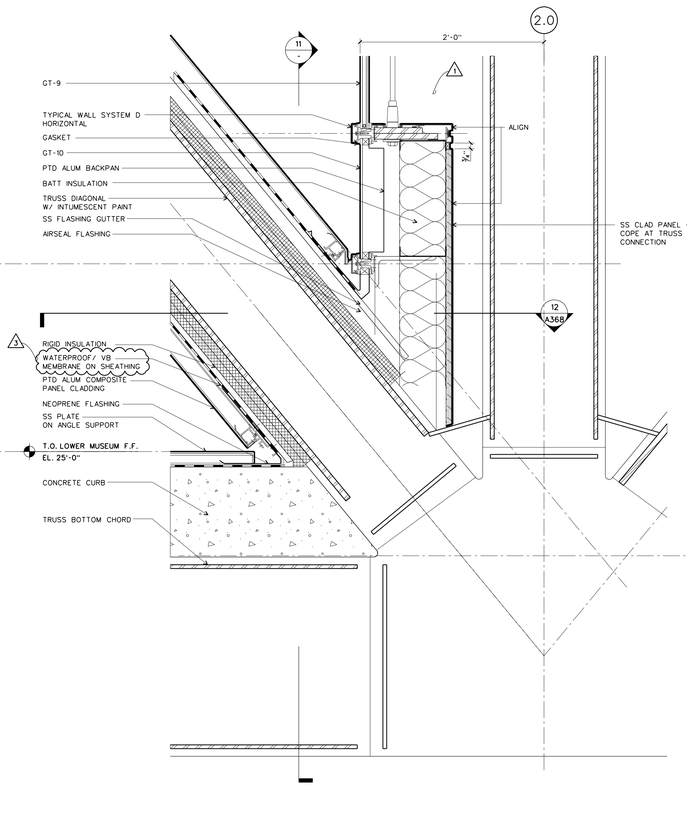

WALL SYSTEM D: SECTION OF SILL AT TRUSS

SCALE: 1-1/2 " = 1'-0" D-CWD01 10

WILLIAM J. CLINTON PRESIDENTIAL CENTER

LITTLE ROCK, ARKANSAS

Architect

POLSHEK PARTNERSHIP LLP
320 West 13th Street
New York, New York 10014
212.807.7171

Coordinating Architects

POLK STANLEY YEARY ARCHITECTS Ltd
700 South Schiller Street
Little Rock, Arkansas 72201
501.378.0878

WITSELL EVANS RASCO
901 West Third Street
Little Rock, Arkansas 72201
501.374.5300

WOODS CARADINE ARCHITECTS
2200 South Main Street
Little Rock, Arkansas 72206
501.374.4060

Landscape Architects

HARGREAVES ASSOCIATES
118 Magazine Street
Cambridge, Massachusettes 02139
617.661.0070

LANDSCAPE ARCHITECTURE, Inc.
2300 Cottondale Lane Suite 202
Little Rock, Arkansas 72202
501.374.5610

Structural Engineer

LESLIE E. ROBERTSON ASSOC., RLLP
30 Broad Street, 47th Floor
New York, New York 10004
212.750.9000

MEP Engineers

FLACK + KURTZ Inc.
475 Fifth Avenue
New York, New York 10017
212.532.9600

CROMWELL ARCHITECTS ENGINEERS
101 South Spring Street
Little Rock, Arkansas 72201
501.372.2900

Curtainwall Consultant

R. A. HEINTGES ARCHITECTS
126 Fifth Avenue, 9th Floor
New York, New York 10011
212.652-2966

Seal

Issue	Date
1 ASI #22	08/01/03
2 Addendum #2	11/15/02
1 100% Construction Documents	09/27/02
90% Progress Printing	08/30/02
100% Struct./ CD Progress	07/01/02
100% Design Development	03/01/02

Job No. 9908

Scale 1-1/2" = 1'-0"


Date September 27, 2002

Title

WALL SYSTEMS D SECTION DETAILS


Sheet No. A366

FOR OFFICIAL USE ONLY

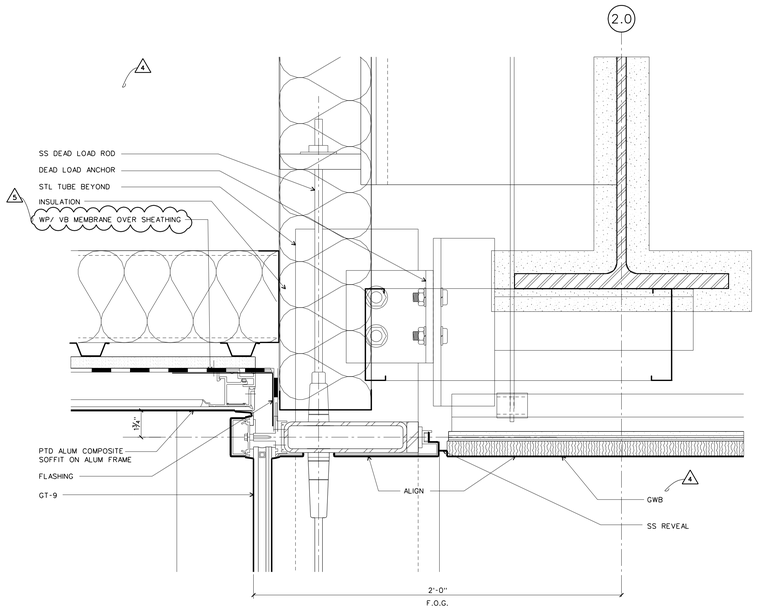


WALL SYSTEM D: SECTION AT NORTH END HEAD

SCALE: 3" = 1'-0" D-CWDE02 **32**

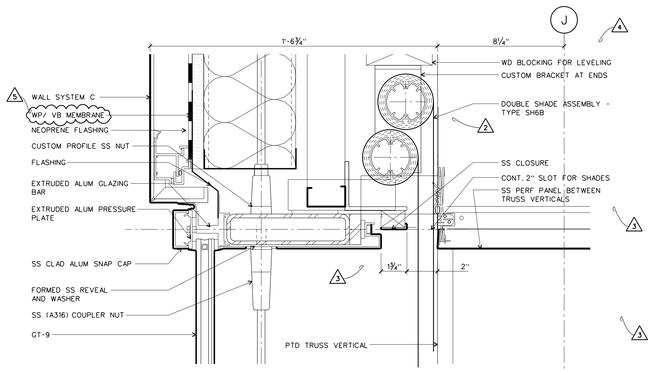


WALL SYSTEM D: SECTION AT HEAD AT 30' MODULE

SCALE: 3" = 1'-0" D-CWDE02 **41**

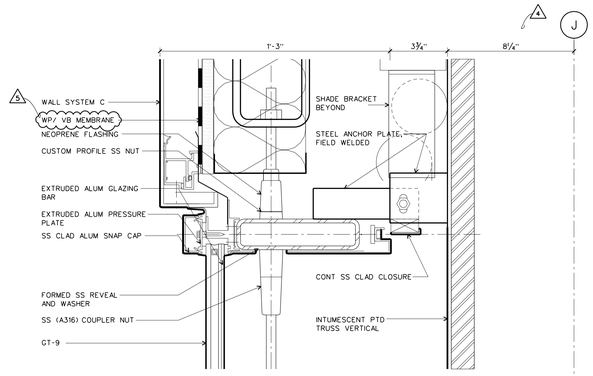


WALL SYSTEM D: DETAIL SECTION AT HEAD

SCALE: 3" = 1'-0" D-CWDE02 **40**

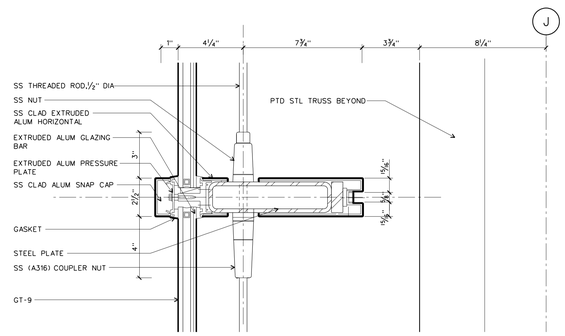


WALL SYSTEM D: SECTION AT TYPICAL HORIZONTAL

SCALE: 3" = 1'-0" D-CWDE02 **31**

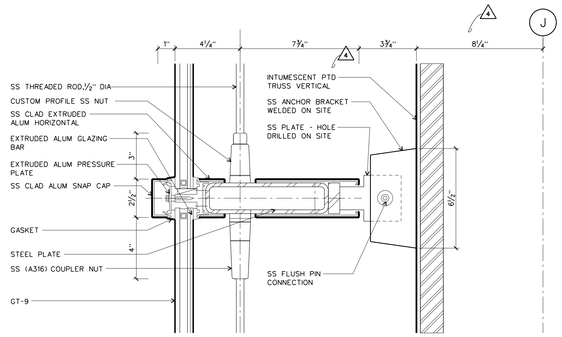


WALL SYSTEM D: DETAIL SECTION AT ANCHOR

SCALE: 3" = 1'-0" D-CWDE02 **30**

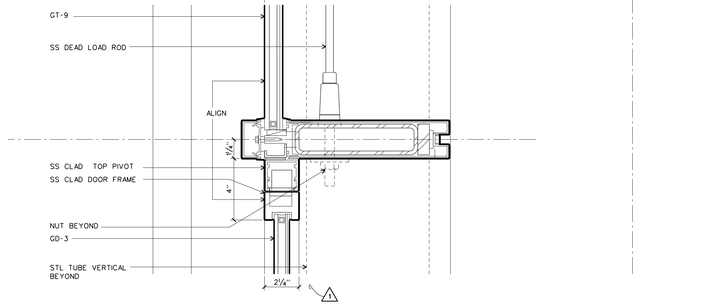


WALL SYSTEM D: SECTION AT NORTH END DOOR

SCALE: 3" = 1'-0" D-CWDE02 **22**

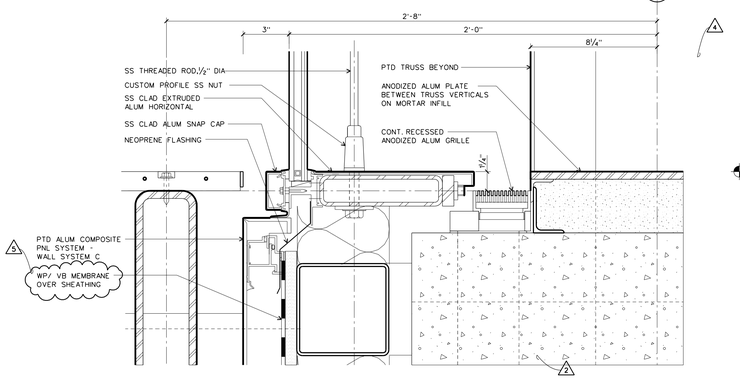


WALL SYSTEM D: SECTION AT SILL AT 30' MODULE

SCALE: 3" = 1'-0" D-CWDE02 **21**

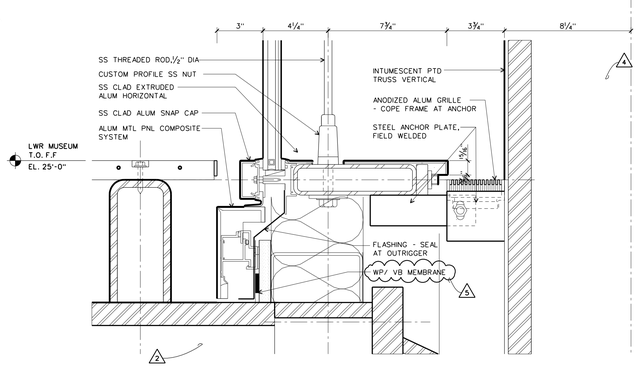


WALL SYSTEM D: DETAIL SECTION AT SILL

SCALE: 3" = 1'-0" D-CWDE02 **20**

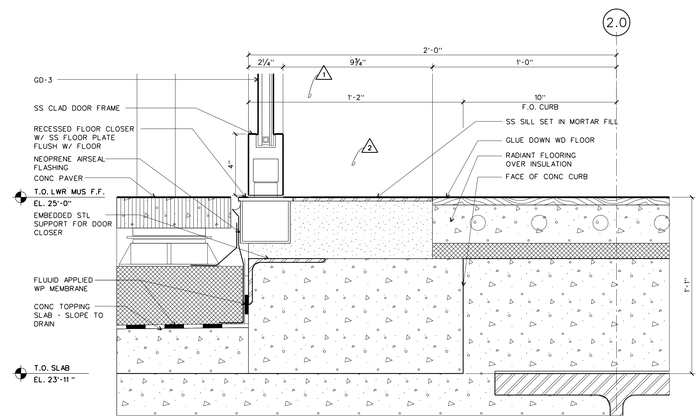

WALL SYSTEM D: SECTION AT NORTH END DOOR SILL

SCALE: 3" = 1'-0" D-CWDE02 **12**

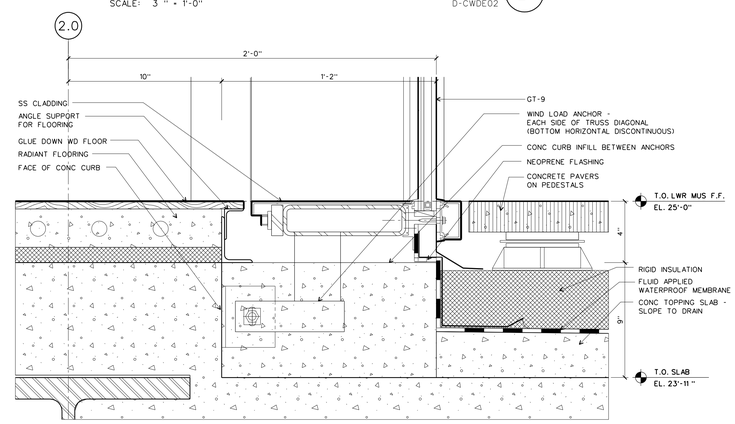

WALL SYSTEM D: SECTION AT SILL NORTH END

SCALE: 3" = 1'-0" D-CWDE02 **11**

WILLIAM J. CLINTON PRESIDENTIAL CENTER

LITTLE ROCK, ARKANSAS

Architect

POLSHEK PARTNERSHIP LLP
320 West 13th Street
New York, New York 10014
212.807.7171

Coordinating Architects

POLK STANLEY YEARY ARCHITECTS Ltd
700 South Schiller Street
Little Rock, Arkansas 72201
501.378.0878

WITSELL EVANS RASCO
901 West Third Street
Little Rock, Arkansas 72201
501.374.5300

WOODS CARADINE ARCHITECTS
2200 South Main Street
Little Rock, Arkansas 72206
501.374.4060

Landscape Architects

HARGREAVES ASSOCIATES
118 Magazine Street
Cambridge, Massachusettes 02139
617.661.0070

LANDSCAPE ARCHITECTURE, Inc.
2300 Cottondale Lane Suite 202
Little Rock, Arkansas 72202
501.374.5610

Structural Engineer

LESLIE E. ROBERTSON ASSOC., RLLP
30 Broad Street, 47th Floor
New York, New York 10004
212.750.9000

MEP Engineers

FLACK + KURTZ Inc.
475 Fifth Avenue
New York, New York 10017
212.532.9600


CROMWELL ARCHITECTS ENGINEERS
101 South Spring Street
Little Rock, Arkansas 72201
501.372.2900

Curtainwall Consultant

R. A. HEINTGES ARCHITECTS
126 Fifth Avenue, 9th Floor
New York, New York 10011
212.652-2966

Seal

5	ASI #22	08/01/03
4	ASI #20	06/06/03
3	Addendum #2	11/15/02
2	100% Construction Documents	09/27/02
1	90% Progress Printing	08/30/02
	100% Struct./ CD Progress	07/01/02
	100% Design Development	03/01/02
	Issue	Date

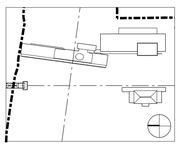

Job No. 9908

Scale 3" = 1'-0"

Date September 27, 2002


Title

WALL SYSTEMS D SECTION DETAILS

Sheet No.


A367

FOR OFFICIAL USE ONLY

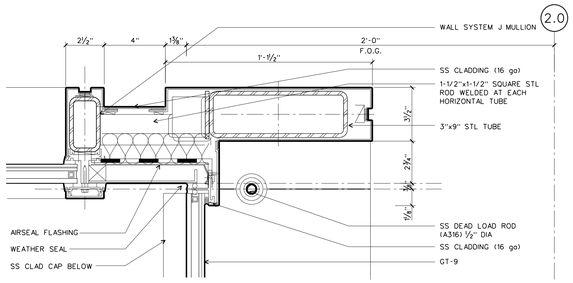


WALL SYSTEM D/J: PLAN ABOVE DOOR JAMB

SCALE: 3 " = 1'-0" D-CWDE03 **33**

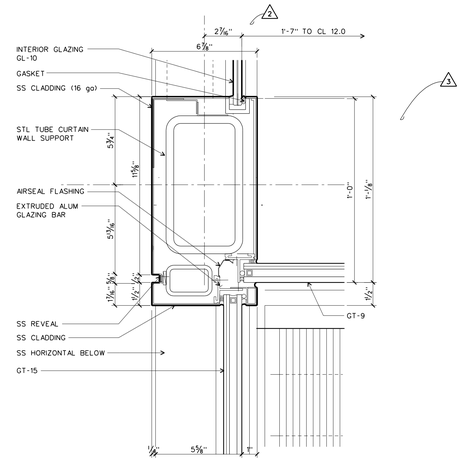


WALL SYSTEM D/K: PLAN DETAIL ABOVE DOOR

SCALE: 3 " = 1'-0" D-CWDE03 **42**

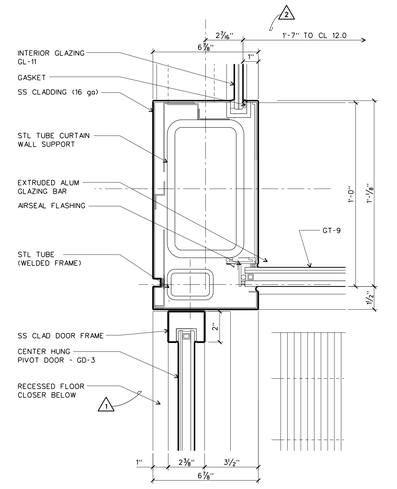

WALL SYSTEM D/K: PLAN DETAIL AT DOOR

SCALE: 3 " = 1'-0" D-CWDE03 **41**

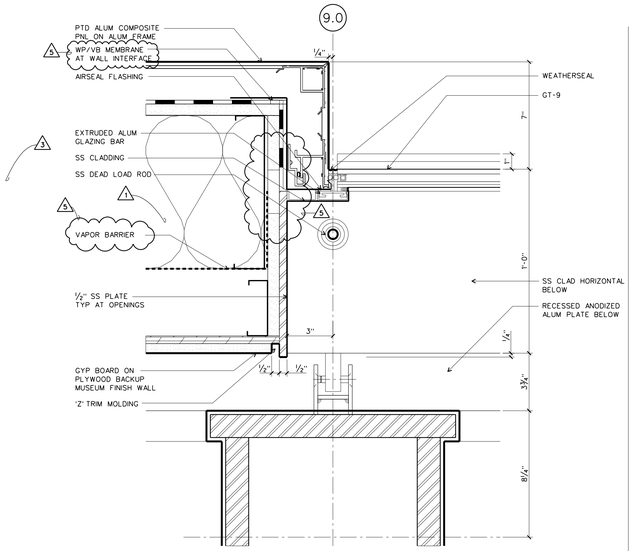

WALL SYSTEM D: PLAN DETAIL AT METAL PANEL

SCALE: 3 " = 1'-0" D-CWDE03 **40**

WALL SYSTEM D/J: PLAN DETAIL AT DOOR JAMB

SCALE: 3 " = 1'-0" D-CWDE03 **23**

WALL SYSTEM D: PLAN DETAIL AT CORNER

SCALE: 3 " = 1'-0" D-CWDE03 **22**

WALL SYSTEM D: PLAN AT DEAD LOAD SUPPORT


SCALE: 3 " = 1'-0" D-CWDE03 **21**

WALL SYSTEM D: PLAN DETAIL AT TRUSS VERTICAL

SCALE: 3 " = 1'-0" D-CWDE03 **20**


WALL SYSTEM D: PLAN DETAIL AT DOOR JAMB

SCALE: 3" = 1'-0" D-CWDE03 **13**

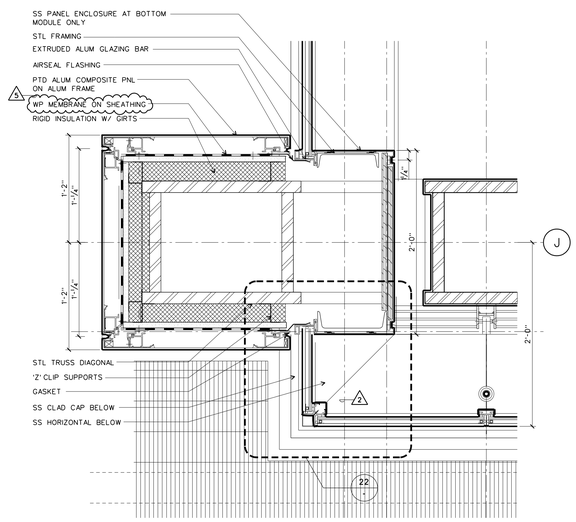


WALL SYSTEM D: PLAN DETAIL AT METAL PANEL

SCALE: 1-1/2" = 1'-0" D-CWDE03 **12**

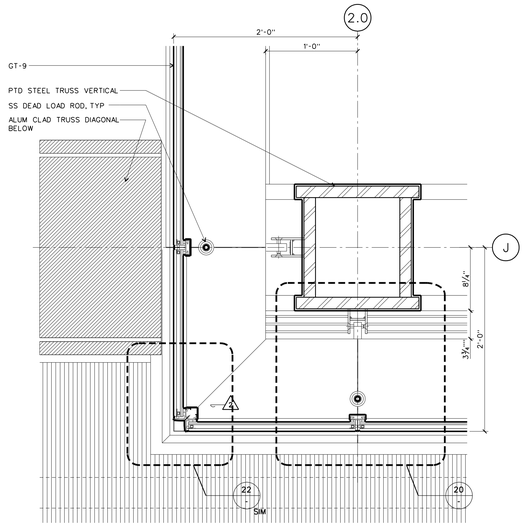

WALL SYSTEM D: PLAN AT CORNER

SCALE: 1-1/2 " = 1'-0" D-CWDE03 **11**

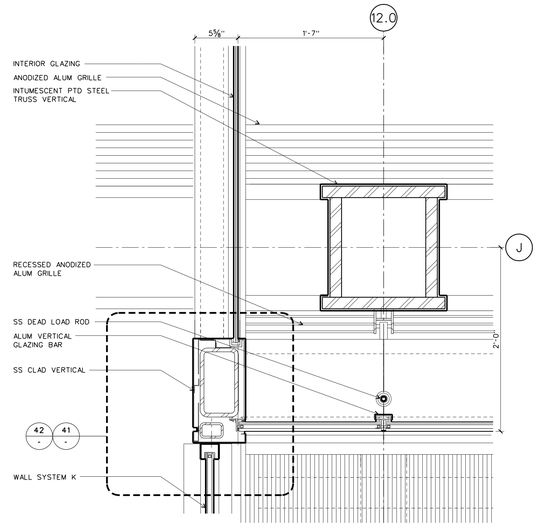

WALL SYSTEM D/K: PLAN AT ESCALATOR

SCALE: 1-1/2 " = 1'-0" D-CWDE03 **10**

WILLIAM J. CLINTON PRESIDENTIAL CENTER

LITTLE ROCK, ARKANSAS

Architect

POLSHEK PARTNERSHIP LLP
320 West 13th Street
New York, New York 10014
212.807.7171

Coordinating Architects

POLK STANLEY YEARY ARCHITECTS Ltd
700 South Schiller Street
Little Rock, Arkansas 72201
501.378.0878

WITSELL EVANS RASCO
901 West Third Street
Little Rock, Arkansas 72201
501.374.5300

WOODS CARADINE ARCHITECTS
2200 South Main Street
Little Rock, Arkansas 72206
501.374.4060

Landscape Architects

HARGREAVES ASSOCIATES
118 Magazine Street
Cambridge, Massachusettes 02139
617.661.0070

LANDSCAPE ARCHITECTURE, Inc.
2300 Cottondale Lane Suite 202
Little Rock, Arkansas 72202
501.374.5610

Structural Engineer

LESLIE E. ROBERTSON ASSOC., RLLP
30 Broad Street, 47th Floor
New York, New York 10004
212.750.9000

MEP Engineers

FLACK + KURTZ Inc.
475 Fifth Avenue
New York, New York 10017
212.532.9600

CROMWELL ARCHITECTS ENGINEERS
101 South Spring Street
Little Rock, Arkansas 72201
501.372.2900

Curtainwall Consultant

R. A. HEINTGES ARCHITECTS
126 Fifth Avenue, 9th Floor
New York, New York 10011
212.652-2966

Seal

5	ASI #22	08/01/03
4	ASI #20	06/06/03
3	Addendum #2	11/15/02
2	100% Construction Documents	09/27/02
1	90% Progress Printing	08/30/02
	100% Struct./ CD Progress	07/01/02
	100% Design Development	03/01/02
	Issue	Date

Job No. 9908

Scale AS NOTED

Date September 27, 2002


Title

WALL SYSTEMS D PLAN DETAILS

Sheet No.


A368

FOR OFFICIAL USE ONLY

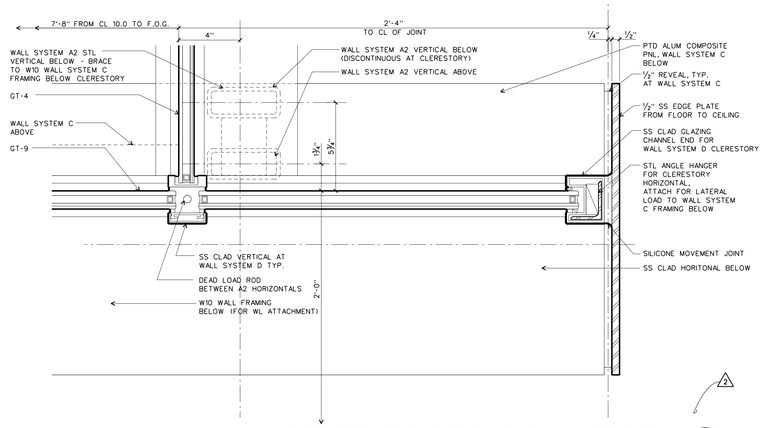


WALL SYSTEM D: PLAN DETAIL AT CLERESTORY

SCALE: 3 " = 1'-0" D-CWD02 **30**

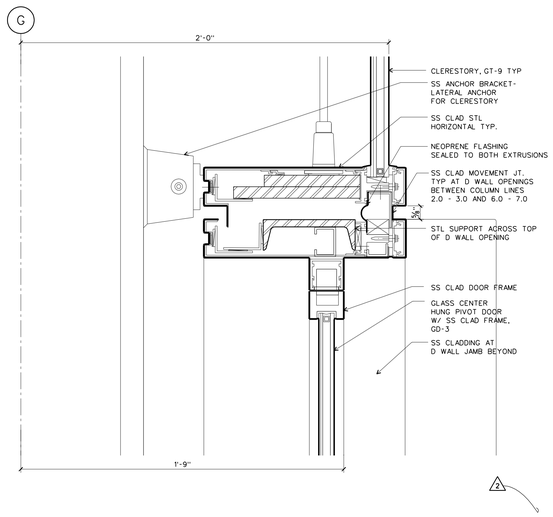


WALL SYSTEM D: DETAIL AT DOOR HEAD/ MOVE JT

SCALE: 3" = 1'-0" D-CWD02 **22**

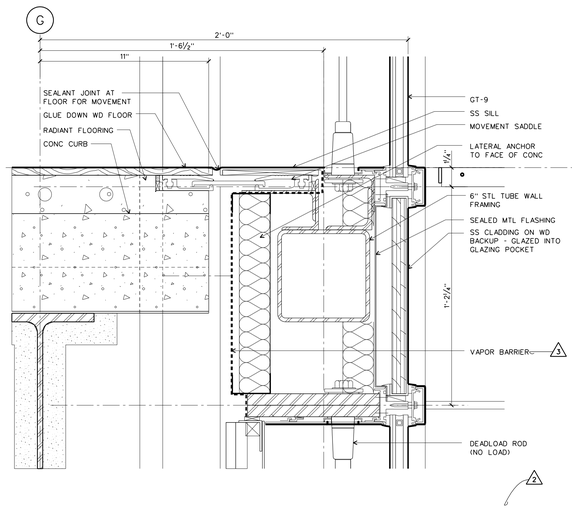


WALL SYSTEM D: SECTION AT CLERESTORY SILL

SCALE: 3 " = 1'-0" D-CWD02 **21**

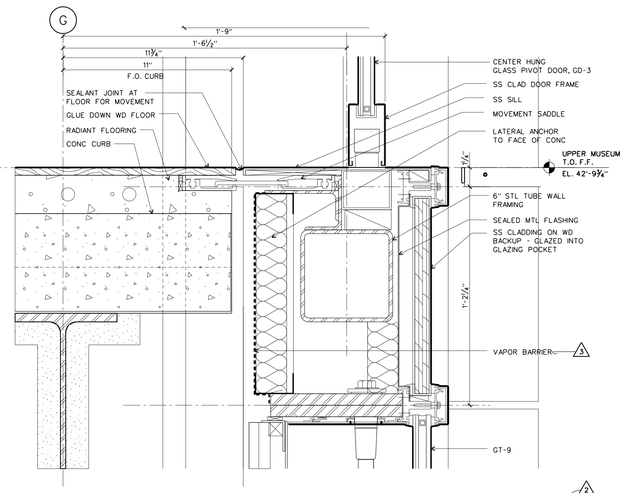


WALL SYSTEM D: EAST ELEVATION SILL

SCALE: 3 " = 1'-0" D-CWD02 **20**

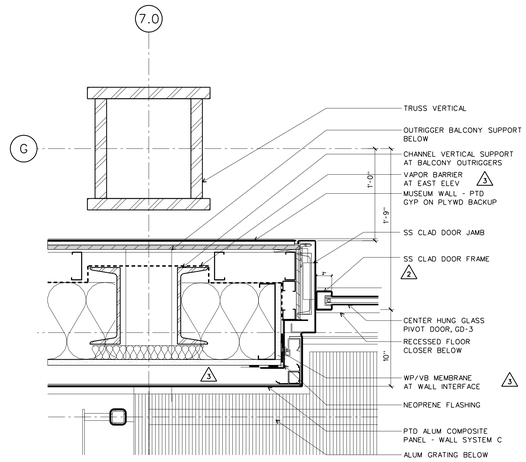


WALL SYSTEM D: PLAN DETAIL AT DOOR JAMB

SCALE: 1-1/2 " = 1'-0" D-CWD02 **13**

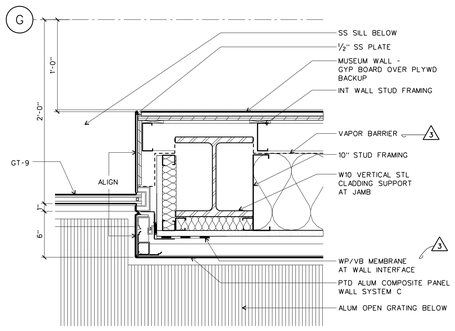


WALL SYSTEM D: PLAN DETAIL AT JAMB

SCALE: 1-1/2 " = 1'-0" D-CWD02 **12**

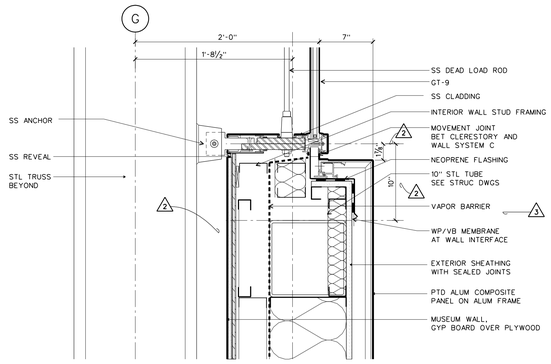

WALL SYSTEM D: SECTION AT CLERESTORY SILL

SCALE: 1-1/2 " = 1'-0" D-CWD02 **11**

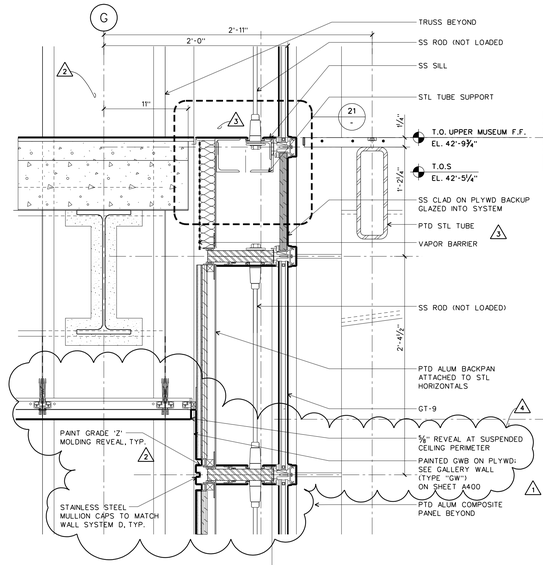

WALL SYSTEM D: EAST ELEVATION SILL

SCALE: 1-1/2 " = 1'-0" D-CWD02 **10**

WILLIAM J. CLINTON PRESIDENTIAL CENTER

LITTLE ROCK, ARKANSAS

Architect

POLSHEK PARTNERSHIP LLP
320 West 13th Street
New York, New York 10014
212.807.7171

Coordinating Architects

POLK STANLEY YEARY ARCHITECTS Ltd
700 South Schiller Street
Little Rock, Arkansas 72201
501.378.0878

WITSELL EVANS RASCO
901 West Third Street
Little Rock, Arkansas 72201
501.374.5300

WOODS CARADINE ARCHITECTS
2200 South Main Street
Little Rock, Arkansas 72206
501.374.4060

Landscape Architects

HARGREAVES ASSOCIATES
118 Magazine Street
Cambridge, Massachusettes 02139
617.661.0070

LANDSCAPE ARCHITECTURE, Inc.
2300 Cottondale Lane Suite 202
Little Rock, Arkansas 72202
501.374.5610

Structural Engineer

LESLIE E. ROBERTSON ASSOC., RLLP
30 Broad Street, 47th Floor
New York, New York 10004
212.750.9000

MEP Engineers

FLACK + KURTZ Inc.
475 Fifth Avenue
New York, New York 10017
212.532.9600

CROMWELL ARCHITECTS ENGINEERS
101 South Spring Street
Little Rock, Arkansas 72201
501.372.2900

Curtainwall Consultant

R. A. HEINTGES ARCHITECTS
126 Fifth Avenue, 9th Floor
New York, New York 10011
212.652-2966

Seal

Issue	Date
1 ASI #25	12/19/03
1 ASI #22	08/01/03
2 Addendum #2	11/15/02
1 90% Progress Printing	08/30/02

Job No. 9908


Scale: AS NOTED

Date: September 27, 2002

Title: WALL SYSTEMS D MISC DETAILS


Sheet No. **A368a**

FOR OFFICIAL USE ONLY

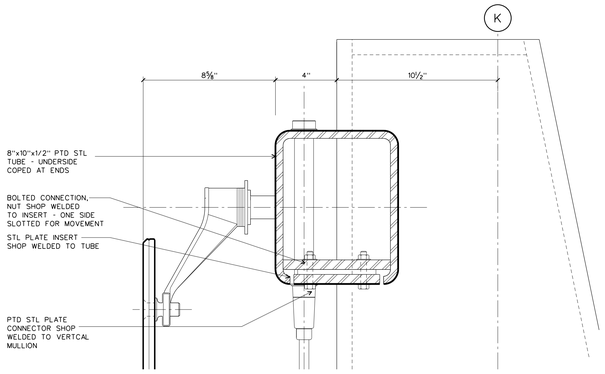


WALL SYSTEM E: SECTION AT VERTICAL

SCALE: 3 " = 1'-0" D-CWDE04 41

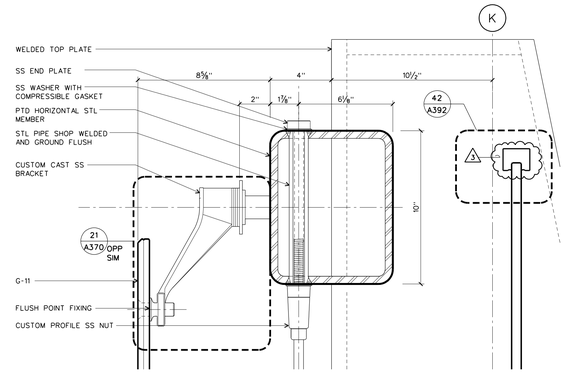


WALL SYSTEM E: SECTION AT TOP HORIZONTAL

SCALE: 3 " = 1'-0" D-CWDE04 40

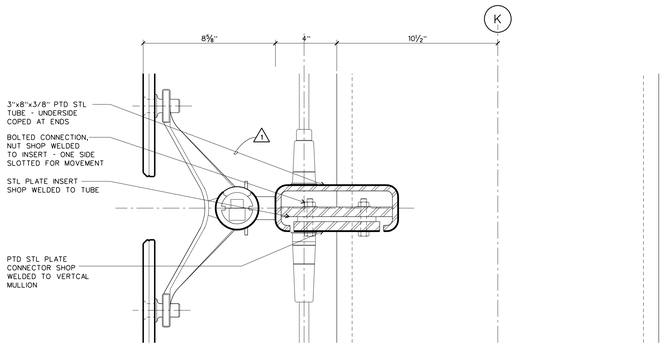


WALL SYSTEM E: SECTION AT VERTICAL

SCALE: 3 " = 1'-0" D-CWDE04 31

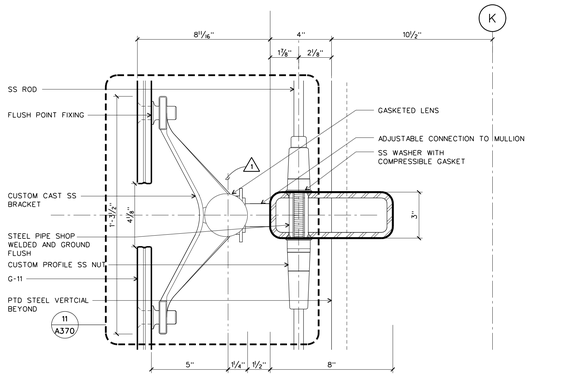


WALL SYSTEM E: SECTION AT TYP HORIZONTAL

SCALE: 3 " = 1'-0" D-CWDE04 30

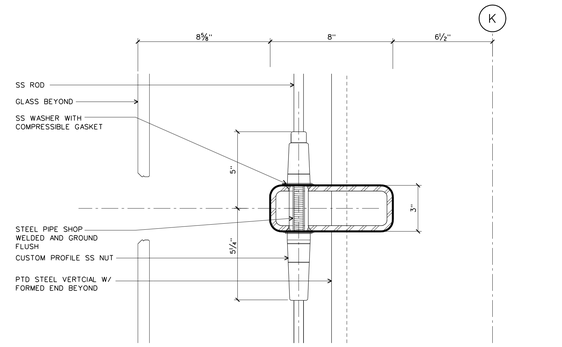


WALL SYSTEM E: SECTION AT HORIZONTAL

SCALE: 3 " = 1'-0" D-CWDE04 20

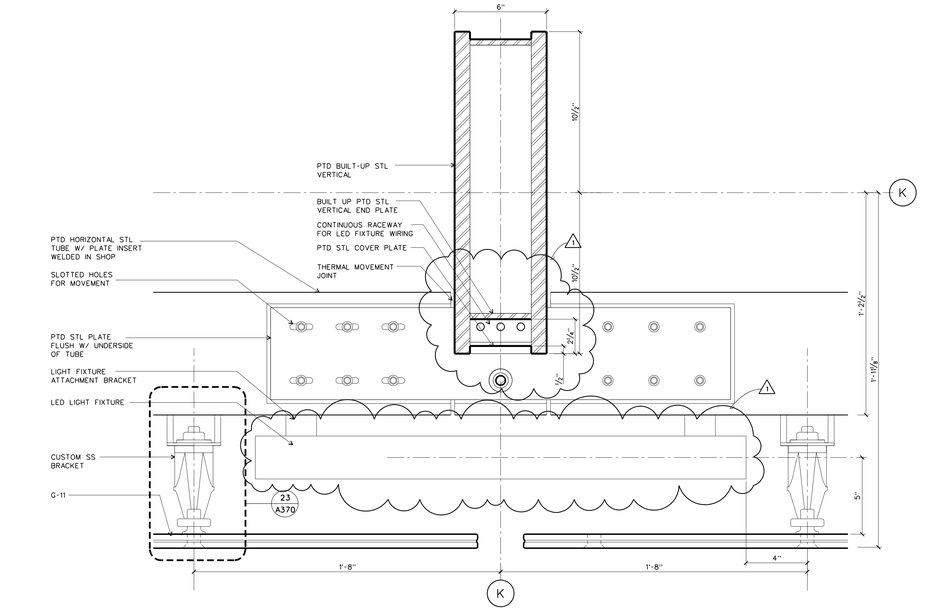


WALL SYSTEM E: REFLECTED PLAN DETAIL AT VERTICAL

SCALE: 3 " = 1'-0" D-CWDE04 12

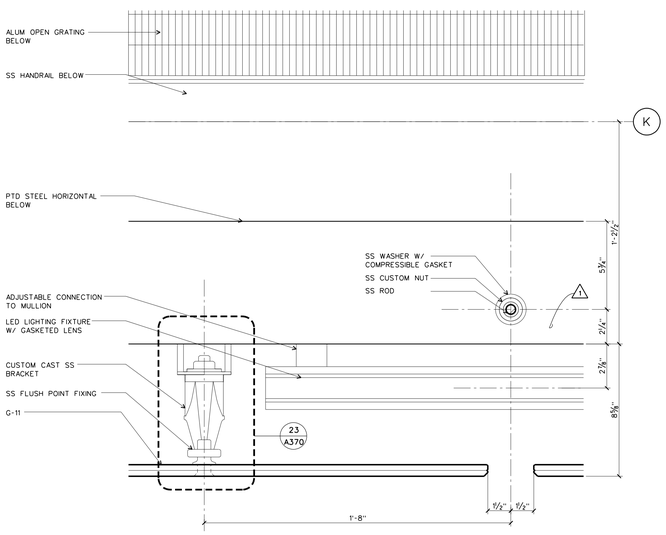

WALL SYSTEM E: PLAN DETAIL AT BRACKET

SCALE: 3 " = 1'-0" D-CWDE04 11

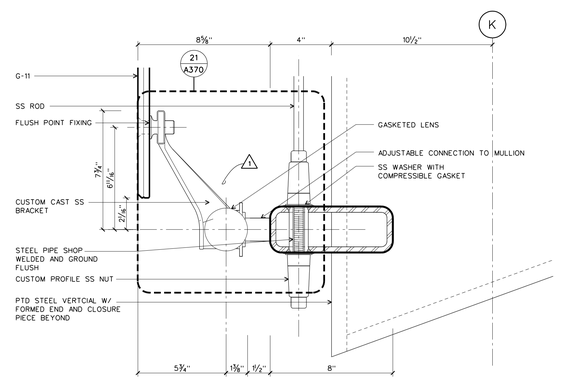

WALL SYSTEM E: SECTION AT BOTTOM HORIZONTAL

SCALE: 3 " = 1'-0" D-CWDE04 10

WILLIAM J. CLINTON PRESIDENTIAL CENTER

LITTLE ROCK, ARKANSAS

Architect

POLSHEK PARTNERSHIP LLP
320 West 13th Street
New York, New York 10014
212.807.7171

Coordinating Architects

POLK STANLEY YEARY ARCHITECTS Ltd
700 South Schiller Street
Little Rock, Arkansas 72201
501.378.0878

WITSELL EVANS RASCO
901 West Third Street
Little Rock, Arkansas 72201
501.374.5300

WOODS CARADINE ARCHITECTS
2200 South Main Street
Little Rock, Arkansas 72206
501.374.4060

Landscape Architects

HARGREAVES ASSOCIATES
118 Magazine Street
Cambridge, Massachusettes 02139
617.661.0070

LANDSCAPE ARCHITECTURE, Inc.
2300 Cottondale Lane Suite 202
Little Rock, Arkansas 72202
501.374.5610

Structural Engineer

LESLIE E. ROBERTSON ASSOC., RLLP
30 Broad Street, 47th Floor
New York, New York 10004
212.750.9000

MEP Engineers

FLACK + KURTZ Inc.
475 Fifth Avenue
New York, New York 10017
212.532.9600

CROMWELL ARCHITECTS ENGINEERS
101 South Spring Street
Little Rock, Arkansas 72201
501.372.2900

Curtainwall Consultant

R. A. HEINTGES ARCHITECTS
126 Fifth Avenue, 9th Floor
New York, New York 10011
212.652-2966

Seal

Issue	Date
1 100% Construction Documents	09/27/02
90% Progress Printing	08/30/02
100% Struct./ CD Progress	07/01/02
100% Design Development	03/01/02

Job No. 9908

Scale AS NOTED

Date September 27, 2002


Title

WALL SYSTEM E
PLAN AND SECTION DETAILS

Sheet No.


A369

FOR OFFICIAL USE ONLY

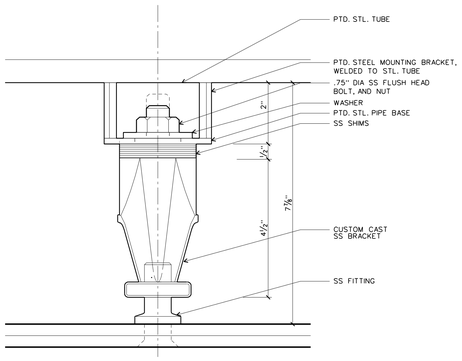


WALL SYSTEM E: BRACKET, PLAN DETAIL

SCALE: 6 " = 1'-0" D-CWDE05 23

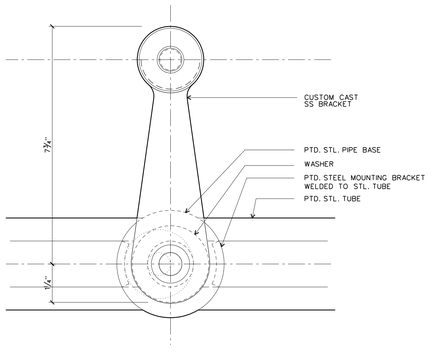


WALL SYSTEM E: BRACKET, FRONT ELEVATION

SCALE: 6 " = 1'-0" D-CWDE05 22

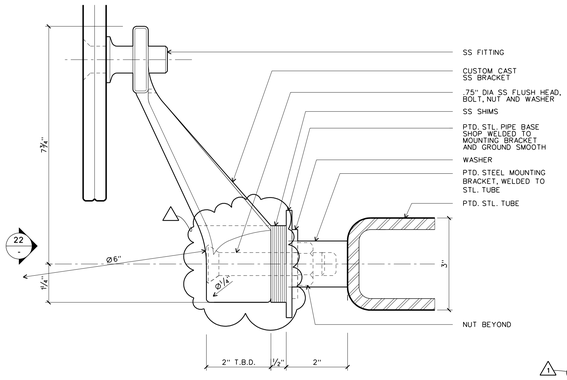


WALL SYSTEM E: BRACKET, SIDE ELEVATION

SCALE: 6 " = 1'-0" D-CWDE05 21

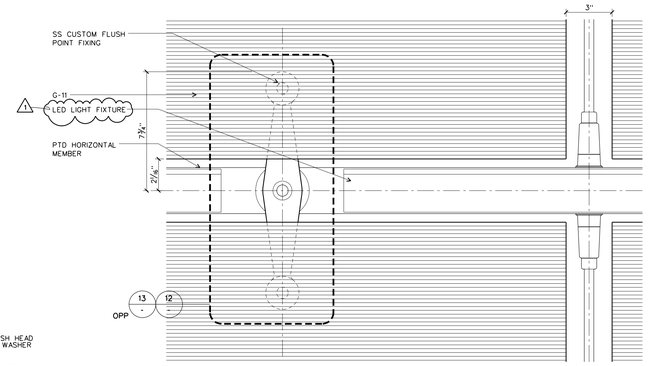


WALL SYSTEM E: ELEVATION DETAIL

SCALE: 3 " = 1'-0" D-CWDE05 20

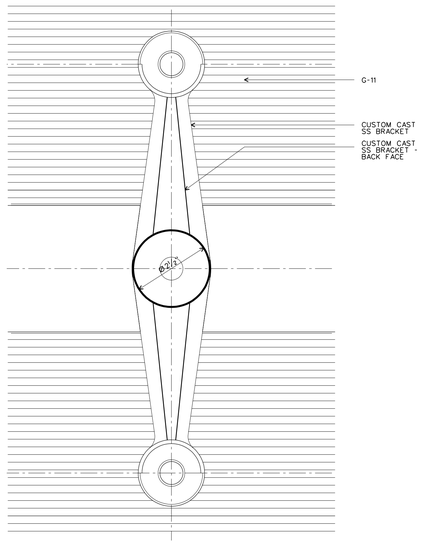


WALL SYSTEM E: BRACKET, BACK ELEVATION

SCALE: 6 " = 1'-0" D-CWDE05 13

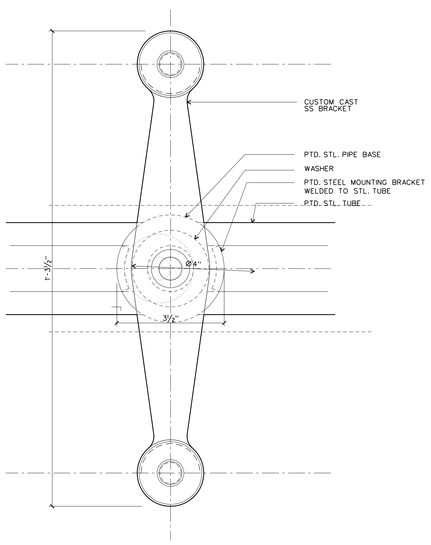


WALL SYSTEM E: BRACKET FRONT ELEVATION

SCALE: 6 " = 1'-0" D-CWDE05 12

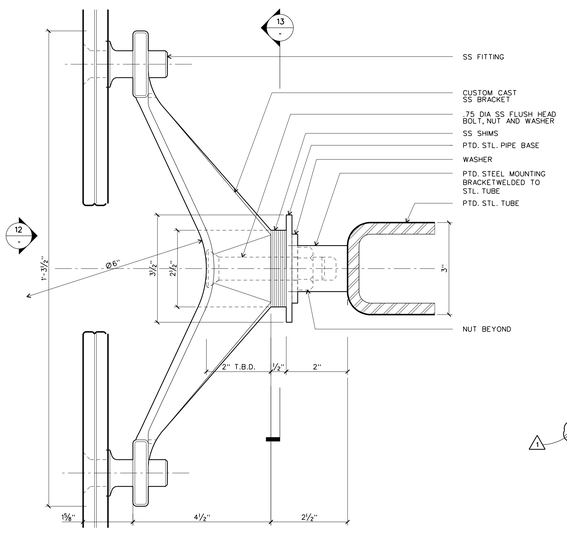

WALL SYSTEM E: BRACKET, SIDE ELEVATION

SCALE: 6 " = 1'-0" D-CWDE05 11

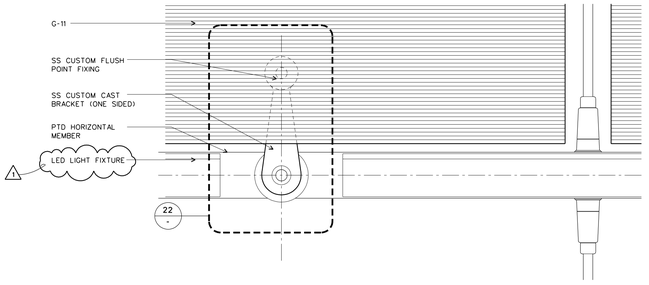

WALL SYSTEM E: ELEVATION DETAIL

SCALE: 3 " = 1'-0" D-CWDE05 10

WILLIAM J. CLINTON PRESIDENTIAL CENTER

LITTLE ROCK, ARKANSAS

Architect

POLSHEK PARTNERSHIP LLP
320 West 13th Street
New York, New York 10014
212.807.7171

Coordinating Architects

POLK STANLEY YEARY ARCHITECTS Ltd
700 South Schiller Street
Little Rock, Arkansas 72201
501.378.0878

WITSELL EVANS RASCO
901 West Third Street
Little Rock, Arkansas 72201
501.374.5300

WOODS CARADINE ARCHITECTS
2200 South Main Street
Little Rock, Arkansas 72206
501.374.4060

Landscape Architects

HARGREAVES ASSOCIATES
118 Magazine Street
Cambridge, Massachusettes 02139
617.661.0070

LANDSCAPE ARCHITECTURE, Inc.
2300 Cottondale Lane Suite 202
Little Rock, Arkansas 72202
501.374.5610

Structural Engineer

LESLIE E. ROBERTSON ASSOC., RLLP
30 Broad Street, 47th Floor
New York, New York 10004
212.750.9000

MEP Engineers

FLACK + KURTZ Inc.
475 Fifth Avenue
New York, New York 10017
212.532.9600

CROMWELL ARCHITECTS ENGINEERS
101 South Spring Street
Little Rock, Arkansas 72201
501.372.2900

Curtainwall Consultant

R. A. HEINTGES ARCHITECTS
126 Fifth Avenue, 9th Floor
New York, New York 10011
212.652-2966

Seal

Issue	Date
1 100% Construction Documents	09/27/02
90% Progress Printing	08/30/02
100% Struct./ CD Progress	07/01/02
100% Design Development	03/01/02

Job No. 9908

Scale AS NOTED

Date September 27, 2002


Title

WALL SYSTEM E PLAN AND SECTION DETAILS

Sheet No.

A370


FOR OFFICIAL USE ONLY

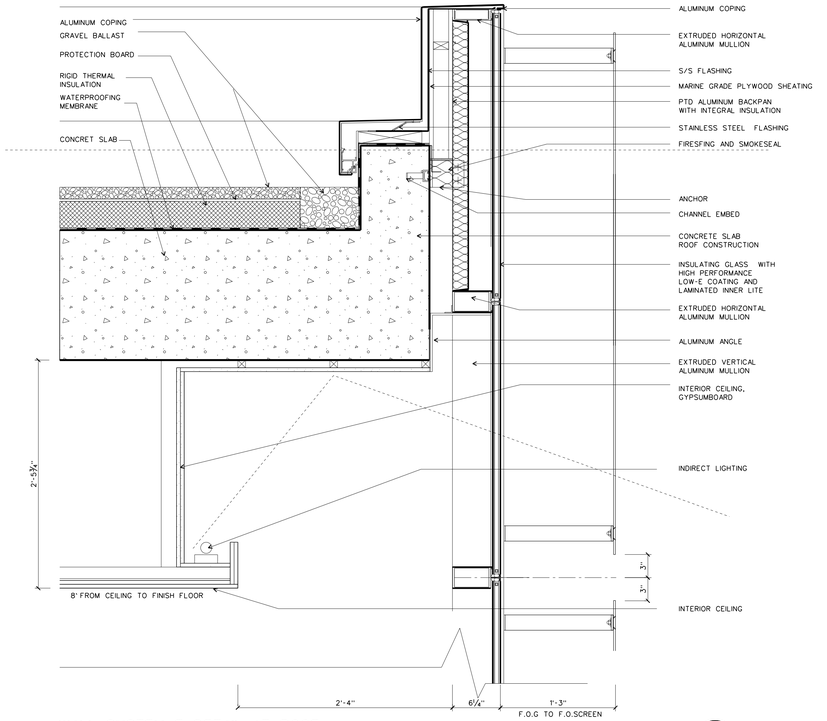

WALL SYSTEM F: DETAIL AT ROOF

SCALE: 1-1/2 " = 1'-0"


DETAILS/D-CWF02 20

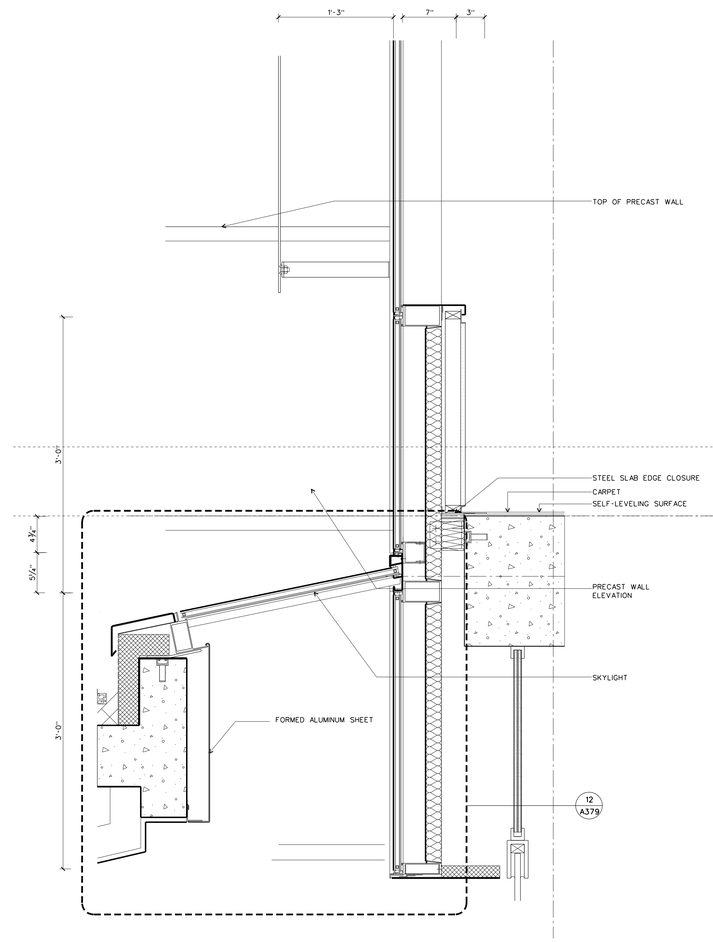

WALL SYSTEM F: DETAIL 2ND FLOOR/NORTH

SCALE: 1-1/2 " = 1'-0"


DETAILS/D-CWF02 12

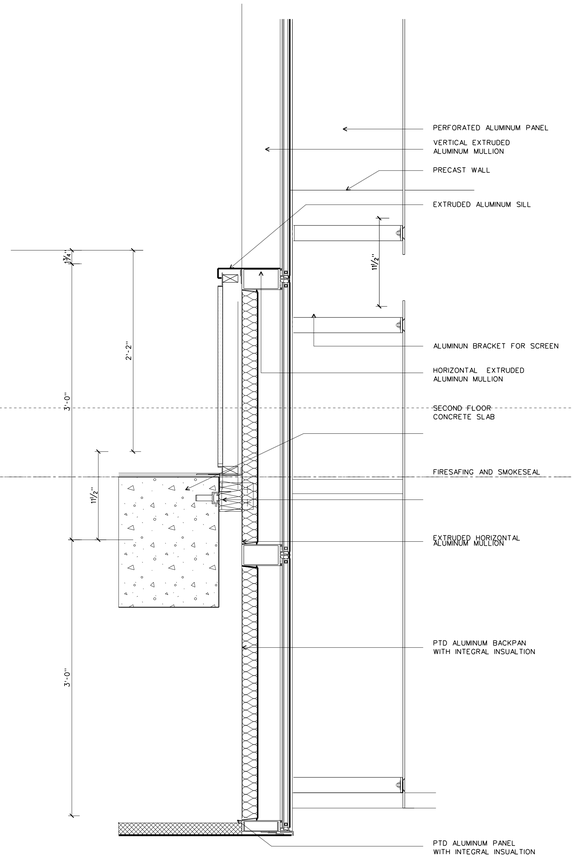

WALL SYSTEM F: DETAIL 2ND FLOOR/SOUTH

SCALE: 1-1/2 " = 1'-0"

DETAILS/D-CWF02 11

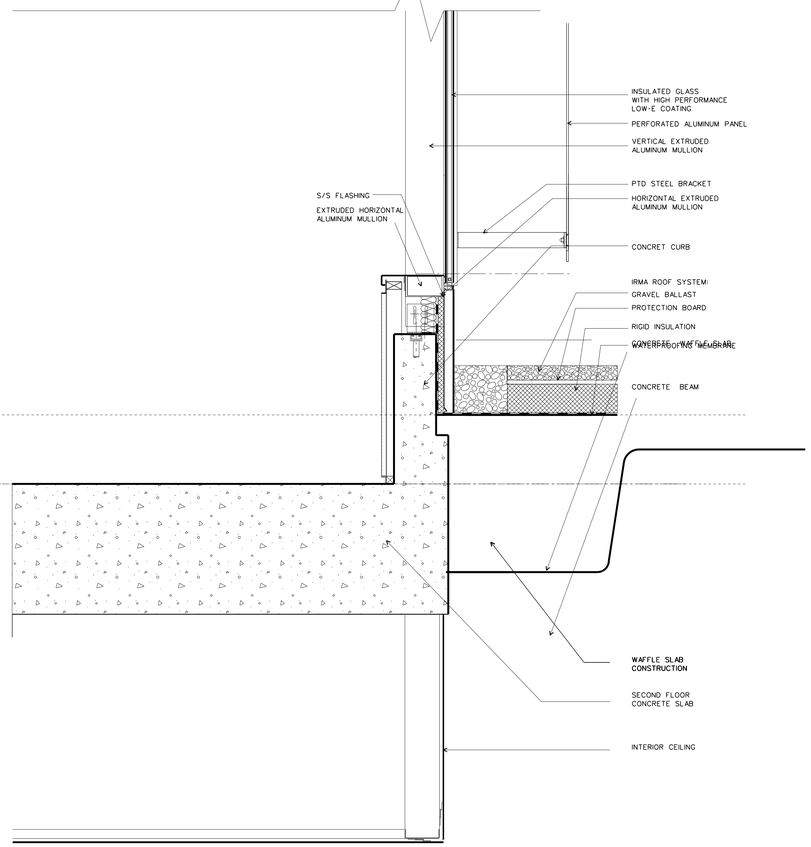

WALL SYSTEM F: DETAIL 2ND FLOOR/ROOF EAST

SCALE: 1-1/2 " = 1'-0"

DETAILS/D-CWF02 10

WILLIAM J. CLINTON PRESIDENTIAL CENTER

LITTLE ROCK, ARKANSAS

Architect

POLSHEK PARTNERSHIP LLP
320 West 13th Street
New York, New York 10014
212.807.7171

Coordinating Architects

POLK STANLEY YEARY ARCHITECTS Ltd
700 South Schiller Street
Little Rock, Arkansas 72201
501.378.0878

WITSELL EVANS RASCO
901 West Third Street
Little Rock, Arkansas 72201
501.374.5300

WOODS CARADINE ARCHITECTS
2200 South Main Street
Little Rock, Arkansas 72206
501.374.4060

Landscape Architects

HARGREAVES ASSOCIATES
118 Magazine Street
Cambridge, Massachusettes 02139
617.661.0070

LANDSCAPE ARCHITECTURE, Inc.
2300 Cottondale Lane Suite 202
Little Rock, Arkansas 72202
501.374.5610

Structural Engineer

LESLIE E. ROBERTSON ASSOC., RLLP
30 Broad Street, 47th Floor
New York, New York 10004
212.750.9000

MEP Engineers

FLACK + KURTZ Inc.
475 Fifth Avenue
New York, New York 10017
212.532.9600


CROMWELL ARCHITECTS ENGINEERS
101 South Spring Street
Little Rock, Arkansas 72201
501.372.2900

Curtainwall Consultant

R. A. HEINTGES ARCHITECTS
126 Fifth Avenue, 9th Floor
New York, New York 10011
212.652-2966

Seal

Issue	Date
100% Construction Documents	09/27/02
90% Progress Printing	08/30/02
ASI #05	08/20/02
100% Struct./ CD Progress	07/01/02
Bridge Bldg. Substructure	06/14/02
100% Steel & Concrete CD & Architectural CD Progress	05/15/02
100% Design Development	03/01/02

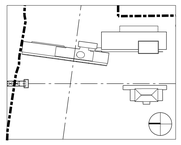

Job No. 9908

Scale 1-1/2" = 1'-0"

Date September 27, 2002


Title

WALL SYSTEM F: SECTIONS

Sheet No.


A371

FOR OFFICIAL USE ONLY

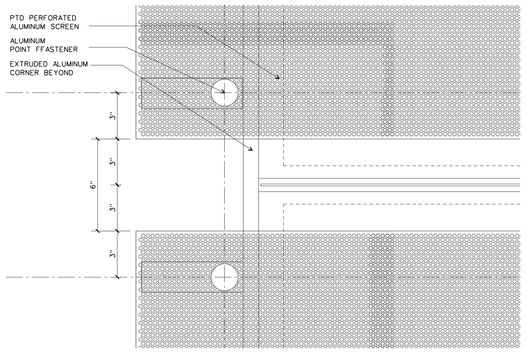


WALL SYSTEM F: POINT FASTENERS IN ELEVATION 43

SCALE: 3 " = 1'-0" DETAILS/D-CWF01

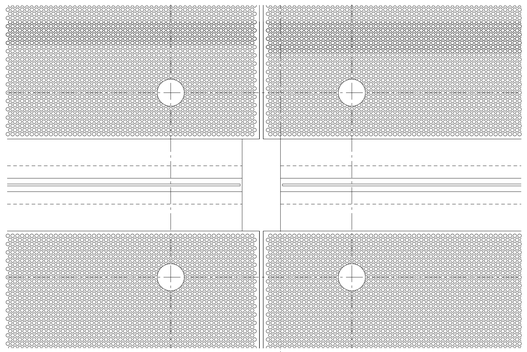


WALL SYSTEM F: POINT FASTENERS IN ELEVATION 42

SCALE: 3 " = 1'-0" DETAILS/D-CWF01

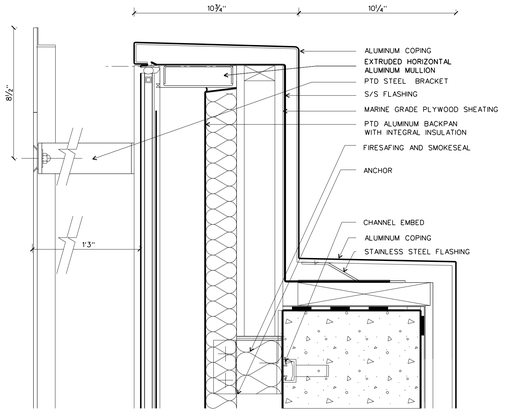


WALL SYSTEM F: DETAIL AT ROOF 41

SCALE: 3 " = 1'-0" DETAILS/D-CWF01

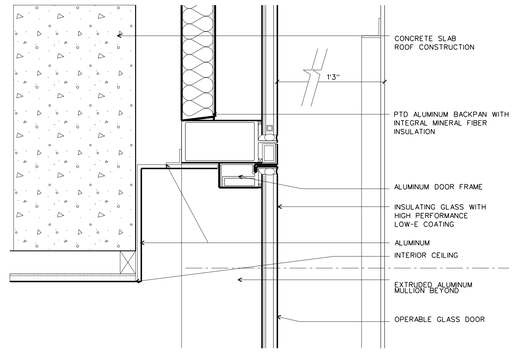


WALL SYSTEM F: DETAIL AT OPERABLE DOOR ABOVE 40

SCALE: 3 " = 1'-0" DETAILS/D-CWF01

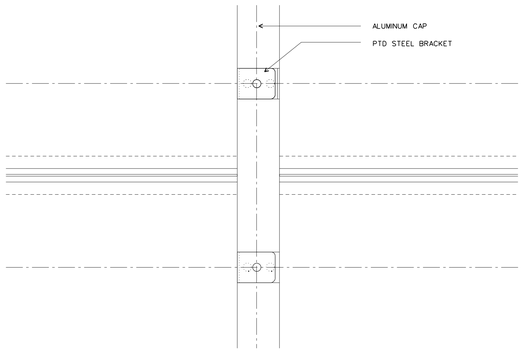


WALL SYSTEM F: BRACKETS AT MID. OF PANEL/ELEV. 33

SCALE: 3 " = 1'-0" DETAILS/D-CWF01

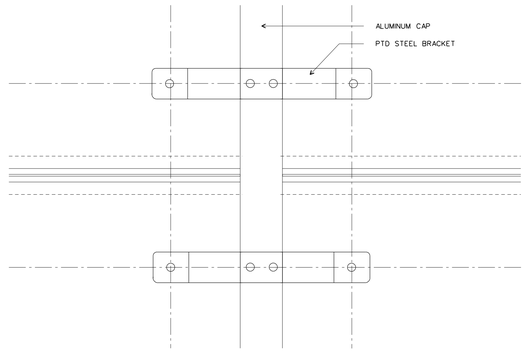


WALL SYSTEM F: BRACKETS IN ELEVATION 32

SCALE: 3 " = 1'-0" DETAILS/D-CWF01

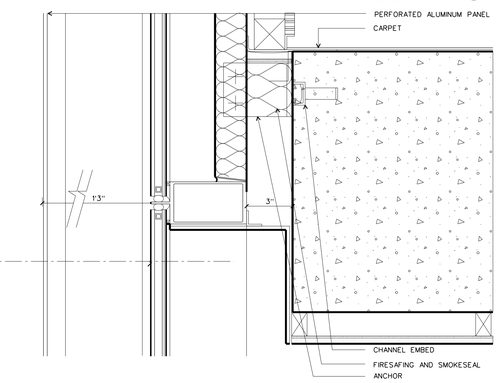


WALL SYSTEM F: DETAIL AT THIRD FLOOR SLAB 31

SCALE: 3 " = 1'-0" DETAILS/D-CWF01

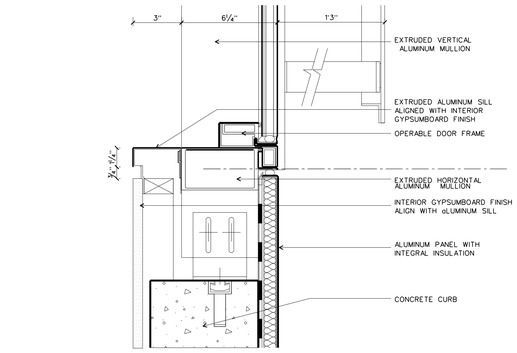


WALL SYSTEM F: DETAIL OPERABLE DOOR 30

SCALE: 3 " = 1'-0" DETAILS/D-CWF01

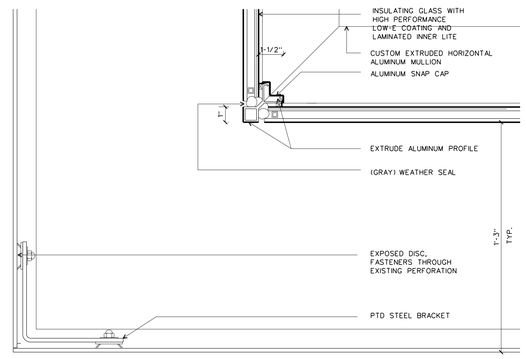


WALL SYSTEM F: CORNER DETAIL 23

SCALE: 3 " = 1'-0" DETAILS/D-CWF01

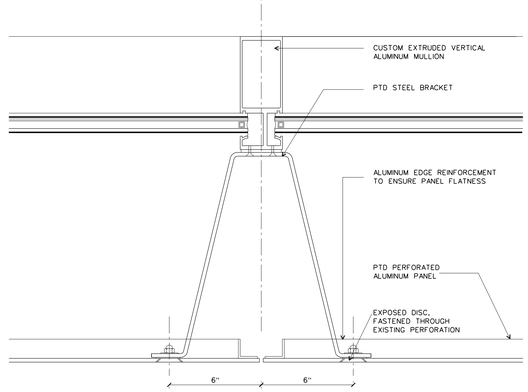


WALL SYSTEM F: VERTICAL MULLION W. BRACKET 22

SCALE: 3 " = 1'-0" DETAILS/D-CWF01

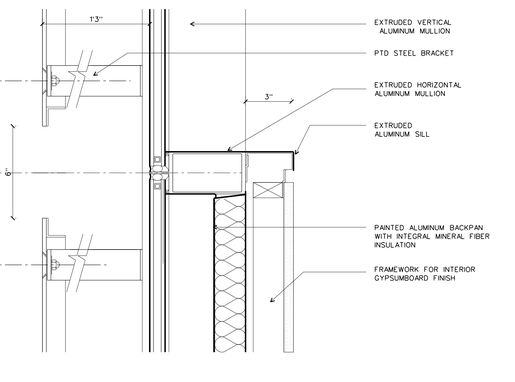


WALL SYSTEM F: DETAIL AT REGULAR MULLION 21

SCALE: 3 " = 1'-0" DETAILS/D-CWF01

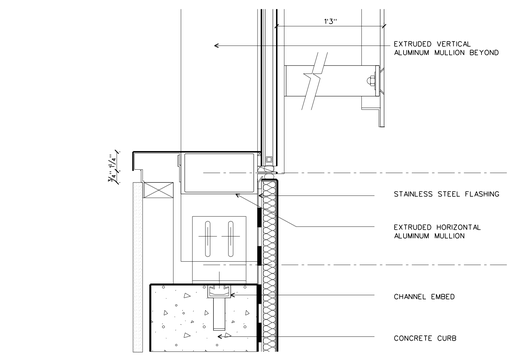


WALL SYSTEM F: DETAIL AT CONCRETE CURB EAST 20

SCALE: 3 " = 1'-0" DETAILS/D-CWF01

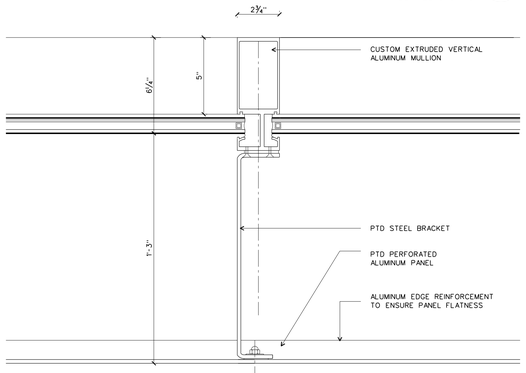


WALL SYSTEM F: TYP. BRACKET AT MIDDLE OF PANEL 13

SCALE: 3 " = 1'-0" DETAILS/D-CWF01

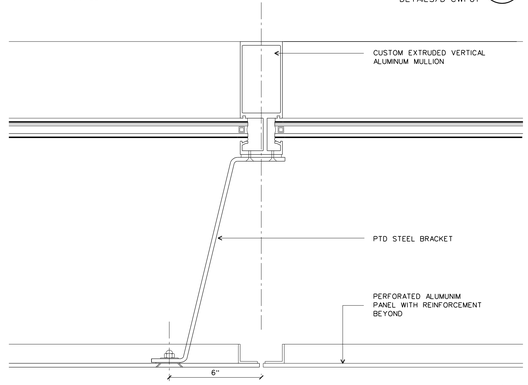


WALL SYSTEM F: TYP. BRACKET AT OPENINGS 12

SCALE: 3 " = 1'-0" DETAILS/D-CWF01

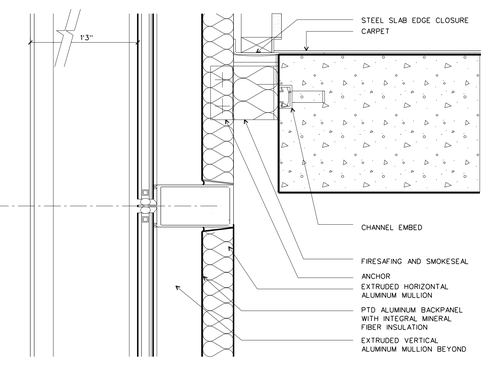

WALL SYSTEM F: DETAIL AT SLAB SECOND FLOOR 11

SCALE: 3 " = 1'-0" DETAILS/D-CWF01

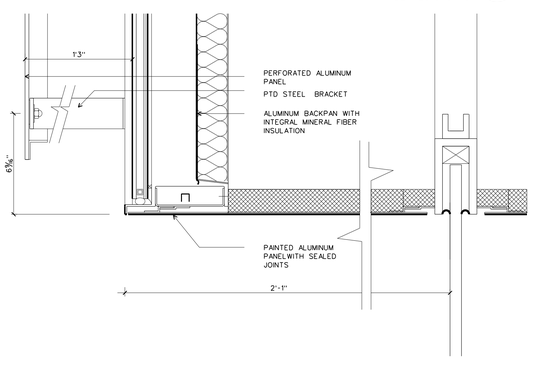

WALL SYSTEM F: CORNER DETAIL AT ENTRANCE 10

SCALE: 3 " = 1'-0" DETAILS/D-CWF01

WILLIAM J. CLINTON PRESIDENTIAL CENTER

LITTLE ROCK, ARKANSAS

Architect

POLSHEK PARTNERSHIP LLP
320 West 13th Street
New York, New York 10014
212.807.7171

Coordinating Architects

POLK STANLEY YEARY ARCHITECTS Ltd
700 South Schiller Street
Little Rock, Arkansas 72201
501.378.0878

WITSELL EVANS RASCO
901 West Third Street
Little Rock, Arkansas 72201
501.374.5300

WOODS CARADINE ARCHITECTS
2200 South Main Street
Little Rock, Arkansas 72206
501.374.4060

Landscape Architects

HARGREAVES ASSOCIATES
118 Magazine Street
Cambridge, Massachusettes 02139
617.661.0070

LANDSCAPE ARCHITECTURE, Inc.
2300 Cottondale Lane Suite 202
Little Rock, Arkansas 72202
501.374.5610

Structural Engineer

LESLIE E. ROBERTSON ASSOC., RLLP
30 Broad Street, 47th Floor
New York, New York 10004
212.750.9000

MEP Engineers

FLACK + KURTZ Inc.
475 Fifth Avenue
New York, New York 10017
212.532.9600


CROMWELL ARCHITECTS ENGINEERS
101 South Spring Street
Little Rock, Arkansas 72201
501.372.2900

Curtainwall Consultant

R. A. HEINTGES ARCHITECTS
126 Fifth Avenue, 9th Floor
New York, New York 10011
212.652-2966

Seal

Issue	Date
100% Construction Documents	09/27/02
90% Progress Printing	08/30/02
ASI #05	08/20/02
100% Struct./ CD Progress	07/01/02
Bridge Bldg. Substructure	06/14/02
100% Steel & Concrete CD	05/15/02
& Architectural CD Progress	
100% Design Development	03/01/02

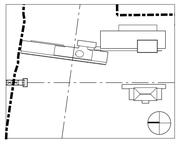

Job No. 9908


Scale 3" = 1'-0"

Date September 27, 2002

Title WALL SYSTEM F PLAN, SECTION AND ELEVATION DETAILS


Sheet No. A373

FOR OFFICIAL USE ONLY

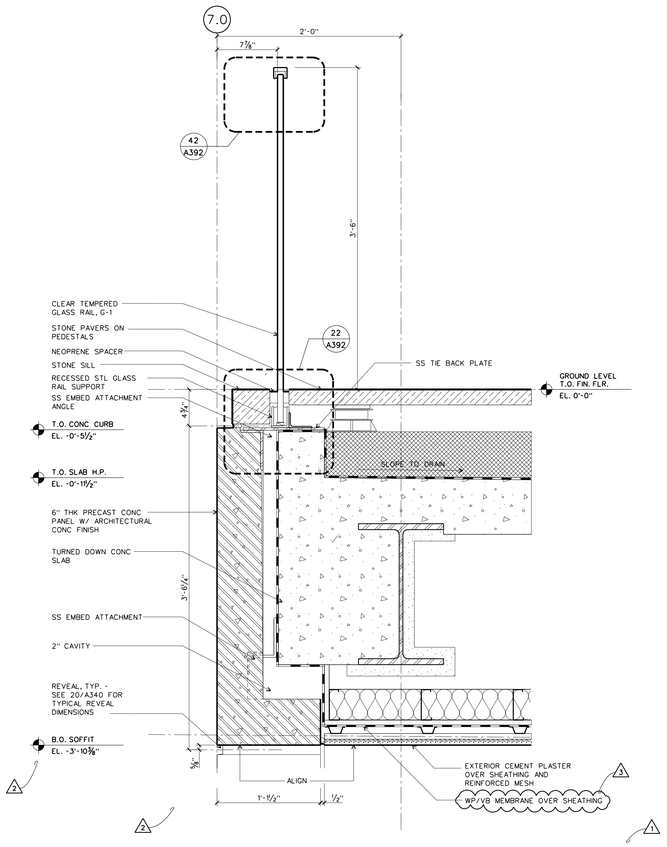


WALL SYSTEM G: DETAIL SECTION AT NORTH TERRACE 22

SCALE: 1-1/2 " = 1'-0" D-CWG02

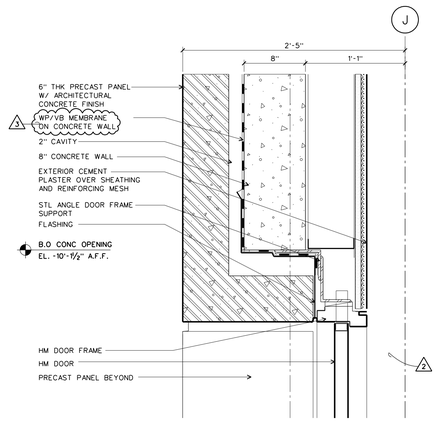


WALL SYSTEM G: DETAIL SECTION AT DOOR HEAD 21

SCALE: 1-1/2 " = 1'-0" D-CWG02

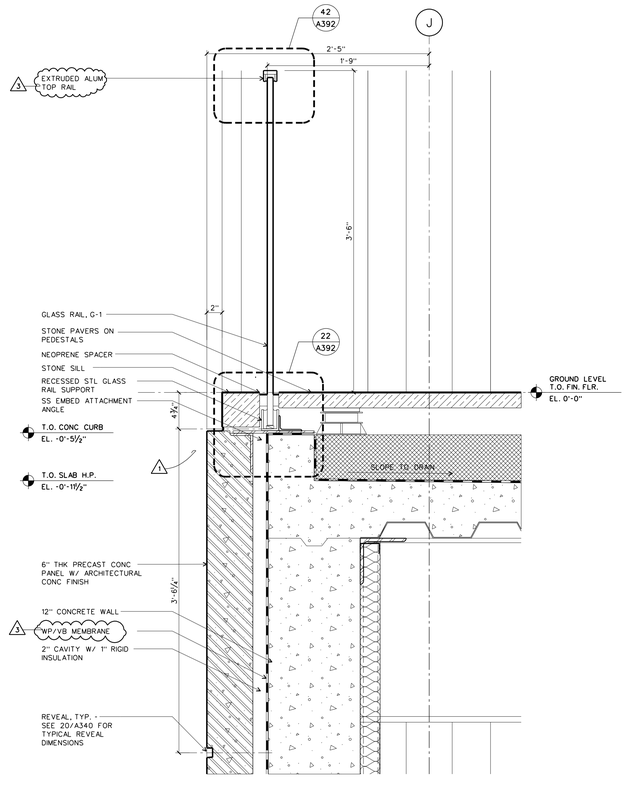


WALL SYSTEM G: DETAIL SECTION AT EAST TERRACE 20

SCALE: 1-1/2 " = 1'-0" D-CWG02

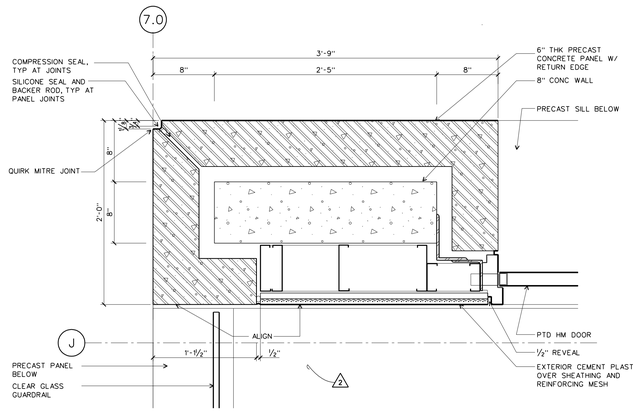


WALL SYSTEM G: PLAN DETAIL AT DOOR JAMB 12

SCALE: 1-1/2 " = 1'-0" D-CWG02

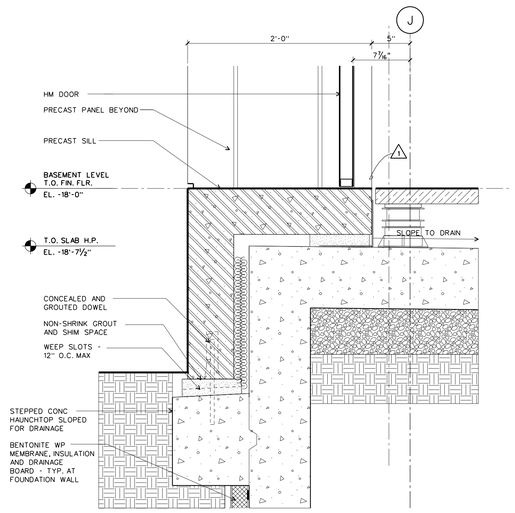

WALL SYSTEM G: DETAIL SECTION AT DOOR SILL 11

SCALE: 1-1/2 " = 1'-0" D-CWG02

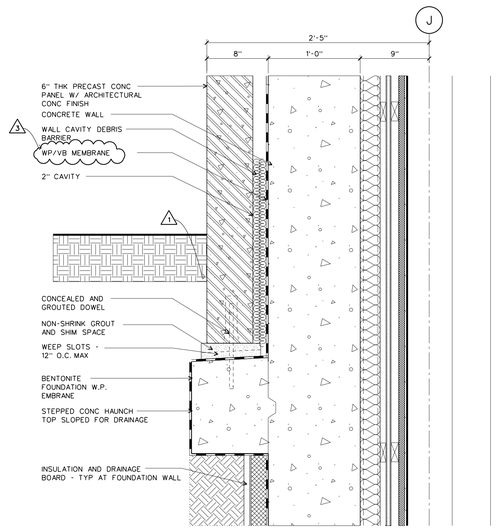

WALL SYSTEM G: DETAIL SECTION AT SILL 10

SCALE: 1-1/2 " = 1'-0" D-CWG02

FOR OFFICIAL USE ONLY

WILLIAM J. CLINTON PRESIDENTIAL CENTER

LITTLE ROCK, ARKANSAS

Architect

POLSHEK PARTNERSHIP LLP
320 West 13th Street
New York, New York 10014
212.807.7171

Coordinating Architects

POLK STANLEY YEARY ARCHITECTS Ltd
700 South Schiller Street
Little Rock, Arkansas 72201
501.378.0878

WITSELL EVANS RASCO
901 West Third Street
Little Rock, Arkansas 72201
501.374.5300

WOODS CARADINE ARCHITECTS
2200 South Main Street
Little Rock, Arkansas 72206
501.374.4060

Landscape Architects

HARGREAVES ASSOCIATES
118 Magazine Street
Cambridge, Massachusettes 02139
617.661.0070

LANDSCAPE ARCHITECTURE, Inc.
2300 Cottondale Lane Suite 202
Little Rock, Arkansas 72202
501.374.5610

Structural Engineer

LESLIE E. ROBERTSON ASSOC., RLLP
30 Broad Street, 47th Floor
New York, New York 10004
212.750.9000

MEP Engineers

FLACK + KURTZ Inc.
475 Fifth Avenue
New York, New York 10017
212.532.9600

CROMWELL ARCHITECTS ENGINEERS
101 South Spring Street
Little Rock, Arkansas 72201
501.372.2900

Curtainwall Consultant

R. A. HEINTGES ARCHITECTS
126 Fifth Avenue, 9th Floor
New York, New York 10011
212.652-2966

Seal

Issue	Date
3 ASI #22	08/01/03
2 Addendum #2	11/15/02
1 100% Construction Documents	09/27/02
90% Progress Printing	08/30/02
100% Struct./ CD Progress	07/01/02
Bridge Bldg. Substructure	06/14/02
100% Design Development	03/01/02

Job No. 9908

Scale 1-1/2" = 1'-0"


Date September 27, 2002

Title

WALL SYSTEM G
DETAIL PLANS AND SECTIONS


Sheet No.

A375

 


WALL SYSTEM H: DETAILS AT PRECAST AND STONE WALL 13

SCALE: 1-1/2 " = 1'-0" DETAILS D-CWH 01

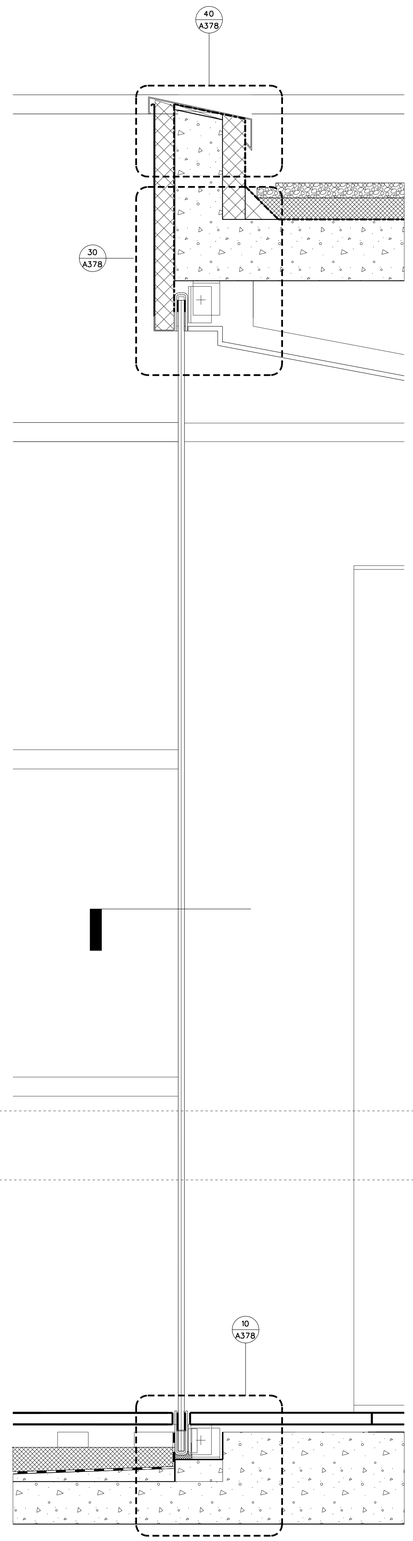


WALL SYSTEM H: TYP DETAIL AT FLOOR AND CORRIDOR ROOF 12

SCALE: 1-1/2 " = 1'-0" DETAILS D-CWH 01

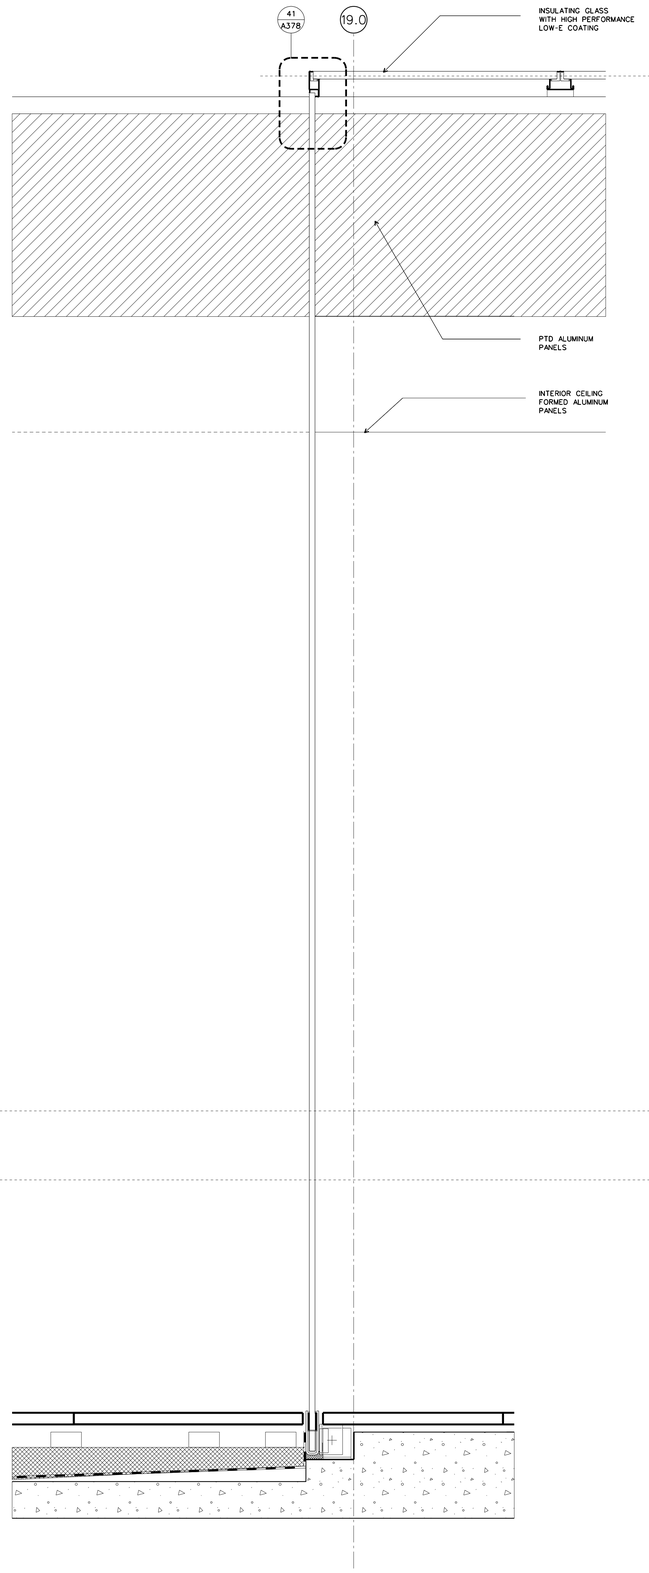

WALL SYSTEM H: SKYLIGHT/WALL SYSTEM H AT GLASS CONNECTOR 11

SCALE: 1-1/2 " = 1'-0" DETAILS D-CWH 01

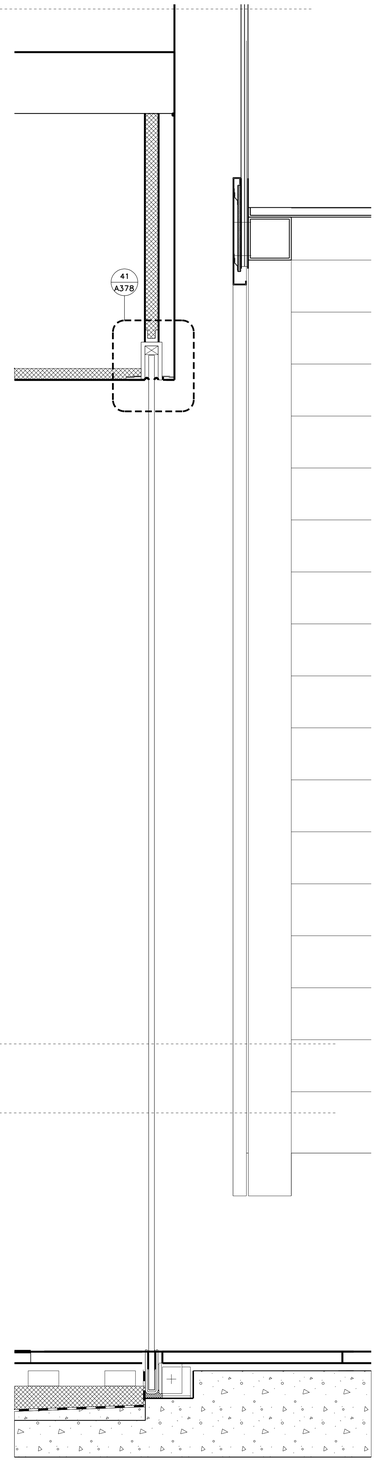

WALL SYSTEM H: ENTRANCE ARCHIVE OFFICE 10

SCALE: 1-1/2 " = 1'-0" DETAILS D-CWH 01

WILLIAM J. CLINTON PRESIDENTIAL CENTER

LITTLE ROCK, ARKANSAS

Architect

POLSHEK PARTNERSHIP LLP
320 West 13th Street
New York, New York 10014
212.807.7171

Coordinating Architects

POLK STANLEY YEARY ARCHITECTS Ltd
700 South Schiller Street
Little Rock, Arkansas 72201
501.378.0878

WITSELL EVANS RASCO
901 West Third Street
Little Rock, Arkansas 72201
501.374.5300

WOODS CARADINE ARCHITECTS
2200 South Main Street
Little Rock, Arkansas 72206
501.374.4060

Landscape Architects

HARGREAVES ASSOCIATES
118 Magazine Street
Cambridge, Massachusettes 02139
617.661.0070

LANDSCAPE ARCHITECTURE, Inc.
2300 Cottondale Lane Suite 202
Little Rock, Arkansas 72202
501.374.5610

Structural Engineer

LESLIE E. ROBERTSON ASSOC., RLLP
30 Broad Street, 47th Floor
New York, New York 10004
212.750.9000

MEP Engineers

FLACK + KURTZ Inc.
475 Fifth Avenue
New York, New York 10017
212.532.9600


CROMWELL ARCHITECTS ENGINEERS
101 South Spring Street
Little Rock, Arkansas 72201
501.372.2900

Curtainwall Consultant

R. A. HEINTGES ARCHITECTS
126 Fifth Avenue, 9th Floor
New York, New York 10011
212.652-2966

Seal

Issue	Date
100% Construction Documents	09/27/02
90% Progress Printing	08/30/02
ASI #05	08/20/02
100% Struct./ CD Progress	07/01/02
Bridge Bldg. Substructure	06/14/02
100% Steel & Concrete CD	05/15/02
& Architectural CD Progress	
100% Design Development	03/01/02

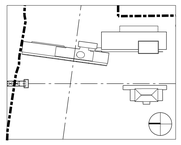

Job No. 9908

Scale 1-1/2" = 1'-0"

Date September 27, 2002


Title

WALL SYSTEM H GLASS: PLAN AND SECTIONS

Sheet No.


A377

FOR OFFICIAL USE ONLY

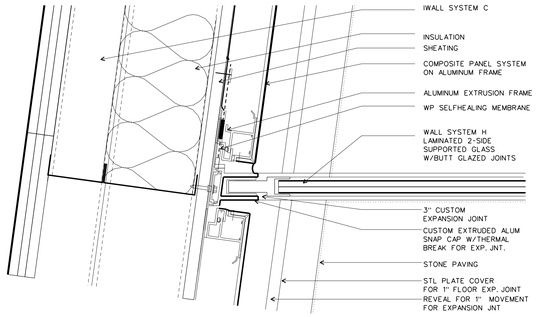


WALL SYSTEM H: PLAN DET. AT WALL SYSTEM C EAST

SCALE: 3 " = 1'-0" DETAILS/D-CWH02 **43**

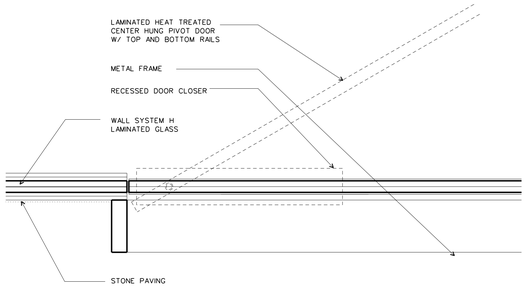


WALL SYSTEM H: PLAN DET. AT GLASS DOOR EAST

SCALE: 3 " = 1'-0" DETAILS/D-CWH02 **42**

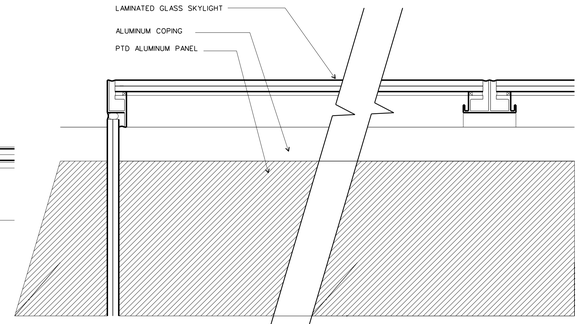


WALL SYSTEM H: DETAIL AT END OF SKYLIGHT

SCALE: 3 " = 1'-0" DETAILS/D-CWH02 **41**

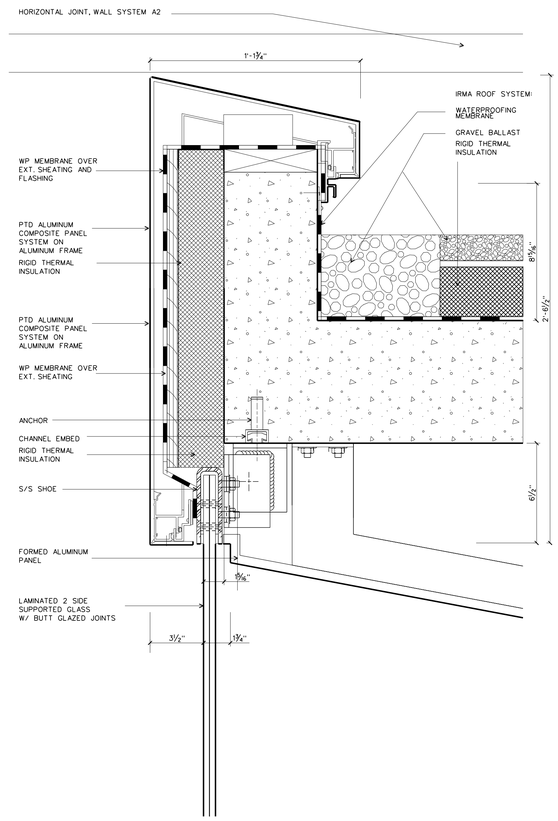


WALL SYSTEM H: DETAIL AT ROOF

SCALE: 3 " = 1'-0" DETAILS/D-CWH02 **30**

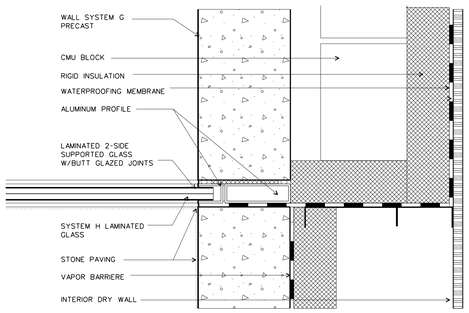


WALL SYSTEM H: PLAN DET. AT WALL SYSTEM G

SCALE: 3 " = 1'-0" DETAILS/D-CWH02 **32**

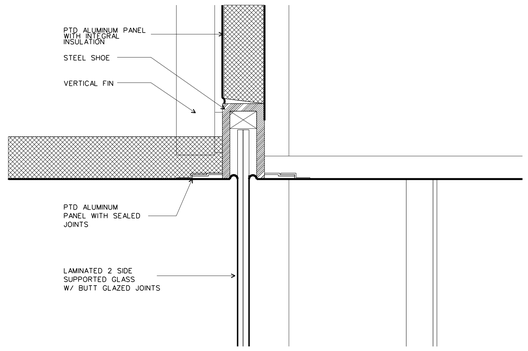


WALL SYSTEM H: TYP. DETAIL HEAD AT ENTRANCE

SCALE: 3 " = 1'-0" DETAILS/D-CWH02 **31**

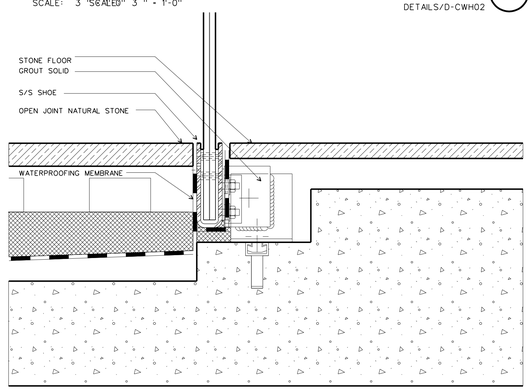


WALL SYSTEM H: DETAIL AT ROOF

SCALE: 3 " = 1'-0" DETAILS/D-CWH02 **20**

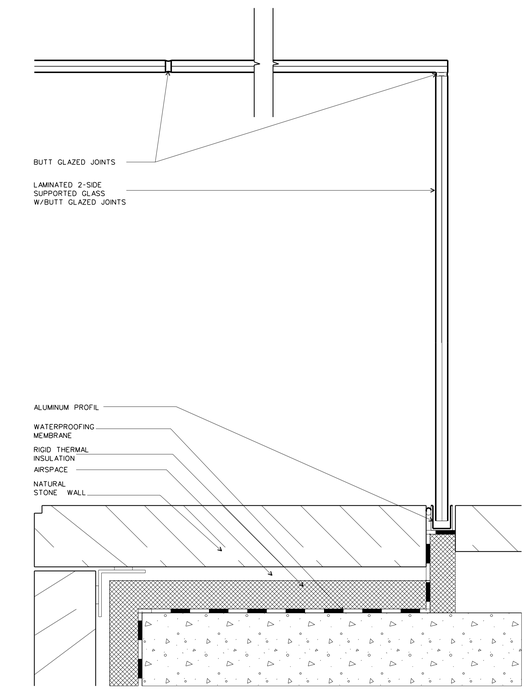

WALL SYSTEM H: PLAN DET. AT OPENINGS IN STONE WALL

SCALE: 3 " = 1'-0" DETAILS/D-CWH02 **12**

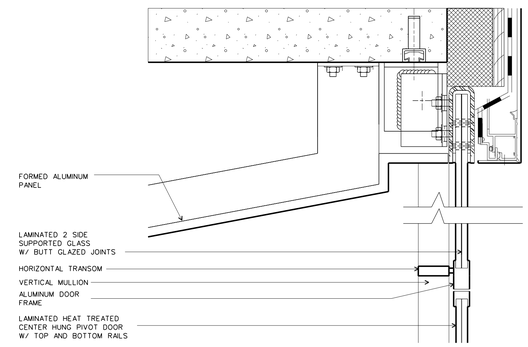

WALL SYSTEM H: DETAIL AT CEILING

SCALE: 3 " = 1'-0" DETAILS/D-CWH02 **10**

WILLIAM J. CLINTON PRESIDENTIAL CENTER

LITTLE ROCK, ARKANSAS

Architect

POLSHEK PARTNERSHIP LLP
320 West 13th Street
New York, New York 10014
212.807.7171

Coordinating Architects

POLK STANLEY YEARY ARCHITECTS Ltd
700 South Schiller Street
Little Rock, Arkansas 72201
501.378.0878

WITSELL EVANS RASCO
901 West Third Street
Little Rock, Arkansas 72201
501.374.5300

WOODS CARADINE ARCHITECTS
2200 South Main Street
Little Rock, Arkansas 72206
501.374.4060

Landscape Architects

HARGREAVES ASSOCIATES
118 Magazine Street
Cambridge, Massachusettes 02139
617.661.0070

LANDSCAPE ARCHITECTURE, Inc.
2300 Cottondale Lane Suite 202
Little Rock, Arkansas 72202
501.374.5610

Structural Engineer

LESLIE E. ROBERTSON ASSOC., RLLP
30 Broad Street, 47th Floor
New York, New York 10004
212.750.9000

MEP Engineers

FLACK + KURTZ Inc.
475 Fifth Avenue
New York, New York 10017
212.532.9600


CROMWELL ARCHITECTS ENGINEERS
101 South Spring Street
Little Rock, Arkansas 72201
501.372.2900

Curtainwall Consultant

R. A. HEINTGES ARCHITECTS
126 Fifth Avenue, 9th Floor
New York, New York 10011
212.652-2966

Seal

Issue	Date
100% Construction Documents	09/27/02
90% Progress Printing	08/30/02
ASI #05	08/20/02
100% Struct./ CD Progress	07/01/02
Bridge Bldg. Substructure	06/14/02
100% Steel & Concrete CD & Architectural CD Progress	05/15/02
100% Design Development	03/01/02

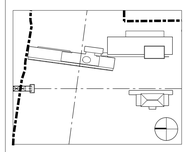

Job No. 9908


Scale 3" = 1'-0"

Date September 27, 2002

Title WALL SYSTEM H GLASS: PLAN AND SECTION DETAILS

Sheet No. A378


FOR OFFICIAL USE ONLY FOR OFFICIAL USE ONLY

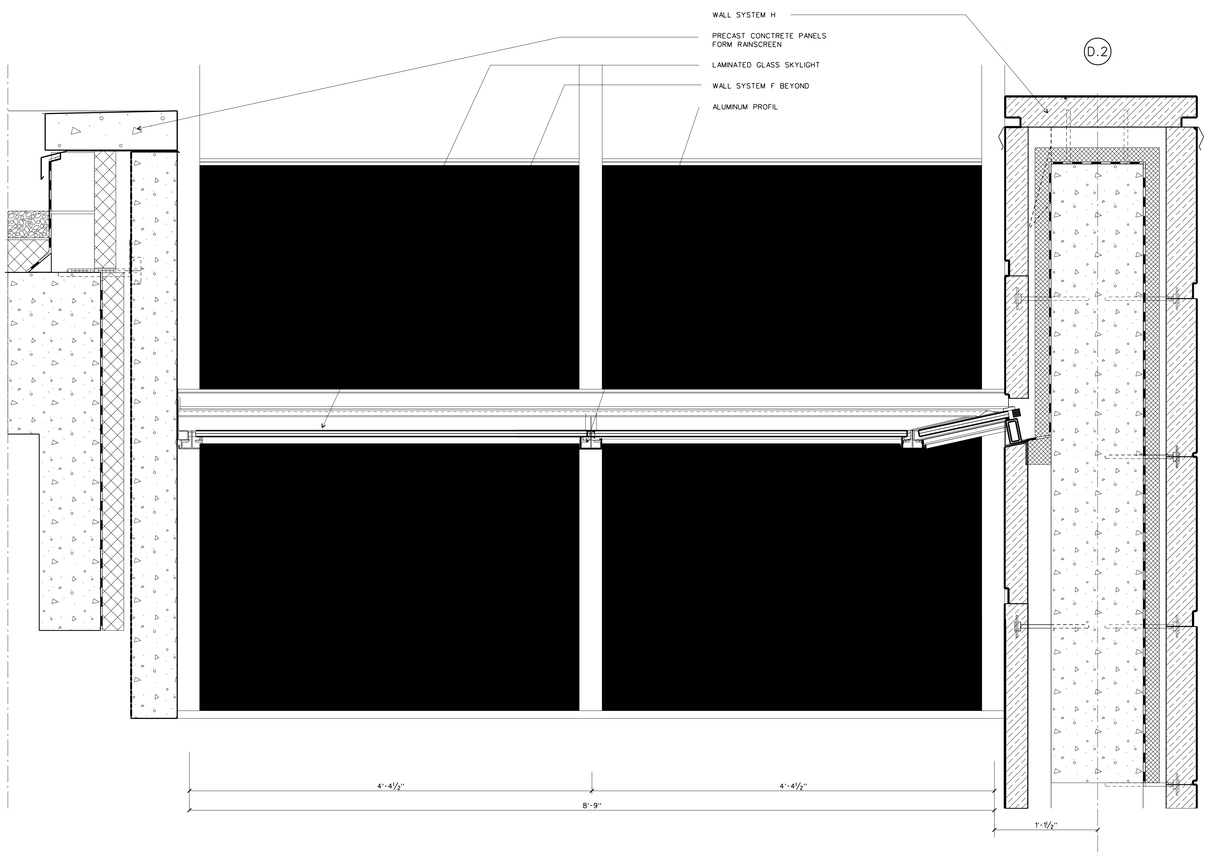

WALL SYSTEM I: SECTION THROUGH SKYLIGHT , EAST-WEST

SCALE: 1-1/2 " = 1'-0"


22 — DETAILS/D-CWF03

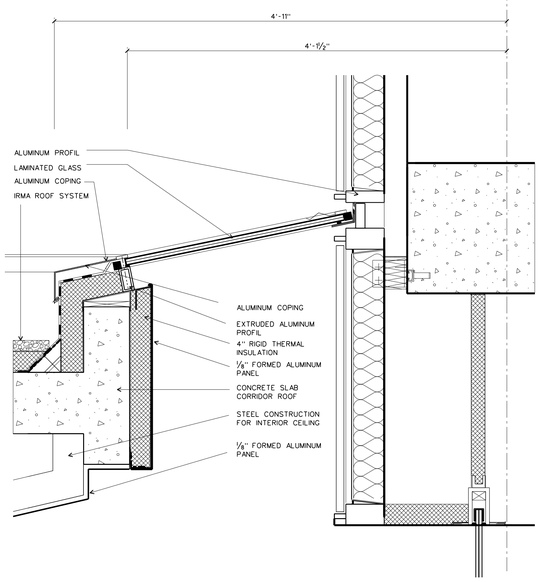

WALL SYSTEM I: SECTION OF SKYLIGHT AT WALL SYSTEM F

SCALE: 1-1/2" = 1'-0"


12 — DETAILS/D-CWF03

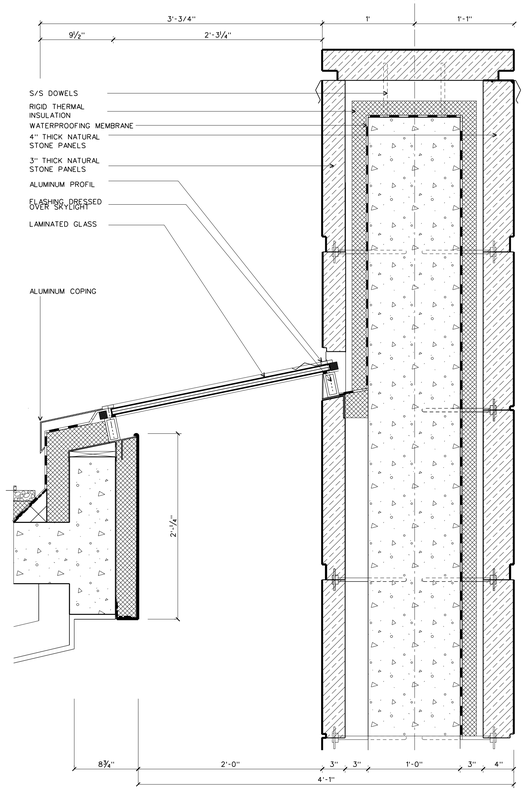

WALL SYSTEM I: SECTION OF SKYLIGHT AT STONEWALL

SCALE: 1-1/2" = 1'-0"

11 — DETAILS/D-CWF03

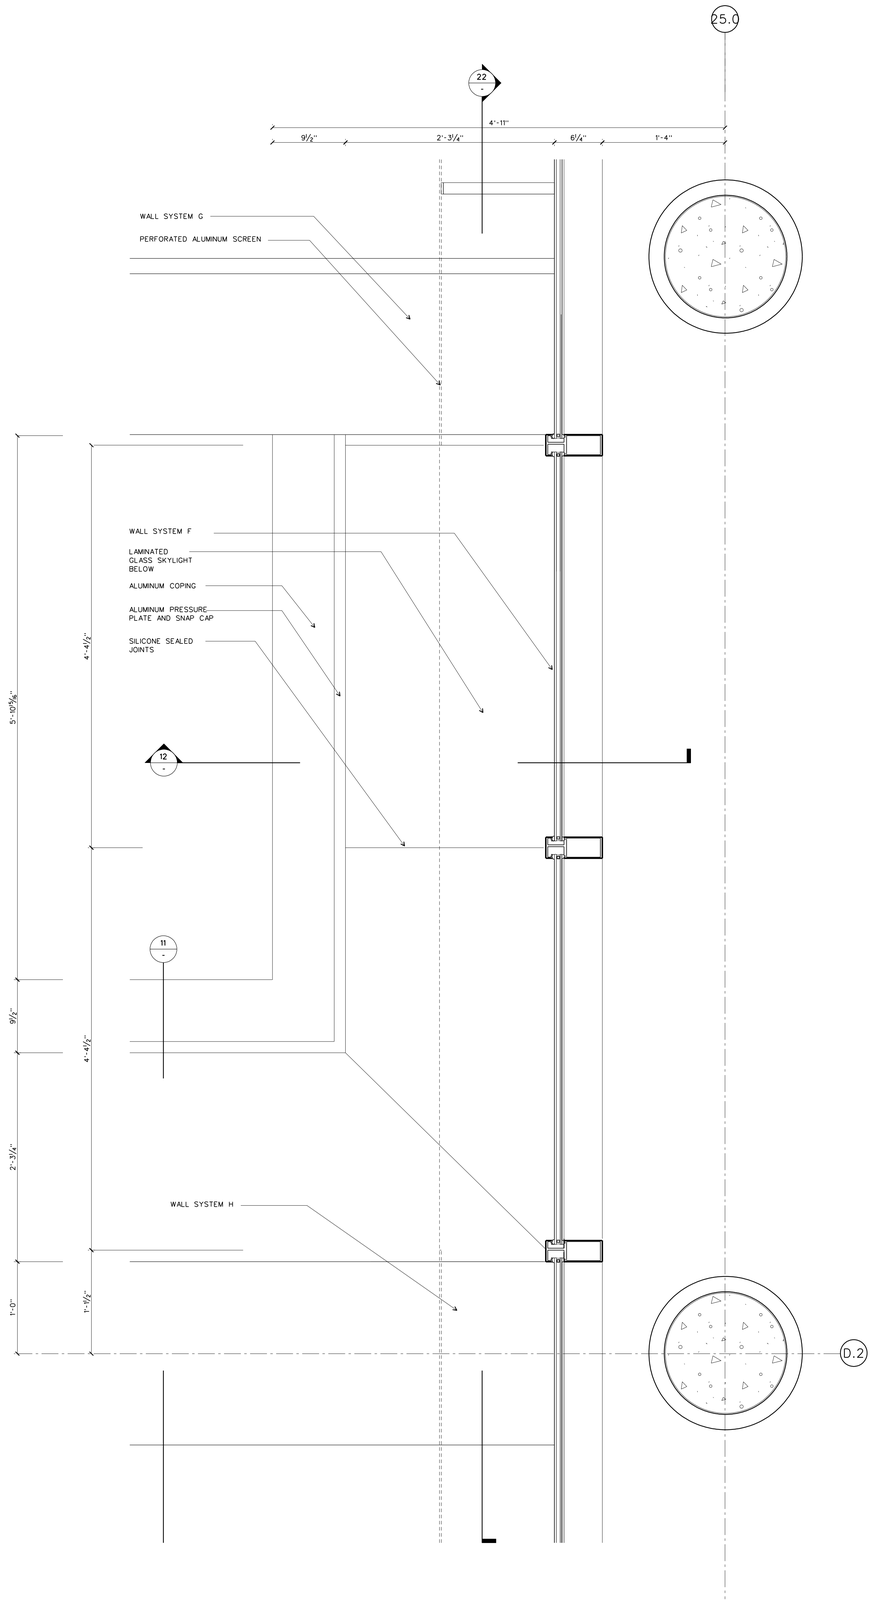

SYSTEM I: PLAN DETAIL SKYLIGHT

SCALE: 1-1/2" = 1'-0"

10 — DETAILS/D-CWF03

WILLIAM J. CLINTON PRESIDENTIAL CENTER

LITTLE ROCK, ARKANSAS

Architect

POLSHEK PARTNERSHIP LLP
320 West 13th Street
New York, New York 10014
212.807.7171

Coordinating Architects

POLK STANLEY YEARY ARCHITECTS Ltd
700 South Schiller Street
Little Rock, Arkansas 72201
501.378.0878

WITSELL EVANS RASCO
901 West Third Street
Little Rock, Arkansas 72201
501.374.5300

WOODS CARADINE ARCHITECTS
2200 South Main Street
Little Rock, Arkansas 72206
501.374.4060

Landscape Architects

HARGREAVES ASSOCIATES
118 Magazine Street
Cambridge, Massachusettes 02139
617.661.0070

LANDSCAPE ARCHITECTURE, Inc.
2300 Cottondale Lane Suite 202
Little Rock, Arkansas 72202
501.374.5610

Structural Engineer

LESLIE E. ROBERTSON ASSOC., RLLP
30 Broad Street, 47th Floor
New York, New York 10004
212.750.9000

MEP Engineers

FLACK + KURTZ Inc.
475 Fifth Avenue
New York, New York 10017
212.532.9600


CROMWELL ARCHITECTS ENGINEERS
101 South Spring Street
Little Rock, Arkansas 72201
501.372.2900

Curtainwall Consultant

R. A. HEINTGES ARCHITECTS
126 Fifth Avenue, 9th Floor
New York, New York 10011
212.652-2966

Seal

Issue	Date
100% Construction Documents	09/27/02
90% Progress Printing	08/30/02
ASI #05	08/20/02
100% Struct./ CD Progress	07/01/02
Bridge Bldg. Substructure	06/14/02
100% Steel & Concrete CD	05/15/02
& Architectural CD Progress	
100% Design Development	03/01/02

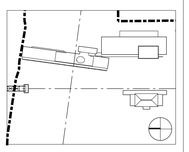

Job No. 9908

Scale 1-1/2" = 1'-0"

Date September 27, 2002


Title

SYSTEM I SKYLIGHT: PLAN AND SECTION

Sheet No.


A379

FOR OFFICIAL USE ONLY

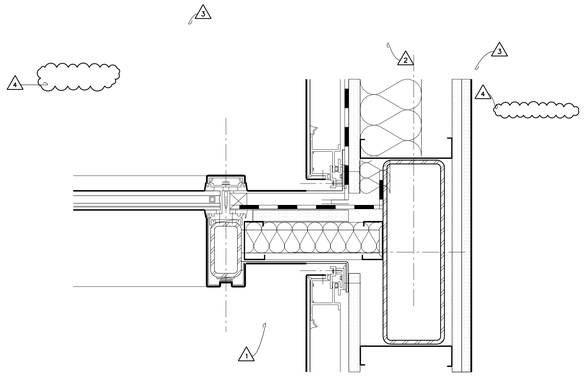


WALL SYSTEM J: PLAN SECTION AT METAL PANEL 43

SCALE: 3 " = 1'-0" D-CWJ01

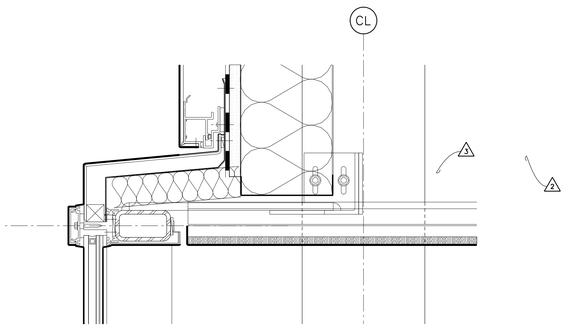


WALL SYSTEM J: DETAIL SECTION AT HEAD 42

SCALE: 3 " = 1'-0" D-CWJ01

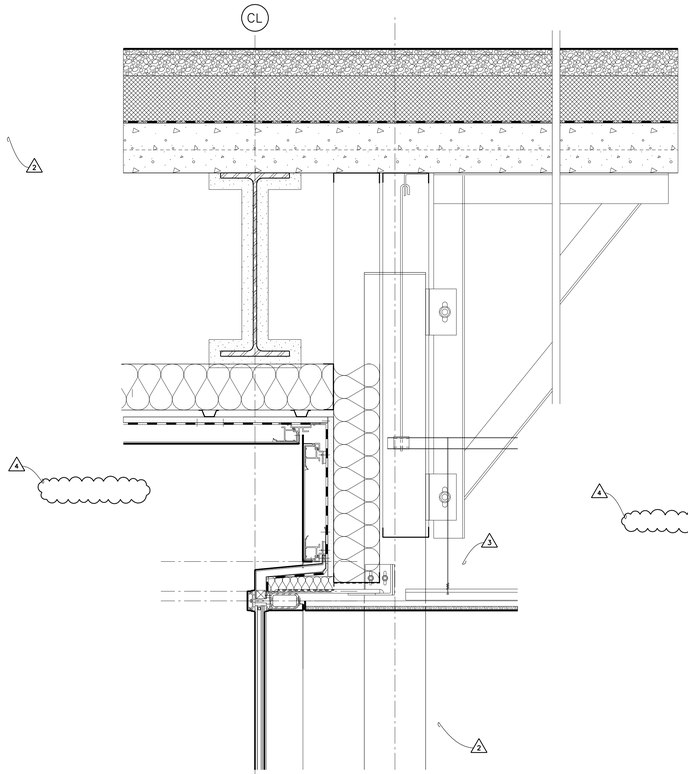


WALL SYSTEM J: DETAIL SECTION AT HEAD 31

SCALE: 1-1/2 " = 1'-0" D-CWJ01

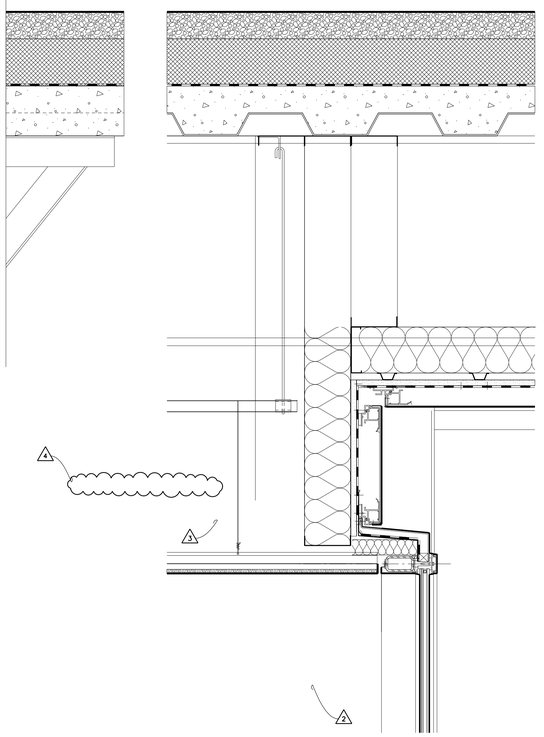


WALL SYSTEM J: DETAIL SECTION AT HEAD 30

SCALE: 1-1/2 " = 1'-0" D-CWJ01

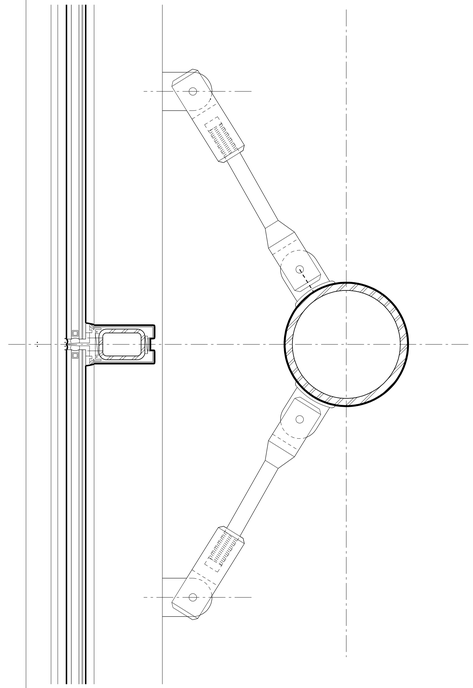


WALL SYSTEM J: PLAN DETAIL AT PIPE COLUMN 23

SCALE: 3 " = 1'-0" D-CWJ01

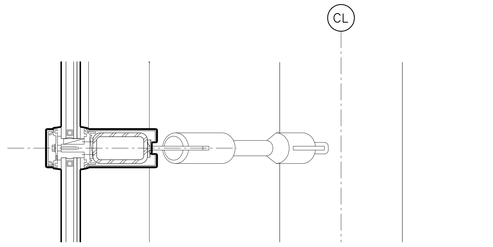


WALL SYSTEM J: DETAIL AT HORIZONTAL 32

SCALE: 3 " = 1'-0" D-CWJ01

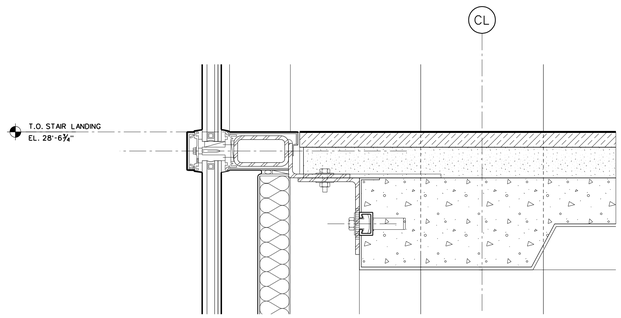


WALL SYSTEM J: DETAIL AT STAIR PLATFORM 22

SCALE: 3" = 1'-0" D-CWJ01

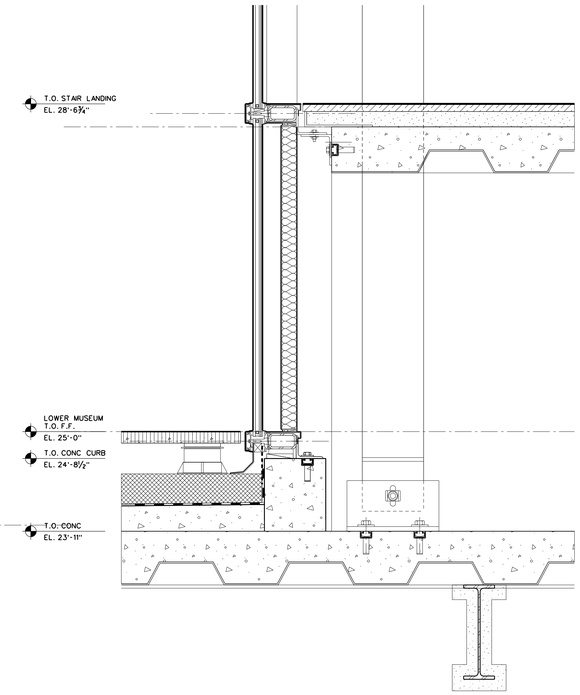


WALL SYSTEM J: DETAIL SECTION AT SILL 11

SCALE: 1-1/2 " = 1'-0" D-CWJ01

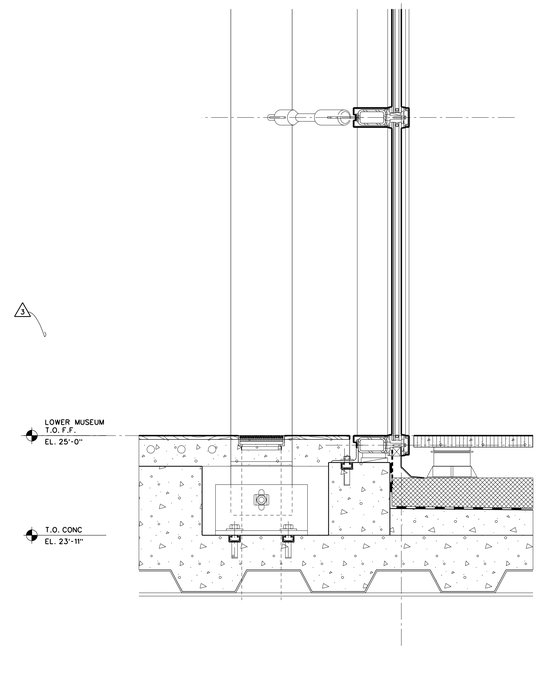


WALL SYSTEM J: DETAIL SECTION AT SILL 10

SCALE: 1-1/2 " = 1'-0" D-CWJ01

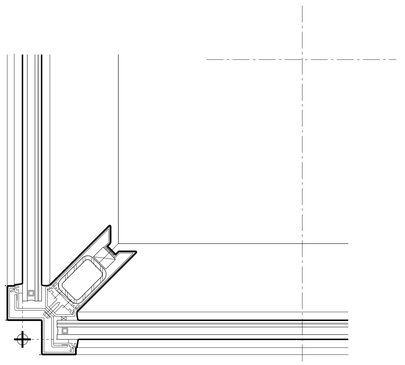

WALL SYSTEM J: PLAN DETAIL AT CORNER 13

SCALE: 3 " = 1'-0" D-CWJ01

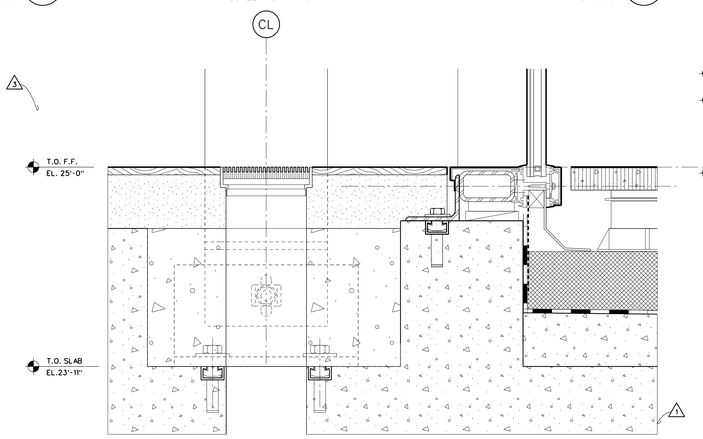

WALL SYSTEM J: SECTION DETIAL AT NORTH SILL 12

SCALE: 3 " = 1'-0" D-CWJ01

WILLIAM J. CLINTON PRESIDENTIAL CENTER

LITTLE ROCK, ARKANSAS

Architect

POLSHEK PARTNERSHIP LLP
320 West 13th Street
New York, New York 10014
212.807.7171

Coordinating Architects

POLK STANLEY YEARY ARCHITECTS Ltd
700 South Schiller Street
Little Rock, Arkansas 72201
501.378.0878

WITSELL EVANS RASCO
901 West Third Street
Little Rock, Arkansas 72201
501.374.5300

WOODS CARADINE ARCHITECTS
2200 South Main Street
Little Rock, Arkansas 72206
501.374.4060

Landscape Architects

HARGREAVES ASSOCIATES
118 Magazine Street
Cambridge, Massachusettes 02139
617.661.0070

LANDSCAPE ARCHITECTURE, Inc.
2300 Cottondale Lane Suite 202
Little Rock, Arkansas 72202
501.374.5610

Structural Engineer

LESLIE E. ROBERTSON ASSOC., RLLP
30 Broad Street, 47th Floor
New York, New York 10004
212.750.9000

MEP Engineers

FLACK + KURTZ Inc.
475 Fifth Avenue
New York, New York 10017
212.532.9600


CROMWELL ARCHITECTS ENGINEERS
101 South Spring Street
Little Rock, Arkansas 72201
501.372.2900

Curtainwall Consultant

R. A. HEINTGES ARCHITECTS
126 Fifth Avenue, 9th Floor
New York, New York 10011
212.652-2966

Seal

	Issue	Date
4	ASI #22	08/01/03
3	ASI #20	06/06/03
2	Addendum #2	11/15/02
1	100% Construction Documents	09/27/02
	90% Progress Printing	08/30/02
	100% Struct./ CD Progress	07/01/02
	100% Design Development	03/01/02

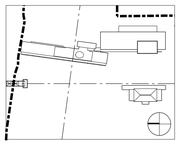

Job No. 9908

Scale AS NOTED

Date September 27, 2002


Title

WALL SYSTEM J DETAILS

Sheet No.


A380

FOR OFFICIAL USE ONLY

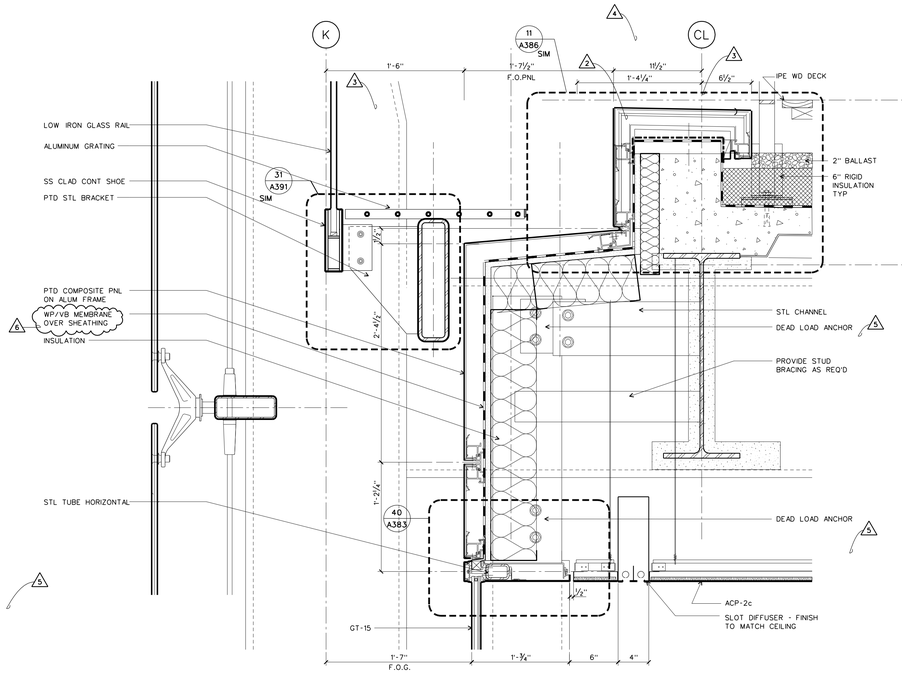


WALL SYSTEM K: DETAIL SECTION AT WEST HEAD 31

SCALE: 1-1/2 " = 1'-0" D-CWK01

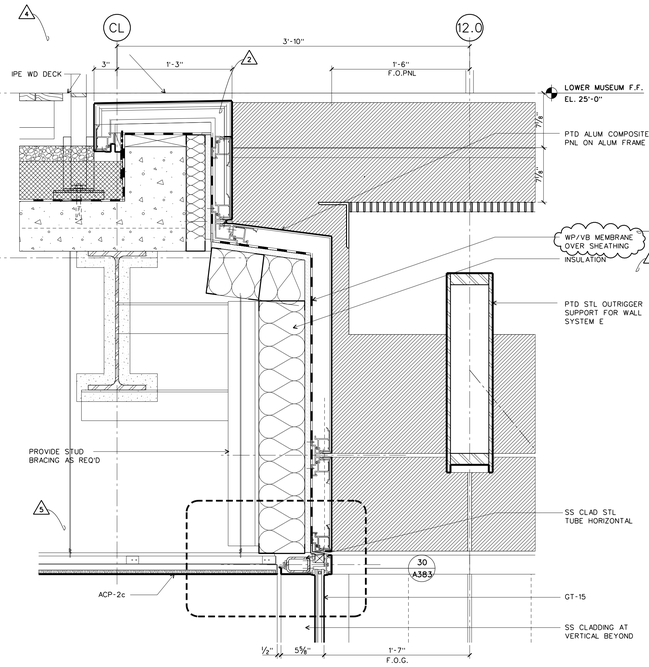


WALL SYSTEM K: DETAIL SECTION AT SOUTH HEAD 30

SCALE: 1-1/2 " = 1'-0" D-CWK01

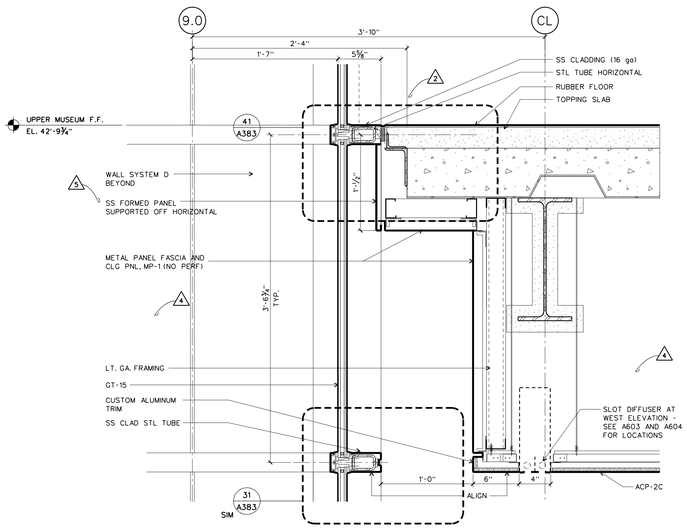


WALL SYSTEM K: SECTION AT UPPER MUSEUM SILL 22

SCALE: 1-1/2 " = 1'-0" D-CWK01

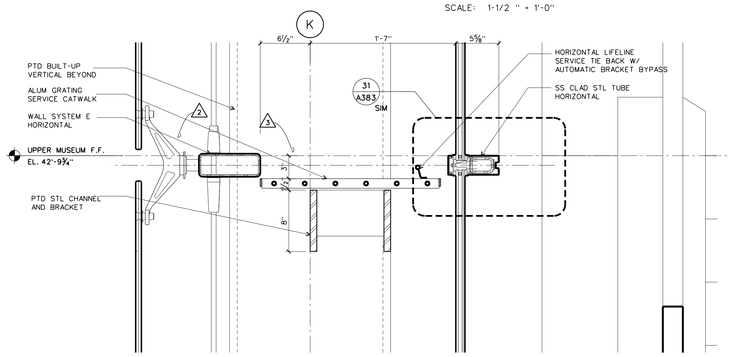


WALL SYSTEM K: SECTION AT UPPER MUSEUM SILL 21

SCALE: 1-1/2 " = 1'-0" D-CWK01

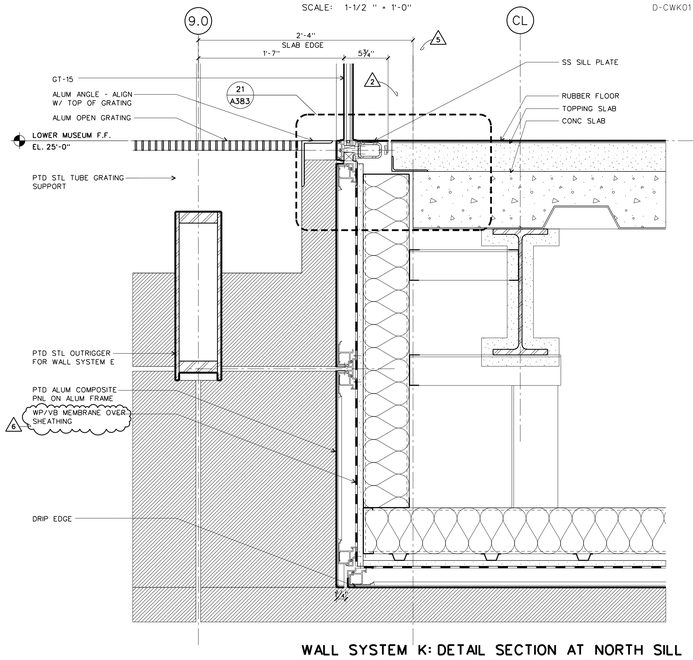


WALL SYSTEM K: DETAIL SECTION AT NORTH SILL 12

SCALE: 1-1/2 " = 1'-0" D-CWK01

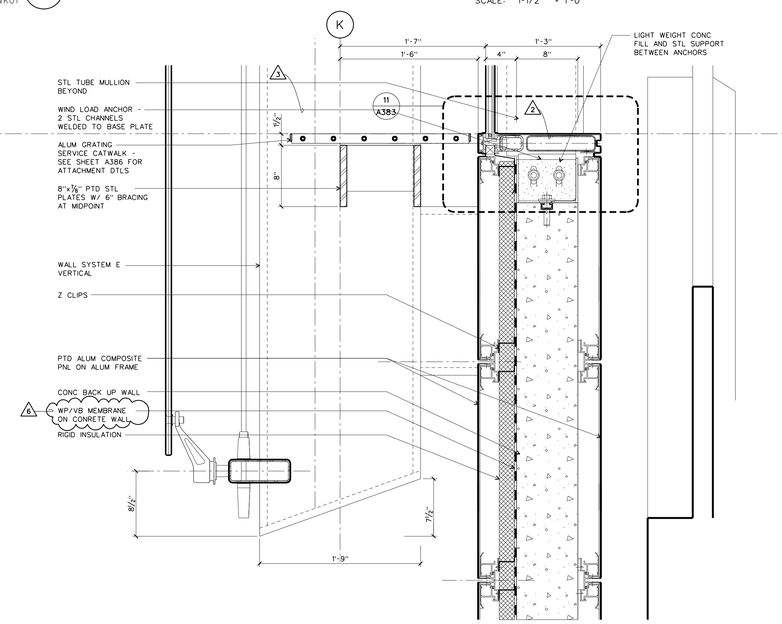

WALL SYSTEM K: DETAIL SECTION AT WEST SILL 11

SCALE: 1-1/2 " = 1'-0" D-CWK01

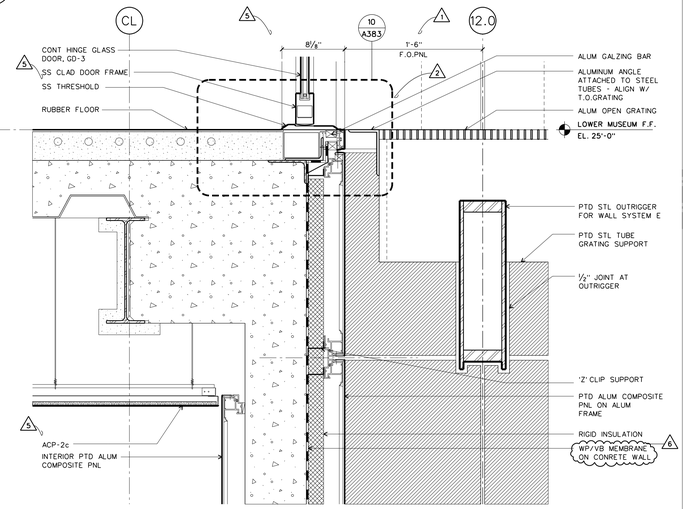

WALL SYSTEM K: DETAIL SECTION AT DOOR SILL 10

SCALE: 1-1/2 " = 1'-0" D-CWK01

WILLIAM J. CLINTON PRESIDENTIAL CENTER

LITTLE ROCK, ARKANSAS

Architect

POLSHEK PARTNERSHIP LLP
320 West 13th Street
New York, New York 10014
212.807.7171

Coordinating Architects

POLK STANLEY YEARY ARCHITECTS Ltd
700 South Schiller Street
Little Rock, Arkansas 72201
501.378.0878

WITSELL EVANS RASCO
901 West Third Street
Little Rock, Arkansas 72201
501.374.5300

WOODS CARADINE ARCHITECTS
2200 South Main Street
Little Rock, Arkansas 72206
501.374.4060

Landscape Architects

HARGREAVES ASSOCIATES
118 Magazine Street
Cambridge, Massachusettes 02139
617.661.0070

LANDSCAPE ARCHITECTURE, Inc.
2300 Cottondale Lane Suite 202
Little Rock, Arkansas 72202
501.374.5610

Structural Engineer

LESLIE E. ROBERTSON ASSOC., RLLP
30 Broad Street, 47th Floor
New York, New York 10004
212.750.9000

MEP Engineers

FLACK + KURTZ Inc.
475 Fifth Avenue
New York, New York 10017
212.532.9600


CROMWELL ARCHITECTS ENGINEERS
101 South Spring Street
Little Rock, Arkansas 72201
501.372.2900

Curtainwall Consultant

R. A. HEINTGES ARCHITECTS
126 Fifth Avenue, 9th Floor
New York, New York 10011
212.652-2966

Seal

6	ASI #22	08/01/03
5	ASI #20	06/06/03
4	ASI #18	04/18/03
3	ASI #12	02/07/03
2	100% Construction Documents	09/27/02
1	90% Progress Printing	08/30/02
	100% Struct./ CD Progress	07/01/02
	100% Design Development	03/01/02
	Issue	Date

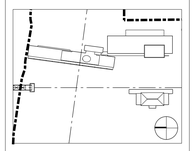

Job No. 9908

Scale 1-1/2" = 1'-0"

Date September 27, 2002


Title

WALL SYSTEMS K DETAIL SECTIONS

Sheet No.


A382

FOR OFFICIAL USE ONLY

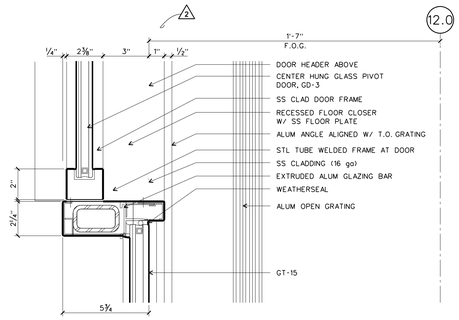


WALL SYSTEM K: PLAN DETAIL AT DOOR JAMB

SCALE: 3 " = 1'-0" D-CWK02 **32**

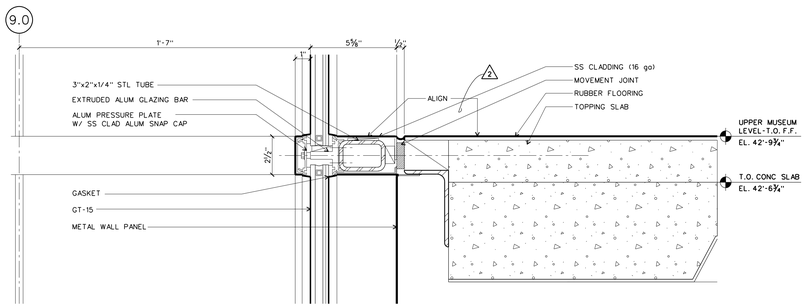


WALL SYSTEM K: SECTION DETAIL AT SILL

SCALE: 3 " = 1'-0" D-CWK02 **41**

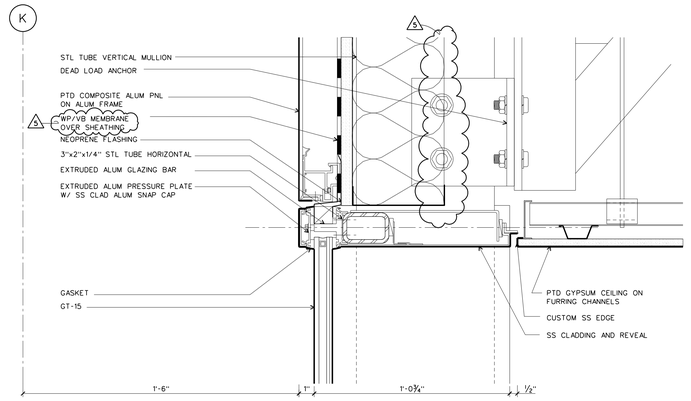


WALL SYSTEM K: SECTION DETAIL AT HEAD

SCALE: 3 " = 1'-0" D-CWK02 **40**

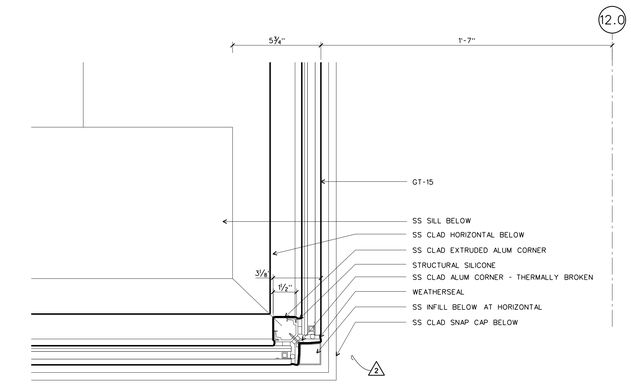


WALL SYSTEM K: PLAN DETAIL AT CORNER

SCALE: 3 " = 1'-0" D-CWK02 **22**

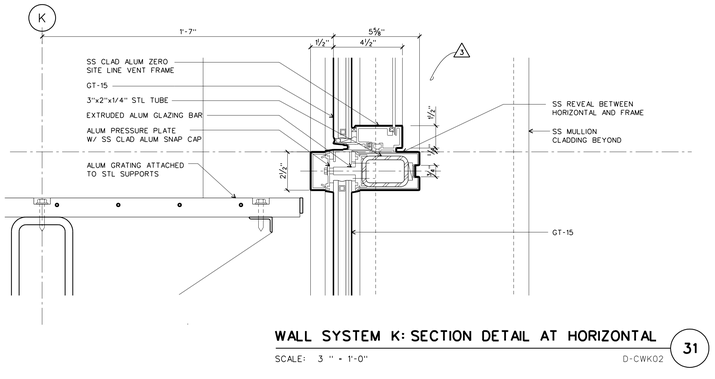


WALL SYSTEM K: SECTION DETAIL AT HORIZONTAL

SCALE: 3 " = 1'-0" D-CWK02 **31**

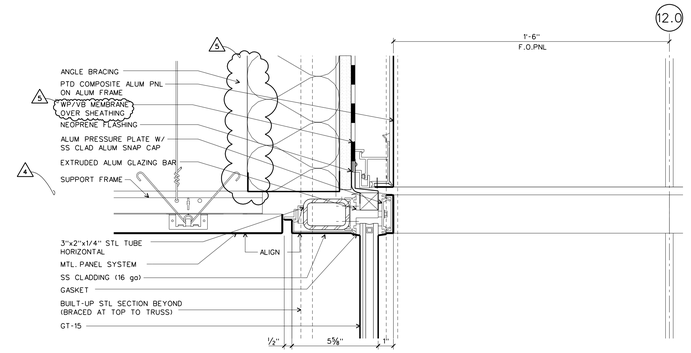


WALL SYSTEM K: SECTION DETAIL AT HEAD

SCALE: 3 " = 1'-0" D-CWK02 **30**

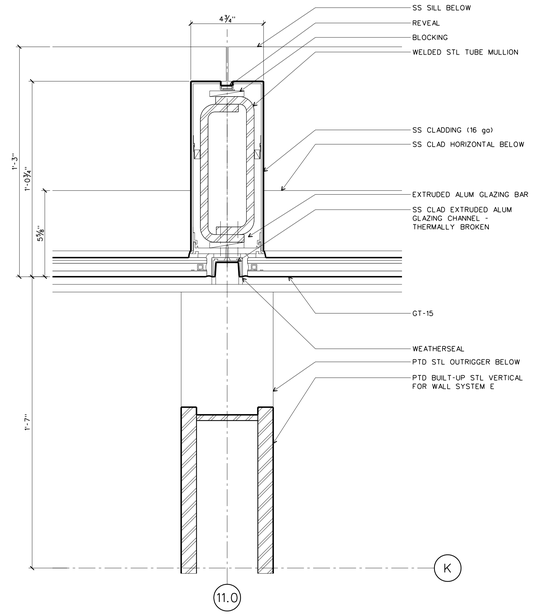


WALL SYSTEM K: PLAN DETAIL AT MULLION

SCALE: 3 " = 1'-0" D-CWK02 **12**

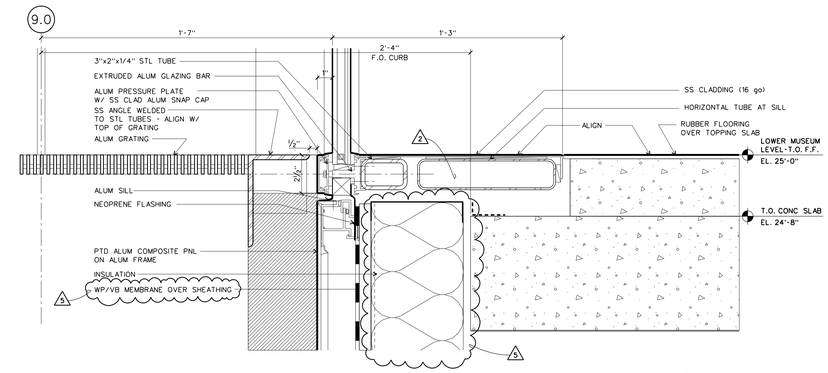


WALL SYSTEM K: SECTION DETAIL AT SILL

SCALE: 3 " = 1'-0" D-CWK02 **21**

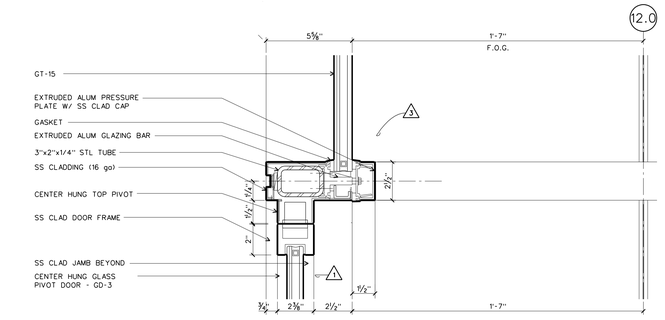


WALL SYSTEM K: SECTION DETAIL AT DOOR HEAD

SCALE: 3 " = 1'-0" D-CWK02 **20**

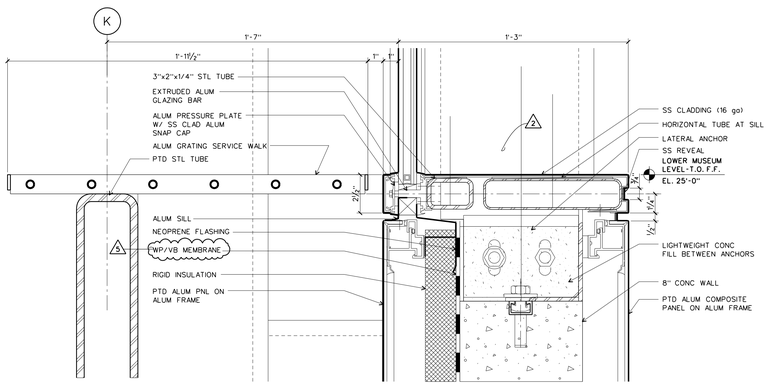

WALL SYSTEM K: SECTION DETAIL AT SILL

SCALE: 3 " = 1'-0" D-CWK02 **11**

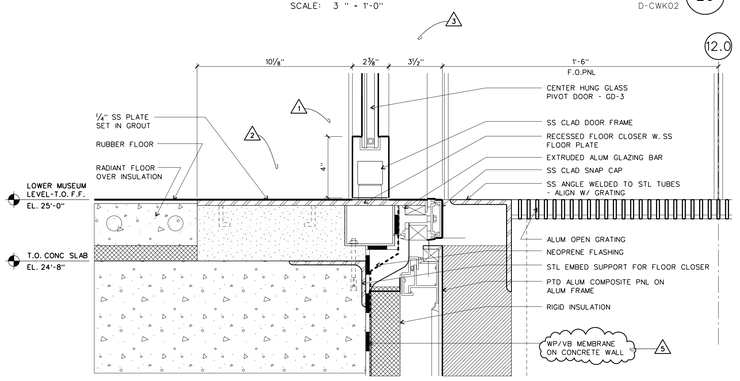

WALL SYSTEM K: SECTION DETAIL AT DOOR

SCALE: 3" = 1'-0" D-CWK02 **10**

WILLIAM J. CLINTON PRESIDENTIAL CENTER

LITTLE ROCK, ARKANSAS

Architect

POLSHEK PARTNERSHIP LLP
320 West 13th Street
New York, New York 10014
212.807.7171

Coordinating Architects

POLK STANLEY YEARY ARCHITECTS Ltd
700 South Schiller Street
Little Rock, Arkansas 72201
501.378.0878

WITSELL EVANS RASCO
901 West Third Street
Little Rock, Arkansas 72201
501.374.5300

WOODS CARADINE ARCHITECTS
2200 South Main Street
Little Rock, Arkansas 72206
501.374.4060

Landscape Architects

HARGREAVES ASSOCIATES
118 Magazine Street
Cambridge, Massachusettes 02139
617.661.0070

LANDSCAPE ARCHITECTURE, Inc.
2300 Cottondale Lane Suite 202
Little Rock, Arkansas 72202
501.374.5610

Structural Engineer

LESLIE E. ROBERTSON ASSOC., RLLP
30 Broad Street, 47th Floor
New York, New York 10004
212.750.9000

MEP Engineers

FLACK + KURTZ Inc.
475 Fifth Avenue
New York, New York 10017
212.532.9600


CROMWELL ARCHITECTS ENGINEERS
101 South Spring Street
Little Rock, Arkansas 72201
501.372.2900

Curtainwall Consultant

R. A. HEINTGES ARCHITECTS
126 Fifth Avenue, 9th Floor
New York, New York 10011
212.652-2966

Seal

Issue	Date
5 ASI #22	08.01.03
4 ASI #18	04/18/03
3 Addendum #2	11/15/02
2 100% Construction Documents	09/27/02
1 90% Progress Printing	08/30/02
100% Struct./ CD Progress	07/01/02
100% Design Development	03/01/02

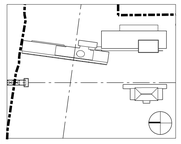

Job No. 9908

Scale 3" = 1'-0"

Date September 27, 2002


Title

WALL SYSTEMS K PLAN AND SECTION DETAILS

Sheet No.

A383

FOR OFFICIAL USE ONLY

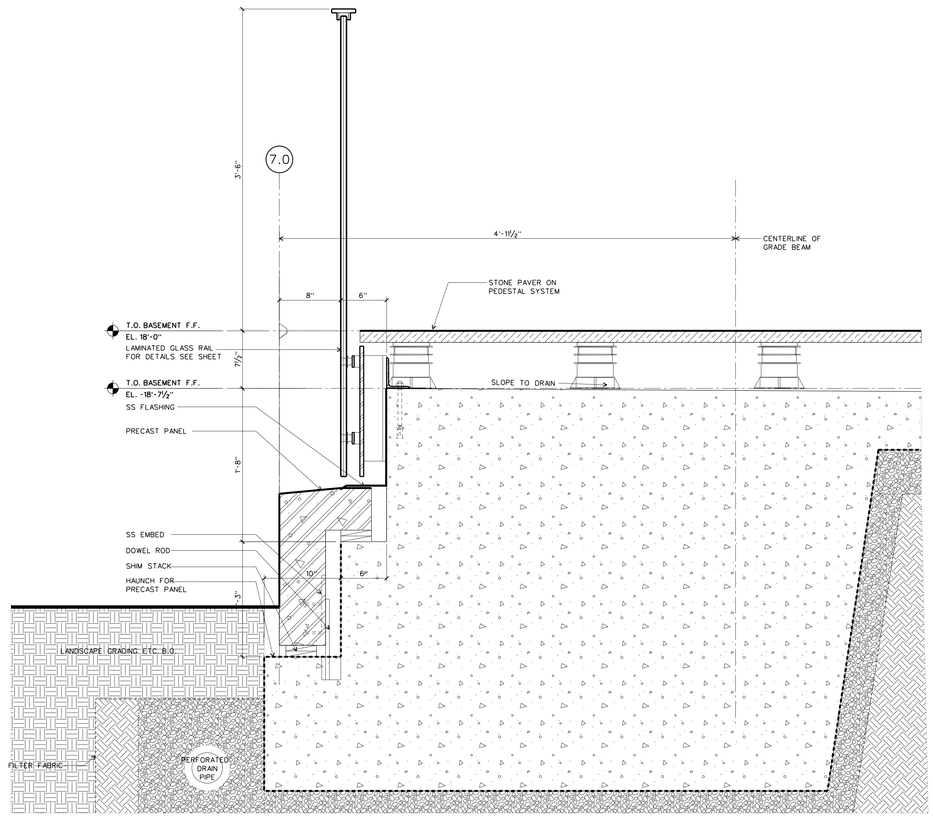


SECTION DETAIL AT CAFE TERRACE RAIL/PRECAST

SCALE: 1-1/2 " = 1'-0"

D-EXT-PLZ

11

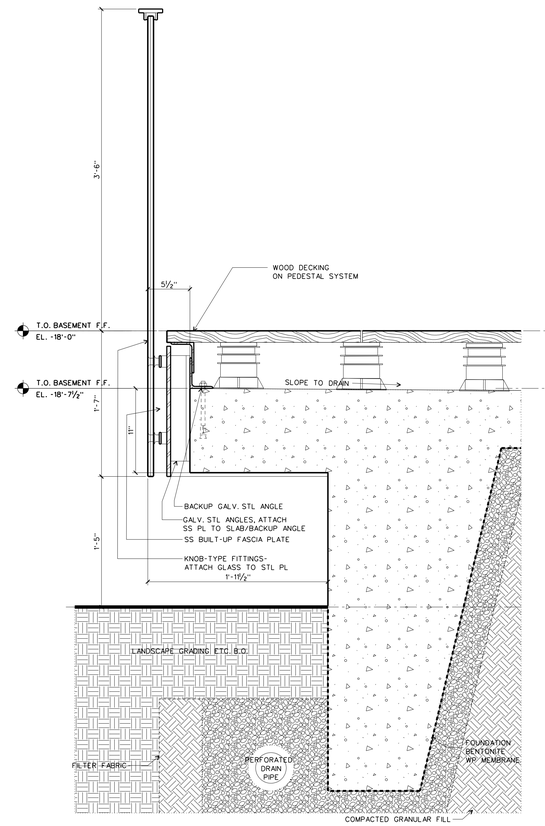

SECTION DETAIL AT CAFE TERRACE RAIL

SCALE: 1-1/2 " = 1'-0"

D-EXT-PLZ

10

WILLIAM J. CLINTON PRESIDENTIAL CENTER

LITTLE ROCK, ARKANSAS

Architect

POLSHEK PARTNERSHIP LLP
320 West 13th Street
New York, New York 10014
212.807.7171

Coordinating Architects

POLK STANLEY YEARY ARCHITECTS Ltd
700 South Schiller Street
Little Rock, Arkansas 72201
501.378.0878

WITSELL EVANS RASCO
901 West Third Street
Little Rock, Arkansas 72201
501.374.5300

WOODS CARADINE ARCHITECTS
2200 South Main Street
Little Rock, Arkansas 72206
501.374.4060

Landscape Architects

HARGREAVES ASSOCIATES
118 Magazine Street
Cambridge, Massachusettes 02139
617.661.0070

LANDSCAPE ARCHITECTURE, Inc.
2300 Cottondale Lane Suite 202
Little Rock, Arkansas 72202
501.374.5610

Structural Engineer

LESLIE E. ROBERTSON ASSOC., RLLP
30 Broad Street, 47th Floor
New York, New York 10004
212.750.9000

MEP Engineers

FLACK + KURTZ Inc.
475 Fifth Avenue
New York, New York 10017
212.532.9600


CROMWELL ARCHITECTS ENGINEERS
101 South Spring Street
Little Rock, Arkansas 72201
501.372.2900

Curtainwall Consultant

R. A. HEINTGES ARCHITECTS
126 Fifth Avenue, 9th Floor
New York, New York 10011
212.652-2966

Seal

Issue	Date
100% Design Development	03/01/02
& Architectural CD Progress	
100% Steel & Concrete CD	05/15/02
Bridge Bldg. Substructure	06/14/02
100% Struct./ CD Progress	07/01/02
ASI #05	08/20/02
90% Progress Printing	08/30/02
100% Construction Documents	09/27/02

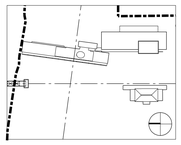

Job No.
9908

Scale
1-1/2" = 1'-0"

Date
September 27, 2002


Title

EXTERIOR PLAZA DETAILS

Sheet No.


A385

FOR OFFICIAL USE ONLY

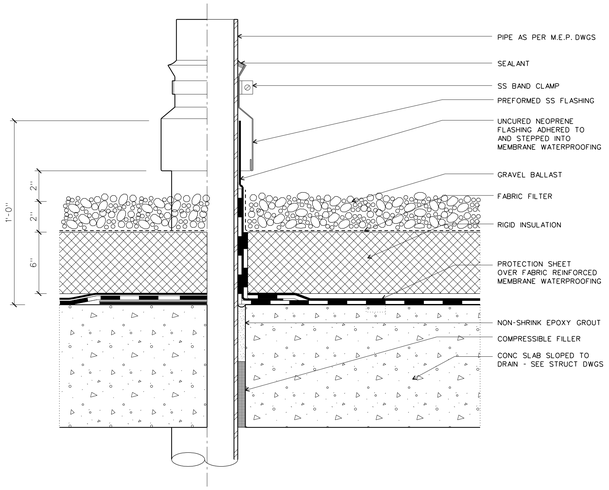

PIPE PENETRATION AT FLUID APPLIED MEMBRANE ROOF 22

SCALE: 3 " = 1'-0"

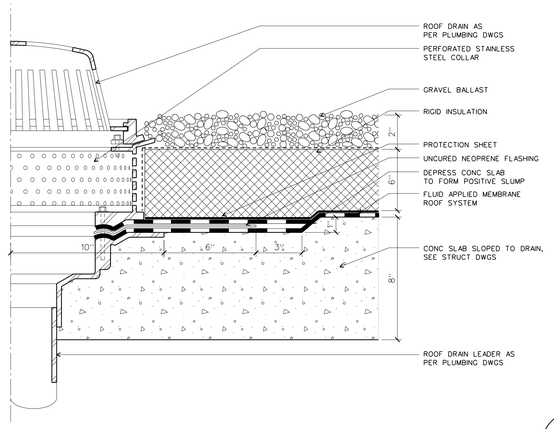

ROOF DRAIN AT FLUID APPLIED MEMBRANE ROOF 21

SCALE: 3 " = 1'-0"

DETAIL SECTION AT WINDOW WASHING TRACK 11

SCALE: 3 " = 1'-0"

PLAN DETAIL AT GRATING STEP 10

SCALE: ½" = 1'-0"

WILLIAM J. CLINTON PRESIDENTIAL CENTER

LITTLE ROCK, ARKANSAS

Architect

POLSHEK PARTNERSHIP LLP
320 West 13th Street
New York, New York 10014
212.807.7171

Coordinating Architects

POLK STANLEY YEARY ARCHITECTS Ltd
700 South Schiller Street
Little Rock, Arkansas 72201
501.378.0878

WITSELL EVANS RASCO
901 West Third Street
Little Rock, Arkansas 72201
501.374.5300

WOODS CARADINE ARCHITECTS
2200 South Main Street
Little Rock, Arkansas 72206
501.374.4060

Landscape Architects

HARGREAVES ASSOCIATES
118 Magazine Street
Cambridge, Massachusettes 02139
617.661.0070

LANDSCAPE ARCHITECTURE, Inc.
2300 Cottondale Lane Suite 202
Little Rock, Arkansas 72202
501.374.5610

Structural Engineer

LESLIE E. ROBERTSON ASSOC., RLLP
30 Broad Street, 47th Floor
New York, New York 10004
212.750.9000

MEP Engineers

FLACK + KURTZ Inc.
475 Fifth Avenue
New York, New York 10017
212.532.9600


CROMWELL ARCHITECTS ENGINEERS
101 South Spring Street
Little Rock, Arkansas 72201
501.372.2900

Curtainwall Consultant

R. A. HEINTGES ARCHITECTS
126 Fifth Avenue, 9th Floor
New York, New York 10011
212.652-2966

Seal

Issue	Date
1 ASI #18	04/18/03
100% Construction Documents	09/27/02
90% Progress Printing	08/30/02

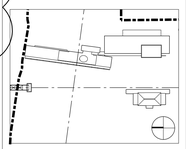

Job No. 9908

Scale AS NOTED

Date September 27, 2002


Title

ROOF DETAILS

Sheet No.

A386


FOR OFFICIAL USE ONLY

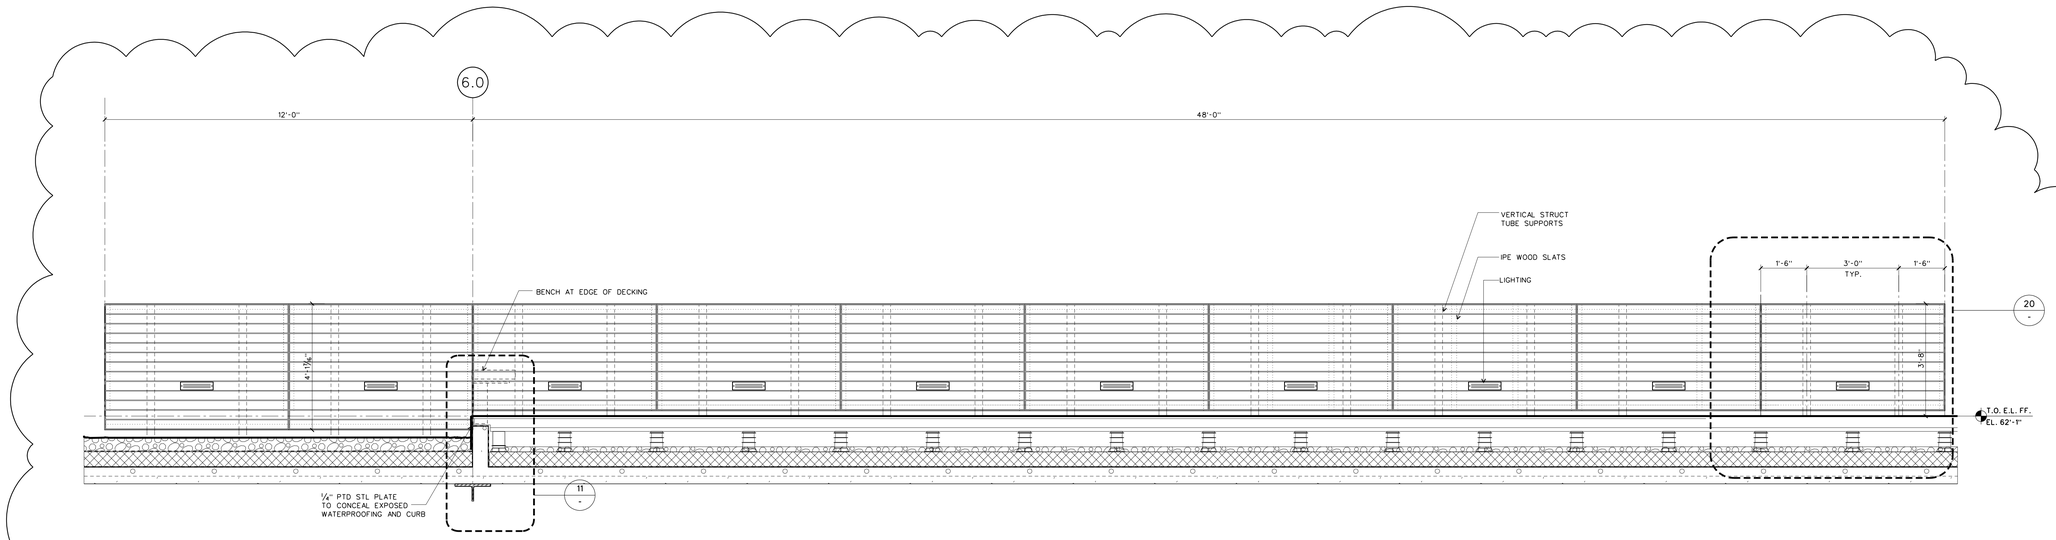

DETAIL ELEVATION AT IPE SCREEN WALL

SCALE: ½" = 1'-0"


D-EXT-ROOF02 — 30

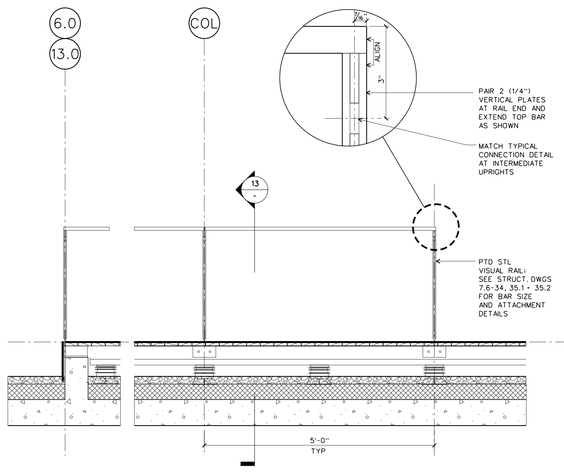

ELEVATION AT VISUAL RAIL: END CONDITIONS

SCALE: ¾" = 1'-0"


D-EXT-ROOF02 — 23

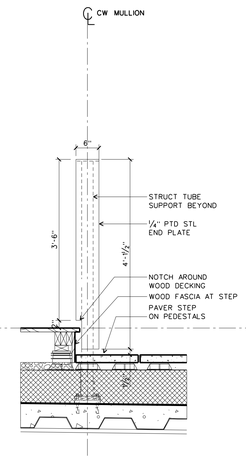

IPE SCREEN WALL END ELEVATION

SCALE: ¾" = 1'-0"


D-EXT-ROOF02 — 22

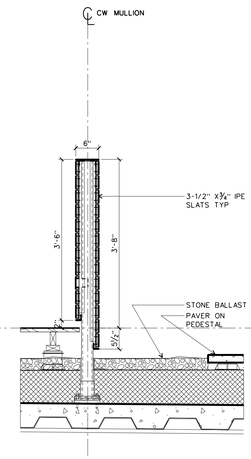

IPE SCREEN WALL SECTION

SCALE: ¾" = 1'-0"


D-EXT-ROOF02 — 21

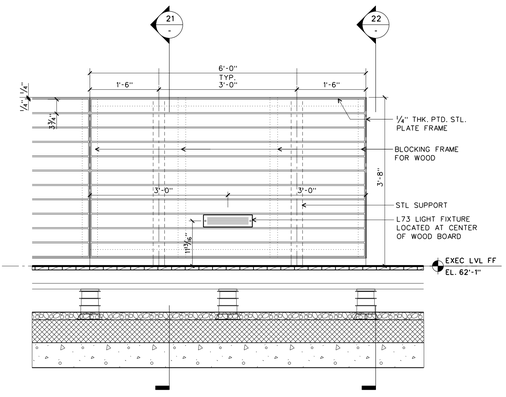

DETAIL ELEVATION AT IPE SCREEN WALL

SCALE: ¾" = 1'-0"


D-EXT-ROOF02 — 20

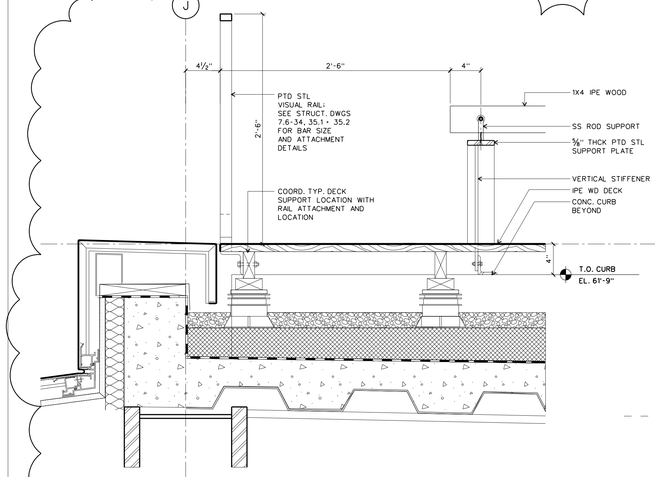

SECTION AT WOOD BENCH END AND VISUAL RAIL

SCALE: 1-1/2 " = 1'-0"


D-EXT-ROOF02 — 13

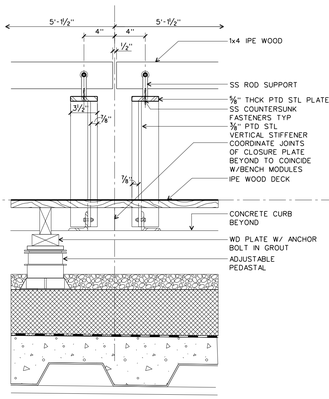

SECTION AT IPE WOOD BENCH

SCALE: 1-1/2 " = 1'-0"


D-EXT-ROOF02 — 12

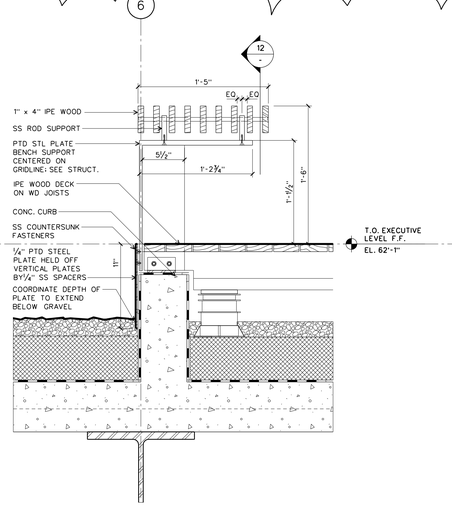

CROSS SECTION AT IPE WOOD BENCH

SCALE: 1-1/2 " = 1'-0"

D-EXT-ROOF02 — 11

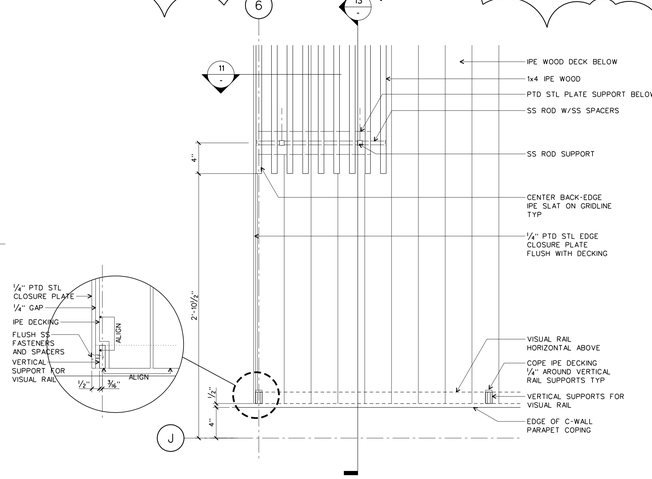

PLAN DETAIL AT IPE WOOD BENCH

SCALE: 1-1/2 " = 1'-0"

D-EXT-ROOF02 — 10

WILLIAM J. CLINTON PRESIDENTIAL CENTER

LITTLE ROCK, ARKANSAS

Architect

POLSHEK PARTNERSHIP LLP
320 West 13th Street
New York, New York 10014
212.807.7171

Coordinating Architects

POLK STANLEY YEARY ARCHITECTS Ltd
700 South Schiller Street
Little Rock, Arkansas 72201
501.378.0878

WITSELL EVANS RASCO
901 West Third Street
Little Rock, Arkansas 72201
501.374.5300

WOODS CARADINE ARCHITECTS
2200 South Main Street
Little Rock, Arkansas 72206
501.374.4060

Landscape Architects

HARGREAVES ASSOCIATES
118 Magazine Street
Cambridge, Massachusettes 02139
617.661.0070

LANDSCAPE ARCHITECTURE, Inc.
2300 Cottondale Lane Suite 202
Little Rock, Arkansas 72202
501.374.5610

Structural Engineer

LESLIE E. ROBERTSON ASSOC., RLLP
30 Broad Street, 47th Floor
New York, New York 10004
212.750.9000

MEP Engineers

FLACK + KURTZ Inc.
475 Fifth Avenue
New York, New York 10017
212.532.9600


CROMWELL ARCHITECTS ENGINEERS
101 South Spring Street
Little Rock, Arkansas 72201
501.372.2900

Curtainwall Consultant

R. A. HEINTGES ARCHITECTS
126 Fifth Avenue, 9th Floor
New York, New York 10011
212.652-2966

Seal

	Issue	Date
2	ASI #36	06/25/04
1	Addendum #2	11/15/02
	100% Construction Documents	09/27/02
	90% Progress Printing	08/30/02
	ASI #05	08/20/02
	100% Struct./ CD Progress	07/01/02
	Bridge Bldg. Substructure	06/14/02
	100% Steel & Concrete CD & Architectural CD Progress	05/15/02
	100% Design Development	03/01/02

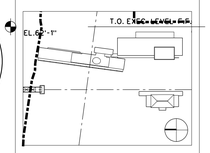

Job No. 9908

Scale 1-1/2" = 1'-0"


Date September 27, 2002


Title

ROOF DETAILS

Sheet No. 2 A387


FOR OFFICIAL USE ONLY

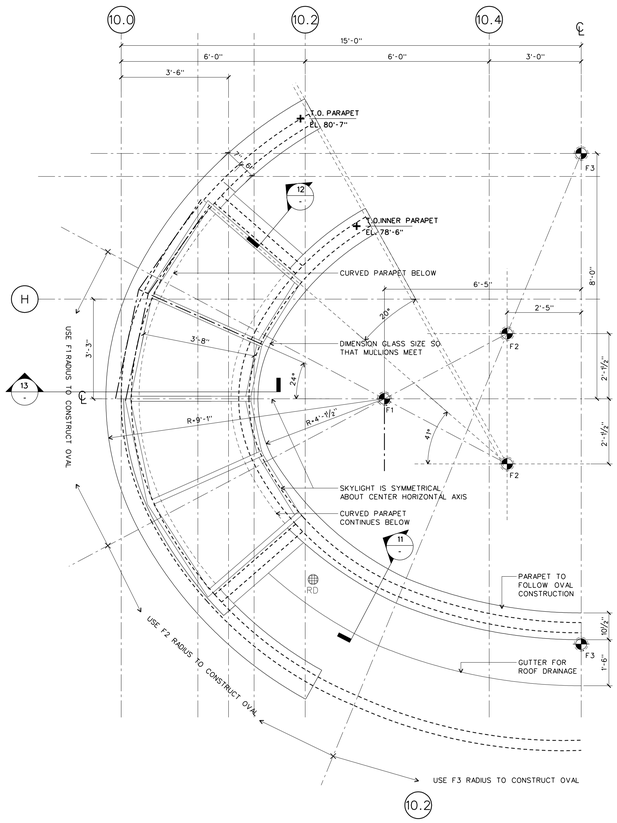

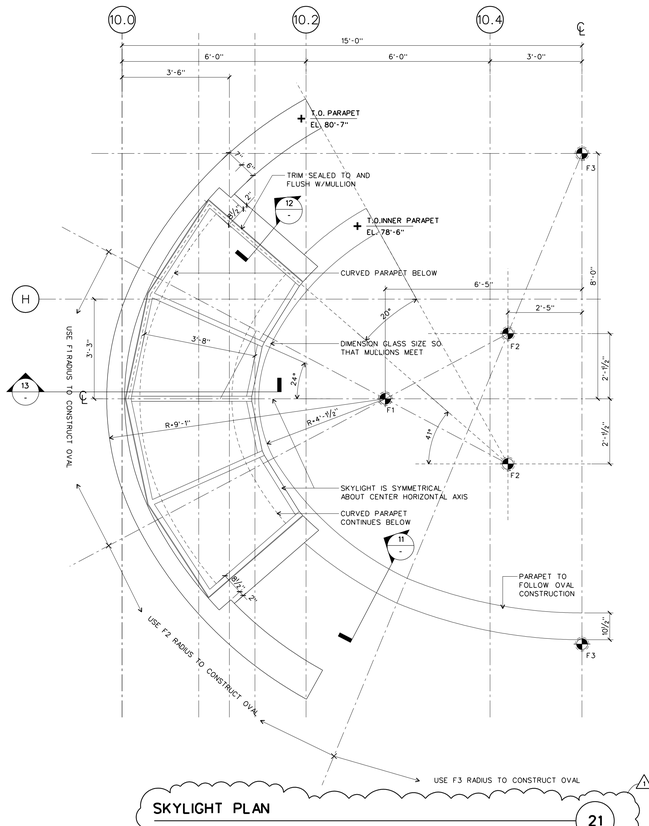


SKYLIGHT PLAN

SCALE: 1-1/2" = 1'-0" 21

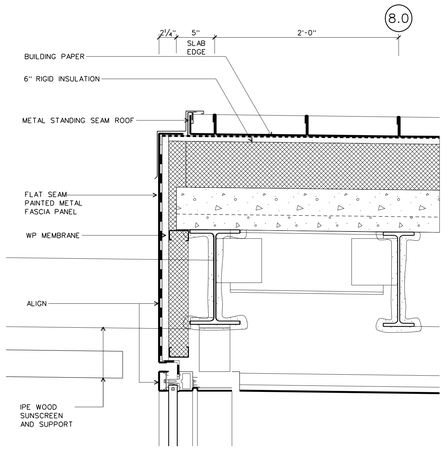


EXEC ROOF: DETAIL SECTION THROUGH GABLE TYP


SCALE: 1-1/2" = 1'-0" 30

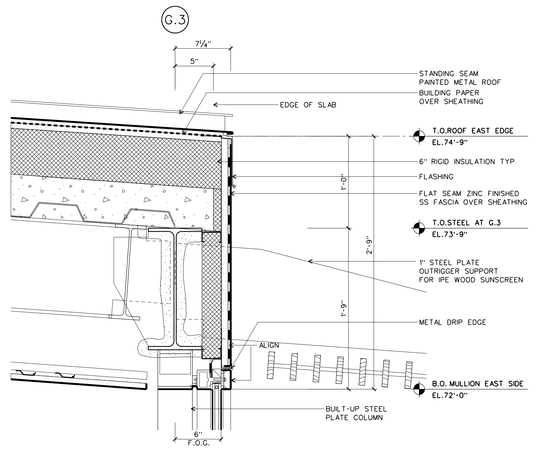

EXEC ROOF: DETAIL SECTION THROUGH WEST EAVE


SCALE: 1-1/2" = 1'-0" 20

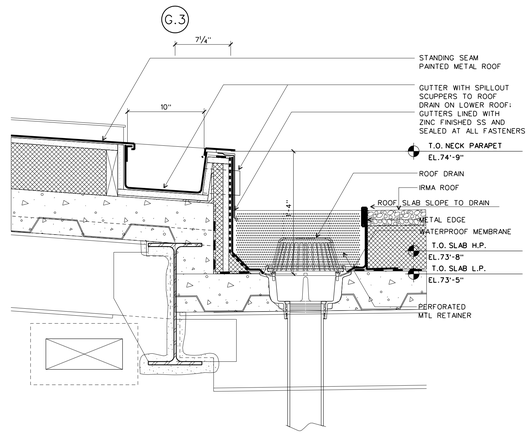

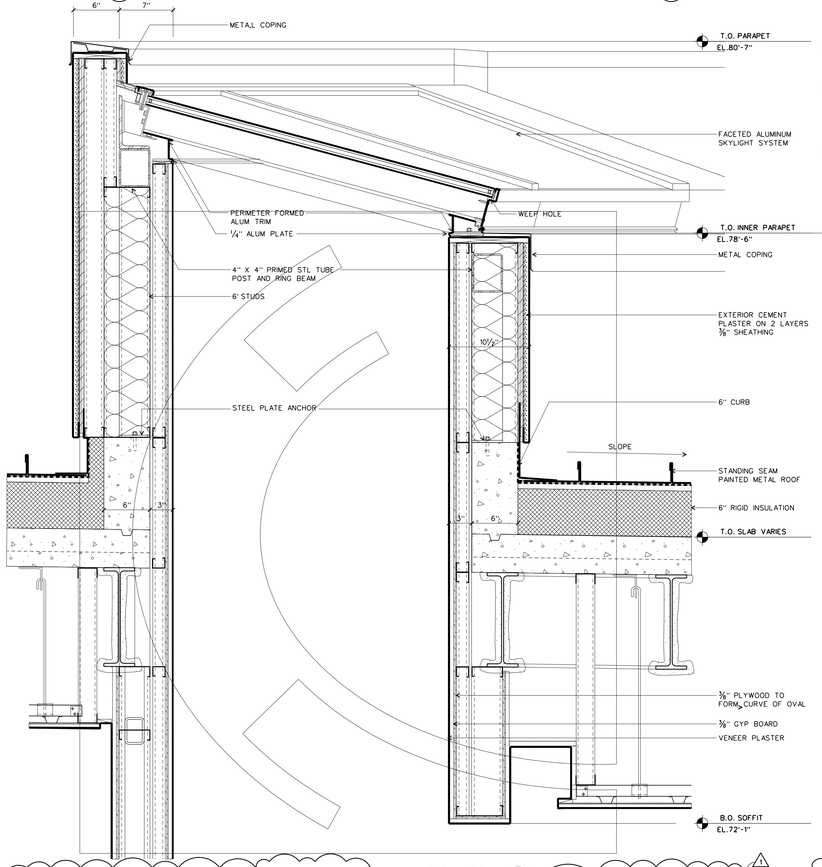


EXEC SKYLIGHT: SECTION DETAIL

SCALE: 1-1/2" = 1'-0" 13

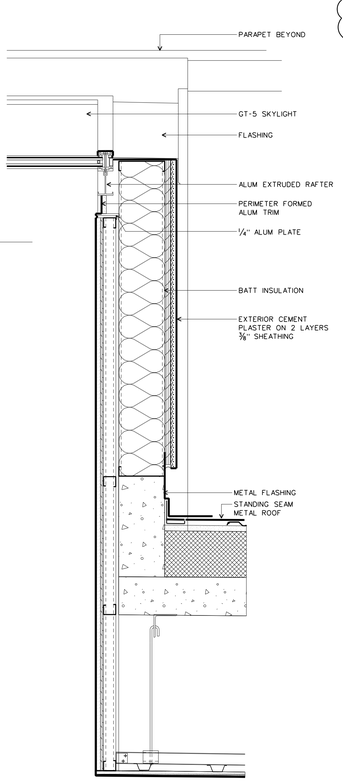

EXEC SKYLIGHT: DETAIL SECTION OF GABLE

SCALE: 1-1/2" = 1'-0" 12

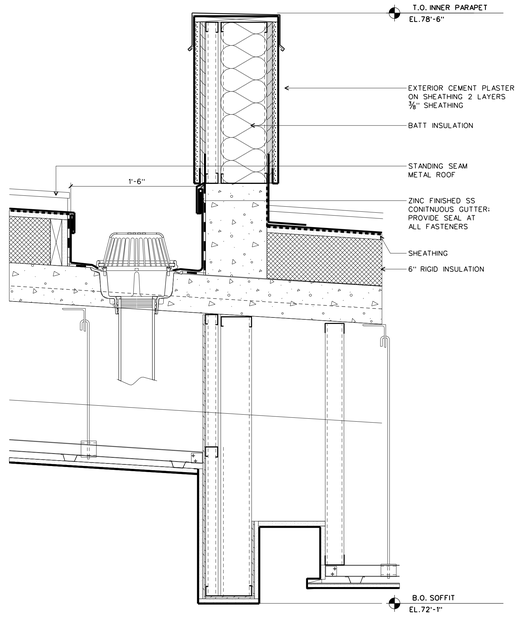

EXEC ROOF: DETAIL SECTION THROUGH WEST PARAPET

SCALE: 1-1/2" = 1'-0" 11

EXEC ROOF: DETAIL SECTION OF TRANSITION TO CORE ROOF

SCALE: 1-1/2" = 1'-0" 10

WILLIAM J. CLINTON PRESIDENTIAL CENTER

LITTLE ROCK, ARKANSAS

Architect

POLSHEK PARTNERSHIP LLP
320 West 13th Street
New York, New York 10014
212.807.7171

Coordinating Architects

POLK STANLEY YEARY ARCHITECTS Ltd
700 South Schiller Street
Little Rock, Arkansas 72201
501.378.0878

WITSELL EVANS RASCO
901 West Third Street
Little Rock, Arkansas 72201
501.374.5300

WOODS CARADINE ARCHITECTS
2200 South Main Street
Little Rock, Arkansas 72206
501.374.4060

Landscape Architects

HARGREAVES ASSOCIATES
118 Magazine Street
Cambridge, Massachusettes 02139
617.661.0070

LANDSCAPE ARCHITECTURE, Inc.
2300 Cottondale Lane Suite 202
Little Rock, Arkansas 72202
501.374.5610

Structural Engineer

LESLIE E. ROBERTSON ASSOC., RLLP
30 Broad Street, 47th Floor
New York, New York 10004
212.750.9000

MEP Engineers

FLACK + KURTZ Inc.
475 Fifth Avenue
New York, New York 10017
212.532.9600

CROMWELL ARCHITECTS ENGINEERS
101 South Spring Street
Little Rock, Arkansas 72201
501.372.2900

Curtainwall Consultant

R. A. HEINTGES ARCHITECTS
126 Fifth Avenue, 9th Floor
New York, New York 10011
212.652-2966

Seal

Issue	Date
1 100% Construction Documents	09/27/02
90% Progress Printing	08/30/02

Job No. 9908

Scale AS NOTED

Date September 27, 2002


Title

MUSEUM BUILDING: ROOF DETAILS - EXEC LVL ROOF & SKYLIGHT

Sheet No.


A388

FOR OFFICIAL USE ONLY

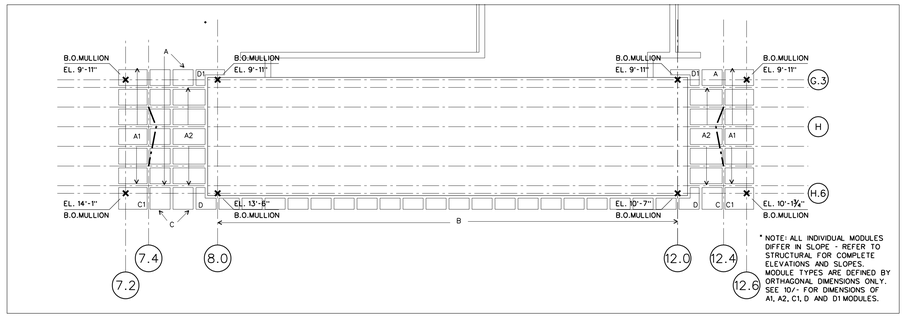


REFERENCE PLAN: MODULES TYPES* AND REF. ELEVATIONS

SCALE: 1-1/2" = 1'-0" detail/canopy exec lev **10A**

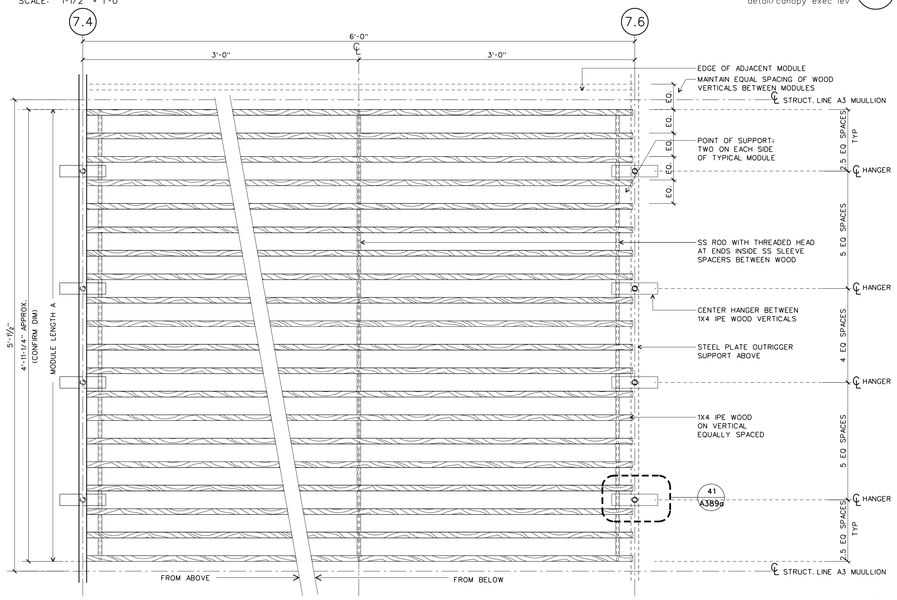


PLAN: TYPICAL SUNSCREEN MODULE LENGTH A

SCALE: 1-1/2" = 1'-0" detail/canopy exec lev **31**

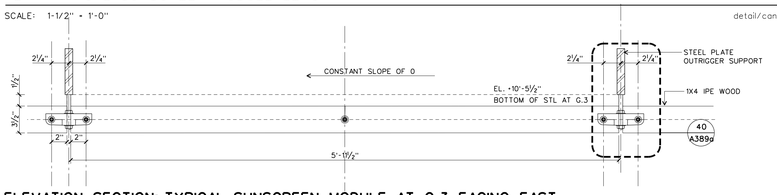


ELEVATION SECTION: TYPICAL SUNSCREEN MODULE AT G.3 FACING EAST

SCALE: 1-1/2" = 1'-0" detail/canopy exec lev **21**

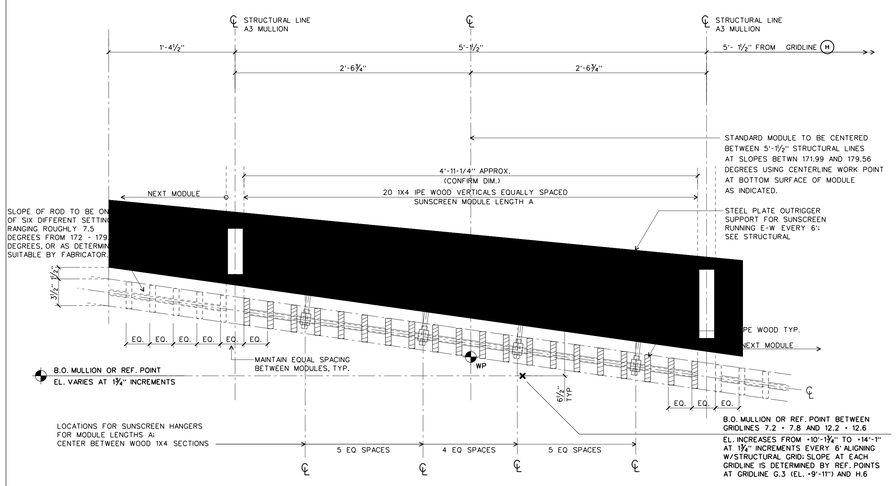


SECTION DETAIL: TYPICAL SUNSCREEN MODULE LENGTH A

SCALE: 1-1/2 " = 1'-0" detail/canopy exec lev **11**

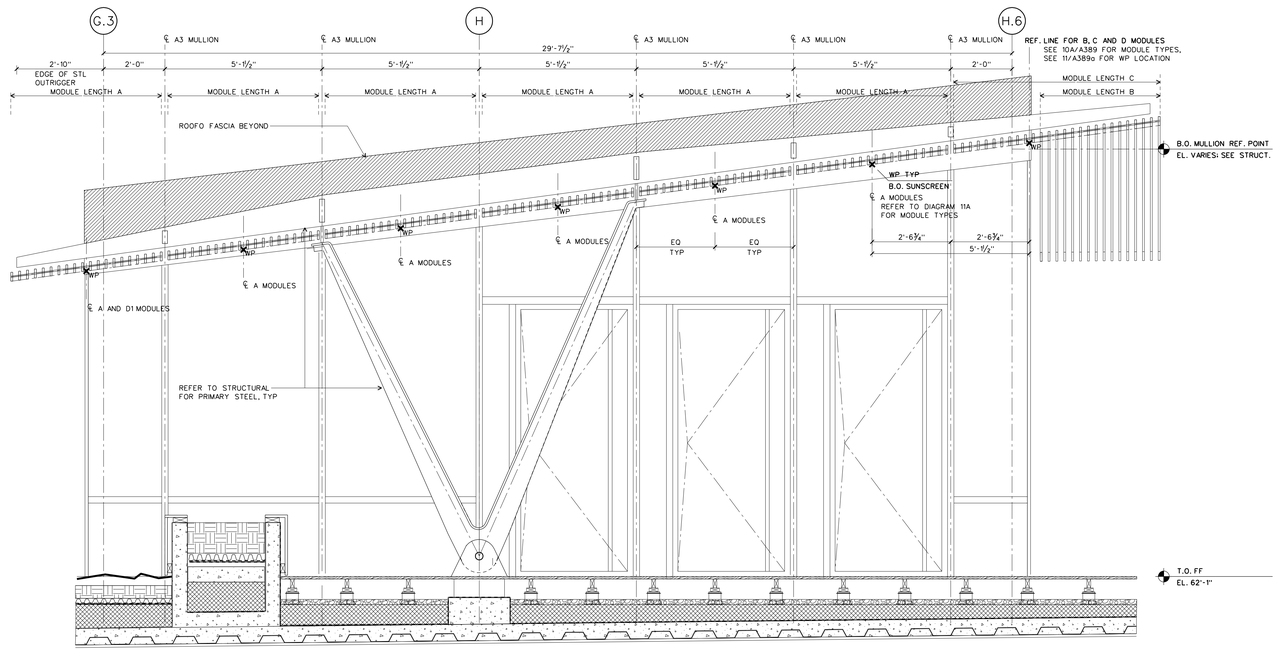

CANOPY SUPPORT AT NORTH

SCALE: ½" = 1'-0" detail/canopy exec lev **20**

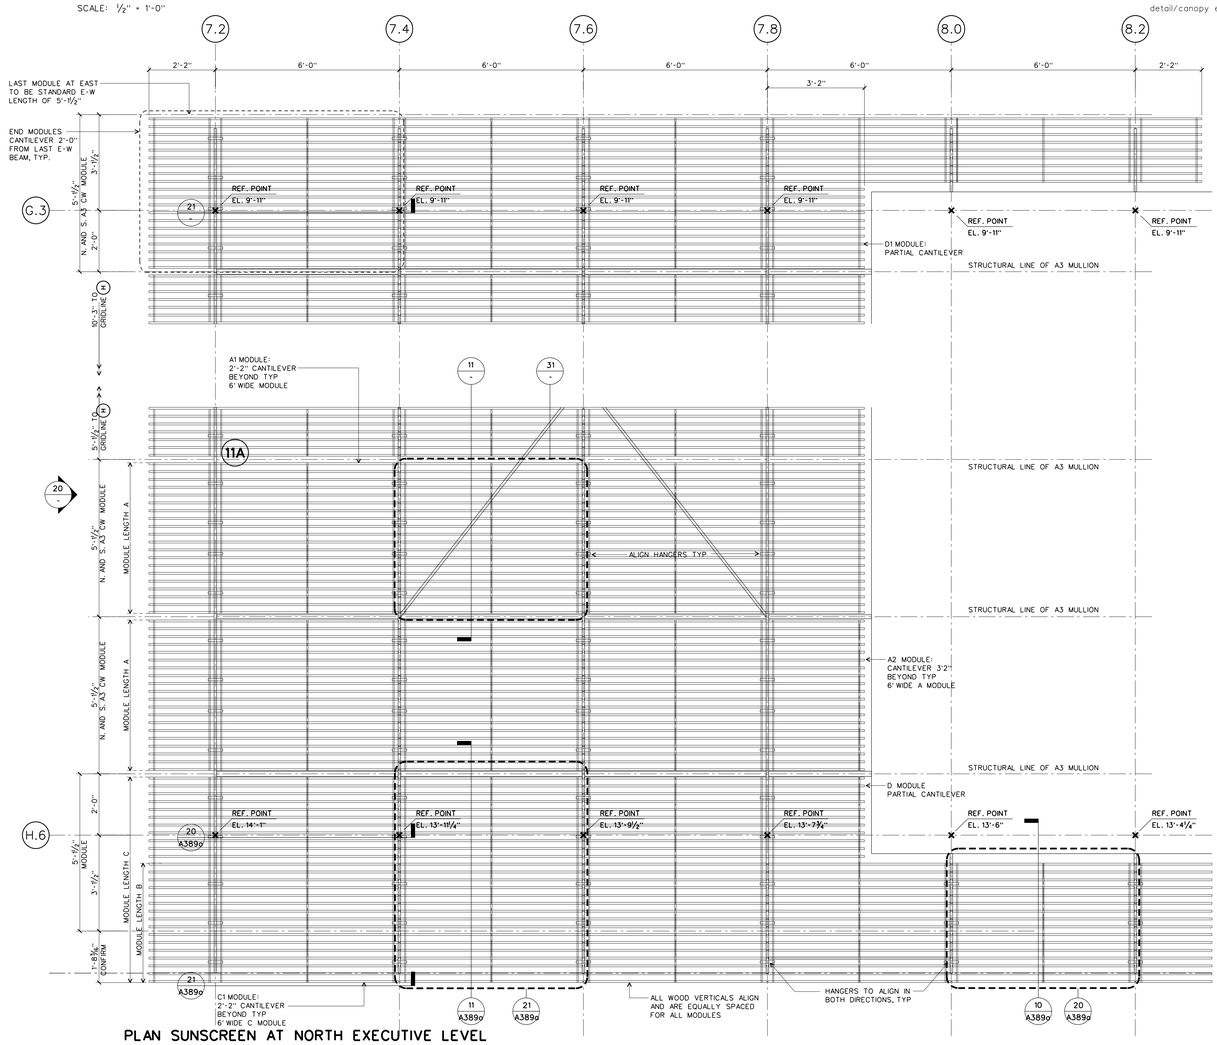

PLAN SUNSCREEN AT NORTH EXECUTIVE LEVEL

SCALE: ½" = 1'-0" detail/canopy exec lev **10**

WILLIAM J. CLINTON PRESIDENTIAL CENTER

LITTLE ROCK, ARKANSAS

Architect

POLSHEK PARTNERSHIP LLP
320 West 13th Street
New York, New York 10014
212.807.7171

Coordinating Architects

POLK STANLEY YEARY ARCHITECTS Ltd
700 South Schiller Street
Little Rock, Arkansas 72201
501.378.0878

WITSELL EVANS RASCO
901 West Third Street
Little Rock, Arkansas 72201
501.374.5300

WOODS CARADINE ARCHITECTS
2200 South Main Street
Little Rock, Arkansas 72206
501.374.4060

Landscape Architects

HARGREAVES ASSOCIATES
118 Magazine Street
Cambridge, Massachusettes 02139
617.661.0070

LANDSCAPE ARCHITECTURE, Inc.
2300 Cottondale Lane Suite 202
Little Rock, Arkansas 72202
501.374.5610

Structural Engineer

LESLIE E. ROBERTSON ASSOC., RLLP
30 Broad Street, 47th Floor
New York, New York 10004
212.750.9000

MEP Engineers

FLACK + KURTZ Inc.
475 Fifth Avenue
New York, New York 10017
212.532.9600


CROMWELL ARCHITECTS ENGINEERS
101 South Spring Street
Little Rock, Arkansas 72201
501.372.2900

Curtainwall Consultant

R. A. HEINTGES ARCHITECTS
126 Fifth Avenue, 9th Floor
New York, New York 10011
212.652-2966

Seal

Issue	Date
ASI #13	02/14/03
Addendum #12	02/07/03
100% Construction Documents	09/27/02
100% Struct./ CD Progress	07/01/02

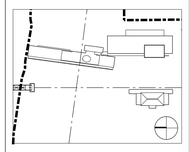

Job No. 9908

Scale AS NOTED

Date September 27, 2002


Title

SUNSCREEN

EXECUTIVE LEVEL


Sheet No. A389

FOR OFFICIAL USE ONLY

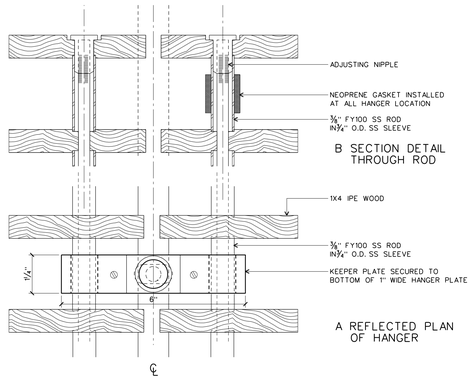

B SECTION DETAIL THROUGH ROD

A REFLECTED PLAN OF HANGER

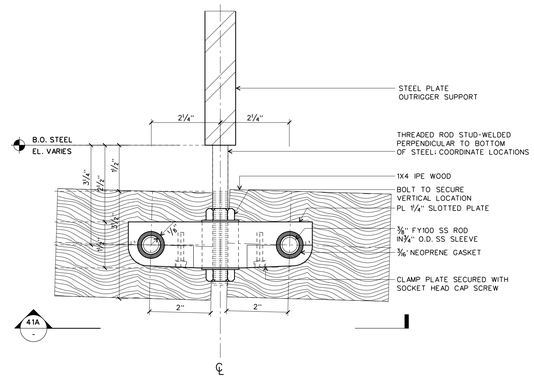


CANOPY: DETAIL PLAN

SCALE: 3 " = 1'-0" detail/canopy exec lev 41


CANOPY: DETAIL SECTION

SCALE: 3 " = 1'-0" detail/canopy exec lev 40

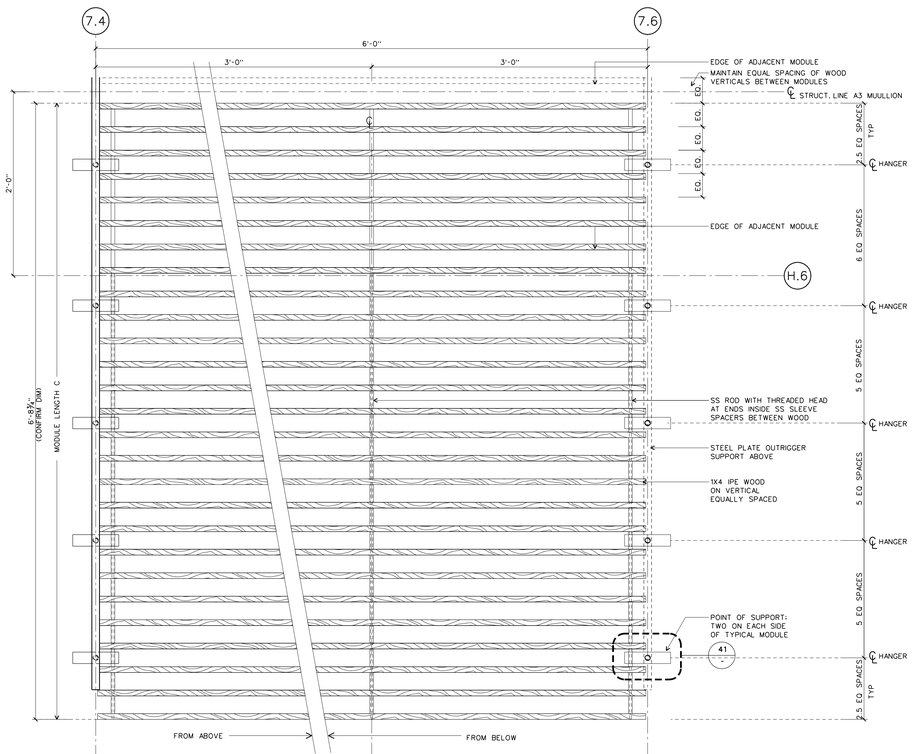


PLAN: TYPICAL SUNSCREEN MODULE LENGTH C

SCALE: 1-1/2" = 1'-0" detail/canopy exec lev 31

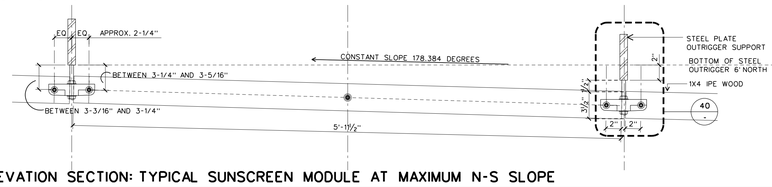


ELEVATION SECTION: TYPICAL SUNSCREEN MODULE AT MAXIMUM N-S SLOPE

SCALE: 1-1/2" = 1'-0" 21

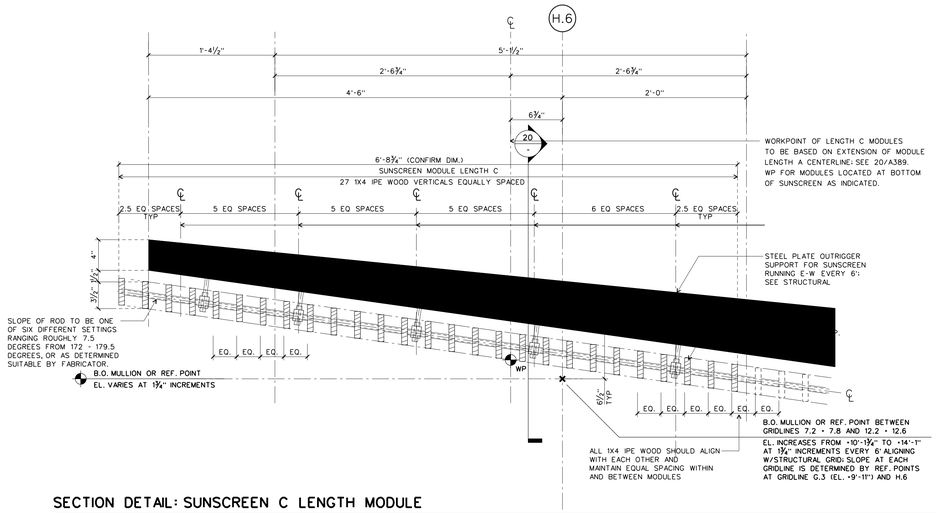


SECTION DETAIL: SUNSCREEN C LENGTH MODULE

SCALE: 1-1/2 " = 1'-0" detail/canopy exec lev 11

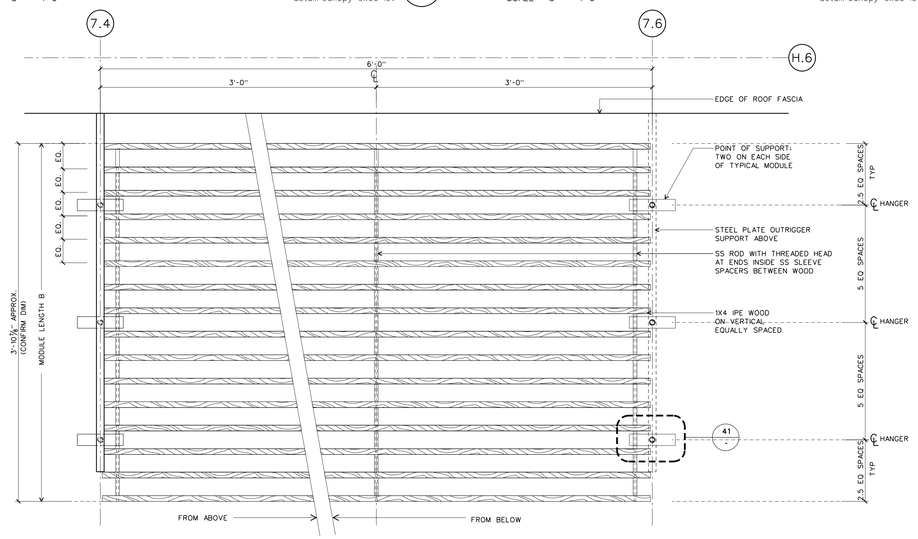


PLAN: TYPICAL SUNSCREEN MODULE LENGTH B

SCALE: 1-1/2" = 1'-0" detail/canopy exec lev 30

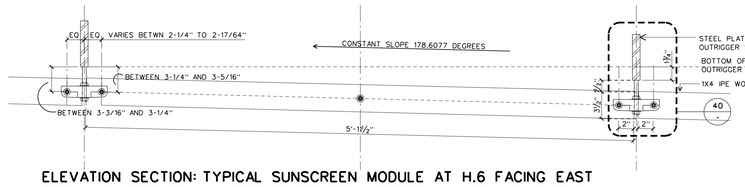

ELEVATION SECTION: TYPICAL SUNSCREEN MODULE AT H.6 FACING EAST

SCALE: 1-1/2" = 1'-0" detail/canopy exec lev 20

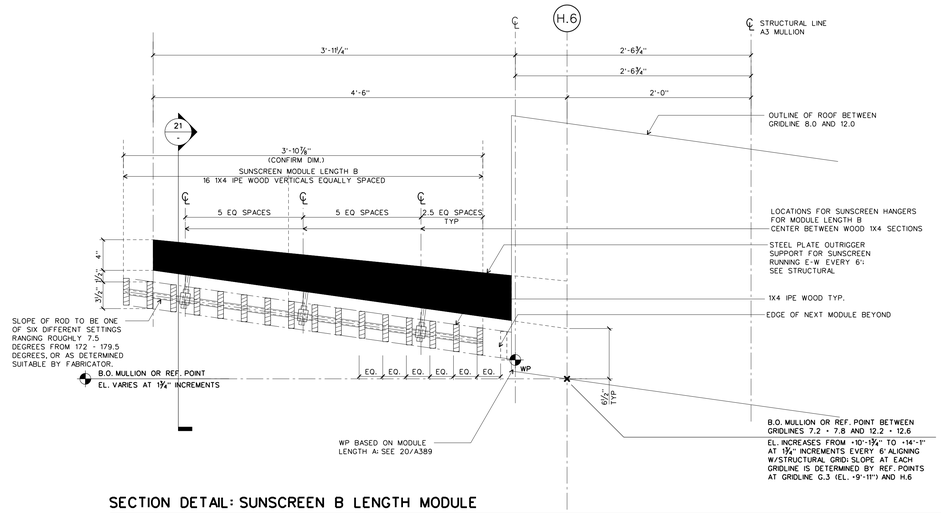

SECTION DETAIL: SUNSCREEN B LENGTH MODULE

SCALE: 1-1/2 " = 1'-0" detail/canopy exec lev 11

WILLIAM J. CLINTON PRESIDENTIAL CENTER

LITTLE ROCK, ARKANSAS

Architect

POLSHEK PARTNERSHIP LLP
320 West 13th Street
New York, New York 10014
212.807.7171

Coordinating Architects

POLK STANLEY YEARY ARCHITECTS Ltd
700 South Schiller Street
Little Rock, Arkansas 72201
501.378.0878

WITSELL EVANS RASCO
901 West Third Street
Little Rock, Arkansas 72201
501.374.5300

WOODS CARADINE ARCHITECTS
2200 South Main Street
Little Rock, Arkansas 72206
501.374.4060

Landscape Architects

HARGREAVES ASSOCIATES
118 Magazine Street
Cambridge, Massachusettes 02139
617.661.0070

LANDSCAPE ARCHITECTURE, Inc.
2300 Cottondale Lane Suite 202
Little Rock, Arkansas 72202
501.374.5610

Structural Engineer

LESLIE E. ROBERTSON ASSOC., RLLP
30 Bread Street, 47th Floor
New York, New York 10004
212.750.9000

MEP Engineers

FLACK + KURTZ Inc.
475 Fifth Avenue
New York, New York 10017
212.532.9600


CROMWELL ARCHITECTS ENGINEERS
101 South Spring Street
Little Rock, Arkansas 72201
501.372.2900

Curtainwall Consultant

R. A. HEINTGES ARCHITECTS
126 Fifth Avenue, 9th Floor
New York, New York 10011
212.652-2966

Seal

Issue	Date
ASI #13	02/14/03

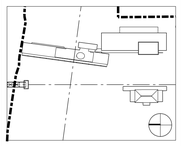

Job No. 9908

Scale AS NOTED

Date September 27, 2002


Title SUNSCREEN


EXECUTIVE LEVEL

Sheet No. SDA-047

A389a


FOR OFFICIAL USE ONLY

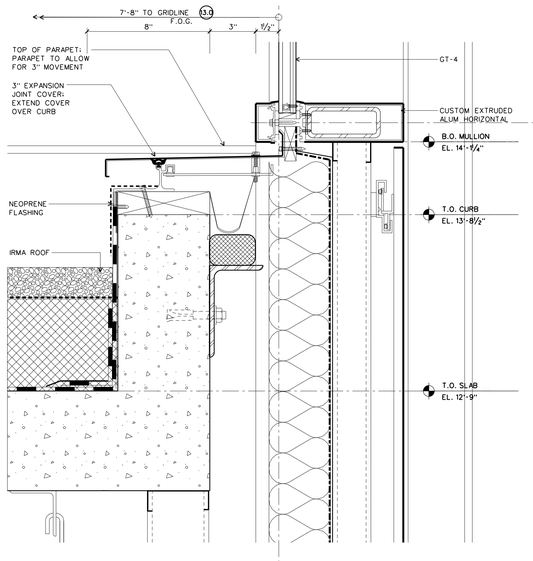

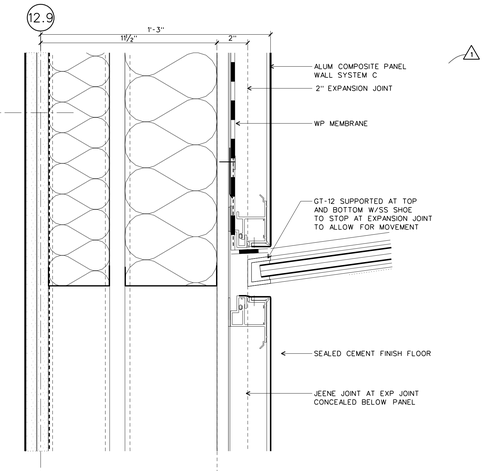


GROUND LEVEL: DETAIL PLAN AT H CURTAINWALL

SCALE: 3 " = 1'-0" D-EXPJNT 32

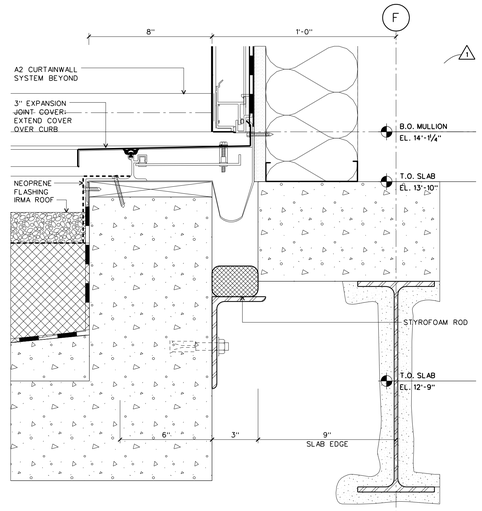


DETAIL SECTION AT ROOF

SCALE: 3 " = 1'-0" D-EXPJNT 31

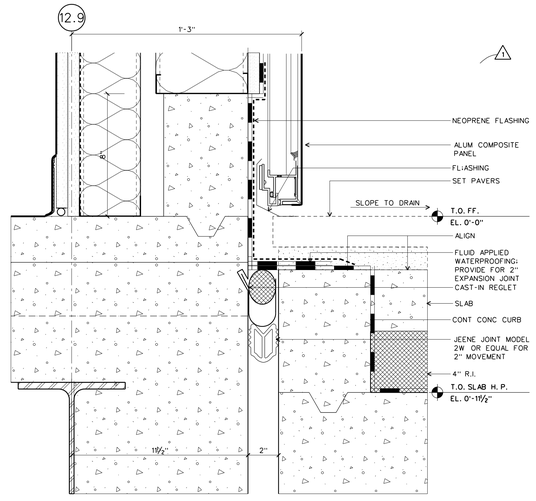


GROUND LEVEL: SECTION AT EXTERIOR

SCALE: 3 " = 1'-0" D-EXPJNT 30

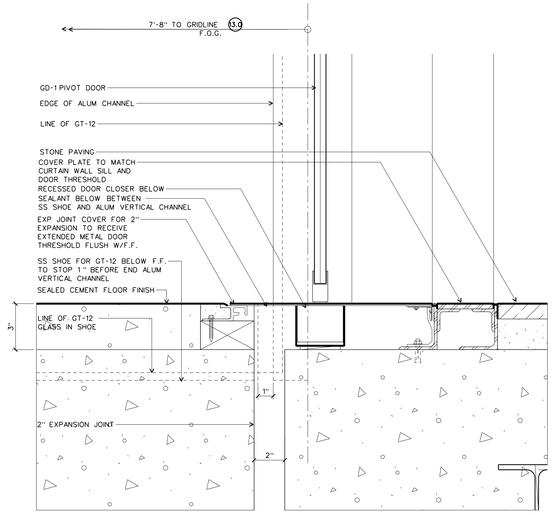


GROUND LEVEL: SECTION DETAIL AT ROOF AND A2 CW DOOR

SCALE: 3 " = 1'-0" D-EXPJNT 22

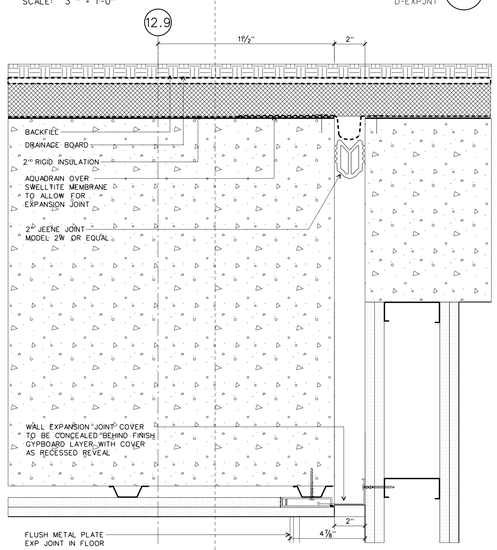


BASEMENT LEVEL: PLAN DETAIL AT FOUNDATION WALL

SCALE: 3 " = 1'-0" D-EXPJNT 22

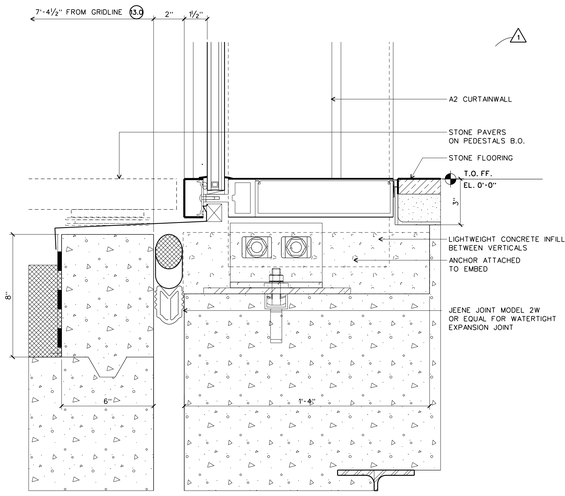


GROUND LEVEL: SECTION AT WALL SYSTEM A2

SCALE: 3 " = 1'-0" D-EXPJNT 21

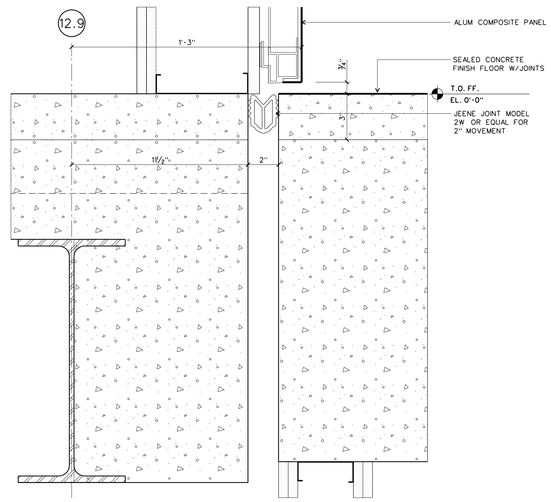


GROUND LEVEL: SECTION AT INTERIOR

SCALE: 3 " = 1'-0" D-EXPJNT 20

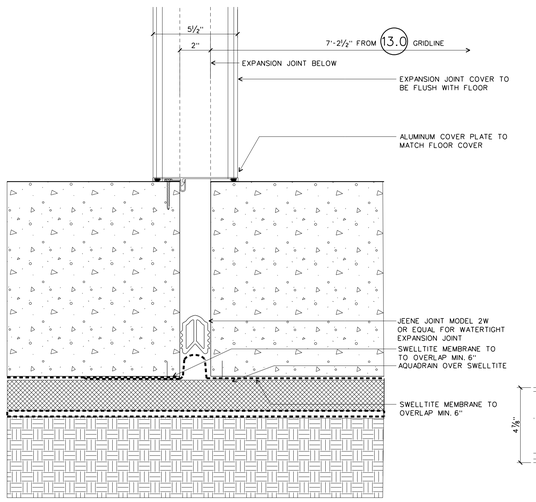


BASEMENT LEVEL: PLAN AT FOUNDATION WALL

SCALE: 3" = 1'-0" D-EXPJNT 13

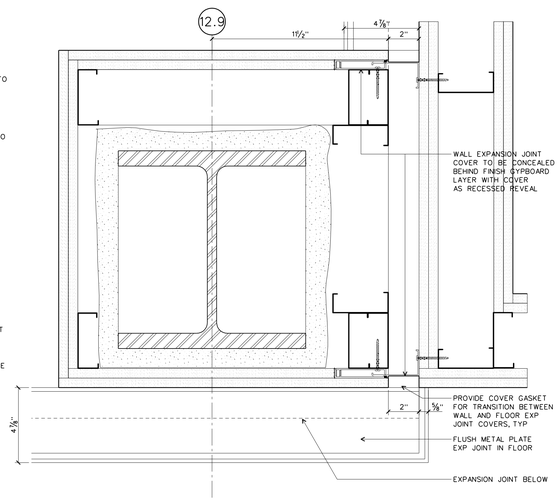


BASEMENT LEVEL: PLAN DETAIL AT INTERIOR

SCALE: 3 " = 1'-0" D-EXPJNT 12

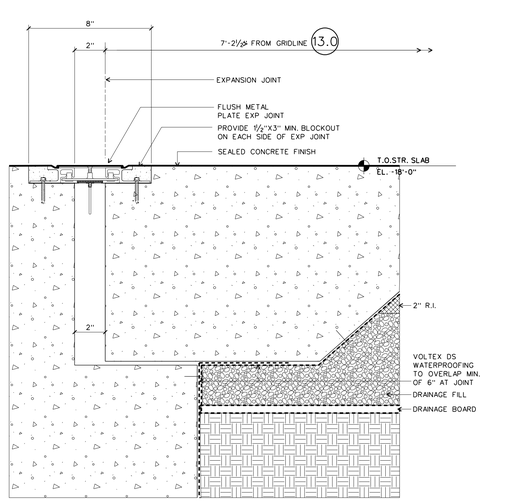

BASEMENT LEVEL: SECTION AT FLOOR

SCALE: 3 " = 1'-0" D-EXPJNT 11

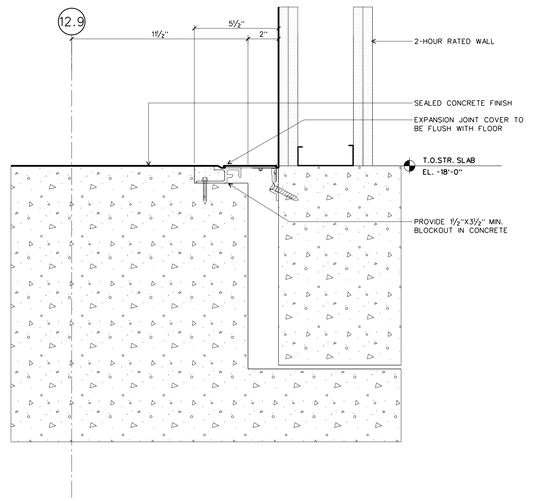

BASEMENT LEVEL: SECTION AT WALL

SCALE: 3 " = 1'-0" D-EXPJNT 10

WILLIAM J. CLINTON PRESIDENTIAL CENTER

LITTLE ROCK, ARKANSAS

Architect

POLSHEK PARTNERSHIP LLP
320 West 13th Street
New York, New York 10014
212.807.7171

Coordinating Architects

POLK STANLEY YEARY ARCHITECTS Ltd
700 South Schiller Street
Little Rock, Arkansas 72201
501.378.0878

WITSELL EVANS RASCO
901 West Third Street
Little Rock, Arkansas 72201
501.374.5300

WOODS CARADINE ARCHITECTS
2200 South Main Street
Little Rock, Arkansas 72206
501.374.4060

Landscape Architects

HARGREAVES ASSOCIATES
118 Magazine Street
Cambridge, Massachusettes 02139
617.661.0070

LANDSCAPE ARCHITECTURE, Inc.
2300 Cottondale Lane Suite 202
Little Rock, Arkansas 72202
501.374.5610

Structural Engineer

LESLIE E. ROBERTSON ASSOC., RLLP
30 Broad Street, 47th Floor
New York, New York 10004
212.750.9000

MEP Engineers

FLACK + KURTZ Inc.
475 Fifth Avenue
New York, New York 10017
212.532.9600

CROMWELL ARCHITECTS ENGINEERS
101 South Spring Street
Little Rock, Arkansas 72201
501.372.2900

Curtainwall Consultant

R. A. HEINTGES ARCHITECTS
126 Fifth Avenue, 9th Floor
New York, New York 10011
212.652-2966

Seal

Issue	Date
2 100% Construction Documents	09/27/02
1 90% Progress Printing	08/30/02
100% Struct./ CD Progress	07/01/02
Bridge Bldg. Substructure	06/14/02
100% Steel & Concrete CD & Architectural CD Progress	05/15/02

Job No. 9908

Scale 3" = 1'-0"

Date September 27, 2002


Title

EXPANSION JOINT DETAILS

Sheet No.


A390

FOR OFFICIAL USE ONLY

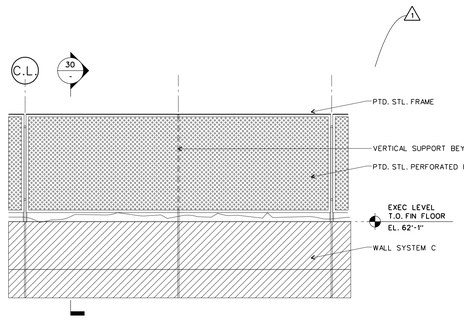


TYPICAL ELEVATION AT PERF. MTL. GUARDRAIL 43

SCALE: 1/2" = 1'-0" D-EXT-RAIL

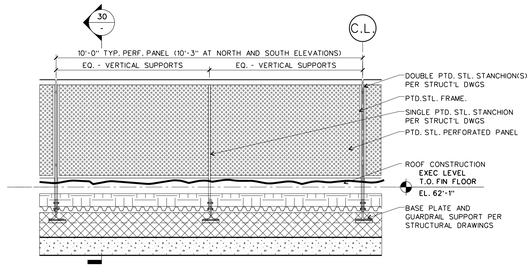


TYPICAL SECTION/ELEVATION AT PERF. MTL. GUARDRAIL 33

SCALE: 1/2" = 1'-0" D-EXT-RAIL

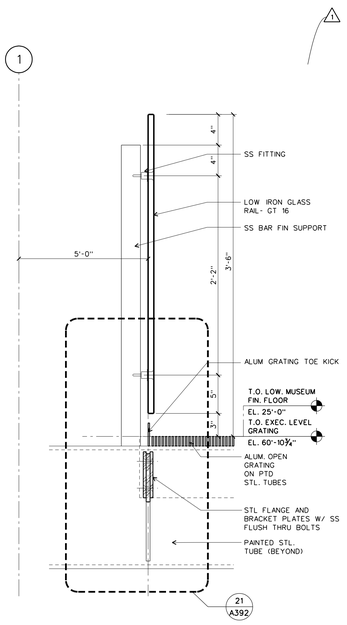


SECTION AT POINT SUPPORTED GUARDRAIL 32

SCALE: 1 1/2" = 1'-0" D-EXT-RAIL

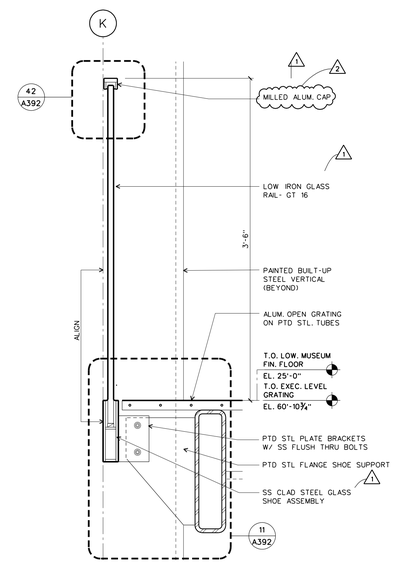


SECTION AT GLASS GUARDRAIL SS SHOE 31

SCALE: 1 1/2" = 1'-0" D-EXT-RAIL

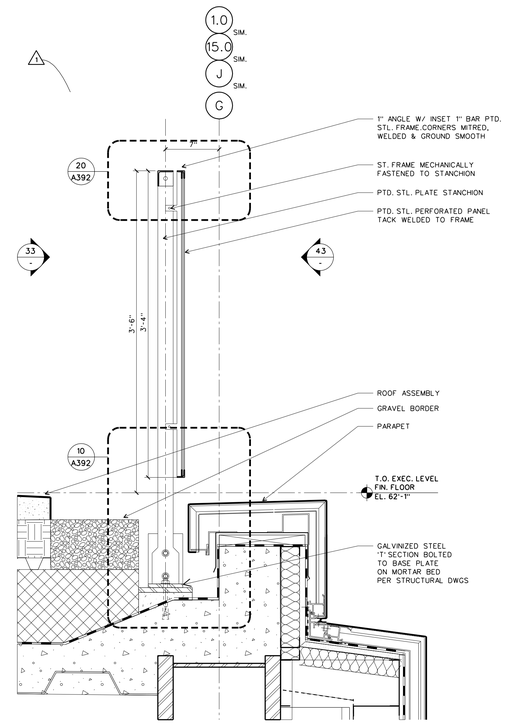


SECTION DETAIL- PERF. MTL. GUARDRAIL 30

SCALE: 1 1/2" = 1'-0" D-EXT-RAIL

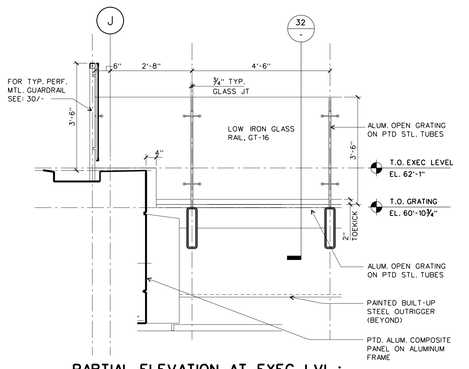


PARTIAL ELEVATION AT EXEC. LVL.: POINT SUPPORT GLASS GUARDRAL 22

SCALE: 1/2" = 1'-0" D-EXT-RAIL

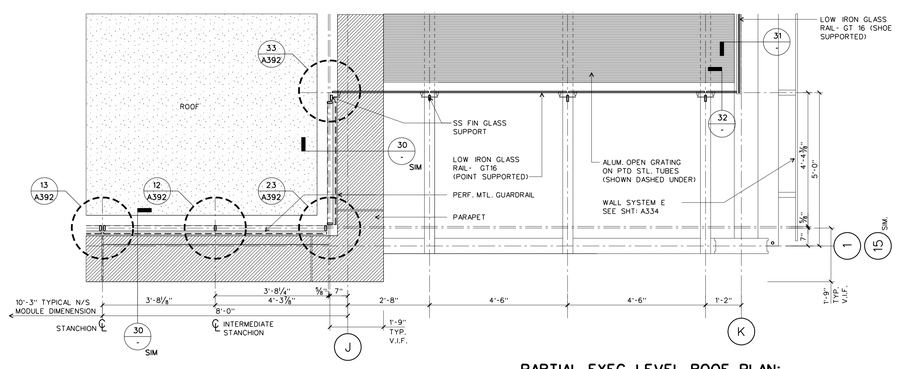


PARTIAL EXEC. LEVEL ROOF PLAN: CORNER AT POINT SUPPORT GLASS GUARD 21

SCALE: 1/2" = 1'-0" D-EXT-RAIL

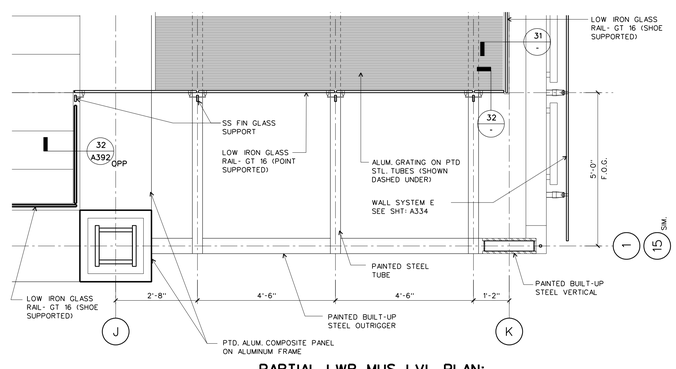


PARTIAL LWR. MUS. LVL. PLAN: POINT SUPPORT GLASS GUARDRAIL 20

SCALE: 1/2" = 1'-0" D-EXT-RAIL

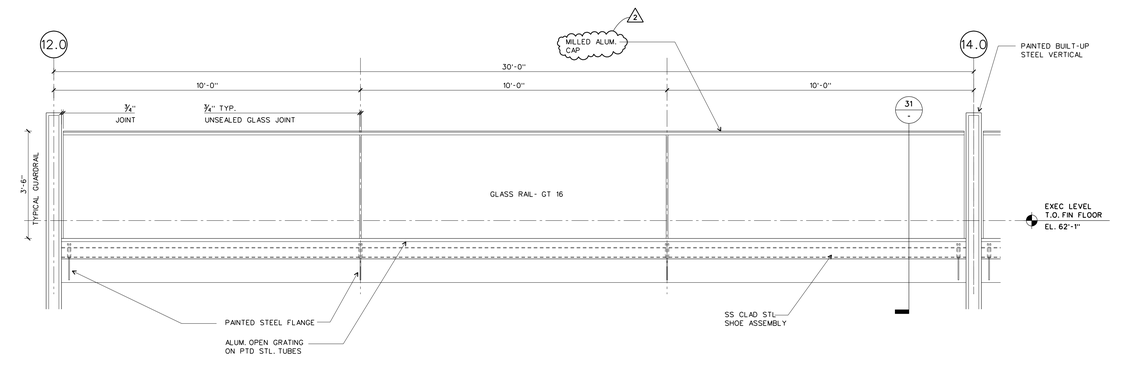

TYPICAL ELEVATION: GLASS GUARD AT TERRACE WALKWAY COLUMN LINE 'K' 11

SCALE: 1/2" = 1'-0" D-EXT-RAIL

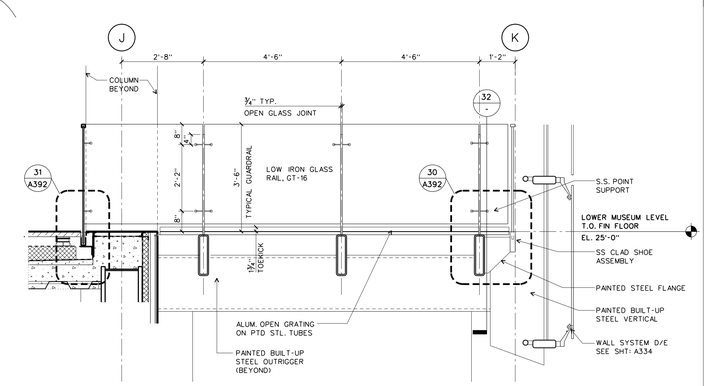

ELEVATION: POINT SUPPORT GLASS GUARD 10

SCALE: 1/2" = 1'-0" D-EXT-RAIL

WILLIAM J. CLINTON PRESIDENTIAL CENTER

LITTLE ROCK, ARKANSAS

Architect

POLSHEK PARTNERSHIP LLP
320 West 13th Street
New York, New York 10014
212.807.7171

Coordinating Architects

POLK STANLEY YEARY ARCHITECTS Ltd
700 South Schiller Street
Little Rock, Arkansas 72201
501.378.0878

WITSELL EVANS RASCO
901 West Third Street
Little Rock, Arkansas 72201
501.374.5300

WOODS CARADINE ARCHITECTS
2200 South Main Street
Little Rock, Arkansas 72206
501.374.4060

Landscape Architects

HARGREAVES ASSOCIATES
118 Magazine Street
Cambridge, Massachusettes 02139
617.661.0070

LANDSCAPE ARCHITECTURE, Inc.
2300 Cottondale Lane Suite 202
Little Rock, Arkansas 72202
501.374.5610

Structural Engineer

LESLIE E. ROBERTSON ASSOC., RLLP
30 Broad Street, 47th Floor
New York, New York 10004
212.750.9000

MEP Engineers

FLACK + KURTZ Inc.
475 Fifth Avenue
New York, New York 10017
212.532.9600

CROMWELL ARCHITECTS ENGINEERS
101 South Spring Street
Little Rock, Arkansas 72201
501.372.2900

Curtainwall Consultant

R. A. HEINTGES ARCHITECTS
126 Fifth Avenue, 9th Floor
New York, New York 10011
212.652-2966

Seal

Issue	Date
2 ASI #22	08/01/03
1 ASI #20	06/06/03
100% Construction Documents	09/27/02

Job No. 9908

Scale AS NOTED

Date September 27, 2002


Title

EXTERIOR RAILING DETAILS

Sheet No.


A391

FOR OFFICIAL USE ONLY

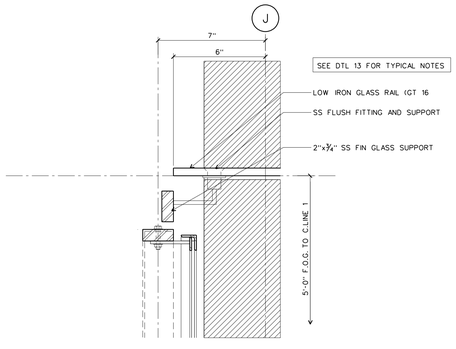


DETAIL PLAN: PERF. MTL. GUARDRAIL @ POINT SUPPORTED GLASS RAIL

SCALE: 3" = 1'-0" — 33

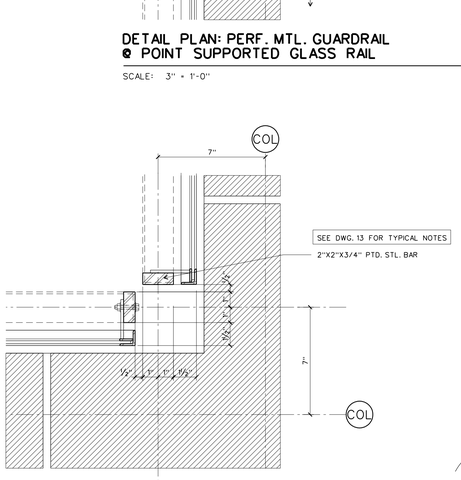


DETAIL PLAN: TYPICAL CORNER @ PERF. MTL. GUARDRAIL

SCALE: 3" = 1'-0" — 23

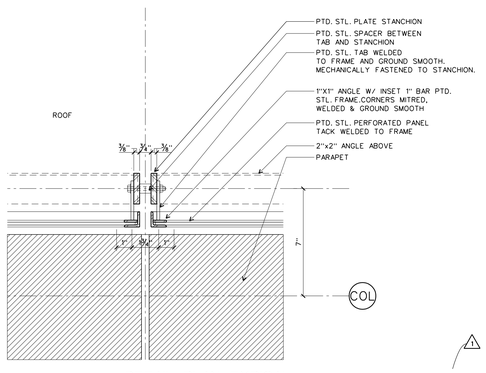


DETAIL PLAN: TYPICAL STANCHION @ PERF. MTL. GUARDRAIL

SCALE: 3" = 1'-0" — 13

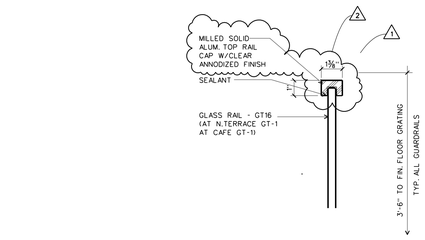


DETAIL: END CAP- GLASS GUARDRAIL

SCALE: 3" = 1'-0" — D-EXT-RAIL — 42

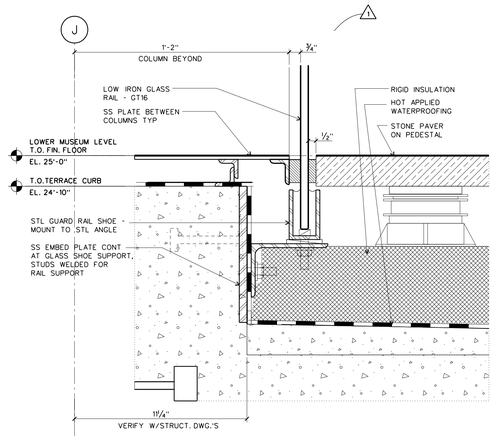


DETAIL: GLASS GUARDRAIL SHOE

SCALE: 3" = 1'-0" — D-EXT-RAIL — 32

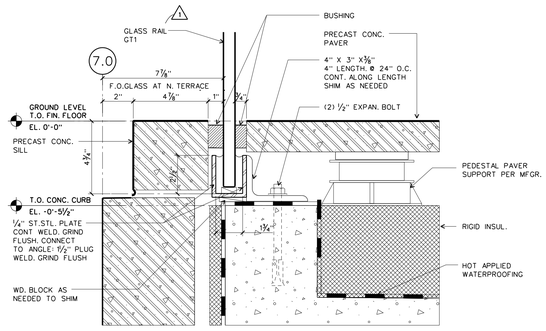


DETAIL: GLASS GUARDRAIL SHOE

SCALE: 3" = 1'-0" — D-EXT-RAIL — 22

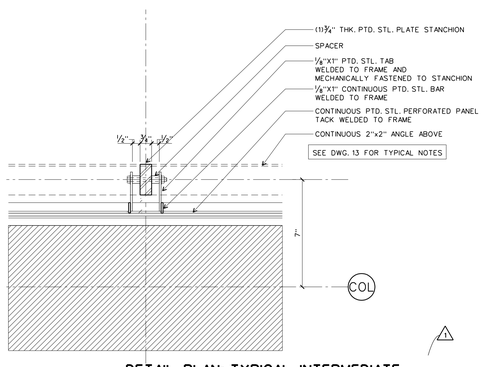


DETAIL PLAN: TYPICAL INTERMEDIATE STANCHION @ PERF. MTL. GUARDRAIL

SCALE: 3" = 1'-0" — 12

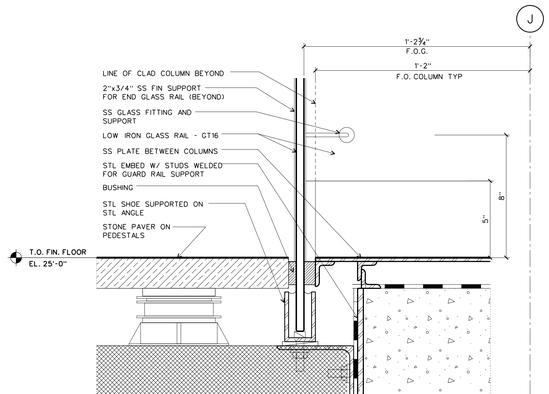


DETAIL- GLASS GUARD. POINT SUPPORT BASE

SCALE: 3" = 1'-0" — D-EXT-RAIL — 31

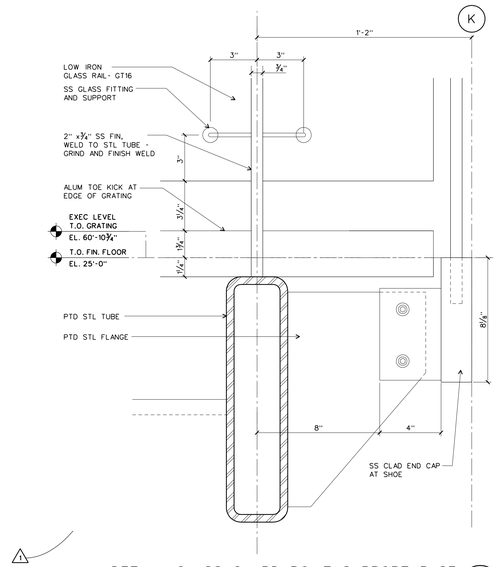


DETAIL- GLASS GUARD. POINT SUPPORT BASE

SCALE: 3" = 1'-0" — D-EXT-RAIL — 30

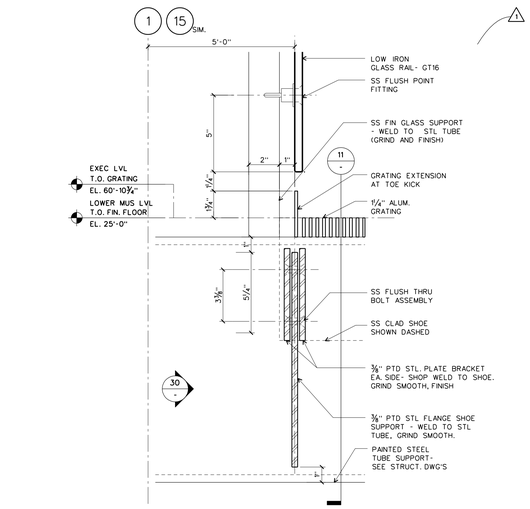


DETAIL- GLASS GUARD. POINT SUPPORT BASE

SCALE: 3" = 1'-0" — D-EXT-RAIL — 21

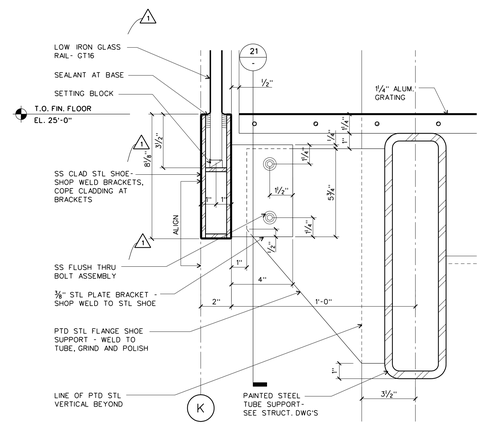


DETAIL- GLASS GUARDRAIL SHOE

SCALE: 3" = 1'-0" — D-EXT-RAIL — 11

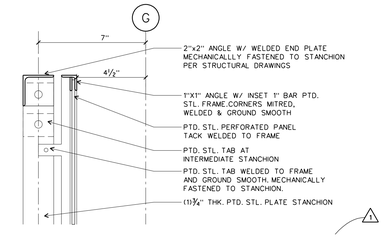

DETAIL- PERF. MTL. GUARDRAIL

SCALE: 3" = 1'-0" — D-EXT-RAIL — 20

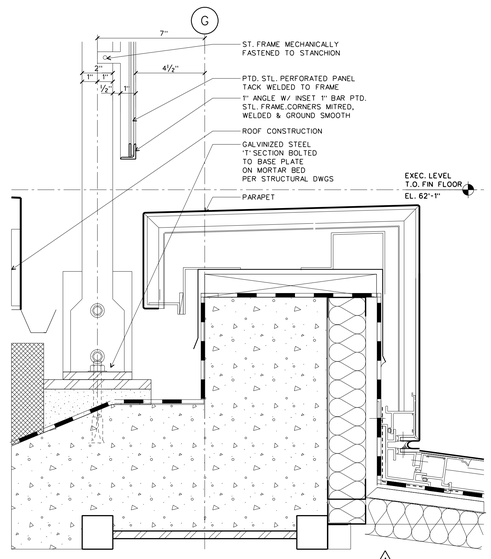

DETAIL- PERF. MTL. GUARDRAIL BASE

SCALE: 3" = 1'-0" — D-EXT-RAIL — 10

WILLIAM J. CLINTON PRESIDENTIAL CENTER

LITTLE ROCK, ARKANSAS

Architect

POLSHEK PARTNERSHIP LLP
320 West 13th Street
New York, New York 10014
212.807.7171

Coordinating Architects

POLK STANLEY YEARY ARCHITECTS Ltd
700 South Schiller Street
Little Rock, Arkansas 72201
501.378.0878

WITSELL EVANS RASCO
901 West Third Street
Little Rock, Arkansas 72201
501.374.5300

WOODS CARADINE ARCHITECTS
2200 South Main Street
Little Rock, Arkansas 72206
501.374.4060

Landscape Architects

HARGREAVES ASSOCIATES
118 Magazine Street
Cambridge, Massachusettes 02139
617.661.0070

LANDSCAPE ARCHITECTURE, Inc.
2300 Cottondale Lane Suite 202
Little Rock, Arkansas 72202
501.374.5610

Structural Engineer

LESLIE E. ROBERTSON ASSOC., RLLP
30 Broad Street, 47th Floor
New York, New York 10004
212.750.9000

MEP Engineers

FLACK + KURTZ Inc.
475 Fifth Avenue
New York, New York 10017
212.532.9600

CROMWELL ARCHITECTS ENGINEERS
101 South Spring Street
Little Rock, Arkansas 72201
501.372.2900

Curtainwall Consultant

R. A. HEINTGES ARCHITECTS
126 Fifth Avenue, 9th Floor
New York, New York 10011
212.652-2966

Seal

Issue	Date
2 ASI #22	08/01/03
1 ASI #20	06/06/03
100% Construction Documents	09/27/02

Job No. 9908


Scale: AS NOTED

Date: September 27, 2002


Title: EXTERIOR RAILING DETAILS

Sheet No. A392


FOR OFFICIAL USE ONLY

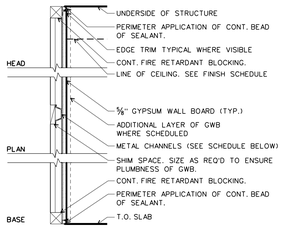


TYPE	SHIM SPACE	STUD SIZE & SPACING	MAX. HEIGHT GAUGE	INSUL. STC RATING	FIRE RATING TEST DESIGN	REMARKS
F00	VARIES	24" O.C.	N/A	N/A	N/A	--
			N/A	N/A	N/A	N/A
F02	VARIES	24" O.C.	N/A	N/A	N/A	--
			N/A	N/A	N/A	N/A

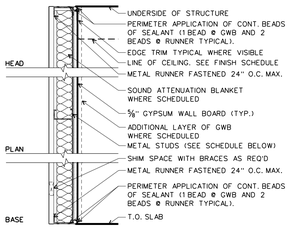


TYPE	SHIM SPACE	STUD SIZE & SPACING	MAX. HEIGHT GAUGE	INSUL. STC RATING	FIRE RATING TEST DESIGN	REMARKS
E00	VARIES	16" O.C.	8'-3"	NONE	NONE	GWB TO 6" ABOVE CEILING
			25	N/A	N/A	N/A
E02	VARIES	16" O.C.	8'-3"	2"	NONE	--
			25	N/A	N/A	N/A
E04	VARIES	16" O.C.	8'-3"	2"	NONE	--
			25	N/A	N/A	N/A
E10	VARIES	16" O.C.	11'-0"	NONE	NONE	GWB TO 6" ABOVE CEILING
			20	N/A	N/A	N/A
E12	VARIES	16" O.C.	11'-0"	2"	NONE	--
			20	N/A	N/A	N/A
E14	VARIES	16" O.C.	11'-0"	2"	NONE	--
			20	N/A	N/A	N/A
E20	VARIES	16" O.C.	14'-6"	NONE	NONE	GWB TO 6" ABOVE CEILING
			20	N/A	N/A	N/A
E22	VARIES	16" O.C.	14'-6"	3"	NONE	--
			20	N/A	N/A	N/A
E24	VARIES	16" O.C.	14'-6"	3"	NONE	--
			20	N/A	N/A	N/A
E30	VARIES	16" O.C.	20'-0"	NONE	NONE	GWB TO 6" ABOVE CEILING
			20	N/A	N/A	N/A
E32	VARIES	16" O.C.	20'-0"	3"	NONE	--
			20	N/A	N/A	N/A
E34	VARIES	16" O.C.	20'-0"	3"	NONE	--
			20	N/A	N/A	N/A

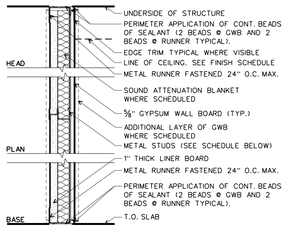


TYPE	STUD SIZE & SPACING	MAX. HEIGHT GAUGE	INSUL. STC RATING	FIRE RATING TEST DESIGN	REMARKS
D00	24" O.C.	14'-0"	1½"	1 HOUR	•VERIFY AT ELEV. CORES
		20	42	UL U469	--
D02	24" O.C.	15'-3"	1½"	2 HOUR	•VERIFY AT ELEV. CORES
		20	45	UL U438	--
D04	24" O.C.	15'-3"	1½"	2 HOUR	•VERIFY AT ELEV. CORES
		20	45	UL U467	--
D10	24" O.C.	17'-6"	3"	1 HOUR	•VERIFY AT ELEV. CORES
		20	52	UL U469	--
D12	24" O.C.	18'-2"	3"	2 HOUR	•VERIFY AT ELEV. CORES
		20	52	UL U438	--
D14	24" O.C.	18'-2"	3"	2 HOUR	•VERIFY AT ELEV. CORES
		20	52	UL U467	--
D20	24" O.C.	24'-3"	3"	1 HOUR	•VERIFY AT ELEV. CORES
		20	52	UL U469	--
D22	24" O.C.	25'-1"	3"	2 HOUR	•VERIFY AT ELEV. CORES
		20	52	UL U438	--
D24	24" O.C.	25'-1"	3"	2 HOUR	•VERIFY AT ELEV. CORES
		20	52	UL U467	--

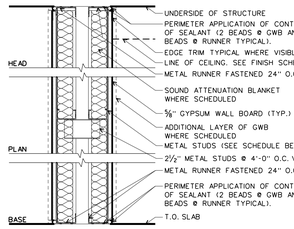

TYPE	STUD SIZE & SPACING	MAX. HEIGHT GAUGE	INSUL. STC RATING	FIRE RATING TEST DESIGN	REMARKS
C00	16" O.C.	13'-3"	3"	NONE	--
		25	52	N/A	N/A
C02	16" O.C.	13'-3"	3"	1 HOUR	--
		25	52	UL 420	--
C04	16" O.C.	14'-6"	3"	2 HOUR	--
		25	57	UL 420	--
C10	16" O.C.	17'-6"	3"	NONE	--
		20	52	N/A	N/A
C12	16" O.C.	17'-6"	3"	1 HOUR	--
		20	52	UL U420	--
C14	16" O.C.	19'-0"	3"	2 HOUR	--
		20	57	UL U420	--
C20	16" O.C.	22'-9"	3"	NONE	--
		20	52	N/A	N/A
C22	16" O.C.	22'-9"	3"	1 HOUR	--
		20	52	UL U420	--
C24	16" O.C.	23'-6"	3"	2 HOUR	--
		20	57	UL U420	--

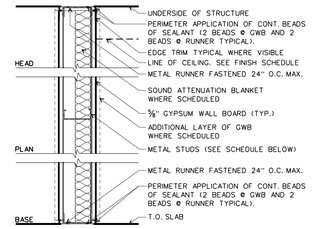

TYPE	STUD SIZE & SPACING	MAX. HEIGHT GAUGE	INSUL. STC RATING	FIRE RATING TEST DESIGN	REMARKS
B00	16" O.C.	13'-0"	NONE	NONE	GWB TO 6" ABOVE CEILING
		20	N/A	N/A	N/A
B02	16" O.C.	13'-10"	2½"	NONE	--
		20	45	N/A	N/A
B04	16" O.C.	13'-10"	2½"	1 HOUR	--
		20	45	OSU T-3296	--
B06	16" O.C.	16'-1"	2½"	2 HOUR	--
		20	55	UL U411	--
B10	16" O.C.	17'-3"	NONE	NONE	GWB TO 6" ABOVE CEILING
		20	N/A	N/A	N/A
B12	16" O.C.	17'-11"	3"	NONE	--
		20	47	N/A	--
B14	16" O.C.	17'-11"	3"	1 HOUR	--
		20	47	UL U465	--
B16	16" O.C.	17'-11"	3"	1½HR	--
		20	50	OSU T3240	--
B18	16" O.C.	20'-2"	3"	2 HOUR	--
		20	53	UL 411	--
B20	16" O.C.	25'-6"	NONE	NONE	--
		20	N/A	N/A	N/A
B22	16" O.C.	26'-1"	3"	NONE	--
		20	47	N/A	N/A
B24	16" O.C.	26'-1"	3"	1 HOUR	--
		20	47	UL 465	--
B26	16" O.C.	26'-1"	3"	1½HR	--
		20	50	OSU T3240	--
B28	16" O.C.	28'-6"	3"	2 HOUR	--
		20	53	UL 411	--
B30	16" O.C.	28'-6"	3"	4 HOUR	NON-LOAD BEARING
		20	53	UL 263 U419	--
B32	16" O.C.	20'-2"	3"	3 HOUR	NON-LOAD BEARING
		20	53	UL 420	--
B34	16" O.C.	2 FLRS	6"	N.A.	'C' WALL SUPPORT
		20	N.A.	N.A.	--

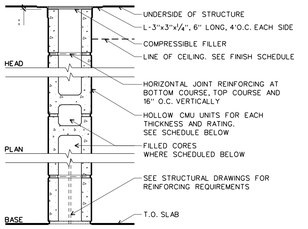

TYPE	NOMINAL SIZE ACTUAL SIZE & WIDTH	MAX. HEIGHT GAUGE	INSUL. STC RATING	FIRE RATING TEST DESIGN	REMARKS
A00	4"	12'-0"	NONE	NONE	NON-LOAD BEARING
	3⅝"	N/A	N/A	N/A	N/A
A10	6"	18'-0"	NONE	NONE	NON-LOAD BEARING
	5⅝"	N/A	N/A	N/A	N/A
A12	6"	18'-0"	NONE	1 HOUR	NON-LOAD BEARING
	5⅝"	N/A	N/A	U906	--
A14	6"	18'-0"	NONE	2 HOUR	NON-LOAD BEARING
	5⅝"	N/A	N/A	U906	--
A20	8"	24'-0"	NONE	NONE	NON-LOAD BEARING
	7⅝"	N/A	N/A	N/A	N/A
A22	8"	24'-0"	NONE	1 HOUR	NON-LOAD BEARING
	7⅝"	N/A	N/A	U905	--
A24	8"	24'-0"	NONE	2 HOUR	NON-LOAD BEARING
	7⅝"	N/A	N/A	U905	SEE STRUCTURAL DRAWING BOOK FOR TYPICAL DETAILS
A26	8"	24'-0"	NONE	3 HOUR	NON-LOAD BEARING
	7⅝"	N/A	N/A	U904	--
A28	8"	24'-0"	NONE	4 HOUR	NON-LOAD BEARING
	7⅝"	N/A	N/A	U901	SEE STRUCTURAL DRAWING BOOK FOR TYPICAL DETAILS

F APPLIED FURRING
SCALE: 1½" = 1'-0"


E FURRING WALL
SCALE: 1½" = 1'-0"

D SHAFT WALL
SCALE: 1½" = 1'-0"

C CHASE WALL
SCALE: 1½" = 1'-0"

B STUD WALL
SCALE: 1½" = 1'-0"

A CMU WALL
SCALE: 1½" = 1'-0"

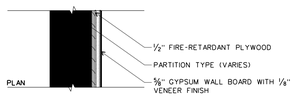

GW ADDITIONAL CONSTRUCTION FOR GALLERY WALL TYPES
SCALE: 1½" = 1'-0"

GENERAL NOTES

1. SEE PARTITION DETAIL DRAWING XXXX AND PROJECT SPECIFICATIONS FOR SEISMIC DETAILS AND PERFORMANCE CRITERIA FOR ALL STUD AND MASONRY PARTITIONS.

2. INSTALL CEMENTITIOUS BACKER BOARD IN LIEU OF GYPSUM WALL BOARD AT LOCATIONS INDICATED TO RECEIVE WALL TILE.

3. INSTALL WATER RESISTANT GYPSUM WALL BOARD AT SURFACES IN TOILET ROOMS, JANITORS CLOSETS AND SIMILAR WET AREAS NOT INDICATED TO RECEIVE WALL TILE.

4. INSTALL TYPE "X" FIRE RATED GWB AT ALL FIRE RATED PARTITIONS.

5. INSTALL "BLUEBOARD" GYPSUM WALL BOARD AT PARTITIONS INDICATED TO RECEIVE VENEER PLASTER.

6. STC RATINGS PROVIDE ONLY A GENERAL INDICATION OF ACOUSTIC PERFORMANCE UNDER LABORATORY TEST CONDITIONS. CONSTRUCTION DETAILS DESCRIBED IN THE DRAWINGS AND SPECIFICATIONS DEFINE THE SPECIFIC REQUIREMENTS FOR THE WORK.

7. EXTRA LAYER OF GYPSUM WALL BOARD AT ASYMMETRICAL PARTITIONS IS TO BE INSTALLED ON SIDE OF PARTITION WHICH TYPE KEY IS SHOWN.

WILLIAM J. CLINTON PRESIDENTIAL CENTER

LITTLE ROCK, ARKANSAS

Architect

POLSHEK PARTNERSHIP LLP
320 West 13th Street
New York, New York 10014
212.807.7171

Coordinating Architects

POLK STANLEY YEARY ARCHITECTS Ltd
700 South Schiller Street
Little Rock, Arkansas 72201
501.378.0878

WITSELL EVANS RASCO
901 West Third Street
Little Rock, Arkansas 72201
501.374.5300

WOODS CARADINE ARCHITECTS
2200 South Main Street
Little Rock, Arkansas 72206
501.374.4060

Landscape Architects

HARGREAVES ASSOCIATES
118 Magazine Street
Cambridge, Massachusettes 02139
617.661.0070

LANDSCAPE ARCHITECTURE, Inc.
2300 Cottondale Lane Suite 202
Little Rock, Arkansas 72202
501.374.5610

Structural Engineer

LESLIE E. ROBERTSON ASSOC., RLLP
30 Broad Street, 47th Floor
New York, New York 10004
212.750.9000

MEP Engineers

FLACK + KURTZ Inc.
475 Fifth Avenue
New York, New York 10017
212.532.9600


CROMWELL ARCHITECTS ENGINEERS
101 South Spring Street
Little Rock, Arkansas 72201
501.372.2900

Curtainwall Consultant

R. A. HEINTGES ARCHITECTS
126 Fifth Avenue, 9th Floor
New York, New York 10011
212.652-2966

Seal

Issue	Date
1 Addendum #2	11/15/02
100% Construction Documents	09/27/02
90% Progress Printing	08/30/02
100% Struct./ CD Progress	07/01/02
100% Design Development	03/01/02

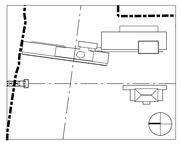

Job No. 9908


Scale AS NOTED

Date September 27, 2002

Title PARTITION TYPES


Sheet No. A400

FOR OFFICIAL USE ONLY

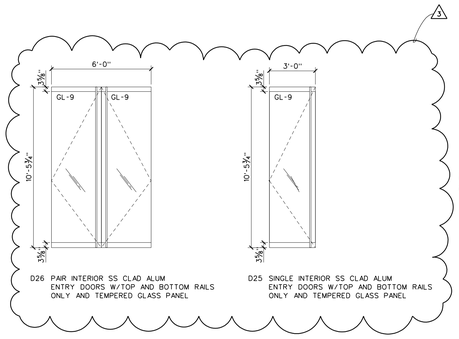


D26 PAIR INTERIOR SS CLAD ALUM ENTRY DOORS W/TOP AND BOTTOM RAILS ONLY AND TEMPERED GLASS PANEL


D25 SINGLE INTERIOR SS CLAD ALUM ENTRY DOORS W/TOP AND BOTTOM RAILS ONLY AND TEMPERED GLASS PANEL

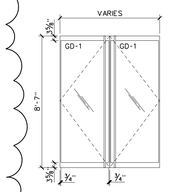


D24a PAIR INTERIOR PAINTED ALUM STILE AND RAIL ENTRY DOORS W/TEMPERED GLASS PANEL

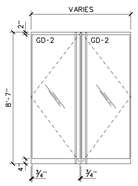


D24 PAIR EXTERIOR PAINTED ALUM STILE AND RAIL ENTRY DOORS W/LAMINATED GLASS PANEL

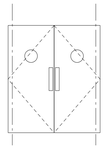

D23 FLUSH METAL W/ VIEW GLASS CENTER HINGE PIVOT

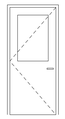


D22 FLUSH METAL W/ HALF GLASS

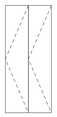

D21 FLUSH BI-FOLD




D20 SLIDING GLASS DOOR W/ ALUM. SHOE AND HEAD

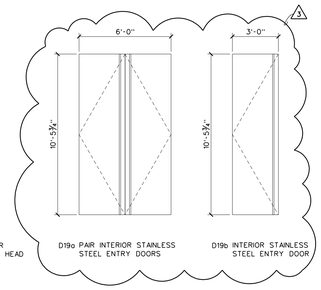


D19a PAIR INTERIOR STAINLESS STEEL ENTRY DOORS

D19b INTERIOR STAINLESS STEEL ENTRY DOOR

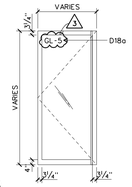


D18a SINGLE INTERIOR PAINTED ALUM STILE AND RAIL ENTRY DOOR W/TEMPERED GLASS PANEL

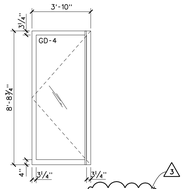


D18 SINGLE EXTERIOR PAINTED ALUM STILE AND RAIL ENTRY DOOR W/INSULATED GLASS PANEL


D17a NOTUSED

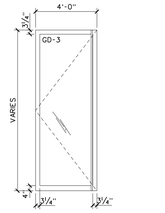

D17 SINGLE EXTERIOR SS CLAD ALUM STILE AND RAIL ENTRY DOOR W/INSULATED AND LAMINATED GLASS PANEL

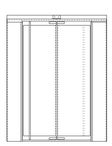


D15 REVOLVING GLASS DOOR

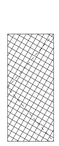


D14 EXPANDED MESH DOOR



D13 OVERHEAD DOOR

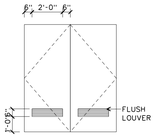


D12 PAIR 1-3/4" THICK FLUSH HOLLOW METAL DOUBLE DOOR W/ LOUVERS

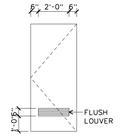

D11 1-3/4" THICK FLUSH HOLLOW METAL DOOR W/ LOUVER




D10 1-3/4" THICK SOLID CORE WOOD VENEER DOUBLE DOOR

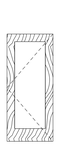


D9a 1-3/4" THICK FLUSH WOOD RAIL & STILE DOOR W/ TEMPERED FULL GLASS PANEL




D9 1-3/4" THICK SOLID CORE WOOD VENEER DOOR

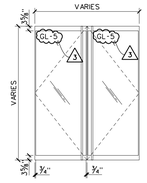


D8a PAIR INTERIOR PAINTED ALUM STILE AND RAIL ENTRY DOORS W/TEMPERED GLASS PANEL

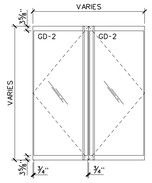


D8 PAIR EXTERIOR PAINTED ALUM STILE AND RAIL ENTRY DOORS W/LAMINATED GLASS PANEL

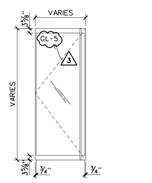


D7a SINGLE INTERIOR PAINTED ALUM STILE AND RAIL ENTRY DOOR W/TEMPERED GLASS PANEL

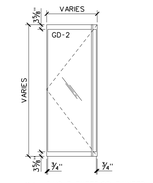


D7 SINGLE EXTERIOR PAINTED ALUM STILE AND RAIL ENTRY DOOR W/LAMINATED GLASS PANEL

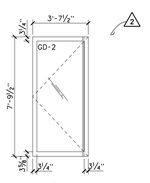

D3 SINGLE EXTERIOR PAINTED ALUM STILE AND RAIL ENTRY DOOR W/LAMINATED GLASS PANEL

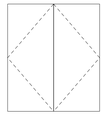

D2 PAIR 1-3/4" THICK FLUSH HOLLOW METAL DOORS

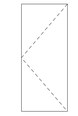


D1 1-3/4" THICK FLUSH HOLLOW METAL DOOR


DOOR TYPES

SCALE: ¼" =1'-0"


DOORTYPES.DGN 40

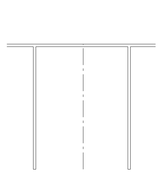


F7 FRAME WITH CENTER PIVOT AT HEAD

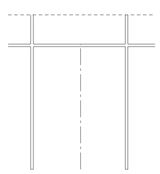


F6 FRAME WITH CENTER PIVOT AT HEAD AND EXTENDED VERTICAL JAMBS

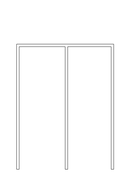


F5 FRAME WITH INTERMEDIATE MULLION

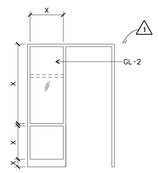

F4 FRAME WITH SIDELIGHT

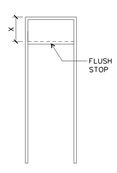

F3 FRAME WITH FLUSH TRANSOM

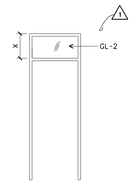

F2 FRAME WITH TRANSOM BAR



F1 STANDARD FRAME

DOOR FRAME TYPES: HOLLOW METAL AND WOOD

SCALE: ¼" =1'-0"

DOORTYPES.DGN 30

WILLIAM J. CLINTON PRESIDENTIAL CENTER

LITTLE ROCK, ARKANSAS

Architect

POLSHEK PARTNERSHIP LLP
320 West 13th Street
New York, New York 10014
212.807.7171

Coordinating Architects

POLK STANLEY YEARY ARCHITECTS Ltd
700 South Schiller Street
501.378.0878

WITSELL EVANS RASCO
901 West Third Street
Little Rock, Arkansas 72201
501.374.5300

WOODS CARADINE ARCHITECTS
2200 South Main Street
Little Rock, Arkansas 72206
501.374.4060

Landscape Architects

HARGREAVES ASSOCIATES
118 Magazine Street
Cambridge, Massachusettes 02139
617.661.0070

LANDSCAPE ARCHITECTURE, Inc.
2300 Cottondale Lane Suite 202
Little Rock, Arkansas 72202
501.374.5610

Structural Engineer

LESLIE E. ROBERTSON ASSOC., RLLP
30 Broad Street, 47th Floor
New York, New York 10004
212.750.9000

MEP Engineers

FLACK + KURTZ Inc.
475 Fifth Avenue
New York, New York 10017
212.532.9600

CROMWELL ARCHITECTS ENGINEERS
101 South Spring Street
Little Rock, Arkansas 72201
501.372.2900


Curtainwall Consultant

R. A. HEINTGES ARCHITECTS
126 Fifth Avenue, 9th Floor
New York, New York 10011
212.652-2966

Seal

	Issue	Date
1	ASI # 20	06/06/03
2	ASI # 18	04/18/03
1	Addendum #2	11/15/02
	100% Construction Documents	09/27/02
	90% Progress Printing*	08/30/02
	100% Struct./ CD Progress*	07/01/02
	100% Design Development*	03/01/02

*Issued Formerly as A402

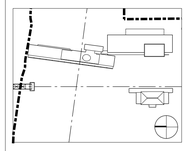

Job No. 9908

Scale AS NOTED


Date September 27, 2002

Title

DOOR TYPES


Sheet No. A401

FOR OFFICIAL USE ONLY

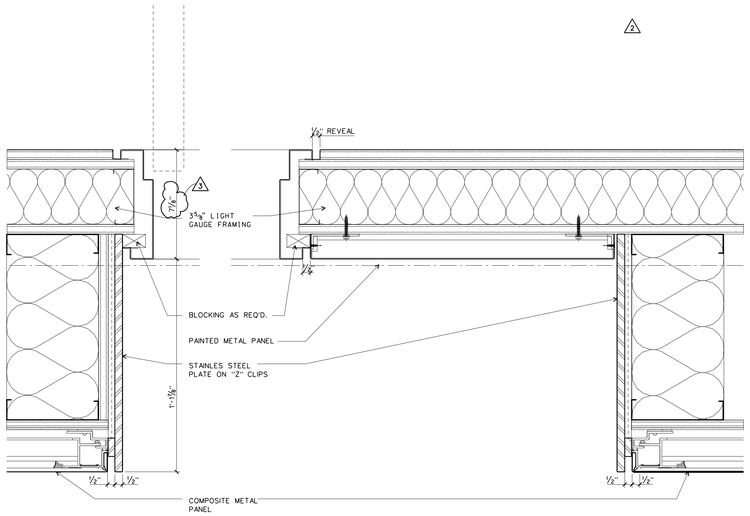


JAMB DETAIL GREEN ROOM

3" = 1'-0" D-doors.dgn 23

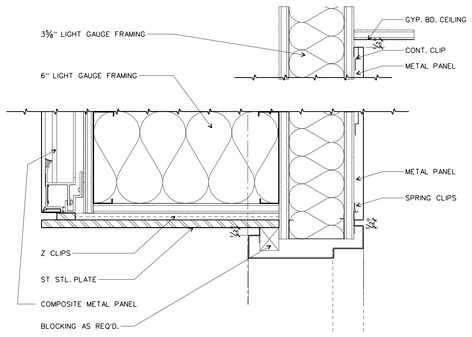


HEAD DETAIL

3" = 1'-0" D-doors.dgn 32

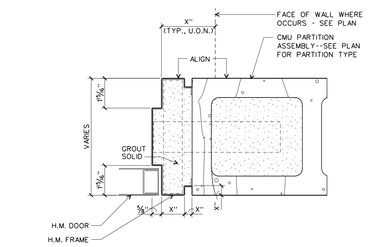


JAMB DETAIL (HEAD SIM.)

3" = 1'-0" D-doors.dgn 31

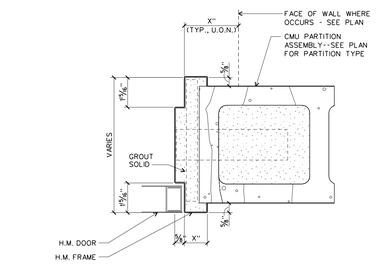


JAMB DETAIL (HEAD SIM.)

3" = 1'-0" D-doors.dgn 30

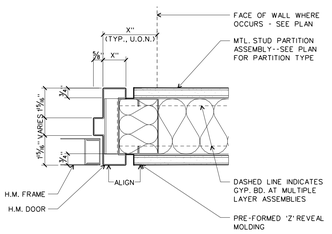


JAMB DETAIL (HEAD SIM.)

3" = 1'-0" D-doors.dgn 22

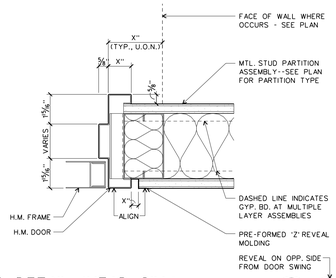


JAMB DETAIL (HEAD SIM.)

3" = 1'-0" D-doors.dgn 21 21.B

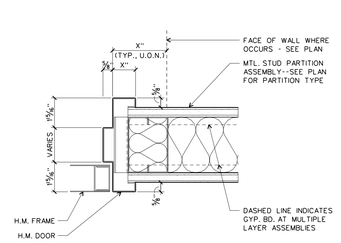


JAMB DETAIL (HEAD SIM.)

3" = 1'-0" D-doors.dgn 20

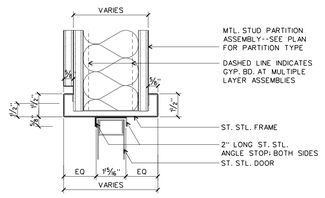


HEAD DETAIL
DOUBLE ACTING DOOR

SCALE: 3 " = 1'-0" D-doors.dgn 14

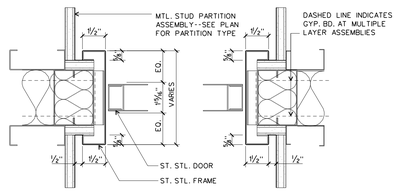


JAMB DETAIL
DOUBLE ACTING DOOR

SCALE: 3 " = 1'-0" D-doors.dgn 13

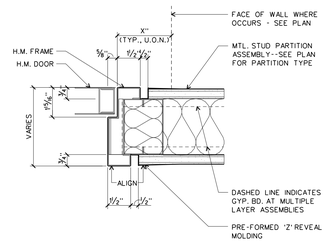


JAMB DETAIL (HEAD SIM)
FLUSH BOTH SIDES

SCALE: 3 " = 1'-0" D-doors.dgn 12

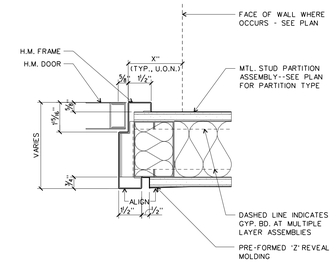

JAMB DETAIL (HEAD SIM)
FLUSH ONE SIDE

SCALE: 3 " = 1'-0" D-doors.dgn 11

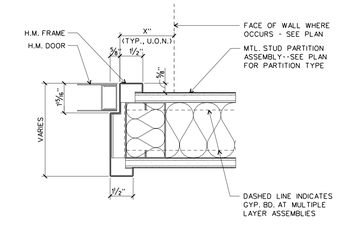

JAMB DETAIL (HEAD SIM)

SCALE: 3 " = 1'-0" D-doors.dgn 10

WILLIAM J. CLINTON PRESIDENTIAL CENTER

LITTLE ROCK, ARKANSAS

Architect

POLSHEK PARTNERSHIP LLP
320 West 13th Street
New York, New York 10014
212.807.7171

Coordinating Architects

POLK STANLEY YEARY ARCHITECTS Ltd
700 South Schiller Street
Little Rock, Arkansas 72201
501.378.0878

WITSELL EVANS RASCO
901 West Third Street
Little Rock, Arkansas 72201
501.374.5300

WOODS CARADINE ARCHITECTS
2200 South Main Street
Little Rock, Arkansas 72206
501.374.4060

Landscape Architects

HARGREAVES ASSOCIATES
118 Magazine Street
Cambridge, Massachusettes 02139
617.661.0070

LANDSCAPE ARCHITECTURE, Inc.
2300 Cottondale Lane Suite 202
Little Rock, Arkansas 72202
501.374.5610

Structural Engineer

LESLIE E. ROBERTSON ASSOC., RLLP
30 Broad Street, 47th Floor
New York, New York 10004
212.750.9000

MEP Engineers

FLACK + KURTZ Inc.
475 Fifth Avenue
New York, New York 10017
212.532.9600

CROMWELL ARCHITECTS ENGINEERS
101 South Spring Street
Little Rock, Arkansas 72201
501.372.2900


Curtainwall Consultant

R. A. HEINTGES ARCHITECTS
126 Fifth Avenue, 9th Floor
New York, New York 10011
212.652-2966

Seal

3	ASI #25	12/19/03
2	ASI #24	10/24/03
1	ASI #20	06/06/03
	100% Construction Documents*	09/27/02

Issue	Date
*New Sheet: Former A402 renamed A401	

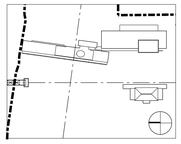

Job No. 9908


Scale AS NOTED

Date September 27, 2002

Title DOOR DETAILS


Sheet No. A402

FOR OFFICIAL USE ONLY

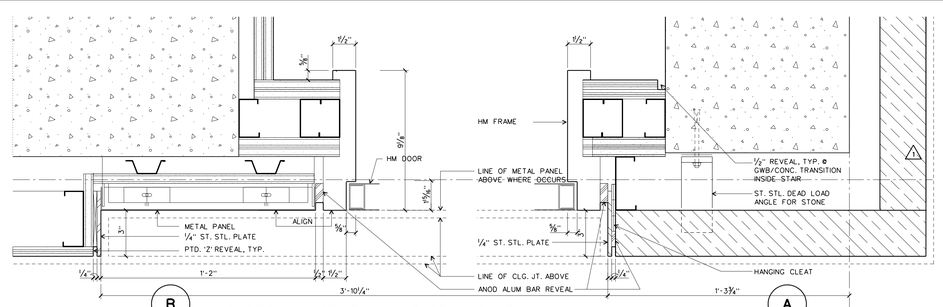


B JAMB DETAIL - STAIR 4 AT GROUND LEVEL A

SCALE: 3 " = 1'-0" d-door01.dgn 43

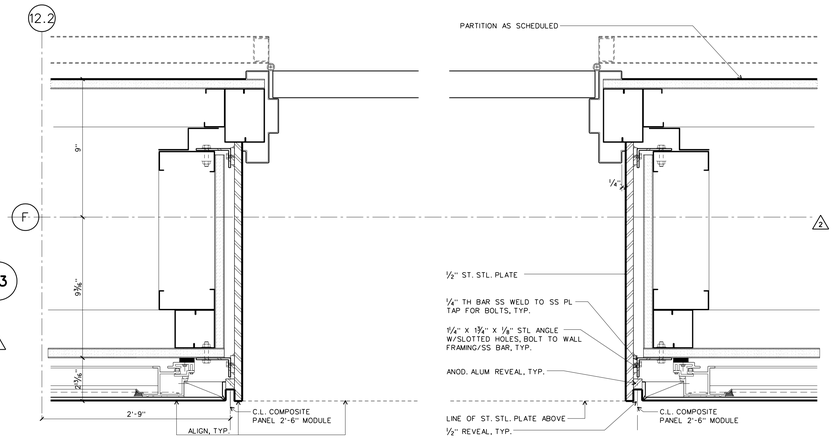


JAMB DETAIL FREIGHT ELEV. VEST.

SCALE: 3 " = 1'-0" d-door05.dgn 40

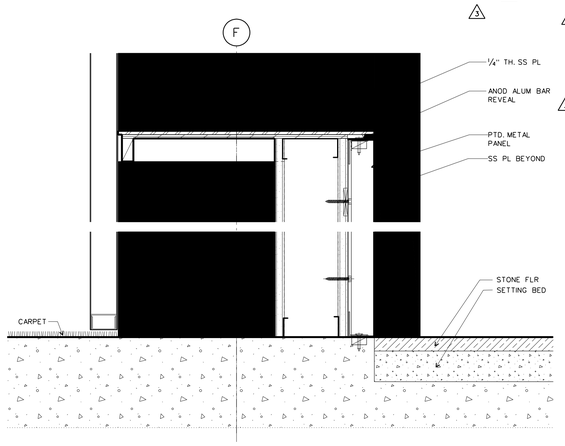


SHELF/SILL DETAIL COAT ROOM

SCALE: 3 " = 1'-0" d-door06.dgn 42

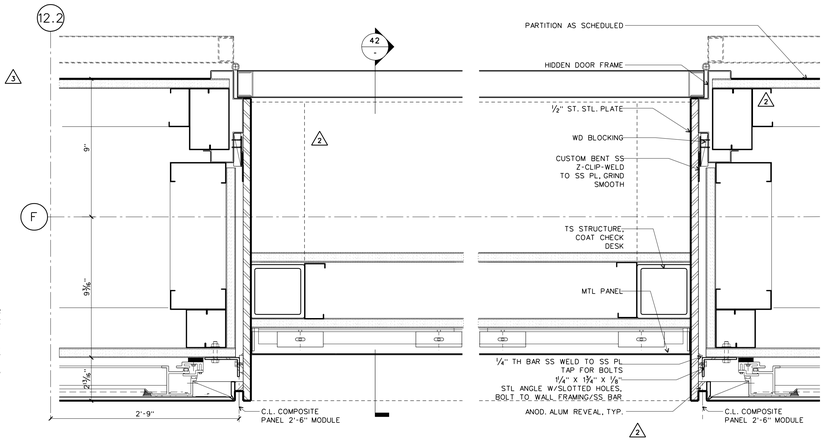


JAMB DETAIL COAT ROOM: HEAD SIM

SCALE: 3 " = 1'-0" d-door06.dgn 41

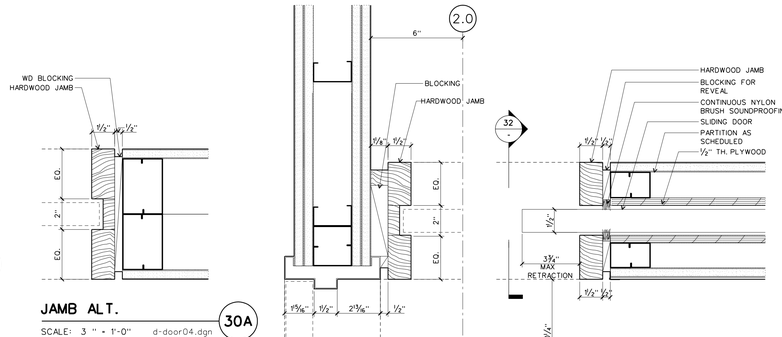


JAMB ALT.

SCALE: 3 " = 1'-0" d-door04.dgn 30A

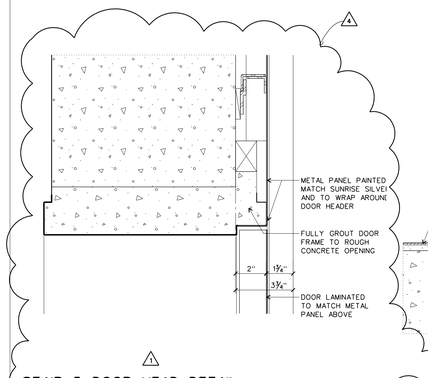


STAIR 5 DOOR HEAD DETAIL

24

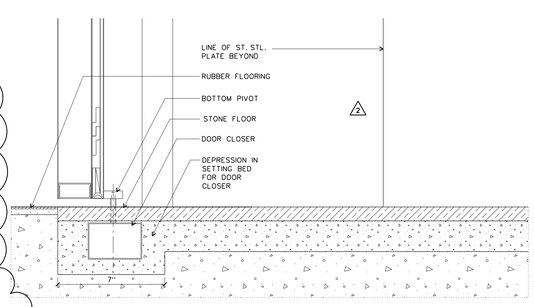


SILL DETAIL FREIGHT ELEV VEST (HEAD SEE 43/A451)

SCALE: 3 " = 1'-0" d-door05.dgn 33

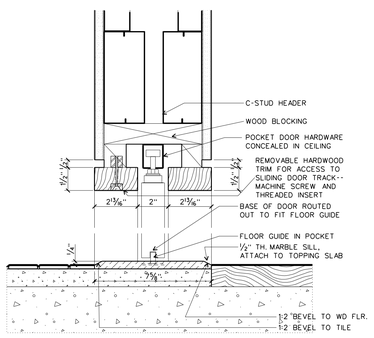


HEAD/SILL DETAIL POCKET DOOR

SCALE: 3 " = 1'-0" d-door04.dgn 32

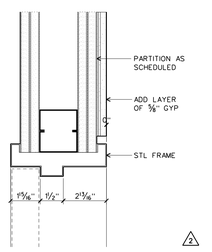


HEAD DETAIL STAIR 2

SCALE: 3 " = 1'-0" d-door04.dgn 31

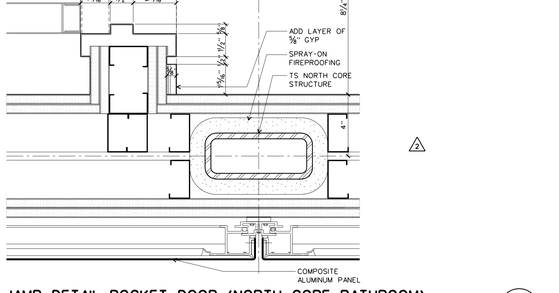


JAMB DETAIL POCKET DOOR (NORTH CORE BATHROOM)

SCALE: 3 " = 1'-0" d-door04.dgn 30

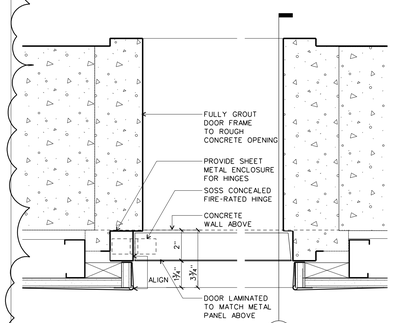


STAIR 5 DOOR JAMB DETAIL

14

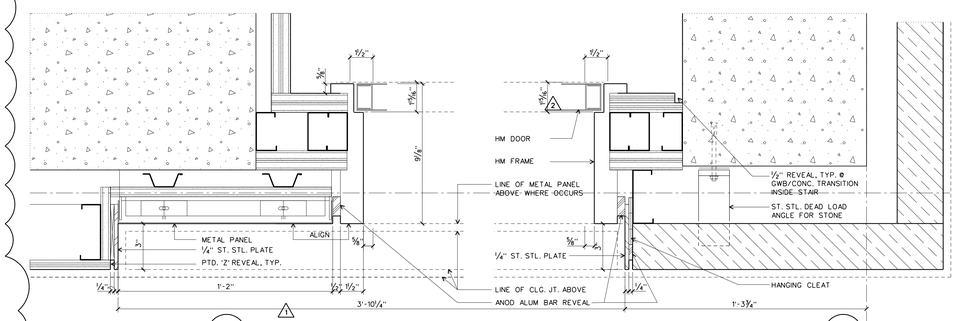

B JAMB DETAIL - STAIR 4: HEAD SIM. A

SCALE: 3" = 1'-0" d-door01.dgn 11

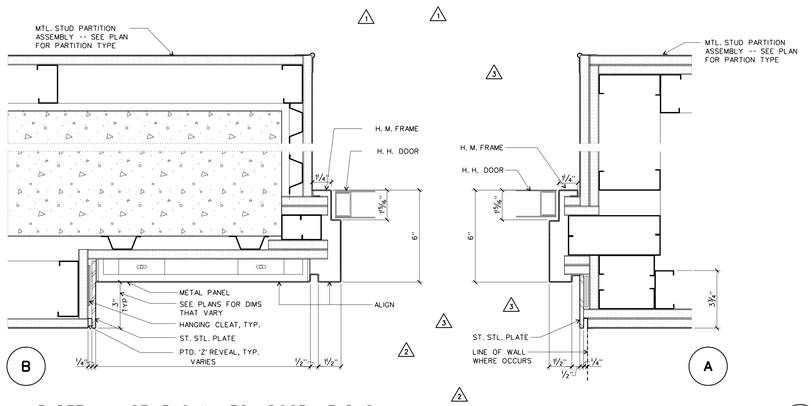

B JAMB DETAIL - STAIR 6: & MECH. DOOR, HEAD SIM. A

SCALE: 3 " = 1'-0" d-door01.dgn 10

WILLIAM J. CLINTON PRESIDENTIAL CENTER

LITTLE ROCK, ARKANSAS

Architect
POLSHEK PARTNERSHIP LLP
320 West 13th Street
New York, New York 10014
212.807.7171

Coordinating Architects
POLK STANLEY YEARY ARCHITECTS Ltd
700 South Schiller Street
Little Rock, Arkansas 72201
501.378.0878

WITSELL EVANS RASCO
901 West Third Street
Little Rock, Arkansas 72201
501.374.5300

WOODS CARADINE ARCHITECTS
2200 South Main Street
Little Rock, Arkansas 72206
501.374.4060

Landscape Architects
HARGREAVES ASSOCIATES
118 Magazine Street
Cambridge, Massachusettes 02139
617.661.0070

LANDSCAPE ARCHITECTURE, Inc.
2300 Cottondale Lane Suite 202
Little Rock, Arkansas 72202
501.374.5610

Structural Engineer
LESLIE E. ROBERTSON ASSOC., RLLP
30 Broad Street, 47th Floor
New York, New York 10004
212.750.9000


MEP Engineers
FLACK + KURTZ Inc.
475 Fifth Avenue
New York, New York 10017
212.532.9600

CROMWELL ARCHITECTS ENGINEERS
101 South Spring Street
Little Rock, Arkansas 72201
501.372.2900

Curtainwall Consultant
R. A. HEINTGES ARCHITECTS
126 Fifth Avenue, 9th Floor
New York, New York 10011
212.852-2966

Seal

Issue	Date
4 ASI # 24	10/24/03
3 ASI # 23	09/12/03
2 ASI # 20	06/06/03
1 Addendum #4	11/22/02
100% Construction Documents	09/27/02
90% Progress Printing	08/30/02

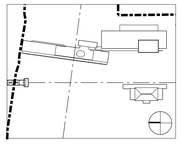

Job No. 9908

Scale AS NOTED

Date September 27, 2002

Title

DOOR DETAILS

Sheet No.

A403

FOR OFFICIAL USE ONLY

WILLIAM J. CLINTON PRESIDENTIAL CENTER

LITTLE ROCK, ARKANSAS

Architect

POLSHEK PARTNERSHIP LLP
320 West 13th Street
New York, New York 10014
212.807.7171

Coordinating Architects

POLK STANLEY YEARY ARCHITECTS Ltd
700 South Schiller Street
Little Rock, Arkansas 72201
501.378.0878

WITSELL EVANS RASCO
901 West Third Street
Little Rock, Arkansas 72201
501.374.5300

WOODS CARADINE ARCHITECTS
2200 South Main Street
Little Rock, Arkansas 72206
501.374.4060

Landscape Architects

HARGREAVES ASSOCIATES
118 Magazine Street
Cambridge, Massachusettes 02139
617.661.0070

LANDSCAPE ARCHITECTURE, Inc.
2300 Cottondale Lane Suite 202
Little Rock, Arkansas 72202
501.374.5610

Structural Engineer

LESLIE E. ROBERTSON ASSOC., RLLP
30 Broad Street, 47th Floor
New York, New York 10004
212.750.9000

MEP Engineers

FLACK + KURTZ Inc.
475 Fifth Avenue
New York, New York 10017
212.532.9600


CROMWELL ARCHITECTS ENGINEERS
101 South Spring Street
Little Rock, Arkansas 72201
501.372.2900

Curtainwall Consultant

R. A. HEINTGES ARCHITECTS
126 Fifth Avenue, 9th Floor
New York, New York 10011
212.652-2966

Seal

Issue	Date
100% Construction Documents	09/27/02
90% Progress Printing	08/30/02
ASI #05	08/20/02
100% Struct./ CD Progress	07/01/02
Bridge Bldg. Substructure	06/14/02
100% Steel & Concrete CD	05/15/02
& Architectural CD Progress	
100% Design Development	03/01/02

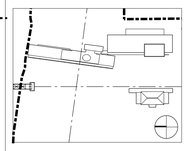

Job No.
9908

Scale
AS NOTED

Date
September 27, 2002

Title

SILL DETAILS

Sheet No.
A405

SILL DETAIL - STAIR 6 @ LOBBY

SCALE: 3" = 1'-0"

XX

d-door02.dgn


SILL DETAIL - STAIR 4,5

SCALE: 3" = 1'-0"

XX


d-door02.dgn

FOR OFFICIAL USE ONLY

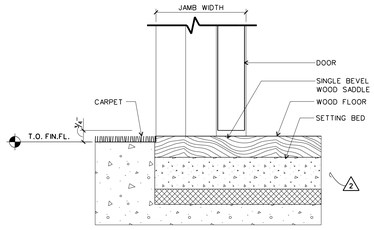


SILL DETAIL - CARPET/WOOD FLOOR 44

SCALE: 3" = 1'-0" d-door02.dgn

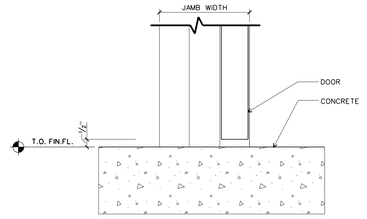


SILL DETAIL - CONCRETE/CONCRETE 43

SCALE: 3" = 1'-0" d-door02.dgn

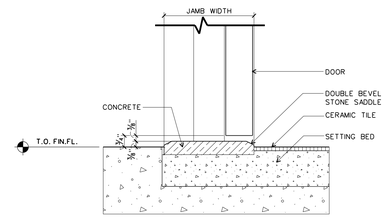


SILL DETAIL - CONCRETE/CERAMIC TILE 42

SCALE: 3" = 1'-0" d-door02.dgn

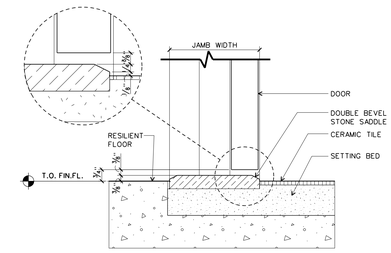


SILL DETAIL - RUBBER FL./CERAMIC TILE 41

SCALE: 3" = 1'-0" d-door02.dgn

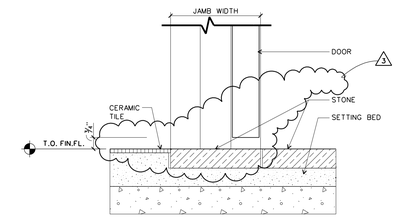


SILL DETAIL - CERAMIC TILE/STONE 40

SCALE: 3" = 1'-0" d-door02.dgn

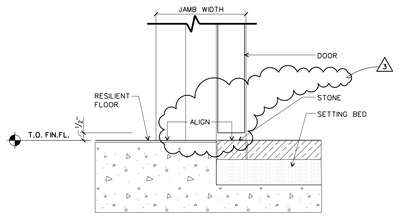


SILL DETAIL - RUBBER FL./STONE 34

SCALE: 3" = 1'-0" d-door02.dgn

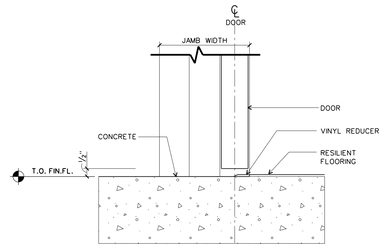


SILL DETAIL - CONCRETE/RUBBER FLOORING 33

SCALE: 3" = 1'-0" d-door02.dgn

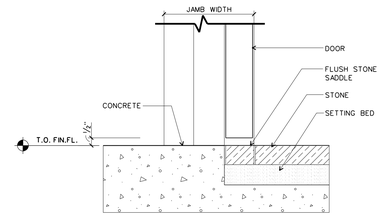


SILL DETAIL - CONCRETE/STONE 32

SCALE: 3" = 1'-0" d-door02.dgn

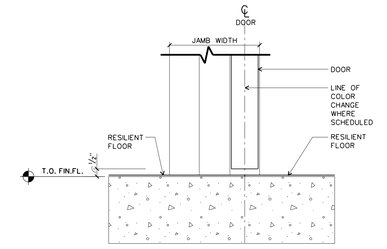


SILL DETAIL - RUBBER FL./RUBBER FL. 31

SCALE: 3" = 1'-0" d-door02.dgn

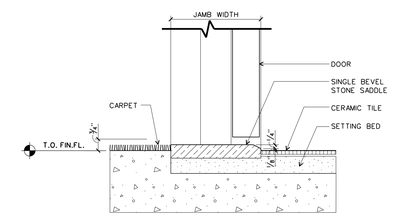


SILL DETAIL - CARPET/CERAMIC TILE 30

SCALE: 3" = 1'-0" d-door02.dgn

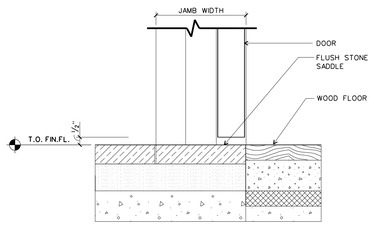


SILL DETAIL - WOOD/STONE 24

SCALE: 3" = 1'-0" d-door02.dgn

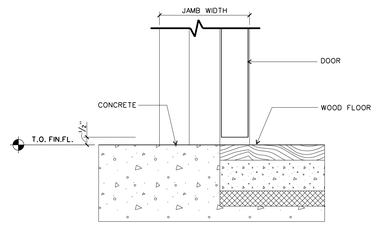


SILL DETAIL - CONCRETE/WOOD FLOOR 23

SCALE: 3" = 1'-0" d-door02.dgn

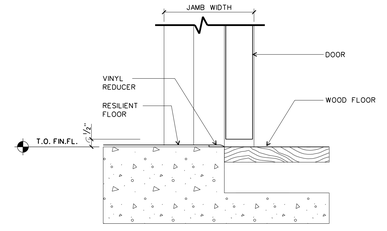


SILL DETAIL - RUBBER FL./WOOD FL. 22

SCALE: 3" = 1'-0" d-door02.dgn

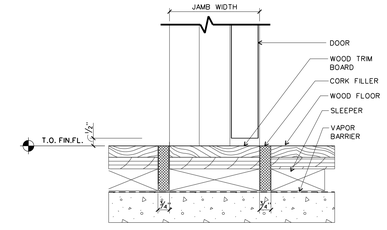


SILL DETAIL - WOOD/WOOD 21

SCALE: 3" = 1'-0" d-door02.dgn

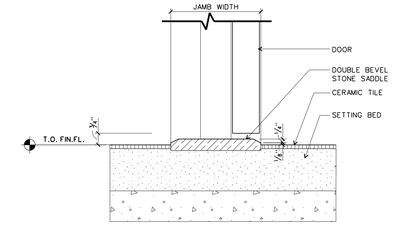


SILL DETAIL - CERAMIC TILE/CERAMIC TILE 20

SCALE: 3" = 1'-0" d-door02.dgn

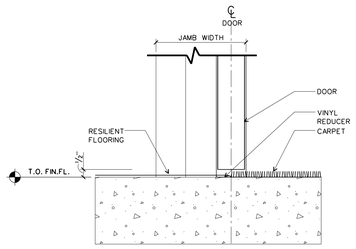


SILL DETAIL - RUBBER FLOORING/CARPET 14

SCALE: 3" = 1'-0" d-door02.dgn

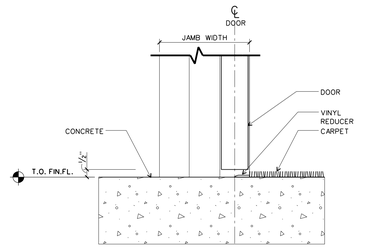


SILL DETAIL - CONCRETE/CARPET 13

SCALE: 3" = 1'-0" d-door02.dgn

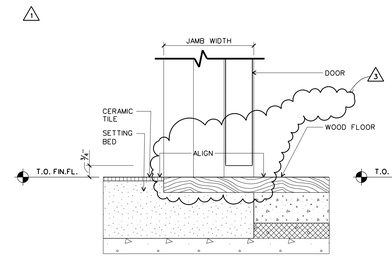


SILL DETAIL - CERAMIC TILE/WOOD 12

SCALE: 3" = 1'-0" d-door02.dgn

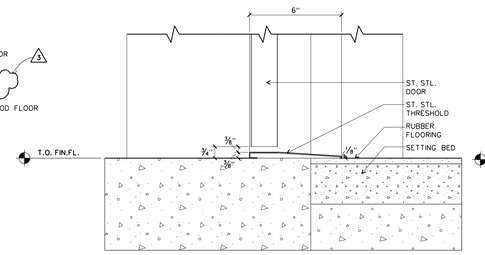

SILL DETAIL - STAIR 4,5 11

SCALE: 3" = 1'-0" d-door02.dgn

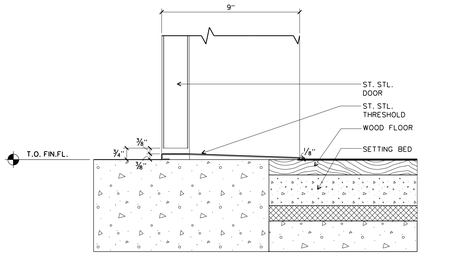

SILL DETAIL - STAIR 4,5 10

SCALE: 3" = 1'-0" d-door02.dgn

WILLIAM J. CLINTON PRESIDENTIAL CENTER

LITTLE ROCK, ARKANSAS

Architect

POLSHEK PARTNERSHIP LLP
320 West 13th Street
New York, New York 10014
212.807.7171

Coordinating Architects

POLK STANLEY YEARY ARCHITECTS Ltd
700 South Schiller Street
Little Rock, Arkansas 72201
501.378.0878

WITSELL EVANS RASCO
901 West Third Street
Little Rock, Arkansas 72201
501.374.5300

WOODS CARADINE ARCHITECTS
2200 South Main Street
Little Rock, Arkansas 72206
501.374.4060

Landscape Architects

HARGREAVES ASSOCIATES
118 Magazine Street
Cambridge, Massachusettes 02139
617.661.0070

LANDSCAPE ARCHITECTURE, Inc.
2300 Cottondale Lane Suite 202
Little Rock, Arkansas 72202
501.374.5610

Structural Engineer

LESLIE E. ROBERTSON ASSOC., RLLP
30 Broad Street, 47th Floor
New York, New York 10004
212.750.9000

MEP Engineers

FLACK + KURTZ Inc.
475 Fifth Avenue
New York, New York 10017
212.532.9600

CROMWELL ARCHITECTS ENGINEERS
101 South Spring Street
Little Rock, Arkansas 72201
501.372.2900

Curtainwall Consultant

R. A. HEINTGES ARCHITECTS
126 Fifth Avenue, 9th Floor
New York, New York 10011
212.652-2966

Seal

Issue	Date
3 ASI #23	09/12/03
2 ASI #20	06/06/03
1 Addendum #2	011/15/02
100% Construction Documents*	09/27/02

*New Sheet. Former A407 renamed A409

Job No. 9908


Scale AS NOTED

Date September 27, 2002


Title SILL DETAILS

Sheet No. A407


FOR OFFICIAL USE ONLY

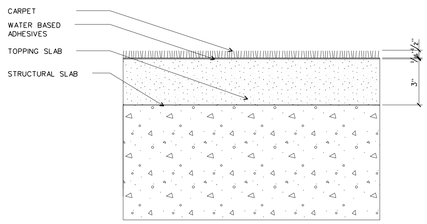


CARPET

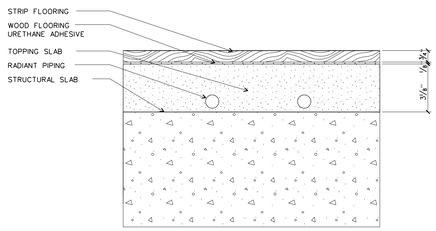


WOOD FLOORING - SOLID LUMBER

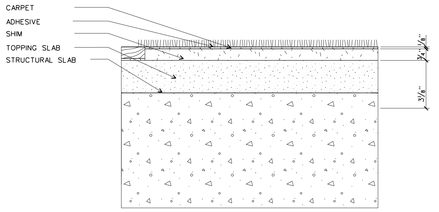


CARPET AT OVAL OFFICE

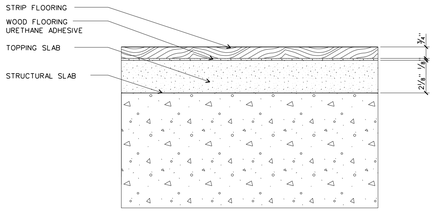


WOOD FLOORING - SOLID LUMBER

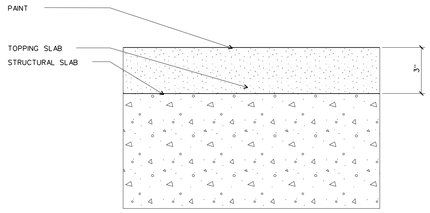


CONCRETE

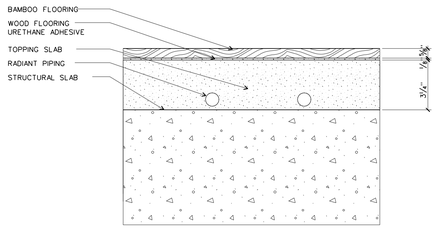


WOOD FLOORING - BAMBOO

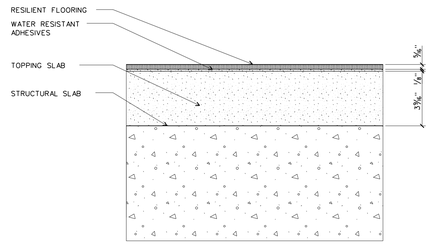


RESILIENT FLOORING

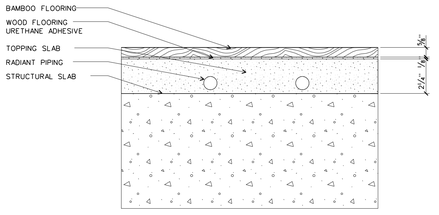


WOOD FLOORING - BAMBOO

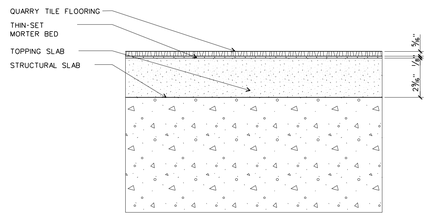


QUARRY TILE

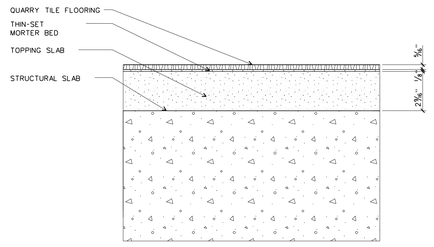


QUARRY TILE

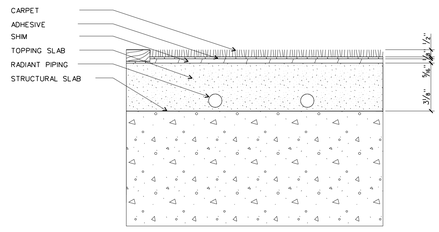


CARPET AT CABINET ROOM

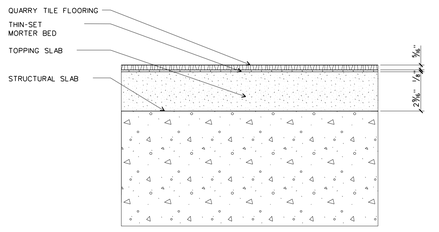


QUARRY TILE

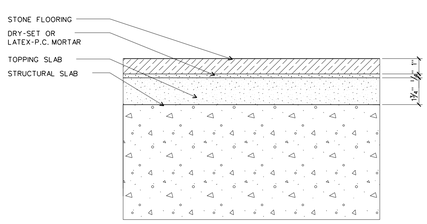


STONE FLOORING

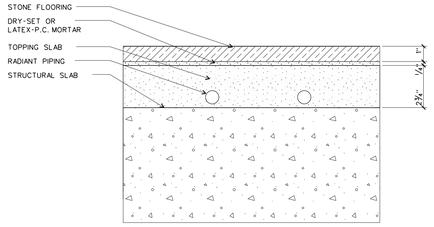

STONE FLOORING

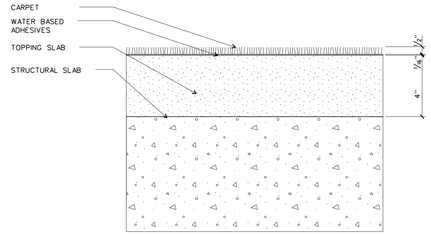

CARPET AT ORIENTATION THEATER

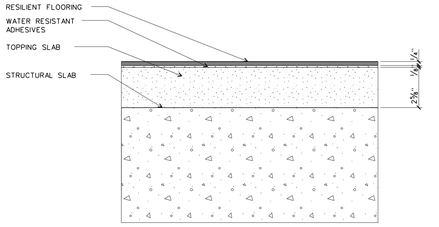

RESILIENT FLOORING

GROUND LEVEL FLOOR SECTIONS

SCALE: 3 " = 1'-0" d-interior-flooring.dgn 12

MUSEUM LOWER LEVEL FLOOR SECTIONS

SCALE: 3 " = 1'-0" d-interior-flooring.dgn 11

MUSEUM UPPER LEVEL FLOOR SECTIONS

SCALE: 3 " = 1'-0" d-interior-flooring.dgn 10

WILLIAM J. CLINTON PRESIDENTIAL CENTER

LITTLE ROCK, ARKANSAS

Architect

POLSHEK PARTNERSHIP LLP
320 West 13th Street
New York, New York 10014
212.807.7171

Coordinating Architects

POLK STANLEY YEARY ARCHITECTS Ltd
700 South Schiller Street
Little Rock, Arkansas 72201
501.378.0878

WITSELL EVANS RASCO
901 West Third Street
Little Rock, Arkansas 72201
501.374.5300

WOODS CARADINE ARCHITECTS
2200 South Main Street
Little Rock, Arkansas 72206
501.374.4060

Landscape Architects

HARGREAVES ASSOCIATES
118 Magazine Street
Cambridge, Massachusettes 02139
617.661.0070

LANDSCAPE ARCHITECTURE, Inc.
2300 Cottondale Lane Suite 202
Little Rock, Arkansas 72202
501.374.5610

Structural Engineer

LESLIE E. ROBERTSON ASSOC., RLLP
30 Broad Street, 47th Floor
New York, New York 10004
212.750.9000

MEP Engineers

FLACK + KURTZ Inc.
475 Fifth Avenue
New York, New York 10017
212.532.9600

CROMWELL ARCHITECTS ENGINEERS
101 South Spring Street
Little Rock, Arkansas 72201
501.372.2900

Curtainwall Consultant

R. A. HEINTGES ARCHITECTS
126 Fifth Avenue, 9th Floor
New York, New York 10011
212.652-2966

Seal

Issue	Date
1 ASI #17	03/07/03

*New Sheet. Former A407 renamed A409

Job No. 9908

Scale 3"=1'-0"


Date September 27, 2002

Title

FLOOR SECTION DETAILS

Sheet No. 1 A408

FOR OFFICIAL USE ONLY

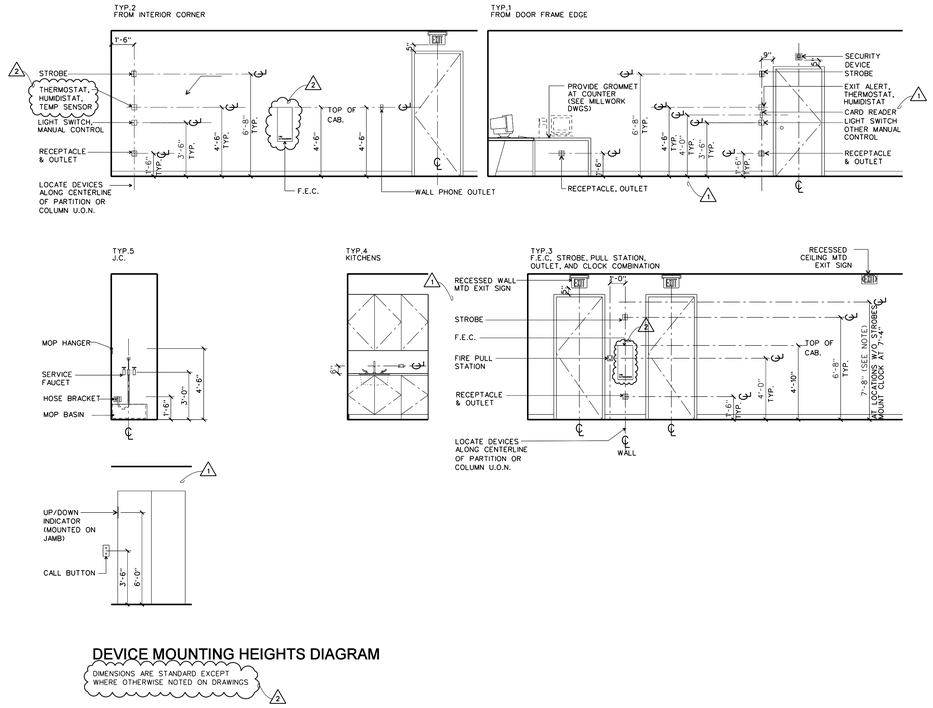

DEVICE MOUNTING HEIGHTS DIAGRAM

DIMENSIONS ARE STANDARD EXCEPT WHERE OTHERWISE NOTED ON DRAWINGS 2

WILLIAM J. CLINTON PRESIDENTIAL CENTER

LITTLE ROCK, ARKANSAS

Architect

POLSHEK PARTNERSHIP LLP
320 West 13th Street
New York, New York 10014
212.807.7171

Coordinating Architects

POLK STANLEY YEARY ARCHITECTS Ltd
700 South Schiller Street
Little Rock, Arkansas 72201
501.378.0878

WITSELL EVANS RASCO
901 West Third Street
Little Rock, Arkansas 72201
501.374.5300

WOODS CARADINE ARCHITECTS
2200 South Main Street
Little Rock, Arkansas 72206
501.374.4060

Landscape Architects

HARGREAVES ASSOCIATES
118 Magazine Street
Cambridge, Massachusettes 02139
617.661.0070

LANDSCAPE ARCHITECTURE, Inc.
2300 Cottondale Lane Suite 202
Little Rock, Arkansas 72202
501.374.5610

Structural Engineer

LESLIE E. ROBERTSON ASSOC., RLLP
30 Broad Street, 47th Floor
New York, New York 10004
212.750.9000

MEP Engineers

FLACK + KURTZ Inc.
475 Fifth Avenue
New York, New York 10017
212.532.9600

CROMWELL ARCHITECTS ENGINEERS
101 South Spring Street
Little Rock, Arkansas 72201
501.372.2900

Curtainwall Consultant

R. A. HEINTGES ARCHITECTS
126 Fifth Avenue, 9th Floor
New York, New York 10011
212.652-2966

Seal

Issue	Date
2 ASI #20	06/06/03
1 Addendum #2	11/15/02
100% Construction Documents	09/27/02
90% Progress Printing	08/30/02

Job No.
9908


Scale

Date
September 27, 2002

Title
INTERIOR MATERIALS, FINISH ABBREV'S. & DEVICE MOUNTING HGHTS


Sheet No.
A410

FOR OFFICIAL USE ONLY

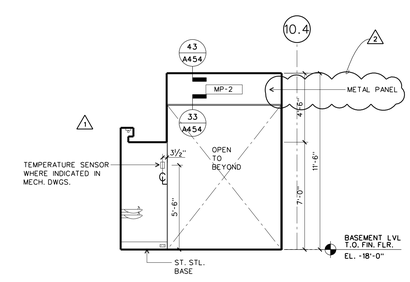


B-11 ELEV LOBBY: WEST ELEVATION

base/elev/b-inel11.dgn **53**

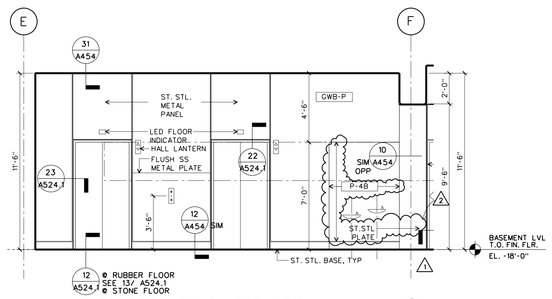


B-01 LOBBY: SOUTH ELEVATION

SCALE: 1/4" = 1'-0" base/elev/b-inel11.dgn **52**

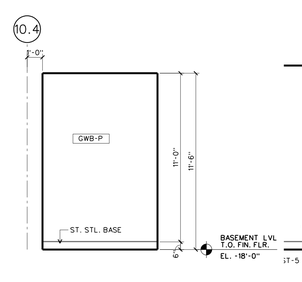


B-11 ELEV LOBBY: EAST ELEVATION

base/elev/b-inel00.dgn **51**

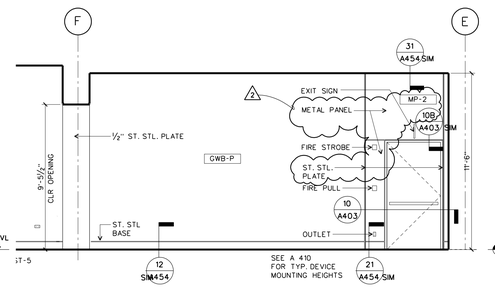

B-01 LOBBY: NORTH ELEVATION

SCALE: 1/4" = 1'-0" base/elev/b-inel11.dgn **50**

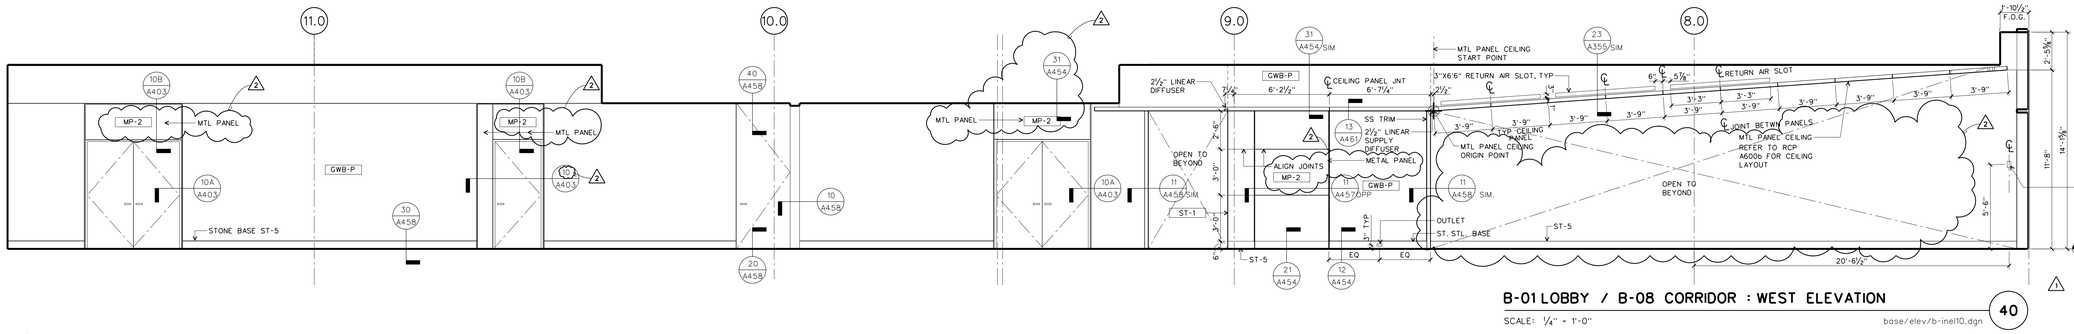

B-01 LOBBY / B-08 CORRIDOR : WEST ELEVATION

SCALE: 1/4" = 1'-0" base/elev/b-inel10.dgn **40**

B-01 LOBBY: SOUTH ELEVATION

SCALE: 1/4" = 1'-0" base/elev/b-inel11.dgn **33**

B-01 LOBBY: NORTH ELEVATION


SCALE: 1/4" = 1'-0" base/elev/b-inel11.dgn **32**

B-05 SERVERY: EAST ELEVATION

SCALE: 1/4" = 1'-0" base/elev/b-inel10.dgn **31**


B-05 SERVERY: SOUTH ELEVATION

SCALE: 1/4" = 1'-0" base/elev/b-inel00.dgn **30**

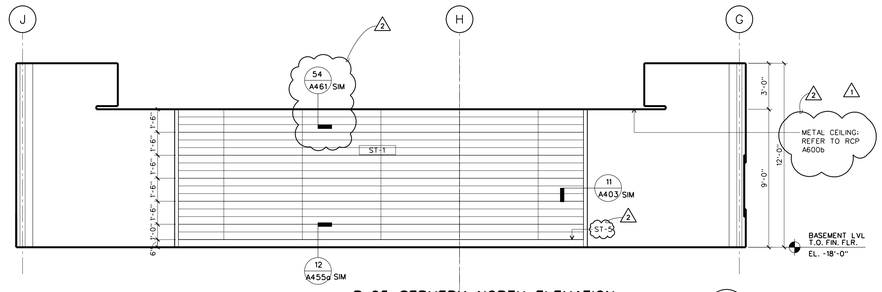

B-05 SERVERY: NORTH ELEVATION

SCALE: 1/4" = 1'-0" base/elev/b-inel00.dgn **21**

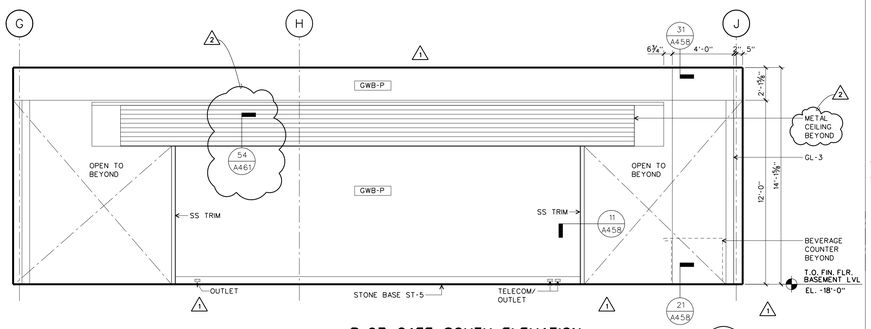

B-07 CAFE: SOUTH ELEVATION

SCALE: 1/4" = 1'-0" base/elev/b-inel10.dgn **20**

B-07 CAFE/ B-08 CORRIDOR/ B-01 LOBBY: EAST ELEVATION

SCALE: 1/4" = 1'-0" base/elev/b-inel11.dgn **10**

WILLIAM J. CLINTON PRESIDENTIAL CENTER

LITTLE ROCK, ARKANSAS

Architect

POLSHEK PARTNERSHIP LLP
320 West 13th Street
New York, New York 10014
212.807.7171

Coordinating Architects

POLK STANLEY YEARY ARCHITECTS Ltd
700 South Schiller Street
Little Rock, Arkansas 72201
501.378.0878

WITSELL EVANS RASCO
901 West Third Street
Little Rock, Arkansas 72201
501.374.5300

WOODS CARADINE ARCHITECTS
2200 South Main Street
Little Rock, Arkansas 72206
501.374.4060

Landscape Architects

HARGREAVES ASSOCIATES
118 Magazine Street
Cambridge, Massachusettes 02139
617.661.0070

LANDSCAPE ARCHITECTURE, Inc.
2300 Cottondale Lane Suite 202
Little Rock, Arkansas 72202
501.374.5610

Structural Engineer

LESLIE E. ROBERTSON ASSOC., RLLP
30 Broad Street, 47th Floor
New York, New York 10004
212.750.9000

MEP Engineers

FLACK + KURTZ Inc.
475 Fifth Avenue
New York, New York 10017
212.532.9600

CROMWELL ARCHITECTS ENGINEERS
101 South Spring Street
Little Rock, Arkansas 72201
501.372.2900

Curtainwall Consultant

R. A. HEINTGES ARCHITECTS
126 Fifth Avenue, 9th Floor
New York, New York 10011
212.652-2966

Seal

2 ASI #23	09/12/03
1 ASI #20	06/06/03
100% Construction Documents	09/27/02
90% Progress Printing	08/30/02
100% Struct./ CD Progress	07/01/02
100% Steel & Concrete CD	05/15/02
& Architectural CD Progress	
100% Design Development	03/01/02
Issue	Date

Job No. 9908

Scale 1/4" = 1'-0"


Date September 27, 2002

Title

MUSEUM BUILDING INTERIOR ELEVATIONS: BASEMENT


Sheet No. A411

FOR OFFICIAL USE ONLY

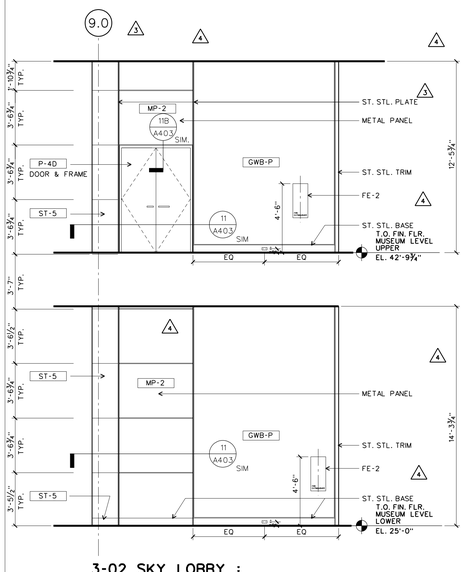


3-02 SKY LOBBY : EAST ELEVATION STAIR 4 — 42

SCALE: 1/4" = 1'-0" base/elev/b-inel10.dgn

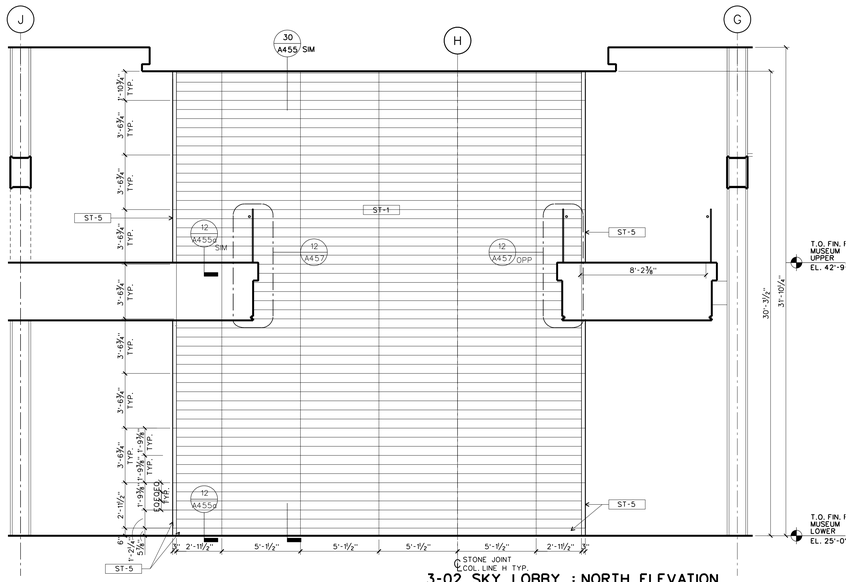


3-02 SKY LOBBY : NORTH ELEVATION LOOKING TOWARDS STAIR 4 — 41

SCALE: 1/4" = 1'-0" base/elev/b-inel10.dgn

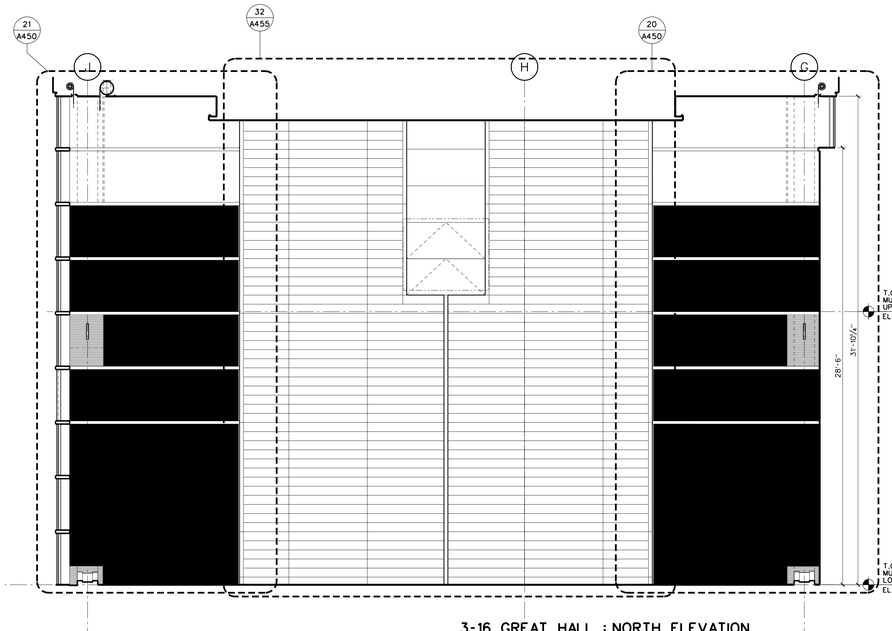


3-16 GREAT HALL : NORTH ELEVATION STAIR 5 — 40

SCALE: 1/4" = 1'-0" base/elev/b-inel13.dgn

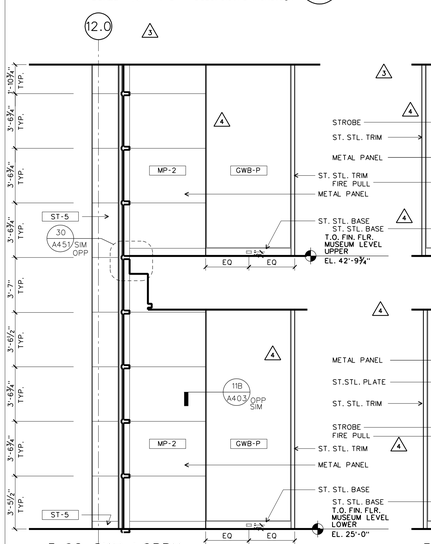


3-02 SKY LOBBY : EAST ELEVATION STAIR 5 — 24

SCALE: 1/4" = 1'-0" base/elev/b-inel10.dgn

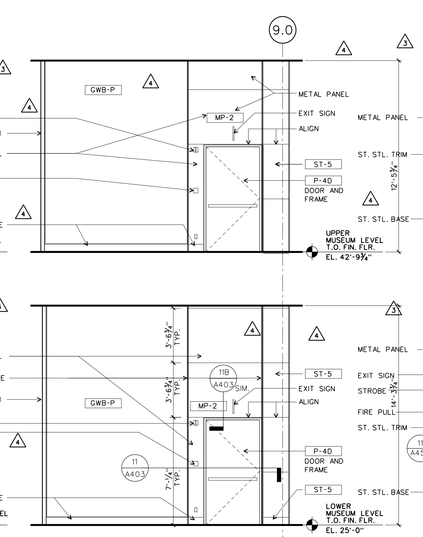


3-02 SKY LOBBY : WEST ELEVATION STAIR 4 — 23

SCALE: 1/4" = 1'-0" base/elev/b-inel10.dgn

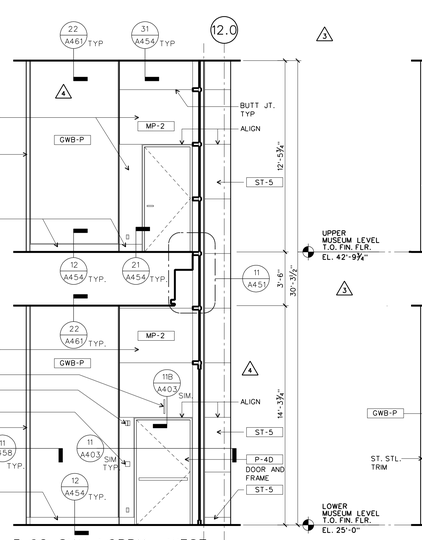


3-02 SKY LOBBY : WEST ELEVATION STAIR 5 — 22

base/elev/b-inel10.dgn

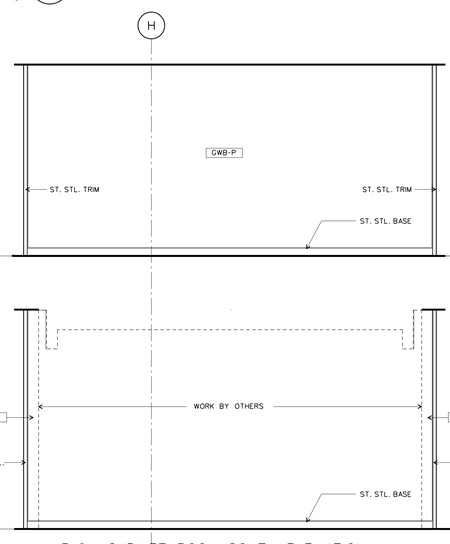


3-04 CABINET ROOM: SOUTH ELEVATION STAIR 4 — 21

SCALE: 1/4" = 1'-0" base/elev/b-inel10.dgn

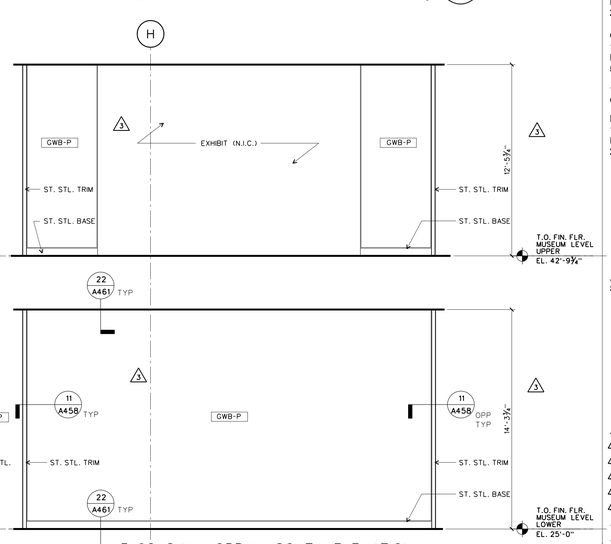


3-02 SKY LOBBY : SOUTH ELEVATION STAIR 5 — 20

SCALE: 1/4" = 1'-0" base/elev/b-inel13.dgn

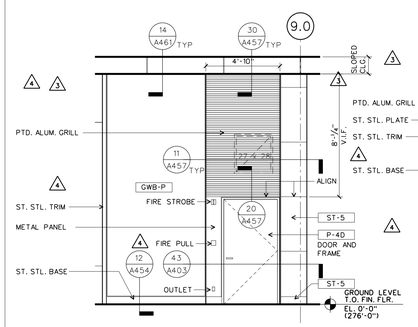


1-01 LOBBY : WEST ELEVATION STAIR 4 — 14

base/elev/b-inel10.dgn

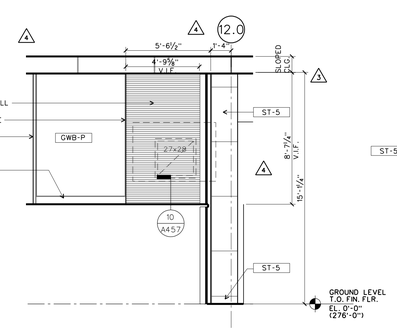


1-01 LOBBY : WEST ELEVATION STAIR 5 — 13

base/elev/b-inel10.dgn

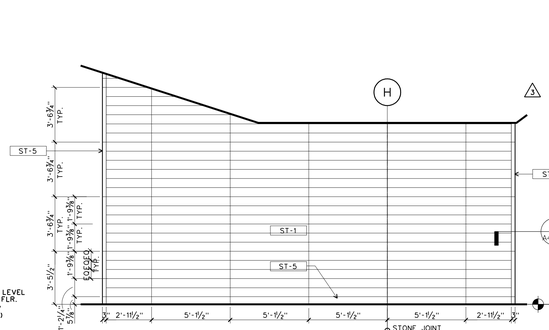


1-01 LOBBY : SOUTH ELEVATION STAIR 4 / STAIR 5 SIM — 12

SCALE: 1/4" = 1'-0" base/elev/b-inel10.dgn

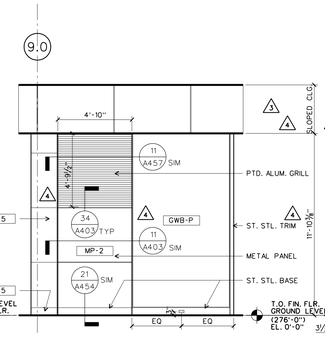

1-01 LOBBY : EAST ELEVATION STAIR 4 — 11

base/elev/b-inel10.dgn

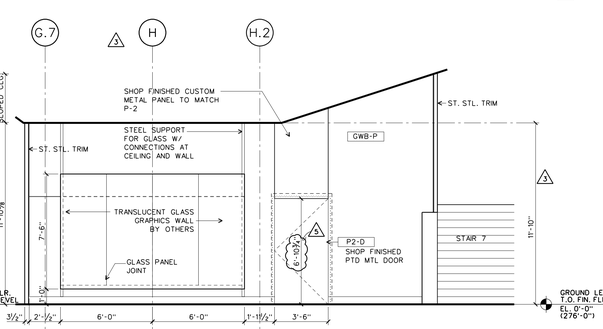

1-01 LOBBY : NORTH ELEVATION STAIR 5/ STAIR 4 SIM — 10

SCALE: 1/4" = 1'-0" base/elev/b-inel13.dgn

WILLIAM J. CLINTON PRESIDENTIAL CENTER

LITTLE ROCK, ARKANSAS

Architect

POLSHEK PARTNERSHIP LLP
320 West 13th Street
New York, New York 10014
212.807.7171

Coordinating Architects

POLK STANLEY YEARY ARCHITECTS Ltd
700 South Schiller Street
Little Rock, Arkansas 72201
501.378.0878

WITSELL EVANS RASCO
901 West Third Street
Little Rock, Arkansas 72201
501.374.5300

WOODS CARADINE ARCHITECTS
2200 South Main Street
Little Rock, Arkansas 72206
501.374.4060

Landscape Architects

HARGREAVES ASSOCIATES
118 Magazine Street
Cambridge, Massachusettes 02139
617.661.0070

LANDSCAPE ARCHITECTURE, Inc.
2300 Cottondale Lane Suite 202
Little Rock, Arkansas 72202
501.374.5610

Structural Engineer

LESLIE E. ROBERTSON ASSOC., RLLP
30 Broad Street, 47th Floor
New York, New York 10004
212.750.9000

MEP Engineers

FLACK + KURTZ Inc.
475 Fifth Avenue
New York, New York 10017
212.532.9600


CROMWELL ARCHITECTS ENGINEERS
101 South Spring Street
Little Rock, Arkansas 72201
501.372.2900

Curtainwall Consultant

R. A. HEINTGES ARCHITECTS
126 Fifth Avenue, 9th Floor
New York, New York 10011
212.652-2966

Seal

Issue	Date
5 ASI #24	10/24/03
4 ASI #23	09/12/03
3 ASI #20	06/06/03
2 Addenda #	01/06/03
1 Addenda #1	11/15/02
100% Construction Documents	09/27/02
90% Progress Printing	08/30/02
100% Struct./ CD Progress	07/01/02
100% Steel & Concrete CD	05/15/02
& Architectural CD Progress	
100% Design Development	03/01/02

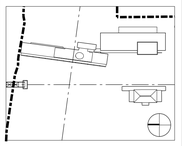

Job No. 9908

Scale 1/4" = 1'-0"

Date September 27, 2002


Title

MUSEUM BUILDING INTERIOR ELEVATIONS: GROUND FLOOR

Sheet No.

A412

FOR OFFICIAL USE ONLY

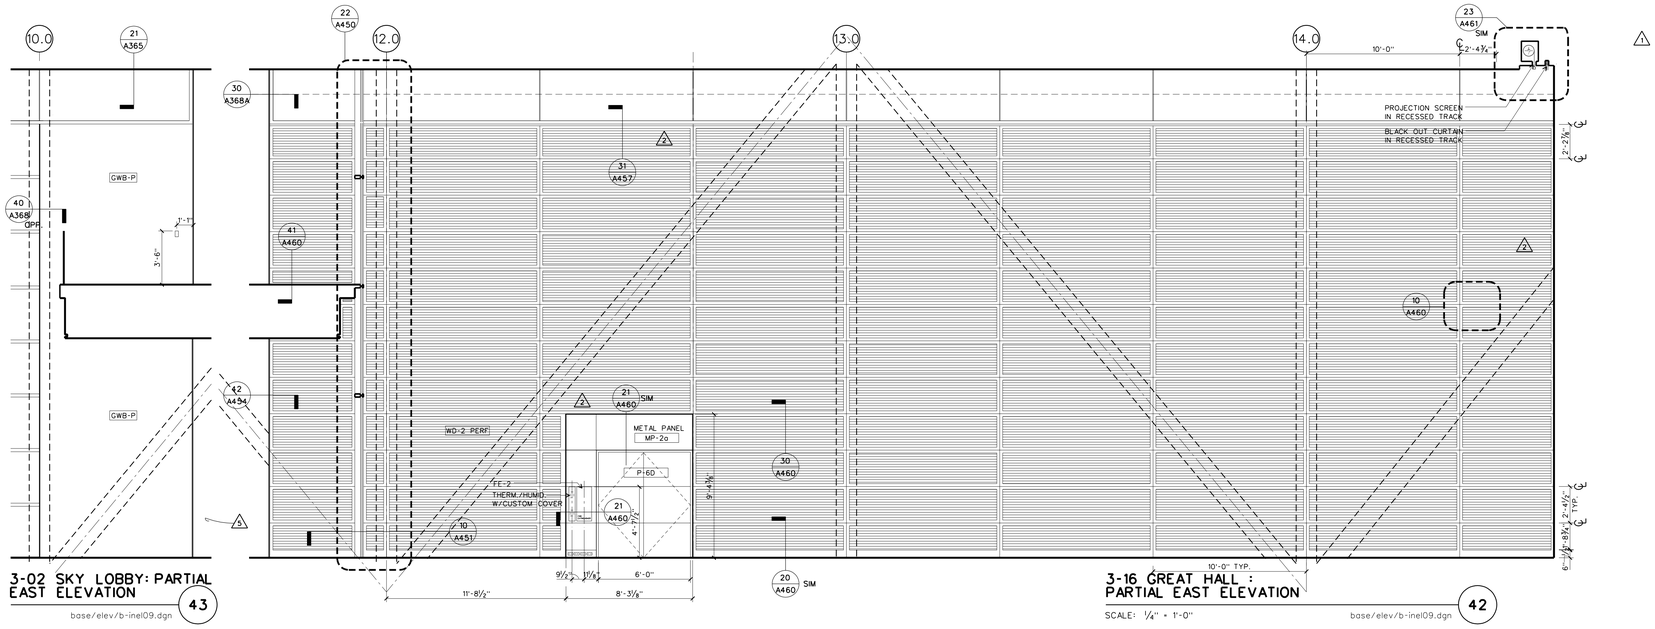


3-02 SKY LOBBY: PARTIAL EAST ELEVATION

base/elev/b-inel09.dgn 43


3-16 GREAT HALL : PARTIAL EAST ELEVATION

SCALE: 1/4" = 1'-0" base/elev/b-inel09.dgn 42

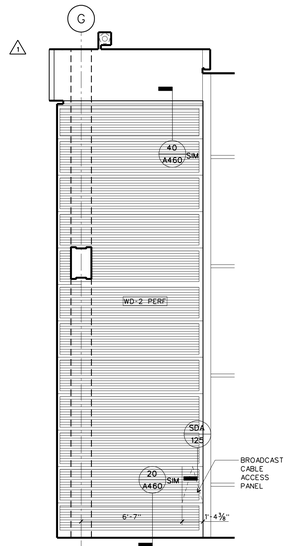

3-16 GREAT HALL: PARTIAL SOUTH ELEVATION

SCALE: 1/4" base/elev/b-inel09.dgn 40

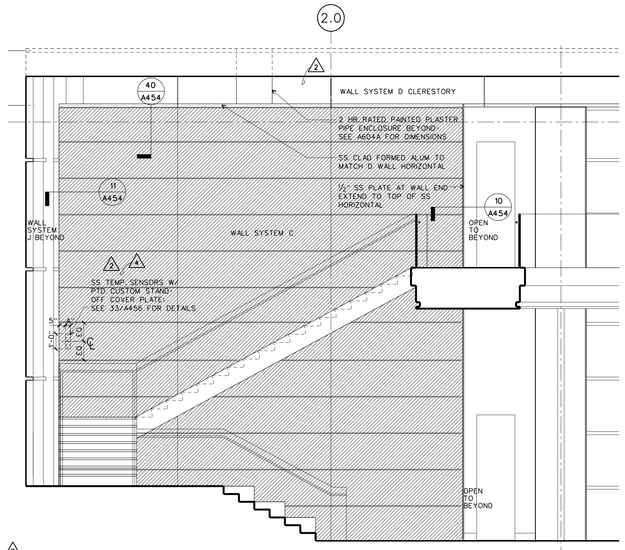


3-09 CORE LOBBY : SOUTH ELEVATION

SCALE: 1/4" bd8e0\elev/b-inel11.dgn 14


3-06 STAIR LANDING: EAST ELEVATION

SCALE: 1/4" = 1'-0" base/elev/b-inel03.dgn 13

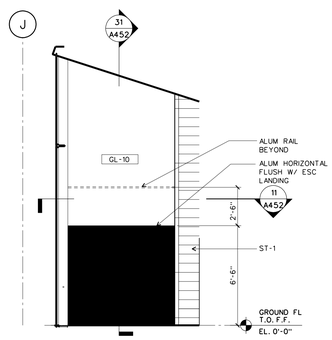


1-06 GIFT SHOP: NORTH ELEVATION

base/elev/b-inel02.dgn 12

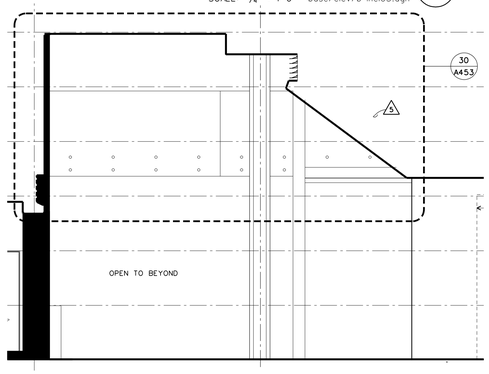

1-07 CORE LOBBY : SOUTH ELEVATION

SCALE: 1/4" = 1'-0" base/elev/b-inel11.dgn 11

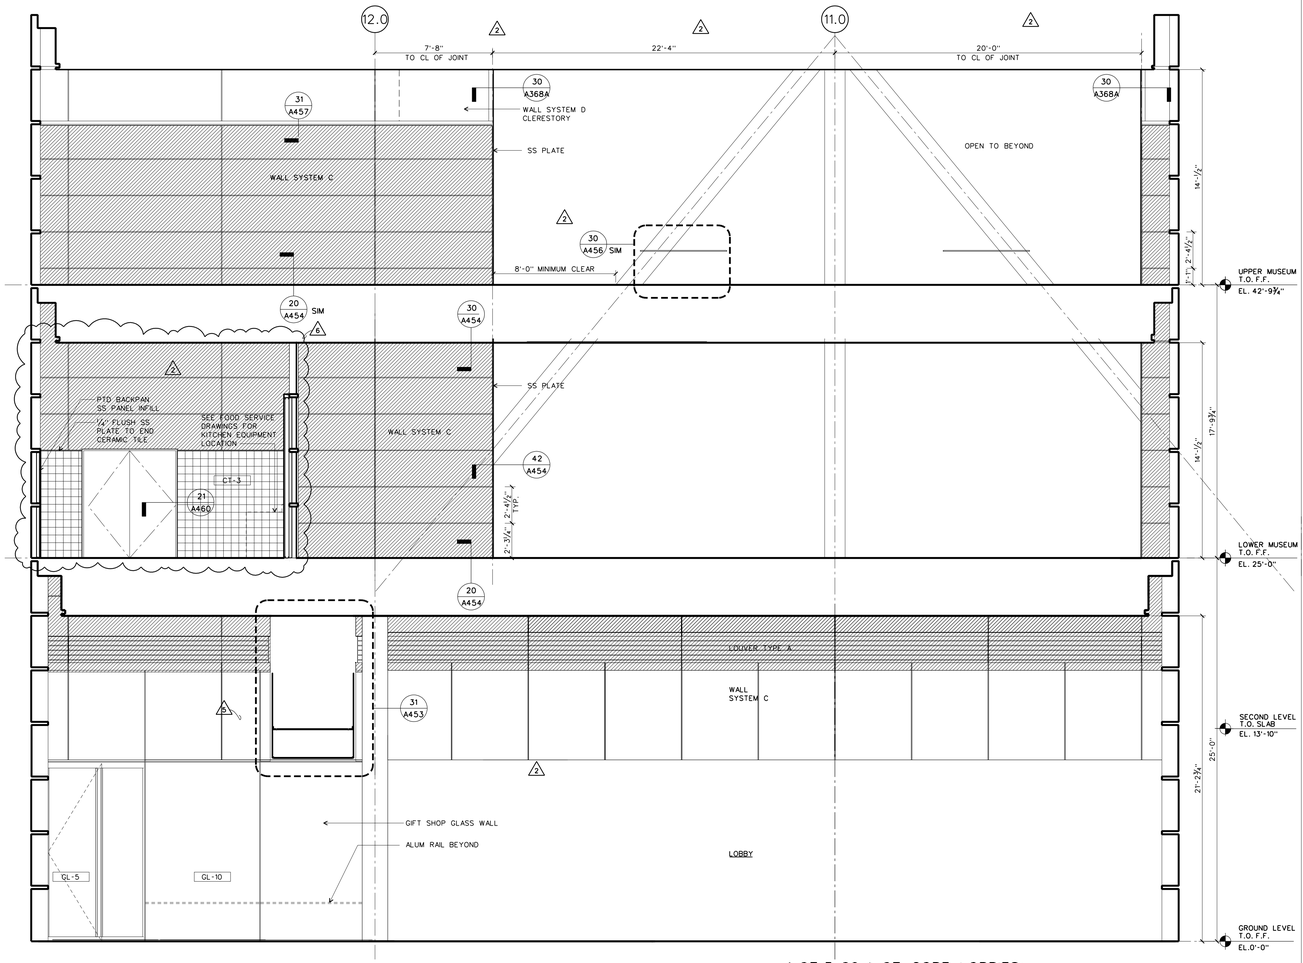

1-07,3-09,4-07 CORE LOBBIES: WEST ELEVATION

SCALE: 1/4" = 1'-0" base/elev/b-inel02.dgn 10

WILLIAM J. CLINTON PRESIDENTIAL CENTER

LITTLE ROCK, ARKANSAS

Architect

POLSHEK PARTNERSHIP LLP
320 West 13th Street
New York, New York 10014
212.807.7171

Coordinating Architects

POLK STANLEY YEARY ARCHITECTS Ltd
700 South Schiller Street
Little Rock, Arkansas 72201
501.378.0878

WITSELL EVANS RASCO
901 West Third Street
Little Rock, Arkansas 72201
501.374.5300

WOODS CARADINE ARCHITECTS
2200 South Main Street
Little Rock, Arkansas 72206
501.374.4060

Landscape Architects

HARGREAVES ASSOCIATES
118 Magazine Street
Cambridge, Massachusettes 02139
617.661.0070

LANDSCAPE ARCHITECTURE, Inc.
2300 Cottondale Lane Suite 202
Little Rock, Arkansas 72202
501.374.5610

Structural Engineer

LESLIE E. ROBERTSON ASSOC., RLLP
30 Broad Street, 47th Floor
New York, New York 10004
212.750.9000

MEP Engineers

FLACK + KURTZ Inc.
475 Fifth Avenue
New York, New York 10017
212.532.9600


CROMWELL ARCHITECTS ENGINEERS
101 South Spring Street
Little Rock, Arkansas 72201
501.372.2900

Curtainwall Consultant

R. A. HEINTGES ARCHITECTS
126 Fifth Avenue, 9th Floor
New York, New York 10011
212.652-2966

Seal

Issue	Date
6 ASI #26	01/16/04
5 ASI #25	12/19/03
4 ASI #24	10/24/03
3 ASI #23	09/12/03
2 ASI #20	06/06/03
1 Addendum #2	11/15/02
100% Construction Documents	09/27/02
90% Progress Printing	08/30/02
100% Struct./ CD Progress	07/01/02
100% Steel & Concrete CD & Architectural CD Progress	05/15/02
100% Design Development	03/01/02

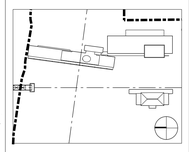

Job No. 9908

Scale 1/4" = 1'-0"

Date September 27, 2002


Title

MUSEUM BUILDING INTERIOR ELEVATIONS:

Sheet No.


A413

FOR OFFICIAL USE ONLY

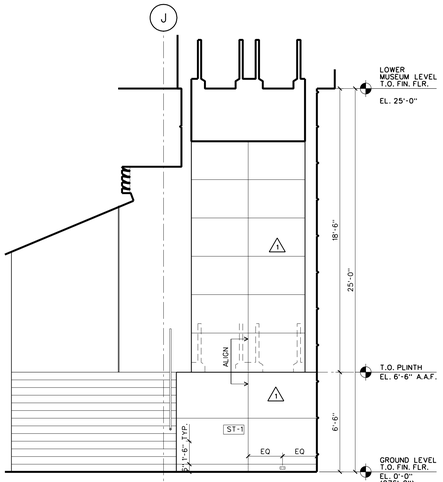


1-01 MAIN LOBBY: PARTIAL SOUTH ELEVATION 52

base/elev/b-inel16.dgn

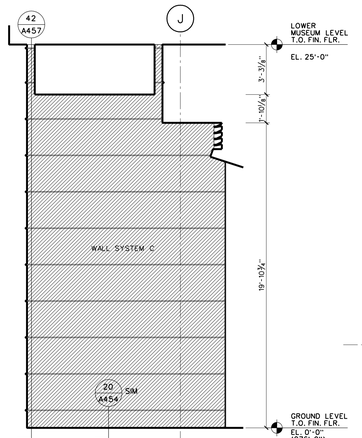


1-01 MAIN LOBBY: PARTIAL NORTH ELEVATION 51

base/elev/b-inel16.dgn

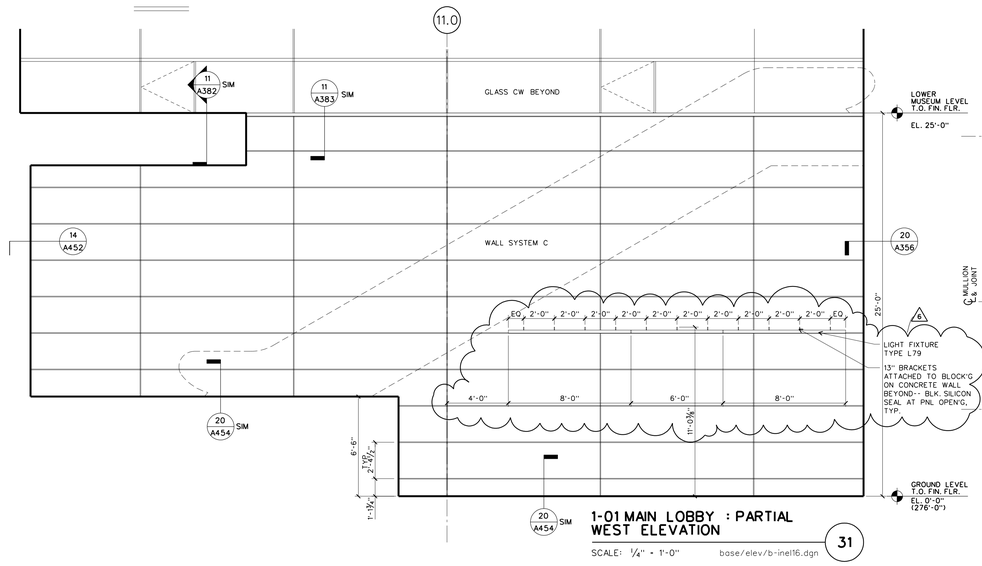


1-01 MAIN LOBBY : PARTIAL WEST ELEVATION 31

SCALE: ¼" = 1'-0" base/elev/b-inel16.dgn

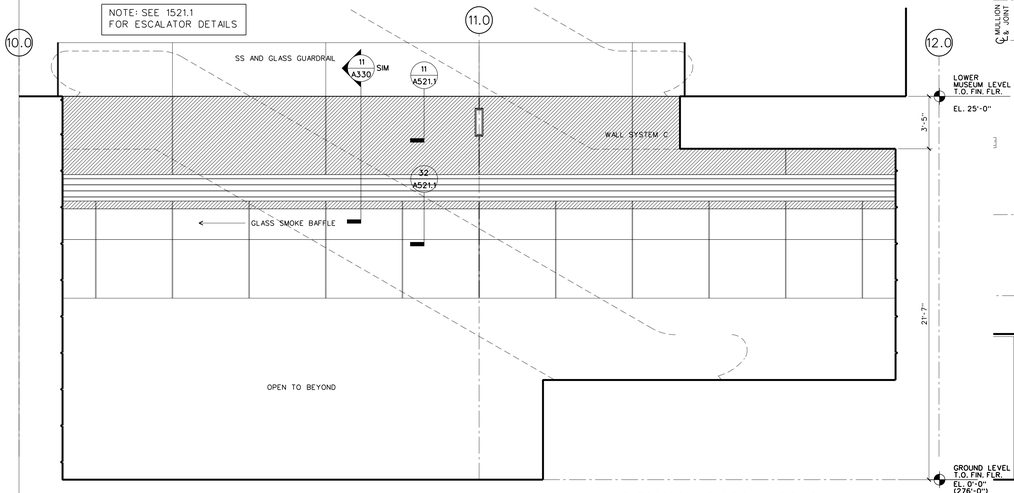

1-01 MAIN LOBBY : PARTIAL EAST ELEVATION 11

SCALE: ¼" = 1'-0" base/elev/b-inel16.dgn

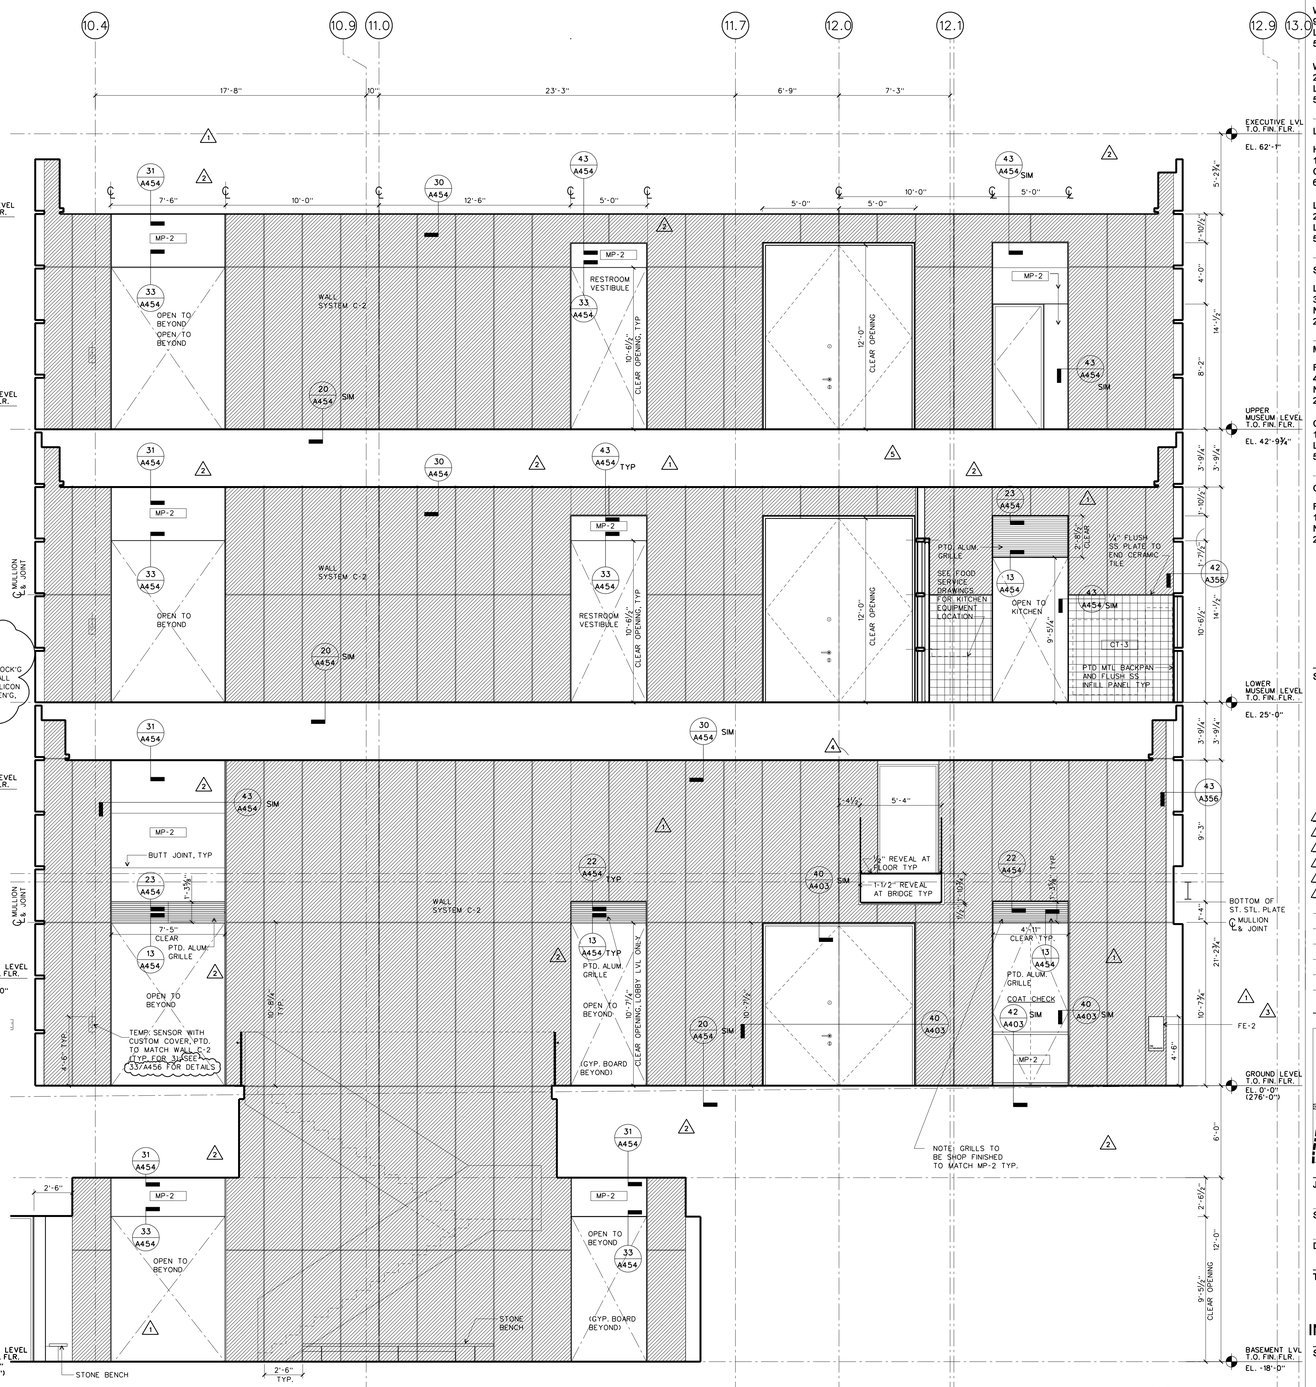

B-01, 1-07,3-09 & 4-07 CORE LOBBIES: EAST ELEVATION 10

SCALE: ¼" = 1'-0" base/elev/b-inel11.dgn

WILLIAM J. CLINTON PRESIDENTIAL CENTER

LITTLE ROCK, ARKANSAS

Architect

POLSHEK PARTNERSHIP LLP
320 West 13th Street
New York, New York 10014
212.807.7171

Coordinating Architects

POLK STANLEY YEARY ARCHITECTS Ltd
700 South Schiller Street
Little Rock, Arkansas 72201
501.378.0878

WITSELL EVANS RASCO
901 West Third Street
Little Rock, Arkansas 72201
501.374.5300

WOODS CARADINE ARCHITECTS
2200 South Main Street
Little Rock, Arkansas 72206
501.374.4060

Landscape Architects

HARGREAVES ASSOCIATES
118 Magazine Street
Cambridge, Massachusetts 02139
617.661.0070

LANDSCAPE ARCHITECTURE, Inc.
2300 Cottondale Lane Suite 202
Little Rock, Arkansas 72202
501.374.5610

Structural Engineer

LESLIE E. ROBERTSON ASSOC., RLLP
30 Broad Street, 47th Floor
New York, New York 10004
212.750.9000

MEP Engineers

FLACK + KURTZ Inc.
475 Fifth Avenue
New York, New York 10017
212.532.9600


CROMWELL ARCHITECTS ENGINEERS
101 South Spring Street
Little Rock, Arkansas 72201
501.372.2900

Curtainwall Consultant

R. A. HEINTGES ARCHITECTS
126 Fifth Avenue, 9th Floor
New York, New York 10011
212.652-2966

Seal

6	ASI #32	04/09/04
5	ASI #26	01/16/04
4	ASI #25	12/19/03
3	ASI #24	10/24/03
2	ASI #23	09/12/03
1	ASI #20	06/06/03
	100% Construction Documents	09/27/02
	90% Progress Printing	08/30/02
	100% Struct./ CD Progress	07/01/02
	100% Steel & Concrete CD & Architectural CD Progress	05/15/02
	100% Design Development	03/01/02
	Issue	Date

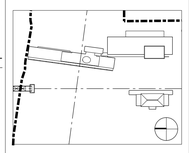

Job No. 9908

Scale 1/4" = 1'-0"

Date September 27, 2002


Title

MUSEUM BUILDING INTERIOR ELEVATIONS:

Sheet No.


A414

FOR OFFICIAL USE ONLY

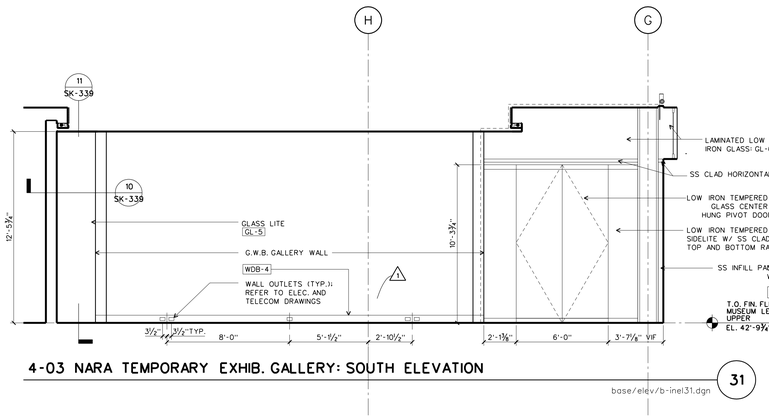


4-03 NARA TEMPORARY EXHIB. GALLERY: SOUTH ELEVATION

base/elev/b-inel31.dgn 31

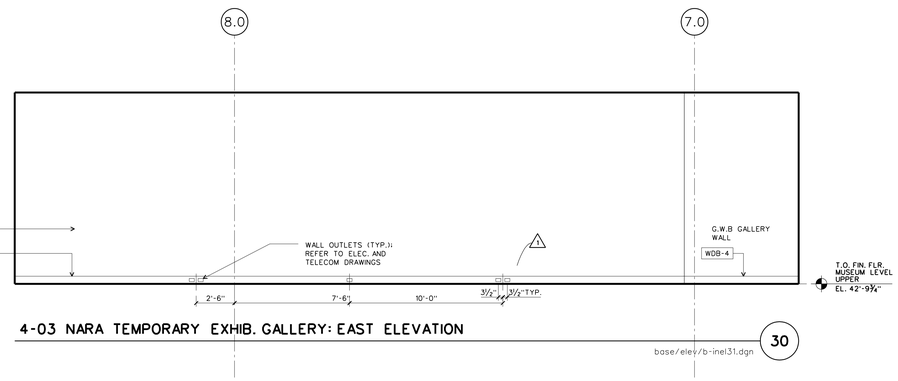


4-03 NARA TEMPORARY EXHIB. GALLERY: EAST ELEVATION

base/elev/b-inel31.dgn 30

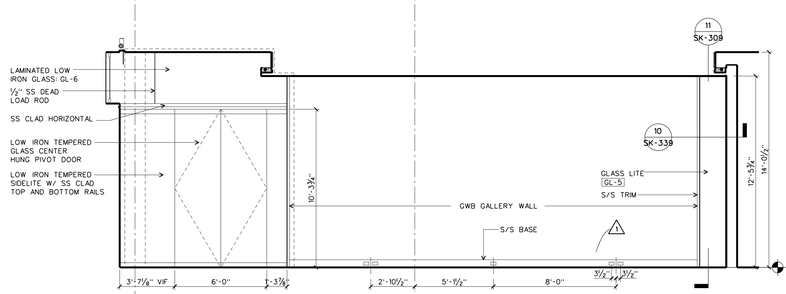


4-03 NARA TEMPORARY EXHIB. GALLERY: SOUTH ELEVATION

base/elev/b-inel31.dgn 31

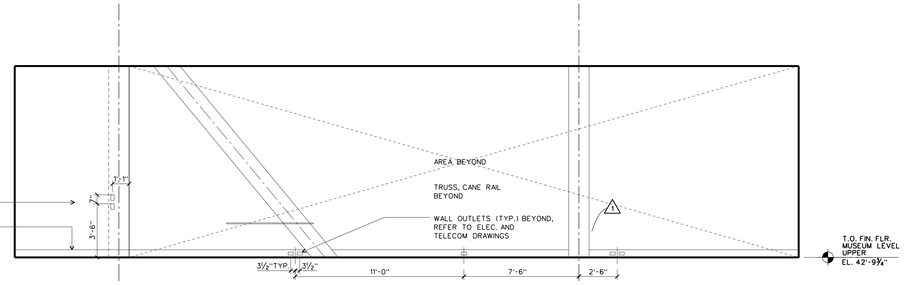


4-03 NARA TEMPORARY EXHIB. GALLERY: EAST ELEVATION

base/elev/b-inel31.dgn 30

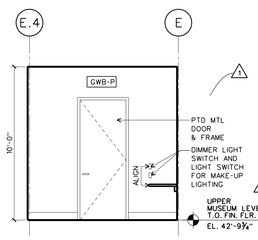


4-12A VESTIBULE :
NORTH ELEV.

base/elev/b-inel30.dgn 27

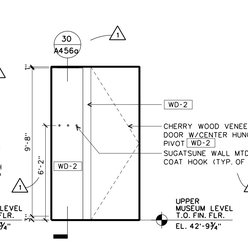


4-12A VESTIBULE :
WEST ELEV.

base/elev/b-inel30.dgn 26

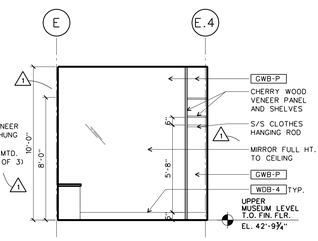


4-12A VESTIBULE :
SOUTH ELEV.

base/elev/b-inel30.dgn 25

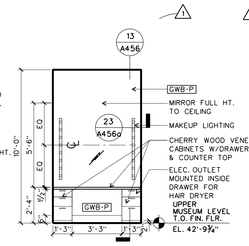


4-12A VESTIBULE :
EAST ELEV.

base/elev/b-inel30.dgn 24

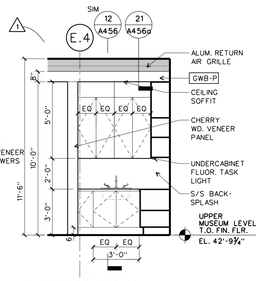


4-12C KITCHEN :
NORTH ELEV.

base/elev/b-inel30.dgn 23

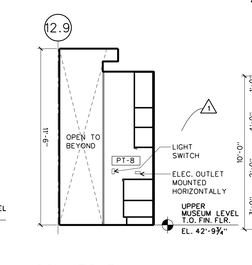


4-12C KITCHEN :
WEST ELEV.

base/elev/b-inel30.dgn 22

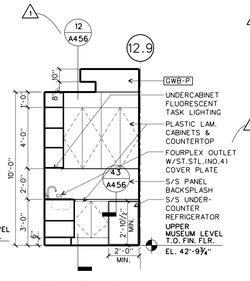

4-12C KITCHEN :
EAST ELEV.

base/elev/b-inel30.dgn 21

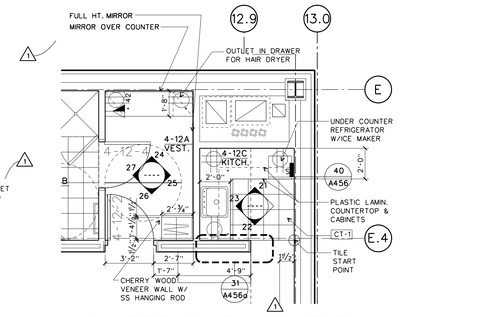


4-12A VESTIBULE AND 4-12C KITCHEN
ENLARGED FLOOR PLAN

base/elev/b-inel30.dgn 20


NOTES:

- COAT HOOK - SUGATSUNE #DSH-01 SATIN FINISH
- CABINET DOOR PULLS - #DS30/S SATIN FINISH
- KITCHEN SINK - ELKAY DLR-1919-10
- KITCHEN FAUCET - ELKAY LK-4101
- REFRIGERATOR - SUB-ZERO 249FI

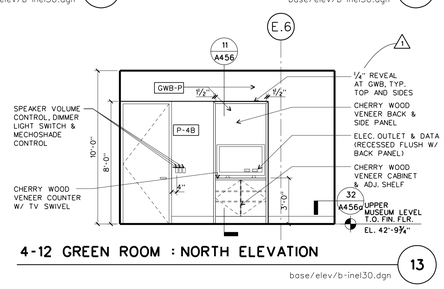


4-12 GREEN ROOM : NORTH ELEVATION

base/elev/b-inel30.dgn 13

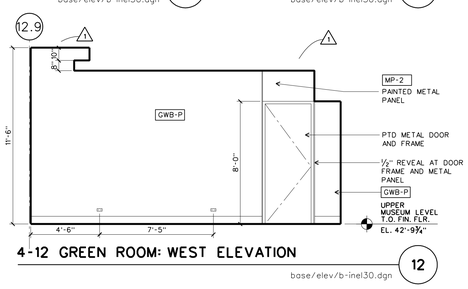


4-12 GREEN ROOM: WEST ELEVATION

base/elev/b-inel30.dgn 12

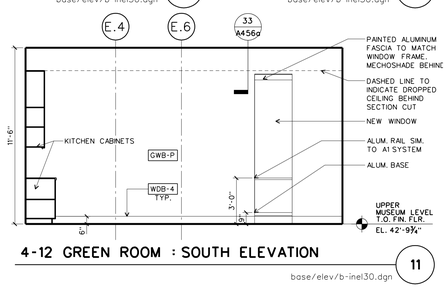

4-12 GREEN ROOM : SOUTH ELEVATION

base/elev/b-inel30.dgn 11

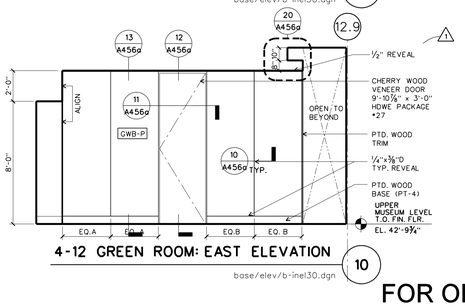

4-12 GREEN ROOM: EAST ELEVATION

base/elev/b-inel30.dgn 10

WILLIAM J. CLINTON PRESIDENTIAL CENTER

LITTLE ROCK, ARKANSAS

Architect

POLSHEK PARTNERSHIP LLP
320 West 13th Street
New York, New York 10014
212.807.7171

Coordinating Architects

POLK STANLEY YEARY ARCHITECTS Ltd
700 South Schiller Street
Little Rock, Arkansas 72201
501.378.0878

WITSELL EVANS RASCO
901 West Third Street
Little Rock, Arkansas 72201
501.374.5300

WOODS CARADINE ARCHITECTS
2200 South Main Street
Little Rock, Arkansas 72206
501.374.4060

Landscape Architects

HARGREAVES ASSOCIATES
118 Magazine Street
Cambridge, Massachusettes 02139
617.661.0070

LANDSCAPE ARCHITECTURE, Inc.
2300 Cottondale Lane Suite 202
Little Rock, Arkansas 72202
501.374.5610

Structural Engineer

LESLIE E. ROBERTSON ASSOC., RLLP
30 Broad Street, 47th Floor
New York, New York 10004
212.750.9000

MEP Engineers

FLACK + KURTZ Inc.
475 Fifth Avenue
New York, New York 10017
212.532.9600

CROMWELL ARCHITECTS ENGINEERS
101 South Spring Street
Little Rock, Arkansas 72201
501.372.2900

Curtainwall Consultant

R. A. HEINTGES ARCHITECTS
126 Fifth Avenue, 9th Floor
New York, New York 10011
212.652-2966

Seal

Issue	Date
1 ASI #24	10/24/03
ASI #23	09/12/03

Job No. 9908

Scale 1/4" = 1'-0"

Date September 27, 2002

Title


MUSEUM BUILDING INTERIOR ELEVATIONS:

Sheet No. SDA-132

A414a


FOR OFFICIAL USE ONLY

EXECUTIVE LEVEL INTERIOR FINISHES N.I.C., TYP.

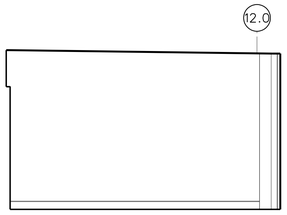


5-10 BEDROOM: PARTIAL EAST ELEVATION 63

base/elev/b-inel28.dgn

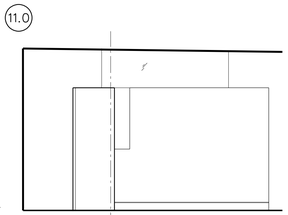


5-10 BEDROOM: PARTIAL EAST ELEVATION 62

base/elev/b-inel26.dgn

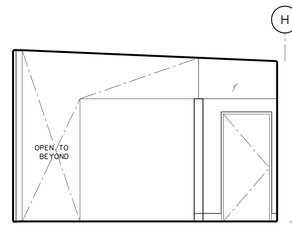


5-10 BEDROOM: NORTH ELEVATION 61

base/elev/b-inel26.dgn

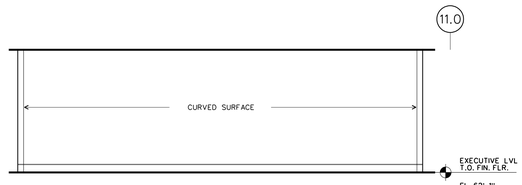


5-12 LIBRARY: PARTIAL EAST ELEVATION 60

base/elev/b-inel23.dgn

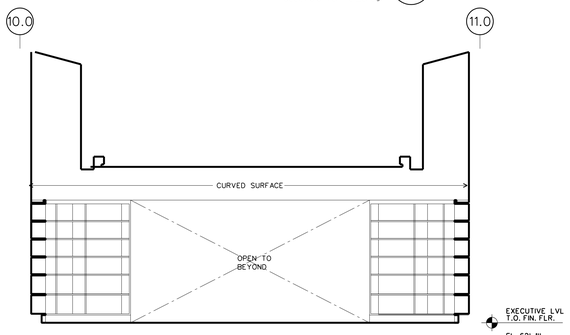


5-12 LIBRARY: PARTIAL EAST ELEVATION 52

base/elev/b-inel22.dgn

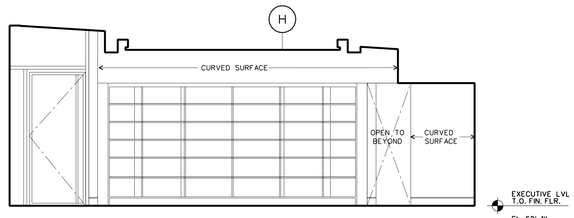


5-12 LIBRARY: NORTH ELEVATION 51

base/elev/b-inel22.dgn

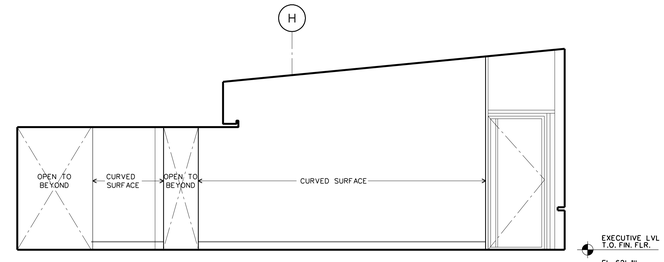


5-13 DINING ROOM: SOUTH ELEVATION 50

base/elev/b-inel22.dgn

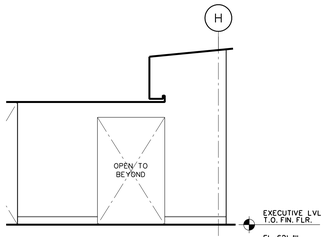


5-13 DINING ROOM : PARTIAL SOUTH ELEVATION 43

base/elev/b-inel20.dgn

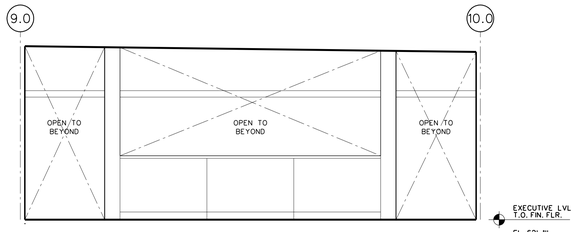


5-13 DINING ROOM : EAST ELEVATION 42

base/elev/b-inel20.dgn

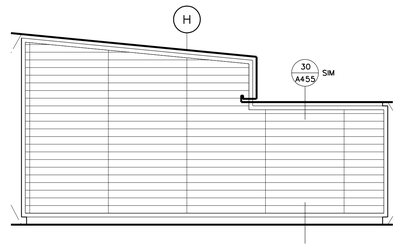


5-13 DINING ROOM : NORTH ELEVATION 41

base/elev/b-inel20.dgn

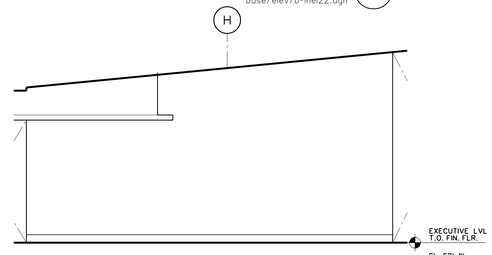


5-14 LIVING ROOM : SOUTH ELEVATION 40

base/elev/b-inel19.dgn

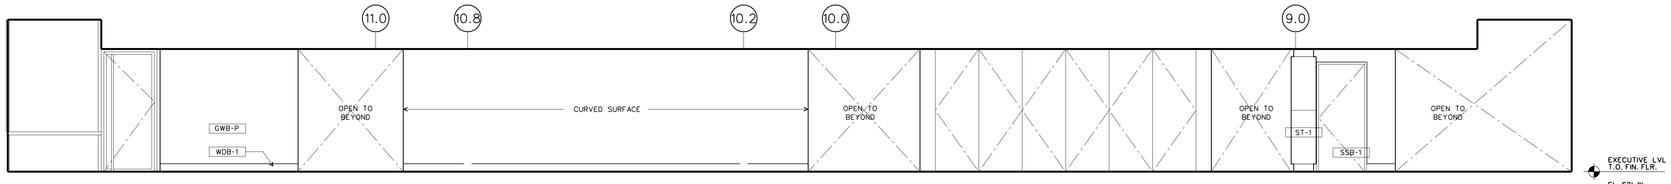


5-10 GALLERY : WEST ELEVATION 30

base/elev/b-inel19.dgn

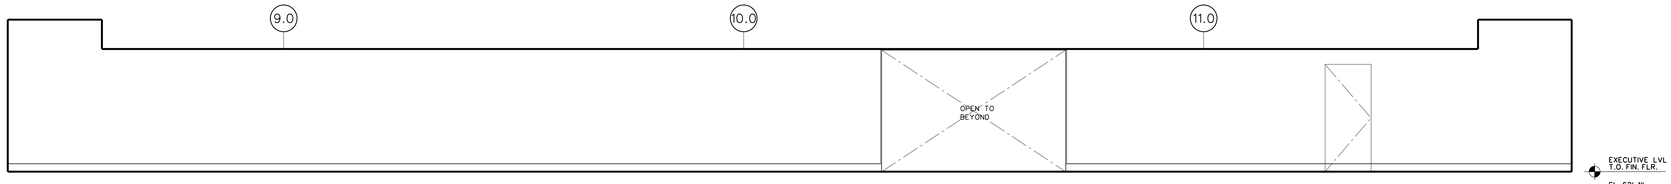


5-10 GALLERY : EAST ELEVATION 20

base/elev/b-inel19.dgn

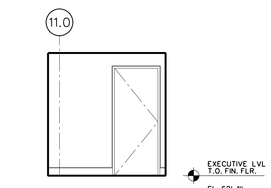


VESTIBULE : WEST ELEVATION 15

base/elev/b-inel25.dgn

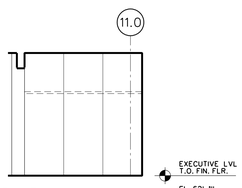


VESTIBULE : EAST ELEVATION 14

base/elev/b-inel25.dgn

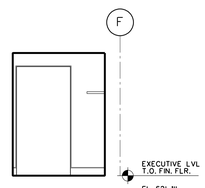


VESTIBULE : NORTH ELEVATION 13

base/elev/b-inel25.dgn

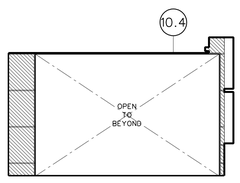


5-08 FOYER : WEST ELEVATION 12

base/elev/b-inel18.dgn

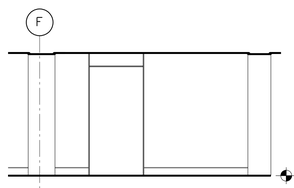

5-08 FOYER : SOUTH ELEVATION 11

base/elev/b-inel18.dgn

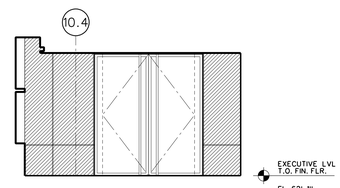

5-08 FOYER : EAST ELEVATION 10

base/elev/b-inel18.dgn

FOR OFFICIAL USE ONLY

WILLIAM J. CLINTON PRESIDENTIAL CENTER

LITTLE ROCK, ARKANSAS

Architect

POLSHEK PARTNERSHIP LLP
320 West 13th Street
New York, New York 10014
212.807.7171

Coordinating Architects

POLK STANLEY YEARY ARCHITECTS Ltd
700 South Schiller Street
Little Rock, Arkansas 72201
501.378.0878

WITSELL EVANS RASCO
901 West Third Street
Little Rock, Arkansas 72201
501.374.5300

WOODS CARADINE ARCHITECTS
2200 South Main Street
Little Rock, Arkansas 72206
501.374.4060

Landscape Architects

HARGREAVES ASSOCIATES
118 Magazine Street
Cambridge, Massachusettes 02139
617.661.0070

LANDSCAPE ARCHITECTURE, Inc.
2300 Cottondale Lane Suite 202
Little Rock, Arkansas 72202
501.374.5610

Structural Engineer

LESLIE E. ROBERTSON ASSOC., RLLP
30 Broad Street, 47th Floor
New York, New York 10004
212.750.9000

MEP Engineers

FLACK + KURTZ Inc.
475 Fifth Avenue
New York, New York 10017
212.532.9600


CROMWELL ARCHITECTS ENGINEERS
101 South Spring Street
Little Rock, Arkansas 72201
501.372.2900

Curtainwall Consultant

R. A. HEINTGES ARCHITECTS
126 Fifth Avenue, 9th Floor
New York, New York 10011
212.652-2966

Seal

Issue	Date
100% Construction Documents	09/27/02
90% Progress Printing	08/30/02
100% Struct./ CD Progress	07/01/02
100% Steel & Concrete CD & Architectural CD Progress	05/15/02
100% Design Development	03/01/02

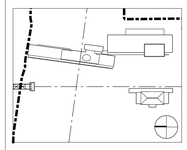

Job No. 9908

Scale 1/4" = 1'-0"

Date September 27, 2002

Title

MUSEUM BUILDING INTERIOR ELEVATIONS:

Sheet No.

A415

EXECUTIVE LEVEL INTERIOR FINISHES N.I.C., TYP.

5-08 FOYER : EAST ELEVATION

base/elev/b-inel18.dgn

10

WILLIAM J. CLINTON PRESIDENTIAL CENTER

LITTLE ROCK, ARKANSAS

Architect

POLSHEK PARTNERSHIP LLP
320 West 13th Street
New York, New York 10014
212.807.7171

Coordinating Architects

POLK STANLEY YEARY ARCHITECTS Ltd
700 South Schiller Street
Little Rock, Arkansas 72201
501.378.0878

WITSELL EVANS RASCO
901 West Third Street
Little Rock, Arkansas 72201
501.374.5300

WOODS CARADINE ARCHITECTS
2200 South Main Street
Little Rock, Arkansas 72206
501.374.4060

Landscape Architects

HARGREAVES ASSOCIATES
118 Magazine Street
Cambridge, Massachusettes 02139
617.661.0070

LANDSCAPE ARCHITECTURE, Inc.
2300 Cottondale Lane Suite 202
Little Rock, Arkansas 72202
501.374.5610

Structural Engineer

LESLIE E. ROBERTSON ASSOC., RLLP
30 Broad Street, 47th Floor
New York, New York 10004
212.750.9000

MEP Engineers

FLACK + KURTZ Inc.
475 Fifth Avenue
New York, New York 10017
212.532.9600


CROMWELL ARCHITECTS ENGINEERS
101 South Spring Street
Little Rock, Arkansas 72201
501.372.2900

Curtainwall Consultant

R. A. HEINTGES ARCHITECTS
126 Fifth Avenue, 9th Floor
New York, New York 10011
212.652-2966

Seal

Issue	Date
100% Construction Documents	09/27/02
90% Progress Printing	08/30/02
100% Struct./ CD Progress	07/01/02
100% Steel & Concrete CD	05/15/02
& Architectural CD Progress	
100% Design Development	03/01/02

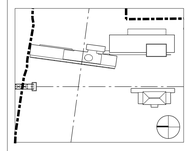

Job No.
9908

Scale
1/4" = 1'-0"

Date
September 27, 2002


Title

MUSEUM BUILDING INTERIOR ELEVATIONS:

Sheet No.

A415

FOR OFFICIAL USE ONLY

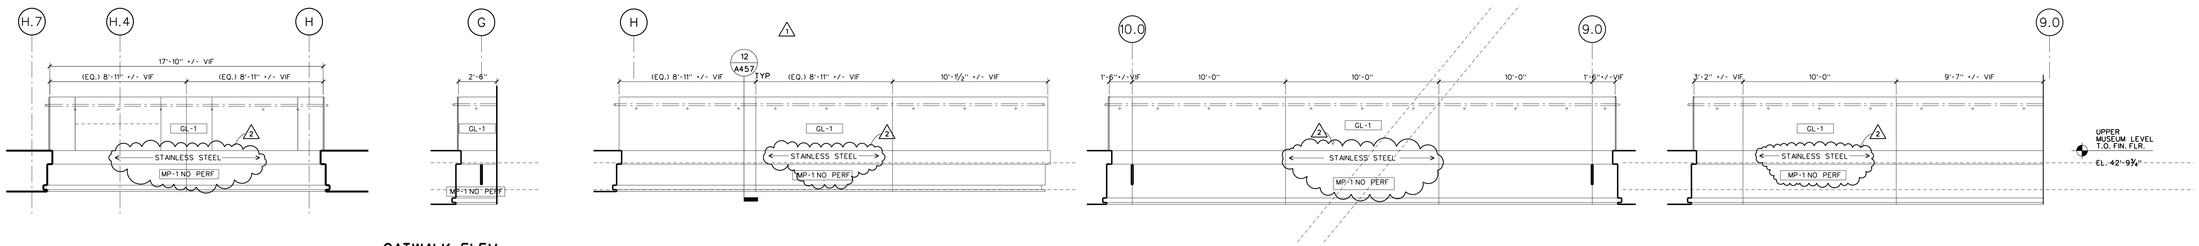


CATWALK ELEVATION - NORTH 1 — 64
SCALE: 1/4" = 1'-0" — b-inel-rail01.dgn

CATWALK ELEV.
NORTH 2 — 63
SCALE: 1/4" = 1'-0" — b-inel-rail02

CATWALK ELEVATION - SOUTH 1 — 62
SCALE: 1/4" = 1'-0" — b-inel-rail02.dgn

CATWALK ELEVATION - WEST 3 — 61
SCALE: 1/4" = 1'-0" — b-inel-rail03.dgn


CATWALK ELEVATION - WEST 2 — 60
SCALE: 1/4" = 1'-0" — b-inel-rail02.dgn

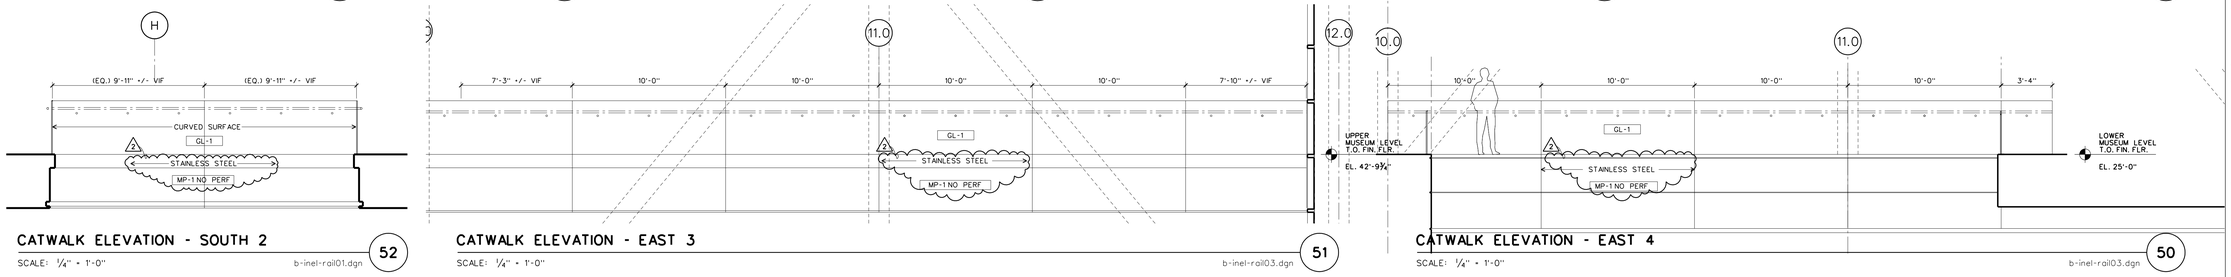


CATWALK ELEVATION - SOUTH 2 — 52
SCALE: 1/4" = 1'-0" — b-inel-rail01.dgn

CATWALK ELEVATION - EAST 3 — 51
SCALE: 1/4" = 1'-0" — b-inel-rail03.dgn


CATWALK ELEVATION - EAST 4 — 50
SCALE: 1/4" = 1'-0" — b-inel-rail03.dgn

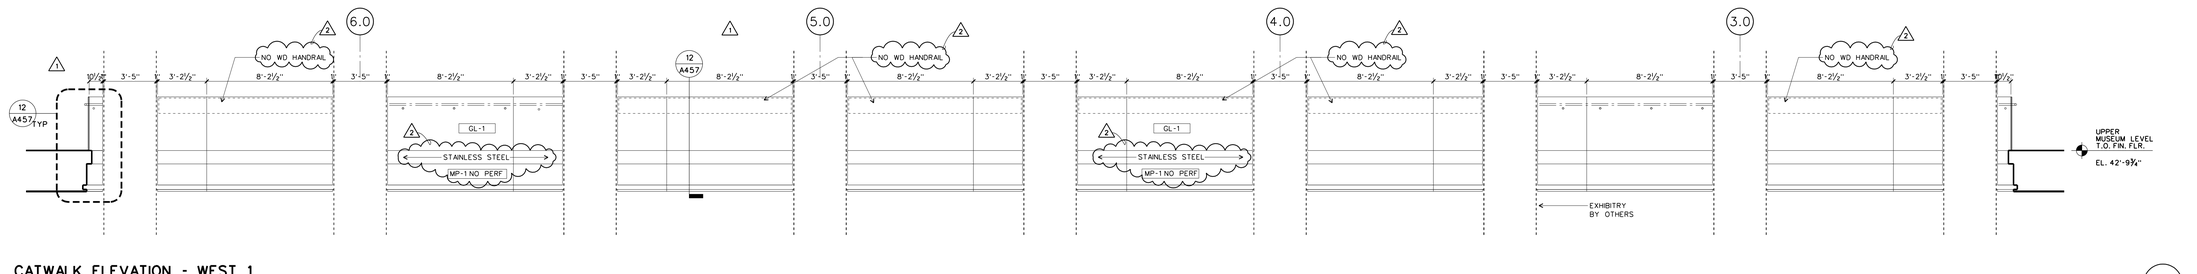

CATWALK ELEVATION - WEST 1 — 40
SCALE: 1/4" = 1'-0" — b-inel-rail01.dgn

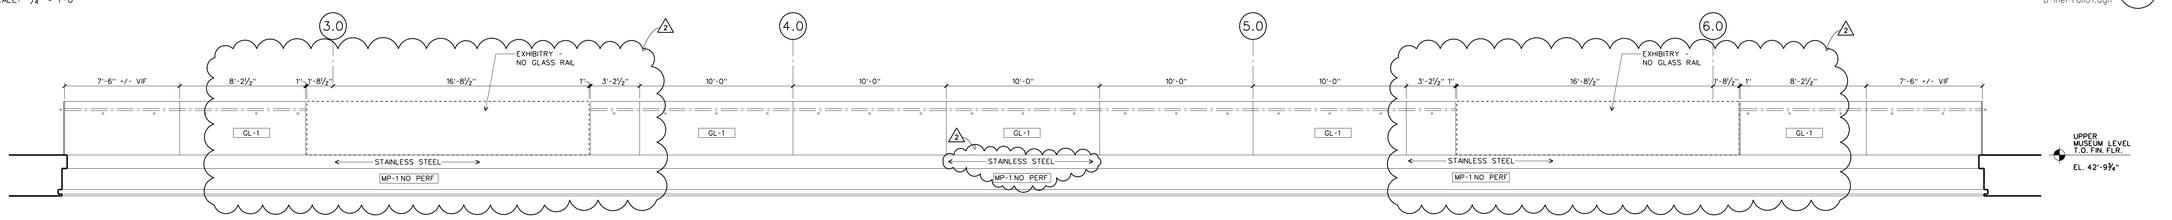


CATWALK ELEVATION - EAST 1 — 30
SCALE: 1/4" = 1'-0" — b-inel-rail01.dgn

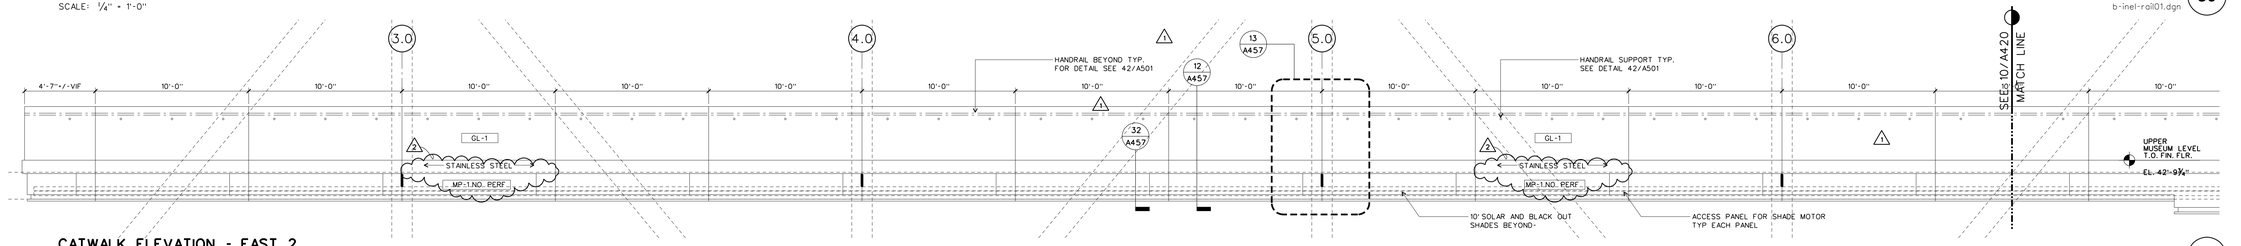

CATWALK ELEVATION - EAST 2
SCALE: 1/4" = 1'-0"

CATWALK ELEVATION - EAST 2 — 20
SCALE: 1/4" = 1'-0" — b-inel-rail02.dgn

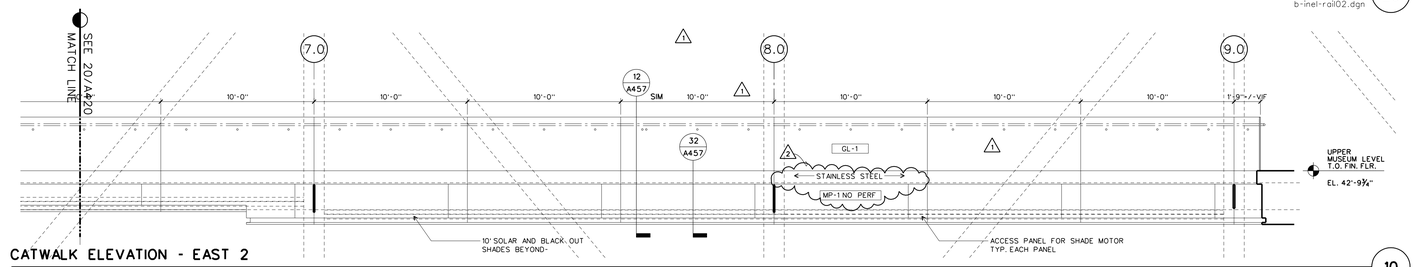

CATWALK ELEVATION - EAST 2 — 10
SCALE: 1/4" = 1'-0" — b-inel-rail02.dgn

WILLIAM J. CLINTON PRESIDENTIAL CENTER

LITTLE ROCK, ARKANSAS

Architect

POLSHEK PARTNERSHIP LLP
320 West 13th Street
New York, New York 10014
212.807.7171

Coordinating Architects

POLK STANLEY YEARY ARCHITECTS Ltd
700 South Schiller Street
Little Rock, Arkansas 72201
501.378.0878

WITSELL EVANS RASCO
901 West Third Street
Little Rock, Arkansas 72201
501.374.5300

WOODS CARADINE ARCHITECTS
2200 South Main Street
Little Rock, Arkansas 72206
501.374.4060

Landscape Architects

HARGREAVES ASSOCIATES
118 Magazine Street
Cambridge, Massachusettes 02139
617.661.0070

LANDSCAPE ARCHITECTURE, Inc.
2300 Cottondale Lane Suite 202
Little Rock, Arkansas 72202
501.374.5610

Structural Engineer

LESLIE E. ROBERTSON ASSOC., RLLP
30 Broad Street, 47th Floor
New York, New York 10004
212.750.9000

MEP Engineers

FLACK + KURTZ Inc.
475 Fifth Avenue
New York, New York 10017
212.532.9600


CROMWELL ARCHITECTS ENGINEERS
101 South Spring Street
Little Rock, Arkansas 72201
501.372.2900

Curtainwall Consultant

R. A. HEINTGES ARCHITECTS
126 Fifth Avenue, 9th Floor
New York, New York 10011
212.652-2966

Seal

Issue	Date
2 ASI #20	06/06/03
1 Addendum #2	11/15/02
100% Construction Documents	09/27/02
90% Progress Printing	08/30/02
100% Struct./ CD Progress	07/01/02
100% Steel & Concrete CD	05/15/02
& Architectural CD Progress	
100% Design Development	03/01/02

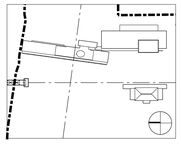

Job No. 9908

Scale 1/4" = 1'-0"

Date September 27, 2002

Title

MUSEUM BUILDING INTERIOR ELEVATIONS: GLASS RAILINGS

Sheet No.

A420

FOR OFFICIAL USE ONLY

T.O. GROUND LEVEL FINISH FLOOR EL. 0'-0"


ARCHIVE OFFICE LOBBY LOOKING SOUTH

SCALE: 1/4" = 1'-0" I-ELEV01ARC.DGN 41

T.O. GROUND LEVEL FINISH FLOOR EL. 0'-0"


ARCHIVE OFFICE LOBBY LOOKING SOUTH

SCALE: 1/4" = 1'-0" I-ELEV01ARC.DGN 40

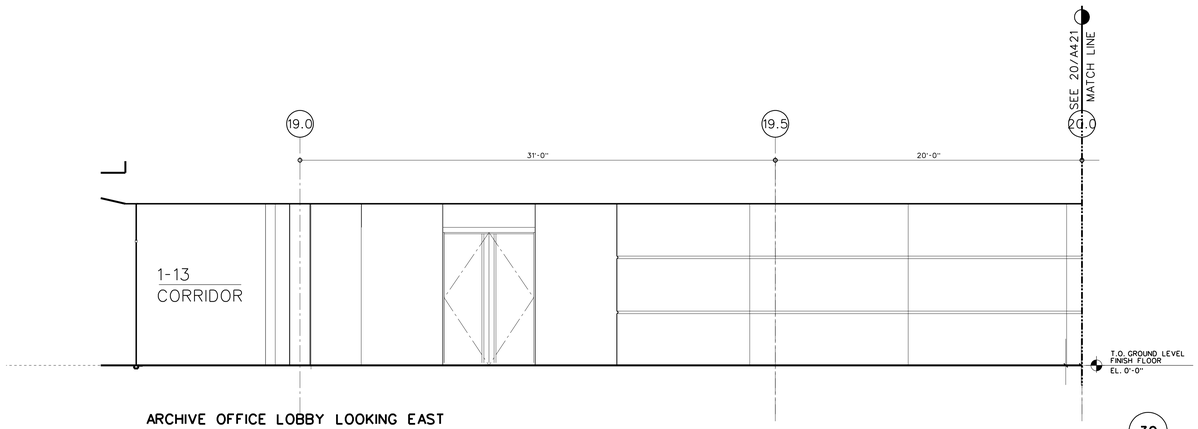


ARCHIVE OFFICE LOBBY LOOKING EAST

SCALE: 1/4" = 1'-0" I-ELEV01ARC.DGN 30

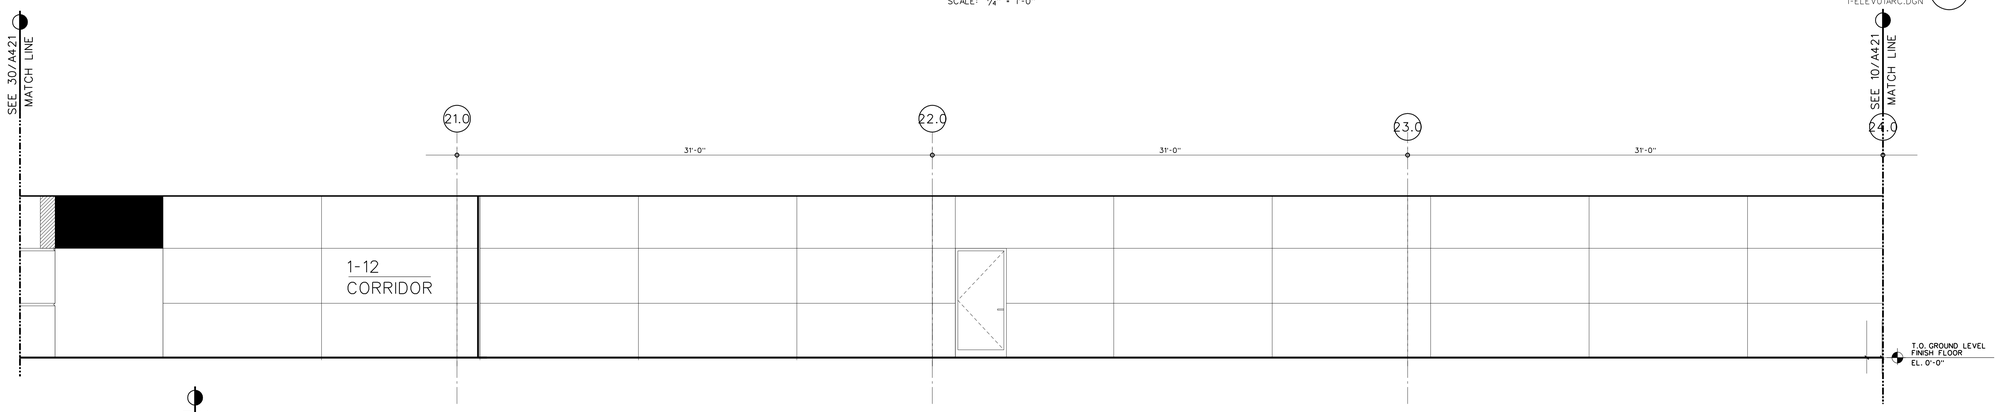

ARCHIVE OFFICE CORRIDOR LOOKING EAST

SCALE: 1/4" = 1'-0" ARCELEVS.DGN 20

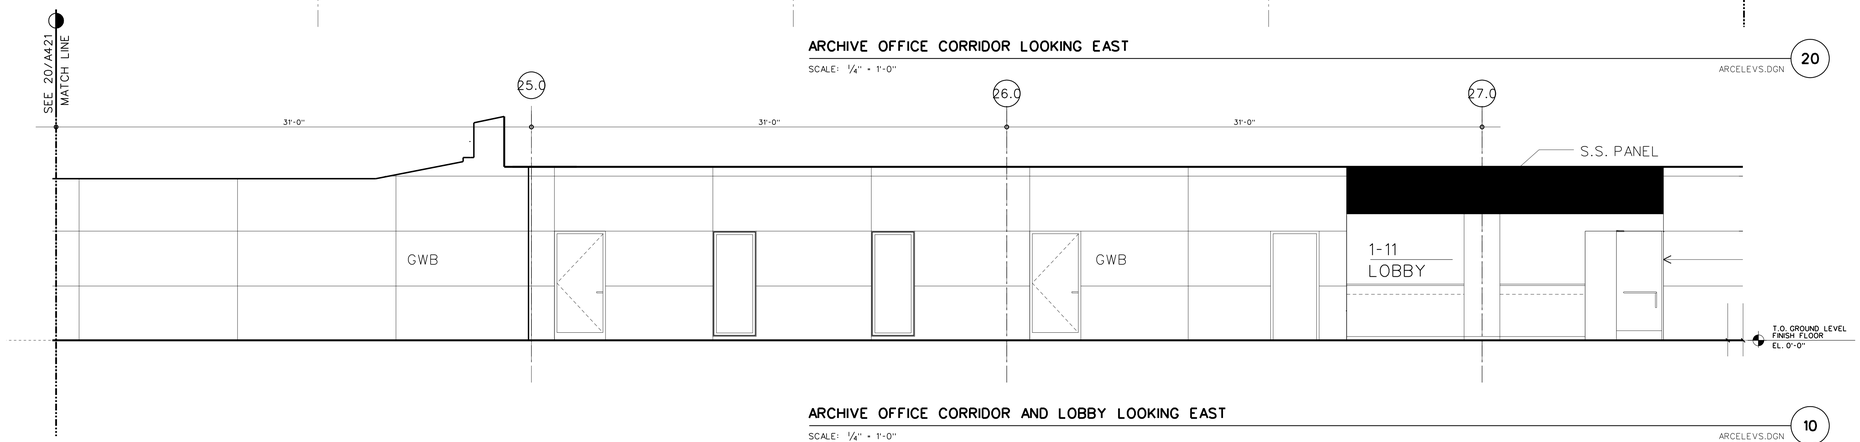

ARCHIVE OFFICE CORRIDOR AND LOBBY LOOKING EAST

SCALE: 1/4" = 1'-0" ARCELEVS.DGN 10

WILLIAM J. CLINTON PRESIDENTIAL CENTER

LITTLE ROCK, ARKANSAS

Architect

POLSHEK PARTNERSHIP LLP
320 West 13th Street
New York, New York 10014
212.807.7171

Coordinating Architects

POLK STANLEY YEARY ARCHITECTS Ltd
700 South Schiller Street
Little Rock, Arkansas 72201
501.378.0878

WITSELL EVANS RASCO
901 West Third Street
Little Rock, Arkansas 72201
501.374.5300

WOODS CARADINE ARCHITECTS
2200 South Main Street
Little Rock, Arkansas 72206
501.374.4060

Landscape Architects

HARGREAVES ASSOCIATES
118 Magazine Street
Cambridge, Massachusettes 02139
617.661.0070

LANDSCAPE ARCHITECTURE, Inc.
2300 Cottondale Lane Suite 202
Little Rock, Arkansas 72202
501.374.5610

Structural Engineer

LESLIE E. ROBERTSON ASSOC., RLLP
30 Broad Street, 47th Floor
New York, New York 10004
212.750.9000

MEP Engineers

FLACK + KURTZ Inc.
475 Fifth Avenue
New York, New York 10017
212.532.9600


CROMWELL ARCHITECTS ENGINEERS
101 South Spring Street
Little Rock, Arkansas 72201
501.372.2900

Curtainwall Consultant

R. A. HEINTGES ARCHITECTS
126 Fifth Avenue, 9th Floor
New York, New York 10011
212.652-2966

Seal

Issue	Date
100% Construction Documents	09/27/02
90% Progress Printing	08/30/02
ASI #05	08/20/02
100% Struct./ CD Progress	07/01/02
Bridge Bldg. Substructure	06/14/02
100% Steel & Concrete CD & Architectural CD Progress	05/15/02
100% Design Development	03/01/02

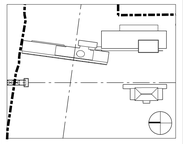

Job No. 9908

Scale 1/4"=1'-0"

Date September 27, 2002


Title

INTERIOR ELEVATIONS: ARCHIVE GROUND LEVEL

Sheet No.

A432

FOR OFFICIAL USE ONLY

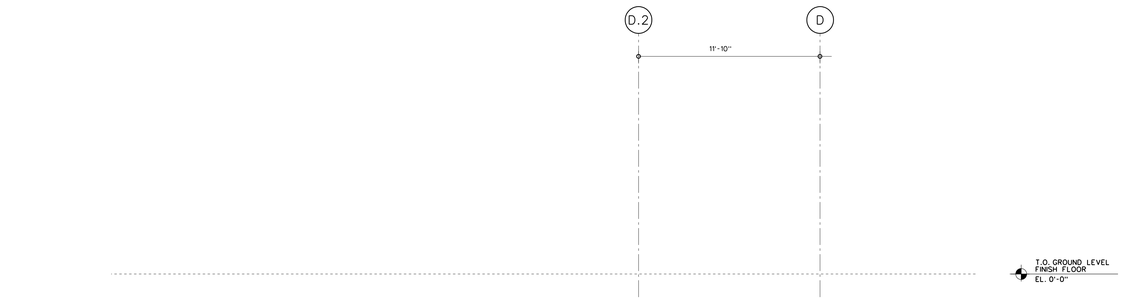

ARCHIVE OFFICE LOBBY LOOKING NORTH

SCALE: 1/4" = 1'-0"


I-ELEV 01ARC.DGN 40



ARCHIVE OFFICE CORRIDOR LOOKING WEST

SCALE: 1/4" = 1'-0"


ARCELEVS.DGN 30

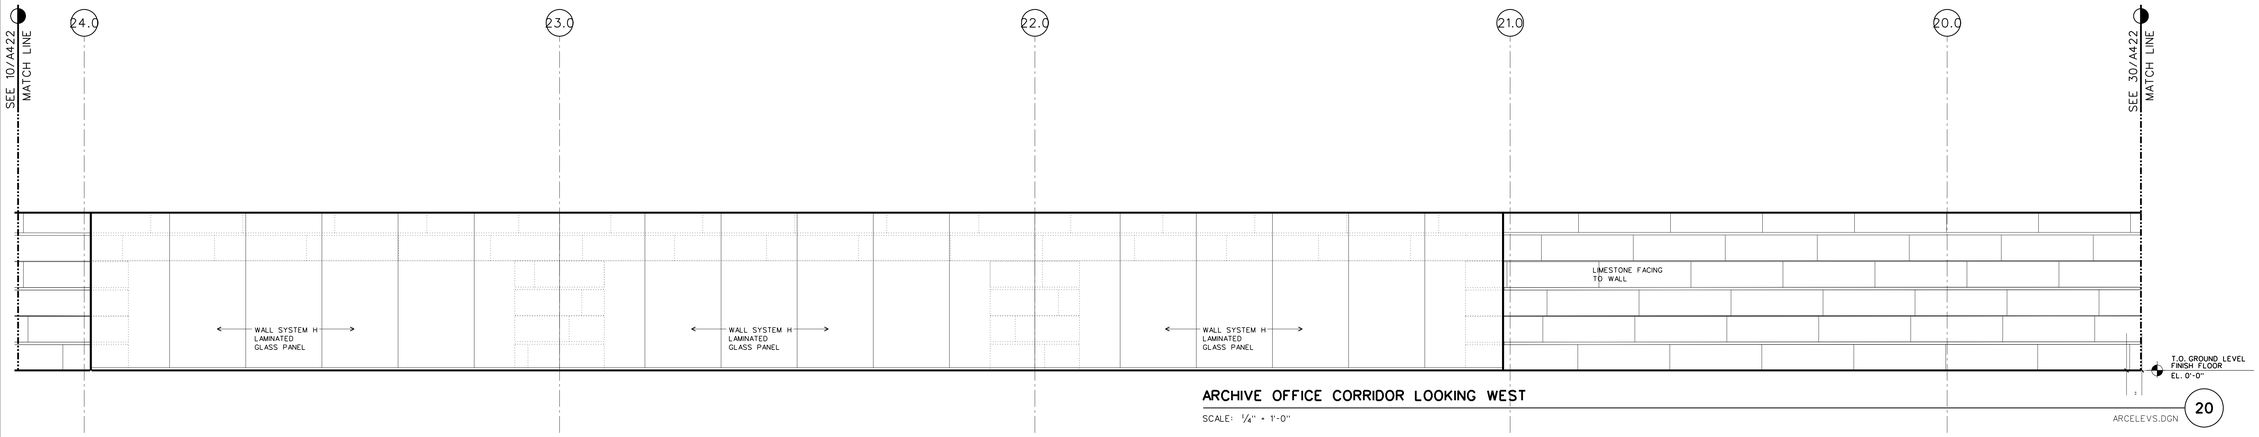

ARCHIVE OFFICE CORRIDOR LOOKING WEST

SCALE: 1/4" = 1'-0"

ARCELEVS.DGN 20

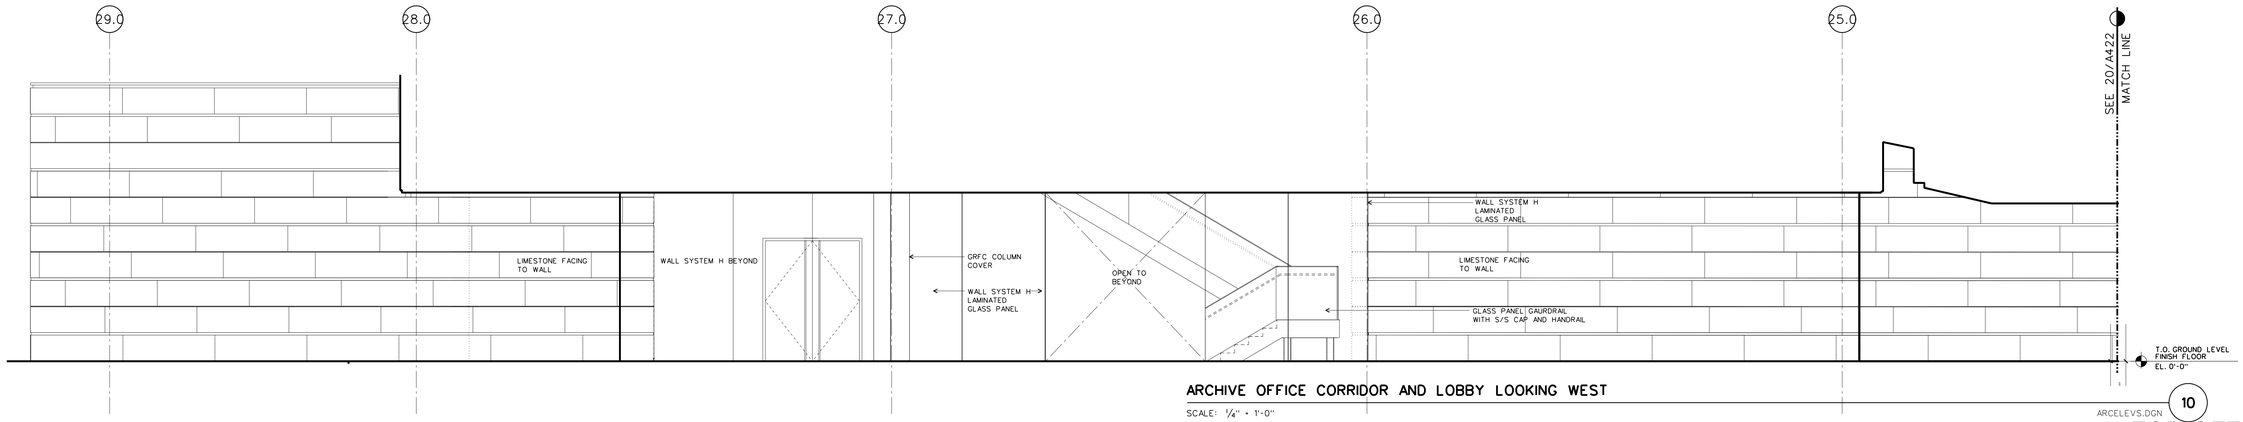

ARCHIVE OFFICE CORRIDOR AND LOBBY LOOKING WEST

SCALE: 1/4" = 1'-0"

ARCELEVS.DGN 10

WILLIAM J. CLINTON PRESIDENTIAL CENTER

LITTLE ROCK, ARKANSAS

Architect

POLSHEK PARTNERSHIP LLP
320 West 13th Street
New York, New York 10014
212.807.7171

Coordinating Architects

POLK STANLEY YEARY ARCHITECTS Ltd
700 South Schiller Street
Little Rock, Arkansas 72201
501.378.0878

WITSELL EVANS RASCO
901 West Third Street
Little Rock, Arkansas 72201
501.374.5300

WOODS CARADINE ARCHITECTS
2200 South Main Street
Little Rock, Arkansas 72206
501.374.4060

Landscape Architects

HARGREAVES ASSOCIATES
118 Magazine Street
Cambridge, Massachusettes 02139
617.661.0070

LANDSCAPE ARCHITECTURE, Inc.
2300 Cottondale Lane Suite 202
Little Rock, Arkansas 72202
501.374.5610

Structural Engineer

LESLIE E. ROBERTSON ASSOC., RLLP
30 Broad Street, 47th Floor
New York, New York 10004
212.750.9000

MEP Engineers

FLACK + KURTZ Inc.
475 Fifth Avenue
New York, New York 10017
212.532.9600


CROMWELL ARCHITECTS ENGINEERS
101 South Spring Street
Little Rock, Arkansas 72201
501.372.2900

Curtainwall Consultant

R. A. HEINTGES ARCHITECTS
126 Fifth Avenue, 9th Floor
New York, New York 10011
212.652-2966

Seal

Issue	Date
100% Construction Documents	09/27/02
90% Progress Printing	08/30/02
ASI #05	08/20/02
100% Struct./ CD Progress	07/01/02
Bridge Bldg. Substructure	06/14/02
100% Steel & Concrete CD	05/15/02
& Architectural CD Progress	
100% Design Development	03/01/02

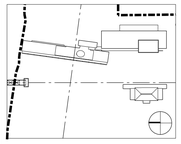

Job No. 9908

Scale 1/4"=1'-0"

Date September 27, 2002

Title

INTERIOR ELEVATIONS: ARCHIVE GROUND LEVEL

Sheet No.

A431

FOR OFFICIAL USE ONLY

ELEVATOR P1 AND P2: ELEVATION CAB LOOKING NORTH

SCALE: ½" = 1'-0" I-ELEVATOR1 25

ELEVATOR P1 AND P2: ELEVATION CAB LOOKING WEST

SCALE: ½" = 1'-0" I-ELEVATOR1 24

ELEVATOR P1 AND P2: ELEVATION CAB LOOKING SOUTH


SCALE: ½" = 1'-0" I-ELEVATOR1 23

ELEVATOR P1 AND P2: ELEVATION CAB LOOKING EAST

SCALE: ½" = 1'-0" I-ELEVATOR1 22


ELEVATOR P1 AND P2: REFLECTED CEILING PLAN

SCALE: ½" = 1'-0" I-ELEVATOR1 21

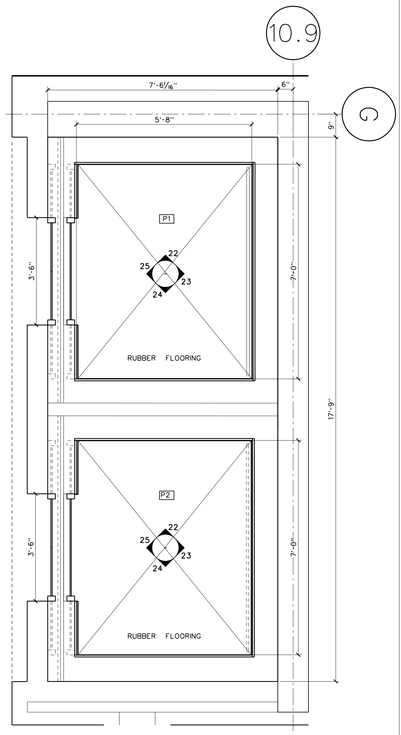


ELEVATOR P1 AND P2: PLAN

SCALE: ½" = 1'-0" I-ELEVATOR1 20

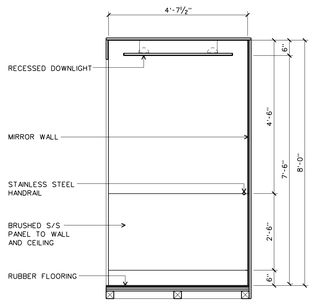


ELEVATOR P7: ELEVATION CAB LOOKING NORTH

SCALE: ½" = 1'-0" I-ELEVATOR1 15

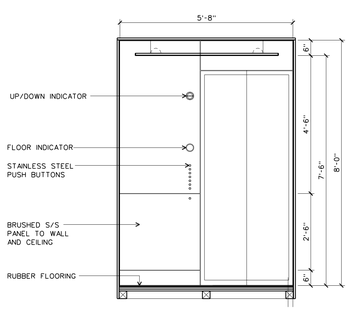


ELEVATOR P7: ELEVATION CAB LOOKING WEST

SCALE: ½" = 1'-0" I-ELEVATOR1 14

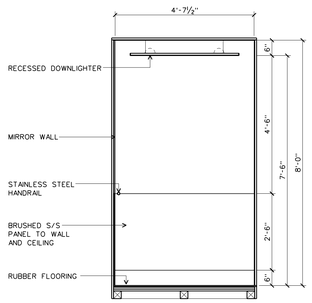


ELEVATOR P7: ELEVATION CAB LOOKING SOUTH

SCALE: ½" = 1'-0" I-ELEVATOR1 13

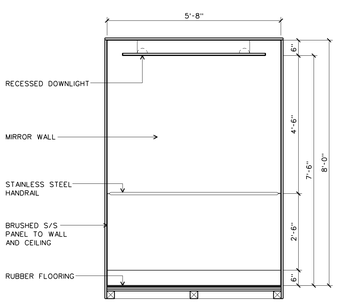


ELEVATOR P7: ELEVATION CAB LOOKING EAST

SCALE: ½" = 1'-0" I-ELEVATOR1 12

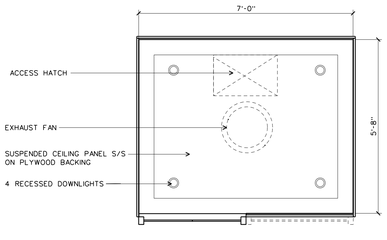

ELEVATOR P7: REFLECTED CEILING PLAN

SCALE: ½" = 1'-0" I-ELEVATOR1 11

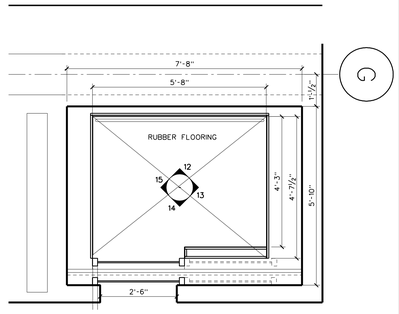

ELEVATOR P7: PLAN

SCALE: ½" = 1'-0" I-ELEVATOR1 10

WILLIAM J. CLINTON PRESIDENTIAL CENTER

LITTLE ROCK, ARKANSAS

Architect

POLSHEK PARTNERSHIP LLP
320 West 13th Street
New York, New York 10014
212.807.7171

Coordinating Architects

POLK STANLEY YEARY ARCHITECTS Ltd
700 South Schiller Street
Little Rock, Arkansas 72201
501.378.0878

WITSELL EVANS RASCO
901 West Third Street
Little Rock, Arkansas 72201
501.374.5300

WOODS CARADINE ARCHITECTS
2200 South Main Street
Little Rock, Arkansas 72206
501.374.4060

Landscape Architects

HARGREAVES ASSOCIATES
118 Magazine Street
Cambridge, Massachusettes 02139
617.661.0070

LANDSCAPE ARCHITECTURE, Inc.
2300 Cottondale Lane Suite 202
Little Rock, Arkansas 72202
501.374.5610

Structural Engineer

LESLIE E. ROBERTSON ASSOC., RLLP
30 Broad Street, 47th Floor
New York, New York 10004
212.750.9000

MEP Engineers

FLACK + KURTZ Inc.
475 Fifth Avenue
New York, New York 10017
212.532.9600


CROMWELL ARCHITECTS ENGINEERS
101 South Spring Street
Little Rock, Arkansas 72201
501.372.2900

Curtainwall Consultant

R. A. HEINTGES ARCHITECTS
126 Fifth Avenue, 9th Floor
New York, New York 10011
212.652-2966

Seal

Issue	Date
100% Construction Documents	09/27/02
90% Progress Printing	08/30/02
ASI #05	08/20/02
100% Struct./ CD Progress	07/01/02
Bridge Bldg. Substructure	06/14/02
100% Steel & Concrete CD	05/15/02
& Architectural CD Progress	
100% Design Development	03/01/02

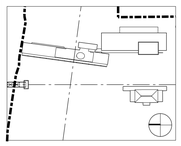

Job No. 9908

Scale 1/2" = 1'-0"


Date September 27, 2002

Title

INTERIOR ELEVATIONS: ELEVATOR P1/P2/P7


Sheet No. A440

FOR OFFICIAL USE ONLY

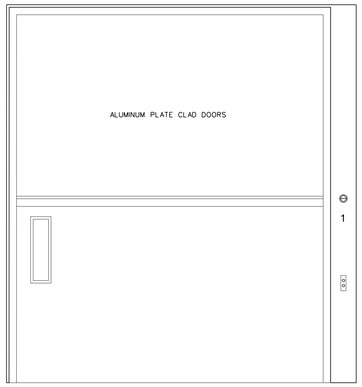


ELEVATOR F3/F5: EXTERIOR CAB DOORS

SCALE: ½" = 1'-0" I-ELEVATOR2 24

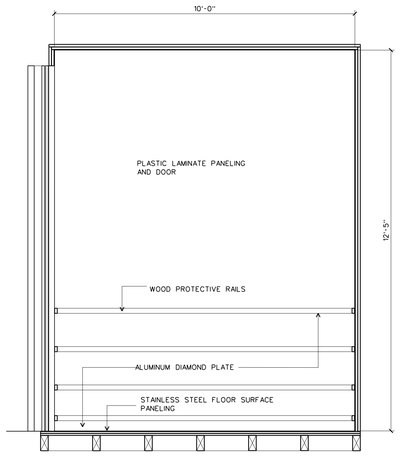


ELEVATOR F3/F5: ELEVATION CAB LOOKING NORTH

SCALE: ½" = 1'-0" I-ELEVATOR2 23

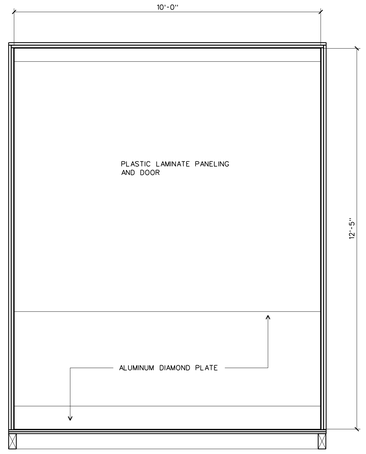


ELEVATOR F3/F5: ELEVATION CAB LOOKING WEST

SCALE: ½" = 1'-0" I-ELEVATOR2 22

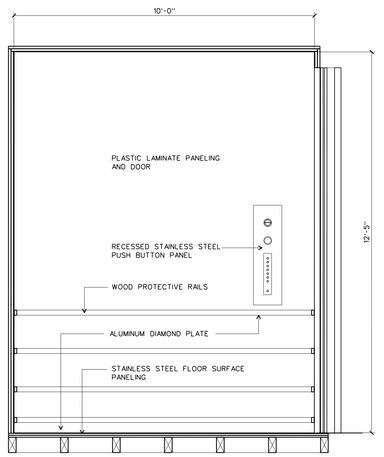


ELEVATOR F3/F5: ELEVATION CAB LOOKING SOUTH

SCALE: ½" = 1'-0" I-ELEVATOR2 21

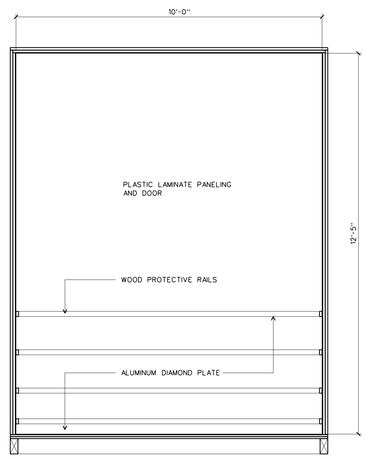


ELEVATOR F3/F5: ELEVATION CAB LOOKING EAST

SCALE: ½" = 1'-0" I-ELEVATOR2 20

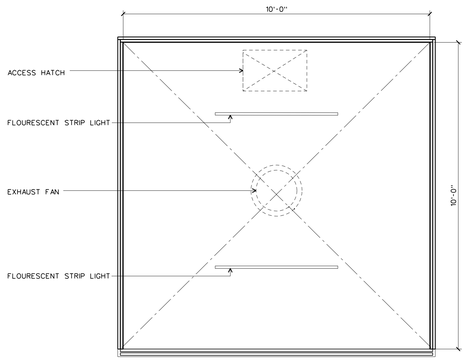

ELEVATOR F3/F5: REFLECTED CEILING PLAN

SCALE: ½" = 1'-0" I-ELEVATOR2 11

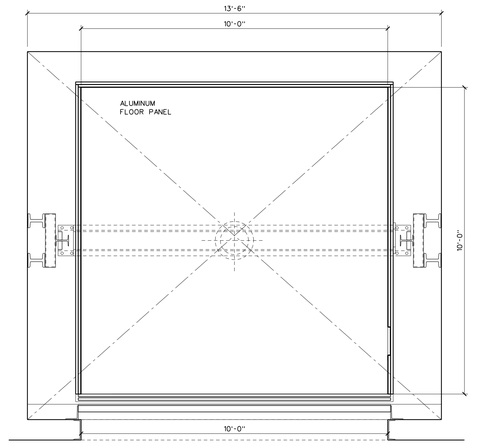

ELEVATOR F3/F5: PLAN

SCALE: ½" = 1'-0" I-ELEVATOR2 10

WILLIAM J. CLINTON PRESIDENTIAL CENTER

LITTLE ROCK, ARKANSAS

Architect

POLSHEK PARTNERSHIP LLP
320 West 13th Street
New York, New York 10014
212.807.7171

Coordinating Architects

POLK STANLEY YEARY ARCHITECTS Ltd
700 South Schiller Street
Little Rock, Arkansas 72201
501.378.0878

WITSELL EVANS RASCO
901 West Third Street
Little Rock, Arkansas 72201
501.374.5300

WOODS CARADINE ARCHITECTS
2200 South Main Street
Little Rock, Arkansas 72206
501.374.4060

Landscape Architects

HARGREAVES ASSOCIATES
118 Magazine Street
Cambridge, Massachusettes 02139
617.661.0070

LANDSCAPE ARCHITECTURE, Inc.
2300 Cottondale Lane Suite 202
Little Rock, Arkansas 72202
501.374.5610

Structural Engineer

LESLIE E. ROBERTSON ASSOC., RLLP
30 Broad Street, 47th Floor
New York, New York 10004
212.750.9000

MEP Engineers

FLACK + KURTZ Inc.
475 Fifth Avenue
New York, New York 10017
212.532.9600


CROMWELL ARCHITECTS ENGINEERS
101 South Spring Street
Little Rock, Arkansas 72201
501.372.2900

Curtainwall Consultant

R. A. HEINTGES ARCHITECTS
126 Fifth Avenue, 9th Floor
New York, New York 10011
212.652-2966

Seal

Issue	Date
100% Construction Documents	09/27/02
90% Progress Printing	08/30/02
ASI #05	08/20/02
100% Struct./ CD Progress	07/01/02
Bridge Bldg. Substructure	06/14/02
100% Steel & Concrete CD	05/15/02
& Architectural CD Progress	
100% Design Development	03/01/02

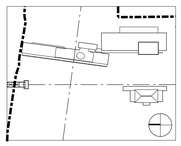

Job No. 9908

Scale AS NOTED

Date September 27, 2002


Title

ELEVATOR F3 AND F5 PLANS ELEVATIONS

Sheet No.


A441

FOR OFFICIAL USE ONLY

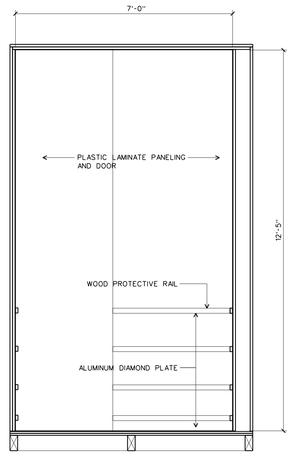


ELEVATOR S4: ELEVATION
CAB LOOKING NORTH

SCALE: ½" = 1'-0" I-ELEV STAIR3 23

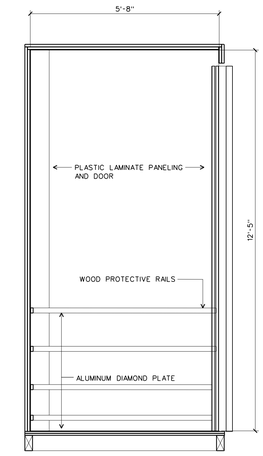


ELEVATOR S4: ELEVATION
CAB LOOKING WEST

SCALE: ½" = 1'-0" I-ELEV STAIR3 22

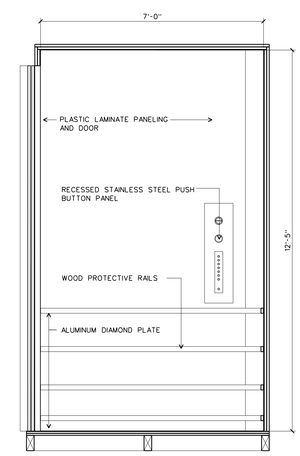


ELEVATOR S4: ELEVATION
CAB LOOKING SOUTH

SCALE: ½" = 1'-0" I-ELEV STAIR3 21

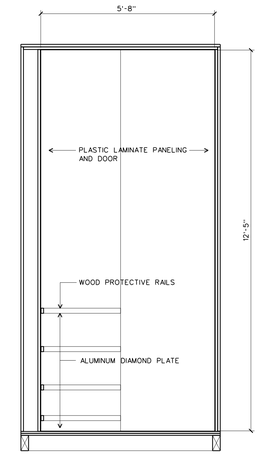


ELEVATOR S4: ELEVATION
CAB LOOKING EAST

SCALE: ½" = 1'-0" I-ELEV STAIR3 20

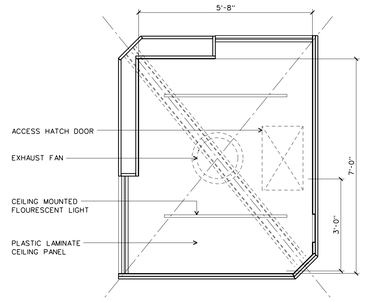

ELEVATOR S4: PLAN

SCALE: ½" = 1'-0" I-ELEV STAIR3 11

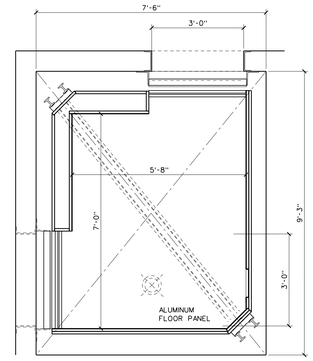

ELEVATOR S4: PLAN

SCALE: ½" = 1'-0" I-ELEV STAIR3 10

WILLIAM J. CLINTON PRESIDENTIAL CENTER

LITTLE ROCK, ARKANSAS

Architect

POLSHEK PARTNERSHIP LLP
320 West 13th Street
New York, New York 10014
212.807.7171

Coordinating Architects

POLK STANLEY YEARY ARCHITECTS Ltd
700 South Schiller Street
Little Rock, Arkansas 72201
501.378.0878

WITSELL EVANS RASCO
901 West Third Street
Little Rock, Arkansas 72201
501.374.5300

WOODS CARADINE ARCHITECTS
2200 South Main Street
Little Rock, Arkansas 72206
501.374.4060

Landscape Architects

HARGREAVES ASSOCIATES
118 Magazine Street
Cambridge, Massachusettes 02139
617.661.0070

LANDSCAPE ARCHITECTURE, Inc.
2300 Cottondale Lane Suite 202
Little Rock, Arkansas 72202
501.374.5610

Structural Engineer

LESLIE E. ROBERTSON ASSOC., RLLP
30 Broad Street, 47th Floor
New York, New York 10004
212.750.9000

MEP Engineers

FLACK + KURTZ Inc.
475 Fifth Avenue
New York, New York 10017
212.532.9600


CROMWELL ARCHITECTS ENGINEERS
101 South Spring Street
Little Rock, Arkansas 72201
501.372.2900

Curtainwall Consultant

R. A. HEINTGES ARCHITECTS
126 Fifth Avenue, 9th Floor
New York, New York 10011
212.652-2966

Seal

Issue	Date
100% Construction Documents	09/27/02
90% Progress Printing	08/30/02
ASI #05	08/20/02
100% Struct./ CD Progress	07/01/02
Bridge Bldg. Substructure	06/14/02
100% Steel & Concrete CD	05/15/02
& Architectural CD Progress	
100% Design Development	03/01/02

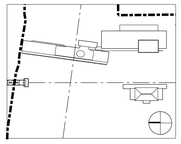

Job No. 9908

Scale AS NOTED

Date September 27, 2002


Title

ELEVATOR P6 & S4
PLANS
ELEVATIONS

Sheet No.


A442

FOR OFFICIAL USE ONLY

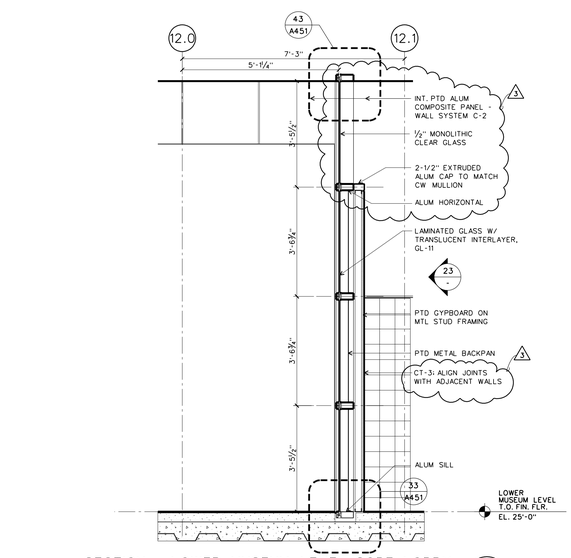


SECTION - LOWER MUSEUM LEVEL CORE LOBBY 33

SCALE: ½" = 1'-0" detail-interior glazing

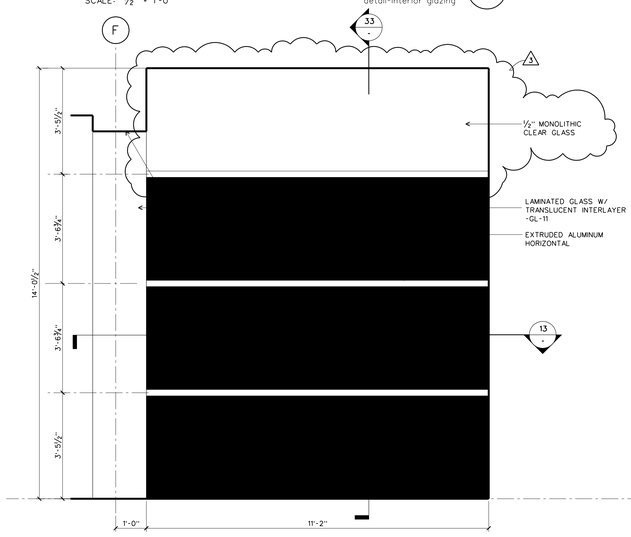


ELEVATION- LOWER MUSEUM LEVEL CORE LOBBY 23

SCALE: ½" = 1'-0" detail-interior glazing

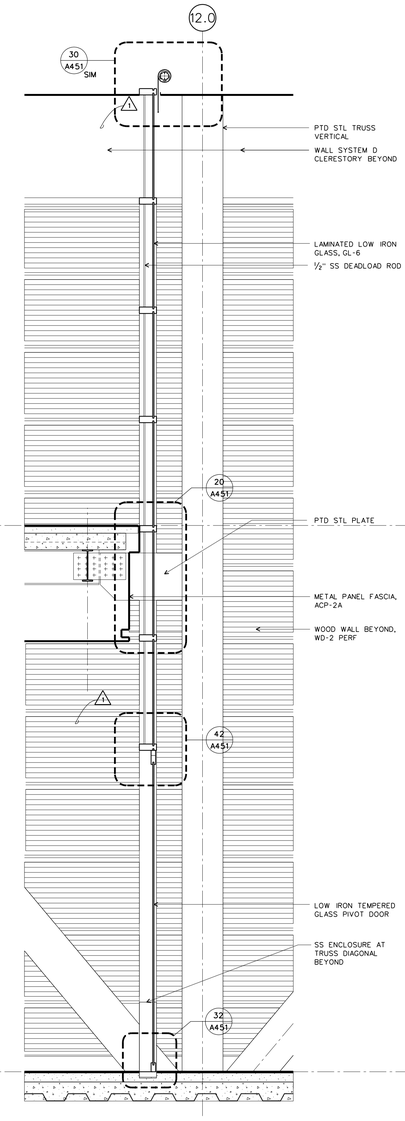


SECTION INTERIOR GLAZING GREAT HALL 22

SCALE: ½" = 1'-0" detail-interior glazing

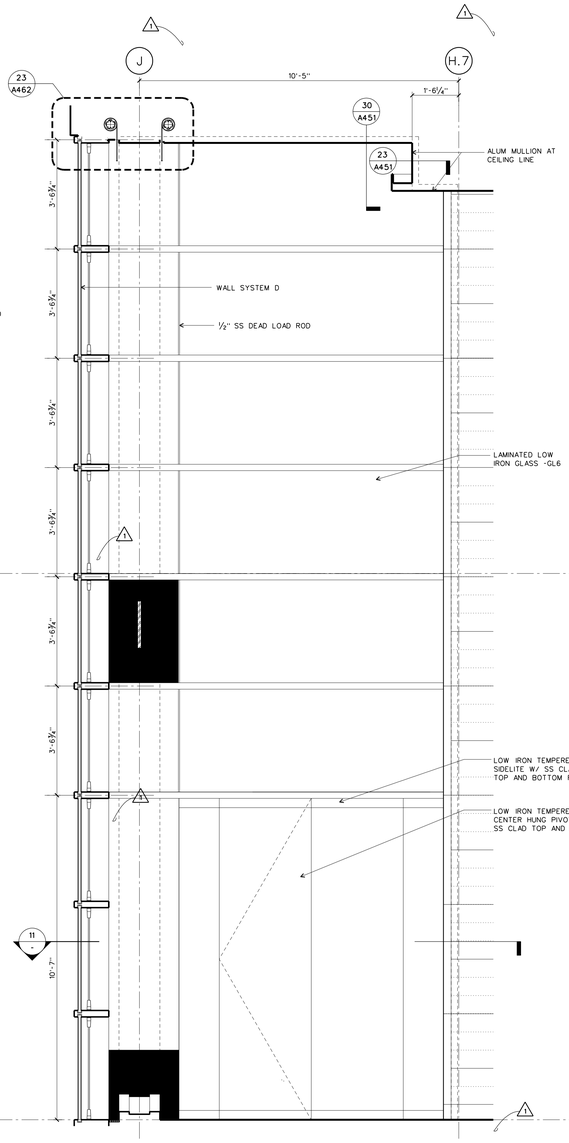


GREAT HALL GLASS WALL ELEVATION - WEST 21

SCALE: ½" = 1'-0" detail-interior glazing

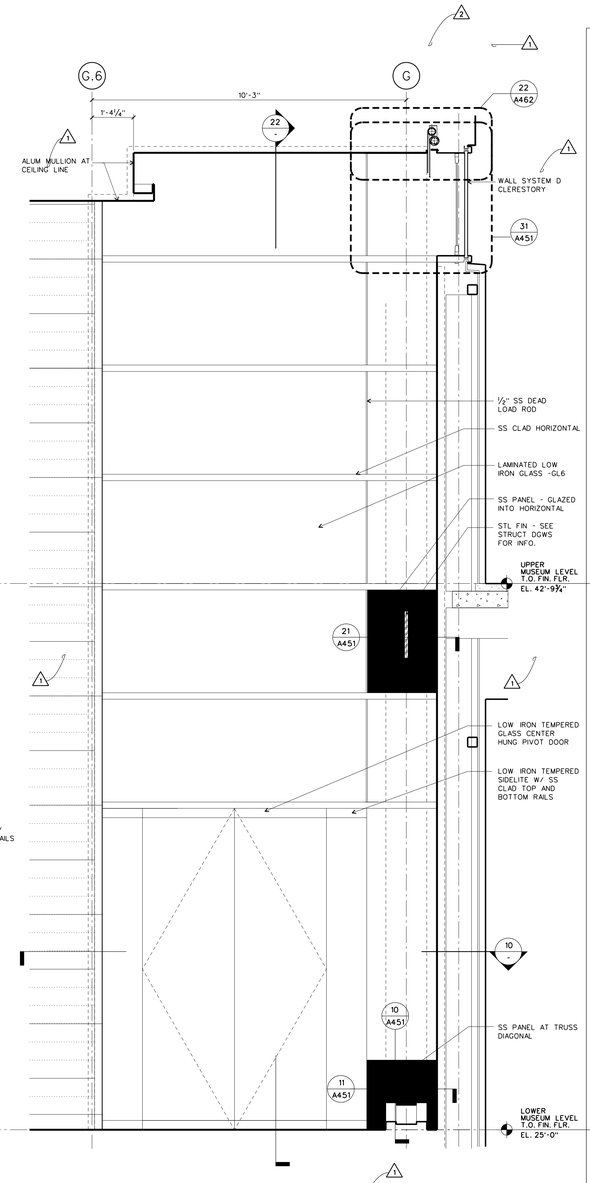


GREAT HALL GLASS WALL ELEVATION - EAST 20

SCALE: ½" = 1'-0" detail-interior glazing

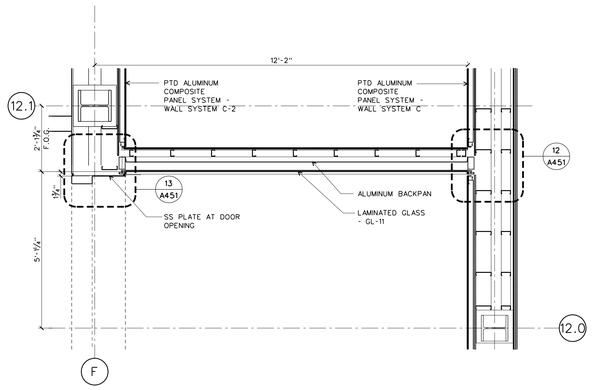


PLAN DTL - LOWER MUSEUM LEVEL CORE LOBBY 13

SCALE: ½" = 1'-0" detail-interior glazing

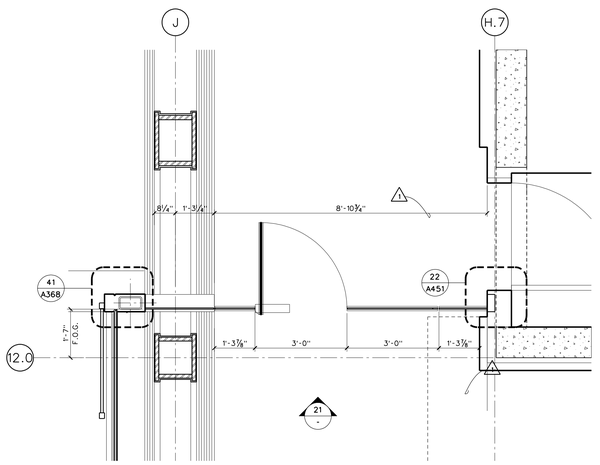

GREAT HALL GLASS WALL - WEST 11

SCALE: ½" = 1'-0" detail-interior glazing

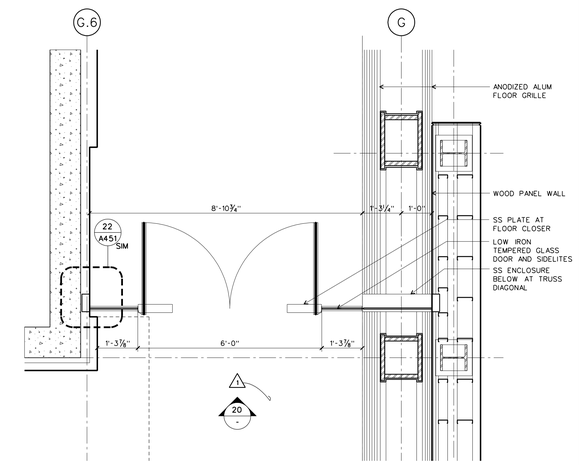

GREAT HALL GLASS WALL - EAST 10

SCALE: ½" = 1'-0" detail-interior glazing

WILLIAM J. CLINTON PRESIDENTIAL CENTER

LITTLE ROCK, ARKANSAS

Architect

POLSHEK PARTNERSHIP LLP
320 West 13th Street
New York, New York 10014
212.807.7171

Coordinating Architects

POLK STANLEY YEARY ARCHITECTS Ltd
700 South Schiller Street
Little Rock, Arkansas 72201
501.378.0878

WITSELL EVANS RASCO
901 West Third Street
Little Rock, Arkansas 72201
501.374.5300

WOODS CARADINE ARCHITECTS
2200 South Main Street
Little Rock, Arkansas 72206
501.374.4060

Landscape Architects

HARGREAVES ASSOCIATES
118 Magazine Street
Cambridge, Massachusettes 02139
617.661.0070

LANDSCAPE ARCHITECTURE, Inc.
2300 Cottondale Lane Suite 202
Little Rock, Arkansas 72202
501.374.5610

Structural Engineer

LESLIE E. ROBERTSON ASSOC., RLLP
30 Broad Street, 47th Floor
New York, New York 10004
212.750.9000

MEP Engineers

FLACK + KURTZ Inc.
475 Fifth Avenue
New York, New York 10017
212.532.9600

CROMWELL ARCHITECTS ENGINEERS
101 South Spring Street
Little Rock, Arkansas 72201
501.372.2900


Curtainwall Consultant

R. A. HEINTGES ARCHITECTS
126 Fifth Avenue, 9th Floor
New York, New York 10011
212.652-2966

Seal

Issue	Date
3 ASI #26	01/16/04
2 ASI #20	06/06/03
1 Addendum #2	11/15/02
100% Construction Documents	09/27/02
90% Progress Printing	08/30/02
100% Struct./ CD Progress*	07/01/02

*New. Former A450 details on A520 dwgs

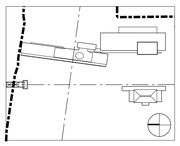

Job No. 9908

Scale 1/2" = 1'-0"


Date September 27, 2002

Title

MUSEUM INTERIOR DETAILS: INTERIOR STOREFRONT SYSTEM


Sheet No. A450

FOR OFFICIAL USE ONLY

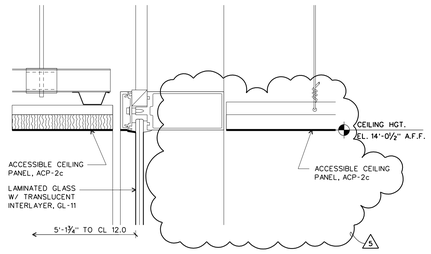


SECTION AT ELEVATOR LOBBY GLAZING

SCALE: 3" = 1'-0" d-interior-glazing-01 **43**

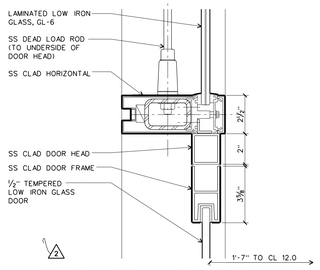


SECTION DETAIL AT GREAT HALL DOOR HEAD

SCALE: 3" = 1'-0" d-interior-glazing-01 **42**

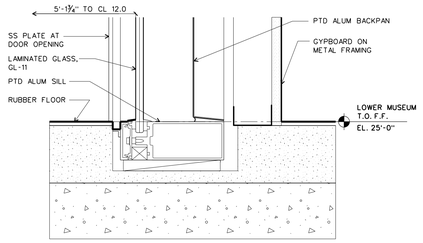

SECTION DETAIL AT ELEVATOR LOBBY SILL

SCALE: 3" = 1'-0" d-interior-glazing-01 **33**

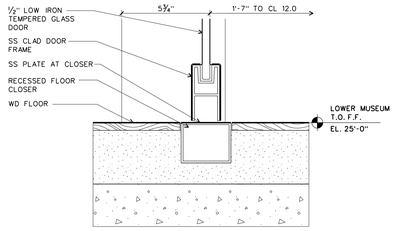


SECTION DETAIL AT GREAT HALL DOOR SILL

SCALE: 3" = 1'-0" d-interior-glazing-01 **32**


PLAN DETAIL AT GREAT HALL LIGHT COVE

SCALE: 3" = 1'-0" d-interior-glazing-01 **23**

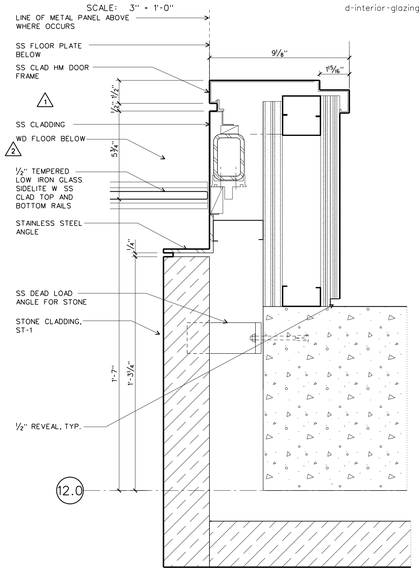


PLAN DETAIL AT GREAT HALLL GLAZING

SCALE: 3" = 1'-0" d-interior-glazing-01 **22**

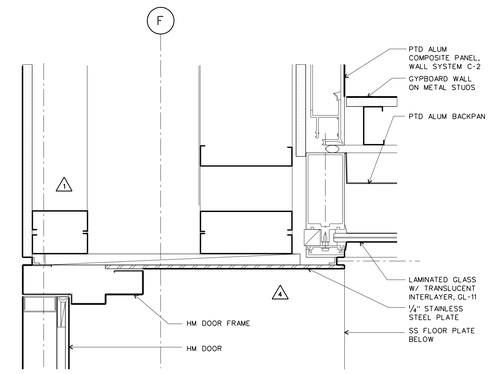


PLAN DETAIL AT ELEVATOR LOBBY GLAZING

SCALE: 3" = 1'-0" d-interior-glazing-01 **13**

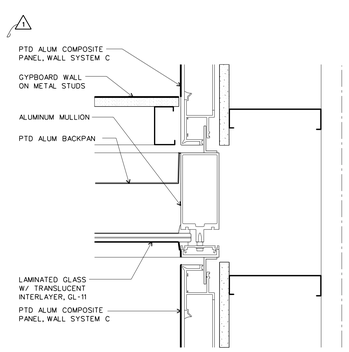


PLAN DETAIL AT ELEVATOR LOBBY GLAZING

SCALE: 3" = 1'-0" d-interior-glazing-01 **12**

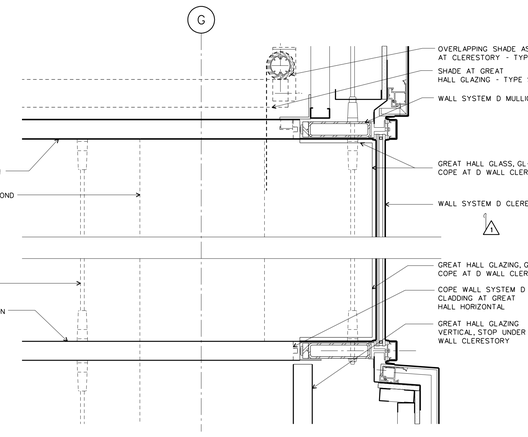


SECTION DETAIL AT GREAT HALL GLAZING AT CLERESTORY

SCALE: 1-1/2" = 1'-0" d-interior-glazing-01 **31**

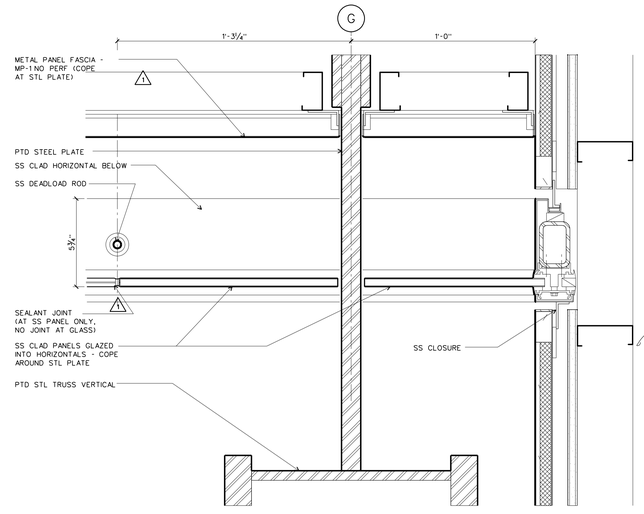


PLAN DETAIL AT STEEL PLATE PENETRATION

SCALE: 3" = 1'-0" d-interior-glazing-01 **21**

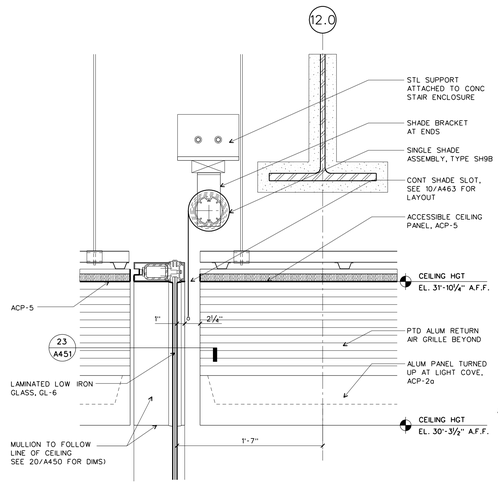


SECTION DETAIL AT CEILING

SCALE: 1-1/2" = 1'-0" d-interior-glazing-01 **30**

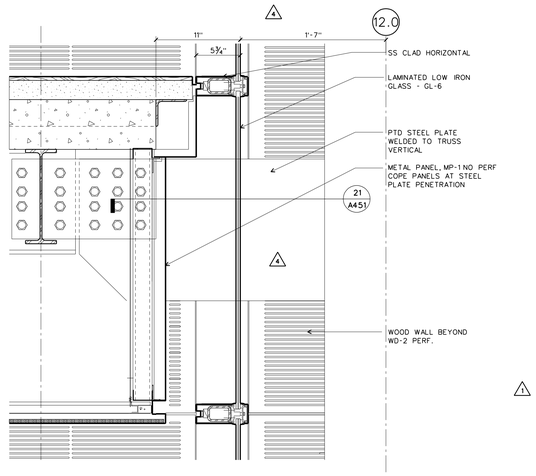


SECTION DETAIL AT UPPER MUSEUM LEVEL

SCALE: 1-1/2" = 1'-0" d-interior-glazing-01 **20**

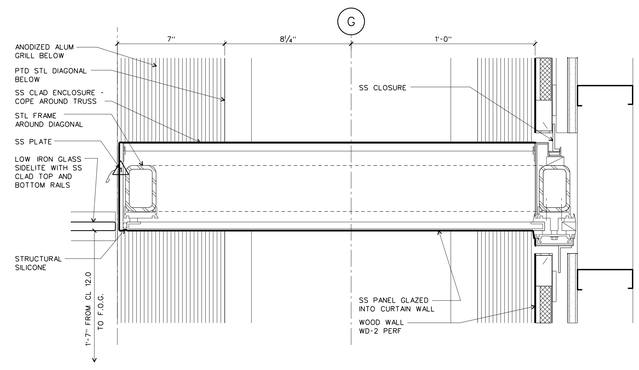

PLAN DETAIL AT TRUSS DIAGONAL ENCLOSURE

SCALE: 3" = 1'-0" d-interior-glazing-01 **11**

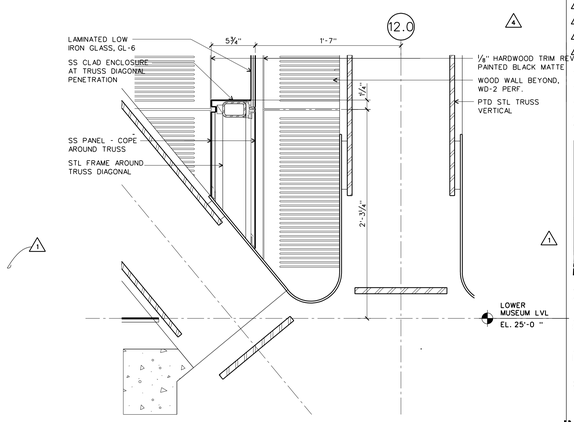

SECTION DETAIL AT TRUSS DIAGONAL

SCALE: 1-1/2" = 1'-0" d-interior-glazing-01 **10**

WILLIAM J. CLINTON PRESIDENTIAL CENTER

LITTLE ROCK, ARKANSAS

Architect

POLSHEK PARTNERSHIP LLP
320 West 13th Street
New York, New York 10014
212.807.7171

Coordinating Architects

POLK STANLEY YEARY ARCHITECTS Ltd
700 South Schiller Street
Little Rock, Arkansas 72201
501.378.0878

WITSELL EVANS RASCO
901 West Third Street
Little Rock, Arkansas 72201
501.374.5300

WOODS CARADINE ARCHITECTS
2200 South Main Street
Little Rock, Arkansas 72206
501.374.4060

Landscape Architects

HARGREAVES ASSOCIATES
118 Magazine Street
Cambridge, Massachusettes 02139
617.661.0070

LANDSCAPE ARCHITECTURE, Inc.
2300 Cottondale Lane Suite 202
Little Rock, Arkansas 72202
501.374.5610

Structural Engineer

LESLIE E. ROBERTSON ASSOC., RLLP
30 Broad Street, 47th Floor
New York, New York 10004
212.750.9000

MEP Engineers

FLACK + KURTZ Inc.
475 Fifth Avenue
New York, New York 10017
212.532.9600

CROMWELL ARCHITECTS ENGINEERS
101 South Spring Street
Little Rock, Arkansas 72201
501.372.2900


Curtainwall Consultant

R. A. HEINTGES ARCHITECTS
126 Fifth Avenue, 9th Floor
New York, New York 10011
212.652-2966

Seal

Issue	Date
5 ASI #26	01/16/04
4 ASI #23	09/12/03
3 ASI #20	08/06/03
2 Addendum #4	11/22/02
1 Addendum #2	11/15/02
100% Construction Documents	09/27/02
90% Progress Printing	08/30/02
100% Struct./ CD Progress	07/01/02

*New. Former A451 details on A523.1

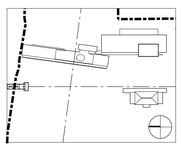

Job No. 9908


Scale 3" = 1'-0"

Date September 27, 2002

Title MUSEUM BUILDING INTERIOR DETAILS: INTERIOR STOREFRONT SYSTEM


Sheet No. **A451**

FOR OFFICIAL USE ONLY

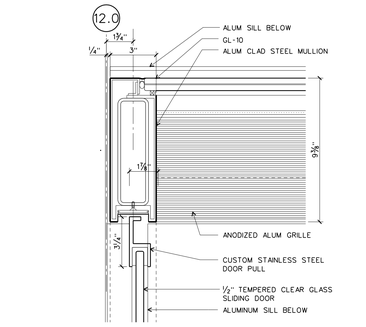


PLAN DETAIL AT SLIDING DOOR JAMB — 43

SCALE: 3 " = 1'-0" d-interiorglazing02

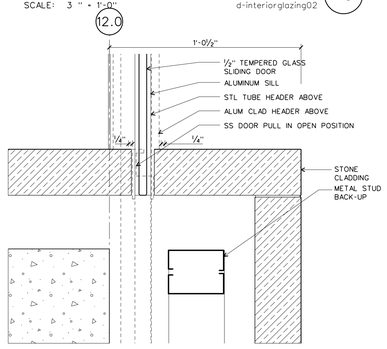


PLAN DETAIL AT SLIDING DOOR JAMB — 33

SCALE: 3 " = 1'-0" d-interiorglazing02

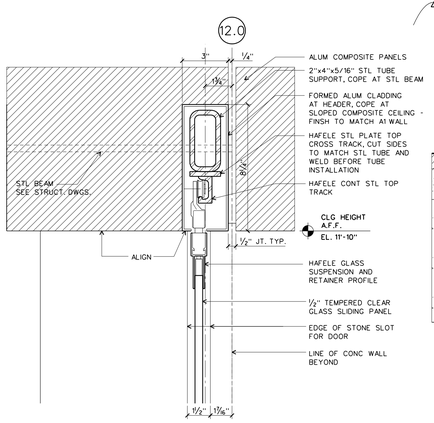


SECTION AT GIFT SHOP DOOR HEAD — 23

SCALE: 3 " = 1'-0" d-interiorglazing02

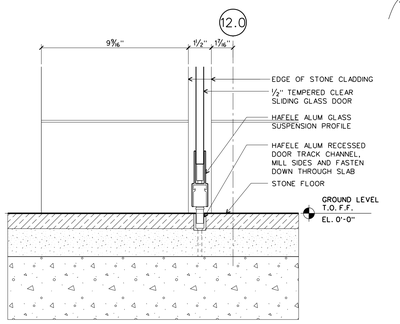


SECTION AT GIFT SHOP DOOR SILL — 13

SCALE: 3 " = 1'-0" d-interiorglazing02

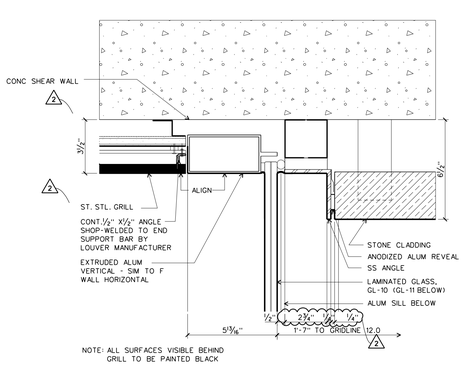


PARTIAL PLAN AT GIFT SHOP — 42

SCALE: 3 " = 1'-0" d-interiorglazing02

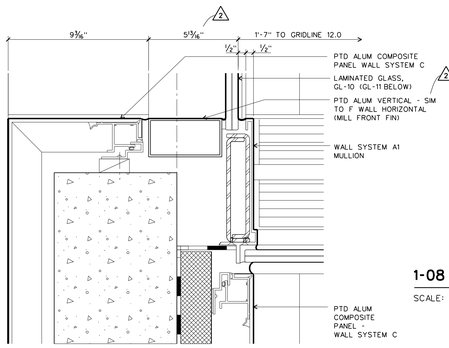


PARTIAL PLAN AT GIFT SHOP — 32

SCALE: 3 " = 1'-0" d-interiorglazing02

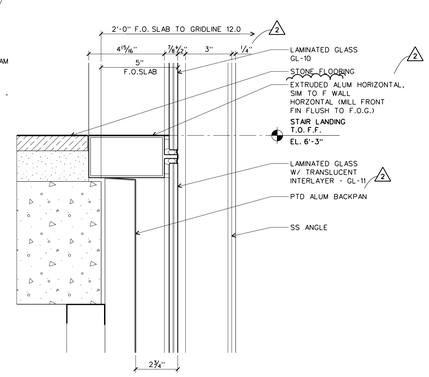


SECTION DETAIL AT ESCALATOR LANDING — 22

SCALE: 3 " = 1'-0" d-interiorglazing02

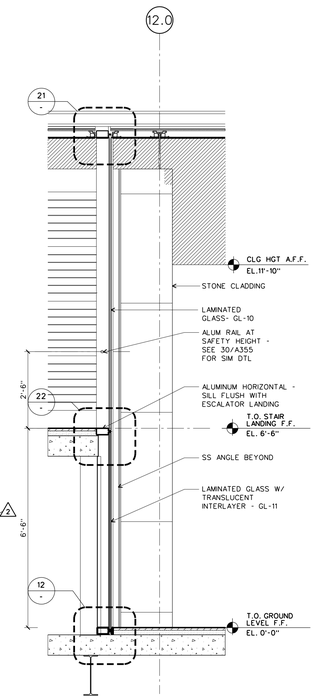


1-08 GIFT SHOP @ ESC LANDING — 31

SCALE: ½" = 1'-0" d-interiorglazing02

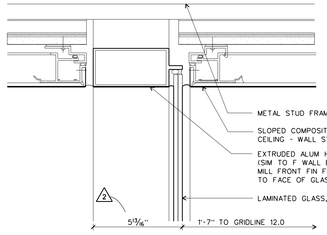


SECTION DETAIL AT GLASS WALL HEAD — 21

SCALE: ½" = 1'-0" d-interiorglazing02

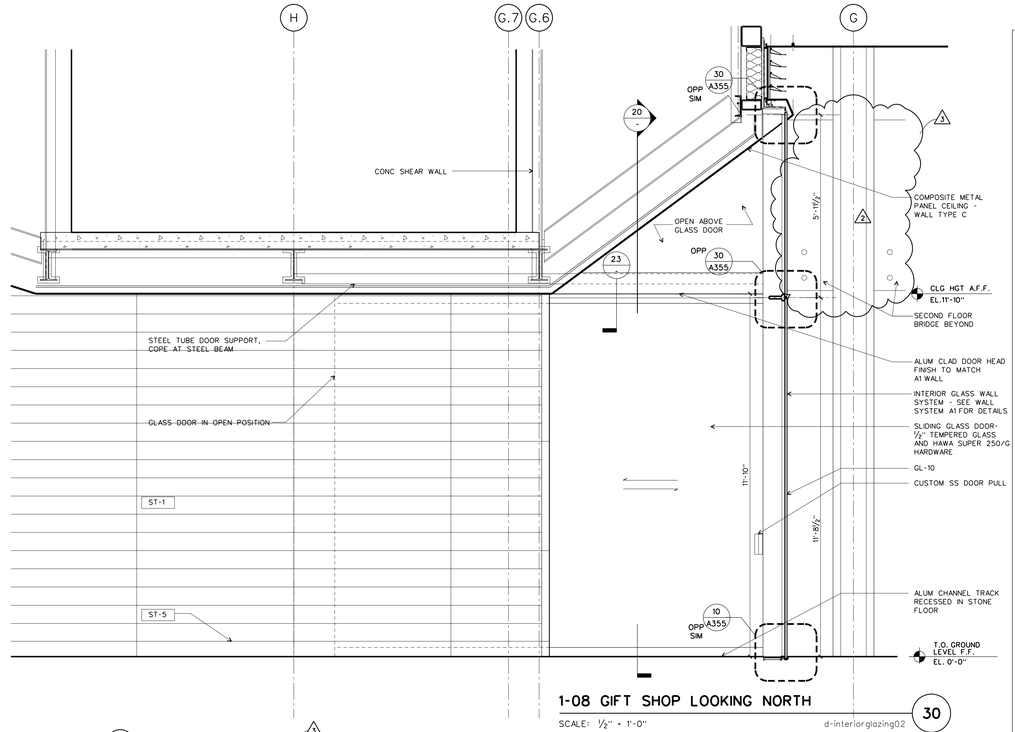


1-08 GIFT SHOP LOOKING NORTH — 30

SCALE: ½" = 1'-0" d-interiorglazing02

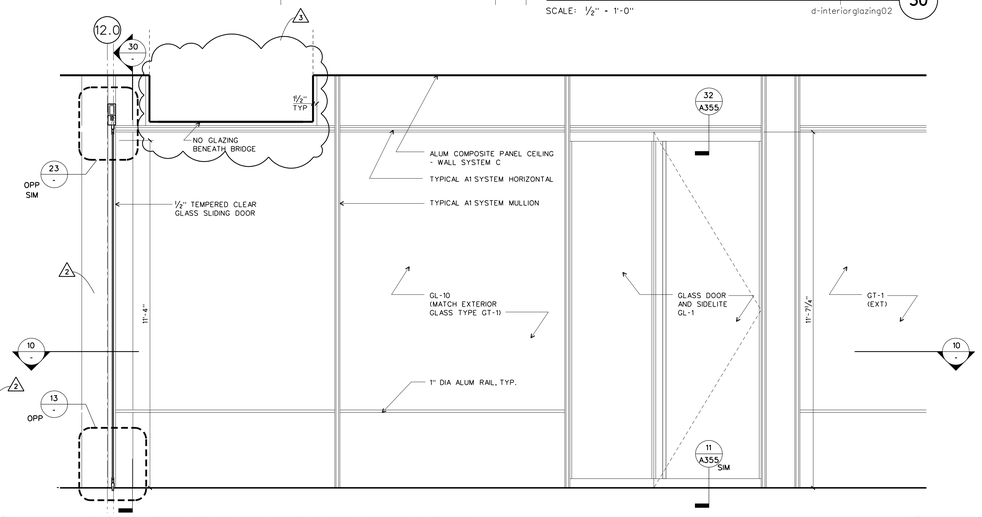


PARTIAL ELEVATION AT GIFT SHOP LOOKING EAST — 20

SCALE: ½" = 1'-0" D-INTERIOR-GLAZING-02

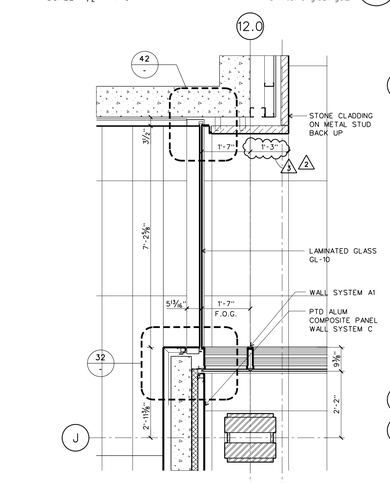

PARTIAL PLAN AT GIFT SHOP — 11

SCALE: ½" = 1'-0" d-interiorglazing02

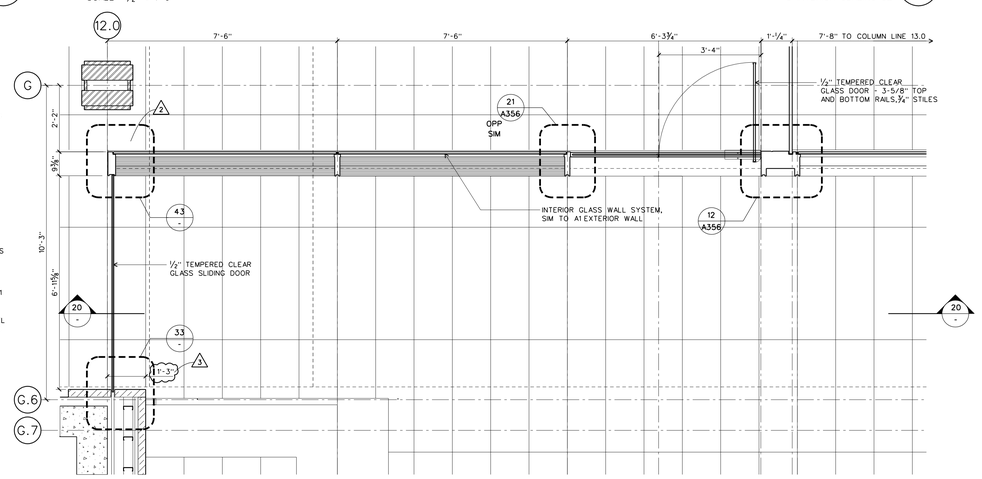

PARTIAL PLAN AT GIFT SHOP EAST WALL — 10

SCALE: ½" = 1'-0" D-INTERIOR-GLAZING-02

WILLIAM J. CLINTON PRESIDENTIAL CENTER

LITTLE ROCK, ARKANSAS

Architect

POLSHEK PARTNERSHIP LLP
320 West 13th Street
New York, New York 10014
212.807.7171

Coordinating Architects

POLK STANLEY YEARY ARCHITECTS Ltd
700 South Schiller Street
Little Rock, Arkansas 72201
501.378.0878

WITSELL EVANS RASCO
901 West Third Street
Little Rock, Arkansas 72201
501.374.5300

WOODS CARADINE ARCHITECTS
2200 South Main Street
Little Rock, Arkansas 72206
501.374.4060

Landscape Architects

HARGREAVES ASSOCIATES
118 Magazine Street
Cambridge, Massachusettes 02139
617.661.0070

LANDSCAPE ARCHITECTURE, Inc.
2300 Cottondale Lane Suite 202
Little Rock, Arkansas 72202
501.374.5610

Structural Engineer

LESLIE E. ROBERTSON ASSOC., RLLP
30 Bread Street, 47th Floor
New York, New York 10004
212.750.9000

MEP Engineers

FLACK + KURTZ Inc.
475 Fifth Avenue
New York, New York 10017
212.532.9600

CROMWELL ARCHITECTS ENGINEERS
101 South Spring Street
Little Rock, Arkansas 72201
501.372.2900

Curtainwall Consultant

R. A. HEINTGES ARCHITECTS
126 Fifth Avenue, 9th Floor
New York, New York 10011
212.652-2966

Seal

Issue	Date
1 ASI #25	12/19/03
2 ASI #22	08/01/03
1 ASI #12	02/07/03
100% Construction Documents	09/27/02
90% Progress Printing	08/30/02
100% Struct./ CD Progress	07/01/02

*New. Former A452 details on A520 dwgs

Job No. 9908


Scale: AS NOTED

Date: September 27, 2002

Title: MUSEUM BUILDING INTERIOR DETAILS: INTERIOR STOREFRONT SYSTEMS


Sheet No. A452

FOR OFFICIAL USE ONLY

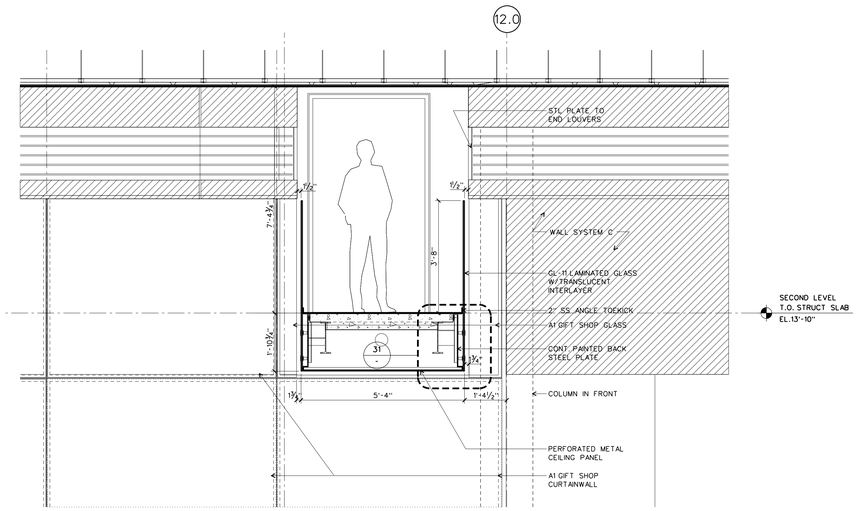


CROSS SECTION BRIDGE CONNECTOR

SCALE: ½" = 1'-0" detail/interior glazing 03 **41**

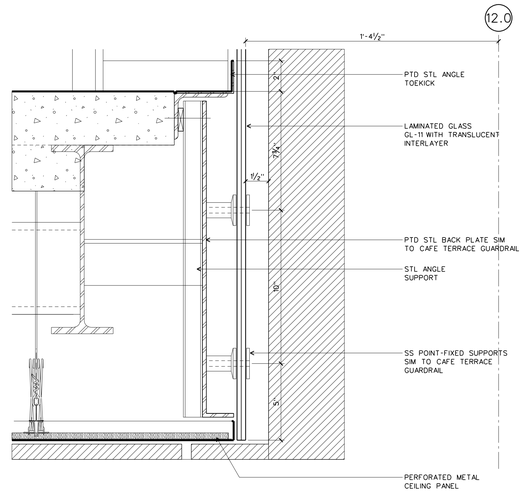


DETAIL SECTION

SCALE: 3 " = 1'-0" detail/interior glazing03 **31**

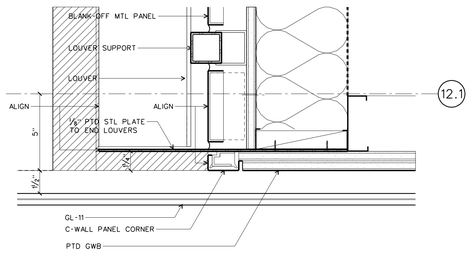


PLAN DETAIL AT LOUVERS TERMINATION

SCALE: 3 " = 1'-0" detail/interior glazing03 **21**

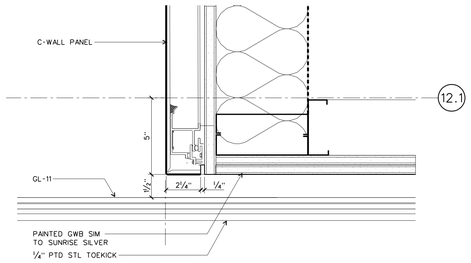


PLAN DETAIL AT METAL PANEL TERMINATION

SCALE: 3 " = 1'-0" detail/interior glazing03 **11**

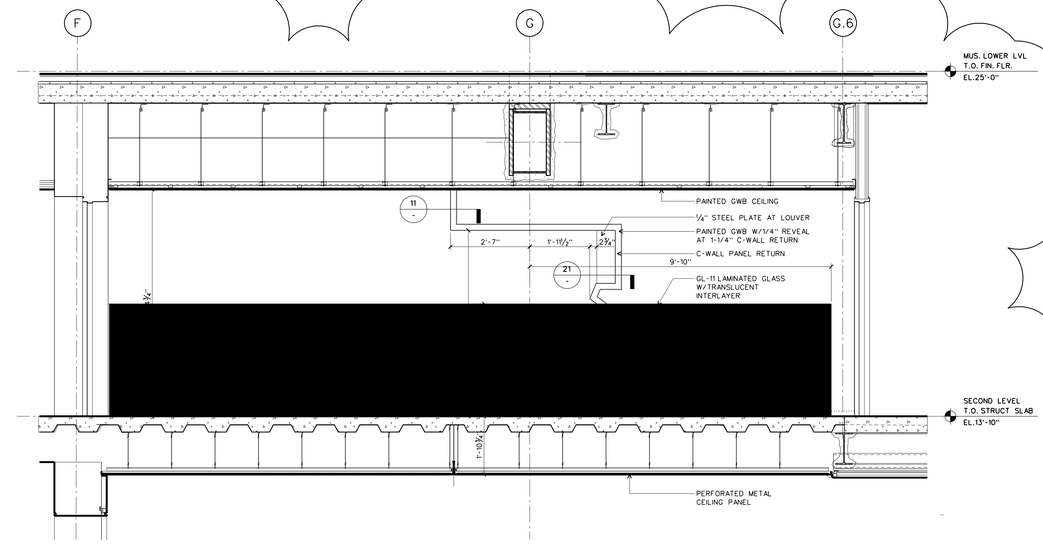


LONGITUDINAL SECTION BRIDGE CONNECTOR

SCALE: ½" = 1'-0" detail/interior glazing 03 **30**

 

ELEVATION

SCALE: ½" = 1'-0" detail/interior glazing 03 **20**

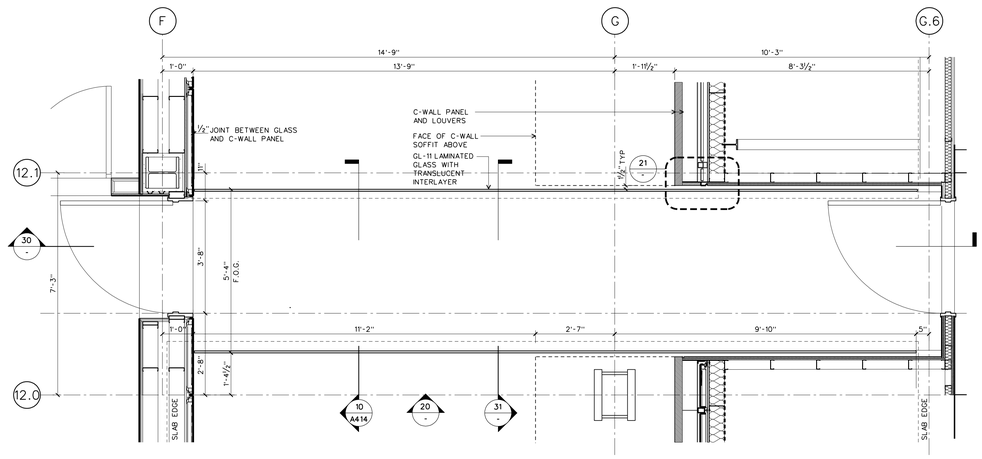

PLAN SECOND LEVEL BRIDGE CONNECTOR

SCALE: ½" = 1'-0" detail/interior glazing 03 **10**

WILLIAM J. CLINTON PRESIDENTIAL CENTER

LITTLE ROCK, ARKANSAS

Architect

POLSHEK PARTNERSHIP LLP
320 West 13th Street
New York, New York 10014
212.807.7171

Coordinating Architects

POLK STANLEY YEARY ARCHITECTS Ltd
700 South Schiller Street
Little Rock, Arkansas 72201
501.378.0878

WITSELL EVANS RASCO
901 West Third Street
Little Rock, Arkansas 72201
501.374.5300

WOODS CARADINE ARCHITECTS
2200 South Main Street
Little Rock, Arkansas 72206
501.374.4060

Landscape Architects

HARGREAVES ASSOCIATES
118 Magazine Street
Cambridge, Massachusettes 02139
617.661.0070

LANDSCAPE ARCHITECTURE, Inc.
2300 Cottondale Lane Suite 202
Little Rock, Arkansas 72202
501.374.5610

Structural Engineer

LESLIE E. ROBERTSON ASSOC., RLLP
30 Broad Street, 47th Floor
New York, New York 10004
212.750.9000

MEP Engineers

FLACK + KURTZ Inc.
475 Fifth Avenue
New York, New York 10017
212.532.9600


CROMWELL ARCHITECTS ENGINEERS
101 South Spring Street
Little Rock, Arkansas 72201
501.372.2900

Curtainwall Consultant

R. A. HEINTGES ARCHITECTS
126 Fifth Avenue, 9th Floor
New York, New York 10011
212.652-2966

Seal

Issue	Date
1 ASI #25	12/19/02
100% Construction Documents	09/27/02
90% Progress Printing	08/30/02
100% Struct./ CD Progress	07/01/02

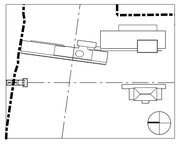

Job No. 9908


Scale 1/2"/1 1/2"/3" = 1':0"

Date September 27, 2002

Title MUSEUM BUILDING INTERIOR DETAILS: INTERIOR STOREFRONT SYSTEMS


Sheet No. A453

FOR OFFICIAL USE ONLY

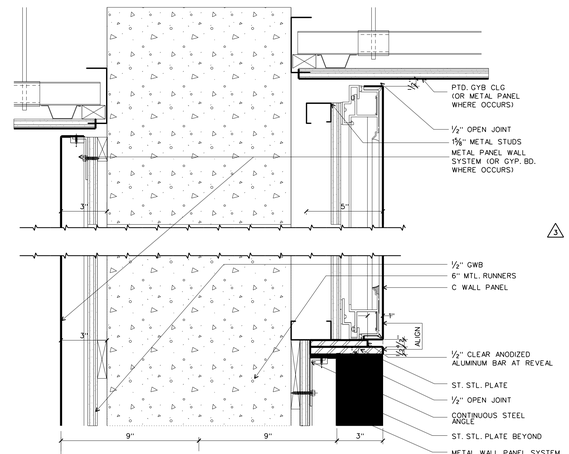


DETAIL AT ST. STL. PANEL/ ALUM. METAL "C" PANEL 43

SCALE: 3 " = 1'-0" detail/interior glazing-01

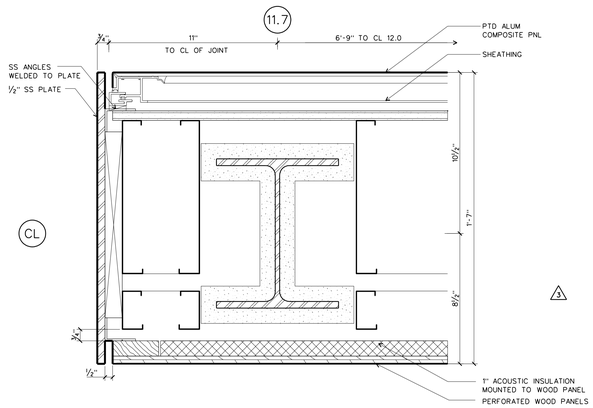


DETAIL AT END OF GREAT HALL WOOD WALL 42

SCALE: 3 " = 1'-0" detail/interior glazing-01

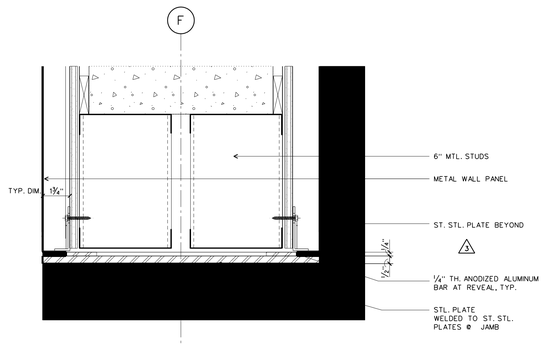


DETAIL OPENING AT CORE BUILDING 33

SCALE: 3 " = 1'-0" detail/interior glazing-01

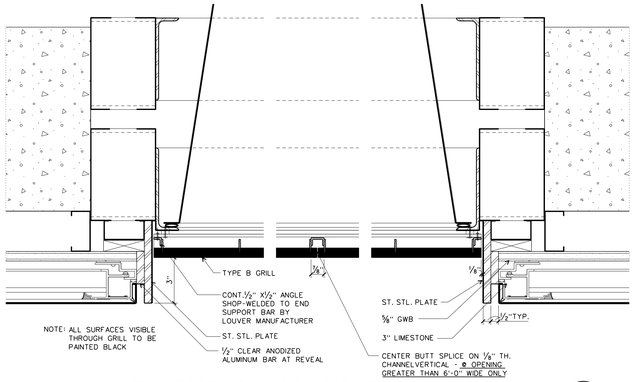


PLAN DETAIL @ C WALL OPENING 32

SCALE: 3 " = 1'-0" detail/interior glazing-01

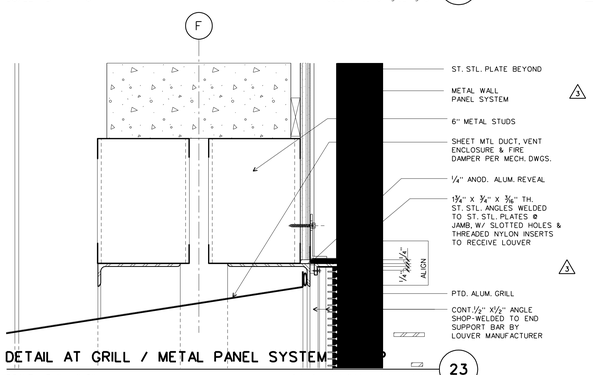


DETAIL AT GRILL / METAL PANEL SYSTEM 23

SCALE: 3 " = 1'-0" interior detail/d-metal panel.dgn

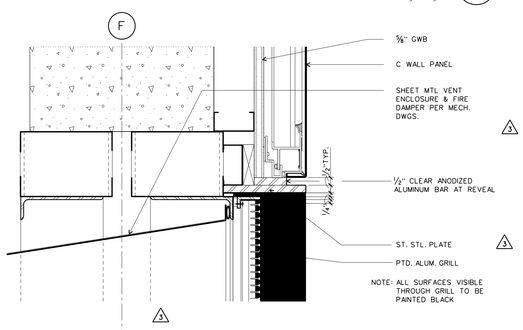


DETAIL AT GRILL / ALUM PANEL SYSTEM 22

SCALE: 3 " = 1'-0" detail/interior glazing-01

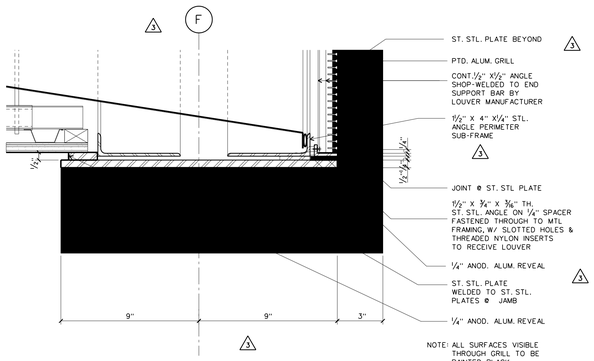


DETAIL AT GRILL / METAL PANEL SYSTEM @ BOTTOM 13

SCALE: 3 " = 1'-0" interior detail/d-metal panel.dgn

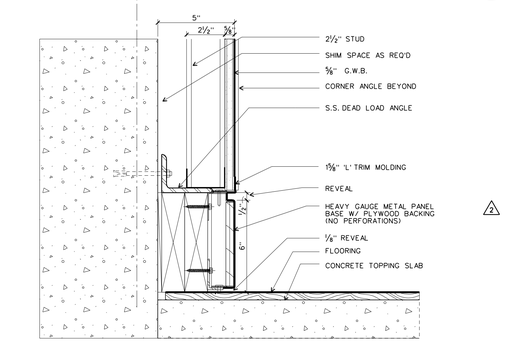

BASE DETAIL @ STR. 4 & 5, STR. 6 SIM.

SCALE: 3 " = 1'-0" 12

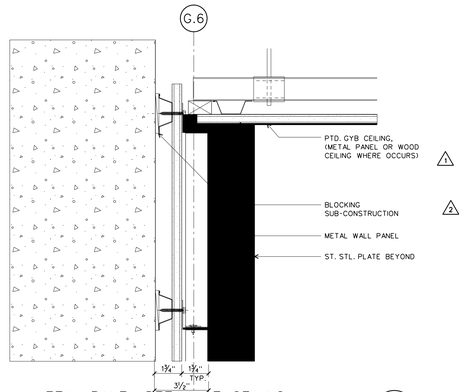


METAL PANEL DETAIL AT CEILING 31

SCALE: 3 " = 1'-0" interior detail/d-metal panel.dgn




SECTION DETAIL AT NORTH CORE WALL 40

SCALE: 3 " = 1'-0" interior detail/d-metal panel.dgn

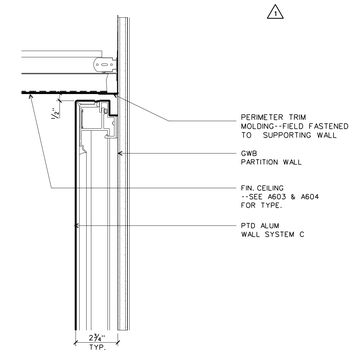


DETAIL AT HEAD OF PTD. ALUM. PANEL 30

SCALE: 3 " = 1'-0" interior detail/d-metal panel.dgn

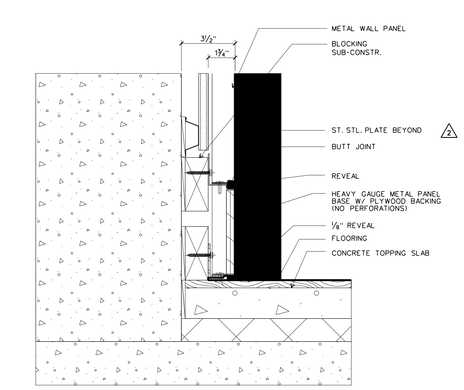


TYP. DETAIL METAL PANEL AT FLOOR 21

SCALE: 3 " = 1'-0" interior detail/d-metal panel.dgn

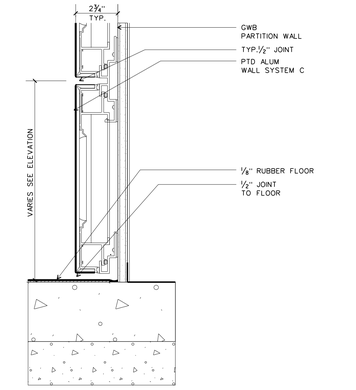


TYP. DETAIL ALUM. PANEL AT FLOOR 20

SCALE: 3 " = 1'-0" interior detail/d-metal panel.dgn

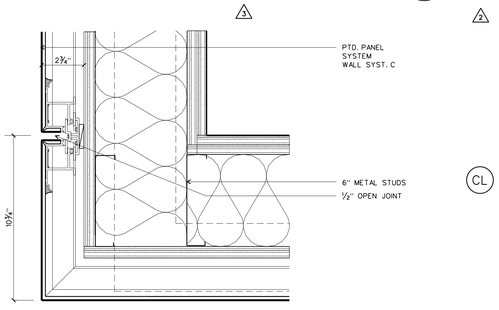

PLAN DETAIL AT METAL PANEL CORNER 11

SCALE: 3 " = 1'-0"

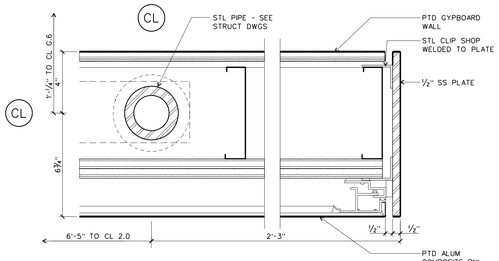

PLAN DETAIL AT END OF NORTH CORE WALL 10

SCALE: 3" = 1'-0" interior detail/d-metal panel.dgn

WILLIAM J. CLINTON PRESIDENTIAL CENTER

LITTLE ROCK, ARKANSAS

Architect

POLSHEK PARTNERSHIP LLP
320 West 13th Street
New York, New York 10014
212.807.7171

Coordinating Architects

POLK STANLEY YEARY ARCHITECTS Ltd
700 South Schiller Street
Little Rock, Arkansas 72201
501.378.0878

WITSELL EVANS RASCO
901 West Third Street
Little Rock, Arkansas 72201
501.374.5300

WOODS CARADINE ARCHITECTS
2200 South Main Street
Little Rock, Arkansas 72206
501.374.4060

Landscape Architects

HARGREAVES ASSOCIATES
118 Magazine Street
Cambridge, Massachusettes 02139
617.661.0070

LANDSCAPE ARCHITECTURE, Inc.
2300 Cottondale Lane Suite 202
Little Rock, Arkansas 72202
501.374.5610

Structural Engineer

LESLIE E. ROBERTSON ASSOC., RLLP
30 Broad Street, 47th Floor
New York, New York 10004
212.750.9000

MEP Engineers

FLACK + KURTZ Inc.
475 Fifth Avenue
New York, New York 10017
212.532.9600


CROMWELL ARCHITECTS ENGINEERS
101 South Spring Street
Little Rock, Arkansas 72201
501.372.2900

Curtainwall Consultant

R. A. HEINTGES ARCHITECTS
126 Fifth Avenue, 9th Floor
New York, New York 10011
212.652-2966

Seal

4	ASI #32	04/09/03
3	ASI #23	09/12/03
2	ASI #20	08/08/03
1	ASI #18	04/18/03
	100% Construction Documents	09/27/02
	90% Progress Printing	08/30/02
	ASI #05	08/20/02
	100% Struct./ CD Progress	07/01/02
	Bridge Bldg. Substructure	06/14/02
	100% Steel & Concrete CD	05/15/02
	& Architectural CD Progress	
	100% Design Development	03/01/02
	Issue	**Date**

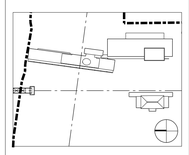

Job No. 9908


Scale 3" = 1'-0"

Date September 27, 2002

Title MUSEUM BUILDING INTERIOR DETAILS: METAL PANEL SYSTEMS

Sheet No. A454


FOR OFFICIAL USE ONLY

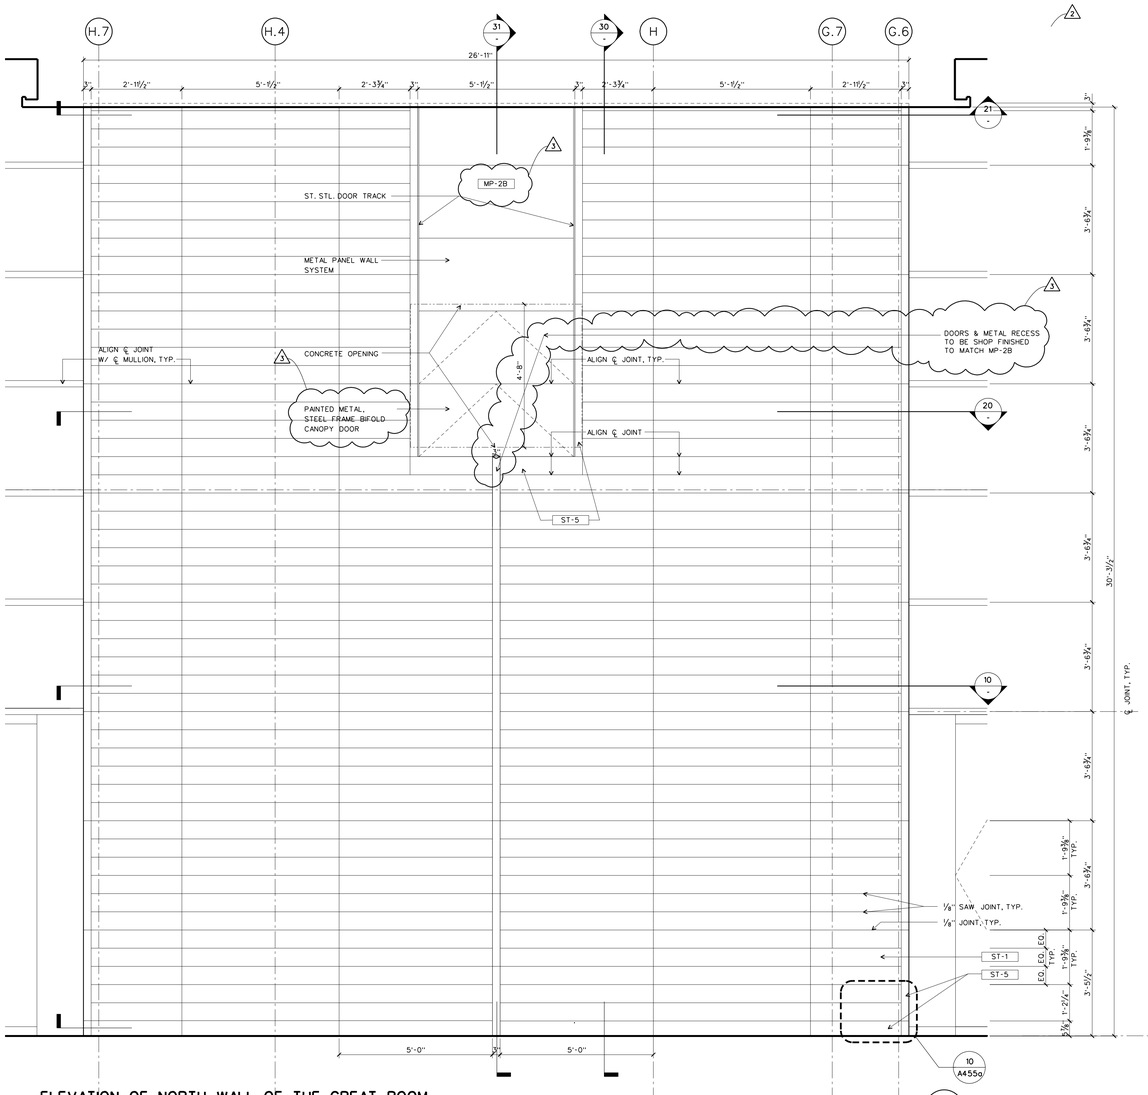

ELEVATION OF NORTH WALL OF THE GREAT ROOM

SCALE: ½" = 1'-0"


32

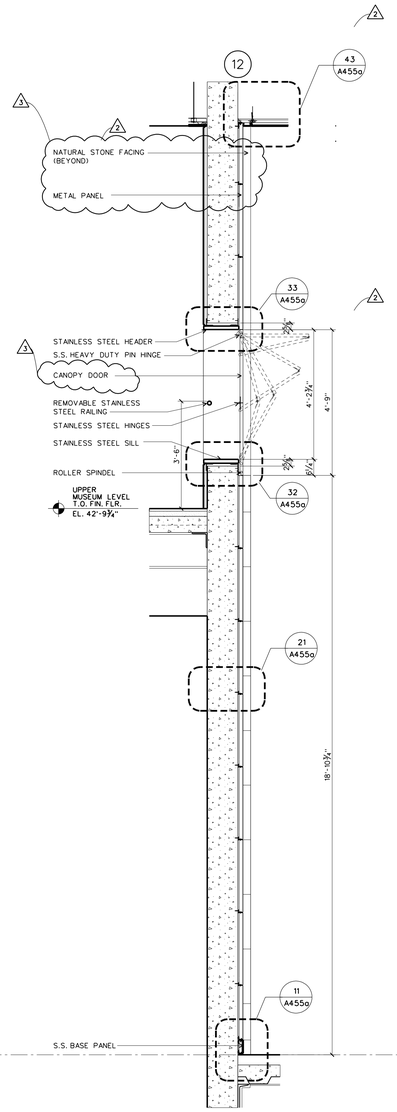

SECTION AT METAL WALL

SCALE: ½" = 1'-0"


31

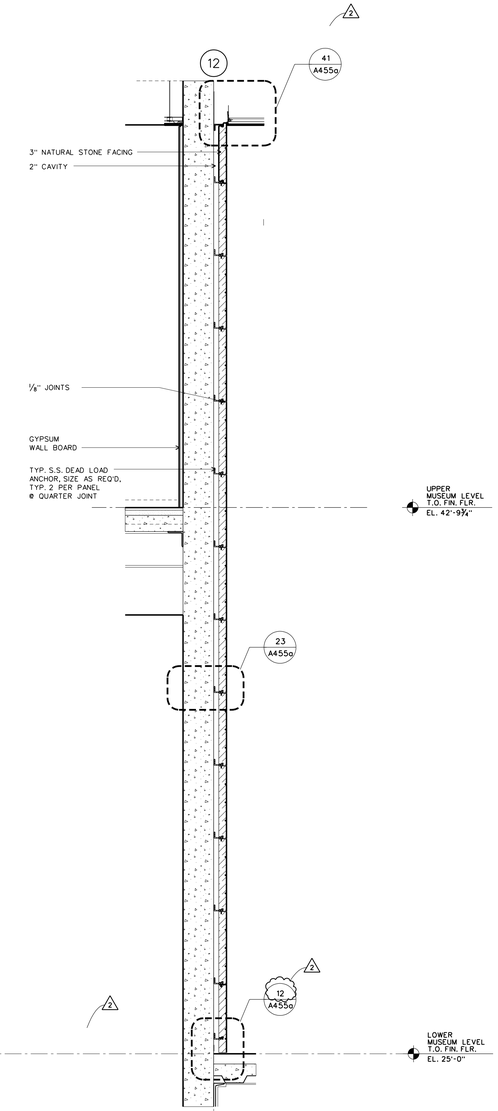

SECTION AT STONE WALL

SCALE: ½" = 1'-0"


30

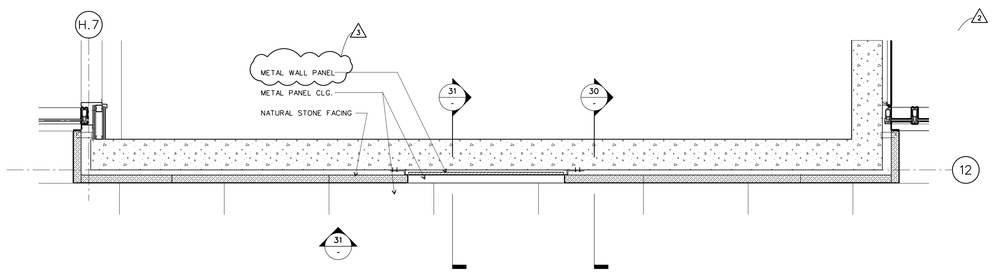

REFLECTED CEILING PLAN AT NORTH WALL OF THE GREAT ROOM

SCALE: ½" = 1'-0"


21

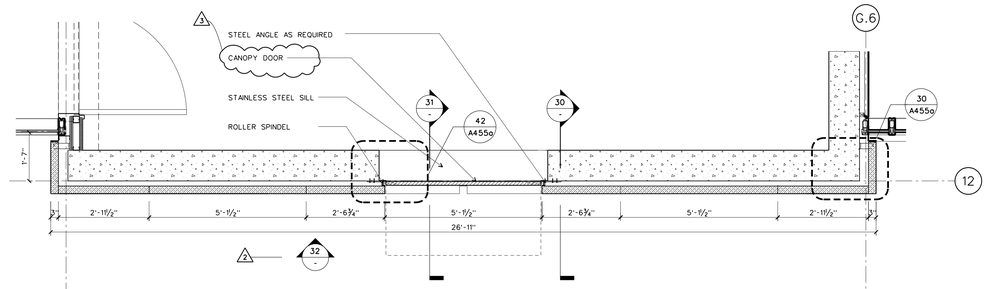

PLAN AT PROJECTION ROOM

SCALE: ½" = 1'-0"

20

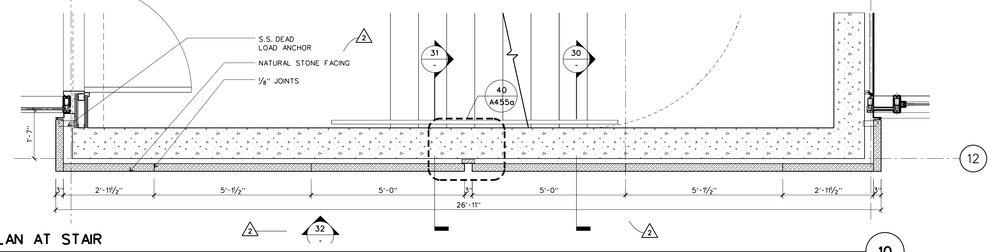

PLAN AT STAIR

SCALE: ½" = 1'-0"

10

FOR OFFICIAL USE ONLY

WILLIAM J. CLINTON PRESIDENTIAL CENTER

LITTLE ROCK, ARKANSAS

Architect

POLSHEK PARTNERSHIP LLP
320 West 13th Street
New York, New York 10014
212.807.7171

Coordinating Architects

POLK STANLEY YEARY ARCHITECTS Ltd
700 South Schiller Street
Little Rock, Arkansas 72201
501.378.0878

WITSELL EVANS RASCO
901 West Third Street
Little Rock, Arkansas 72201
501.374.5300

WOODS CARADINE ARCHITECTS
2200 South Main Street
Little Rock, Arkansas 72206
501.374.4060

Landscape Architects

HARGREAVES ASSOCIATES
118 Magazine Street
Cambridge, Massachusettes 02139
617.661.0070

LANDSCAPE ARCHITECTURE, Inc.
2300 Cottondale Lane Suite 202
Little Rock, Arkansas 72202
501.374.5610

Structural Engineer

LESLIE E. ROBERTSON ASSOC., RLLP
30 Broad Street, 47th Floor
New York, New York 10004
212.750.9000

MEP Engineers

FLACK + KURTZ Inc.
475 Fifth Avenue
New York, New York 10017
212.532.9600


CROMWELL ARCHITECTS ENGINEERS
101 South Spring Street
Little Rock, Arkansas 72201
501.372.2900

Curtainwall Consultant

R. A. HEINTGES ARCHITECTS
126 Fifth Avenue, 9th Floor
New York, New York 10011
212.652-2966

Seal

	Issue	Date
3	ASI #23	09/12/03
2	ASI #20	06/06/03
1	Addendum #7	12/20/02
	100% Construction Documents	09/27/02
	90% Progress Printing	08/30/02
	100% Struct./ CD Progress	07/01/02

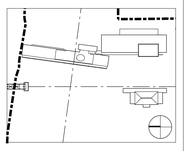


Job No.
9908

Scale
1'-1/2" / 3" = 1'-0"

Date
September 27, 2002


Title
MUSEUM BUILDING INTERIOR DETAILS: STONE

Sheet No.
A455

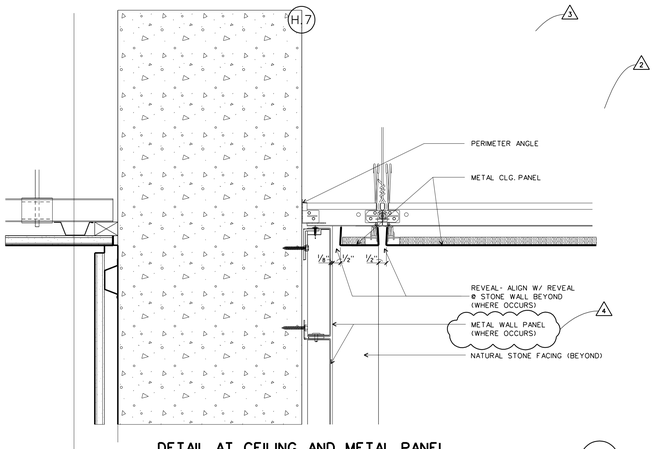


DETAIL AT CEILING AND METAL PANEL — 43

SCALE: 3 " = 1'-0"

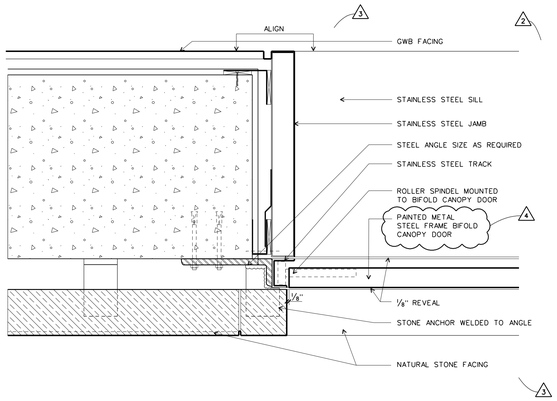


PLAN DETAIL AT BI-FOLD DOOR PROJECTION ROOM — 42

SCALE: 3 " = 1'-0"

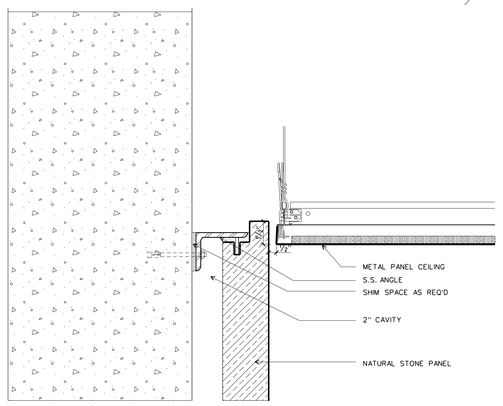


DETAIL AT TOP OF STONE WALL — 41

SCALE: 3 " = 1'-0"

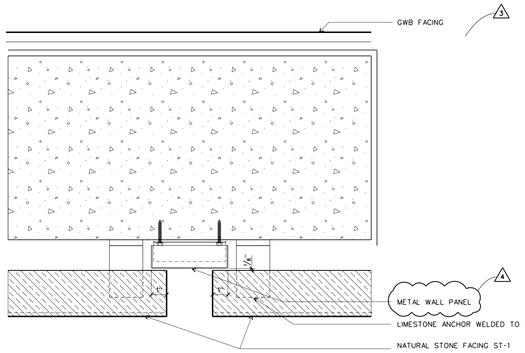


PLAN DETAIL AT STONE AND METAL WALL PANEL — 40

SCALE: 3 " = 1'-0"

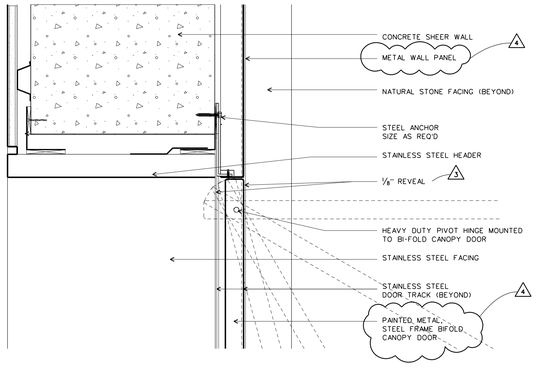

DETAIL AT DOOR HEAD PROJECTION ROOM — 33


SCALE: 3 " = 1'-0"

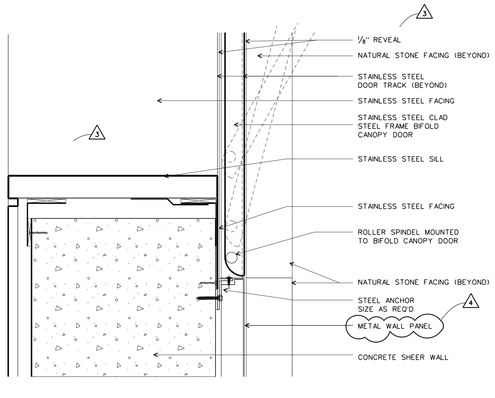

DETAIL AT DOOR SILL PROJECTION ROOM — 32


SCALE: 3 " = 1'-0"

NOT USED — 31

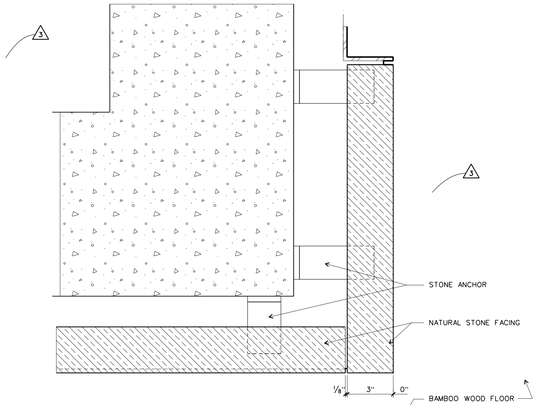


PLAN DETAIL AT STONE CORNER — 30

SCALE: 3 " = 1'-0"

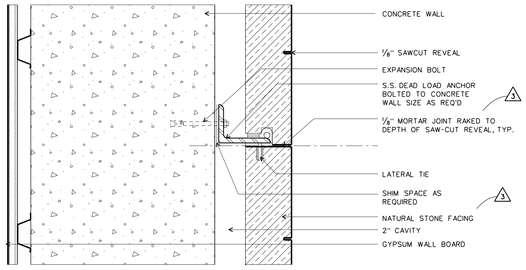


DETAIL TYP. STONE BRACKET — 23

SCALE: 3 " = 1'-0"

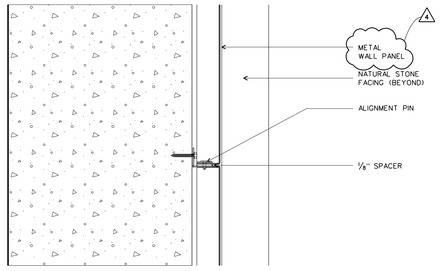


NOT USED — 22

SCALE:

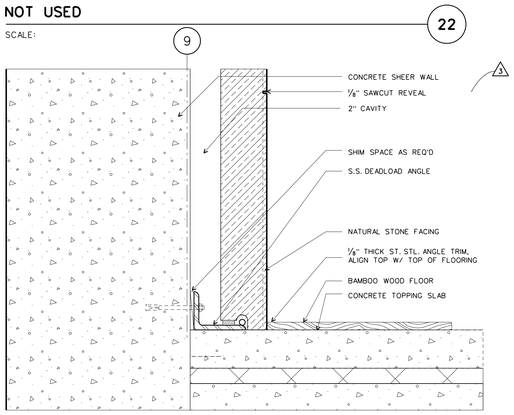



SCALE: 3 " = 1'-0"

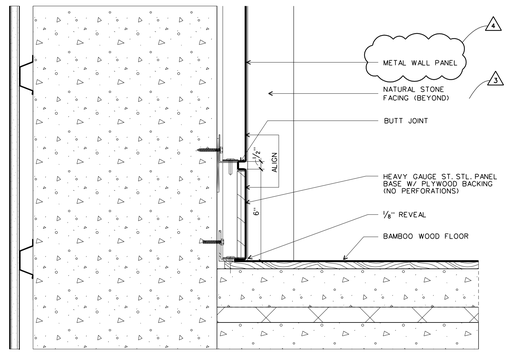

NOT USED — 20

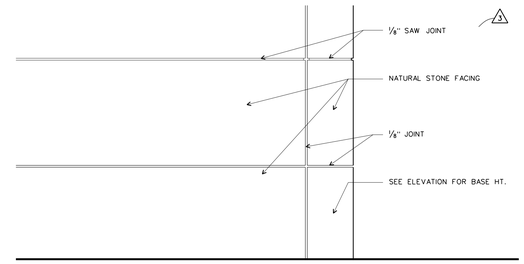

NOT USED — 13

SCALE:

SECTION DETAIL AT FLOOR & STONE WALL — 12

SCALE: 3 " = 1'-0"

SECTION DETAIL AT FLOOR AND METAL PANEL — 11

SCALE: 3 " = 1'-0"

ELEVATION DETAIL AT STONE CORNER — 10

SCALE: 3 " = 1'-0"

WILLIAM J. CLINTON PRESIDENTIAL CENTER

LITTLE ROCK, ARKANSAS

Architect

POLSHEK PARTNERSHIP LLP
320 West 13th Street
New York, New York 10014
212.807.7171

Coordinating Architects

POLK STANLEY YEARY ARCHITECTS Ltd
700 South Schiller Street
Little Rock, Arkansas 72201
501.378.0878

WITSELL EVANS RASCO
901 West Third Street
Little Rock, Arkansas 72201
501.374.5300

WOODS CARADINE ARCHITECTS
2200 South Main Street
Little Rock, Arkansas 72206
501.374.4060

Landscape Architects

HARGREAVES ASSOCIATES
118 Magazine Street
Cambridge, Massachusettes 02139
617.661.0070

LANDSCAPE ARCHITECTURE, Inc.
2300 Cottondale Lane Suite 202
Little Rock, Arkansas 72202
501.374.5610

Structural Engineer

LESLIE E. ROBERTSON ASSOC., RLLP
30 Broad Street, 47th Floor
New York, New York 10004
212.750.9000

MEP Engineers

FLACK + KURTZ Inc.
475 Fifth Avenue
New York, New York 10017
212.532.9600


CROMWELL ARCHITECTS ENGINEERS
101 South Spring Street
Little Rock, Arkansas 72201
501.372.2900

Curtainwall Consultant

R. A. HEINTGES ARCHITECTS
126 Fifth Avenue, 9th Floor
New York, New York 10011
212.652-2966

Seal

Issue	Date
4 ASI #23	09/12/03
3 ASI #20	06/06/03
2 ASI #18	04/18/03
1 Addendum #7	12/20/02

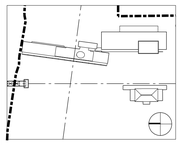

Job No. 9908

Scale 1'-1/2" / 3" = 1'-0"

Date September 27, 2002


Title

MUSEUM BUILDING INTERIOR DETAILS: METAL & STONE

Sheet No.


4 A455a

FOR OFFICIAL USE ONLY

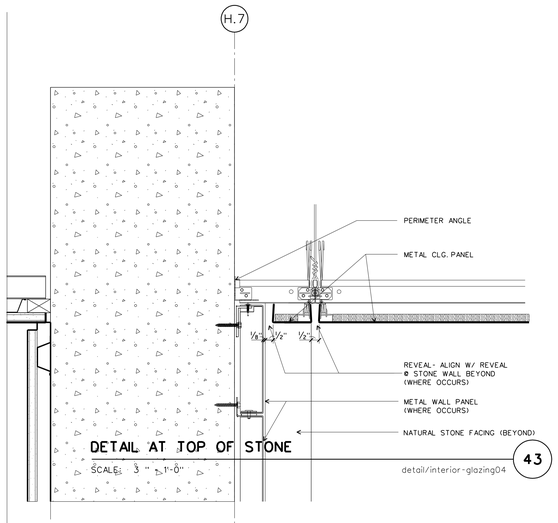


DETAIL AT TOP OF STONE

SCALE: 3 " = 1'-0" detail/interior-glazing04 **43**

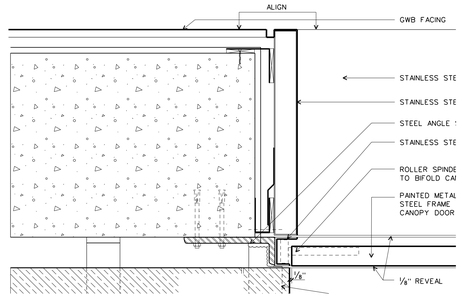


PLAN DETAIL AT DOOR HINGE PROJECTION ROOM

SCALE: 3 " = 1'-0" detail/interior-glazing04 **42**

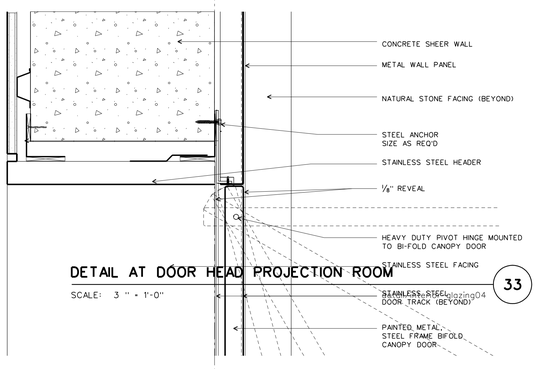


DETAIL AT DOOR HEAD PROJECTION ROOM

SCALE: 3 " = 1'-0" detail/interior-glazing04 **33**

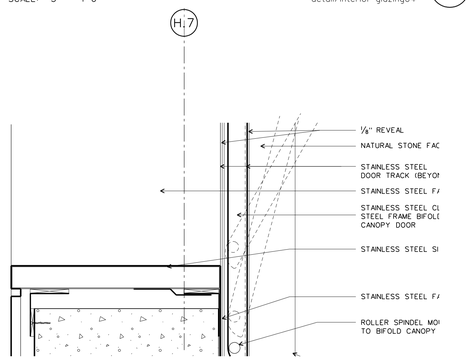


DETAIL AT DOOR SILL PROJECTION ROOM

SCALE: 3 " = 1'-0" detail/interior-glazing04 **32**

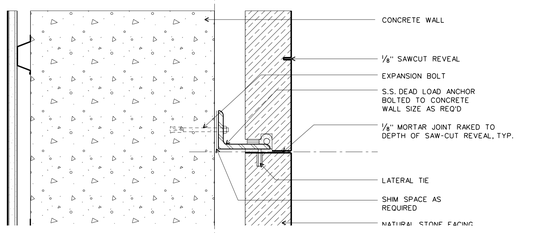

DETAIL TYP. STONE BRACKET

SCALE: 3 " = 1'-0" detail/interior-glazing04 **23**

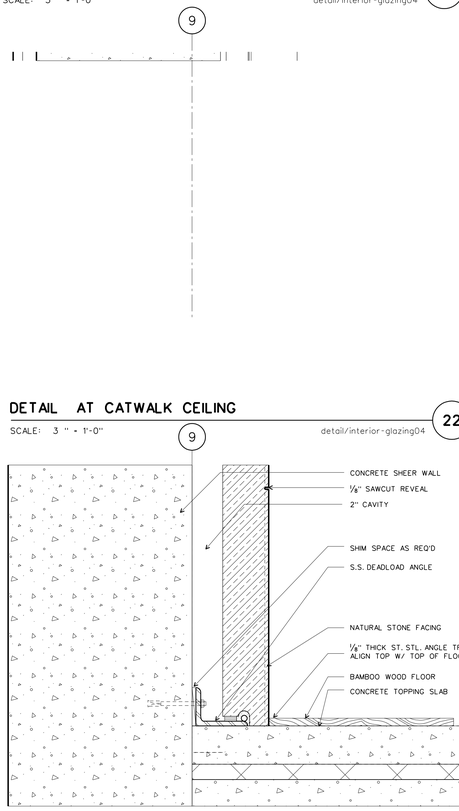


DETAIL AT CATWALK CEILING

SCALE: 3 " = 1'-0" detail/interior-glazing04 **22**


SECTION AT FLOOR

SCALE: 3 " = 1'-0" detail/interior-glazing04 **13**

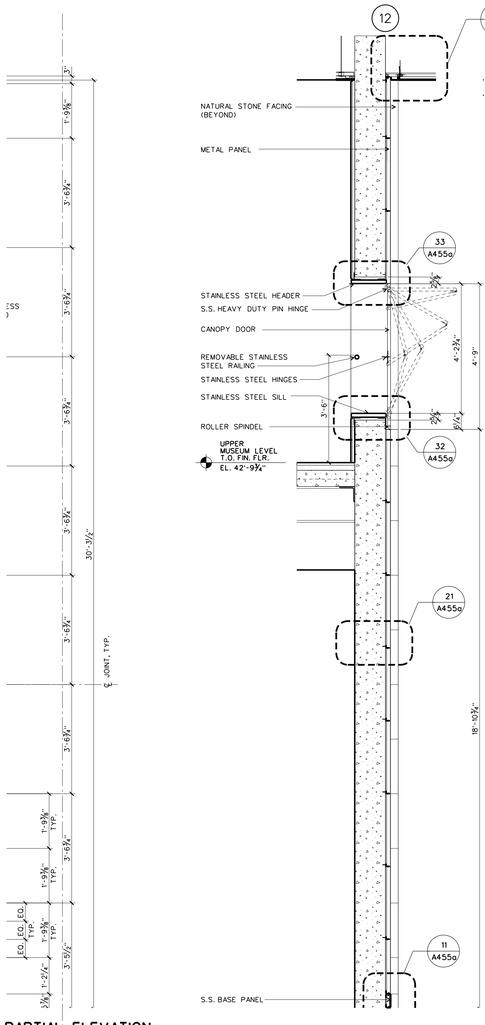


PARTIAL ELEVATION

SCALE: ½" = 1'-0" detail/interior-glazing04 **31**

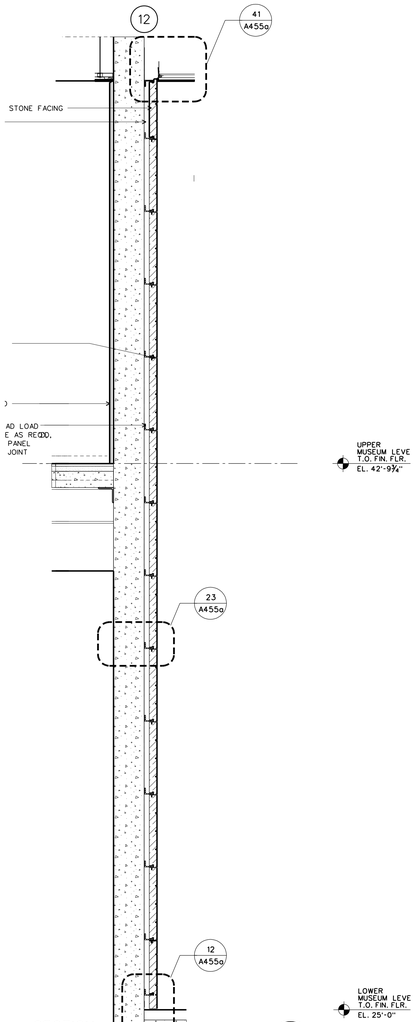


SECTION

SCALE: ½" = 1'-0" detail/interior-glazing04 **30**

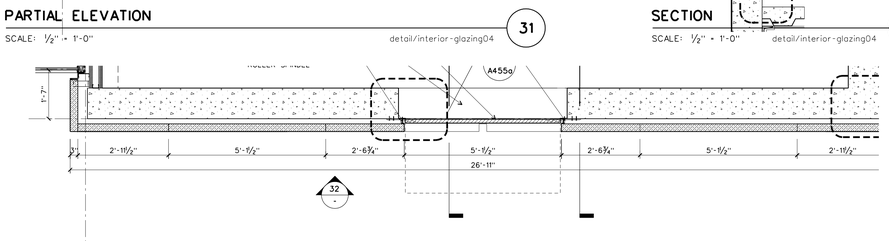

PLAN AT PROJECTION ROOM

SCALE: ½" = 1'-0" detail/interior-glazing04 **20**

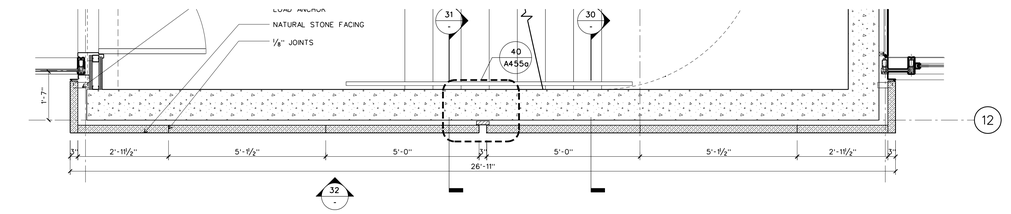

PLAN AT STAIR

SCALE: ½" = 1'-0" detail/interior-glazing04 **10**

WILLIAM J. CLINTON PRESIDENTIAL CENTER

LITTLE ROCK, ARKANSAS

Architect

POLSHEK PARTNERSHIP LLP
320 West 13th Street
New York, New York 10014
212.807.7171

Coordinating Architects

POLK STANLEY YEARY ARCHITECTS Ltd
700 South Schiller Street
Little Rock, Arkansas 72201
501.378.0878

WITSELL EVANS RASCO
901 West Third Street
Little Rock, Arkansas 72201
501.374.5300

WOODS CARADINE ARCHITECTS
2200 South Main Street
Little Rock, Arkansas 72206
501.374.4060

Landscape Architects

HARGREAVES ASSOCIATES
118 Magazine Street
Cambridge, Massachusettes 02139
617.661.0070

LANDSCAPE ARCHITECTURE, Inc.
2300 Cottondale Lane Suite 202
Little Rock, Arkansas 72202
501.374.5610

Structural Engineer

LESLIE E. ROBERTSON ASSOC., RLLP
30 Broad Street, 47th Floor
New York, New York 10004
212.750.9000

MEP Engineers

FLACK + KURTZ Inc.
475 Fifth Avenue
New York, New York 10017
212.532.9600


CROMWELL ARCHITECTS ENGINEERS
101 South Spring Street
Little Rock, Arkansas 72201
501.372.2900

Curtainwall Consultant

R. A. HEINTGES ARCHITECTS
126 Fifth Avenue, 9th Floor
New York, New York 10011
212.652-2966

Seal

Issue	Date
100% Construction Documents	09/27/02
90% Progress Printing	08/30/02
100% Struct./ CD Progress	07/01/02

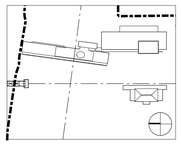

Job No. 9908


Scale 1'-1/2" / 3" = 1'-0"

Date September 27, 2002

Title MUSEUM BUILDING INTERIOR DETAILS: STONE

Sheet No. A455


FOR OFFICIAL USE ONLY

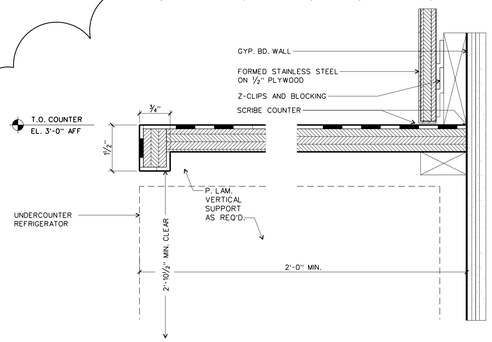

DETAIL COUNTERTOP EDGE AT REFRIGERATOR

SCALE: 6 " = 1'-0"


43

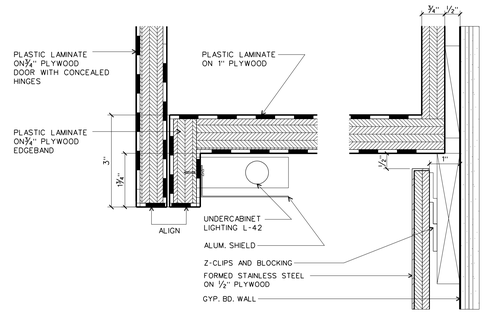

DETAIL AT LIGHT STRIP

SCALE: 6 " = 1'-0"


42

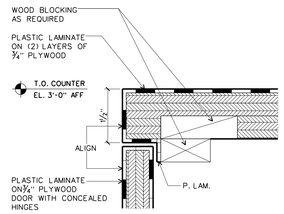

DETAIL AT COUNTERTOP EDGE

SCALE: 6 " = 1'-0"


41

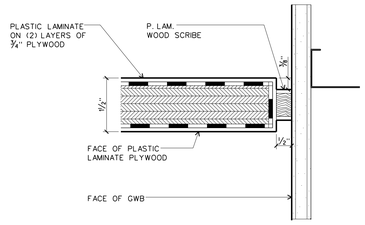

DETAIL AT COUNTER & GWB IN KITCHEN

SCALE: 6 " = 1'-0"

40

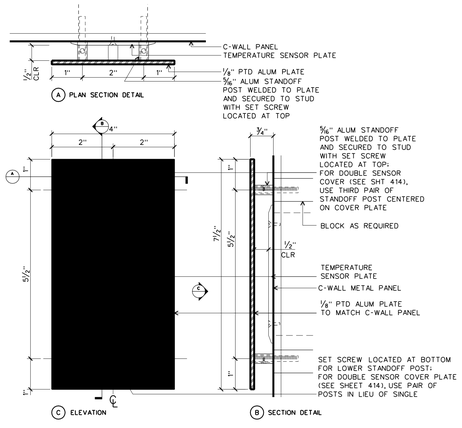


TEMPERATURE SENSOR COVER

SCALE: 3"=1'-0"

details/interior details/d-i-tempSensor

33

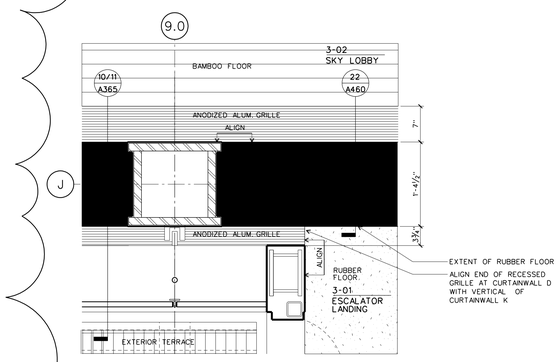


PLAN DETAIL AT CW-K / ESCALATOR LANDING - LOWER MUSEUM LEVEL

SCALE: 1"=1'-0"

interior details/d-i-truss01


30

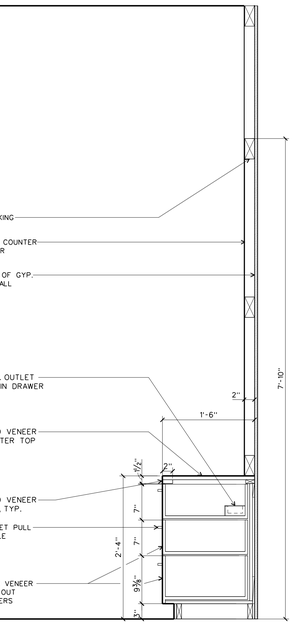

MAKE UP COUNTER CABINET

SCALE: 1" =1'-0"


13

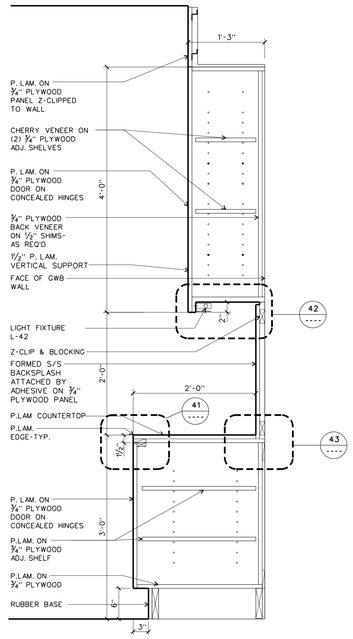

KITCHEN CABINET

SCALE: 1 " =1'-0"


12

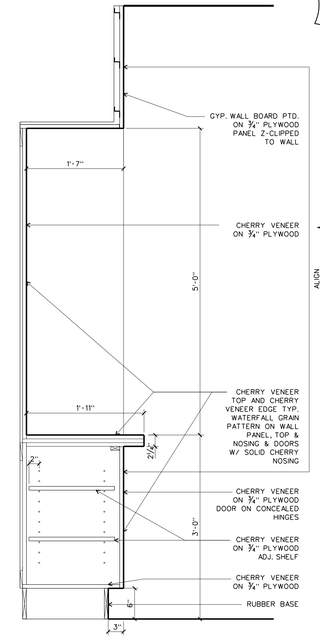

TV CABINET

SCALE: 1 " =1'-0"

11

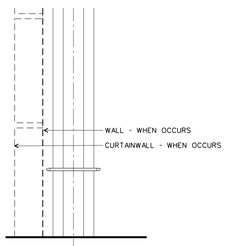


CANE RAIL: ELEVATION

SCALE: ½"=1'-0"

details/interiordetails/d-i-cane-01.dgn

31

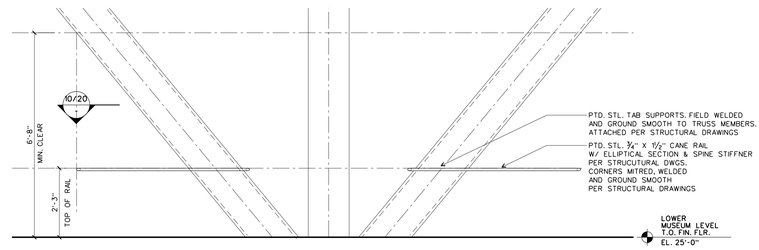


CANE RAIL: TYPICAL ELEVATION

SCALE: ½"=1'-0"

details/interiordetails/d-i-cane-01.dgn

30

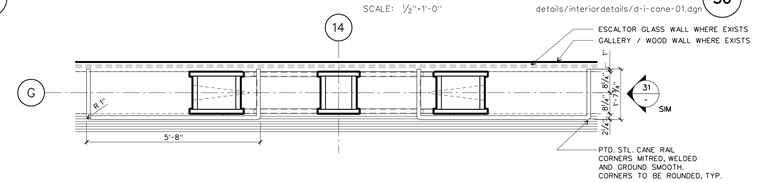


CANE RAIL PLAN - TYPE "B"

SCALE: ½"=1'-0"

details/interiordetails/d-i-cane-01.dgn

20

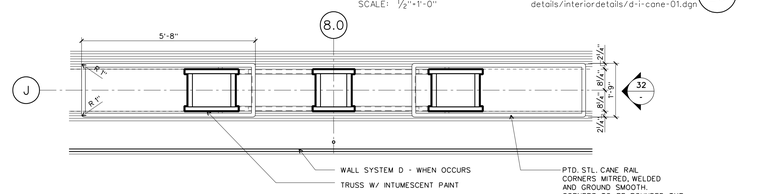

CANE RAIL PLAN - TYPE "A"

SCALE: ½"=1'-0"

details/interiordetails/d-i-cane-01.dgn

10

WILLIAM J. CLINTON PRESIDENTIAL CENTER

LITTLE ROCK, ARKANSAS

Architect

POLSHEK PARTNERSHIP LLP
320 West 13th Street
New York, New York 10014
212.807.7171

Coordinating Architects

POLK STANLEY YEARY ARCHITECTS Ltd
700 South Schiller Street
Little Rock, Arkansas 72201
501.378.0878

WITSELL EVANS RASCO
901 West Third Street
Little Rock, Arkansas 72201
501.374.5300

WOODS CARADINE ARCHITECTS
2200 South Main Street
Little Rock, Arkansas 72206
501.374.4060

Landscape Architects

HARGREAVES ASSOCIATES
118 Magazine Street
Cambridge, Massachusettes 02139
617.661.0070

LANDSCAPE ARCHITECTURE, Inc.
2300 Cottondale Lane Suite 202
Little Rock, Arkansas 72202
501.374.5610

Structural Engineer

LESLIE E. ROBERTSON ASSOC., RLLP
30 Broad Street, 47th Floor
New York, New York 10004
212.750.9000

MEP Engineers

FLACK + KURTZ Inc.
475 Fifth Avenue
New York, New York 10017
212.532.9600

CROMWELL ARCHITECTS ENGINEERS
101 South Spring Street
Little Rock, Arkansas 72201
501.372.2900

Curtainwall Consultant

R. A. HEINTGES ARCHITECTS
126 Fifth Avenue, 9th Floor
New York, New York 10011
212.652-2966

Seal

Issue	Date
2 ASI #24	10/24/03
1 ASI #20	06/06/03

Job No. 9908

Scale As Noted

Date September 27, 2002

Title


1

MUSEUM BUILDING INTERIOR DETAILS

Sheet No.


A456

FOR OFFICIAL USE ONLY

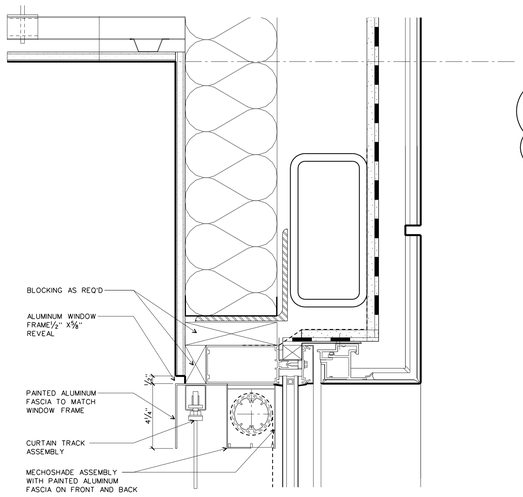


DETAIL AT MECHOSHADE AND WINDOW IN GREEN ROOM — 33

SCALE: 3 " = 1'-0"

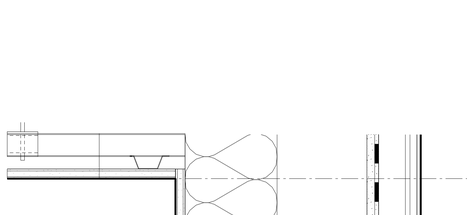


DETAIL AT MIRROR MAKE UP LIGHT FIXTURE — 23

SCALE: 3 " = 1'-0"

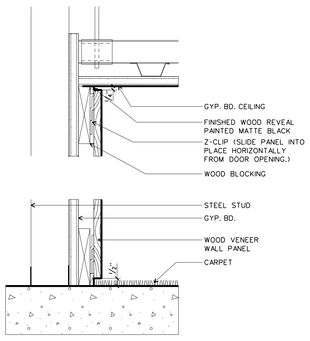

WOOD VENEER WALL AT CEILING AND BASE — 13

SCALE: 3 " = 1'-0"

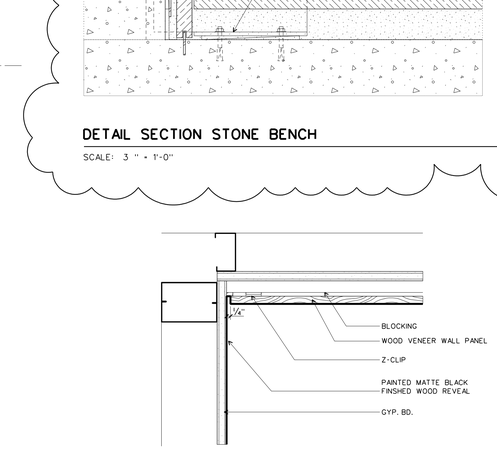


DETAIL AT WOOD VENEER WALL AND GYP. BD. WALL — 32

SCALE: 3 " = 1'-0"

NOT USED


SECTION AT WOOD COUNTER — 22

SCALE: 3 " = 1'-0"

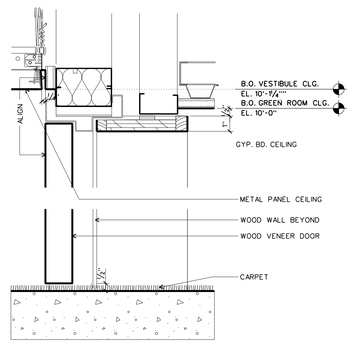


SECTION DETAIL AT GREEN ROOM DOOR — 12

SCALE: 3 " = 1'-0"

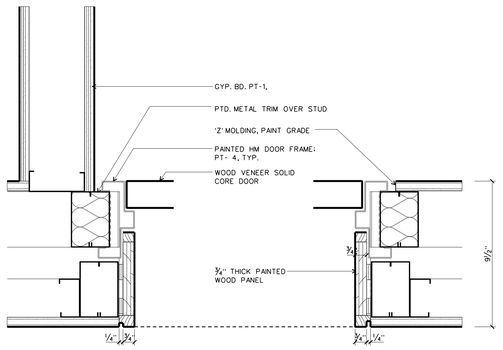

PLAN DETAIL AT GREEN ROOM DOOR — 11

SCALE: 3 " = 1'-0"

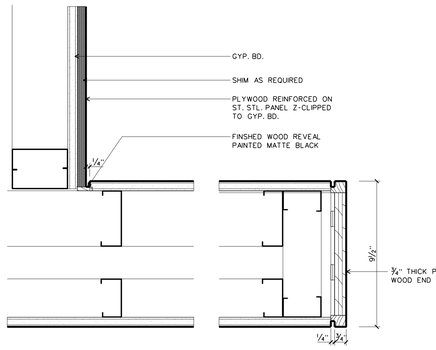


PLAN DETAIL AT GREEN ROOM WALL — 10

SCALE: 3 " = 1'-0"

DETAIL SECTION STONE BENCH — 42


SCALE: 3 " = 1'-0"

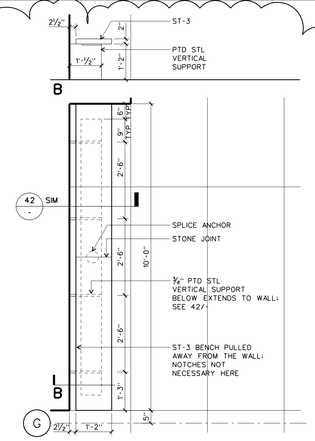

PLAN OF WALL BENCH ON CAFE LEVEL — 41

SCALE: ½" = 1'-0"


d-stonebench.dgn

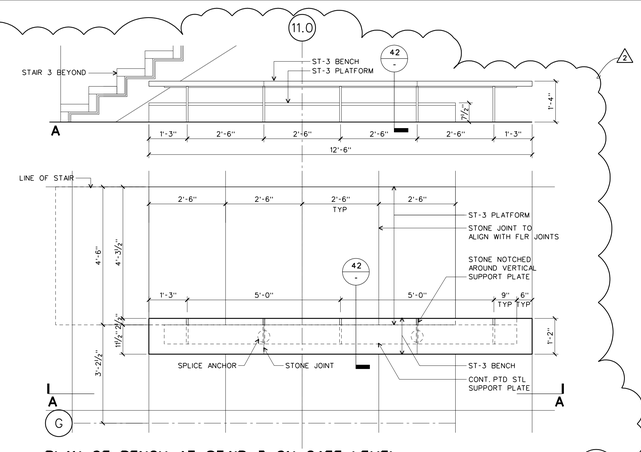

PLAN OF BENCH AT STAIR 3 ON CAFE LEVEL — 40


SCALE: ½" = 1'-0"

d-stonebench.dgn

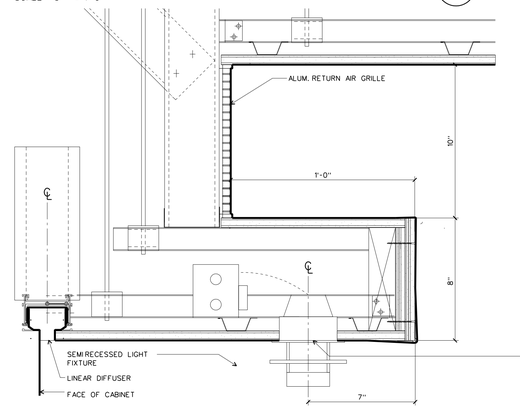

DETAIL AT KITCHEN ST. STEEL/WOOD WALLS — 31

SCALE: 3 " = 1'-0"

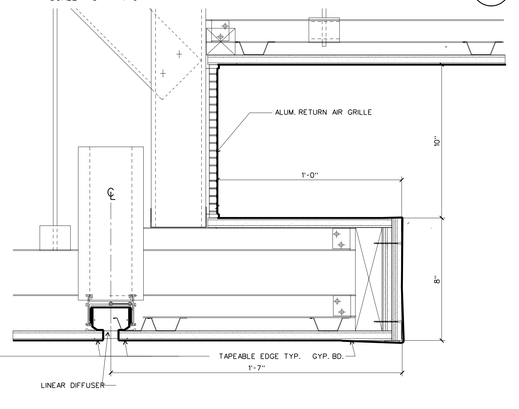

DETAIL AT WOOD WALL IN VESTIBULE — 30


SCALE: 3 " = 1'-0"

DETAIL AT CEILING SOFFIT IN KITCHEN — 21

SCALE: 3 " = 1'-0"

DETAIL AT CEILING SOFFIT IN GREEN ROOM — 20

SCALE: 3 " = 1'-0"

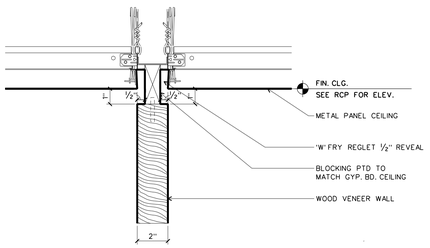

DETAIL AT WOOD WALL IN VESTIBULE — 30

SCALE: 3 " = 1'-0"

WILLIAM J. CLINTON PRESIDENTIAL CENTER

LITTLE ROCK, ARKANSAS

Architect

POLSHEK PARTNERSHIP LLP
320 West 13th Street
New York, New York 10014
212.807.7171

Coordinating Architects

POLK STANLEY YEARY ARCHITECTS Ltd
700 South Schiller Street
Little Rock, Arkansas 72201
501.378.0878

WITSELL EVANS RASCO
901 West Third Street
Little Rock, Arkansas 72201
501.374.5300

WOODS CARADINE ARCHITECTS
2200 South Main Street
Little Rock, Arkansas 72206
501.374.4060

Landscape Architects

HARGREAVES ASSOCIATES
118 Magazine Street
Cambridge, Massachusettes 02139
617.661.0070

LANDSCAPE ARCHITECTURE, Inc.
2300 Cottondale Lane Suite 202
Little Rock, Arkansas 72202
501.374.5610

Structural Engineer

LESLIE E. ROBERTSON ASSOC., RLLP
30 Broad Street, 47th Floor
New York, New York 10004
212.750.9000

MEP Engineers

FLACK + KURTZ Inc.
475 Fifth Avenue
New York, New York 10017
212.532.9600

CROMWELL ARCHITECTS ENGINEERS
101 South Spring Street
Little Rock, Arkansas 72201
501.372.2900

Curtainwall Consultant

R. A. HEINTGES ARCHITECTS
126 Fifth Avenue, 9th Floor
New York, New York 10011
212.652-2966

Seal

Issue	Date
2 ASI #25	12/19/03
1 ASI #24	10/24/03

Job No. 9908

Scale As Noted

Date September 27, 2002


Title

MUSEUM BUILDING INTERIOR DETAILS

Sheet No.


A456a

FOR OFFICIAL USE ONLY

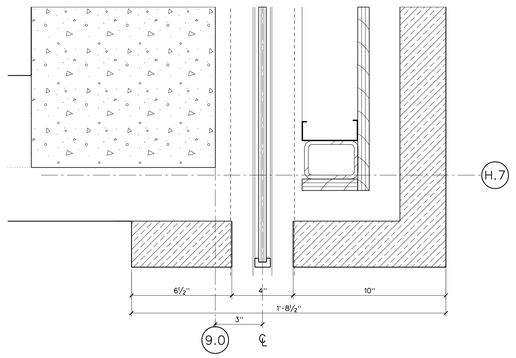


PLAN AT STR. 4 POCKET DOOR

SCALE: 3"=1'-0" details/dtl-glassdr.dgn 41

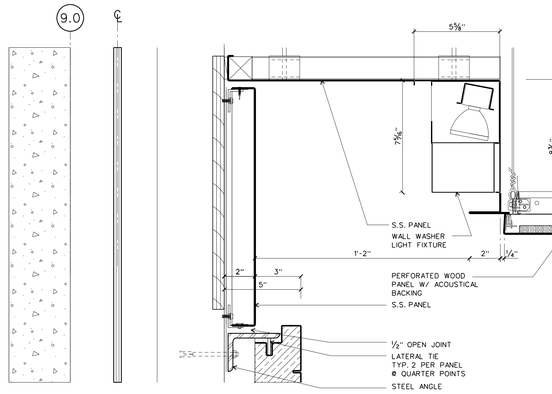


SECTION AT U.M.L. CLG./POCKET DOOR

SCALE: 3"=1'-0" details/dtl-glassdr.dgn 40

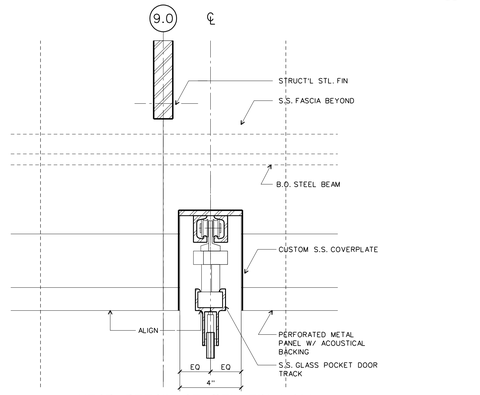


HEAD DETAIL AT STL. FIN L.M.L.-
POCKET DOOR

SCALE: 3"=1'-0" details/dtl-glassdr.dgn 31

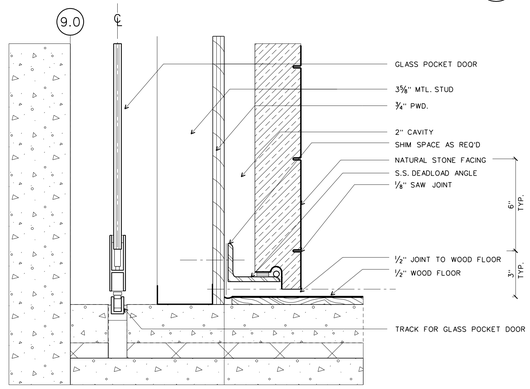


SECTION AT U.M.L. BASE/POCKET DOOR

SCALE: 3"=1'-0" details/dtl-glassdr.dgn 30

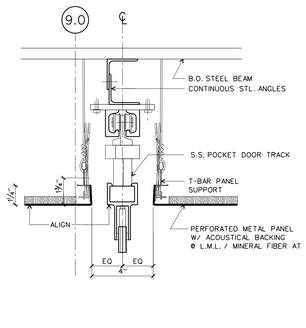


HEAD DETAIL AT L.M.L. (U.M.L. SIM.) -
GLASS POCKET DOOR

SCALE: 3"=1'-0" details/dtl-glassdr.dgn 21

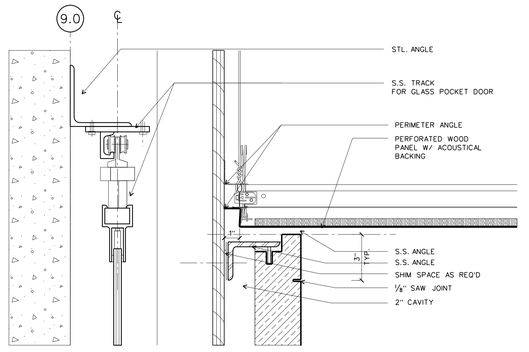


SECTION AT L.M.L. CEILING/POCKET DOOR

SCALE: 3"=1'-0" details/dtl-glassdr.dgn 20

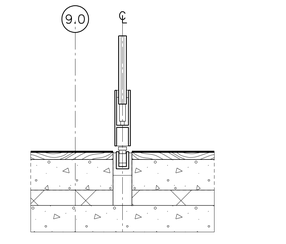

SILL DETAIL AT L.M.L. (U.M.L. SIM.) -
POCKET DOOR

SCALE: 3"=1'-0" details/dtl-glassdr.dgn 11

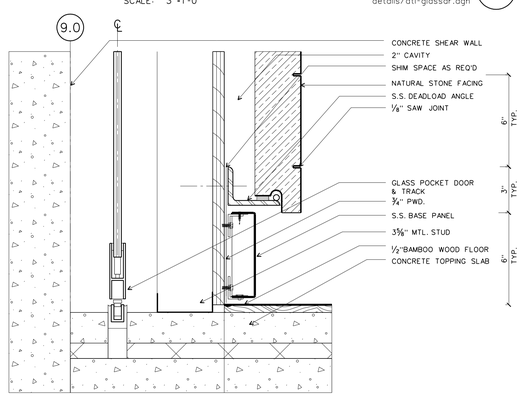

SECTION AT BASE/POCKET DOOR

SCALE: 3"=1'-0" details/dtl-glassdr.dgn 10

WILLIAM J. CLINTON PRESIDENTIAL CENTER

LITTLE ROCK, ARKANSAS

Architect
POLSHEK PARTNERSHIP LLP
320 West 13th Street
New York, New York 10014
212.807.7171

Coordinating Architects
POLK STANLEY YEARY ARCHITECTS Ltd
700 South Schiller Street
Little Rock, Arkansas 72201
501.378.0878

WITSELL EVANS RASCO
901 West Third Street
Little Rock, Arkansas 72201
501.374.5300

WOODS CARADINE ARCHITECTS
2200 South Main Street
Little Rock, Arkansas 72206
501.374.4060

Landscape Architects
HARGREAVES ASSOCIATES
118 Magazine Street
Cambridge, Massachusettes 02139
617.661.0070

LANDSCAPE ARCHITECTURE, Inc.
2300 Cottondale Lane Suite 202
Little Rock, Arkansas 72202
501.374.5610

Structural Engineer
LESLIE E. ROBERTSON ASSOC., RLLP
30 Broad Street, 47th Floor
New York, New York 10004
212.750.9000


MEP Engineers
FLACK + KURTZ Inc.
475 Fifth Avenue
New York, New York 10017
212.532.9600

CROMWELL ARCHITECTS ENGINEERS
101 South Spring Street
Little Rock, Arkansas 72201
501.372.2900

Curtainwall Consultant
R. A. HEINTGES ARCHITECTS
126 Fifth Avenue, 9th Floor
New York, New York 10011
212.652-2966

Seal

Issue	Date
1 Addenda #1	11/15/02

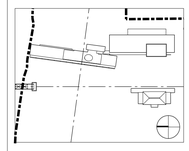

Job No. 9908

Scale 3" = 1'-0"

Date September 27, 2002

Title MUSEUM BUILDING INTERIOR DETAILS: STONE

Sheet No. A456

FOR OFFICIAL USE ONLY

DETAIL AT ESCALATOR UPPER LEVEL 33
SCALE: 3" = 1'-0"

DETAIL AT CATWALK SHADES 32
SCALE: 1½" = 1'-0"

DETAIL AT WOOD WALL GREAT HALL 31
SCALE: 3" = 1'-0"

DETAIL S.S. METAL PANEL AT CEILING 30
SCALE: 3" = 1'-0"

DETAIL AT ESCALATOR LOWER LEVEL 42
SCALE: 3" = 1'-0"

DETAIL AT CATWALK 41
SCALE: 3" = 1'-0"

DETAIL CATWALK AT STRUCTURAL FIN 21
SCALE: 3" = 1'-0"

DETAIL GRILL AT DOOR HEAD 20
SCALE: 3" = 1'-0"

DETAIL CATWALK AT STRUCTURAL FIN 13
SCALE: 3" = 1'-0"

DETAIL AT CATWALK 12
SCALE: 3" = 1'-0"

PLAN DETAIL AT STAIR 4 11
SCALE: 3" = 1'-0"

DETAIL AT STAIR 4, BASE AT GRILL 10
SCALE: 3" = 1'-0"

WILLIAM J. CLINTON PRESIDENTIAL CENTER

LITTLE ROCK, ARKANSAS

Architect

POLSHEK PARTNERSHIP LLP
320 West 13th Street
New York, New York 10014
212.807.7171

Coordinating Architects

POLK STANLEY YEARY ARCHITECTS Ltd
700 South Schiller Street
Little Rock, Arkansas 72201
501.378.0878

WITSELL EVANS RASCO
901 West Third Street
Little Rock, Arkansas 72201
501.374.5300

WOODS CARADINE ARCHITECTS
2200 South Main Street
Little Rock, Arkansas 72206
501.374.4060

Landscape Architects

HARGREAVES ASSOCIATES
118 Magazine Street
Cambridge, Massachusettes 02139
617.661.0070

LANDSCAPE ARCHITECTURE, Inc.
2300 Cottondale Lane Suite 202
Little Rock, Arkansas 72202
501.374.5610

Structural Engineer

LESLIE E. ROBERTSON ASSOC., RLLP
30 Broad Street, 47th Floor
New York, New York 10004
212.750.9000

MEP Engineers

FLACK + KURTZ Inc.
475 Fifth Avenue
New York, New York 10017
212.532.9600


CROMWELL ARCHITECTS ENGINEERS
101 South Spring Street
Little Rock, Arkansas 72201
501.372.2900

Curtainwall Consultant

R. A. HEINTGES ARCHITECTS
126 Fifth Avenue, 9th Floor
New York, New York 10011
212.652-2966

Seal

Issue	Date
ASI #23	09/12/03
ASI #20	06/06/03
ASI #19	05/07/03
ASI #18	04/18/03
Addendum #2	11/15/02
100% Construction Documents	09/27/02
100% Struct./ CD Progress	07/01/02

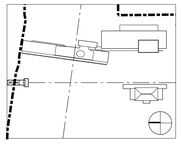

Job No.
9908


Scale
3" = 1'-0"

Date
September 27, 2002

Title
MUSEUM BUILDING INTERIOR DETAILS: METAL PANEL SYSTEMS


Sheet No.
A457

FOR OFFICIAL USE ONLY

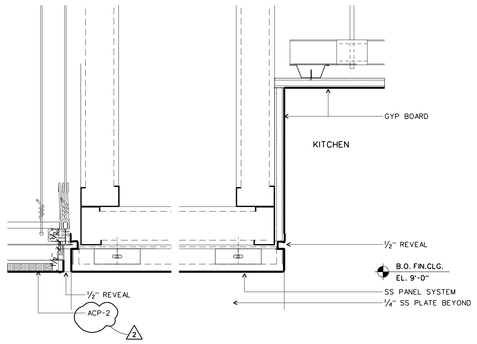

HEAD DETAIL AT SERVERY OPENING

SCALE: 3" = 1'-0" details/dtl-wd-02.dgn **43**

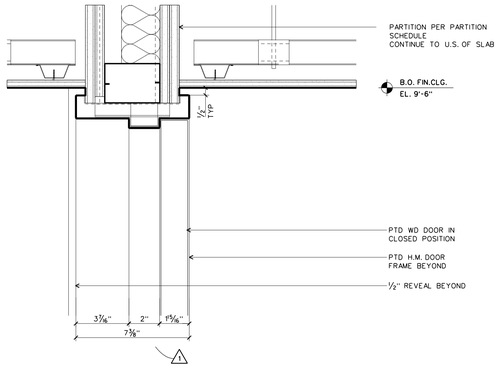


HEAD DETAIL AT HOLD OPEN DOOR

SCALE: 3" = 1'-0" details/dtl-wd-02.dgn **42**


NOT USED

41

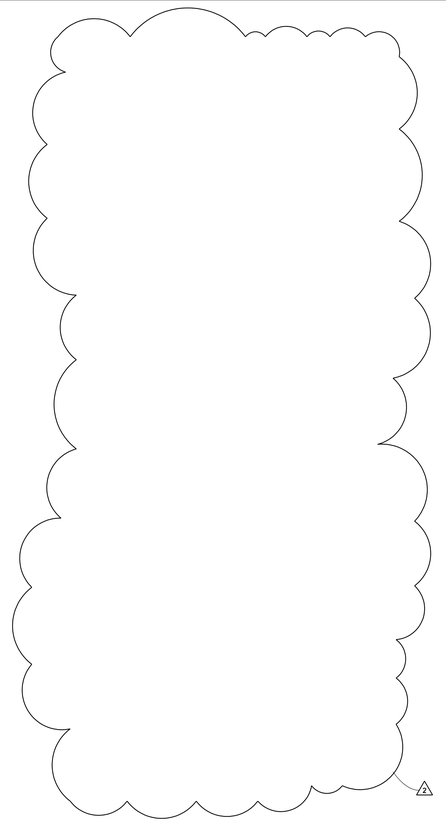


NOT USED

30

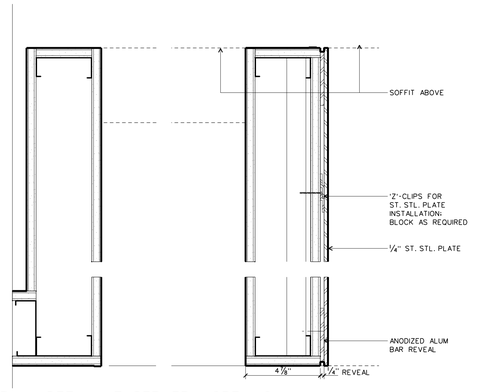


PLAN DETAIL AT SERVERY OPENING

SCALE: 3" = 1'-0" details/dtl-wd-02.dgn **33**

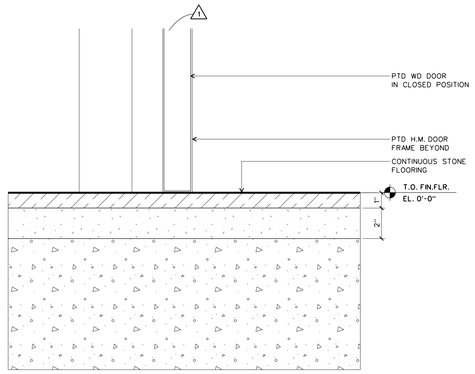

SILL DETAIL AT HOLD OPEN DOOR

SCALE: 3" = 1'-0" details/dtl-wd-02.dgn **32**

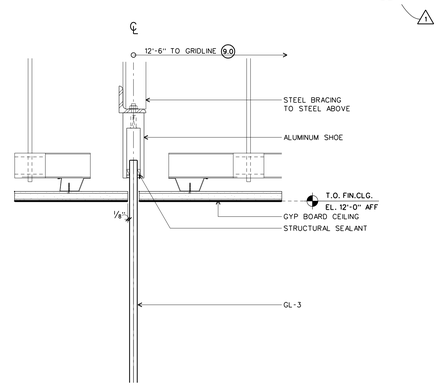


HEAD DETAIL AT FULL-HGT GLASS PARTITION

SCALE: 3" = 1'-0" details/dtl-wd-02.dgn **31**

NOT USED


20



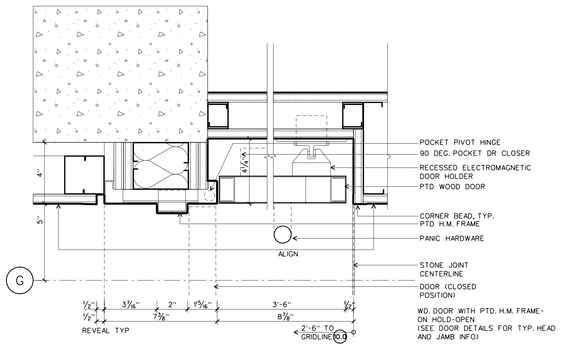

JAMB DETAIL AT HOLD OPEN DOOR

SCALE: 3" = 1'-0" details/dtl-wd-02.dgn **22**

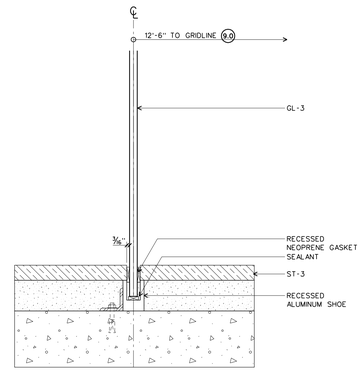


BASE DETAIL AT FULL-HGT GLASS PARTITION

SCALE: 3" = 1'-0" details/dtl-wd-02.dgn **21**

NOT USED

10

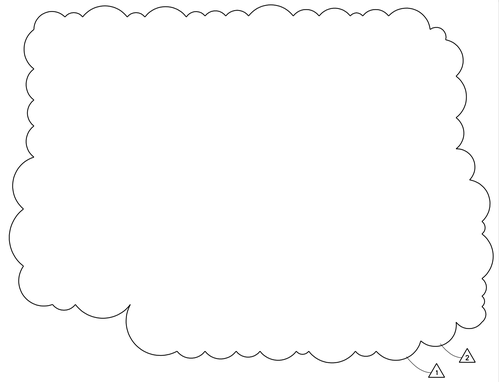

NOT USED


23

NOT USED

13

NOT USED

12

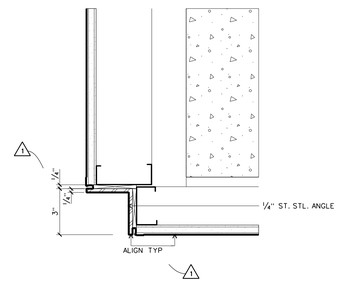

TYP. CORNER CONDITION

details/dtl-wd-02.dgn **11**

WILLIAM J. CLINTON PRESIDENTIAL CENTER

LITTLE ROCK, ARKANSAS

Architect

POLSHEK PARTNERSHIP LLP
320 West 13th Street
New York, New York 10014
212.807.7171

Coordinating Architects

POLK STANLEY YEARY ARCHITECTS Ltd
700 South Schiller Street
Little Rock, Arkansas 72201
501.378.0878

WITSELL EVANS RASCO
901 West Third Street
Little Rock, Arkansas 72201
501.374.5300

WOODS CARADINE ARCHITECTS
2200 South Main Street
Little Rock, Arkansas 72206
501.374.4060

Landscape Architects

HARGREAVES ASSOCIATES
118 Magazine Street
Cambridge, Massachusettes 02139
617.661.0070

LANDSCAPE ARCHITECTURE, Inc.
2300 Cottondale Lane Suite 202
Little Rock, Arkansas 72202
501.374.5610

Structural Engineer

LESLIE E. ROBERTSON ASSOC., RLLP
30 Broad Street, 47th Floor
New York, New York 10004
212.750.9000

MEP Engineers

FLACK + KURTZ Inc.
475 Fifth Avenue
New York, New York 10017
212.532.9600


CROMWELL ARCHITECTS ENGINEERS
101 South Spring Street
Little Rock, Arkansas 72201
501.372.2900

Curtainwall Consultant

R. A. HEINTGES ARCHITECTS
126 Fifth Avenue, 9th Floor
New York, New York 10011
212.652-2966

Seal

Issue	Date
2 ASI #23	09/12/03
1 ASI #20	06/06/03
100% Construction Documents	09/27/02
100% Struct./ CD Progress	07/01/02

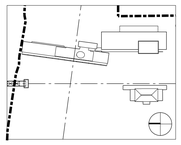

Job No. 9908

Scale

Date September 27, 2002

Title

MUSEUM BUILDING WOOD PANEL SYSTEM: DETAILS

Sheet No.

A458

FOR OFFICIAL USE ONLY


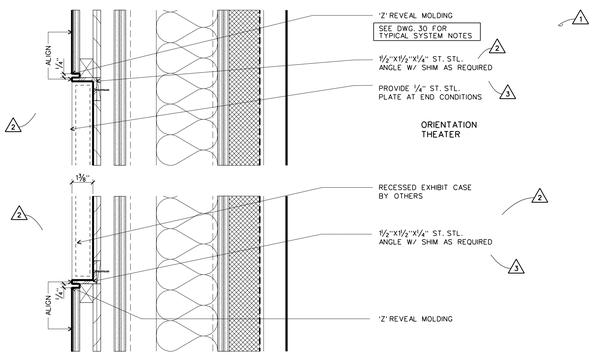



EXHIBIT DETAIL

SCALE: 3" = 1'-0" details/dtl-wd-03 **42**

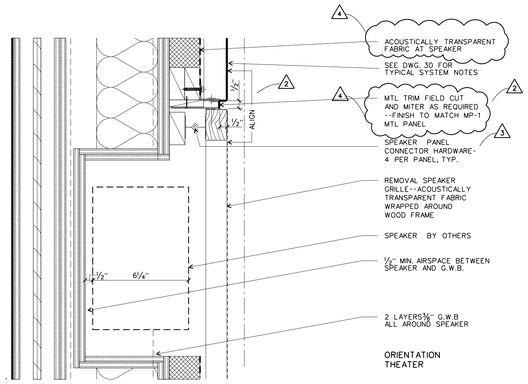


WOOD PANEL DETAIL AT WALL SPEAKER

SCALE: 3" = 1'-0" details/dtl-wd-03 **41**

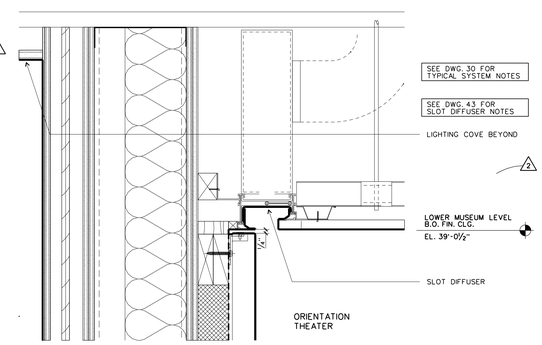


PANEL CEILING DETAIL AT ORIENTATION THEATER

SCALE: 3" = 1'-0" details/dtl-wd-03 **40**

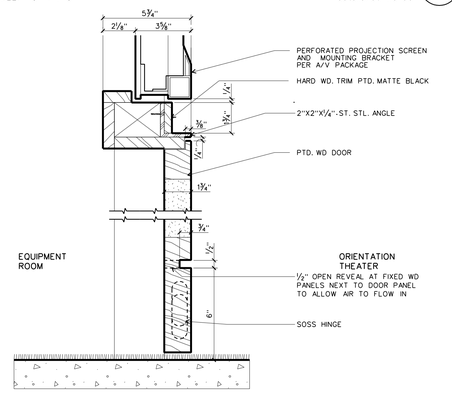


ACCESS PANEL DOOR HEAD & SILL AT ORIENTATION THEATER

SCALE: 3" = 1'-0" details/dtl-wd-03 **32**

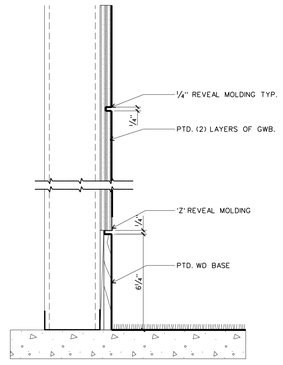


GWB. AND BASE AT ORIENTATION THEATER

SCALE: 3" = 1'-0" details/dtl-wd-03 **31**

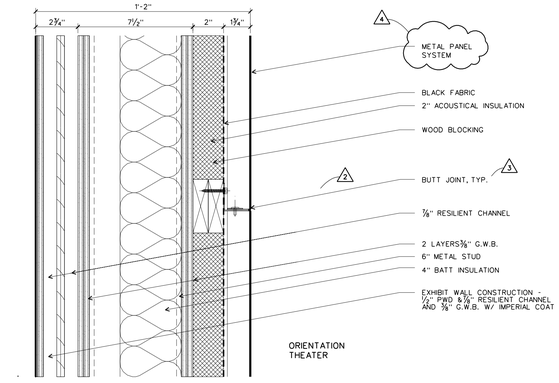


PANEL HORIZ. JOINT AT ORIENTATION THEATER

SCALE: 3" = 1'-0" details/dtl-wd-03 **30**

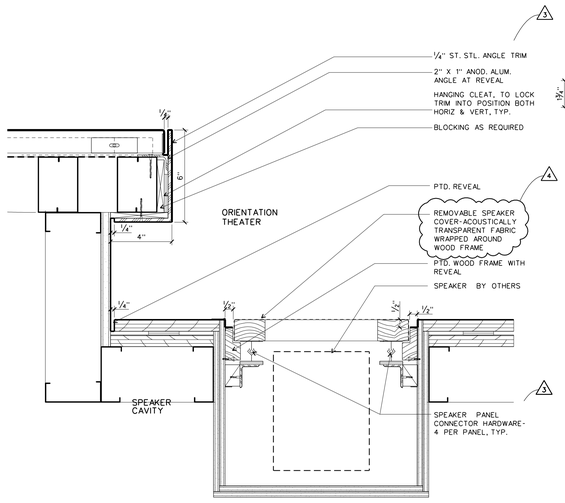


PLAN DETAIL AT ORIENTATION THEATER

SCALE: 3" = 1'-0" details/dtl-wd-02.dgn **13**

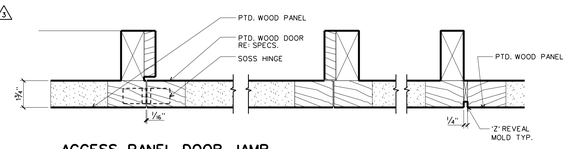


ACCESS PANEL DOOR JAMB AT ORIENTATION THEATER

SCALE: 3" = 1'-0" details/dtl-wd-03 **22**

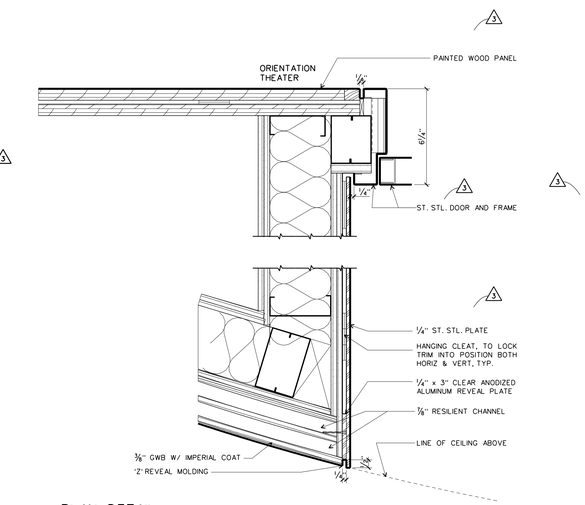


PLAN DETAIL AT ORIENTATION THEATER

SCALE: 3" = 1'-0" details/dtl-wd-03 **12**

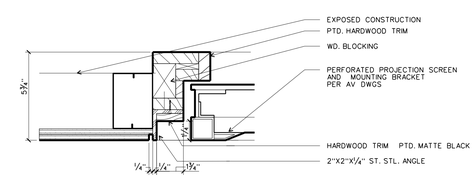


PROJECTION SCREEN FRAME

SCALE: 3" = 1'-0" details/dtl-wd-03 **21**

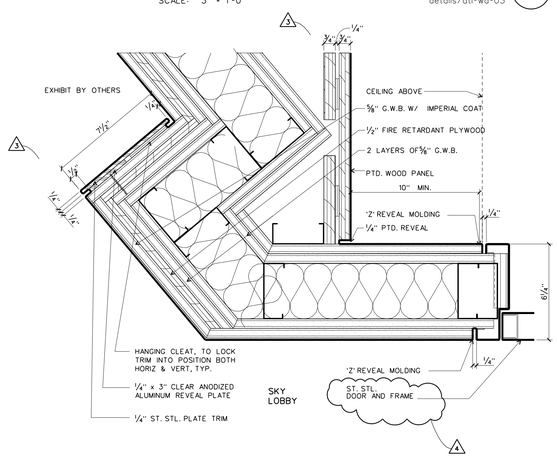


PLAN DETAIL AT ORIENTATION THEATER

SCALE: 3" = 1'-0" details/dtl-wd-03 **11**

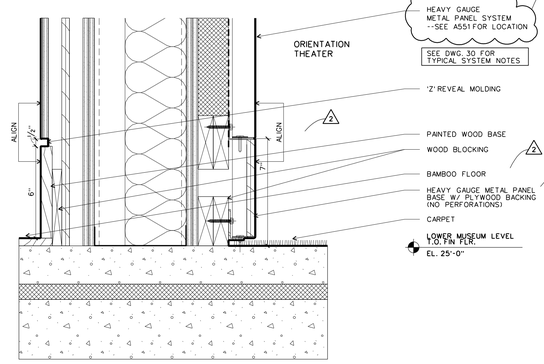

PANEL BASE DETAIL AT ORIENTATION THEATER

SCALE: 3" = 1'-0" details/dtl-wd-03 **20**

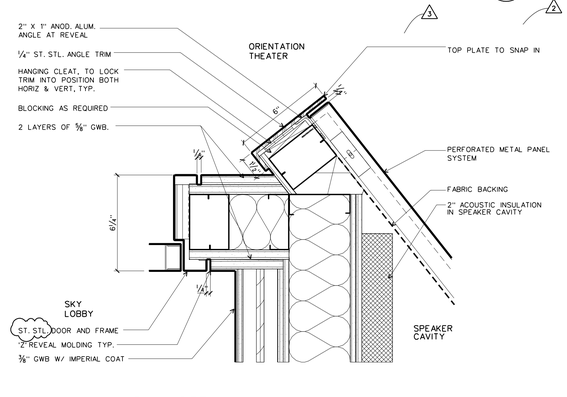

PLAN DETAIL AT ORIENTATION THEATER

SCALE: 3" = 1'-0" details/dtl-wd-03 **10**

WILLIAM J. CLINTON PRESIDENTIAL CENTER

LITTLE ROCK, ARKANSAS

Architect

POLSHEK PARTNERSHIP LLP
320 West 13th Street
New York, New York 10014
212.807.7171

Coordinating Architects

POLK STANLEY YEARY ARCHITECTS Ltd
700 South Schiller Street
Little Rock, Arkansas 72201
501.378.0878

WITSELL EVANS RASCO
901 West Third Street
Little Rock, Arkansas 72201
501.374.5300

WOODS CARADINE ARCHITECTS
2200 South Main Street
Little Rock, Arkansas 72206
501.374.4060

Landscape Architects

HARGREAVES ASSOCIATES
118 Magazine Street
Cambridge, Massachusettes 02139
617.661.0070

LANDSCAPE ARCHITECTURE, Inc.
2300 Cottondale Lane Suite 202
Little Rock, Arkansas 72202
501.374.5610

Structural Engineer

LESLIE E. ROBERTSON ASSOC., RLLP
30 Broad Street, 47th Floor
New York, New York 10004
212.750.9000

MEP Engineers

FLACK + KURTZ Inc.
475 Fifth Avenue
New York, New York 10017
212.532.9600


CROMWELL ARCHITECTS ENGINEERS
101 South Spring Street
Little Rock, Arkansas 72201
501.372.2900

Curtainwall Consultant

R. A. HEINTGES ARCHITECTS
126 Fifth Avenue, 9th Floor
New York, New York 10011
212.652-2966

Seal

	Issue	Date
7	ASI #23	09/12/03
6	ASI #20	06/06/03
5	ASI #18	04/18/03
4	ASI # 15	02/28/03
	100% Construction Documents	09/27/02
	100% Struct./ CD Progress	07/01/02

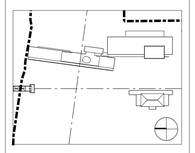

Job No. 9908

Scale

Date September 27, 2002


Title

MUSEUM BUILDING WOOD PANEL SYSTEM: DETAILS

Sheet No.


A459

FOR OFFICIAL USE ONLY

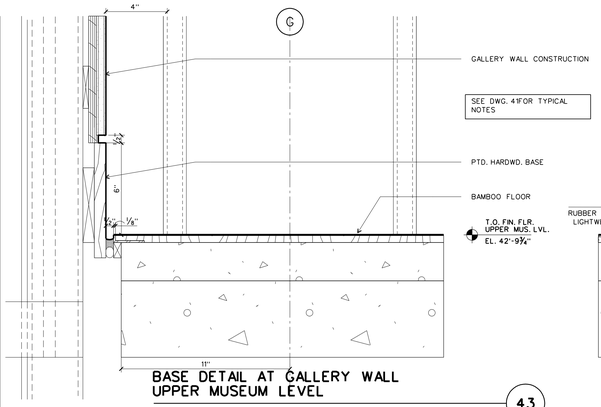


BASE DETAIL AT GALLERY WALL UPPER MUSEUM LEVEL

SCALE: 3"=1'-0" details/dtl-wd-01 **43**

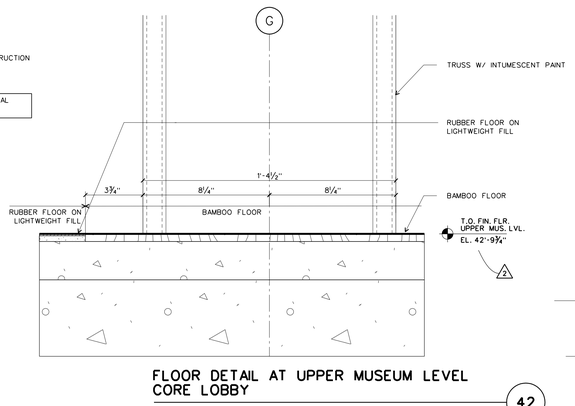


FLOOR DETAIL AT UPPER MUSEUM LEVEL CORE LOBBY

SCALE: 3"=1'-0" details/dtl-wd-01 **42**

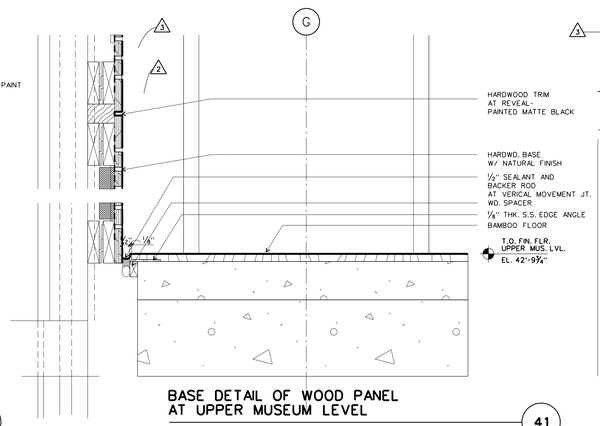


BASE DETAIL OF WOOD PANEL AT UPPER MUSEUM LEVEL

SCALE: 3"=1'-0" details/dtl-wd-01 **41**

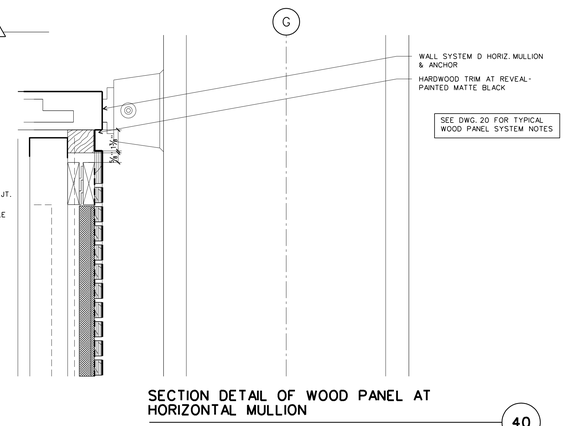


SECTION DETAIL OF WOOD PANEL AT HORIZONTAL MULLION

SCALE: 3"=1'-0" details/dtl-wd-01 **40**

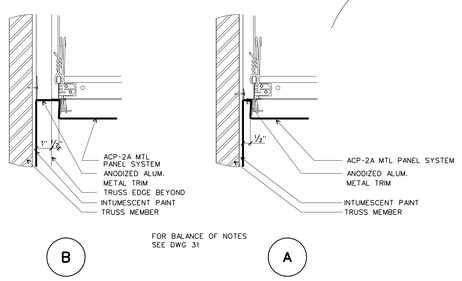


LOWER MUSEUM LEVEL CEILING DETAIL AT TRUSS

SCALE: 3"=1'-0" details/dtl-wd-01 **33**

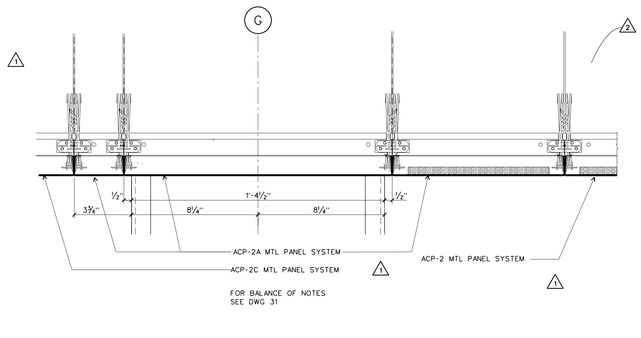


LOWER MUSEUM LEVEL CEILING DETAIL AT CORE LOBBY

SCALE: 3"=1'-0" details/dtl-wd-01 **32**

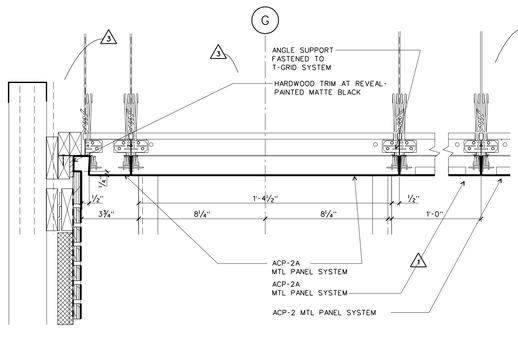


LOWER MUSEUM LEVEL CEILING DETAIL AT WOOD PANEL

SCALE: 3"=1'-0" details/dtl-wd-01 **31**

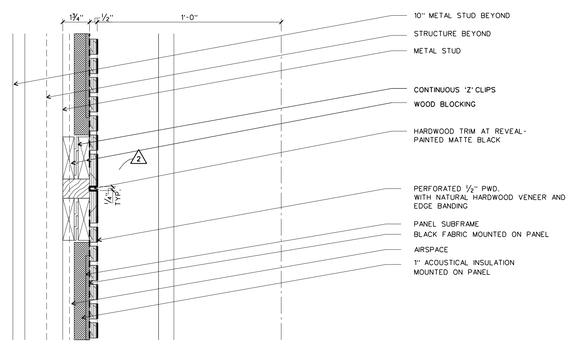


TYP. HORIZ. JOINT AT WOOD PANEL (VERTICAL SIMILAR)

SCALE: 3"=1'-0" details/dtl-wd-01 **30**

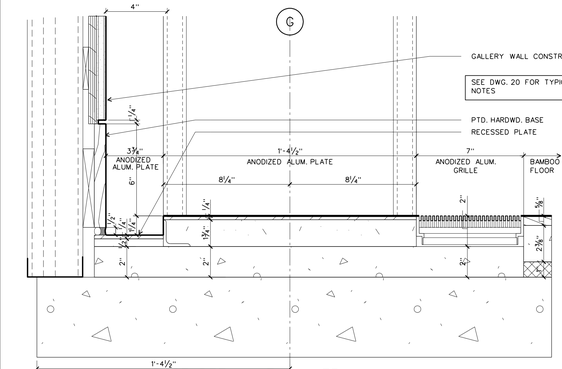


BASE DETAIL AT GALLERY WALL LOWER MUSEUM LEVEL

SCALE: 3"=1'-0" details/dtl-wd-01 **23**

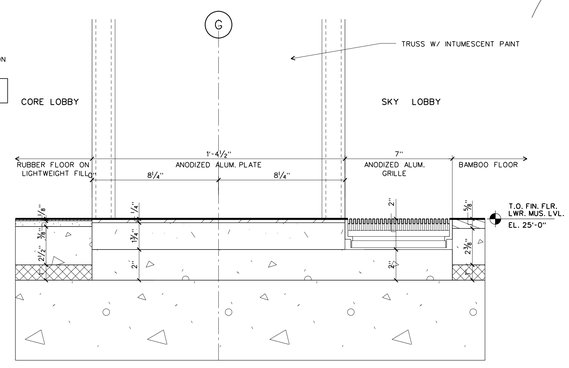


FLOOR DETAIL AT LOWER MUSEUM LEVEL CORE LOBBY

SCALE: 3"=1'-0" details/dtl-wd-01 **22**

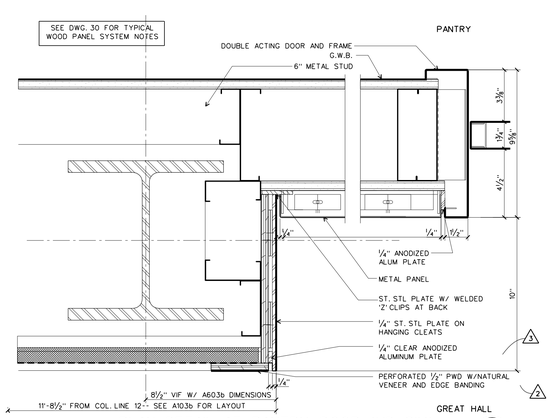


PLAN DETAIL AT PANTRY DOOR (HD SIM)

SCALE: 3"=1'-0" details/dtl-wd-01 **21**

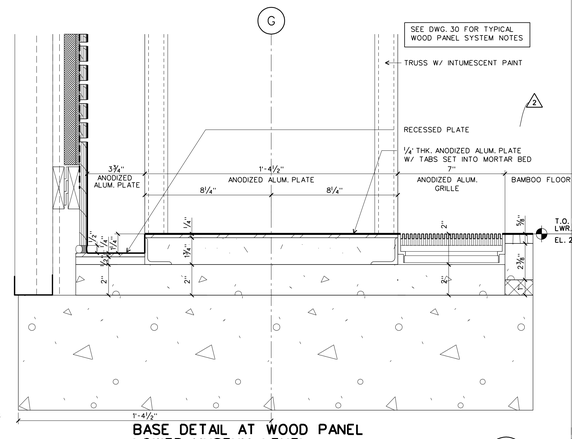


BASE DETAIL AT WOOD PANEL LOWER MUSEUM LEVEL

SCALE: 3"=1'-0" details/dtl-wd-01 **20**

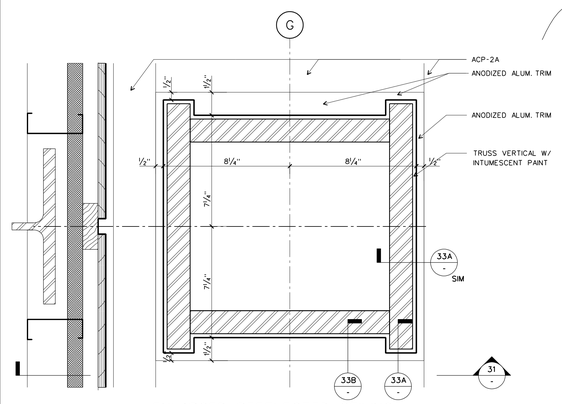


ENLARGED REFELECTED CEILING PLAN AT TRUSS

SCALE: 3"=1'-0" details/dtl-wd-01 **13**

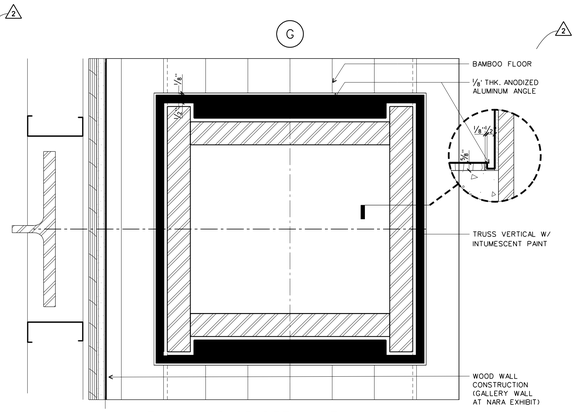


TYPICAL BASE DETAIL AT TRUSS MEMBERS - UPPER MUSEUM LEVEL

SCALE: 3"=1'-0" details/dtl-wd-01 **12**

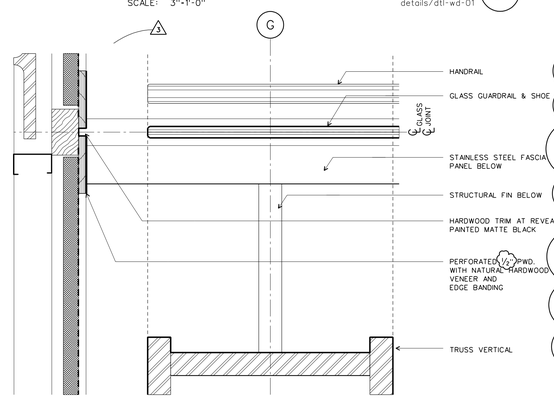

VERTICAL JOINT AT UPPER MUSEUM LEVEL BASE

SCALE: 3"=1'-0" details/dtl-wd-01 **11**

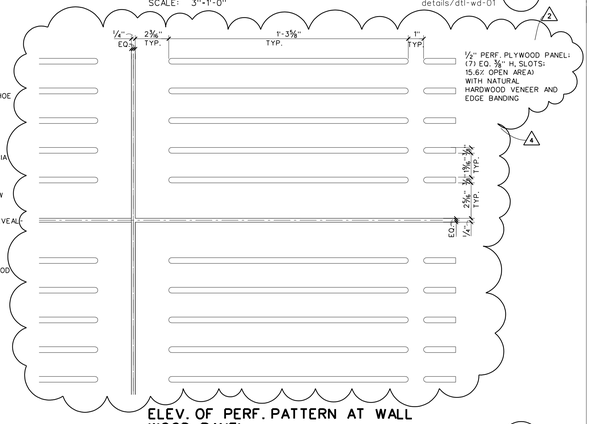

ELEV. OF PERF. PATTERN AT WALL WOOD PANEL

SCALE: 3"=1'-0" details/dtl-wd-01 **10**

WILLIAM J. CLINTON PRESIDENTIAL CENTER

LITTLE ROCK, ARKANSAS

Architect

POLSHEK PARTNERSHIP LLP
320 West 13th Street
New York, New York 10014
212.807.7171

Coordinating Architects

POLK STANLEY YEARY ARCHITECTS Ltd
700 South Schiller Street
Little Rock, Arkansas 72201
501.378.0878

WITSELL EVANS RASCO
901 West Third Street
Little Rock, Arkansas 72201
501.374.5300

WOODS CARADINE ARCHITECTS
2200 South Main Street
Little Rock, Arkansas 72206
501.374.4060

Landscape Architects

HARGREAVES ASSOCIATES
118 Magazine Street
Cambridge, Massachusettes 02139
617.661.0070

LANDSCAPE ARCHITECTURE, Inc.
2300 Cottondale Lane Suite 202
Little Rock, Arkansas 72202
501.374.5610

Structural Engineer

LESLIE E. ROBERTSON ASSOC., RLLP
30 Broad Street, 47th Floor
New York, New York 10004
212.750.9000

MEP Engineers

FLACK + KURTZ Inc.
475 Fifth Avenue
New York, New York 10017
212.532.9600

CROMWELL ARCHITECTS ENGINEERS
101 South Spring Street
Little Rock, Arkansas 72201
501.372.2900

Curtainwall Consultant

R. A. HEINTGES ARCHITECTS
126 Fifth Avenue, 9th Floor
New York, New York 10011
212.652-2966

Seal

4	ASI # 25	12/19/03
3	ASI # 23	09/12/03
2	ASI # 20	06/06/03
1	ASI # 18	04/18/03
	100% Construction Documents	09/27/02
	100% Struct./ CD Progress	07/01/02
	Issue	Date

Job No. 9908

Scale


Date September 27, 2002

Title

MUSEUM BUILDING WOOD PANEL SYSTEM: DETAILS


Sheet No. A460

FOR OFFICIAL USE ONLY

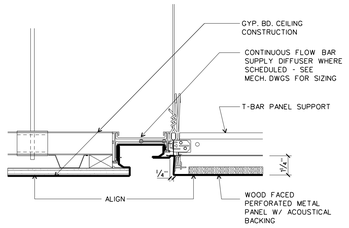


DETAIL AT METAL PANEL & GYP. BD CEILING

SCALE: 3 " = 1'-0" D-CEILING-1.DGN **55**

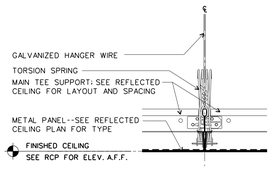


TYP. DETAIL AT METAL PANEL CEILING

SCALE: 3 " = 1'-0" D-CEILING-1.DGN **24**

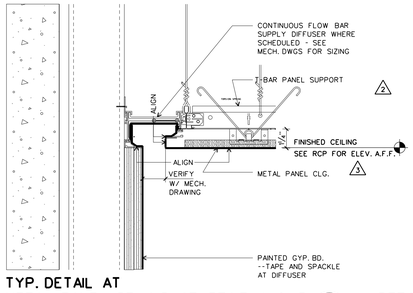


TYP. DETAIL AT METAL PANEL CEILING AT STAIR 4 & 5

SCALE: 3 " = 1'-0" D-CEILING-1.DGN **54**

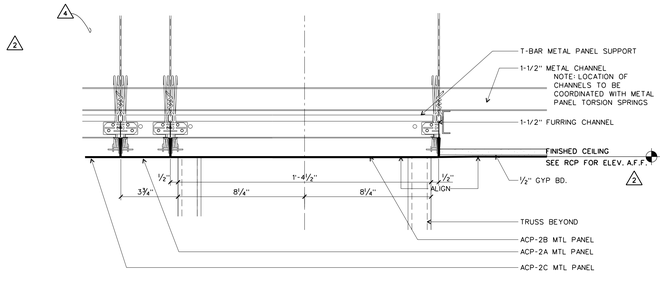


DETAIL AT TRUSS AT UPPER MUSEUM LEVEL CEILING

SCALE: 3 " = 1'-0" **52**

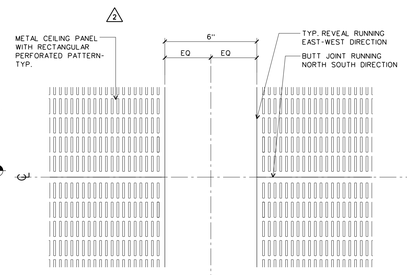


ENLARGED PLAN OF TYPICAL WOOD FINISH PERFORATED PANEL PATTERN

SCALE: 3 " = 1'-0" D-CEILING-1.DGN **51**

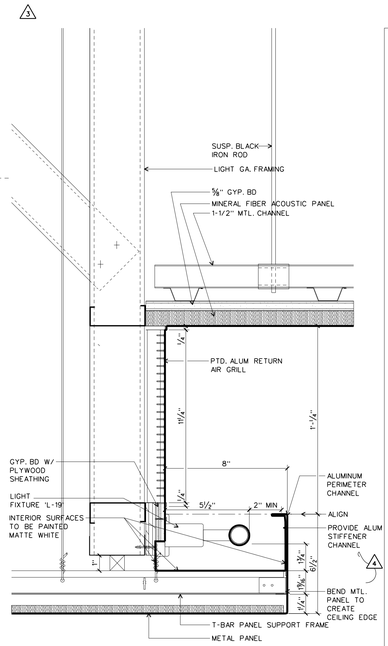


LIGHT COVE DETAIL AT UPPER MUSEUM LEVEL CEILING

SCALE: 3 " = 1'-0" D-CEILING-1.DGN **40**

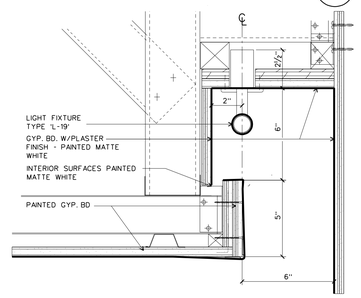


UPPER MUSEUM LEVEL LIGHT COVE DETAIL AT OVAL OFFICE

SCALE: 3 " = 1'-0" D-CEILING-1.DGN **42**

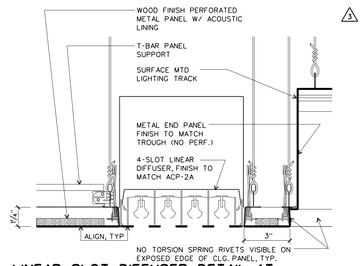


LINEAR SLOT DIFFUSER DETAIL AT UPPER MUSEUM LEVEL CEILING

SCALE: 3 " = 1'-0" D-CEILING-1.DGN **41**

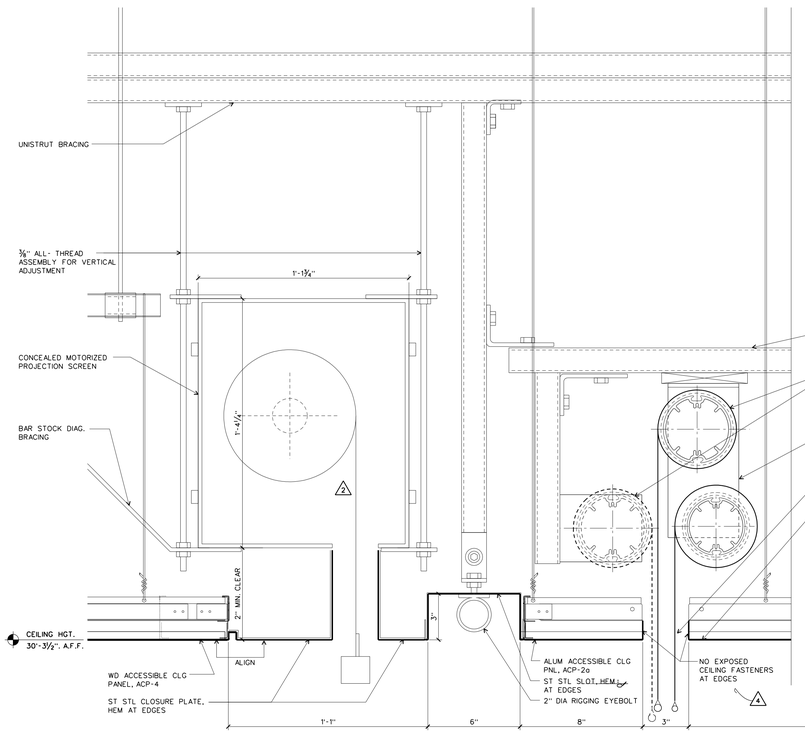


SHADE/ PROJ SCREEN DETAIL AT GREAT HALL CEILING SOUTH

SCALE: 3 " = 1'-0" D-CEILING-1.DGN **23**

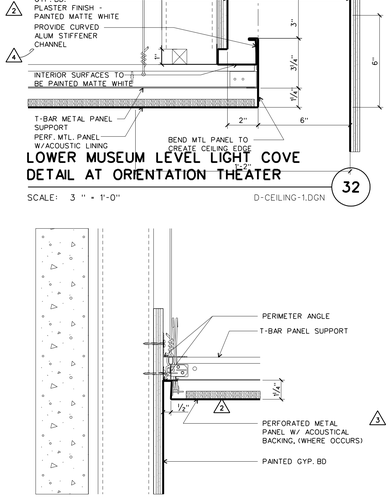


TYP. METAL CEILING DETAIL AT GYP. BD. WALL

SCALE: 3 " = 1'-0" D-CEILING-1.DGN **22**

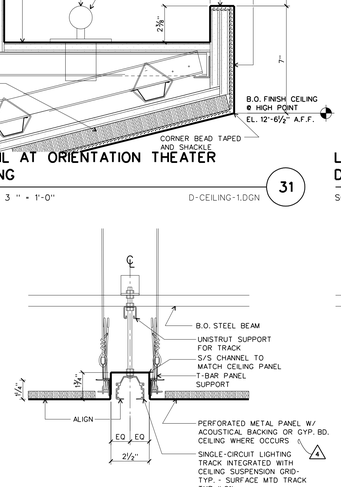


TYP. CEILING DETAIL AT RECESSED TRACK LIGHTS AT LWR MUSEUM LVL

SCALE: 3 " = 1'-0" D-CEILING-1.DGN **21**

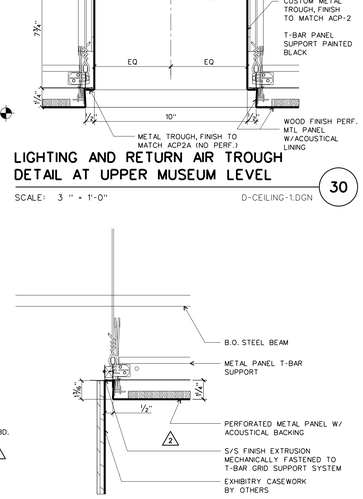


METAL PANEL CEILING DETAIL AT LOWER MUSEUM LEVEL

SCALE: 3 " = 1'-0" D-CEILING-1.DGN **20**

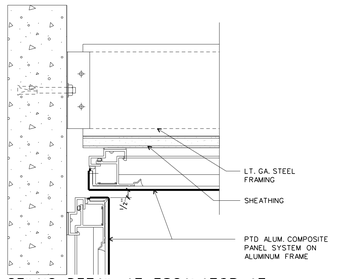

CEILNG DETAIL AT ESCALATOR AT GROUND LEVEL

SCALE: 3 " = 1'-0" D-CEILING-1.DGN **15**

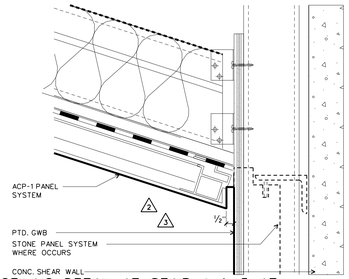


CEILING DETAIL AT STAIR 4 & 5 AT GROUND LEVEL

SCALE: 3 " = 1'-0" D-CEILING-1.DGN **14**


NOT USED

SCALE: **13**

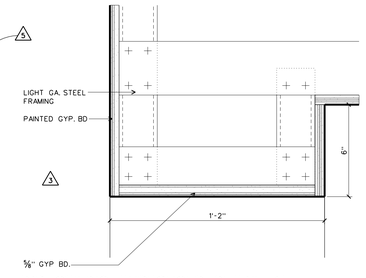


TYP. CEILING THRESHOLD DETAIL AT DRINKING FOUNTAINS

SCALE: 3 " = 1'-0" D-CEILING-1.DGN **12**

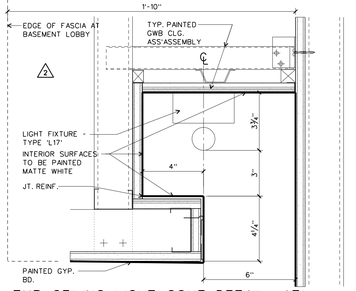


TYP. CEILING LIGHT COVE DETAIL AT DRINKING FOUNTAINS & BASEMENT LOBBY

SCALE: 3 " = 1'-0" D-CEILING-1.DGN **11**

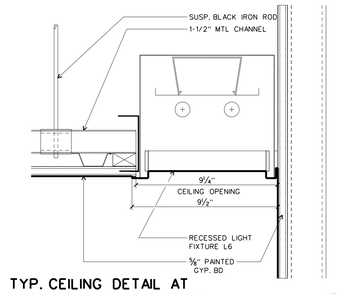

TYP. CEILING DETAIL AT RESTROOM LIGHT FIXTURE

SCALE: 3 " = 1'-0" D-CEILING-1.DGN **10**

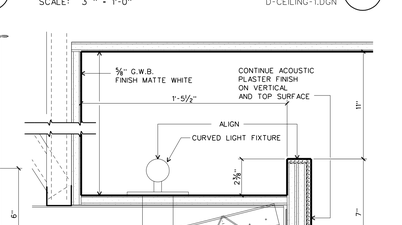

LIGHTING AND RETURN AIR TROUGH DETAIL AT UPPER MUSEUM LEVEL

SCALE: 3 " = 1'-0" D-CEILING-1.DGN **30**

WILLIAM J. CLINTON PRESIDENTIAL CENTER

LITTLE ROCK, ARKANSAS

Architect

POLSHEK PARTNERSHIP LLP
320 West 13th Street
New York, New York 10014
212.807.7171

Coordinating Architects

POLK STANLEY YEARY ARCHITECTS Ltd
700 South Schiller Street
Little Rock, Arkansas 72201
501.378.0878

WITSELL EVANS RASCO
901 West Third Street
Little Rock, Arkansas 72201
501.374.5300

WOODS CARADINE ARCHITECTS
2200 South Main Street
Little Rock, Arkansas 72206
501.374.4060

Landscape Architects

HARGREAVES ASSOCIATES
118 Magazine Street
Cambridge, Massachusettes 02139
617.661.0070

LANDSCAPE ARCHITECTURE, Inc.
2300 Cottondale Lane Suite 202
Little Rock, Arkansas 72202
501.374.5610

Structural Engineer

LESLIE E. ROBERTSON ASSOC., RLLP
30 Broad Street, 47th Floor
New York, New York 10004
212.750.9000

MEP Engineers

FLACK + KURTZ Inc.
475 Fifth Avenue
New York, New York 10017
212.532.9600


CROMWELL ARCHITECTS ENGINEERS
101 South Spring Street
Little Rock, Arkansas 72201
501.372.2900

Curtainwall Consultant

R. A. HEINTGES ARCHITECTS
126 Fifth Avenue, 9th Floor
New York, New York 10011
212.652-2966

Seal

3	ASI #23	09/12/03
2	ASI #20	08/06/03
1	ASI #19	05/07/03
2	ASI #18	04/18/03
1	Addendum #2	11/15/02
	100% Construction Documents	09/27/02
	Issue	Date

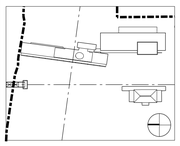

Job No. 9908

Scale 3" = 1'-0"

Date September 27, 2002


Title

CEILING DETAILS

Sheet No.


A461

FOR OFFICIAL USE ONLY

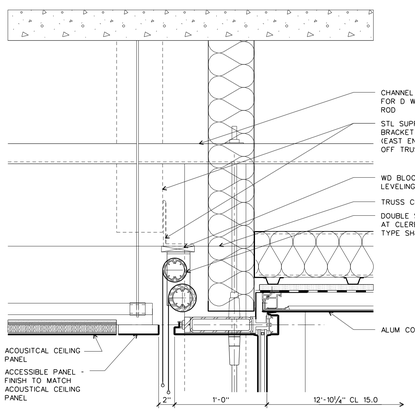


SHADE DETAIL - GREAT HALL SOUTH ELEV.

SCALE: 1-1/2" = 1'-0" D-I-CEILING-3 **33**

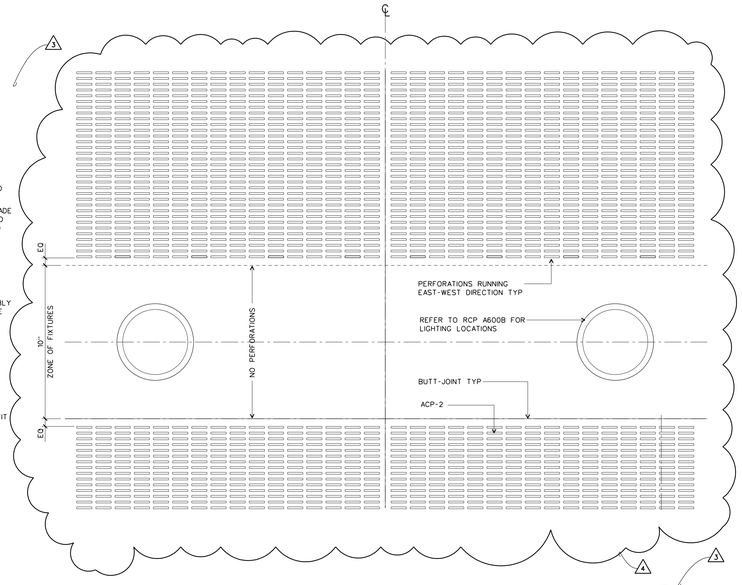


PLAN DETAIL OF PERFORATED CAFE WOOD CEILING

SCALE: 3 " = 1'-0" **32**

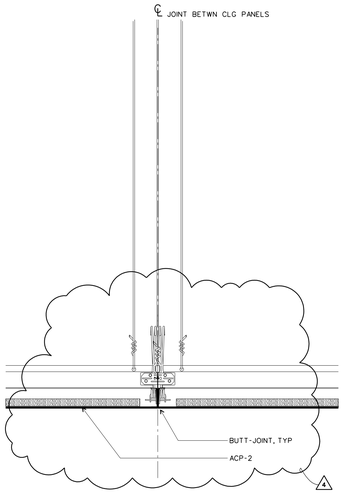


TYP JOINT AT CAFE WD CLG

SCALE: 3 " = 1'-0" **31**

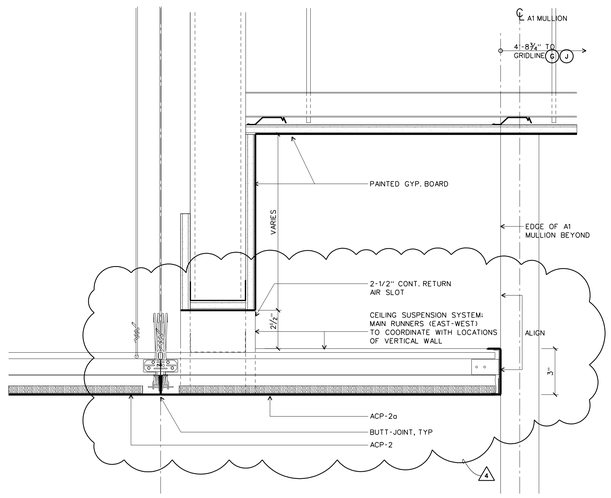


SECT DETAIL: EDGE OF WD CAFE CLG W/RETURN AIR SLOT

SCALE: 3 " = 1'-0" **30**

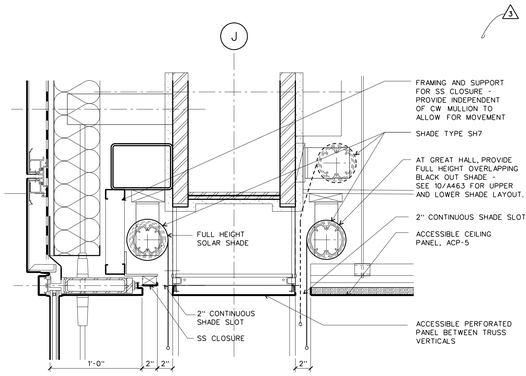


SHADE DETAIL - GREAT HALL WEST ELEV.

SCALE: 1-1/2" = 1'-0" D-I-CEILING-3 **23**

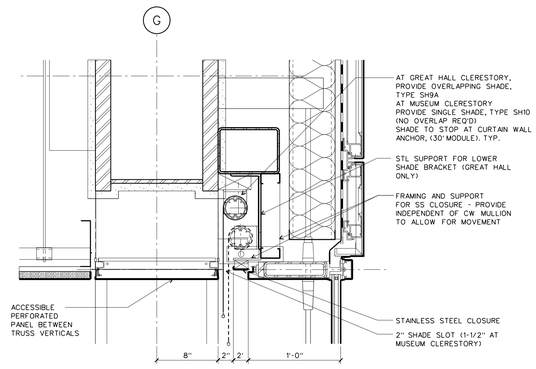


SHADE DETAIL - EAST ELEV. CLERESTORY

SCALE: 1-1/2" = 1'-0" D-I-CEILING-3 **22**

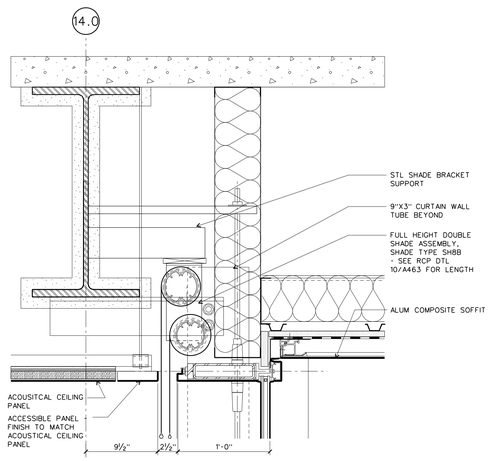


SHADE DETAIL - GREAT HALL SOUTH ELEV

SCALE: 1-1/2" = 1'-0" D-I-CEILING-3 **13**

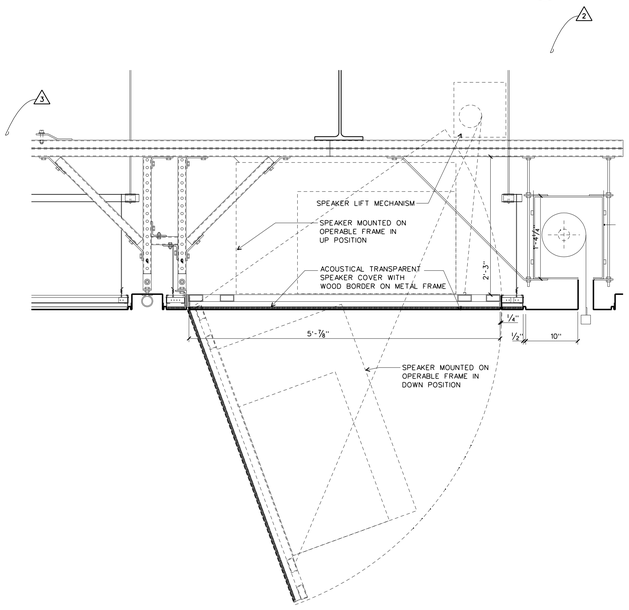

SPEAKER DETAIL - GREAT HALL

SCALE: 1" = 1'-0" D-I-CEILING-3 **11**

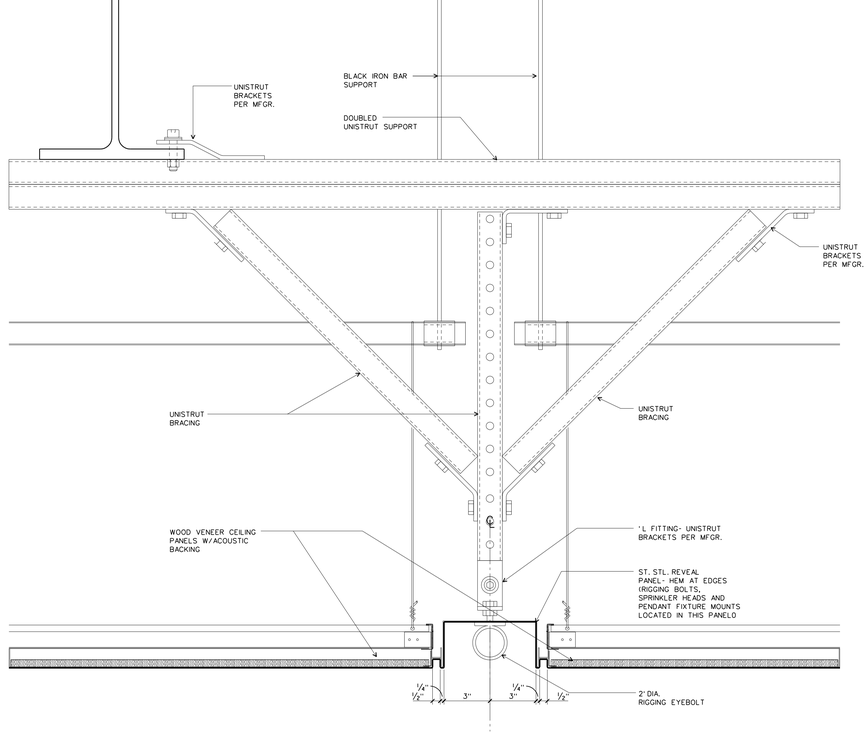

WOOD PANEL CEILING AT REVEAL PANEL

SCALE: 3 " = 1'-0" D-I-CEILING-3 **10**

WILLIAM J. CLINTON PRESIDENTIAL CENTER

LITTLE ROCK, ARKANSAS

Architect

POLSHEK PARTNERSHIP LLP
320 West 13th Street
New York, New York 10014
212.807.7171

Coordinating Architects

POLK STANLEY YEARY ARCHITECTS Ltd
700 South Schiller Street
Little Rock, Arkansas 72201
501.378.0878

WITSELL EVANS RASCO
901 West Third Street
Little Rock, Arkansas 72201
501.374.5300

WOODS CARADINE ARCHITECTS
2200 South Main Street
Little Rock, Arkansas 72206
501.374.4060

Landscape Architects

HARGREAVES ASSOCIATES
118 Magazine Street
Cambridge, Massachusettes 02139
617.661.0070

LANDSCAPE ARCHITECTURE, Inc.
2300 Cottondale Lane Suite 202
Little Rock, Arkansas 72202
501.374.5610

Structural Engineer

LESLIE E. ROBERTSON ASSOC., RLLP
30 Broad Street, 47th Floor
New York, New York 10004
212.750.9000

MEP Engineers

FLACK + KURTZ Inc.
475 Fifth Avenue
New York, New York 10017
212.532.9600

CROMWELL ARCHITECTS ENGINEERS
101 South Spring Street
Little Rock, Arkansas 72201
501.372.2900

Curtainwall Consultant

R. A. HEINTGES ARCHITECTS
126 Fifth Avenue, 9th Floor
New York, New York 10011
212.652-2966

Seal

Issue	Date
1 ASI #23	09/12/03
1 ASI #19	05/07/03
1 ASI #18	4/18/03
1 Addendum #2	11/15/02

Job No. 9908


Scale


Date September 27, 2002

Title CEILING DETAILS

Sheet No. 1 A462

FOR OFFICIAL USE ONLY

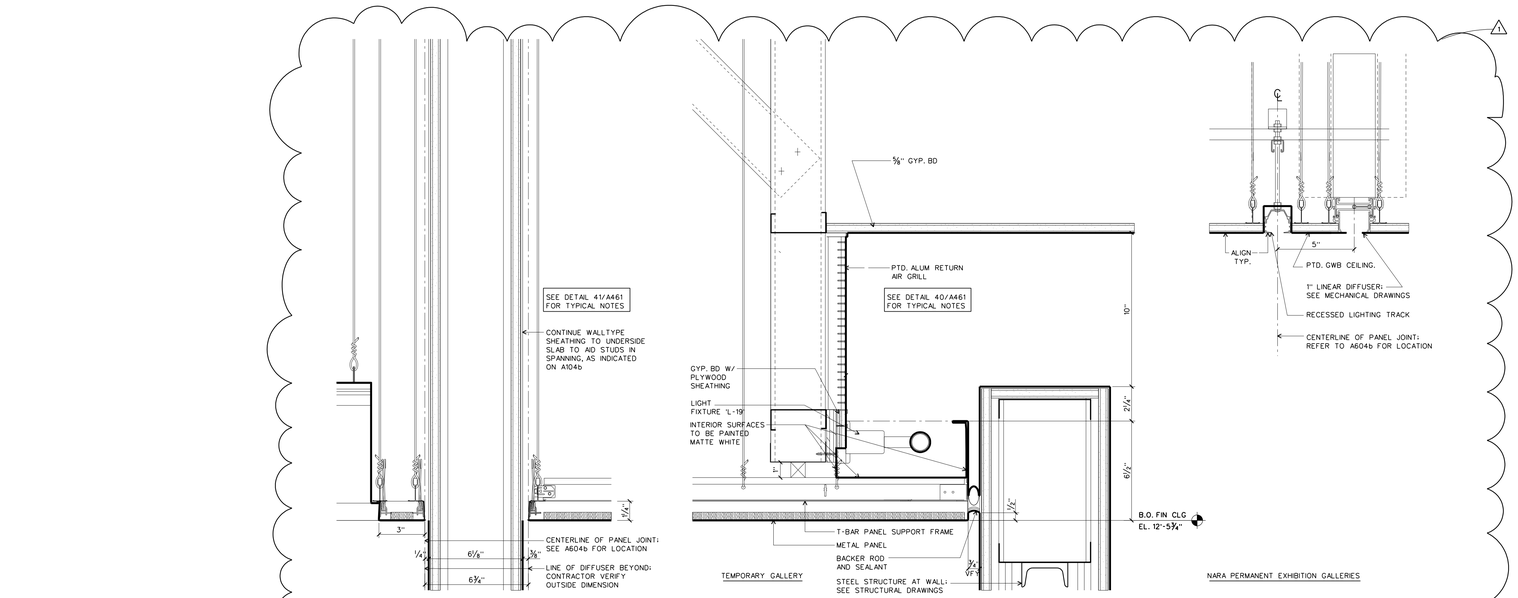

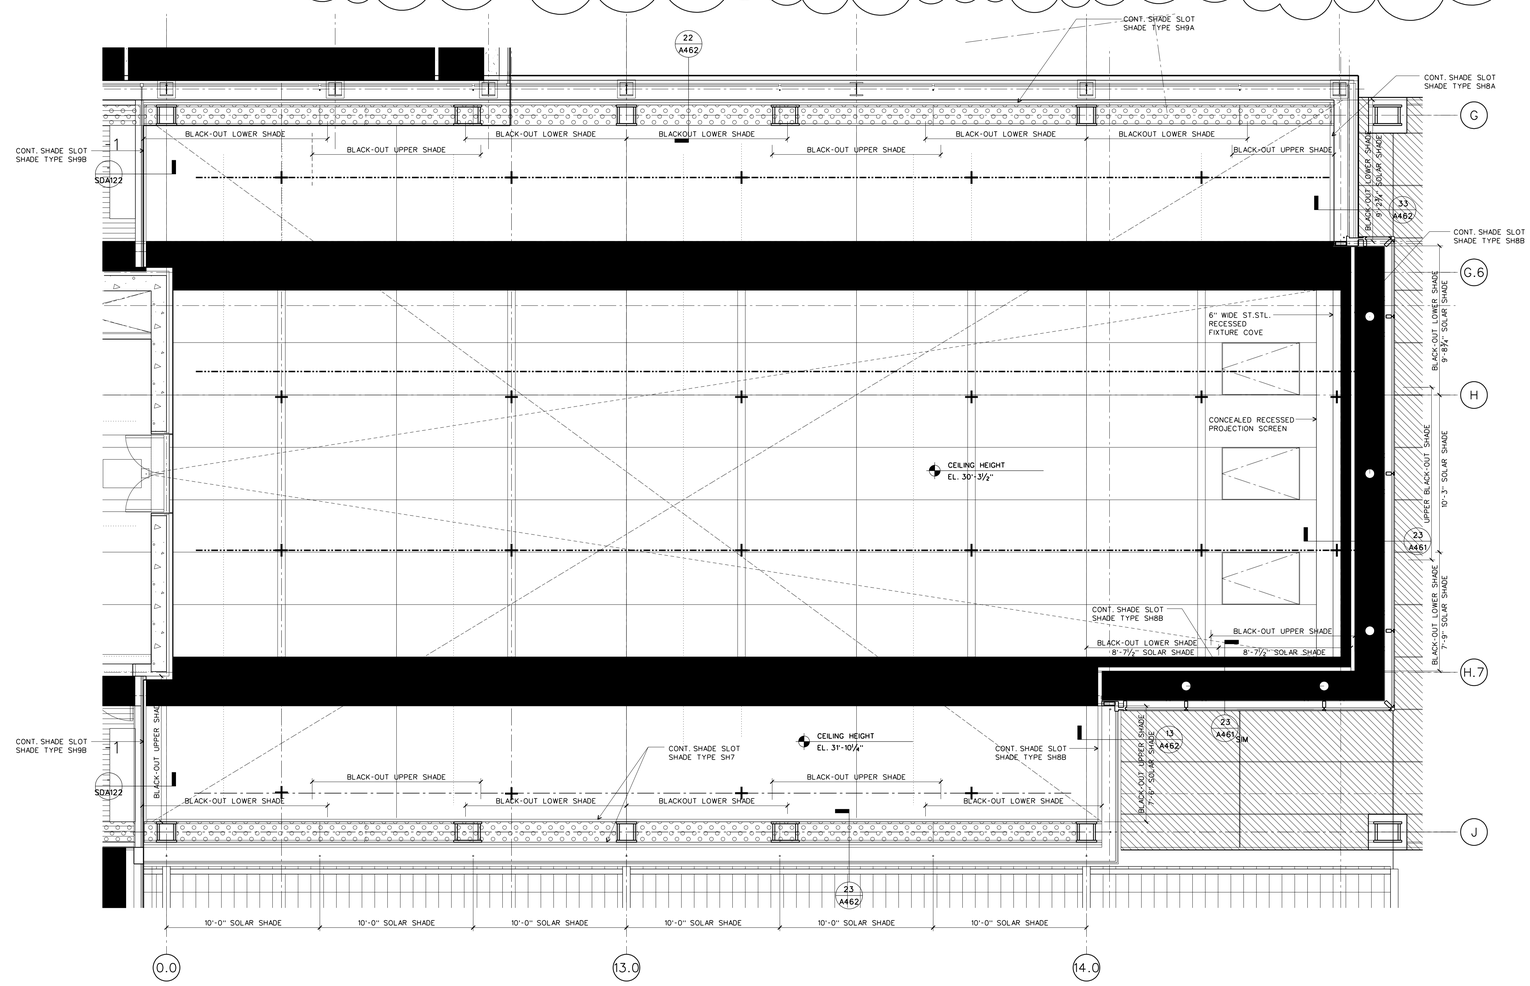

GREAT HALL - PARTIAL REFLECTED CEILING PLAN

SCALE: ¼" = 1'-0"

d-i-ceiling-4

10

WILLIAM J. CLINTON PRESIDENTIAL CENTER

LITTLE ROCK, ARKANSAS

Architect

POLSHEK PARTNERSHIP LLP
320 West 13th Street
New York, New York 10014
212.807.7171

Coordinating Architects

POLK STANLEY YEARY ARCHITECTS Ltd
700 South Schiller Street
Little Rock, Arkansas 72201
501.378.0878

WITSELL EVANS RASCO
901 West Third Street
Little Rock, Arkansas 72201
501.374.5300

WOODS CARADINE ARCHITECTS
2200 South Main Street
Little Rock, Arkansas 72206
501.374.4060

Landscape Architects

HARGREAVES ASSOCIATES
118 Magazine Street
Cambridge, Massachusettes 02139
617.661.0070

LANDSCAPE ARCHITECTURE, Inc.
2300 Cottondale Lane Suite 202
Little Rock, Arkansas 72202
501.374.5610

Structural Engineer

LESLIE E. ROBERTSON ASSOC., RLLP
30 Broad Street, 47th Floor
New York, New York 10004
212.750.9000

MEP Engineers

FLACK + KURTZ Inc.
475 Fifth Avenue
New York, New York 10017
212.532.9600

CROMWELL ARCHITECTS ENGINEERS
101 South Spring Street
Little Rock, Arkansas 72201
501.372.2900

Curtainwall Consultant

R. A. HEINTGES ARCHITECTS
126 Fifth Avenue, 9th Floor
New York, New York 10011
212.652-2966

Seal

Issue	Date
1 ASI #23	09/12/03
ASI #19	05/07/03

Job No. 9908


Scale AS NOTED

Date September 27, 2002

Title
GREAT HALL ENLARGED REFLECTED CEILING PLAN


Sheet No. SDA-121
A463

FOR OFFICIAL USE ONLY

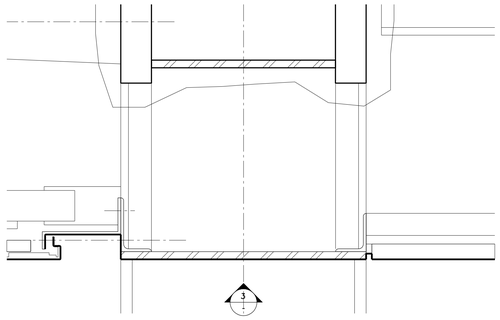


SECTION DETAIL AT TRUSS AT CEILING

SCALE: 3 " = 1'-0" DTL-TRUSS BASE-CLG 41

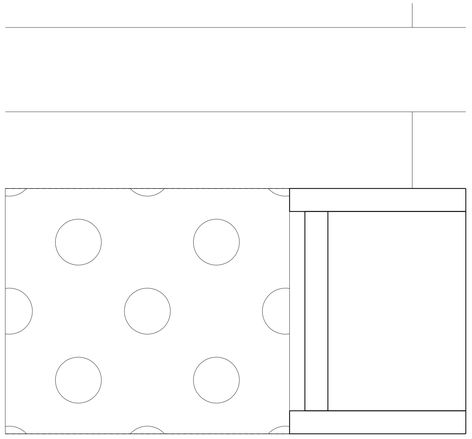


PLAN DETAIL AT TRUSS AT CEILING

SCALE: 3 " = 1'-0" DTL-TRUSS BASE-CLG 31

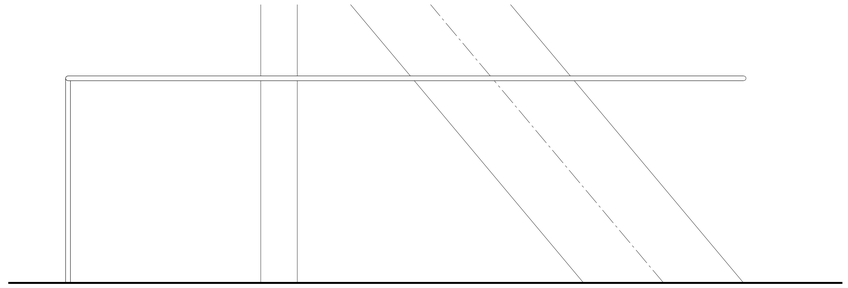


ELEVATION AT CANE RAIL

SCALE: 1½" = 1'-0" DTL-CANE RAILS 40

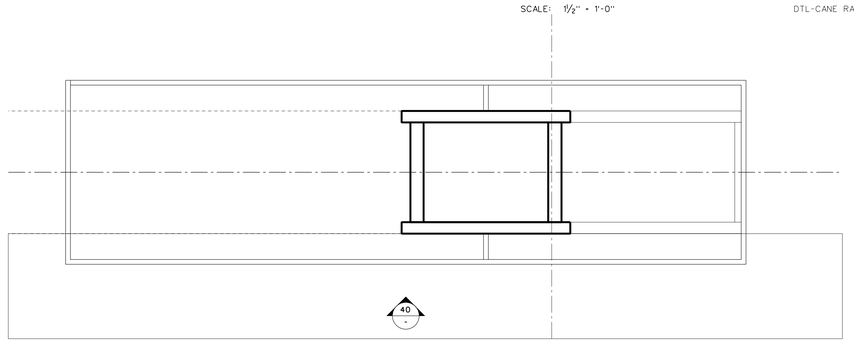


PLAN AT CANE RAIL

SCALE: 1½" = 1'-0" DTL-CANE RAILS 30

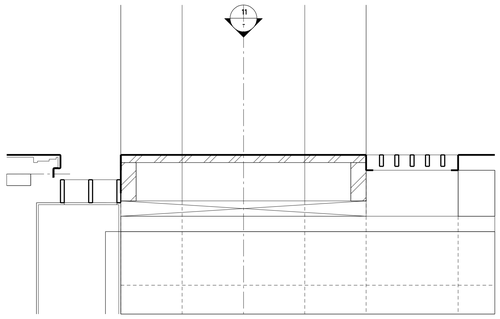


SECTION DETAIL AT TRUSS BASE

SCALE: 3 " = 1'-0" DTL-TRUSS BASE-CLG 21

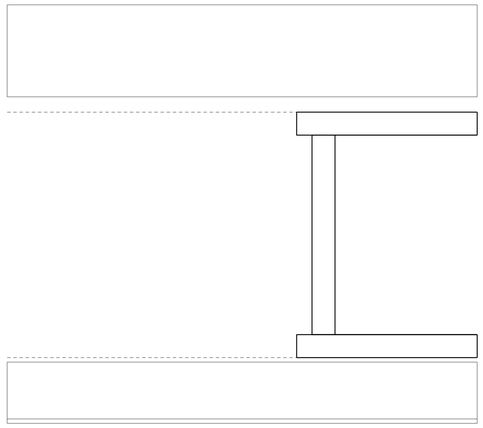


PLAN DETAIL AT TRUSS BASE

SCALE: 3 " = 1'-0" DTL-TRUSS BASE-CLG 11

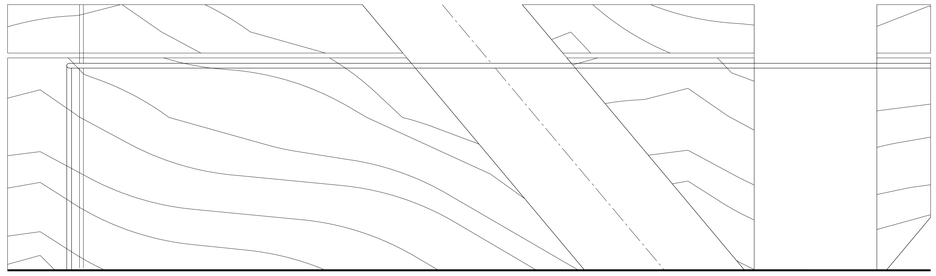

ELEVATION AT CANE RAIL

SCALE: 1½" = 1'-0" DTL-CANE RAILS 20

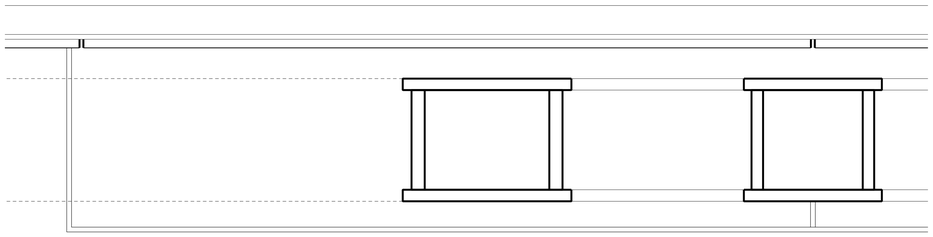

PLAN AT CANE RAIL

SCALE: 1½" = 1'-0" DTL-CANE RAILS 10

WILLIAM J. CLINTON PRESIDENTIAL CENTER

LITTLE ROCK, ARKANSAS

Architect

POLSHEK PARTNERSHIP LLP
320 West 13th Street
New York, New York 10014
212.807.7171

Coordinating Architects

POLK STANLEY YEARY ARCHITECTS Ltd
700 South Schiller Street
Little Rock, Arkansas 72201
501.378.0878

WITSELL EVANS RASCO
901 West Third Street
Little Rock, Arkansas 72201
501.374.5300

WOODS CARADINE ARCHITECTS
2200 South Main Street
Little Rock, Arkansas 72206
501.374.4060

Landscape Architects

HARGREAVES ASSOCIATES
118 Magazine Street
Cambridge, Massachusettes 02139
617.661.0070

LANDSCAPE ARCHITECTURE, Inc.
2300 Cottondale Lane Suite 202
Little Rock, Arkansas 72202
501.374.5610

Structural Engineer

LESLIE E. ROBERTSON ASSOC., RLLP
30 Broad Street, 47th Floor
New York, New York 10004
212.750.9000

MEP Engineers

FLACK + KURTZ Inc.
475 Fifth Avenue
New York, New York 10017
212.532.9600


CROMWELL ARCHITECTS ENGINEERS
101 South Spring Street
Little Rock, Arkansas 72201
501.372.2900

Curtainwall Consultant

R. A. HEINTGES ARCHITECTS
126 Fifth Avenue, 9th Floor
New York, New York 10011
212.652-2966

Seal

Issue	Date
100% Construction Documents	09/27/02
90% Progress Printing	08/30/02
ASI #05	08/20/02
100% Struct./ CD Progress	07/01/02
Bridge Bldg. Substructure	06/14/02
100% Steel & Concrete CD & Architectural CD Progress	05/15/02
100% Design Development	03/01/02

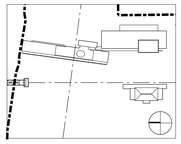

Job No. 9908


Scale AS NOTED

Date September 27, 2002

Title CANE RAILS
TRUSS BASE - CEILING
DETAILS


Sheet No. A463

FOR OFFICIAL USE ONLY

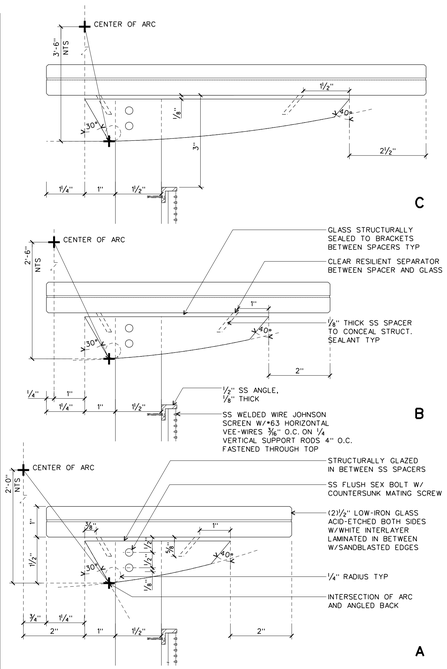


SS GLASS SUPPPORT DETAIL

SCALE: 6" = 1'-0" d-i-lobbydesks 32

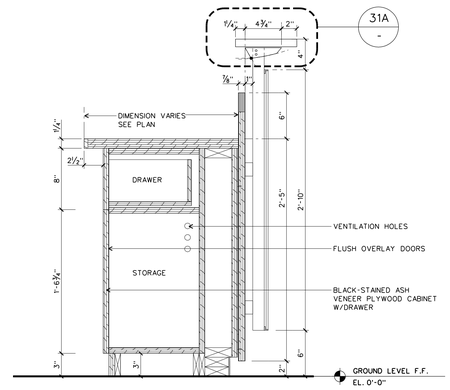

LOBBY TICKET DESK SECTION

SCALE: 1-1/2 " = 1'-0" d-i-lobbydesks 22

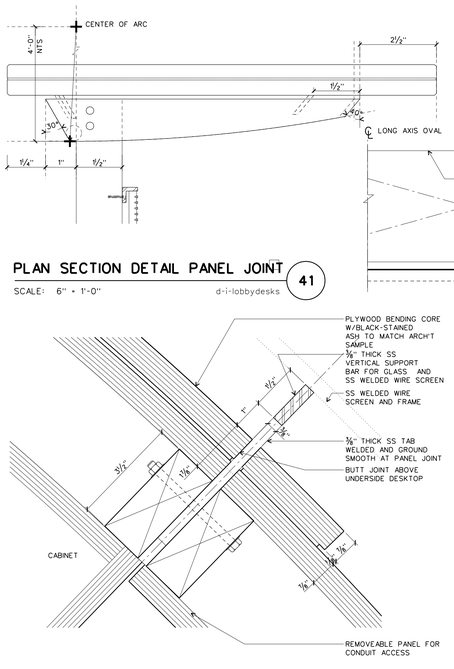


PLAN SECTION DETAIL PANEL JOINT

SCALE: 6" = 1'-0" d-i-lobbydesks 41


PLAN SECTION DETAIL PANEL JOINT

SCALE: 6" = 1'-0" d-i-lobbydesks 31

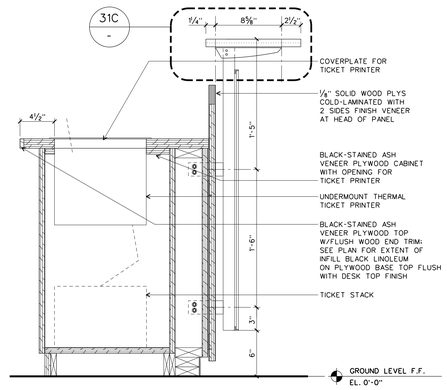


LOBBY TICKET DESK SECTION

SCALE: 1-1/2 " = 1'-0" d-i-lobbydesks 21

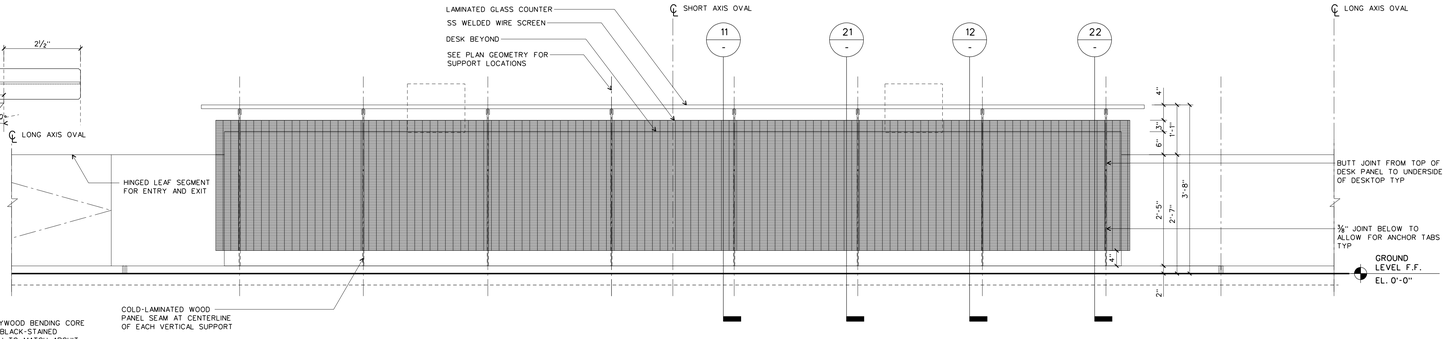


FLATTENED EXTERIOR ELEVATION OF DESK

SCALE: ¾" = 1'-0" d-i-lobbydesks 30

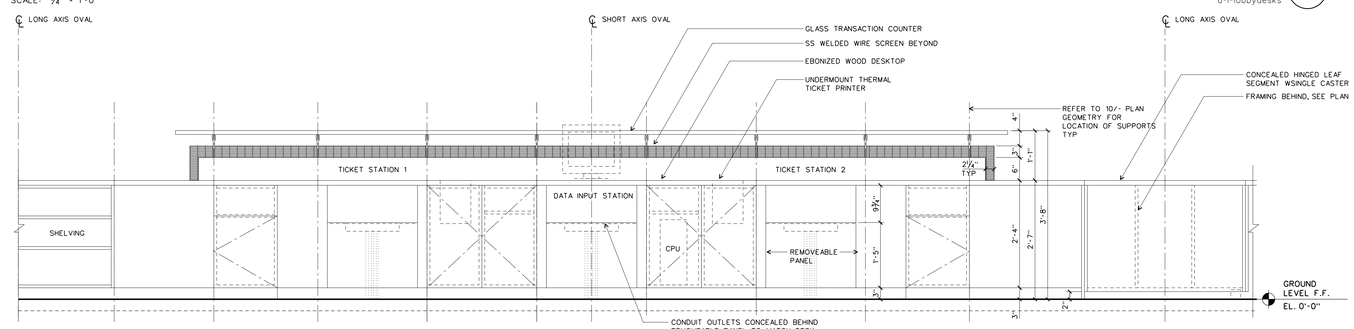


FLATTENED INTERIOR ELEVATION OF DESK

SCALE: ¾" = 1'-0" d-i-lobbydesks 20

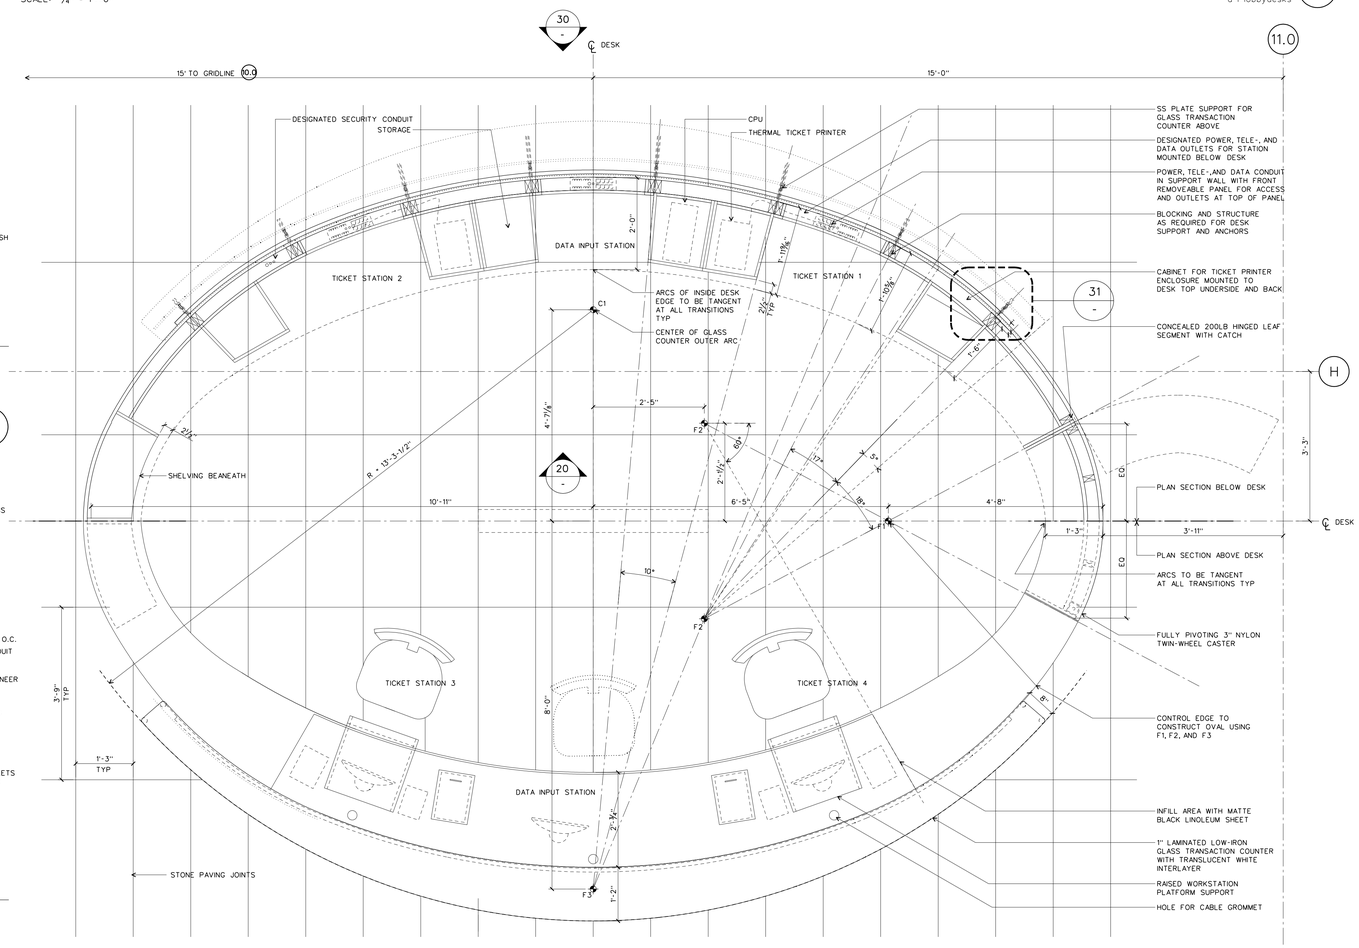


LOBBY TICKET DESK PLAN

SCALE: ¾" = 1'-0" d-i-lobbydesks 10

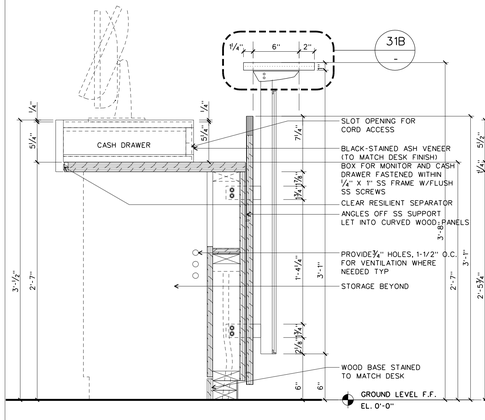

LOBBY TICKET DESK SECTION

SCALE: 1-1/2 " = 1'-0" d-i-lobbydesks 12

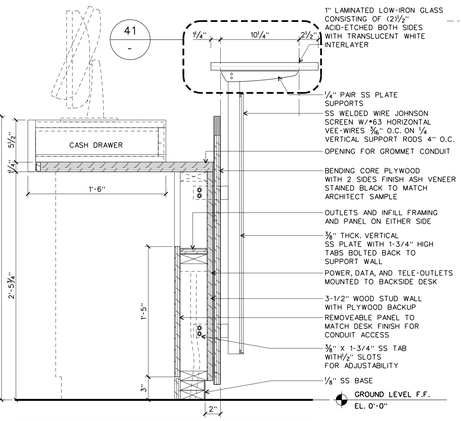

LOBBY TICKET DESK SECTION

SCALE: 1-1/2 " = 1'-0" d-i-lobbydesks 11

WILLIAM J. CLINTON PRESIDENTIAL CENTER

LITTLE ROCK, ARKANSAS

Architect

POLSHEK PARTNERSHIP LLP
320 West 13th Street
New York, New York 10014
212.807.7171

Coordinating Architects

POLK STANLEY YEARY ARCHITECTS Ltd
700 South Schiller Street
Little Rock, Arkansas 72201
501.378.0878

WITSELL EVANS RASCO
901 West Third Street
Little Rock, Arkansas 72201
501.374.5300

WOODS CARADINE ARCHITECTS
2200 South Main Street
Little Rock, Arkansas 72206
501.374.4060

Landscape Architects

HARGREAVES ASSOCIATES
118 Magazine Street
Cambridge, Massachusettes 02139
617.661.0070

LANDSCAPE ARCHITECTURE, Inc.
2300 Cottondale Lane Suite 202
Little Rock, Arkansas 72202
501.374.5610

Structural Engineer

LESLIE E. ROBERTSON ASSOC., RLLP
30 Bread Street, 47th Floor
New York, New York 10004
212.750.9000

MEP Engineers

FLACK + KURTZ Inc.
475 Fifth Avenue
New York, New York 10017
212.532.9600

CROMWELL ARCHITECTS ENGINEERS
101 South Spring Street
Little Rock, Arkansas 72201
501.372.2900

Curtainwall Consultant

R. A. HEINTGES ARCHITECTS
126 Fifth Avenue, 9th Floor
New York, New York 10011
212.652-2966

Seal

Issue	Date
ASI #35	05/07/04

Job No. 9908

Scale AS NOTED

Date September 27, 2002


Title

LOBBY TICKET DESK MILLWORK

Sheet No.

A464


FOR OFFICIAL USE ONLY

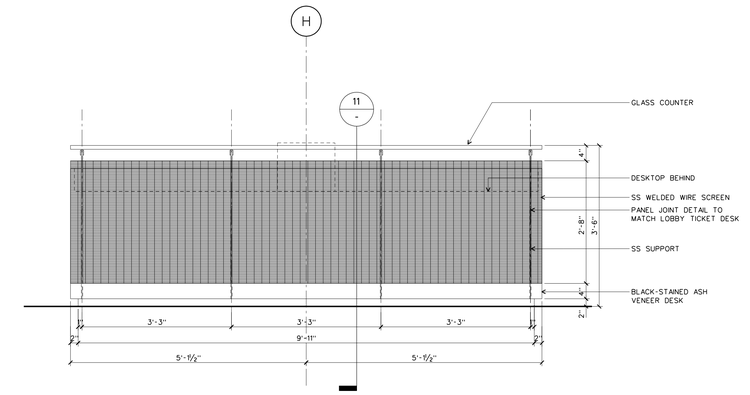

NORTH-FACING ELEVATION OF DESK

SCALE: ¾" = 1'-0"


d-i-lobbydesks 30

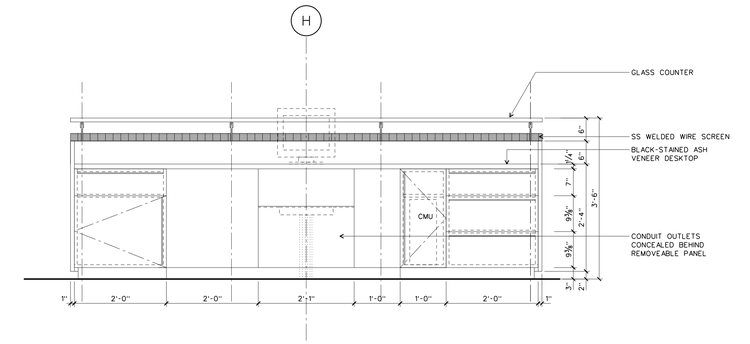

SOUTH-FACING ELEVATION OF DESK

SCALE: ¾" = 1'-0"


d-i-lobbydesks 20

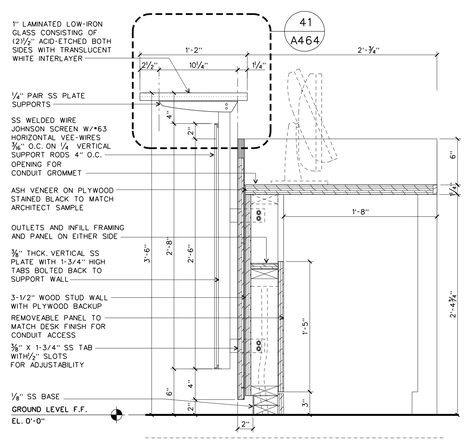

DESK SECTION

SCALE: 1-1/2 " = 1'-0"

d-i-lobbydesks 11

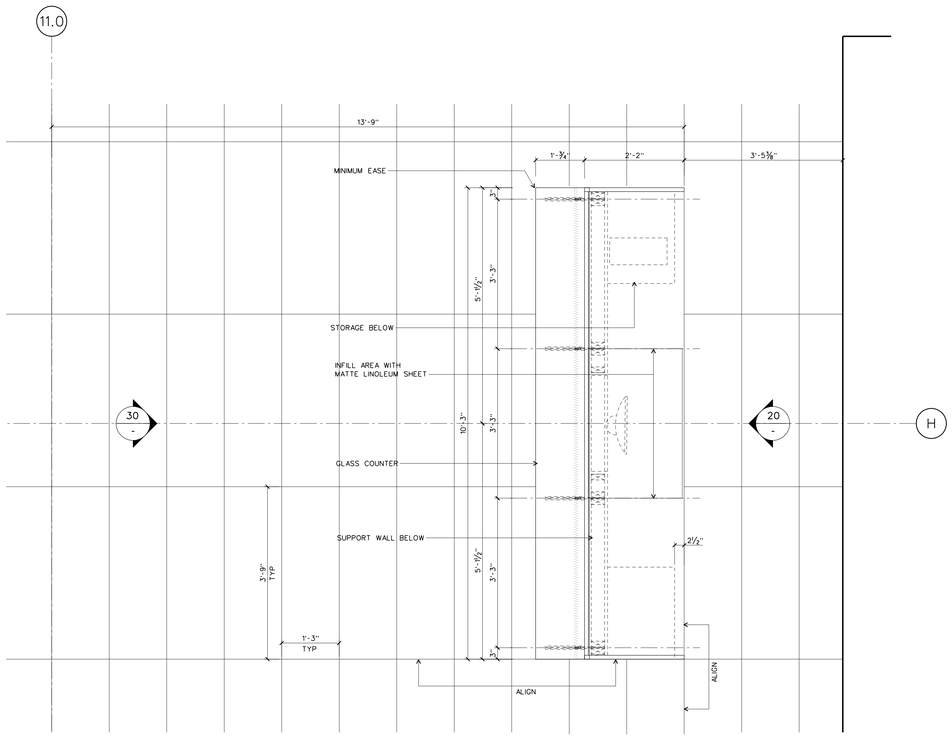

LOBBY DESK PLAN

SCALE: ¾" = 1'-0"

d-i-lobbydesks 10

WILLIAM J. CLINTON PRESIDENTIAL CENTER

LITTLE ROCK, ARKANSAS

Architect

POLSHEK PARTNERSHIP LLP
320 West 13th Street
New York, New York 10014
212.807.7171

Coordinating Architects

POLK STANLEY YEARY ARCHITECTS Ltd
700 South Schiller Street
Little Rock, Arkansas 72201
501.378.0878

WITSELL EVANS RASCO
901 West Third Street
Little Rock, Arkansas 72201
501.374.5300

WOODS CARADINE ARCHITECTS
2200 South Main Street
Little Rock, Arkansas 72206
501.374.4060

Landscape Architects

HARGREAVES ASSOCIATES
118 Magazine Street
Cambridge, Massachusettes 02139
617.661.0070

LANDSCAPE ARCHITECTURE, Inc.
2300 Cottondale Lane Suite 202
Little Rock, Arkansas 72202
501.374.5610

Structural Engineer

LESLIE E. ROBERTSON ASSOC., RLLP
30 Broad Street, 47th Floor
New York, New York 10004
212.750.9000

MEP Engineers

FLACK + KURTZ Inc.
475 Fifth Avenue
New York, New York 10017
212.532.9600


CROMWELL ARCHITECTS ENGINEERS
101 South Spring Street
Little Rock, Arkansas 72201
501.372.2900

Curtainwall Consultant

R. A. HEINTGES ARCHITECTS
126 Fifth Avenue, 9th Floor
New York, New York 10011
212.652-2966

Seal

Issue	Date
ASI #35	05/07/04

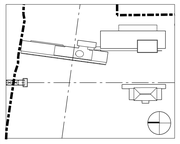

Job No. 9908

Scale AS NOTED

Date September 27, 2002


Title

RECEPTION DESK MILLWORK

Sheet No.


A464a


FOR OFFICIAL USE ONLY

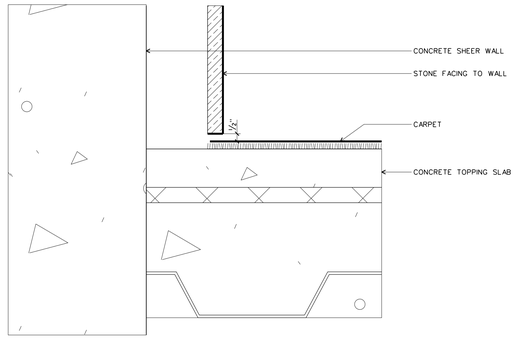


STONE BASE AT STAIR TOWER
(GREAT HALL - SOUTH FACE)

SCALE: 3 " = 1'-0" DTL-FLOOR-BASE 30

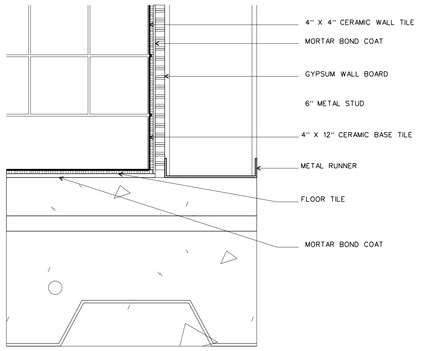

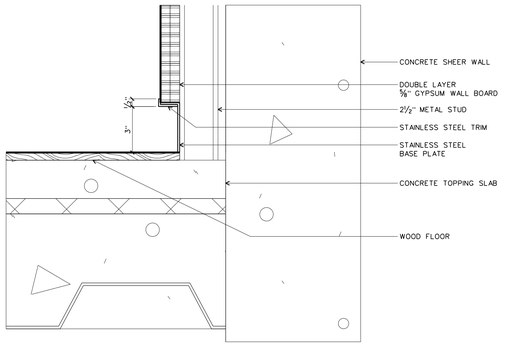

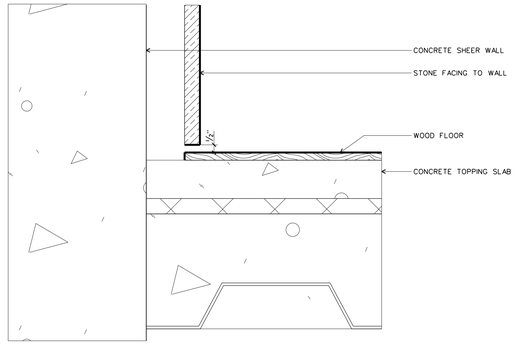

METAL PANELS AT WOOD FLOOR

SCALE: 3 " = 1'-0" DTL-FLOOR-BASE 10

TILE BASE AT BATHROOMS


SCALE: 3 " = 1'-0" DTL-FLOOR-BASE 22


WOOD BASE AT STAIR TOWER


SCALE: 3 " = 1'-0" DTL-FLOOR-BASE 21


STONE BASE AT STAIR TOWER
(SKY LOBBY - SOUTH FACE)

SCALE: 3 " = 1'-0" DTL-FLOOR-BASE 20

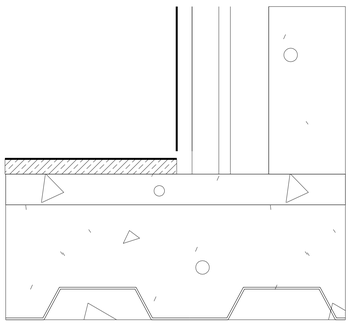

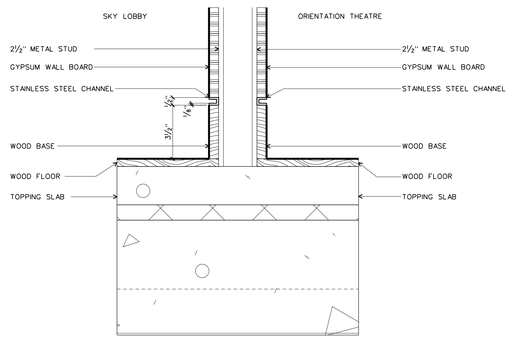

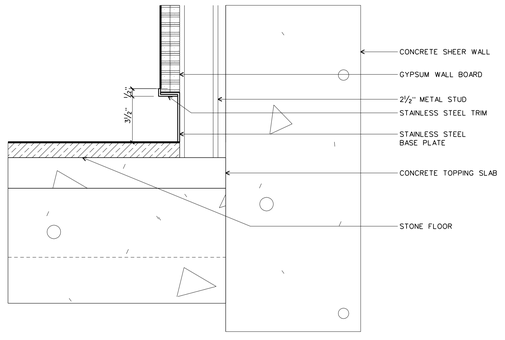

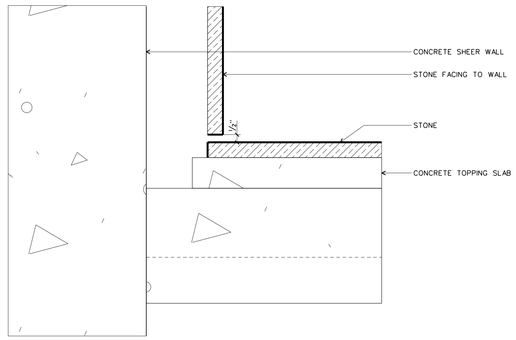

METAL PANELS AT STONE FLOOR

SCALE: 3 " = 1'-0" DTL-FLOOR-BASE 13

WOOD BASE AT ORIENTATION THEATRE

SCALE: 3 " = 1'-0" DTL-FLOOR-BASE 12

STONE BASE AT STAIR TOWER

SCALE: 3 " = 1'-0" DTL-FLOOR-BASE 11

STONE BASE AT STAIR TOWER
(GROUND LEVEL - SOUTH FACE)

SCALE: 3 " = 1'-0" DTL-FLOOR-BASE 10

WILLIAM J. CLINTON PRESIDENTIAL CENTER

LITTLE ROCK, ARKANSAS

Architect

POLSHEK PARTNERSHIP LLP
320 West 13th Street
New York, New York 10014
212.807.7171

Coordinating Architects

POLK STANLEY YEARY ARCHITECTS Ltd
700 South Schiller Street
Little Rock, Arkansas 72201
501.378.0878

WITSELL EVANS RASCO
901 West Third Street
Little Rock, Arkansas 72201
501.374.5300

WOODS CARADINE ARCHITECTS
2200 South Main Street
Little Rock, Arkansas 72206
501.374.4060

Landscape Architects

HARGREAVES ASSOCIATES
118 Magazine Street
Cambridge, Massachusettes 02139
617.661.0070

LANDSCAPE ARCHITECTURE, Inc.
2300 Cottondale Lane Suite 202
Little Rock, Arkansas 72202
501.374.5610

Structural Engineer

LESLIE E. ROBERTSON ASSOC., RLLP
30 Broad Street, 47th Floor
New York, New York 10004
212.750.9000

MEP Engineers

FLACK + KURTZ Inc.
475 Fifth Avenue
New York, New York 10017
212.532.9600


CROMWELL ARCHITECTS ENGINEERS
101 South Spring Street
Little Rock, Arkansas 72201
501.372.2900

Curtainwall Consultant

R. A. HEINTGES ARCHITECTS
126 Fifth Avenue, 9th Floor
New York, New York 10011
212.652-2966

Seal

Issue	Date
100% Construction Documents	09/27/02
90% Progress Printing	08/30/02
ASI #05	08/20/02
100% Struct./ CD Progress	07/01/02
Bridge Bldg. Substructure	06/14/02
100% Steel & Concrete CD & Architectural CD Progress	05/15/02
100% Design Development	03/01/02

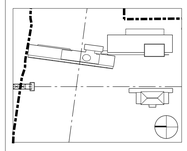

Job No. 9908

Scale 3" = 1'-0"

Date September 27, 2002


Title

FLOOR AND BASE DETAILS

Sheet No.


A460

FOR OFFICIAL USE ONLY

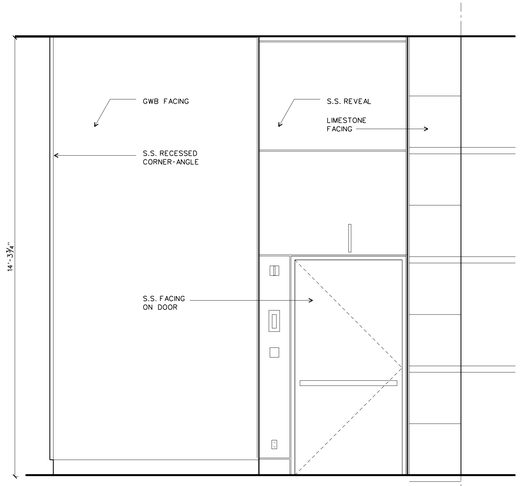


ELEVATION

SCALE: ½" = 1'-0" AFP-03.DGN 20

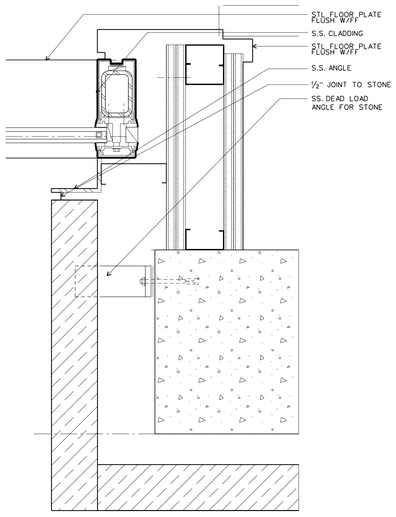

CORNER DETAIL STONE

SCALE: 3" = 1'-0" AFP-03.DGN 11

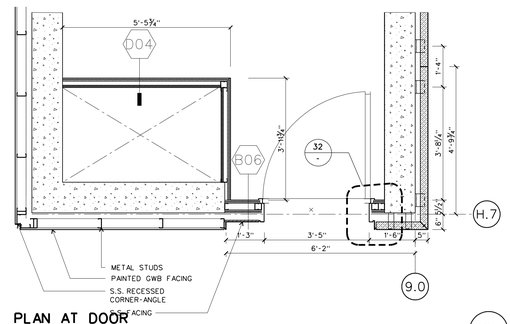

PLAN AT DOOR

SCALE: ½" = 1'-0" AFP-03.DGN 10

WILLIAM J. CLINTON PRESIDENTIAL CENTER

LITTLE ROCK, ARKANSAS

Architect

POLSHEK PARTNERSHIP LLP
320 West 13th Street
New York, New York 10014
212.807.7171

Coordinating Architects

POLK STANLEY YEARY ARCHITECTS Ltd
700 South Schiller Street
Little Rock, Arkansas 72201
501.378.0878

WITSELL EVANS RASCO
901 West Third Street
Little Rock, Arkansas 72201
501.374.5300

WOODS CARADINE ARCHITECTS
2200 South Main Street
Little Rock, Arkansas 72206
501.374.4060

Landscape Architects

HARGREAVES ASSOCIATES
118 Magazine Street
Cambridge, Massachusettes 02139
617.661.0070

LANDSCAPE ARCHITECTURE, Inc.
2300 Cottondale Lane Suite 202
Little Rock, Arkansas 72202
501.374.5610

Structural Engineer

LESLIE E. ROBERTSON ASSOC., RLLP
30 Broad Street, 47th Floor
New York, New York 10004
212.750.9000

MEP Engineers

FLACK + KURTZ Inc.
475 Fifth Avenue
New York, New York 10017
212.532.9600


CROMWELL ARCHITECTS ENGINEERS
101 South Spring Street
Little Rock, Arkansas 72201
501.372.2900

Curtainwall Consultant

R. A. HEINTGES ARCHITECTS
126 Fifth Avenue, 9th Floor
New York, New York 10011
212.652-2966

Seal

Issue	Date
100% Construction Documents	09/27/02
90% Progress Printing	08/30/02
ASI #05	08/20/02
100% Struct./ CD Progress	07/01/02
Bridge Bldg. Substructure	06/14/02
100% Steel & Concrete CD	05/15/02
& Architectural CD Progress	
100% Design Development	03/01/02

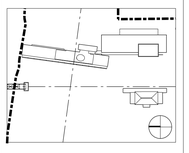

Job No.
9908


Scale
1'-1/2" / 3" = 1'-0"

Date
September 27, 2002

Title
MUSEUM BUILDING INTERIOR DETAILS: STONE


Sheet No.
A465

FOR OFFICIAL USE ONLY

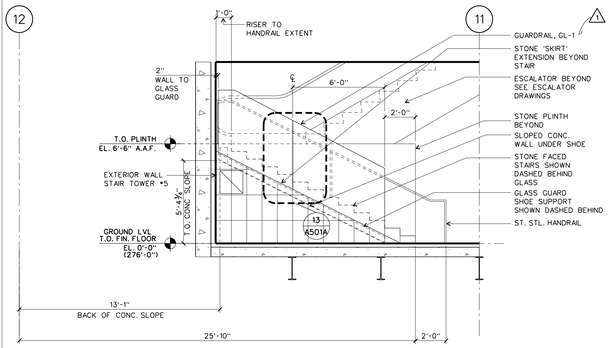


STAIR 7: ELEVATION LOOKING WEST

SCALE: 1/4" = 1'-0" — STAIR 1 — 43

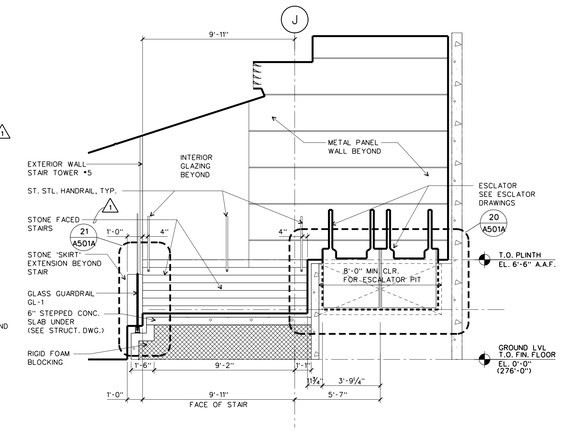


STAIR 7: E/W SECTION LOOKING SOUTH

SCALE: 1/4" = 1'-0" — STAIR 1 — 42

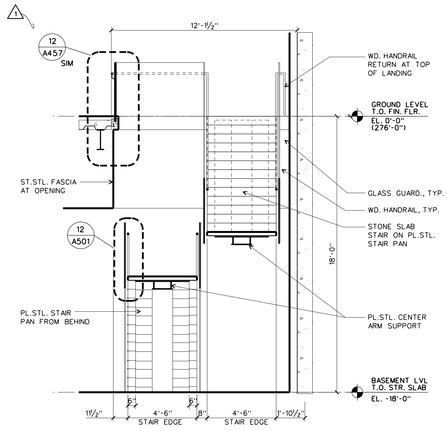


STAIR 3: E/W SECTION LOOKING NORTH

SCALE: 1/4" = 1'-0" — STAIR 1-3-7 — 41

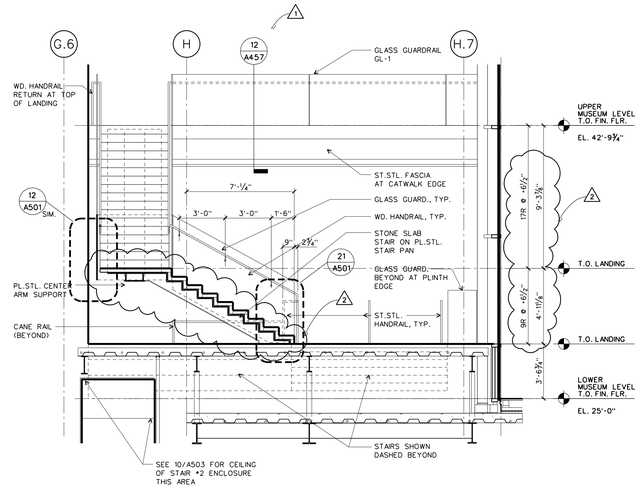


STAIR 1: E/W SECTION LOOKING SOUTH

SCALE: 1/4" = 1'-0" — STAIR 1 — 40

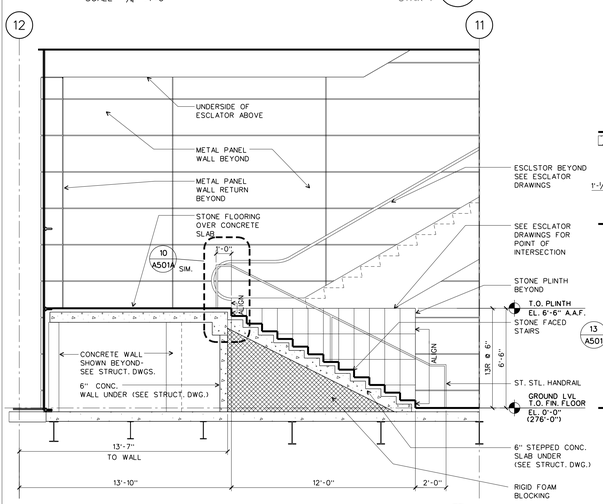


STAIR 7: N/S SECTION LOOKING WEST

SCALE: 1/4" = 1'-0" — STAIR 1 — 33

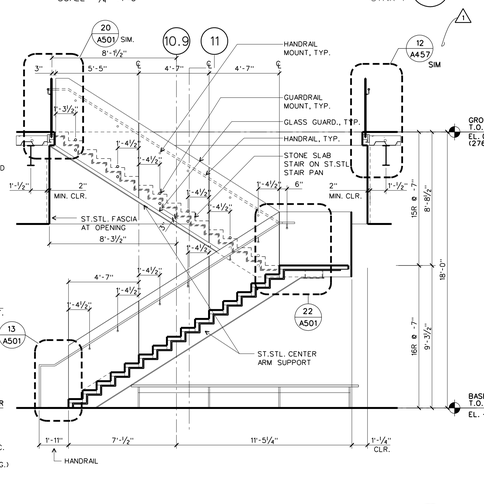


STAIR 3: N/S SECTION LOOKING EAST

SCALE: 1/4" = 1'-0" — STAIR 1 — 32

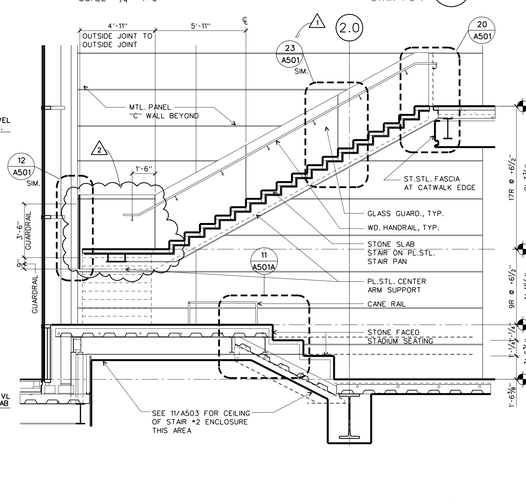


STAIR 1: N/S SECTION LOOKING EAST

SCALE: 1/4" = 1'-0" — STAIR 1 — 31

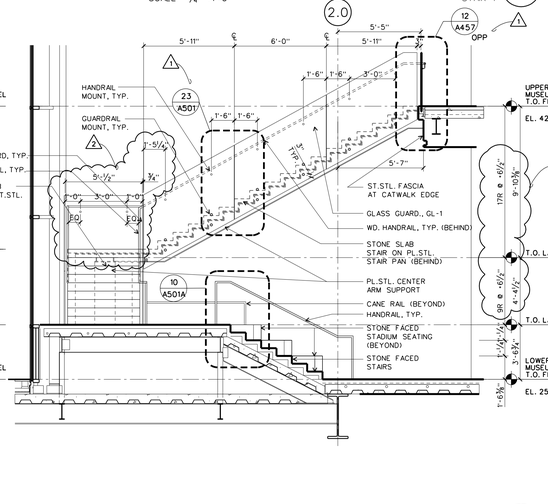


STAIR 1: N/S SECTION LOOKING EAST

SCALE: 1/4" = 1'-0" — STAIR 1 — 30

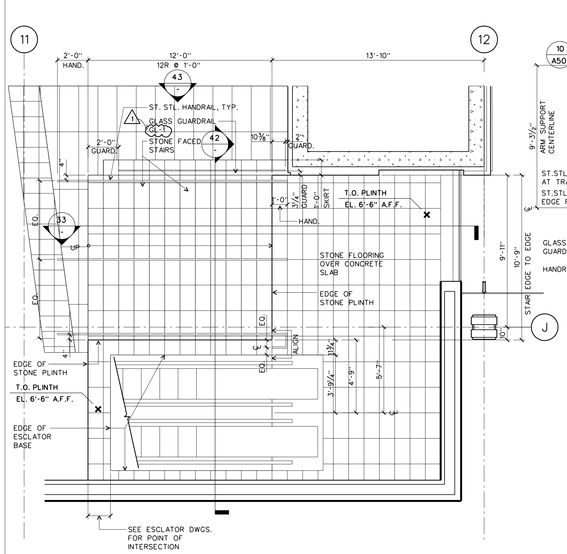


STAIR 7: GROUND LEVEL PLAN

SCALE: 1/4" = 1'-0" — STAIR 1 — 13

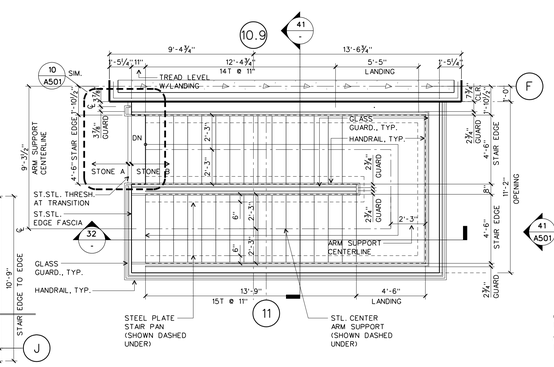


STAIR 3: GROUND LEVEL PLAN

SCALE: 1/4" = 1'-0" — STAIR 1 — 20

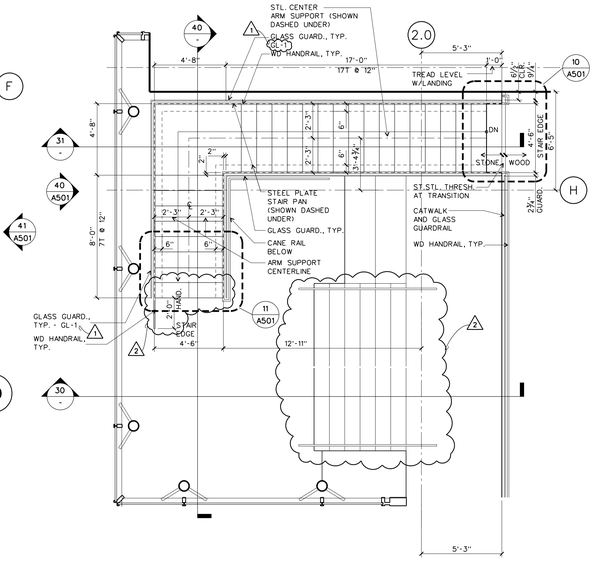

STAIR 1: MUSEUM UPPER LEVEL PLAN

SCALE: 1/4" = 1'-0" — STAIR 1 — 11

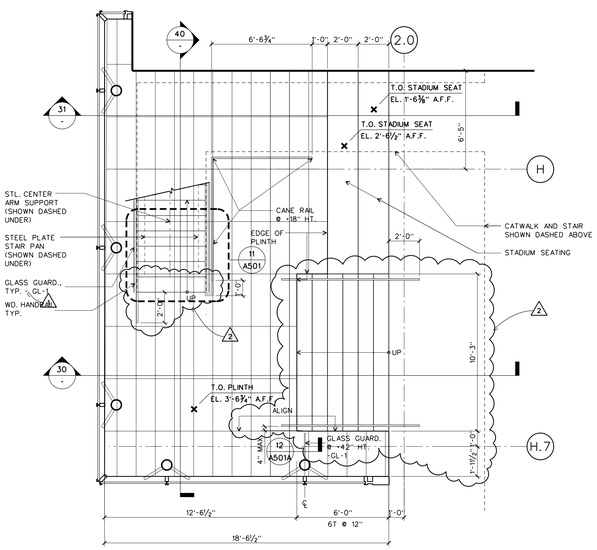

STAIR 1: MUSEUM LOWER LEVEL PLAN

SCALE: 1/4" = 1'-0" — STAIR 1 — 10

FOR OFFICIAL USE ONLY

WILLIAM J. CLINTON PRESIDENTIAL CENTER

LITTLE ROCK, ARKANSAS

Architect

POLSHEK PARTNERSHIP LLP
320 West 13th Street
New York, New York 10014
212.807.7171

Coordinating Architects

POLK STANLEY YEARY ARCHITECTS Ltd
700 South Schiller Street
Little Rock, Arkansas 72201
501.378.0878

WITSELL EVANS RASCO
901 West Third Street
Little Rock, Arkansas 72201
501.374.5300

WOODS CARADINE ARCHITECTS
2200 South Main Street
Little Rock, Arkansas 72206
501.374.4060

Landscape Architects

HARGREAVES ASSOCIATES
118 Magazine Street
Cambridge, Massachusettes 02139
617.661.0070

LANDSCAPE ARCHITECTURE, Inc.
2300 Cottondale Lane Suite 202
Little Rock, Arkansas 72202
501.374.5610

Structural Engineer

LESLIE E. ROBERTSON ASSOC., RLLP
30 Broad Street, 47th Floor
New York, New York 10004
212.750.9000

MEP Engineers

FLACK + KURTZ Inc.
475 Fifth Avenue
New York, New York 10017
212.532.9600


CROMWELL ARCHITECTS ENGINEERS
101 South Spring Street
Little Rock, Arkansas 72201
501.372.2900

Curtainwall Consultant

R. A. HEINTGES ARCHITECTS
126 Fifth Avenue, 9th Floor
New York, New York 10011
212.652-2966

Seal

	Issue	Date
2	ASI #24	10/24/03
1	Addendum #2	11/15/02
	100% Construction Documents	09/27/02
	90% Progress Printing	08/30/02
	100% Struct./ CD Progress	07/01/02
	Bridge Bldg. Substructure	06/14/02
	100% Steel & Concrete CD & Architectural CD Progress	05/15/02
	100% Design Development	03/01/02

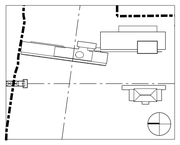


Job No.
9908

Scale
1/2"=1'-0"

Date
September 27, 2002


Title
MUSEUM BUILDING ORNAMENTAL STAIR: PLANS AND SECTIONS 1/3/7

Sheet No.
A500

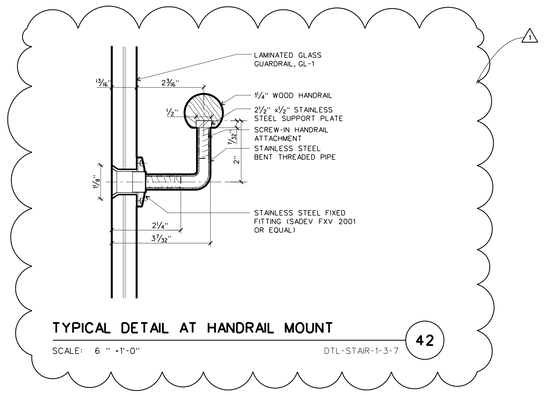


TYPICAL DETAIL AT HANDRAIL MOUNT

SCALE: 6 " =1'-0" DTL-STAIR-1-3-7 **42**

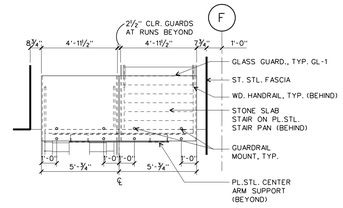


STAIR 3: PARTIAL ELEVATION- MID LANDING

SCALE: ¼" =1'-0" DTL-STAIR-1-3-7 **41**

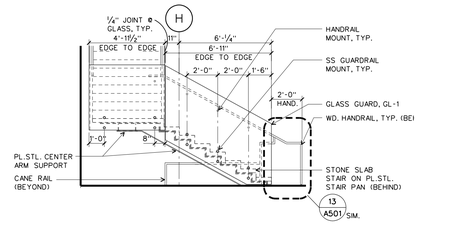


STAIR 1: PARTIAL ELEVATION- MID LANDING

SCALE: ¼" =1'-0" DTL-STAIR-1-3-7 **40**

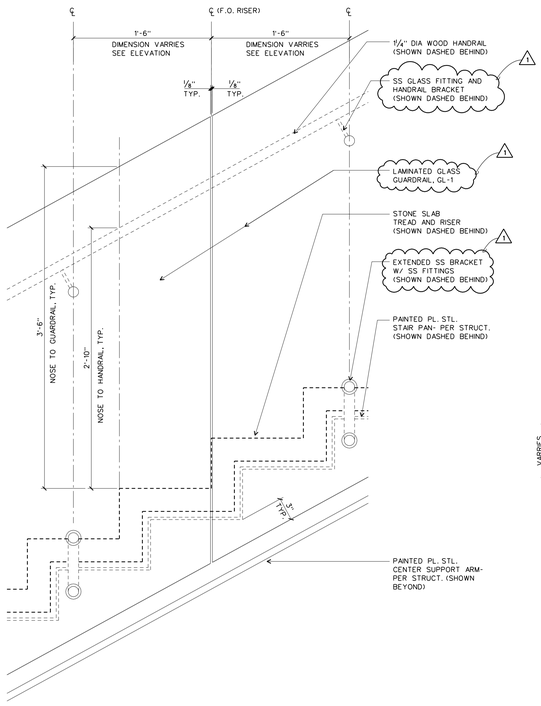


STAIR 1 (STAIR 3 SIM.): SECTION AT GUARD.

SCALE: 1½" =1'-0" DTL-STAIR-1-3-7 **23**

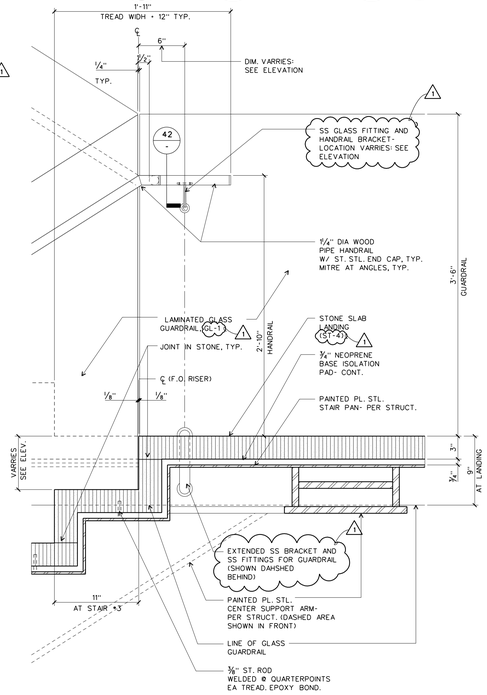


STAIR 1 (STAIR 3 SIM.): SECTION AT LANDING

SCALE: 1½" =1'-0" DTL-STAIR-1-3-7 **22**

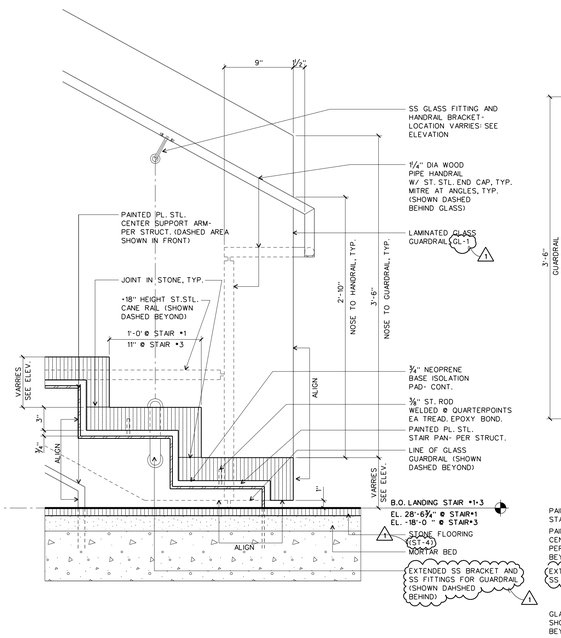


STAIR 1 (STAIR 3 SIM.): SECT. AT BOT. LAND.

SCALE: 1½" =1'-0" DTL-STAIR-1-3-7 **21**

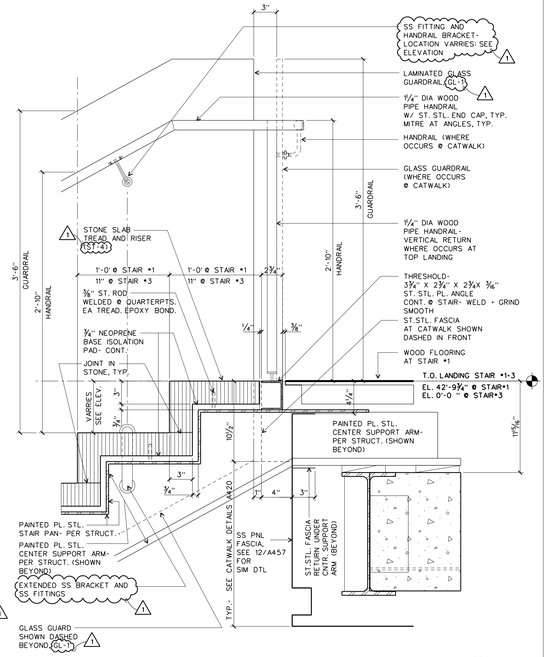


STAIR 1 (STAIR 3 SIM.): SECTION AT LANDING

SCALE: 1½" =1'-0" DTL-STAIR-1-3-7 **20**

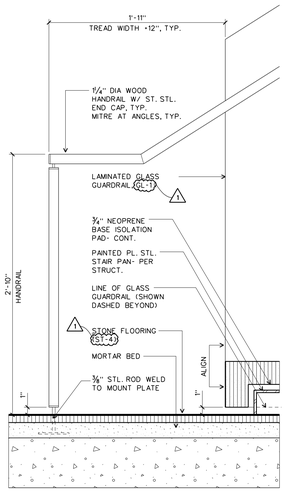


STAIR 3 (STAIR 1 SIM.): HANDRAIL AT BASE

SCALE: 1½" =1'-0" DTL-STAIR-1-3-7 **13**

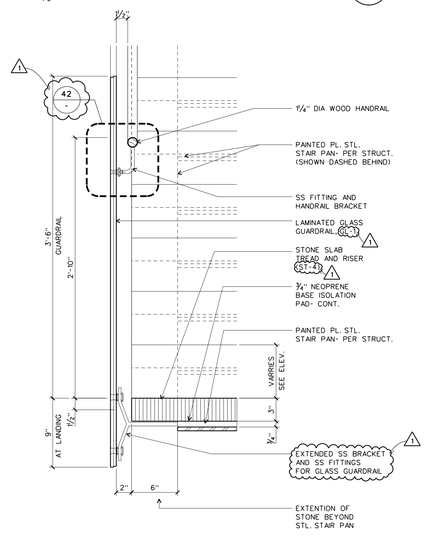


STAIR 1 (STAIR 3 SIM.): SECTION AT LANDING

SCALE: 1½" =1'-0" DTL-STAIR-1-3-7 **12**

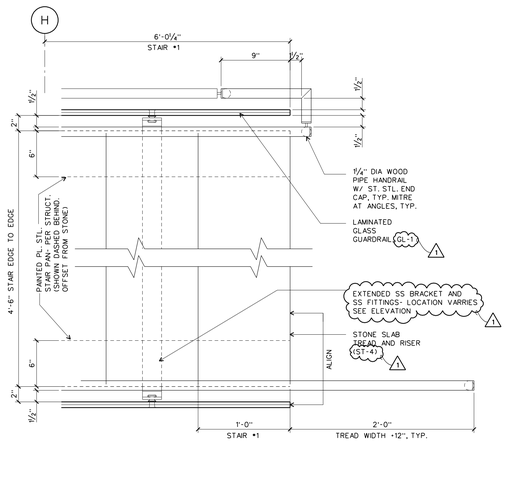

STAIR 1 (STAIR 3 SIM.): PLAN AT BOT. LAND.

SCALE: 1½" =1'-0" DTL-STAIR-1-3-7 **11**

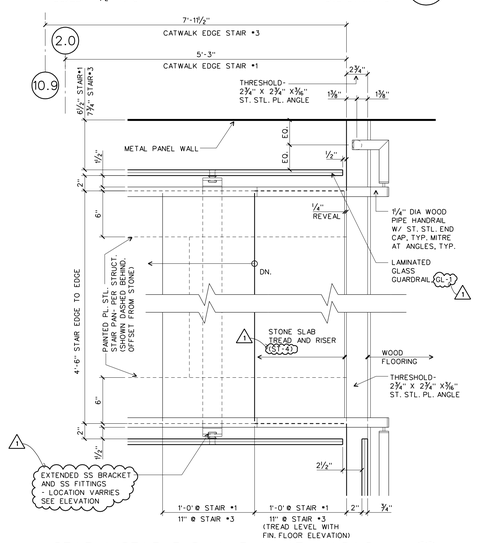

STAIR 1 (STAIR 3 SIM.): PLAN AT LANDING

SCALE: 1½" =1'-0" DTL-STAIR-1-3-7 **10**

WILLIAM J. CLINTON PRESIDENTIAL CENTER

LITTLE ROCK, ARKANSAS

Architect

POLSHEK PARTNERSHIP LLP
320 West 13th Street
New York, New York 10014
212.807.7171

Coordinating Architects

POLK STANLEY YEARY ARCHITECTS Ltd
700 South Schiller Street
Little Rock, Arkansas 72201
501.378.0878

WITSELL EVANS RASCO
901 West Third Street
Little Rock, Arkansas 72201
501.374.5300

WOODS CARADINE ARCHITECTS
2200 South Main Street
Little Rock, Arkansas 72206
501.374.4060

Landscape Architects

HARGREAVES ASSOCIATES
118 Magazine Street
Cambridge, Massachusettes 02139
617.661.0070

LANDSCAPE ARCHITECTURE, Inc.
2300 Cottondale Lane Suite 202
Little Rock, Arkansas 72202
501.374.5610

Structural Engineer

LESLIE E. ROBERTSON ASSOC., RLLP
30 Broad Street, 47th Floor
New York, New York 10004
212.750.9000

MEP Engineers

FLACK + KURTZ Inc.
475 Fifth Avenue
New York, New York 10017
212.532.9600

CROMWELL ARCHITECTS ENGINEERS
101 South Spring Street
Little Rock, Arkansas 72201
501.372.2900


Curtainwall Consultant

R. A. HEINTGES ARCHITECTS
126 Fifth Avenue, 9th Floor
New York, New York 10011
212.852-2966

Seal

Issue	Date
1 Addendum #2	11/15/02
100% Construction Documents	09/27/02
100% Struct./ CD Progress*	07/01/02

*New Sheet. Former A501 details on A502.

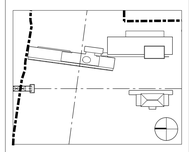

Job No. 9908

Scale 1 1/2" = 1'-0"

Date September 27, 2002


Title


MUSEUM BUILDING ORNAMENTAL STAIR: DETAILS

Sheet No.

A501


FOR OFFICIAL USE ONLY

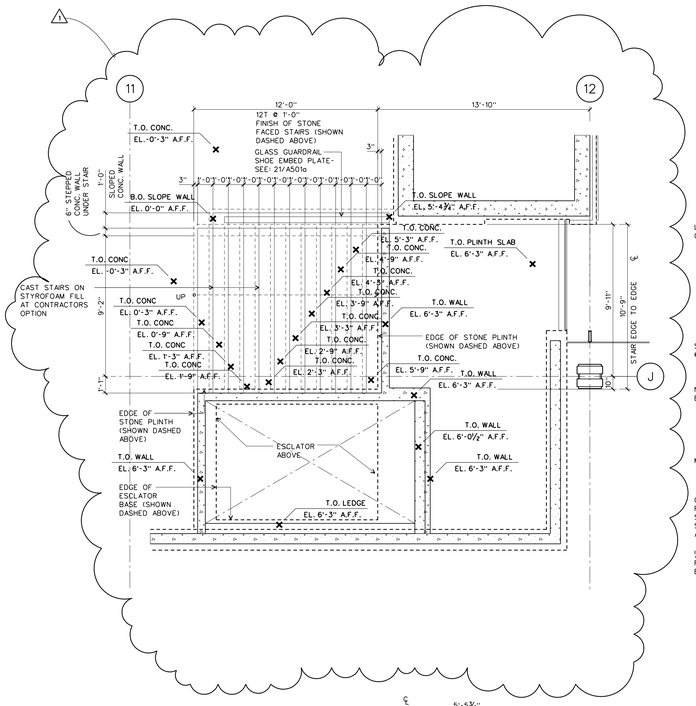
11
12
J
12'-0"
12T @ 1'-0"
FINISH OF STONE
FACED STAIRS (SHOWN
DASHED ABOVE)
13'-10"
GLASS GUARDRAIL
SHOE EMBED PLATE-
SEE 21/A501a
T.O. CONC.
EL. -0'-3" A.F.F.
6" STEPPED
CONC. WALL
UNDER STAIR
SLOPED
CONC. WALL
B.O. SLOPE WALL
EL. 0'-0" A.F.F.
T.O. SLOPE WALL
EL. 5'-4¾" A.F.F.
T.O. CONC.
EL. 5'-3" A.F.F.
T.O. PLINTH SLAB
EL. 6'-3" A.F.F.
EL. 4'-9" A.F.F.
EL. 4'-5" A.F.F.
EL. 3'-9" A.F.F.
EL. 3'-3" A.F.F.
EL. 2'-9" A.F.F.
EL. 2'-3" A.F.F.
EL. 5'-9" A.F.F.
T.O. WALL
EL. 6'-3" A.F.F.
CAST STAIRS ON
STYROFOAM FILL
AT CONTRACTORS
OPTION
UP
EL. 0'-3" A.F.F.
EL. 0'-9" A.F.F.
EL. 1'-3" A.F.F.
EL. 1'-9" A.F.F.
EDGE OF STONE PLINTH
(SHOWN DASHED
ABOVE)
EDGE OF STONE PLINTH
(SHOWN DASHED ABOVE)
ESCLATOR
ABOVE
T.O. WALL
EL. 6'-0½" A.F.F.
EDGE OF
ESCLATOR
BASE (SHOWN
DASHED ABOVE)
T.O. LEDGE
EL. 6'-3" A.F.F.
9'-2"
1'-1"
3'-0"
3'-0"
3'-0

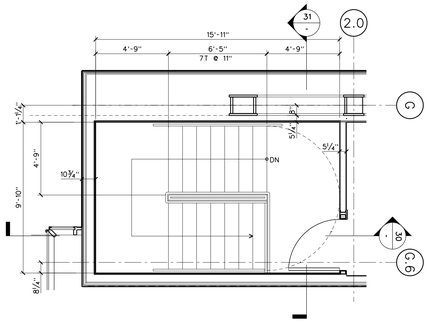


STAIR 2: MUSEUM UPPER LEVEL PLAN 41

SCALE: ¼" = 1'-0" STAIR 2

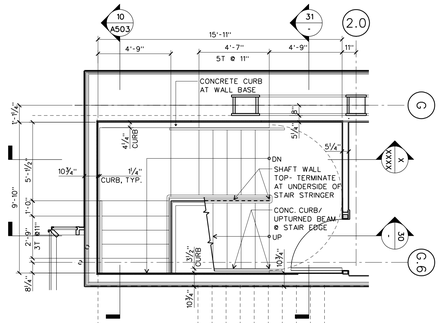


STAIR 2: MUSEUM LOWER LEVEL PLAN 40

SCALE: ¼" = 1'-0" STAIR 2

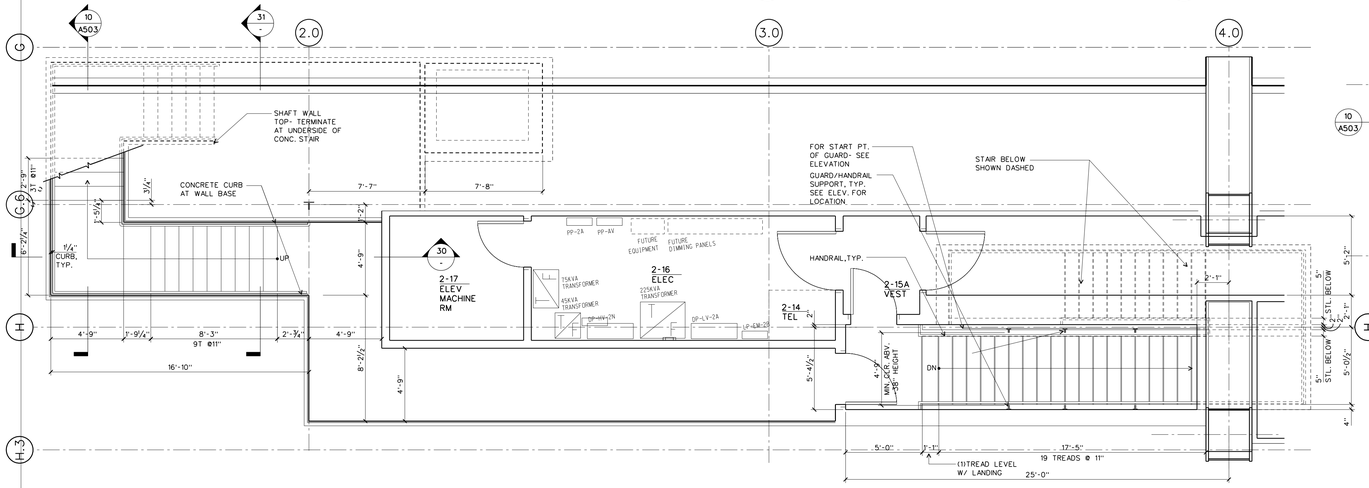


STAIR 2: SECOND LEVEL PLAN 32

SCALE: ¼" = 1'-0" STAIR 2

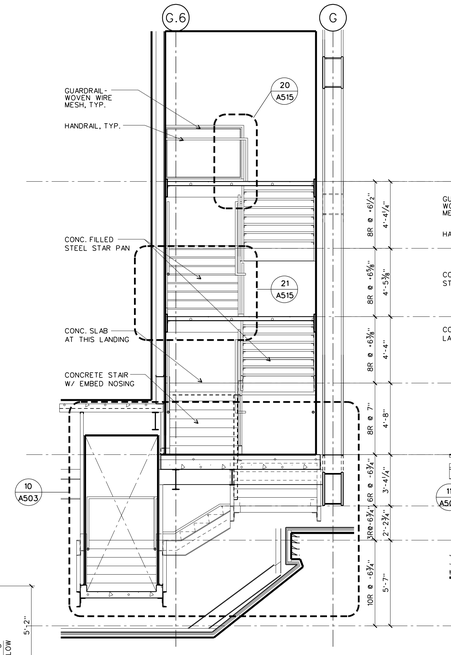


STAIR 2: E/W SECTION LOOKING NORTH 31

SCALE: ¼" = 1'-0" STAIR 2

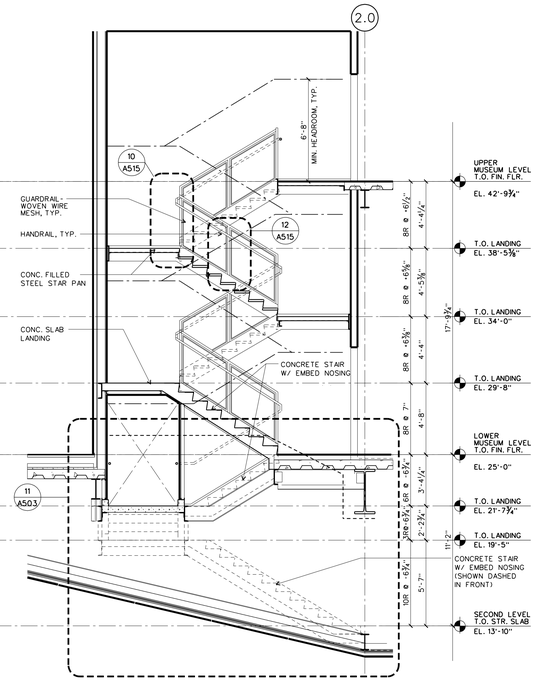


STAIR 2: N/S SECTION LOOKING EAST 30

SCALE: ¼" = 1'-0" STAIR 2

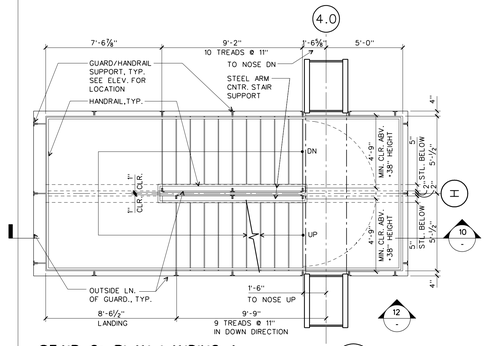


STAIR 2: PLAN LANDING 1 21

SCALE: ¼" = 1'-0" STAIR 2

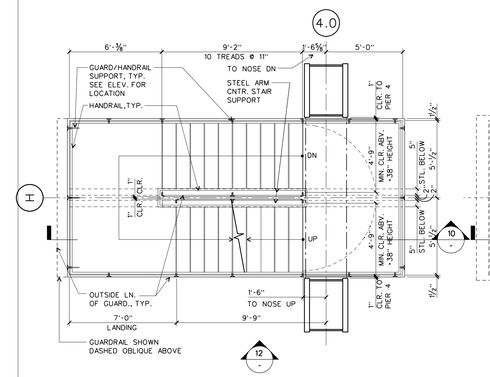


STAIR 2: PLAN LANDING 2 14

SCALE: ¼" = 1'-0" STAIR 2

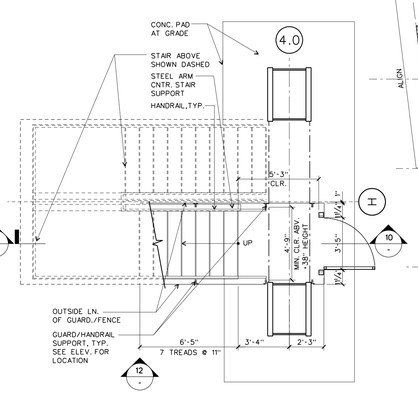


STAIR 2: PLAN LANDING 3 13

SCALE: ¼" = 1'-0" STAIR 2

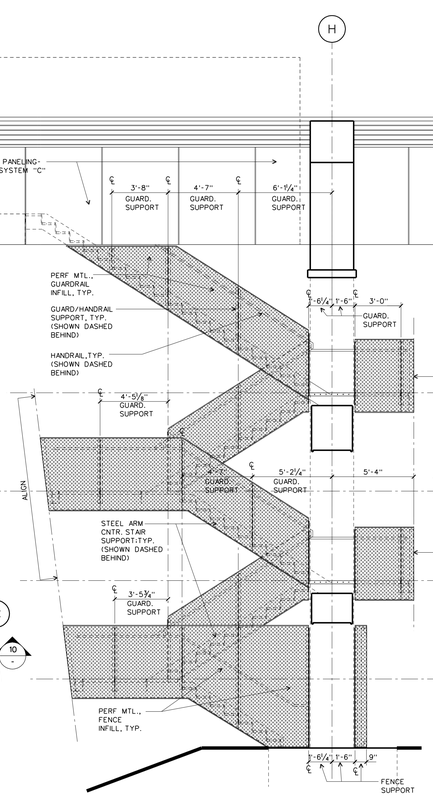


STAIR 2: ELEVATION 12

SCALE: ¼" = 1'-0" STAIR 2

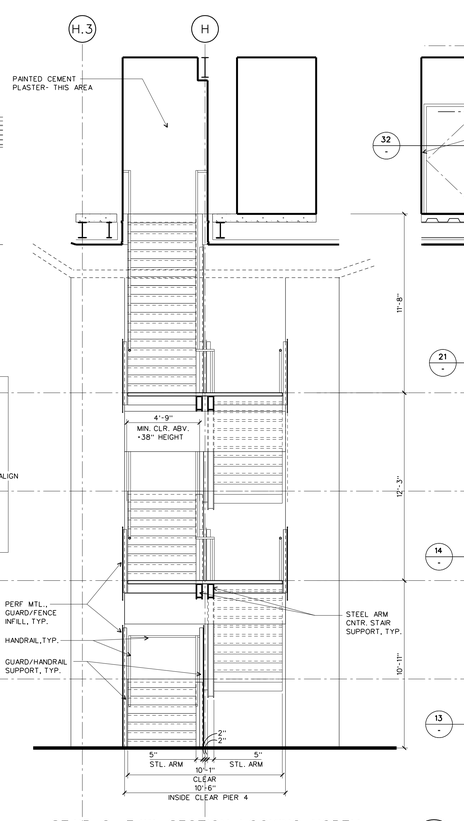

STAIR 2: E/W SECTION LOOKING NORTH 11

SCALE: ¼" = 1'-0" stair 2

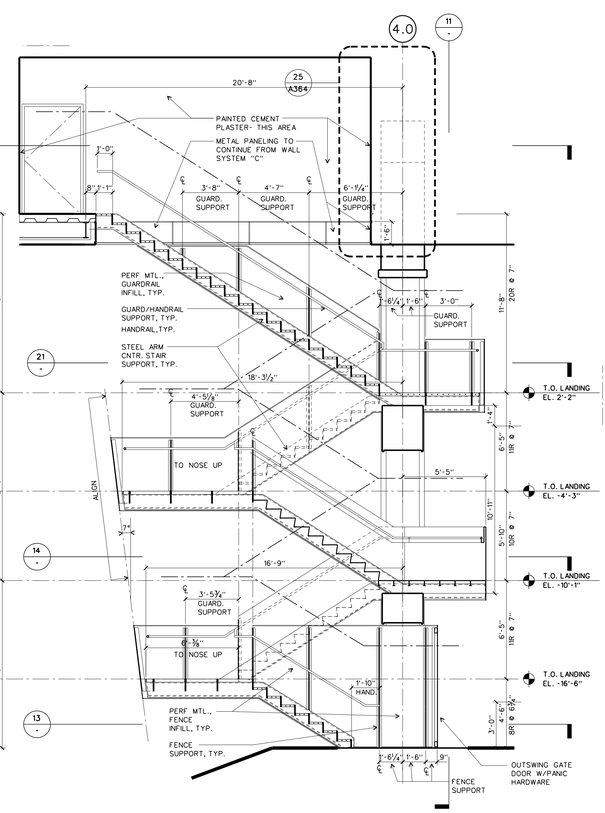

STAIR 2: N/S SECTION LOOKING EAST 10

SCALE: ¼" = 1'-0" stair 2

WILLIAM J. CLINTON PRESIDENTIAL CENTER

LITTLE ROCK, ARKANSAS

Architect

POLSHEK PARTNERSHIP LLP
320 West 13th Street
New York, New York 10014
212.807.7171

Coordinating Architects

POLK STANLEY YEARY ARCHITECTS Ltd
700 South Schiller Street
Little Rock, Arkansas 72201
501.378.0878

WITSELL EVANS RASCO
901 West Third Street
Little Rock, Arkansas 72201
501.374.5300

WOODS CARADINE ARCHITECTS
2200 South Main Street
Little Rock, Arkansas 72206
501.374.4060

Landscape Architects

HARGREAVES ASSOCIATES
118 Magazine Street
Cambridge, Massachusettes 02139
617.661.0070

LANDSCAPE ARCHITECTURE, Inc.
2300 Cottondale Lane Suite 202
Little Rock, Arkansas 72202
501.374.5610

Structural Engineer

LESLIE E. ROBERTSON ASSOC., RLLP
30 Broad Street, 47th Floor
New York, New York 10004
212.750.9000

MEP Engineers

FLACK + KURTZ Inc.
475 Fifth Avenue
New York, New York 10017
212.532.9600

CROMWELL ARCHITECTS ENGINEERS
101 South Spring Street
Little Rock, Arkansas 72201
501.372.2900


Curtainwall Consultant

R. A. HEINTGES ARCHITECTS
126 Fifth Avenue, 9th Floor
New York, New York 10011
212.652-2966

Seal

Issue	Date
100% Construction Documents	09/27/02
90% Progress Printing	08/30/02
100% Struct./ CD Progress	07/01/02
Bridge Bldg. Substructure	06/14/02
100% Steel & Concrete CD & Architectural CD Progress	05/15/02
100% Design Development*	03/01/02

*Issued orig. A501/Former A502 dtls on A505

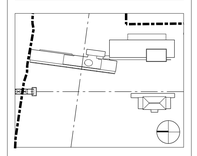

Job No. 9908

Scale 1/4"=1'-0"

Date September 27, 2002


Title

MUSEUM BUILDING
STAIR 2:
PLANS AND SECTIONS

Sheet No.


A502

FOR OFFICIAL USE ONLY

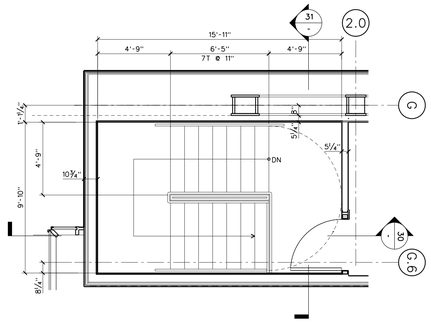


STAIR 2: MUSEUM UPPER LEVEL PLAN 41

SCALE: ¼" = 1'-0" STAIR 2

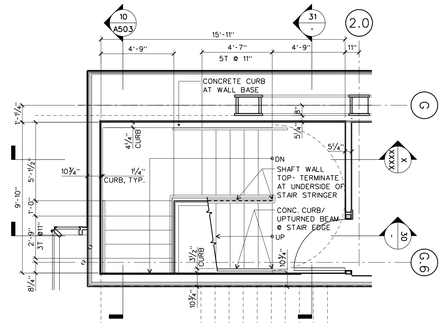


STAIR 2: MUSEUM LOWER LEVEL PLAN 40

SCALE: ¼" = 1'-0" STAIR 2

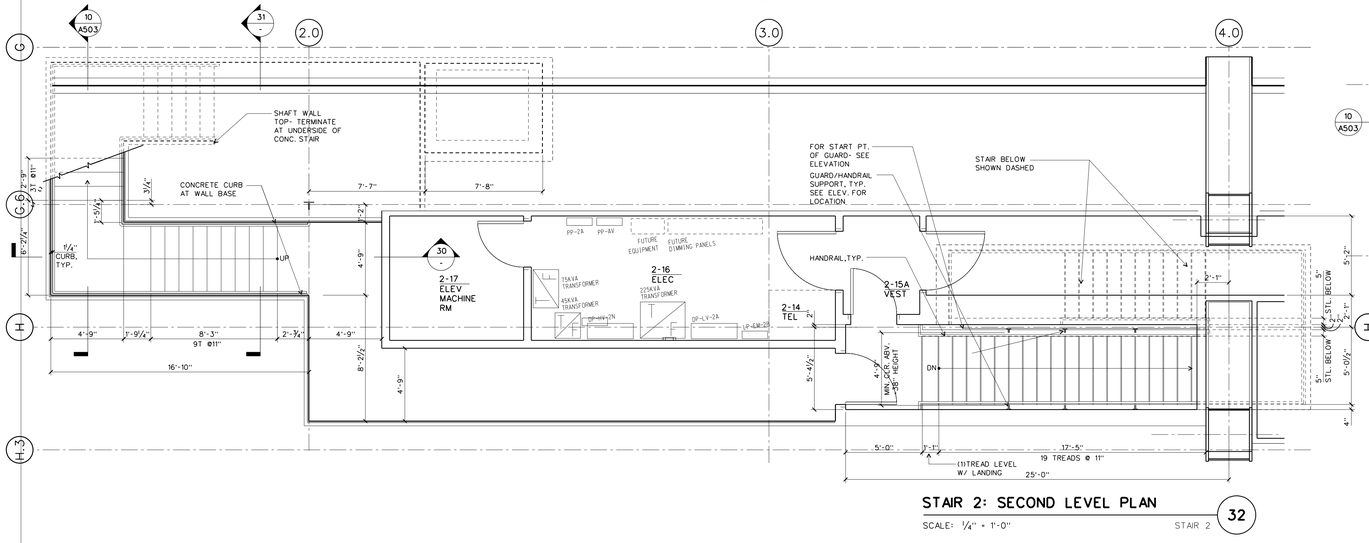


STAIR 2: SECOND LEVEL PLAN 32

SCALE: ¼" = 1'-0" STAIR 2

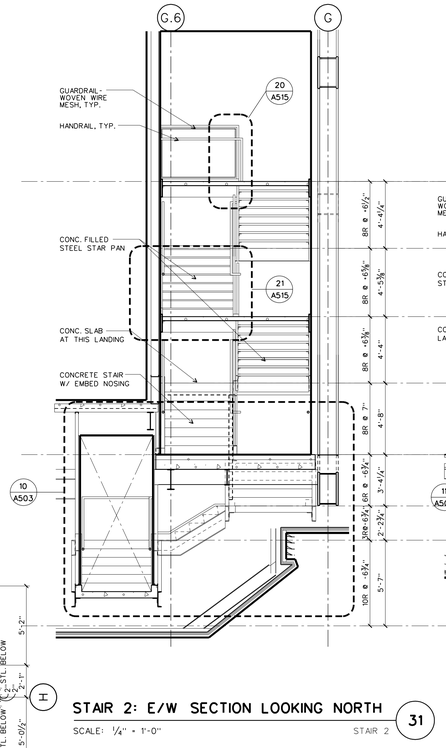


STAIR 2: E/W SECTION LOOKING NORTH 31

SCALE: ¼" = 1'-0" STAIR 2

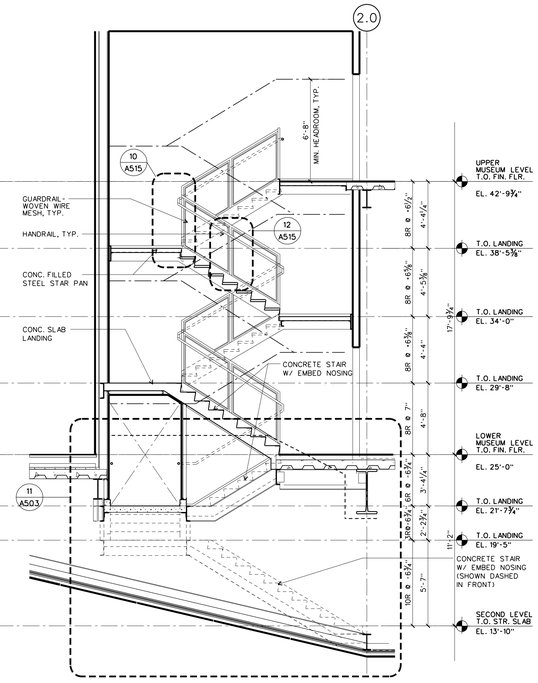


STAIR 2: N/S SECTION LOOKING EAST 30

SCALE: ¼" = 1'-0" STAIR 2

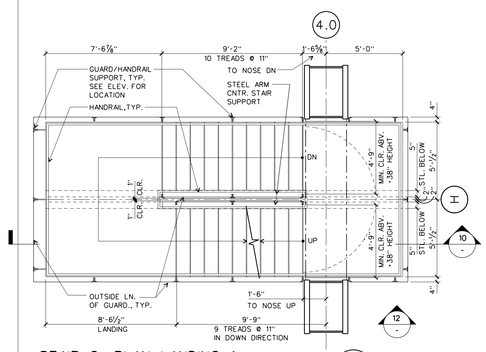


STAIR 2: PLAN LANDING 1 21

SCALE: ¼" = 1'-0" STAIR 2

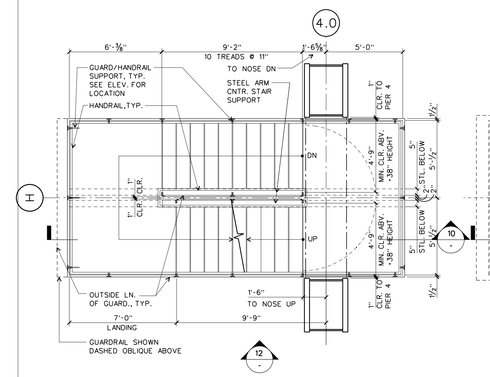


STAIR 2: PLAN LANDING 2 14

SCALE: ¼" = 1'-0" STAIR 2

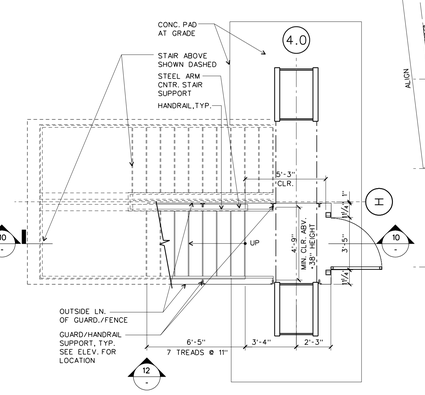


STAIR 2: PLAN LANDING 3 13

SCALE: ¼" = 1'-0" STAIR 2

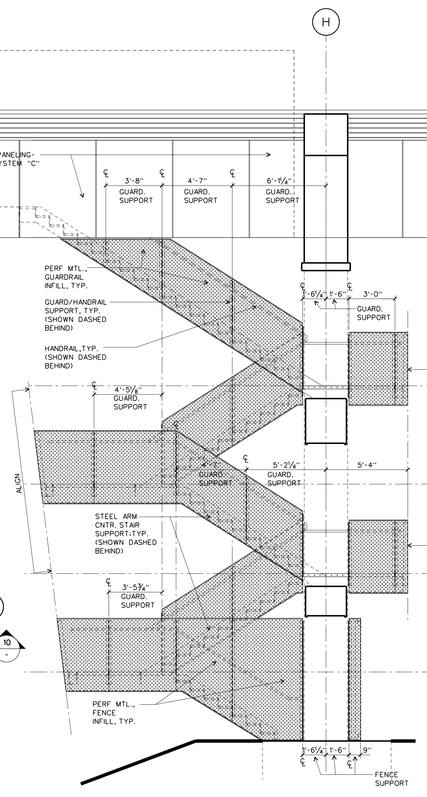


STAIR 2: ELEVATION 12

SCALE: ¼" = 1'-0" STAIR 2

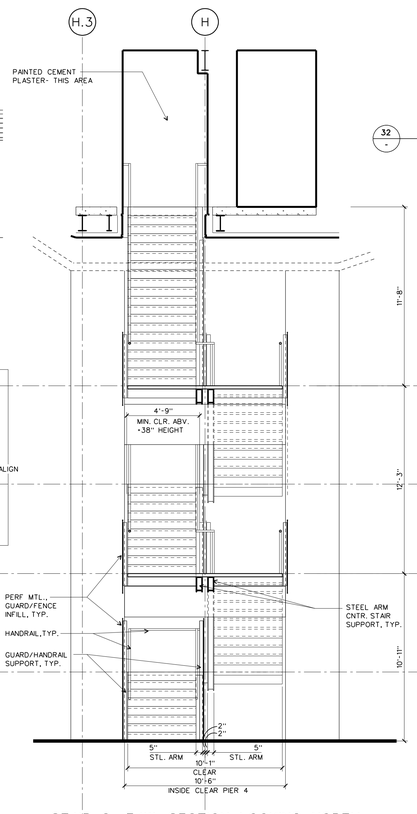

STAIR 2: E/W SECTION LOOKING NORTH 11

SCALE: ¼" = 1'-0" stair 2

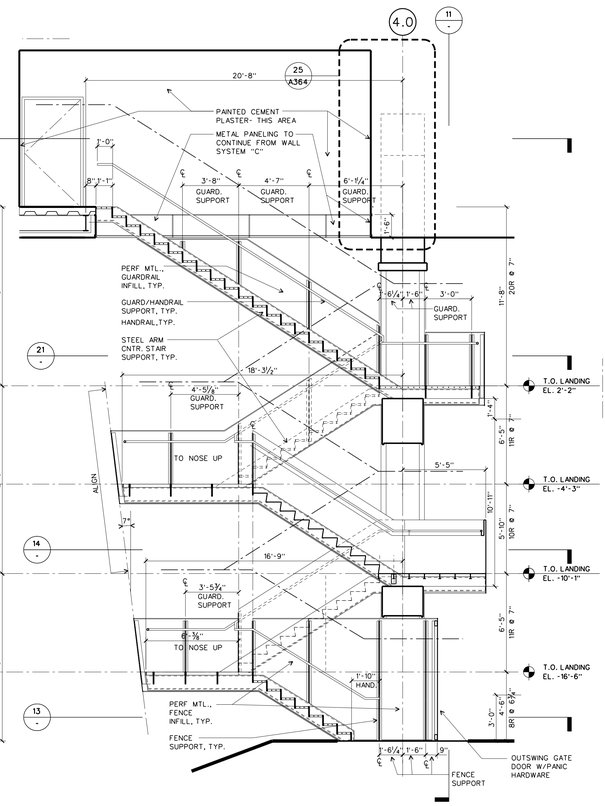

STAIR 2: N/S SECTION LOOKING EAST 10

SCALE: ¼" = 1'-0" stair 2

FOR OFFICIAL USE ONLY

WILLIAM J. CLINTON PRESIDENTIAL CENTER

LITTLE ROCK, ARKANSAS

Architect

POLSHEK PARTNERSHIP LLP
320 West 13th Street
New York, New York 10014
212.807.7171

Coordinating Architects

POLK STANLEY YEARY ARCHITECTS Ltd
700 South Schiller Street
Little Rock, Arkansas 72201
501.378.0878

WITSELL EVANS RASCO
901 West Third Street
Little Rock, Arkansas 72201
501.374.5300

WOODS CARADINE ARCHITECTS
2200 South Main Street
Little Rock, Arkansas 72206
501.374.4060

Landscape Architects

HARGREAVES ASSOCIATES
118 Magazine Street
Cambridge, Massachusettes 02139
617.661.0070

LANDSCAPE ARCHITECTURE, Inc.
2300 Cottondale Lane Suite 202
Little Rock, Arkansas 72202
501.374.5610

Structural Engineer

LESLIE E. ROBERTSON ASSOC., RLLP
30 Broad Street, 47th Floor
New York, New York 10004
212.750.9000

MEP Engineers

FLACK + KURTZ Inc.
475 Fifth Avenue
New York, New York 10017
212.532.9600

CROMWELL ARCHITECTS ENGINEERS
101 South Spring Street
Little Rock, Arkansas 72201
501.372.2900


Curtainwall Consultant

R. A. HEINTGES ARCHITECTS
126 Fifth Avenue, 9th Floor
New York, New York 10011
212.652-2966

Seal

Issue	Date
100% Construction Documents	09/27/02
90% Progress Printing	08/30/02
100% Struct./ CD Progress	07/01/02
Bridge Bldg. Substructure	06/14/02
100% Steel & Concrete CD & Architectural CD Progress	05/15/02
100% Design Development*	03/01/02

*Issued orig. A501/Former A502 dtls on A505

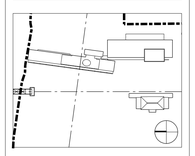

Job No. 9908

Scale 1/4"=1'-0"


Date September 27, 2002

Title

MUSEUM BUILDING
STAIR 2:
PLANS AND SECTIONS

Sheet No.

A502

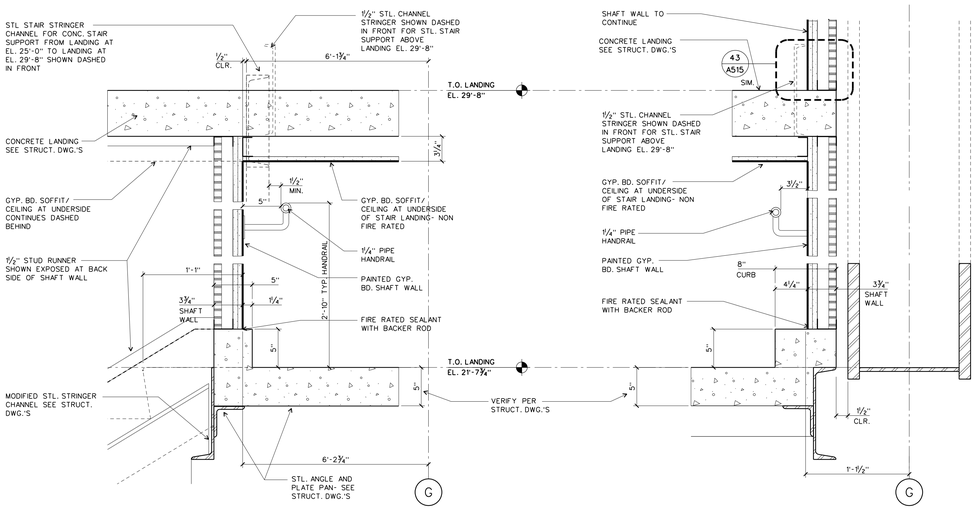

SECTION DETAIL AT WALL


1 ½" = 1'-0"

33

SECTION DETAIL AT CURB

1 ½" = 1'-0"


32

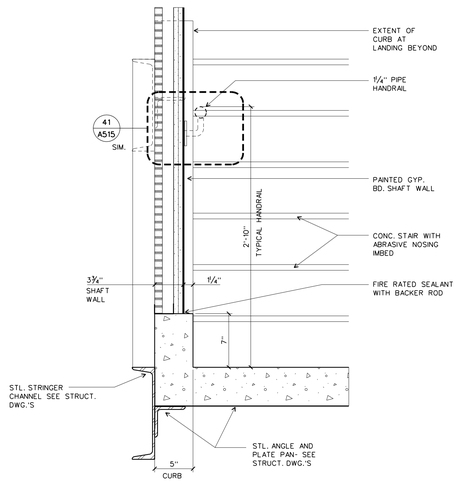

SECTION DETAIL AT WALL, TYPICAL

1 ½" = 1'-0"


23

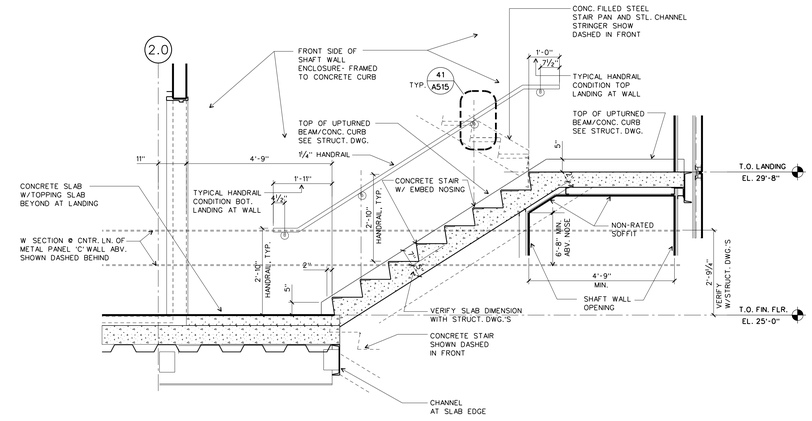

STAIR 2: N/S SECTION LOOKING WEST

SCALE: ½" = 1'-0"


21

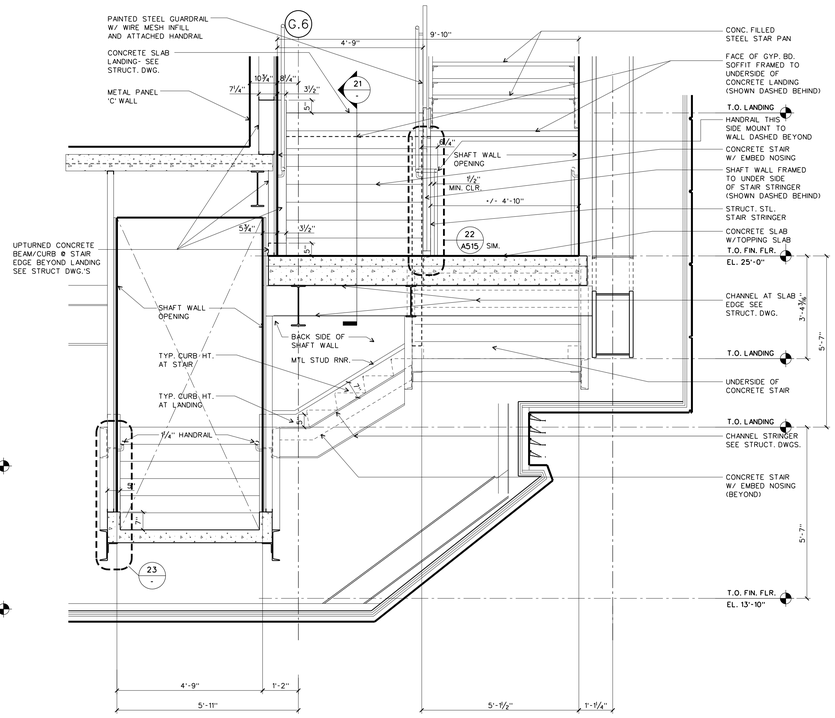

STAIR 2: E/W SECTION LOOKING NORTH

SCALE: ½" = 1'-0"


20

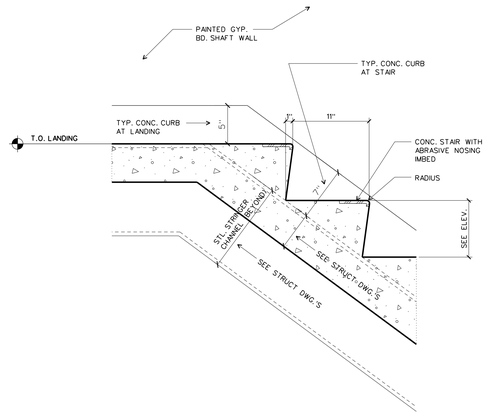

SECTION DETAIL THRU STAIR

1 ½" = 1'-0"


13

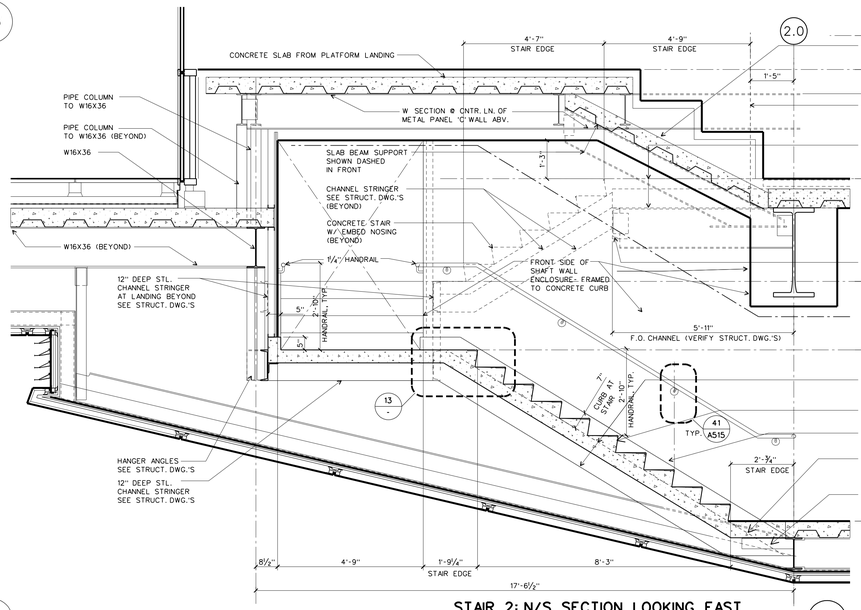

STAIR 2: N/S SECTION LOOKING EAST

SCALE: ½" = 1'-0"

11

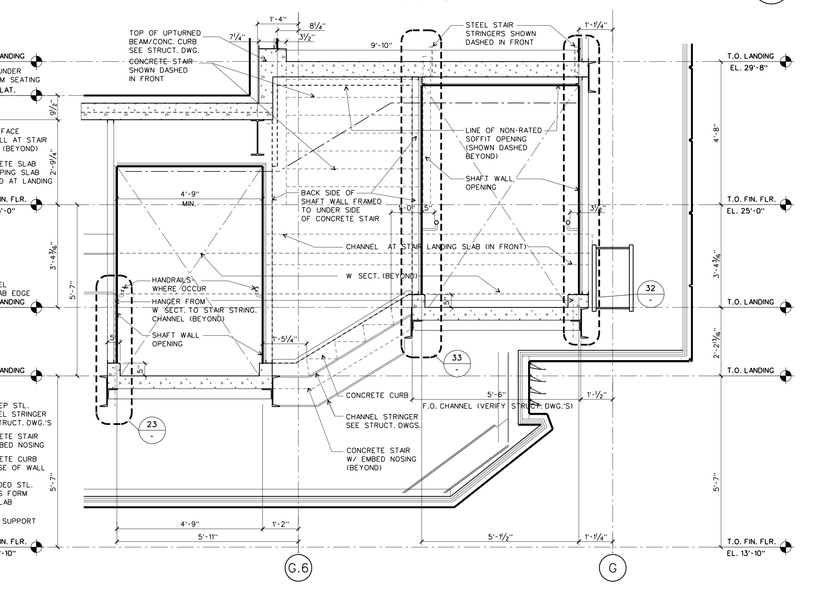

STAIR 2: E/W SECTION LOOKING NORTH

SCALE: ½" = 1'-0"

10

WILLIAM J. CLINTON PRESIDENTIAL CENTER

LITTLE ROCK, ARKANSAS

Architect

POLSHEK PARTNERSHIP LLP
320 West 13th Street
New York, New York 10014
212.807.7171

Coordinating Architects

POLK STANLEY YEARY ARCHITECTS Ltd
700 South Schiller Street
Little Rock, Arkansas 72201
501.378.0878

WITSELL EVANS RASCO
901 West Third Street
Little Rock, Arkansas 72201
501.374.5300

WOODS CARADINE ARCHITECTS
2200 South Main Street
Little Rock, Arkansas 72206
501.374.4060

Landscape Architects

HARGREAVES ASSOCIATES
118 Magazine Street
Cambridge, Massachusettes 02139
617.661.0070

LANDSCAPE ARCHITECTURE, Inc.
2300 Cottondale Lane Suite 202
Little Rock, Arkansas 72202
501.374.5610

Structural Engineer

LESLIE E. ROBERTSON ASSOC., RLLP
30 Broad Street, 47th Floor
New York, New York 10004
212.750.9000

MEP Engineers

FLACK + KURTZ Inc.
475 Fifth Avenue
New York, New York 10017
212.532.9600

CROMWELL ARCHITECTS ENGINEERS
101 South Spring Street
Little Rock, Arkansas 72201
501.372.2900


Curtainwall Consultant

R. A. HEINTGES ARCHITECTS
126 Fifth Avenue, 9th Floor
New York, New York 10011
212.652-2966

Seal

Issue	Date
100% Construction Documents	09/27/02
90% Progress Printing	08/30/02
100% Struct./ CD Progress	07/01/02
100% Steel & Concrete CD & Architectural CD Progress*	05/15/02

*New Sheet. Former A503 details on A506

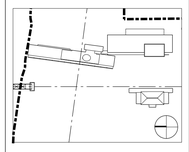

Job No. 9908

Scale: AS NOTED

Date: September 27, 2002

Title

MUSEUM BUILDING
STAIR 2: DETAILS

Sheet No.

A503

FOR OFFICIAL USE ONLY

WILLIAM J. CLINTON PRESIDENTIAL CENTER

LITTLE ROCK, ARKANSAS

Architect

POLSHEK PARTNERSHIP LLP
320 West 13th Street
New York, New York 10014
212.807.7171

Coordinating Architects

POLK STANLEY YEARY ARCHITECTS Ltd
700 South Schiller Street
Little Rock, Arkansas 72201
501.378.0878

WITSELL EVANS RASCO
901 West Third Street
Little Rock, Arkansas 72201
501.374.5300

WOODS CARADINE ARCHITECTS
2200 South Main Street
Little Rock, Arkansas 72206
501.374.4060

Landscape Architects

HARGREAVES ASSOCIATES
118 Magazine Street
Cambridge, Massachusettes 02139
617.661.0070

LANDSCAPE ARCHITECTURE, Inc.
2300 Cottondale Lane Suite 202
Little Rock, Arkansas 72202
501.374.5610

Structural Engineer

LESLIE E. ROBERTSON ASSOC., RLLP
30 Broad Street, 47th Floor
New York, New York 10004
212.750.9000

MEP Engineers

FLACK + KURTZ Inc.
475 Fifth Avenue
New York, New York 10017
212.532.9600


CROMWELL ARCHITECTS ENGINEERS
101 South Spring Street
Little Rock, Arkansas 72201
501.372.2900

Curtainwall Consultant

R. A. HEINTGES ARCHITECTS
126 Fifth Avenue, 9th Floor
New York, New York 10011
212.652-2966

Seal

Issue	Date
100% Construction Documents	09/27/02
90% Progress Printing	08/30/02
ASI #05	08/20/02
100% Struct./ CD Progress	07/01/02
Bridge Bldg. Substructure	06/14/02
100% Steel & Concrete CD	05/15/02
& Architectural CD Progress	
100% Design Development	03/01/02

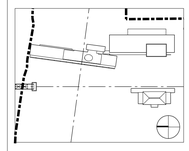

Job No.
9908


Scale
AS NOTED

Date
September 27, 2002

Title
ORNAMENTAL STAIR RAILINGS

Sheet No.
A504


FOR OFFICIAL USE ONLY

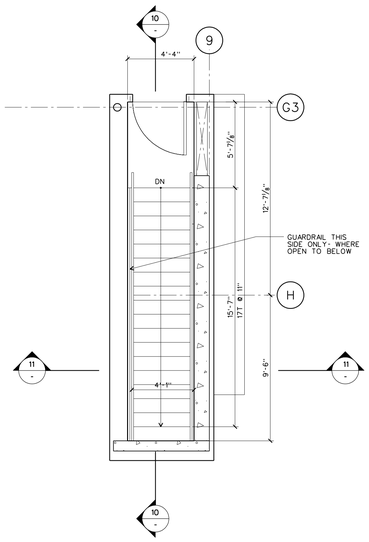

STAIR 4: EXECUTIVE LEVEL PLAN

SCALE: 1/4" = 1'-0"


PLANS/STAIR 4 — 33

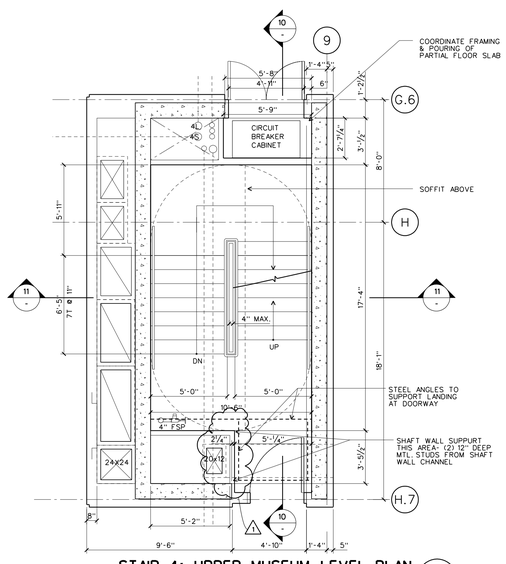

STAIR 4: UPPER MUSEUM LEVEL PLAN

SCALE: 1/4" = 1'-0"


PLANS/STAIR 4 — 32

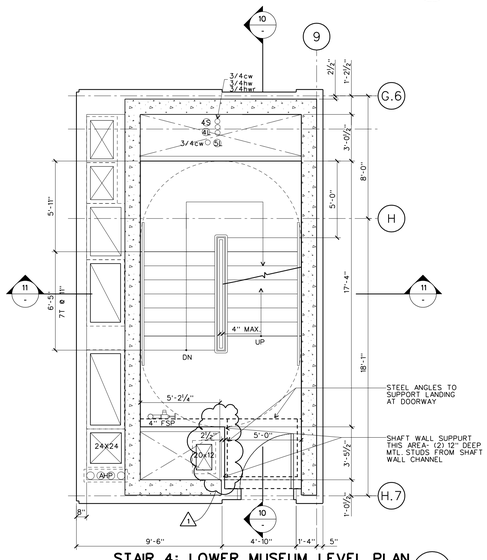

STAIR 4: LOWER MUSEUM LEVEL PLAN

SCALE: 1/4" = 1'-0"


PLANS/STAIR 4 — 23

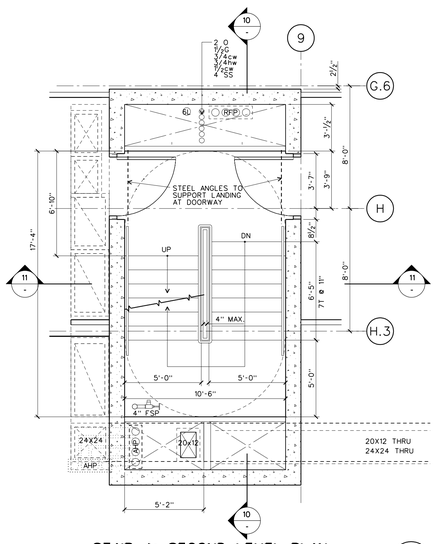

STAIR 4: SECOND LEVEL PLAN

SCALE: 1/4" = 1'-0"


PLANS/STAIR 4 — 22

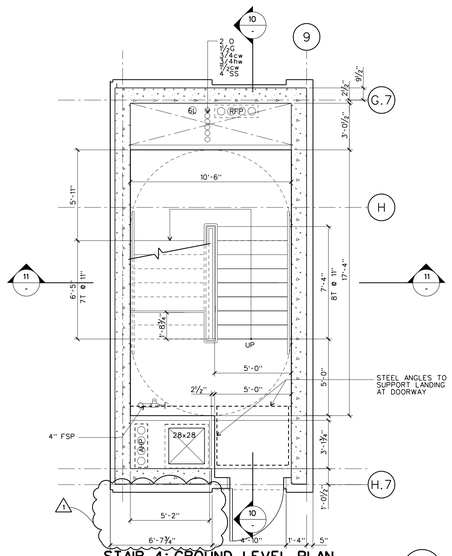

STAIR 4: GROUND LEVEL PLAN

SCALE: 1/4" = 1'-0"


PLANS/STAIR 4 — 13

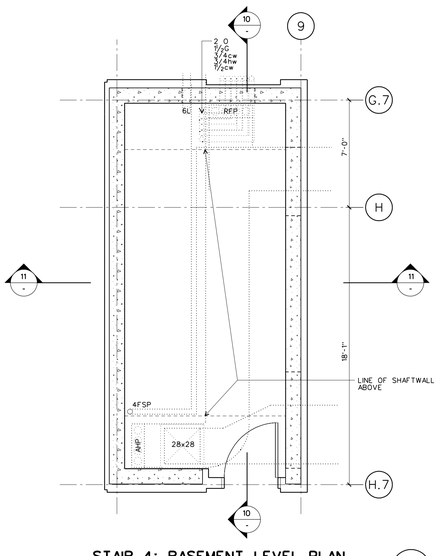

STAIR 4: BASEMENT LEVEL PLAN

SCALE: 1/4" = 1'-0"


PLANS/STAIR 4 — 12

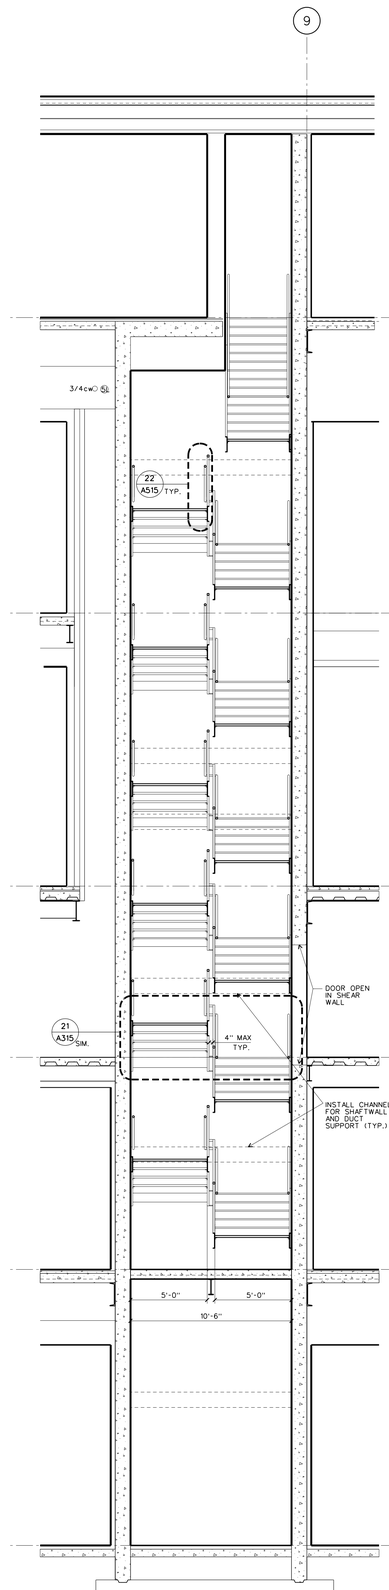

STAIR 4 NORTH SOUTH SECTION LOOKING EAST

SCALE: 1/4" = 1'-0"

PLANS/STAIR 4 — 11

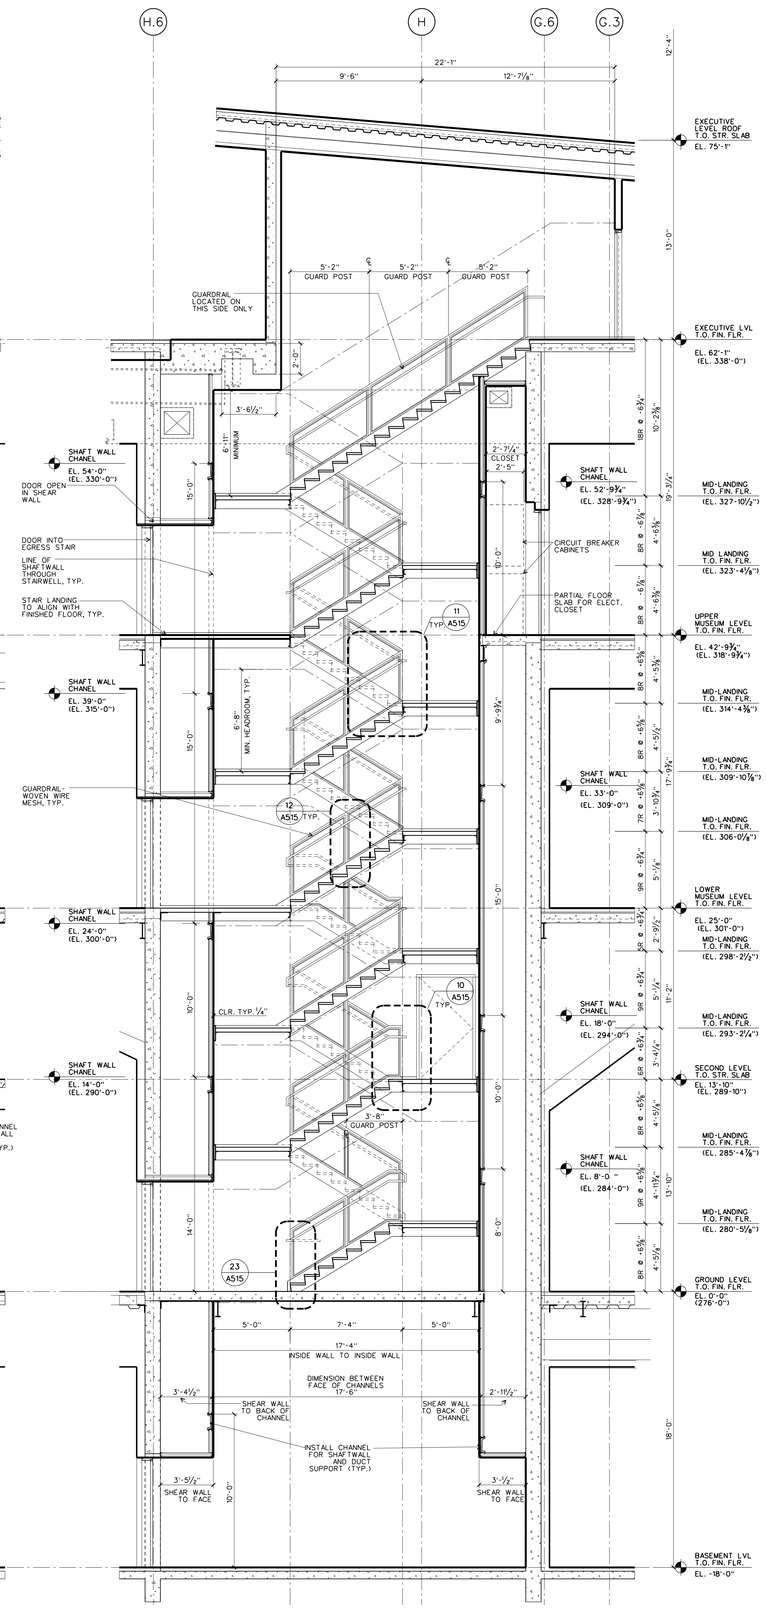

STAIR 4 EAST WEST SECTION LOOKING NORTH

SCALE: 1/4" = 1'-0"

PLANS/STAIR 4 — 10

WILLIAM J. CLINTON PRESIDENTIAL CENTER

LITTLE ROCK, ARKANSAS

Architect

POLSHEK PARTNERSHIP LLP
320 West 13th Street
New York, New York 10014
212.807.7171

Coordinating Architects

POLK STANLEY YEARY ARCHITECTS Ltd
700 South Schiller Street
Little Rock, Arkansas 72201
501.378.0878

WITSELL EVANS RASCO
901 West Third Street
Little Rock, Arkansas 72201
501.374.5300

WOODS CARADINE ARCHITECTS
2200 South Main Street
Little Rock, Arkansas 72206
501.374.4060

Landscape Architects

HARGREAVES ASSOCIATES
118 Magazine Street
Cambridge, Massachusettes 02139
617.661.0070

LANDSCAPE ARCHITECTURE, Inc.
2300 Cottondale Lane Suite 202
Little Rock, Arkansas 72202
501.374.5610

Structural Engineer

LESLIE E. ROBERTSON ASSOC., RLLP
30 Broad Street, 47th Floor
New York, New York 10004
212.750.9000

MEP Engineers

FLACK + KURTZ Inc.
475 Fifth Avenue
New York, New York 10017
212.532.9600

CROMWELL ARCHITECTS ENGINEERS
101 South Spring Street
Little Rock, Arkansas 72201
501.372.2900

Curtainwall Consultant

R. A. HEINTGES ARCHITECTS
126 Fifth Avenue, 9th Floor
New York, New York 10011
212.652-2966

Seal

	Issue	Date
1	ASI #23	09/12/03
	100% Construction Documents	09/27/02
	90% Progress Printing	08/30/02
	100% Struct./ CD Progress	07/01/02
	Bridge Bldg. Substructure	06/14/02
	100% Steel & Concrete CD	05/15/02
	& Architectural CD Progress	
	100% Design Development*	03/01/02

*Issued orig. A502/Former A505 dtls on A510

Job No. 9908

Scale 1/4"=1'-0"

Date September 27, 2002


Title

MUSEUM BUILDING STAIR 4: PLANS AND SECTIONS

Sheet No.


A505

FOR OFFICIAL USE ONLY

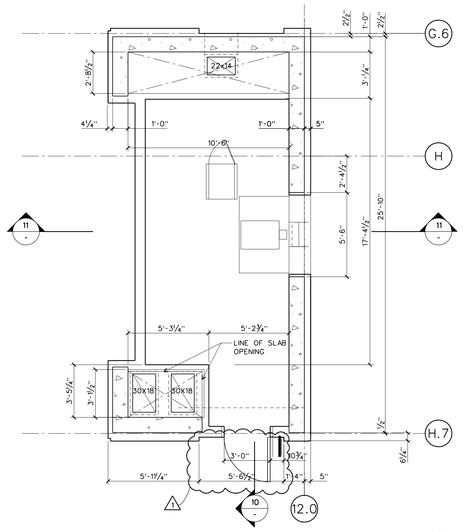


STAIR 5: MUSEUM UPPER LEVEL PLAN

SCALE: ¼" = 1'-0" PLANS/STAIR 5 30

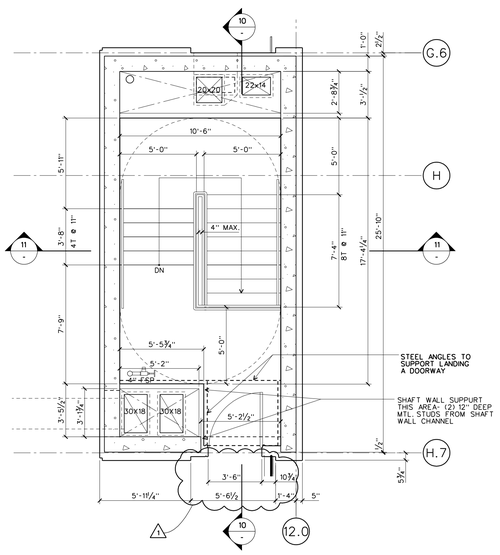


STAIR 5: MUSEUM LOWER LEVEL PLAN

SCALE: ¼" = 1'-0" PLANS/STAIR 5 21

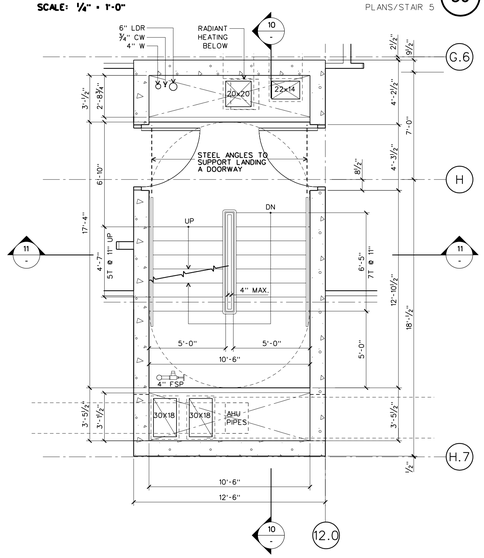


STAIR 5: SECOND LEVEL PLAN

SCALE: ¼" = 1'-0" PLANS/STAIR 5 20

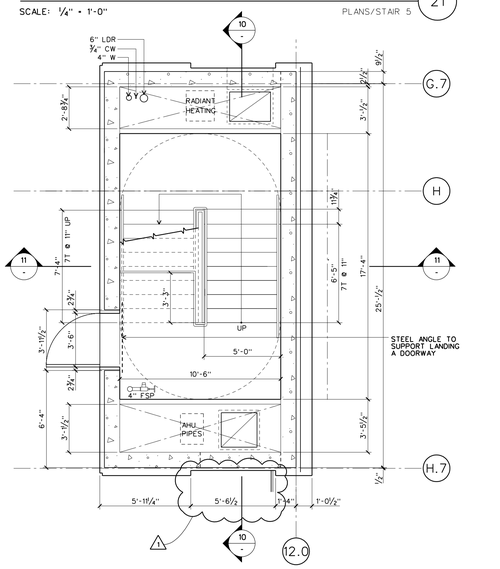

STAIR 5: GROUND LEVEL PLAN

SCALE: ¼" = 1'-0" PLANS/STAIR 5 13

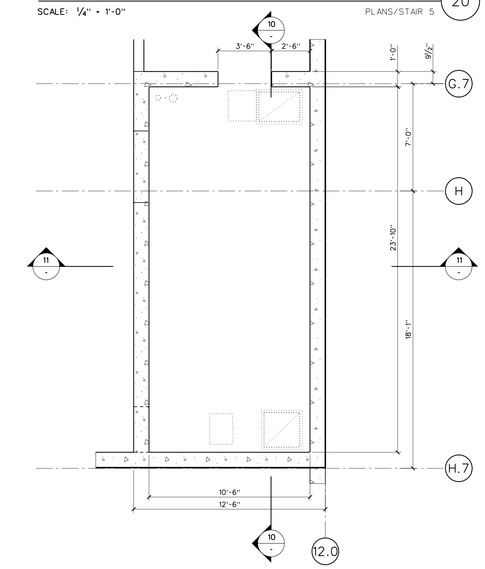


STAIR 5: SECOND LEVEL PLAN

SCALE: ¼" = 1'-0" PLANS/STAIR 5 20

STAIR 5: BASEMENT LEVEL PLAN

SCALE: ¼" = 1'-0" PLANS/STAIR 5 12

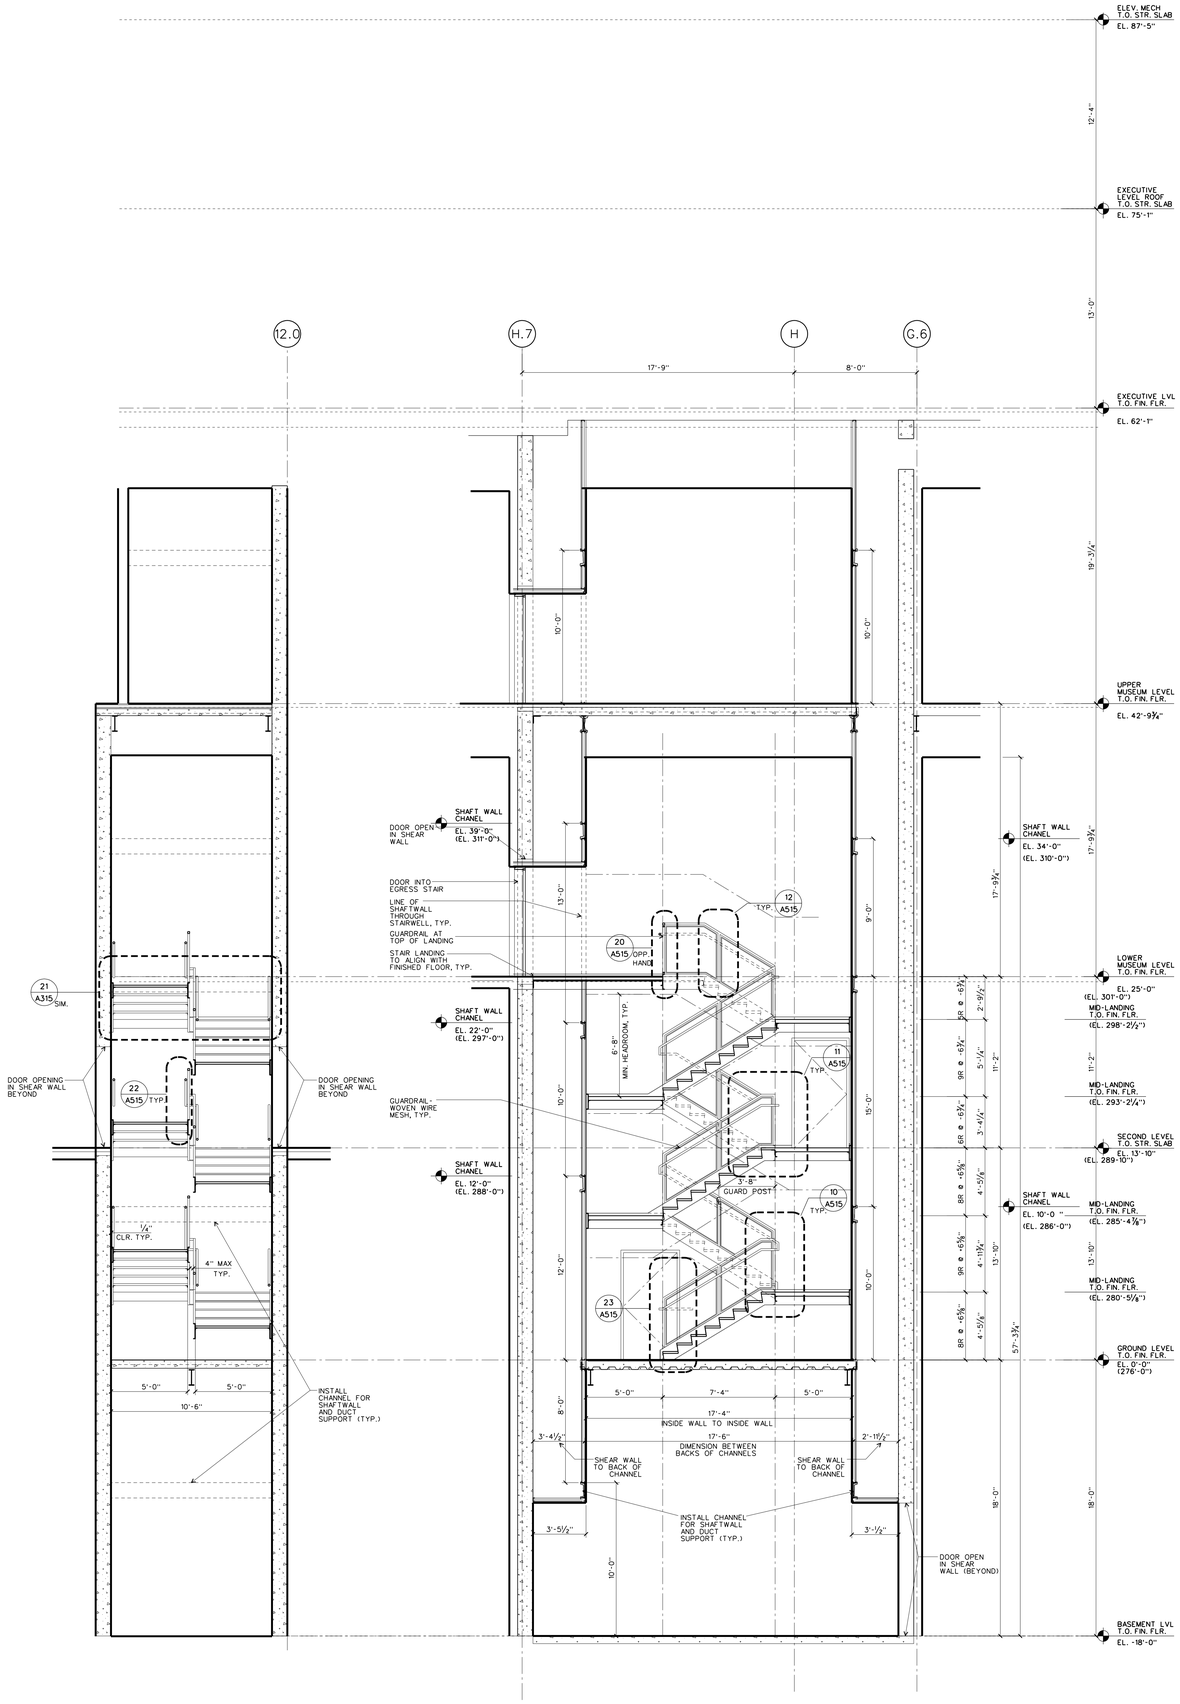

STAIR 5: N/S SECTION LOOKING EAST

SCALE: ¼" = 1'-0" PLANS/STAIR 5 11

STAIR 5: E/W SECTION LOOKING NORTH

SCALE: ¼" = 1'-0" PLANS/STAIR 5 10

WILLIAM J. CLINTON PRESIDENTIAL CENTER

LITTLE ROCK, ARKANSAS

Architect

POLSHEK PARTNERSHIP LLP
320 West 13th Street
New York, New York 10014
212.807.7171

Coordinating Architects

POLK STANLEY YEARY ARCHITECTS Ltd
700 South Schiller Street
Little Rock, Arkansas 72201
501.378.0878

WITSELL EVANS RASCO
901 West Third Street
Little Rock, Arkansas 72201
501.374.5300

WOODS CARADINE ARCHITECTS
2200 South Main Street
Little Rock, Arkansas 72206
501.374.4060

Landscape Architects

HARGREAVES ASSOCIATES
118 Magazine Street
Cambridge, Massachusettes 02139
617.661.0070

LANDSCAPE ARCHITECTURE, Inc.
2300 Cottondale Lane Suite 202
Little Rock, Arkansas 72202
501.374.5610

Structural Engineer

LESLIE E. ROBERTSON ASSOC., RLLP
30 Broad Street, 47th Floor
New York, New York 10004
212.750.9000

MEP Engineers

FLACK + KURTZ Inc.
475 Fifth Avenue
New York, New York 10017
212.532.9600

CROMWELL ARCHITECTS ENGINEERS
101 South Spring Street
Little Rock, Arkansas 72201
501.372.2900

Curtainwall Consultant

R. A. HEINTGES ARCHITECTS
126 Fifth Avenue, 9th Floor
New York, New York 10011
212.652-2966

Seal

Issue	Date
1 ASI #23	09/12/03
100% Construction Documents	09/27/02
90% Progress Printing	08/30/02
100% Struct./ CD Progress	07/01/02
Bridge Bldg. Substructure	06/14/02
100% Steel & Concrete CD	05/15/02
& Architectural CD Progress	
100% Design Development*	03/01/02

*Issued orig. A503/Former A506 dtls on A511

Job No. 9908

Scale AS NOTED

Date September 27, 2002


Title

MUSEUM BUILDING
STAIR 5: PLANS AND SECTIONS

Sheet No.


A506

FOR OFFICIAL USE ONLY

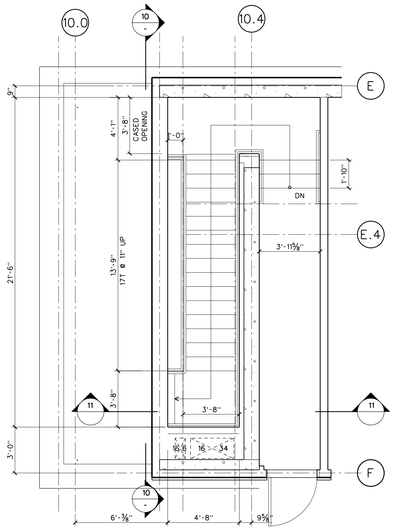


STAIR 6: MECH LEVEL PLAN 31

SCALE: 1/4" = 1'-0"

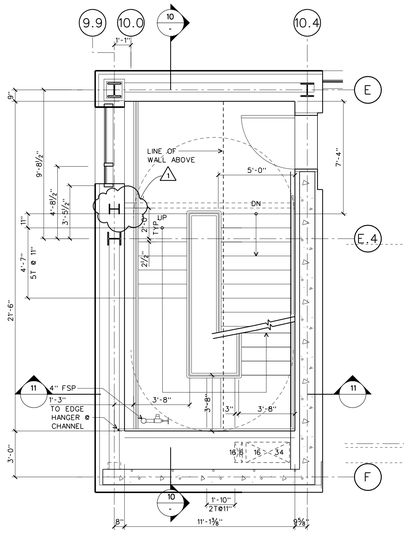


STAIR 6: EXEC LEVEL PLAN 30

SCALE: 1/4" = 1'-0"

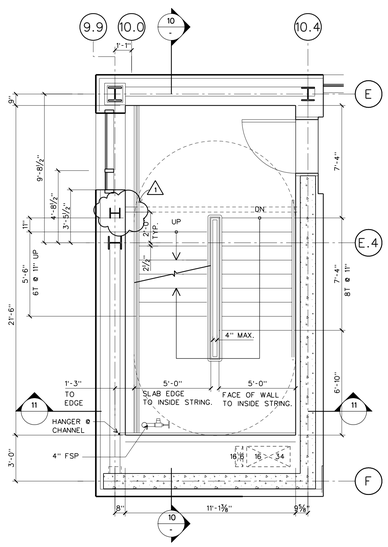


STAIR 6: INTERMEDIATE LEVEL PLAN 22

SCALE: 1/4" = 1'-0"

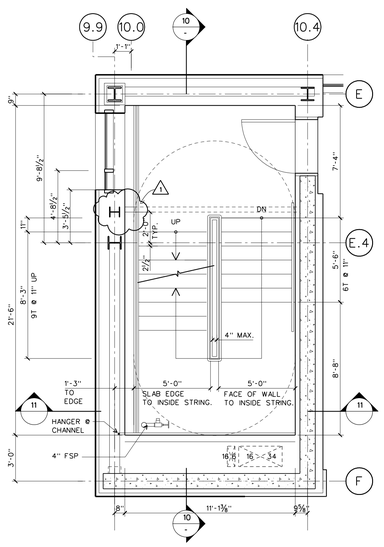


STAIR 6: UPPER MUSEUM LEVEL 21

SCALE: 1/4" = 1'-0"

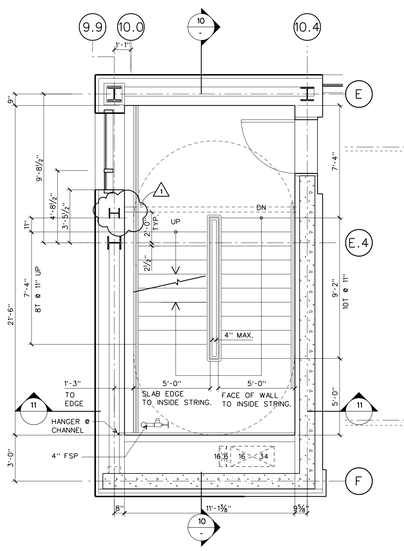


STAIR 6: MUSEUM LOWER LEVEL 20

SCALE: 1/4" = 1'-0"

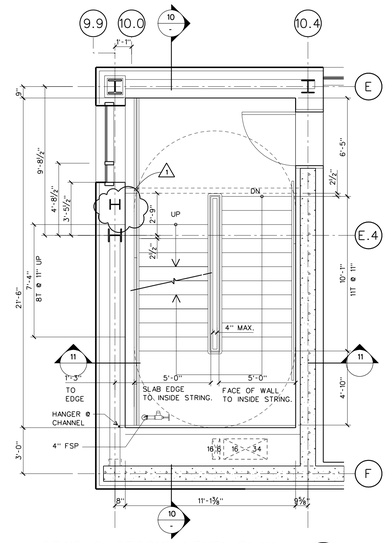


STAIR 6: SECOND LEVEL PLAN 14

SCALE: 1/4" = 1'-0"

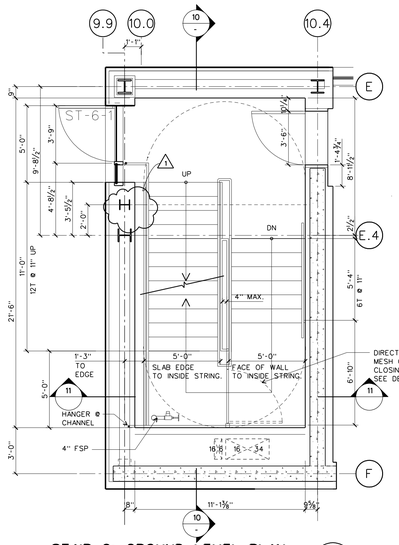


STAIR 6: GROUND LEVEL PLAN 13

SCALE: 1/4" = 1'-0"

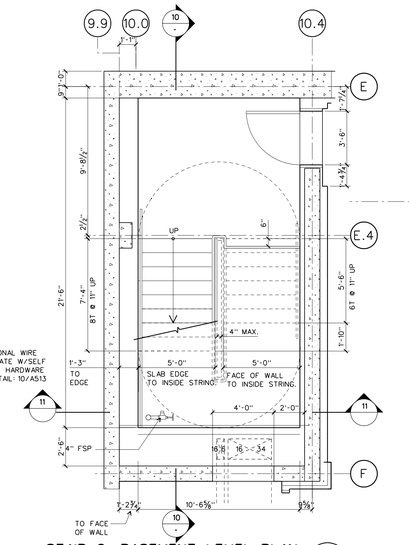


STAIR 6: BASEMENT LEVEL PLAN 12

SCALE: 1/4" = 1'-0"

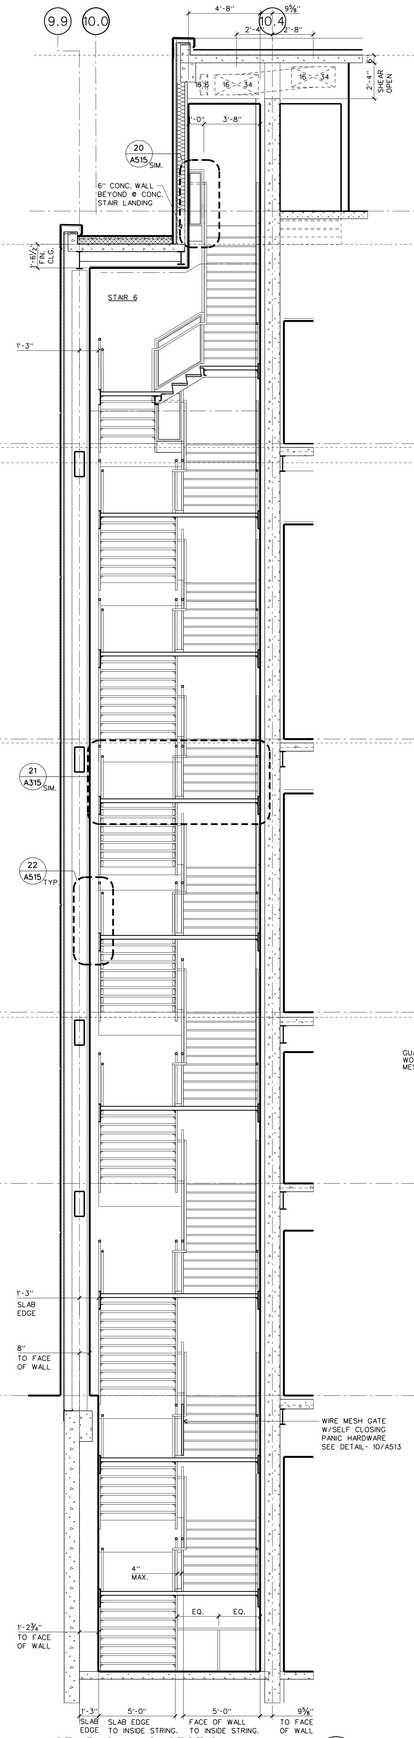

STAIR 6: N/S SECTION 11

SCALE: 1/4" = 1'-0"

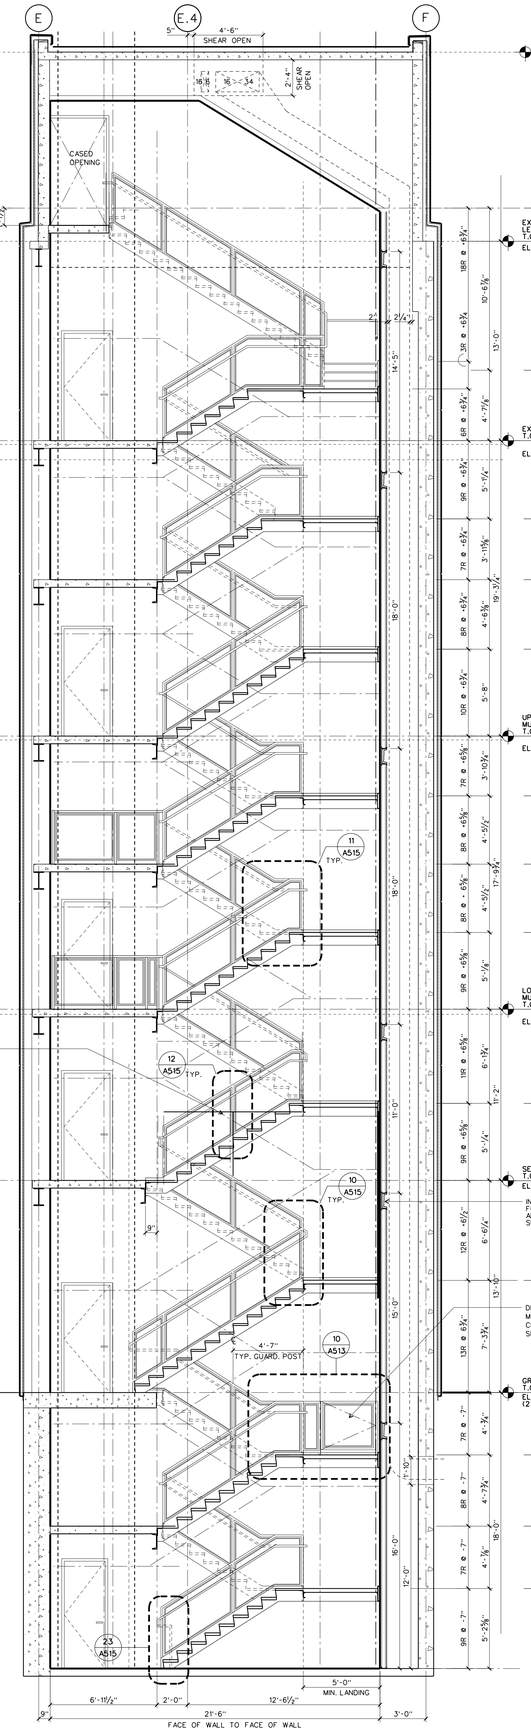

STAIR 6: E/W SECTION 10

SCALE: 1/4" = 1'-0"

ELEV. MECH T.O. STR. SLAB EL. 87'-5"

ELEVATOR MACHINE ROOM T.O. FIN. FLR. (EL. 353'-3")

EXECUTIVE LEVEL ROOF T.O. STR. SLAB EL. 75'-1"

MID-LANDING T.O. FIN. FLR. (EL. 342'-7⅞")

EXECUTIVE LVL T.O. FIN. FLR. EL. 62'-1" (EL. 338'-0")

MID-LANDING T.O. FIN. FLR. (EL. 332'-11¾")

MID-LANDING T.O. FIN. FLR. (EL. 329'-0¼")

MID LANDING T.O. FIN. FLR. (EL. 324'-5⅞")

UPPER MUSEUM LEVEL T.O. FIN. FLR. EL. 42'-9⅝" (EL. 318'-9¾")

MID-LANDING T.O. FIN. FLR. (EL. 314'-11¼")

MID-LANDING T.O. FIN. FLR. (EL. 310'-5¾")

MID-LANDING T.O. FIN. FLR. (EL. 306'-0¼")

LOWER MUSEUM LEVEL T.O. FIN. FLR. EL. 25'-0" (EL. 301'-0")

MID-LANDING T.O. FIN. FLR. (EL. 294'-10¼")

SECOND LEVEL T.O. STR. SLAB EL. 13'-10" (EL. 289-10")

INSTALL CHANNEL FOR SHAFTWALL AND DUCT SUPPORT (TYP.)

MID-LANDING T.O. FIN. FLR. (EL. 283'-3¾")

DIRECTIONAL WIRE MESH GATE W/SELF CLOSING HARDWARE SEE DETAIL- 10/A513

GROUND LEVEL T.O. FIN. FLR. EL. 0'-0" (276'-0")

MID-LANDING T.O. FIN. FLR. (EL. 271'-11¼")

MID-LANDING T.O. FIN. FLR. (EL. 267'-3½")

MID-LANDING T.O. FIN. FLR. (EL. 263'-2⅝")

WILLIAM J. CLINTON PRESIDENTIAL CENTER

LITTLE ROCK, ARKANSAS

Architect

POLSHEK PARTNERSHIP LLP
320 West 13th Street
New York, New York 10014
212.807.7171

Coordinating Architects

POLK STANLEY YEARY ARCHITECTS Ltd
700 South Schiller Street
Little Rock, Arkansas 72201
501.378.0878

WITSELL EVANS RASCO
901 West Third Street
Little Rock, Arkansas 72201
501.374.5300

WOODS CARADINE ARCHITECTS
2200 South Main Street
Little Rock, Arkansas 72206
501.374.4060

Landscape Architects

HARGREAVES ASSOCIATES
118 Magazine Street
Cambridge, Massachusettes 02139
617.661.0070

LANDSCAPE ARCHITECTURE, Inc.
2300 Cottondale Lane Suite 202
Little Rock, Arkansas 72202
501.374.5610

Structural Engineer

LESLIE E. ROBERTSON ASSOC., RLLP
30 Broad Street, 47th Floor
New York, New York 10004
212.750.9000

MEP Engineers

FLACK + KURTZ Inc.
475 Fifth Avenue
New York, New York 10017
212.532.9600

CROMWELL ARCHITECTS ENGINEERS
101 South Spring Street
Little Rock, Arkansas 72201
501.372.2900

Curtainwall Consultant

R. A. HEINTGES ARCHITECTS
126 Fifth Avenue, 9th Floor
New York, New York 10011
212.652-2966

Seal

Issue	Date
1 Addendum #2	11/15/02
100% Construction Documents	09/27/02
90% Progress Printing	08/30/02
100% Struct./ CD Progress	07/01/02
Bridge Bldg. Substructure	06/14/02
100% Steel & Concrete CD	05/15/02
& Architectural CD Progress	
100% Design Development*	03/01/02

*Issued originally as A504

Job No. 9908

Scale 1/4"= 1'-0"

Date September 27, 2002


Title

MUSEUM BUILDING
STAIR 6: PLANS AND SECTIONS

Sheet No.


A507

FOR OFFICIAL USE ONLY

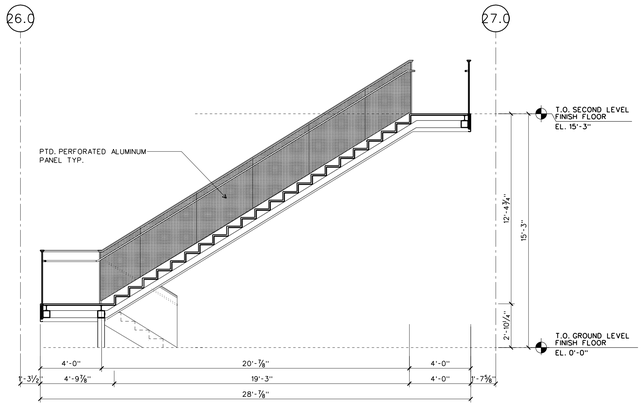


STAIR 12: N/S SECTION LOOKING EAST

SCALE: 1/4" = 1'-0" stair 8-9-12 32

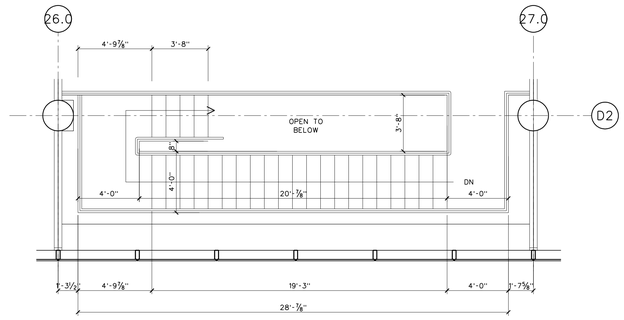


STAIR 12: SECOND LEVEL PLAN

SCALE: 1/4" = 1'-0" stair 8-9-12 31

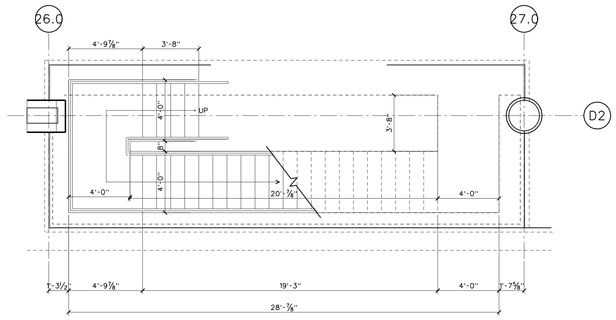


STAIR 12: GROUND LEVEL PLAN

SCALE: 1/4" = 1'-0" stair 8-9-12 30

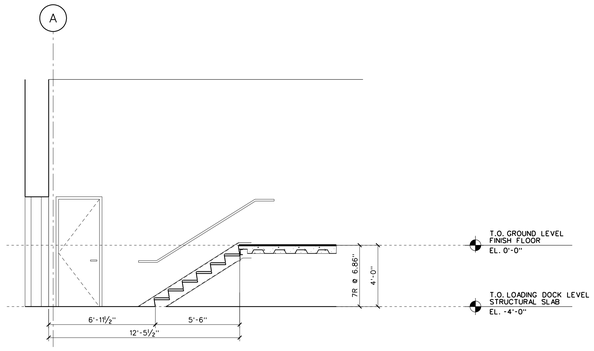


STAIR 9: E/W SECTION LOOKING SOUTH

SCALE: 1/4" = 1'-0" stair 8-9-12 XX

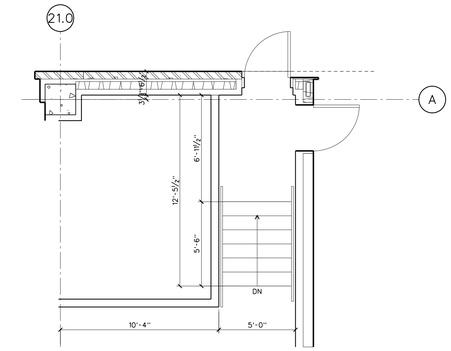


STAIR 9: GROUND LEVEL PLAN

SCALE: 1/4" = 1'-0" stair 8-9-12 XX

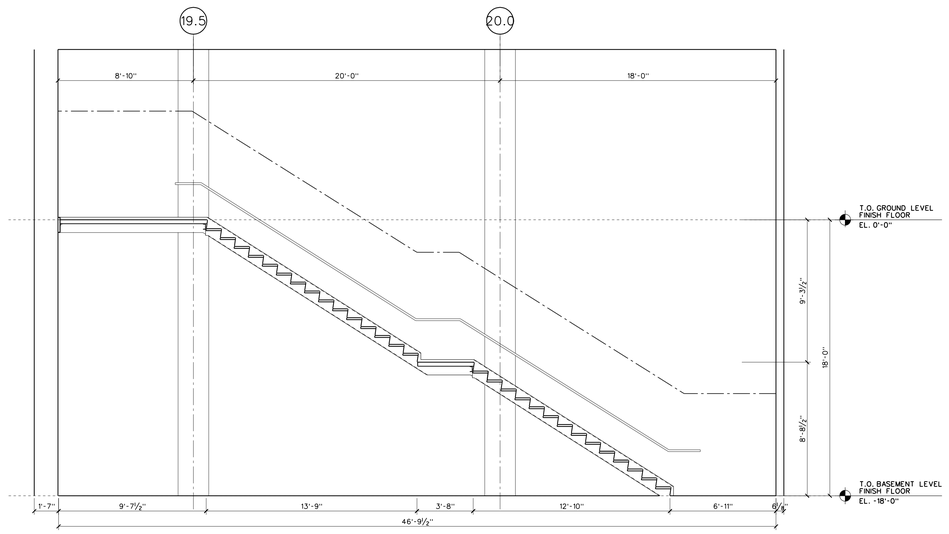


STAIR 8: N/S SECTION LOOKING EAST

SCALE: 1/4" = 1'-0" stair 8-9-12 12

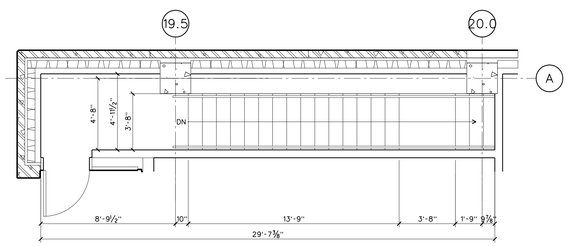

STAIR 8: GROUND LEVEL PLAN

SCALE: 1/4" = 1'-0" stair 8-9-12 11

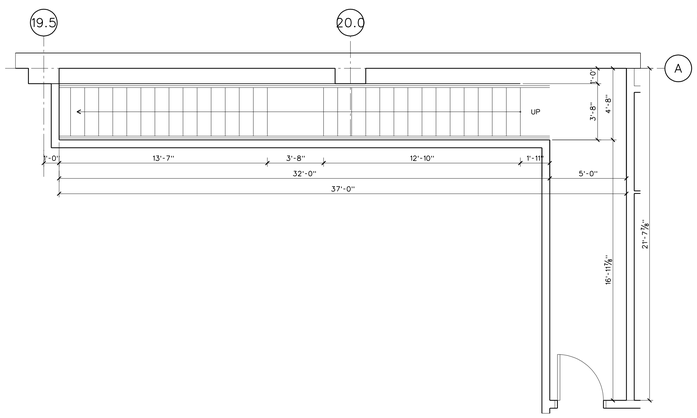

STAIR 8: BASEMENT LEVEL PLAN

SCALE: 1/4" = 1'-0" stair 8-9-12 10

WILLIAM J. CLINTON PRESIDENTIAL CENTER

LITTLE ROCK, ARKANSAS

Architect

POLSHEK PARTNERSHIP LLP
320 West 13th Street
New York, New York 10014
212.807.7171

Coordinating Architects

POLK STANLEY YEARY ARCHITECTS Ltd
700 South Schiller Street
Little Rock, Arkansas 72201
501.378.0878

WITSELL EVANS RASCO
901 West Third Street
Little Rock, Arkansas 72201
501.374.5300

WOODS CARADINE ARCHITECTS
2200 South Main Street
Little Rock, Arkansas 72206
501.374.4060

Landscape Architects

HARGREAVES ASSOCIATES
118 Magazine Street
Cambridge, Massachusettes 02139
617.661.0070

LANDSCAPE ARCHITECTURE, Inc.
2300 Cottondale Lane Suite 202
Little Rock, Arkansas 72202
501.374.5610

Structural Engineer

LESLIE E. ROBERTSON ASSOC., RLLP
30 Broad Street, 47th Floor
New York, New York 10004
212.750.9000

MEP Engineers

FLACK + KURTZ Inc.
475 Fifth Avenue
New York, New York 10017
212.532.9600


CROMWELL ARCHITECTS ENGINEERS
101 South Spring Street
Little Rock, Arkansas 72201
501.372.2900

Curtainwall Consultant

R. A. HEINTGES ARCHITECTS
126 Fifth Avenue, 9th Floor
New York, New York 10011
212.652-2966

Seal

Issue	Date
100% Construction Documents	09/27/02
90% Progress Printing	08/30/02
ASI #05	08/20/02
100% Struct./ CD Progress	07/01/02
Bridge Bldg. Substructure	06/14/02
100% Steel & Concrete CD	05/15/02
& Architectural CD Progress	
100% Design Development	03/01/02

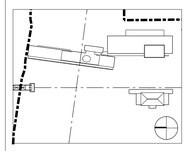

Job No. 9908

Scale 1/4" = 1'-0"

Date September 27, 2002


Title

STAIR 8, 9 AND 12 PLANS AND SECTIONS

Sheet No.


A510

FOR OFFICIAL USE ONLY

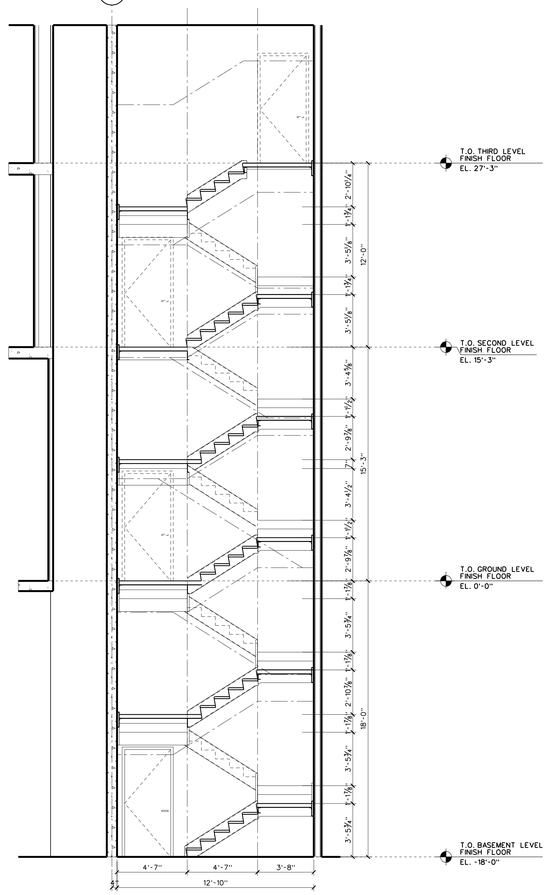


STAIR 10: N/S SECTION LOOKING EAST — 33

SCALE: 1/4" = 1'-0" REF FILE NAME

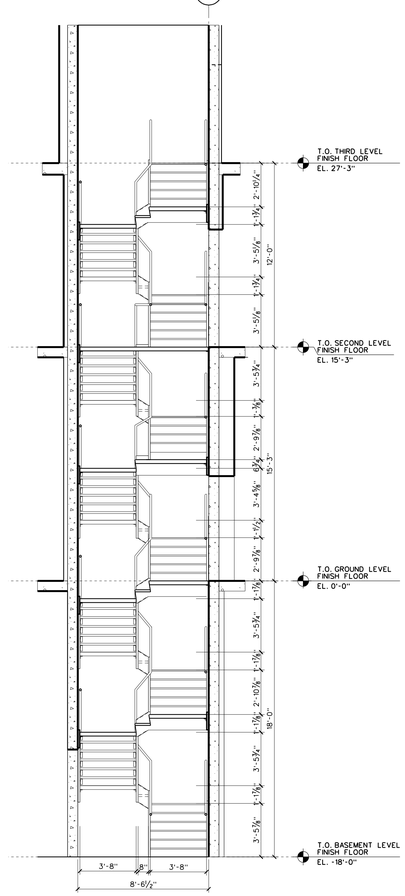


STAIR 10: E/W SECTION LOOKING SOUTH — 32

SCALE: 1/4" = 1'-0" REF FILE NAME

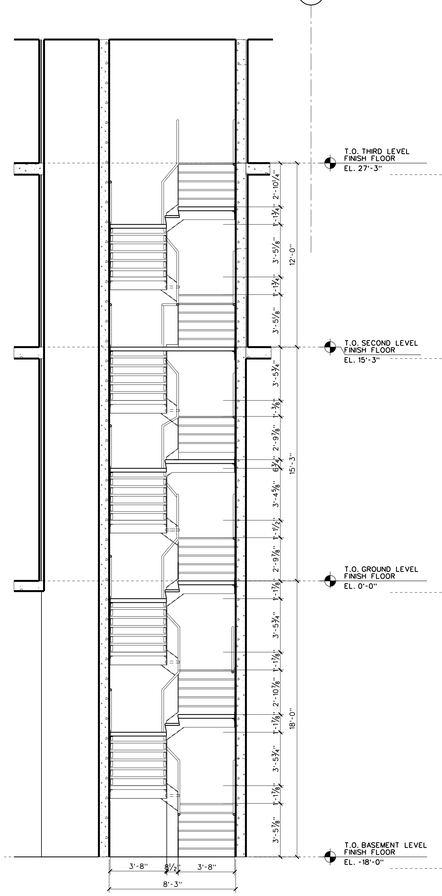


STAIR 11: N/S SECTION LOOKING EAST — 31

SCALE: 1/4" = 1'-0" REF FILE NAME

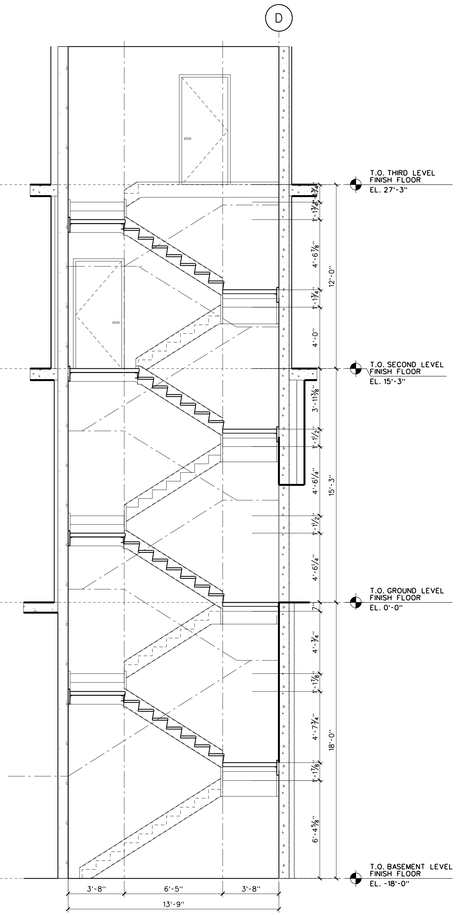


STAIR 11: E/W SECTION LOOKING SOUTH — 30

SCALE: 1/4" = 1'-0" REF FILE NAME

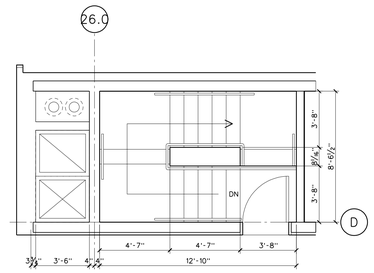


STIAR 10: THIRD LEVEL PLAN — 23

SCALE: 1/4" = 1'-0" REF FILE NAME

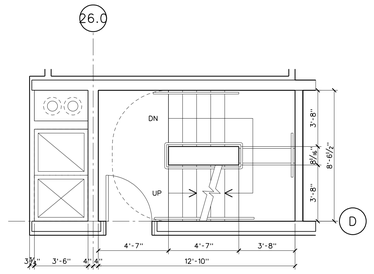


STAIR 10: SECOND LEVEL PLAN — 22

SCALE: 1/4" = 1'-0" REF FILE NAME

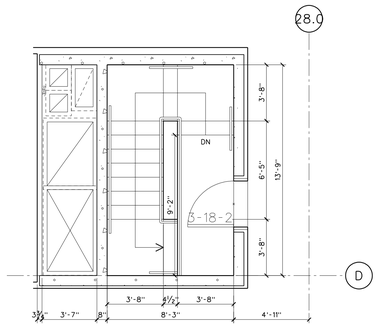


STAIR 11: THIRD LEVEL PLAN — 21

SCALE: 1/4" = 1'-0" REF FILE NAME

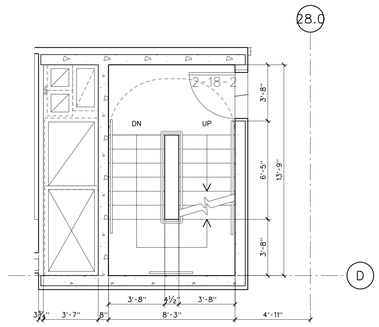


STAIR 11: SECOND LEVEL PLAN — 20

SCALE: 1/4" = 1'-0" REF FILE NAME

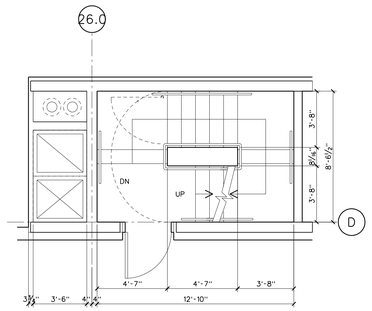


STAIR 10: GROUND LEVEL PLAN — 13

SCALE: 1/4" = 1'-0" REF FILE NAME

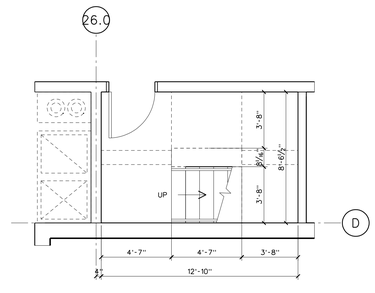


STAIR 10: BASEMENT LEVEL PLAN — 12

SCALE: 1/4" = 1'-0" REF FILE NAME

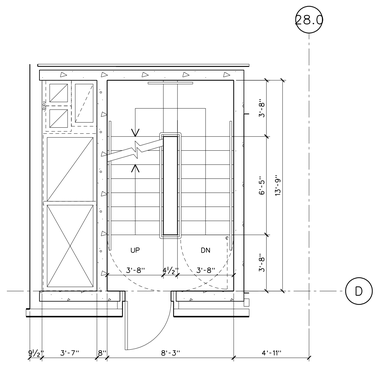

STAIR 11: GROUND LEVEL PLAN — 11

SCALE: 1/4" = 1'-0" REF FILE NAME

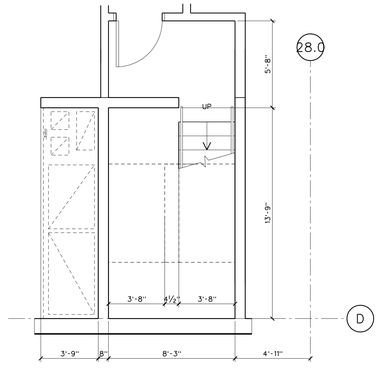

STAIR 11: BASEMENT LEVEL PLAN — 10

SCALE: 1/4" = 1'-0" REF FILE NAME

WILLIAM J. CLINTON PRESIDENTIAL CENTER

LITTLE ROCK, ARKANSAS

Architect

POLSHEK PARTNERSHIP LLP
320 West 13th Street
New York, New York 10014
212.807.7171

Coordinating Architects

POLK STANLEY YEARY ARCHITECTS Ltd
700 South Schiller Street
Little Rock, Arkansas 72201
501.378.0878

WITSELL EVANS RASCO
901 West Third Street
Little Rock, Arkansas 72201
501.374.5300

WOODS CARADINE ARCHITECTS
2200 South Main Street
Little Rock, Arkansas 72206
501.374.4060

Landscape Architects

HARGREAVES ASSOCIATES
118 Magazine Street
Cambridge, Massachusettes 02139
617.661.0070

LANDSCAPE ARCHITECTURE, Inc.
2300 Cottondale Lane Suite 202
Little Rock, Arkansas 72202
501.374.5610

Structural Engineer

LESLIE E. ROBERTSON ASSOC., RLLP
30 Broad Street, 47th Floor
New York, New York 10004
212.750.9000

MEP Engineers

FLACK + KURTZ Inc.
475 Fifth Avenue
New York, New York 10017
212.532.9600


CROMWELL ARCHITECTS ENGINEERS
101 South Spring Street
Little Rock, Arkansas 72201
501.372.2900

Curtainwall Consultant

R. A. HEINTGES ARCHITECTS
126 Fifth Avenue, 9th Floor
New York, New York 10011
212.652-2966

Seal

Issue	Date
100% Construction Documents	09/27/02
90% Progress Printing	08/30/02
ASI #05	08/20/02
100% Struct./ CD Progress	07/01/02
Bridge Bldg. Substructure	06/14/02
100% Steel & Concrete CD	05/15/02
& Architectural CD Progress	
100% Design Development	03/01/02

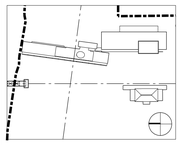

Job No. 9908

Scale 1/4" = 1'-0"

Date September 27, 2002


Title

STAIR 10 AND 11

Sheet No.


A511

FOR OFFICIAL USE ONLY

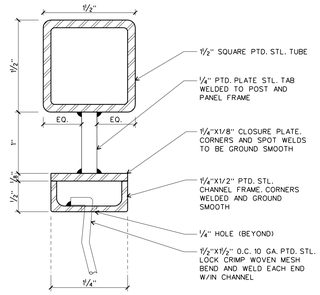


GUARDRAIL DETAIL

FULL SCALE — D-STAIR-FIRE — 44

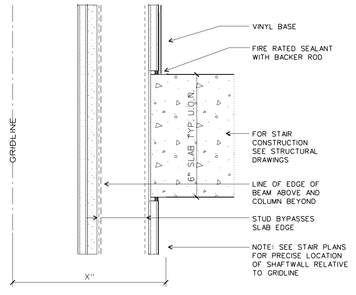


WALL TO SLAB INTERFACE DETAIL

SCALE: 3" = 1'-0" — D-STAIR-FIRE — 43

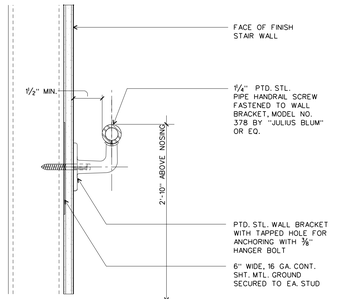


TYP. HANDRAIL BRACKET DETAIL

SCALE: 3" = 1'-0" — D-STAIR-FIRE — 42

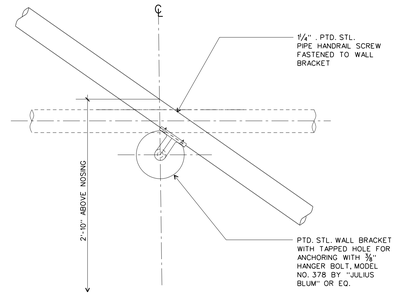


TYP. WALL MOUNTED HANDRAIL

SCALE: 3" = 1'-0" — D-FIRE-STAIR — 41

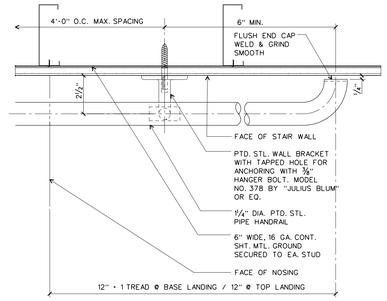


TYP. HANDRAIL BRACKET - PLAN DETAIL

SCALE: 3" = 1'-0" — D-FIRE-STAIR — 40

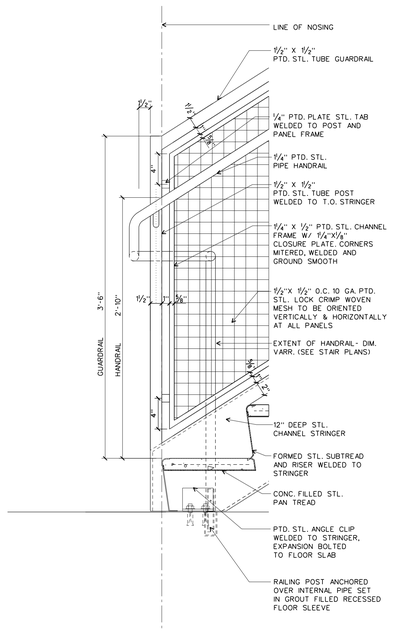


HAND / GUARDRAIL AT STAIR BOTTOM

SCALE: 1½" = 1'-0" — D-STAIR-FIRE — 23

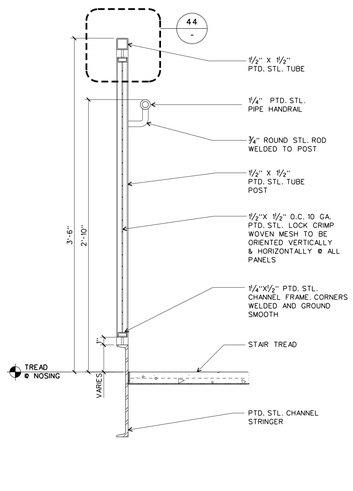


HAND / GUARDRAIL - TYPICAL SECTION

SCALE: 1½" = 1'-0" — D-STAR-FIRE — 22

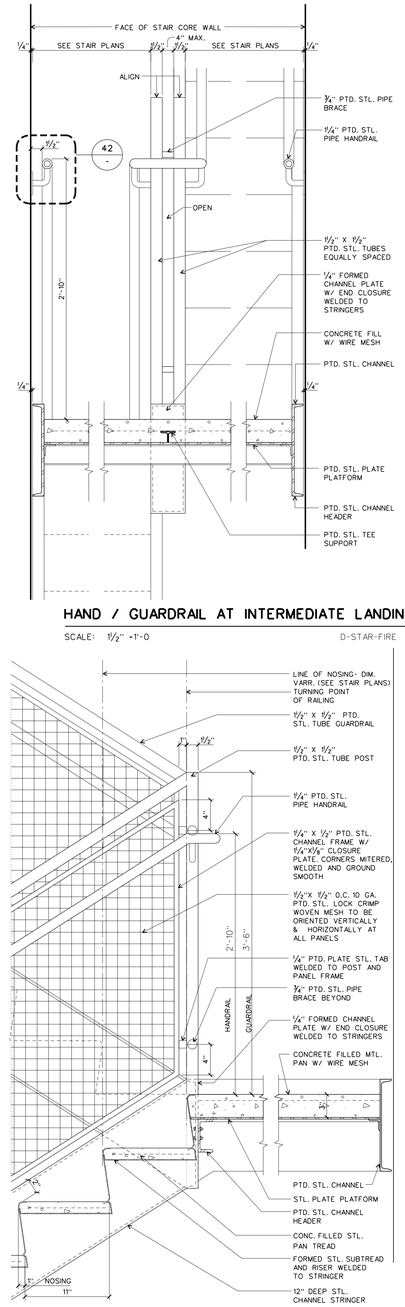


HAND / GUARDRAIL AT INTERMEDIATE LANDING

SCALE: 1½" = 1'-0" — D-STAR-FIRE — 21

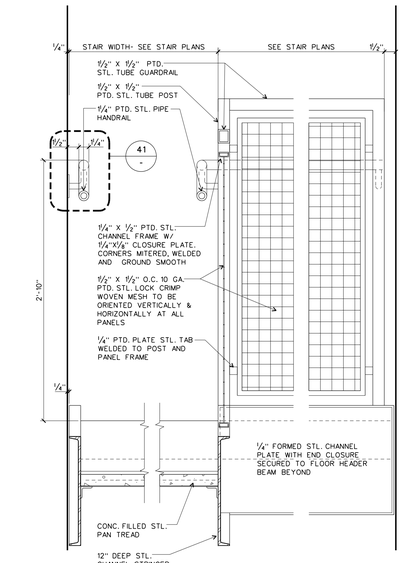


HAND / GUARDRAIL AT UPPER FLOOR LANDING

SCALE: 1½" = 1'-0" — D-STAIR-FIRE — 20

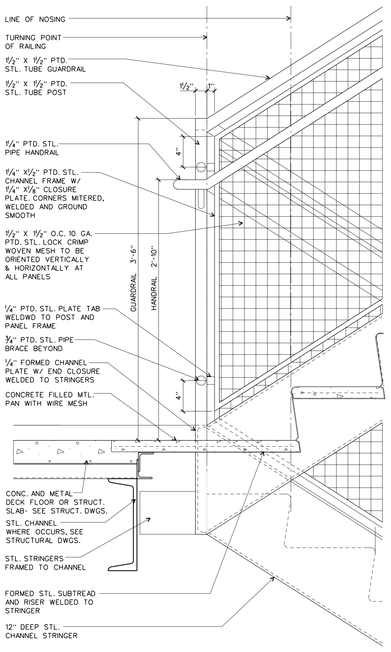


HAND / GUARDRAIL AT FLOOR LANDING

SCALE: 1½" = 1'-0" — D-STAIR-FIRE — 13

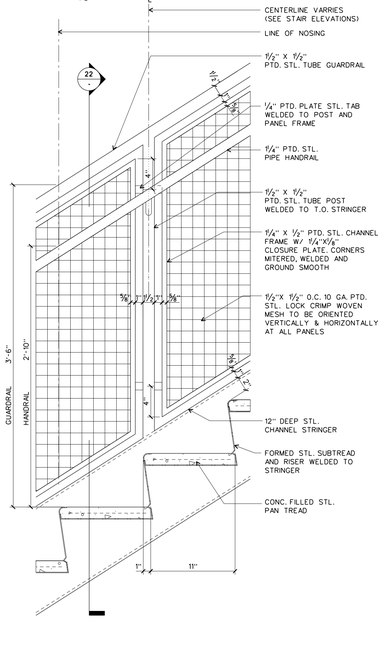


HAND / GUARDRAIL TYPICAL POST DETAIL

SCALE: 1½" = 1'-0" — D-STAIR-FIRE — 12

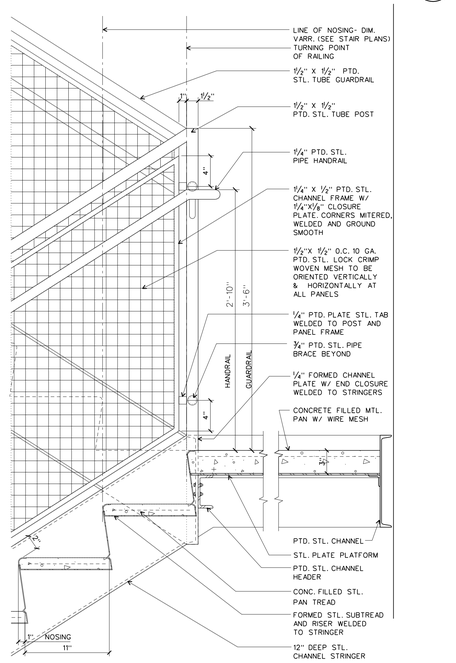

HAND / GUARDRAIL AT INTERMEDIATE LANDING (OFFSET)

SCALE: 1½" = 1'-0" — D-FIRE-STAIR — 11

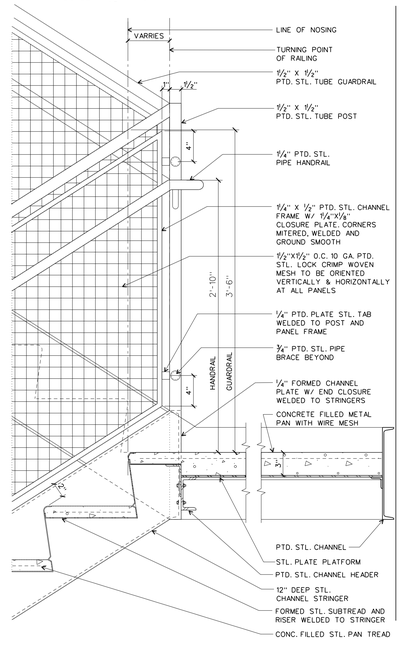

HAND / GUARDRAIL AT INTERMEDIATE LANDING (ALIGNED)

SCALE: 1½" = 1'-0" — D-FIRE-STAIR — 10

WILLIAM J. CLINTON PRESIDENTIAL CENTER

LITTLE ROCK, ARKANSAS

Architect

POLSHEK PARTNERSHIP LLP
320 West 13th Street
New York, New York 10014
212.807.7171

Coordinating Architects

POLK STANLEY YEARY ARCHITECTS Ltd
700 South Schiller Street
Little Rock, Arkansas 72201
501.378.0878

WITSELL EVANS RASCO
901 West Third Street
Little Rock, Arkansas 72201
501.374.5300

WOODS CARADINE ARCHITECTS
2200 South Main Street
Little Rock, Arkansas 72206
501.374.4060

Landscape Architects

HARGREAVES ASSOCIATES
118 Magazine Street
Cambridge, Massachusettes 02139
617.661.0070

LANDSCAPE ARCHITECTURE, Inc.
2300 Cottondale Lane Suite 202
Little Rock, Arkansas 72202
501.374.5610

Structural Engineer

LESLIE E. ROBERTSON ASSOC., RLLP
30 Broad Street, 47th Floor
New York, New York 10004
212.750.9000

MEP Engineers

FLACK + KURTZ Inc.
475 Fifth Avenue
New York, New York 10017
212.532.9600

CROMWELL ARCHITECTS ENGINEERS
101 South Spring Street
Little Rock, Arkansas 72201
501.372.2900

Curtainwall Consultant

R. A. HEINTGES ARCHITECTS
126 Fifth Avenue, 9th Floor
New York, New York 10011
212.652-2966

Seal

Issue	Date
100% Construction Documents	09/27/02

Job No. 9908


Scale: AS NOTED

Date: September 27, 2002

Title: FIRE STAIR- TYPICAL DETAILS


Sheet No. A515

FOR OFFICIAL USE ONLY

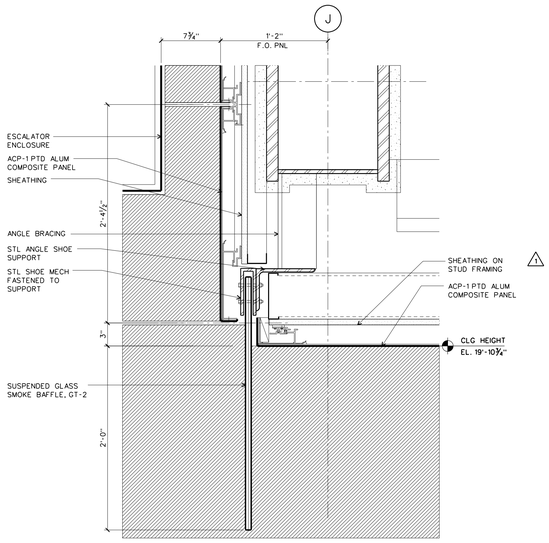


DETAIL AT SMOKE BAFFLE

SCALE: 1-1/2 " = 1'-0" d-escalator-dtls **32**

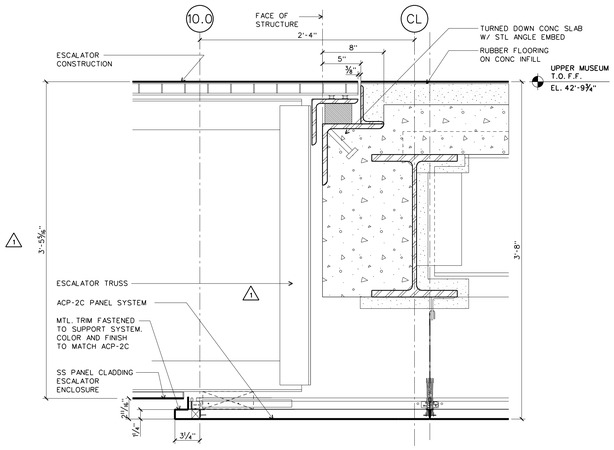


SILL DETAIL AT UPPER MUSEUM LEVEL

SCALE: 1-1/2 " = 1'-0" d-escalator-dtls **31**

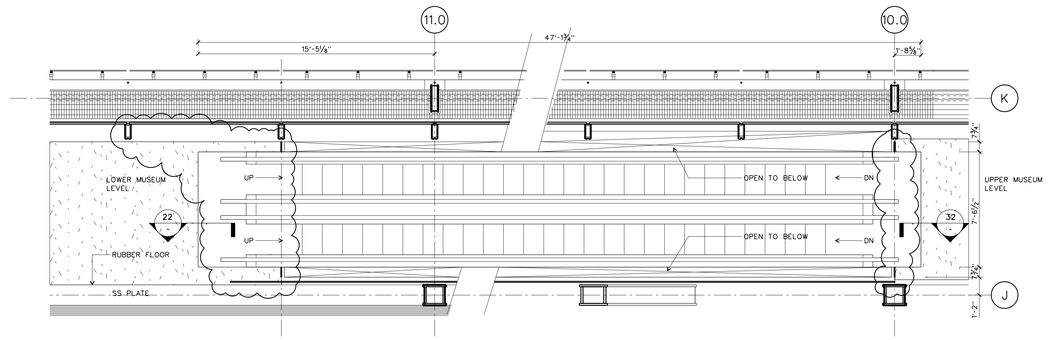


PLAN DETAIL AT ESCALATOR 2 - LOWER MUSEUM LEVEL TO UPPER MUSEUM LEVEL

SCALE: ¼" = 1'-0" d-escalator-dtls **40**

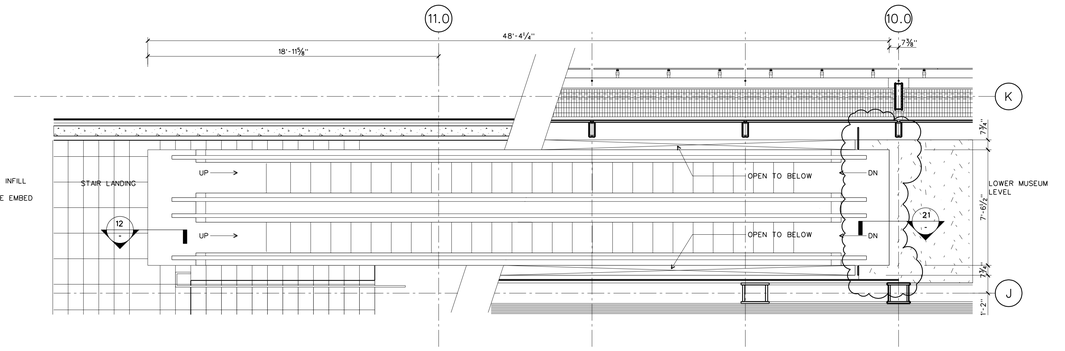


PLAN DETAIL AT ESCALATOR 1 - GROUND FLOOR TO LOWER MUSEUM LEVEL

SCALE: ¼" = 1'-0" d-escalator-dtls **30**

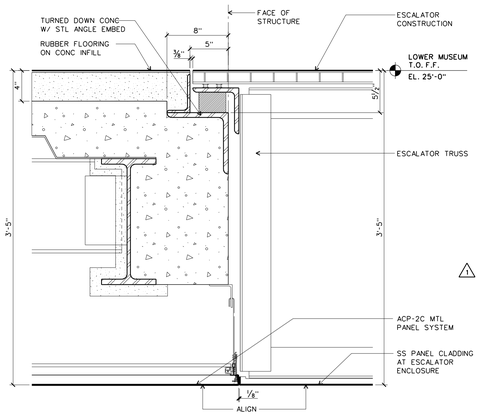


SILL DETAIL AT LOWER MUSEUM LEVEL

SCALE: 1-1/2 " = 1'-0" d-escalator-dtls **22**

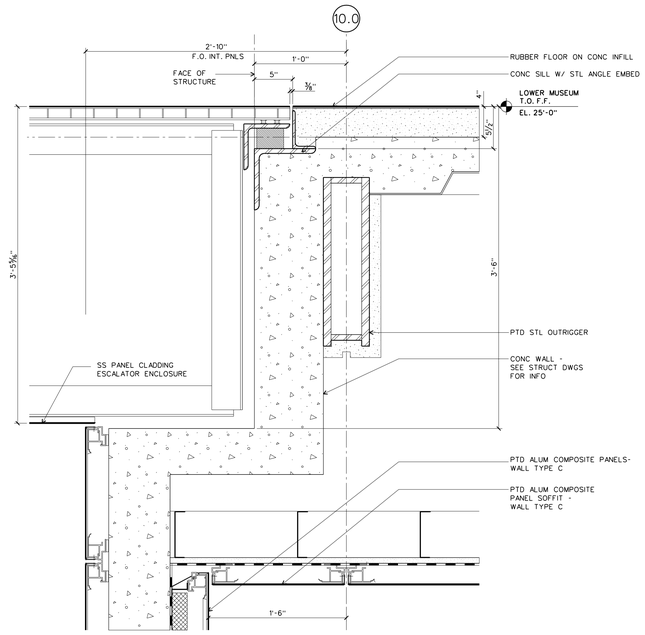


SILL DETAIL AT LOWER MUSEUM LEVEL

SCALE: 1-1/2" = 1'-0" d-escalator-dtls **21**

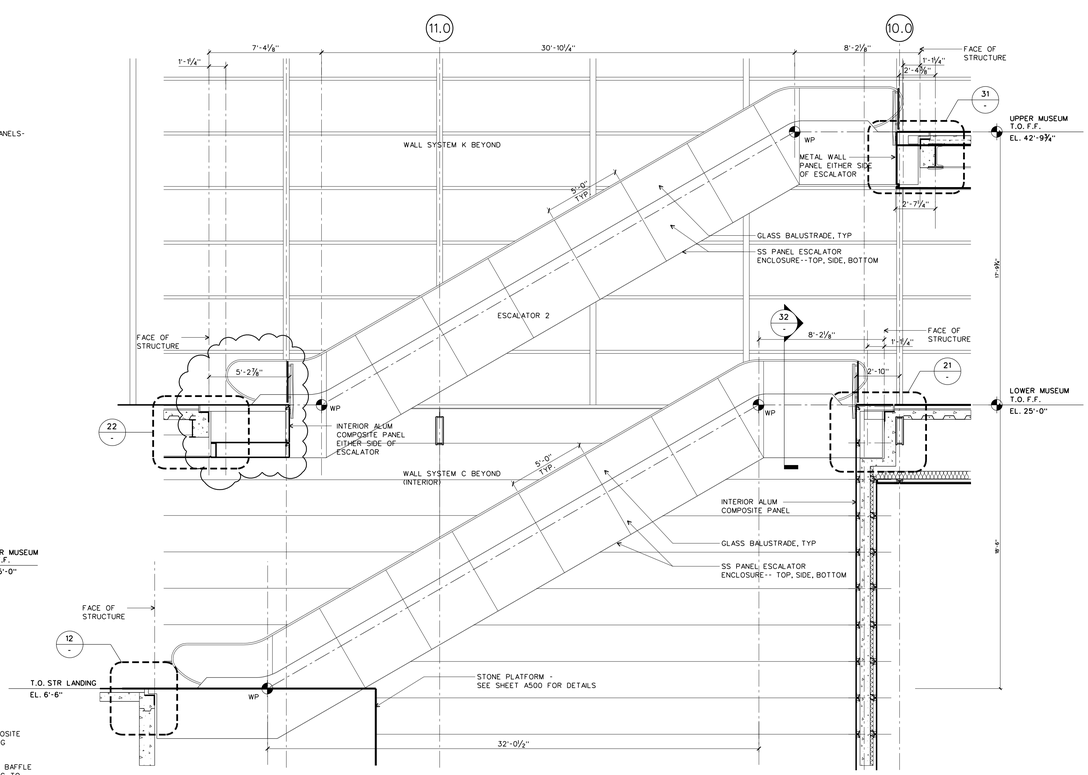


DETAIL SECTION OF ESCALATORS LOOKING WEST

SCALE: ¼" = 1'-0" d-escalator-dtls **10**

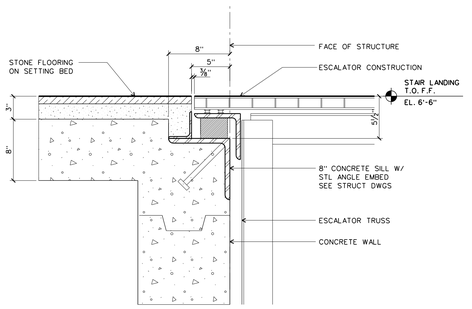

SILL DETAIL AT STAIR LANDING

SCALE: 1-1/2" = 1'-0" d-escalator-dtls **12**

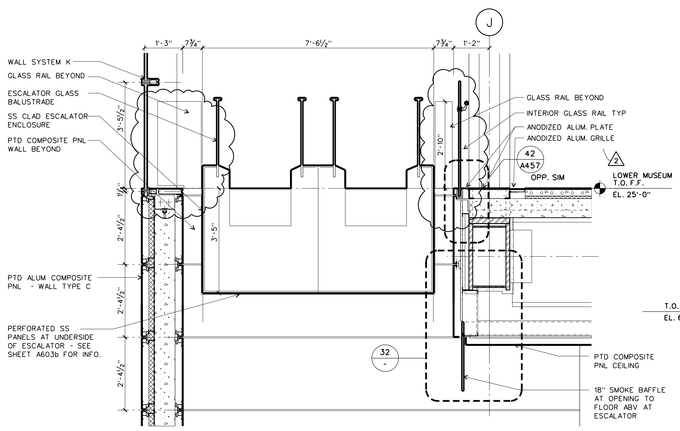

DETAIL SECTION AT LOWER ESCALATOR

SCALE: ½" = 1'-0" d-escalator-dtls **11**

WILLIAM J. CLINTON PRESIDENTIAL CENTER

LITTLE ROCK, ARKANSAS

Architect

POLSHEK PARTNERSHIP LLP
320 West 13th Street
New York, New York 10014
212.807.7171

Coordinating Architects

POLK STANLEY YEARY ARCHITECTS Ltd
700 South Schiller Street
Little Rock, Arkansas 72201
501.378.0878

WITSELL EVANS RASCO
901 West Third Street
Little Rock, Arkansas 72201
501.374.5300

WOODS CARADINE ARCHITECTS
2200 South Main Street
Little Rock, Arkansas 72206
501.374.4060

Landscape Architects

HARGREAVES ASSOCIATES
118 Magazine Street
Cambridge, Massachusettes 02139
617.661.0070

LANDSCAPE ARCHITECTURE, Inc.
2300 Cottondale Lane Suite 202
Little Rock, Arkansas 72202
501.374.5610

Structural Engineer

LESLIE E. ROBERTSON ASSOC., RLLP
30 Broad Street, 47th Floor
New York, New York 10004
212.750.9000

MEP Engineers

FLACK + KURTZ Inc.
475 Fifth Avenue
New York, New York 10017
212.532.9600

CROMWELL ARCHITECTS ENGINEERS
101 South Spring Street
Little Rock, Arkansas 72201
501.372.2900

Curtainwall Consultant

R. A. HEINTGES ARCHITECTS
126 Fifth Avenue, 9th Floor
New York, New York 10011
212.652-2966

Seal

3	ASI #30	04/12/04
2	ASI #20	06/06/03
1	ASI #18	04/18/03
	100% Construction Documents	09/27/02
	Issue	Date

Job No. 9908

Scale AS NOTED

Date September 27, 2002


Title

ESCALATOR PLANS AND DETAILS

Sheet No.

A521.1

FOR OFFICIAL USE ONLY

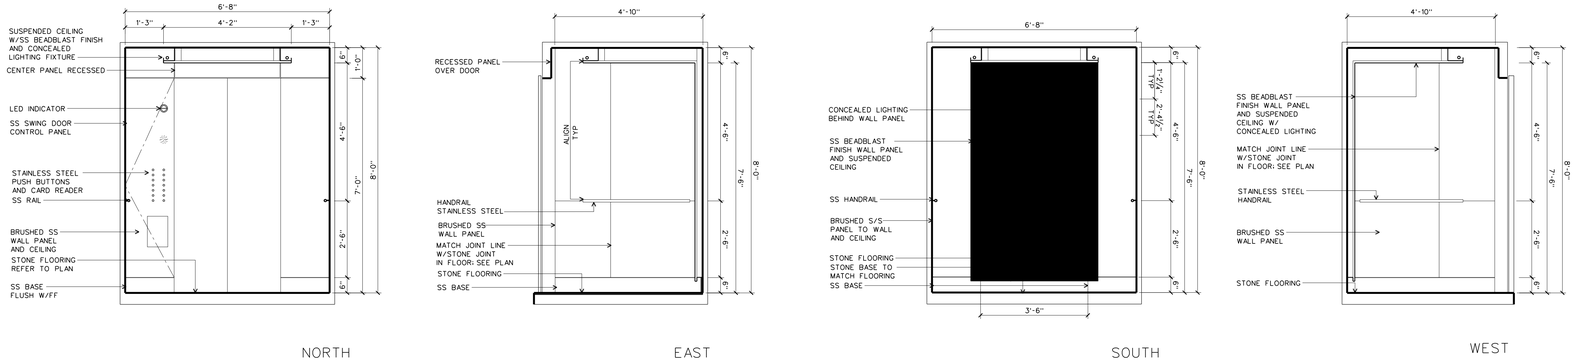


INTERIOR CAB ELEVATIONS

SCALE: ½" = 1'-0"

D-ELEVATORP1.DGN

31

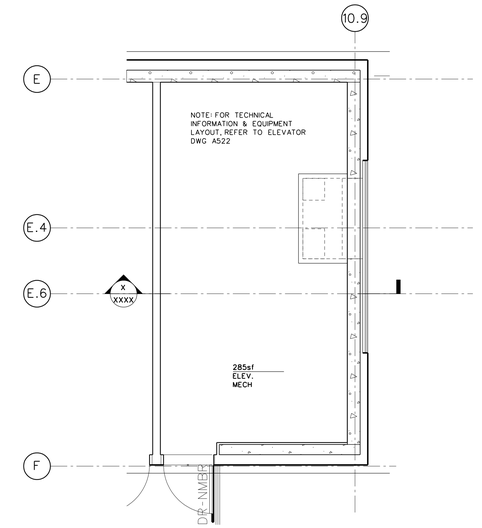


ELEVATOR P1 & P2 MACHINE ROOM PLAN

SCALE: 1/4" = 1'-0"

D-ELEVATORP1.DGN

30

 


REFLECTED CAB CEILING PLAN

SCALE: ½" = 1'-0"

D-ELEVATORP1.DGN

23

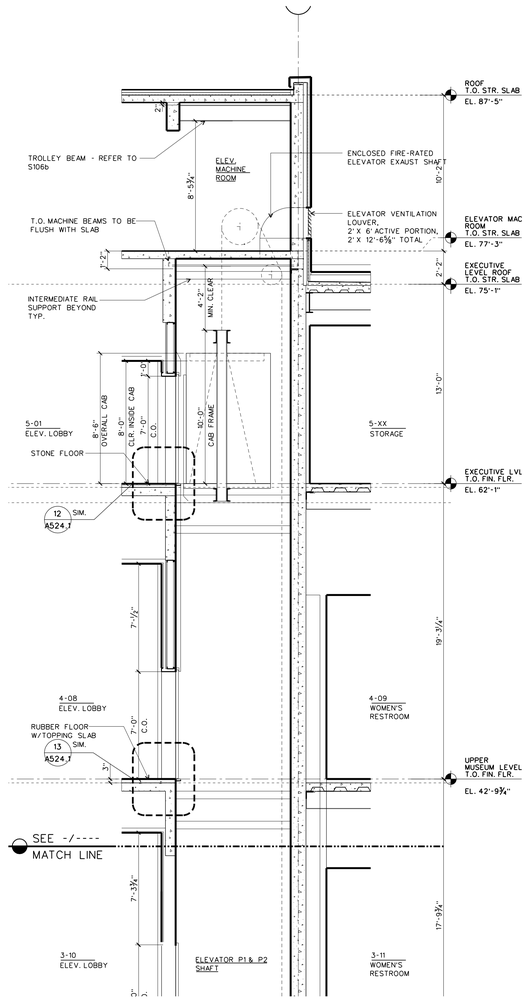


SECTION ELEVATION: LWR MUSEUM LVL TO MACHINE RM LVL

SCALE: ¼" = 1'-0"

D-ELEVATORP1.DGN

12

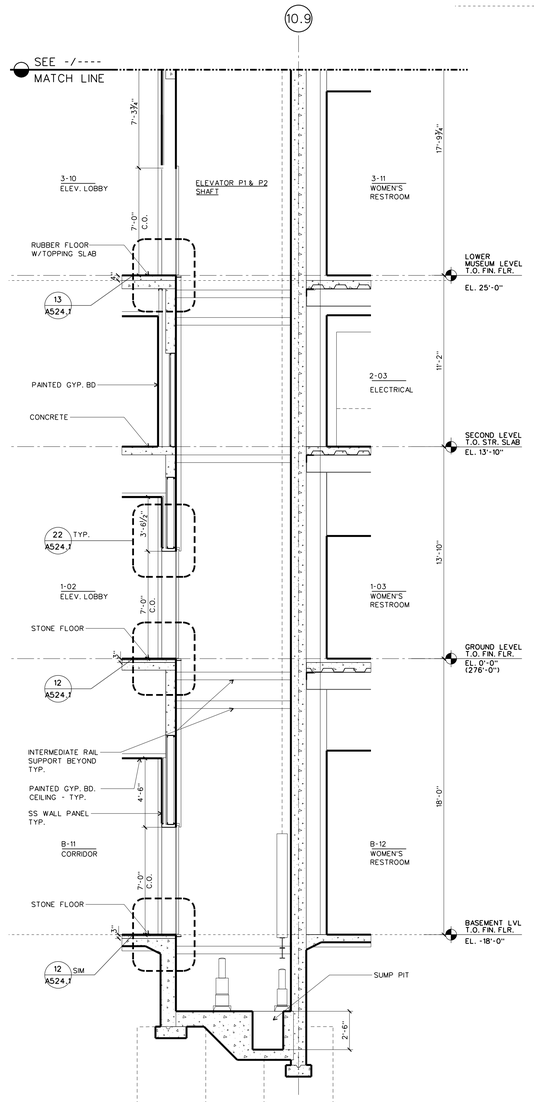


SECTION ELEVATION: BASEMENT TO LWR MUSEUM LEVEL

SCALE: ¼" = 1'-0"

D-ELEVATORP1.DGN

11

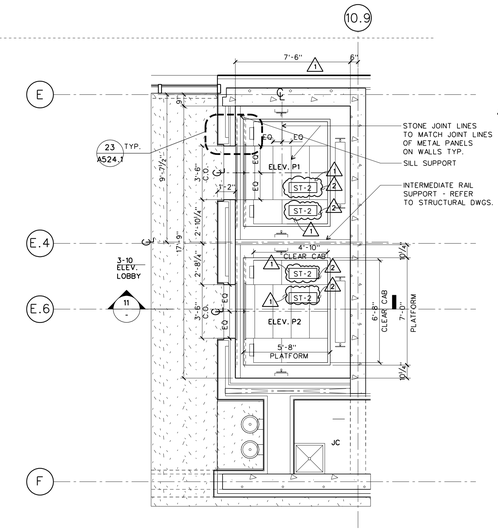


TYP. ELEVATOR HOISTWAY PLAN

SCALE: ¼" = 1'-0"

D-ELEVATORP1.DGN

20

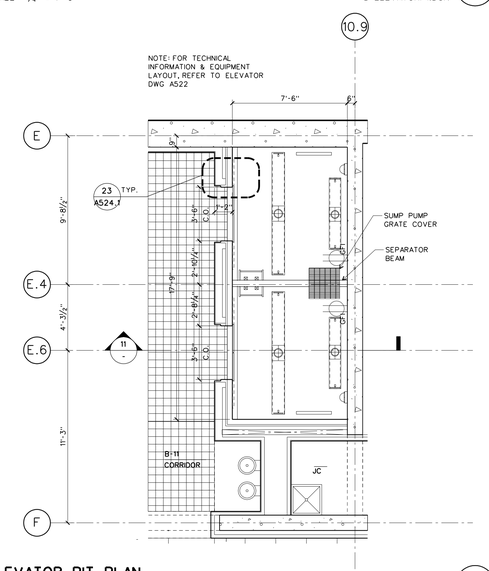

ELEVATOR PIT PLAN

SCALE: ¼" = 1'-0"

D-ELEVATORP1.DGN

10

WILLIAM J. CLINTON PRESIDENTIAL CENTER

LITTLE ROCK, ARKANSAS

Architect

POLSHEK PARTNERSHIP LLP
320 West 13th Street
New York, New York 10014
212.807.7171

Coordinating Architects

POLK STANLEY YEARY ARCHITECTS Ltd
700 South Schiller Street
Little Rock, Arkansas 72201
501.378.0878

WITSELL EVANS RASCO
901 West Third Street
Little Rock, Arkansas 72201
501.374.5300

WOODS CARADINE ARCHITECTS
2200 South Main Street
Little Rock, Arkansas 72206
501.374.4060

Landscape Architects

HARGREAVES ASSOCIATES
118 Magazine Street
Cambridge, Massachusettes 02139
617.661.0070

LANDSCAPE ARCHITECTURE, Inc.
2300 Cottondale Lane Suite 202
Little Rock, Arkansas 72202
501.374.5610

Structural Engineer

LESLIE E. ROBERTSON ASSOC., RLLP
30 Broad Street, 47th Floor
New York, New York 10004
212.750.9000

MEP Engineers

FLACK + KURTZ Inc.
475 Fifth Avenue
New York, New York 10017
212.532.9600

CROMWELL ARCHITECTS ENGINEERS
101 South Spring Street
Little Rock, Arkansas 72201
501.372.2900

Curtainwall Consultant

R. A. HEINTGES ARCHITECTS
126 Fifth Avenue, 9th Floor
New York, New York 10011
212.652-2966

Seal

2	ASI #24	10/24/03
1	Addendum #6	12/04/02
	100% Construction Documents	09/27/02
	90% Progress Printing*	08/30/02
	100% Struct./ CD Progress*	07/01/02
	Issue	Date
	*Issued orginally as A440	

Job No.
9908


Scale
AS NOTED

Date
September 27, 2002

Title
ELEVATOR P1/P2: PLANS, SECTIONS, INTERIOR ELEVATIONS


Sheet No.
A522.1

FOR OFFICIAL USE ONLY

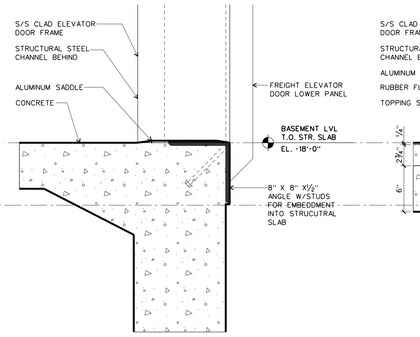


BASEMENT LVL FREIGHT ELEVATOR SILL 34

SCALE: 1-1/2 " =1'-0" D-ELEVATOR-DETAILS.DGN

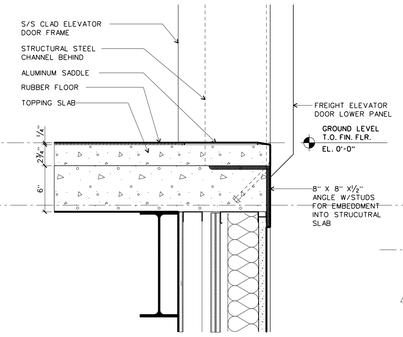

TYPICAL FREIGHT ELEVATOR SILL DETAIL 33


SCALE: 1-1/2 " =1'-0" D-ELEVATOR-DETAILS.DGN

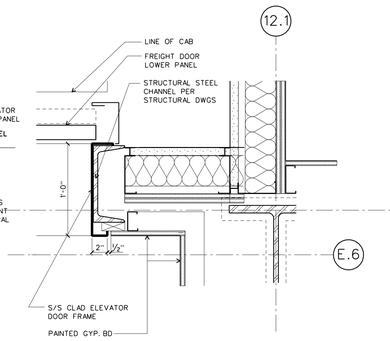



FREIGHT ELEVATOR JAMB DETAIL 32


SCALE: 1-1/2 " =1'-0" D-ELEVATOR-DETAILS.DGN

S/S CLAD ELEVATOR DOOR
S/S CLAD ELEVATOR

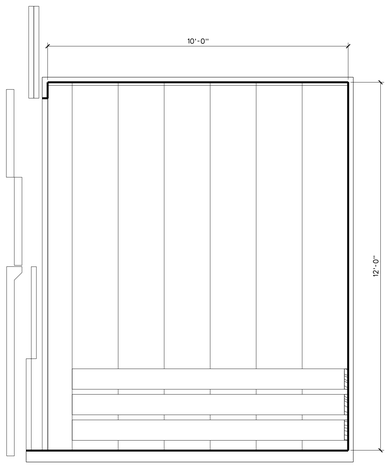

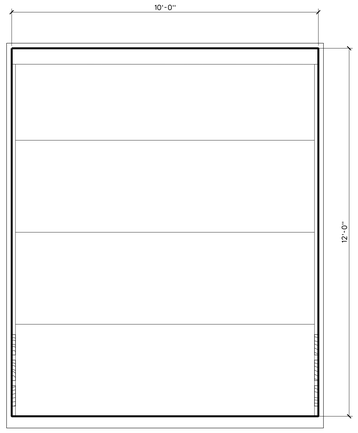


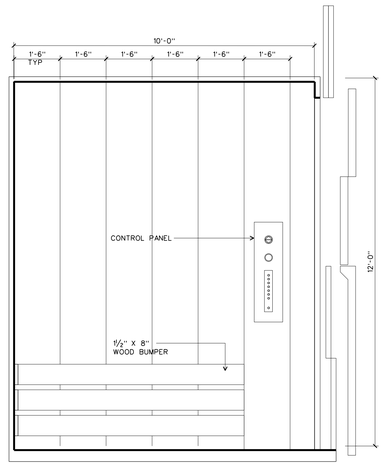

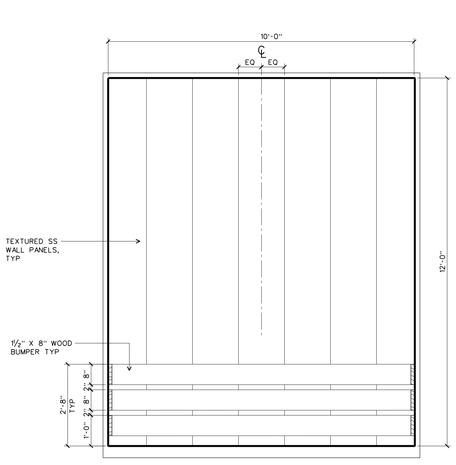


INTERIOR CAB ELEVATIONS - ELEVATORS F3 & F5 12

SCALE: ½" =1'-0" D-ELEVATORF3.DGN

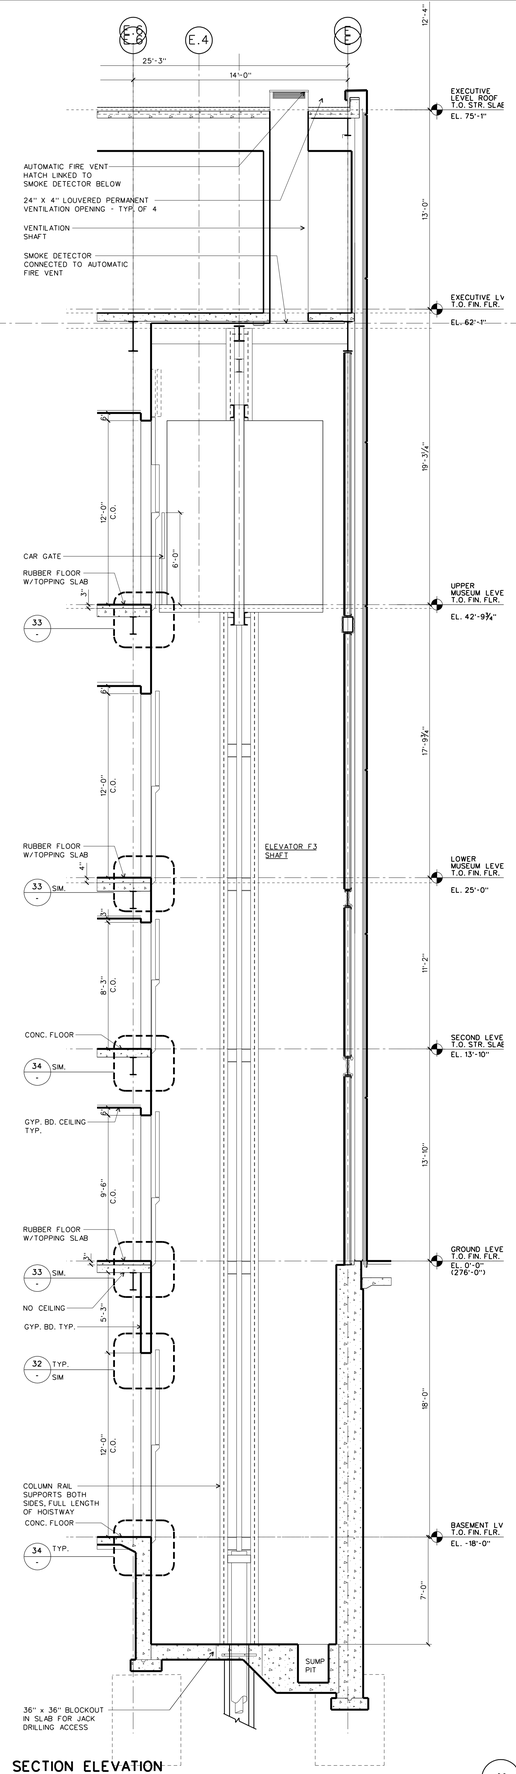


SECTION ELEVATION

SCALE: ¼" =1'-0" D-ELEVATORF3.DGN 11

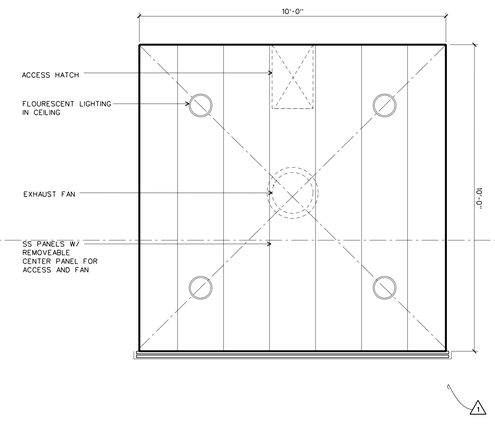


REFLECTED CAB CEILING PLAN 30

SCALE: ½" =1'-0" D-ELEVATORF3.DGN

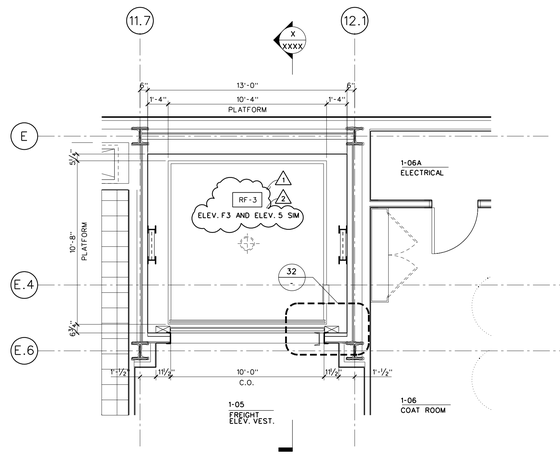

TYPICAL HOISTWAY PLAN 20

SCALE: ¼" =1'-0" D-ELEVATORF3.DGN

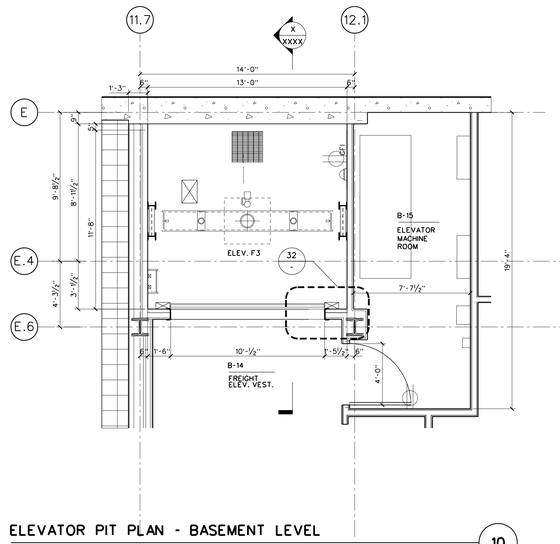

ELEVATOR PIT PLAN - BASEMENT LEVEL 10

SCALE: ¼" =1'-0" D-ELEVATORF3.DGN

WILLIAM J. CLINTON PRESIDENTIAL CENTER

LITTLE ROCK, ARKANSAS

Architect

POLSHEK PARTNERSHIP LLP
320 West 13th Street
New York, New York 10014
212.807.7171

Coordinating Architects

POLK STANLEY YEARY ARCHITECTS Ltd
700 South Schiller Street
Little Rock, Arkansas 72201
501.378.0878

WITSELL EVANS RASCO
901 West Third Street
Little Rock, Arkansas 72201
501.374.5300

WOODS CARADINE ARCHITECTS
2200 South Main Street
Little Rock, Arkansas 72206
501.374.4060

Landscape Architects

HARGREAVES ASSOCIATES
118 Magazine Street
Cambridge, Massachusettes 02139
617.661.0070

LANDSCAPE ARCHITECTURE, Inc.
2300 Cottondale Lane Suite 202
Little Rock, Arkansas 72202
501.374.5610

Structural Engineer

LESLIE E. ROBERTSON ASSOC., RLLP
30 Broad Street, 47th Floor
New York, New York 10004
212.750.9000

MEP Engineers

FLACK + KURTZ Inc.
475 Fifth Avenue
New York, New York 10017
212.532.9600

CROMWELL ARCHITECTS ENGINEERS
101 South Spring Street
Little Rock, Arkansas 72201
501.372.2900

Curtainwall Consultant

R. A. HEINTGES ARCHITECTS
126 Fifth Avenue, 9th Floor
New York, New York 10011
212.652-2966

Seal

2	ASI #22	08/01/02
1	Addendum #6	12/04/02
	100% Construction Documents	09/27/02
	90% Progress Printing*	08/30/02
	100% Struct./ CD Progress*	07/01/02
	Issue	Date

*Issued originally as A441

Job No. 9908

Scale 1/4" = 1'-0"

Date September 27, 2002


Title

ELEVATOR F3: PLANS, SECTIONS, INTERIOR ELEVATIONS

Sheet No.

A523.1


FOR OFFICIAL USE ONLY

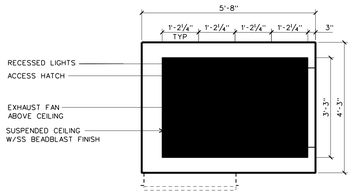


1

REFLECTED CAB CEILING PLAN


SCALE: ½" = 1'-0" D-ELEVATORP7.DGN 43

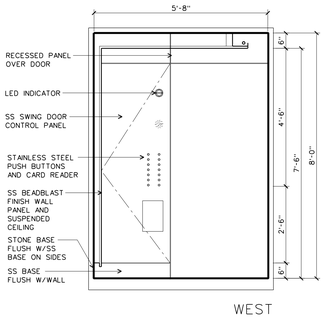


WEST

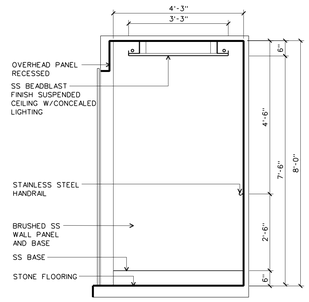

NORTH

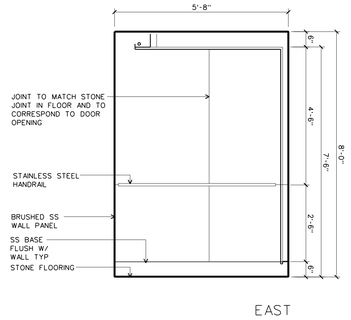

EAST

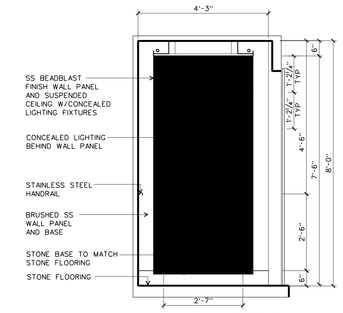


SOUTH

1


INTERIOR CAB ELEVATIONS

SCALE: ½" = 1'-0" D-ELEVATORP7.DGN 40

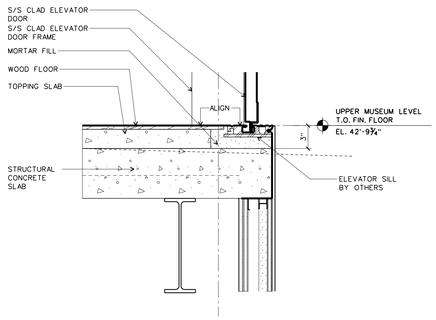


SILL DETAIL-ELEVATOR P7


SCALE: ¼" = 1'-0" D-ELEVATOR-DETAILS.DGN 32

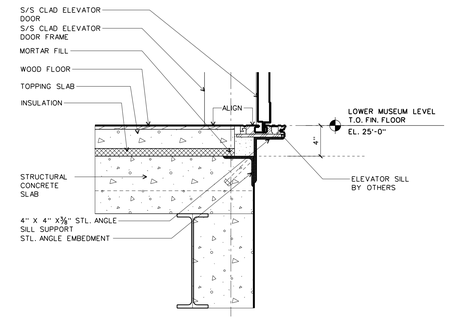

JAMB DETAIL-ELEVATOR P7


SCALE: ¼" = 1'-0" D-ELEVATOR-DETAILS.DGN 31

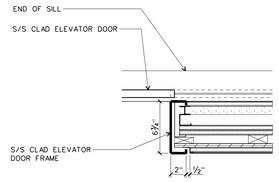

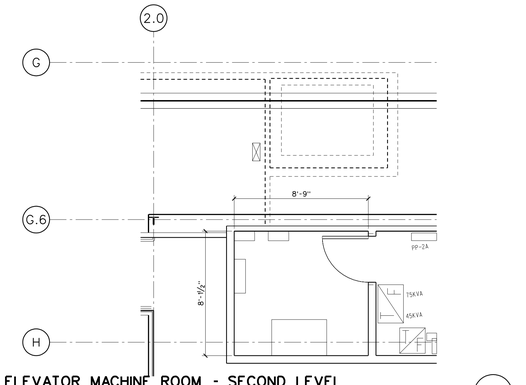


ELEVATOR MACHINE ROOM - SECOND LEVEL

SCALE: ¼" = 1'-0" D-ELEVATORP7.DGN 30

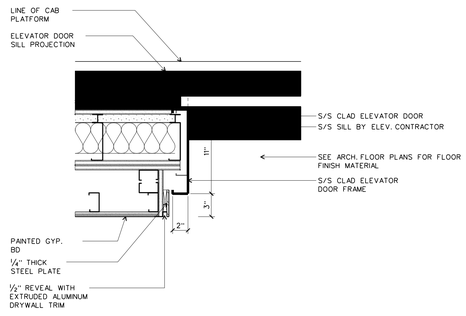


TYPICAL JAMB DETAIL - ELEVATOR P1/P2

SCALE: 1-1/2 " = 1'-0" D-ELEVATOR-DETAILS.DGN 23

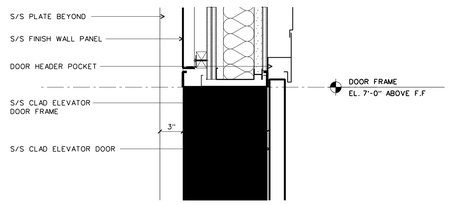


TYPICAL HEADER DETAIL - ELEVATOR P1/P2

SCALE: 1-1/2 " = 1'-0" D-ELEVATOR-DETAILS.DGN 22

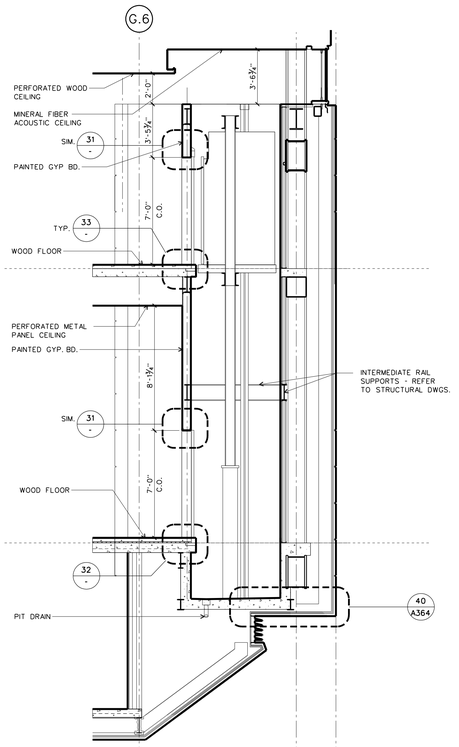

SECTION ELEVATION


SCALE: ¼" = 1'-0" D-ELEVATORP7.DGN 11

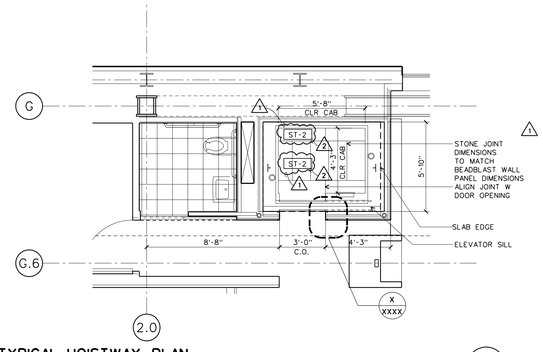

1


TYPICAL HOISTWAY PLAN

SCALE: ¼" = 1'-0" D-ELEVATORP7.DGN 20

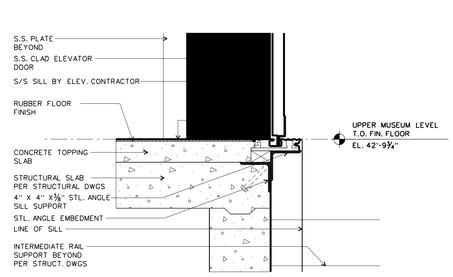


TYPICAL SILL DETAIL W/RUBBER FLOOR - ELEVATOR P1/P2

SCALE: 1-1/2 " = 1'-0" D-ELEVATOR-DETAILS.DGN 13

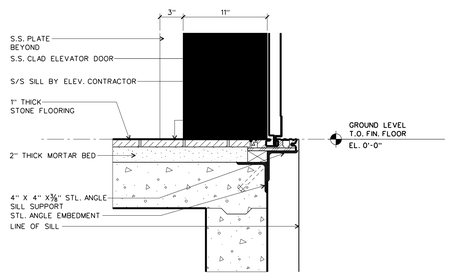

TYPICAL SILL DETAIL W/STONE FLOOR - ELEVATOR P1/P2

SCALE: 1-1/2 " = 1'-0" D-ELEVATOR-DETAILS.DGN 12

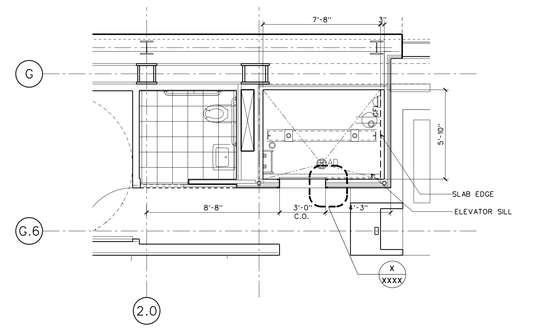

PIT PLAN

SCALE: ¼" = 1'-0" D-ELEVATORP7.DGN 10

WILLIAM J. CLINTON PRESIDENTIAL CENTER

LITTLE ROCK, ARKANSAS

Architect

POLSHEK PARTNERSHIP LLP
320 West 13th Street
New York, New York 10014
212.807.7171

Coordinating Architects

POLK STANLEY YEARY ARCHITECTS Ltd
700 South Schiller Street
Little Rock, Arkansas 72201
501.378.0878

WITSELL EVANS RASCO
901 West Third Street
Little Rock, Arkansas 72201
501.374.5300

WOODS CARADINE ARCHITECTS
2200 South Main Street
Little Rock, Arkansas 72206
501.374.4060

Landscape Architects

HARGREAVES ASSOCIATES
118 Magazine Street
Cambridge, Massachusettes 02139
617.661.0070

LANDSCAPE ARCHITECTURE, Inc.
2300 Cottondale Lane Suite 202
Little Rock, Arkansas 72202
501.374.5610

Structural Engineer

LESLIE E. ROBERTSON ASSOC., RLLP
30 Broad Street, 47th Floor
New York, New York 10004
212.750.9000

MEP Engineers

FLACK + KURTZ Inc.
475 Fifth Avenue
New York, New York 10017
212.532.9600

CROMWELL ARCHITECTS ENGINEERS
101 South Spring Street
Little Rock, Arkansas 72201
501.372.2900


Curtainwall Consultant

R. A. HEINTGES ARCHITECTS
126 Fifth Avenue, 9th Floor
New York, New York 10011
212.652-2966

Seal

Issue	Date
1 ASI #24	10/24/03
1 Addendum #6	12/04/02
100% Construction Documents	09/27/02
90% Progress Printing*	08/30/02
100% Struct./ CD Progress*	07/01/02

*Issued originally as A440

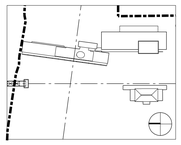

Job No. 9908


Scale: AS NOTED

Date: September 27, 2002

Title: ELEVATOR P7: PLANS, SECTIONS, INTERIOR ELEVATIONS


Sheet No. A524.1

FOR OFFICIAL USE ONLY

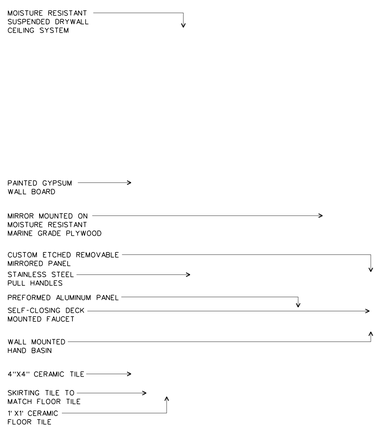


WOMEN'S RESTROOM: NORTH ELEVATION TYP. 21

SCALE: ½" = 1'-0" I-ELEV BATH

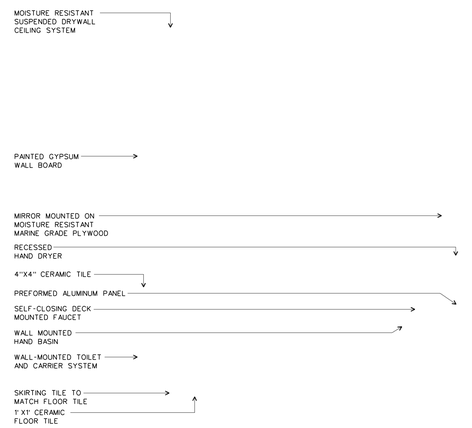


WOMEN'S RESTROOM: WEST ELEVATION TYP. 20

SCALE: ½" = 1'-0" I-ELEV BATH

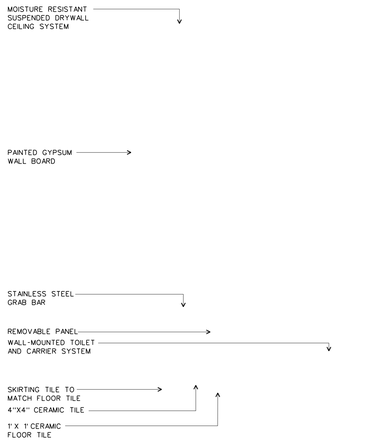

WOMEN'S RESTROOM: SOUTH ELEVATION TYP. 11

SCALE: ½" = 1'-0" I-ELEV BATH

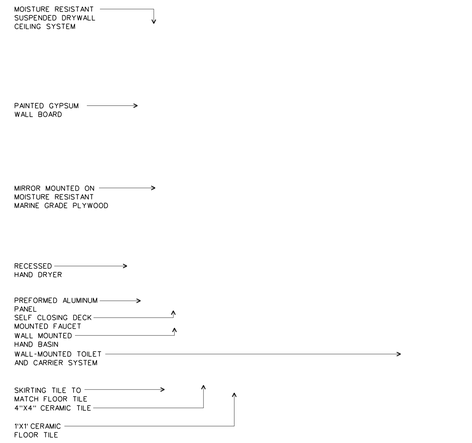

WOMEN'S RESTROOM: EAST ELEVATION TYP. 10

SCALE: ½" = 1'-0" I-ELEV BATH

WILLIAM J. CLINTON PRESIDENTIAL CENTER

LITTLE ROCK, ARKANSAS

Architect

POLSHEK PARTNERSHIP LLP
320 West 13th Street
New York, New York 10014
212.807.7171

Coordinating Architects

POLK STANLEY YEARY ARCHITECTS Ltd
700 South Schiller Street
Little Rock, Arkansas 72201
501.378.0878

WITSELL EVANS RASCO
901 West Third Street
Little Rock, Arkansas 72201
501.374.5300

WOODS CARADINE ARCHITECTS
2200 South Main Street
Little Rock, Arkansas 72206
501.374.4060

Landscape Architects

HARGREAVES ASSOCIATES
118 Magazine Street
Cambridge, Massachusettes 02139
617.661.0070

LANDSCAPE ARCHITECTURE, Inc.
2300 Cottondale Lane Suite 202
Little Rock, Arkansas 72202
501.374.5610

Structural Engineer

LESLIE E. ROBERTSON ASSOC., RLLP
30 Broad Street, 47th Floor
New York, New York 10004
212.750.9000

MEP Engineers

FLACK + KURTZ Inc.
475 Fifth Avenue
New York, New York 10017
212.532.9600


CROMWELL ARCHITECTS ENGINEERS
101 South Spring Street
Little Rock, Arkansas 72201
501.372.2900

Curtainwall Consultant

R. A. HEINTGES ARCHITECTS
126 Fifth Avenue, 9th Floor
New York, New York 10011
212.652-2966

Seal

Issue	Date
100% Construction Documents	09/27/02
90% Progress Printing	08/30/02
ASI #05	08/20/02
100% Struct./ CD Progress	07/01/02
Bridge Bldg. Substructure	06/14/02
100% Steel & Concrete CD	05/15/02
& Architectural CD Progress	
100% Design Development	03/01/02

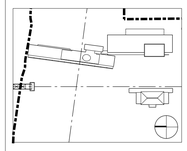

Job No. 9908

Scale 1/2"=1'-0"

Date September 27, 2002


Title


INTERIOR ELEVATIONS: WOMEN'S RESTROOMS


Sheet No.

A526

FOR OFFICIAL USE ONLY

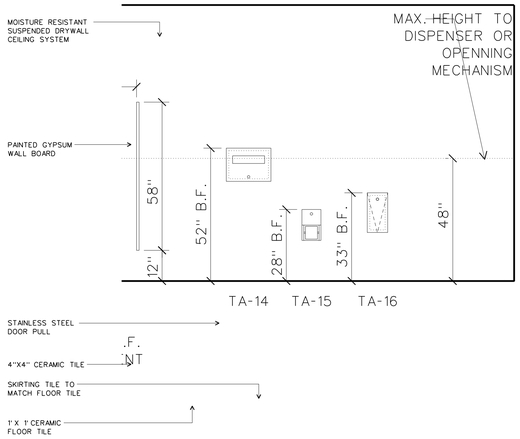


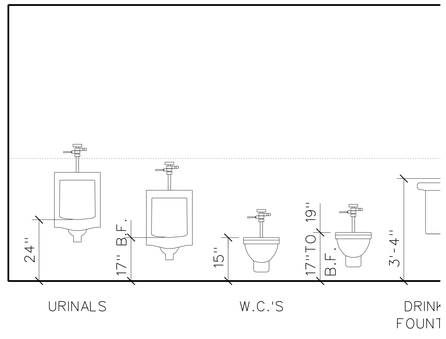

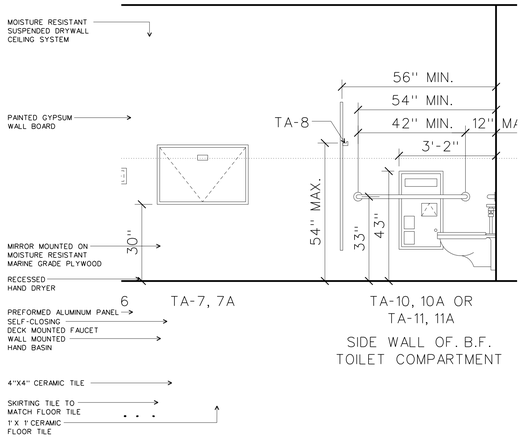

MEN'S RESTROOM: NORTH ELEVATION TYP. — 21
SCALE: ½" = 1'-0" — I-ELEV BATH


MEN'S RESTROOM: WEST ELEVATION TYP. — 20
SCALE: ½" = 1'-0" — I-ELEV BATH

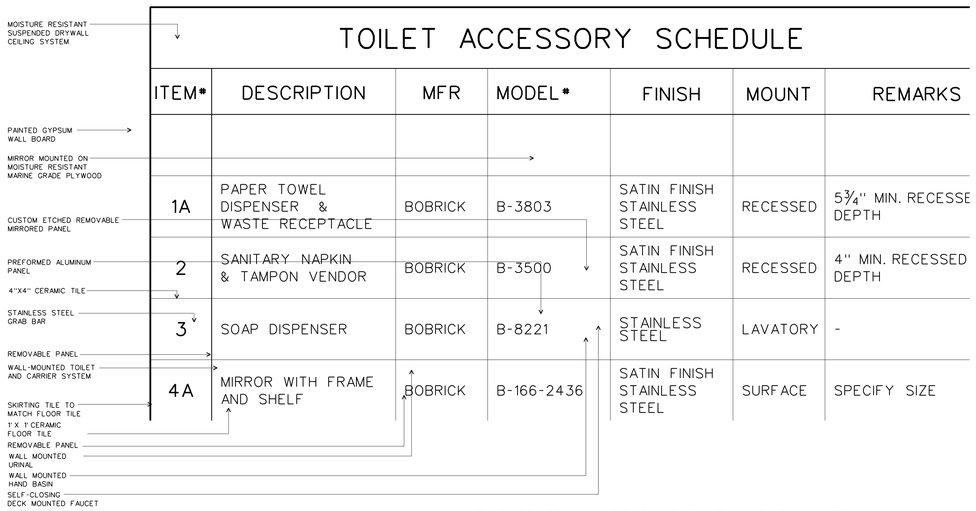

TOILET ACCESSORY SCHEDULE

ITEM*	DESCRIPTION	MFR	MODEL*	FINISH	MOUNT	REMARKS
1A	PAPER TOWEL DISPENSER & WASTE RECEPTACLE	BOBRICK	B-3803	SATIN FINISH STAINLESS STEEL	RECESSED	5¾'' MIN. RECESSE DEPTH
2	SANITARY NAPKIN & TAMPON VENDOR	BOBRICK	B-3500	SATIN FINISH STAINLESS STEEL	RECESSED	4'' MIN. RECESSED DEPTH
3	SOAP DISPENSER	BOBRICK	B-8221	STAINLESS STEEL	LAVATORY	-
4A	MIRROR WITH FRAME AND SHELF	BOBRICK	B-166-2436	SATIN FINISH STAINLESS STEEL	SURFACE	SPECIFY SIZE

MEN'S RESTROOM: SOUTH ELEVATION TYP. — 11
SCALE: ½" = 1'-0" — I-ELEV BATH

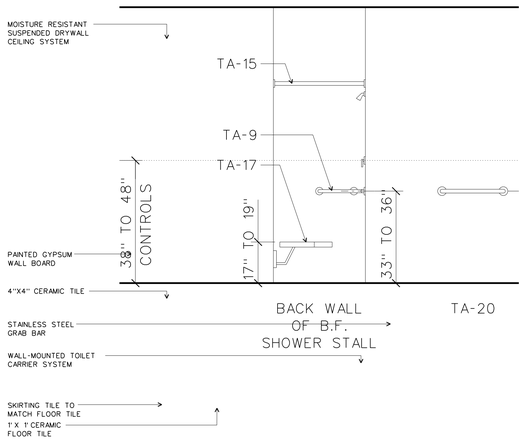

MEN'S RESTROOM: EAST ELEVATION TYP. — 10
SCALE: ½" = 1'-0" — I-ELEV BATH

WILLIAM J. CLINTON PRESIDENTIAL CENTER

LITTLE ROCK, ARKANSAS

Architect

POLSHEK PARTNERSHIP LLP
320 West 13th Street
New York, New York 10014
212.807.7171

Coordinating Architects

POLK STANLEY YEARY ARCHITECTS Ltd
700 South Schiller Street
Little Rock, Arkansas 72201
501.378.0878

WITSELL EVANS RASCO
901 West Third Street
Little Rock, Arkansas 72201
501.374.5300

WOODS CARADINE ARCHITECTS
2200 South Main Street
Little Rock, Arkansas 72206
501.374.4060

Landscape Architects

HARGREAVES ASSOCIATES
118 Magazine Street
Cambridge, Massachusettes 02139
617.661.0070

LANDSCAPE ARCHITECTURE, Inc.
2300 Cottondale Lane Suite 202
Little Rock, Arkansas 72202
501.374.5610

Structural Engineer

LESLIE E. ROBERTSON ASSOC., RLLP
30 Broad Street, 47th Floor
New York, New York 10004
212.750.9000

MEP Engineers

FLACK + KURTZ Inc.
475 Fifth Avenue
New York, New York 10017
212.532.9600


CROMWELL ARCHITECTS ENGINEERS
101 South Spring Street
Little Rock, Arkansas 72201
501.372.2900

Curtainwall Consultant

R. A. HEINTGES ARCHITECTS
126 Fifth Avenue, 9th Floor
New York, New York 10011
212.652-2966

Seal

Issue	Date
100% Construction Documents	09/27/02
90% Progress Printing	08/30/02
ASI #05	08/20/02
100% Struct./ CD Progress	07/01/02
Bridge Bldg. Substructure	06/14/02
100% Steel & Concrete CD	05/15/02
& Architectural CD Progress	
100% Design Development	03/01/02

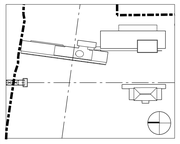

Job No. 9908

Scale 1/2" = 1'-0"

Date September 27, 2002


Title

INTERIOR ELEVATIONS: RESTROOMS SERVICE CORE

Sheet No.


A527

FOR OFFICIAL USE ONLY

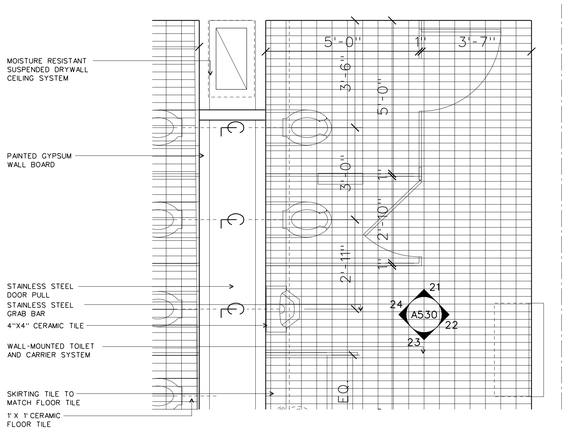


SERVICE CORE RESTROOM: NORTH ELEVATION 21

SCALE: ½" = 1'-0" I-ELEV BATH

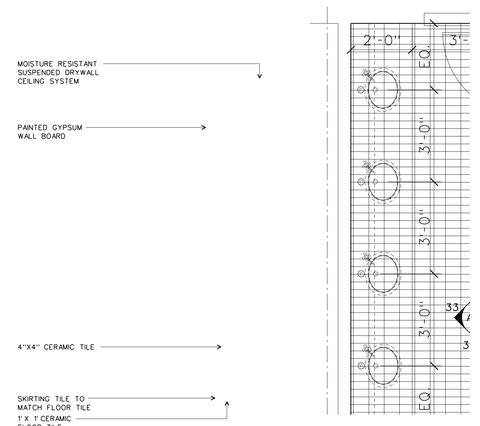


SERVICE CORE RESTROOM: WEST ELEVATION 20

SCALE: ½" = 1'-0" I-ELEV BATH

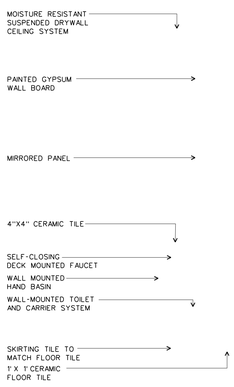

SERVICE CORE RESTROOM: SOUTH ELEVATION 11

SCALE: ½" = 1'-0" I-ELEV BATH

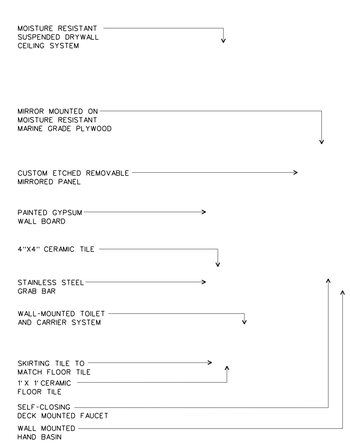

SERVICE CORE RESTROOM: EAST ELEVATION 10

SCALE: ½" = 1'-0" I-ELEV BATH

WILLIAM J. CLINTON PRESIDENTIAL CENTER

LITTLE ROCK, ARKANSAS

Architect

POLSHEK PARTNERSHIP LLP
320 West 13th Street
New York, New York 10014
212.807.7171

Coordinating Architects

POLK STANLEY YEARY ARCHITECTS Ltd
700 South Schiller Street
Little Rock, Arkansas 72201
501.378.0878

WITSELL EVANS RASCO
901 West Third Street
Little Rock, Arkansas 72201
501.374.5300

WOODS CARADINE ARCHITECTS
2200 South Main Street
Little Rock, Arkansas 72206
501.374.4060

Landscape Architects

HARGREAVES ASSOCIATES
118 Magazine Street
Cambridge, Massachusettes 02139
617.661.0070

LANDSCAPE ARCHITECTURE, Inc.
2300 Cottondale Lane Suite 202
Little Rock, Arkansas 72202
501.374.5610

Structural Engineer

LESLIE E. ROBERTSON ASSOC., RLLP
30 Broad Street, 47th Floor
New York, New York 10004
212.750.9000

MEP Engineers

FLACK + KURTZ Inc.
475 Fifth Avenue
New York, New York 10017
212.532.9600


CROMWELL ARCHITECTS ENGINEERS
101 South Spring Street
Little Rock, Arkansas 72201
501.372.2900

Curtainwall Consultant

R. A. HEINTGES ARCHITECTS
126 Fifth Avenue, 9th Floor
New York, New York 10011
212.652-2966

Seal

Issue	Date
100% Construction Documents	09/27/02
90% Progress Printing	08/30/02
ASI #05	08/20/02
100% Struct./ CD Progress	07/01/02
Bridge Bldg. Substructure	06/14/02
100% Steel & Concrete CD	05/15/02
& Architectural CD Progress	
100% Design Development	03/01/02

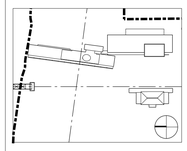

Job No. 9908

Scale 1/2" = 1'-0"

Date September 27, 2002


Title

INTERIOR ELEVATIONS: RESTROOMS SERVICE CORE

Sheet No.


A528

FOR OFFICIAL USE ONLY

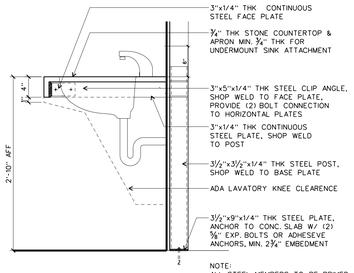


COUNTER MTD LAVATORY SECTION 56

1" = 1'-0"

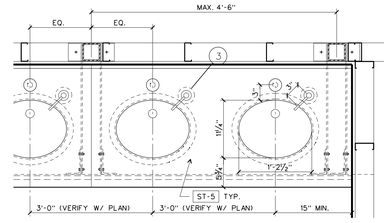


COUNTER MTD LAVATORY PLAN 55

1" = 1'-0"

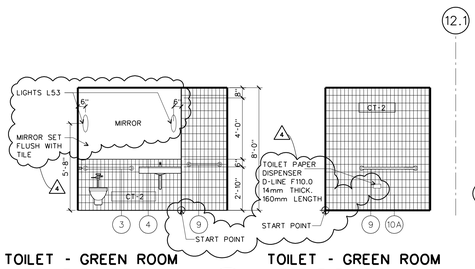


TOILET - GREEN ROOM NORTH ELEVATION 54

SCALE: ¼" = 1'-0" i-elev-bath

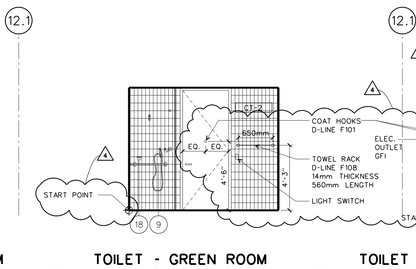


TOILET - GREEN ROOM WEST ELEVATION 53

SCALE: ¼" = 1'-0" i-elev-bath

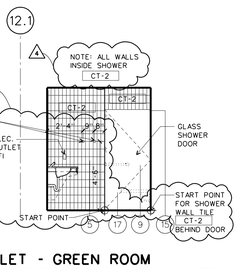

TOILET - GREEN ROOM SOUTH ELEVATION 52

SCALE: ¼" = 1'-0" i-elev-bath

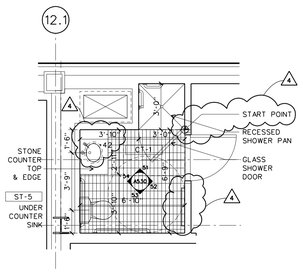


TOILET - GREEN ROOM EAST ELEVATION 51

SCALE: ¼" = 1'-0" i-elev-bath


PLAN: GREEN ROOM TOILET 50

SCALE: ¼" = 1'-0" i-elev-bath

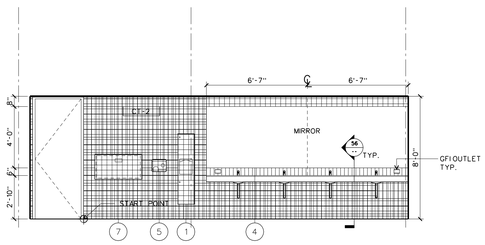


WOMEN'S TOILET - TYPICAL NORTH ELEVATION 44

SCALE: ¼" = 1'-0" i-elev-bath

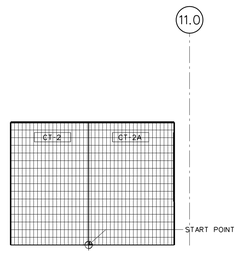


WOMEN'S TOILET - TYPICAL WEST ELEVATION 43

SCALE: ¼" = 1'-0" i-elev-bath

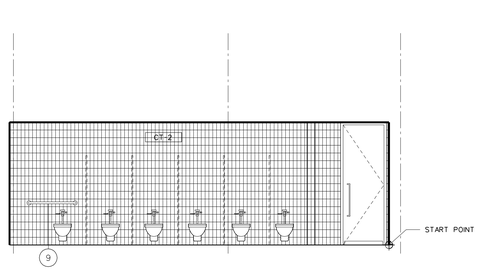


WOMEN'S TOILET - TYPICAL SOUTH ELEVATION 42

SCALE: ¼" = 1'-0" i-elev-bath

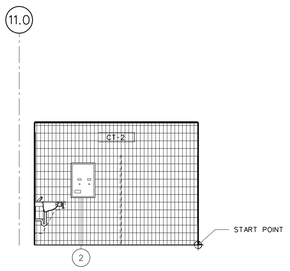


WOMEN'S TOILET - TYPICAL EAST ELEVATION 41

SCALE: ¼" = 1'-0" i-elev-bath

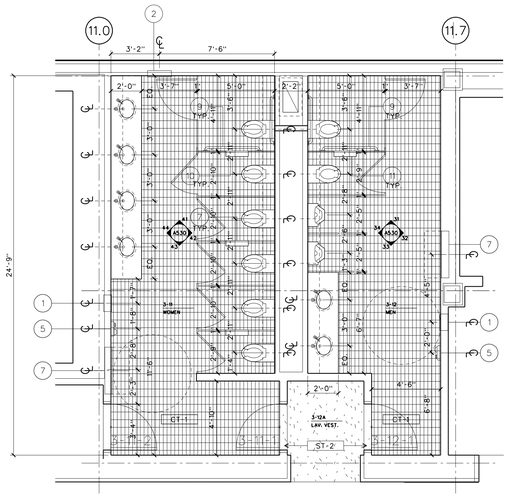


PLAN: LOWER AND UPPER MUSEUM LEVELS 30

SCALE: ¼" = 1'-0" i-elev-bath

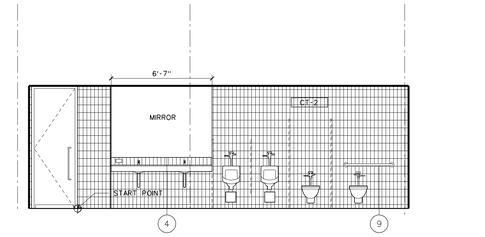


MENS TOILET - TYPICAL NORTH ELEVATION 34

SCALE: ¼" = 1'-0" i-elev-bath

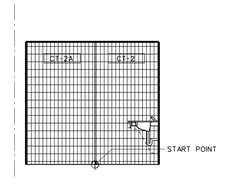


MENS TOILET - TYPICAL WEST ELEVATION 33

SCALE: ¼" = 1'-0" i-elev-bath

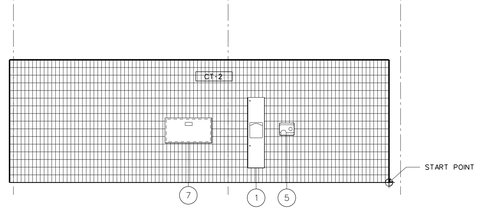


MENS TOILET - TYPICAL SOUTH ELEVATION 32

SCALE: ¼" = 1'-0" i-elev-bath

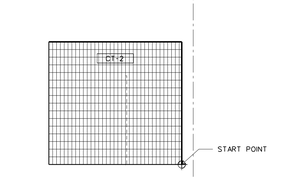


MENS TOILET - TYPICAL EAST ELEVATION 31

SCALE: ¼" = 1'-0" i-elev-bath

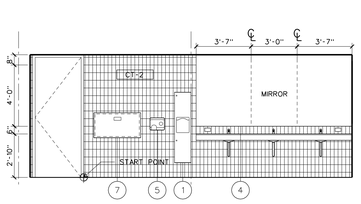


WOMEN'S TOILET - GROUND LEVEL NORTH ELEVATION 24

SCALE: ¼" = 1'-0" i-elev-bath

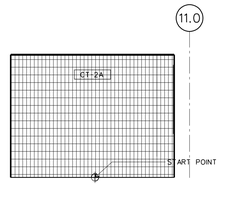


WOMEN'S TOILET - GROUND LEVEL WEST ELEVATION 23

SCALE: ¼" = 1'-0" i-elev-bath

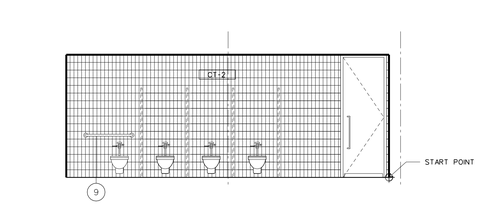


WOMEN'S TOILET - GROUND LEVEL SOUTH ELEVATION 22

SCALE: ¼" = 1'-0" i-elev-bath

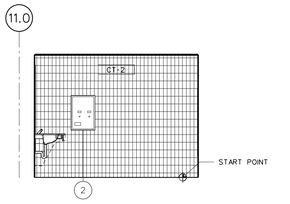


WOMEN'S TOILET - GROUND LEVEL EAST ELEVATION 21

SCALE: ¼" = 1'-0" i-elev-bath

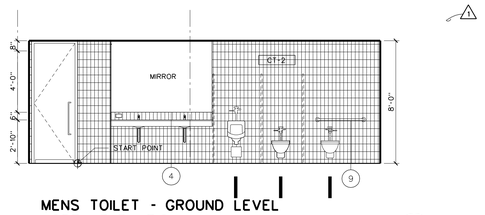


MENS TOILET - GROUND LEVEL NORTH ELEVATION 14

SCALE: ¼" = 1'-0" i-elev-bath

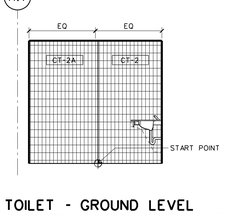


MENS TOILET - GROUND LEVEL WEST ELEVATION 13

SCALE: ¼" = 1'-0" i-elev-bath

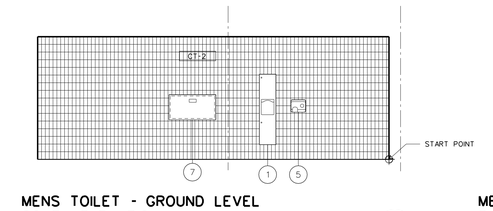


MENS TOILET - GROUND LEVEL SOUTH ELEVATION 12

SCALE: ¼" = 1'-0" i-elev-bath

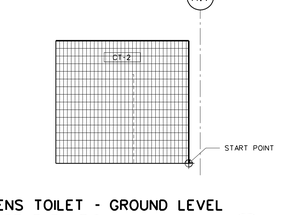

MENS TOILET - GROUND LEVEL EAST ELEVATION 11

SCALE: ¼" = 1'-0" i-elev-bath

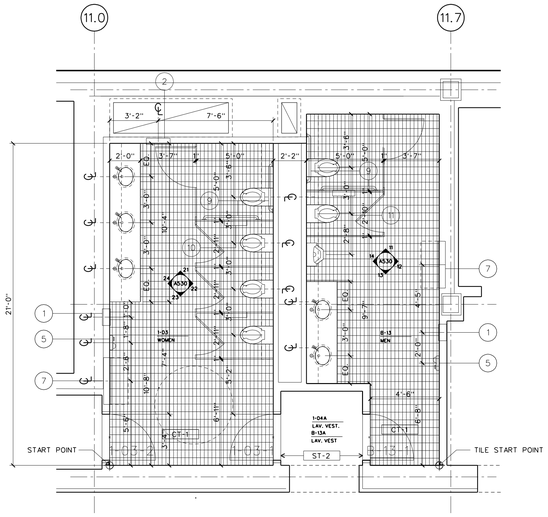

PLAN: GROUND LEVEL 10

SCALE: ¼" = 1'-0" i-elev-bath

WILLIAM J. CLINTON PRESIDENTIAL CENTER

LITTLE ROCK, ARKANSAS

Architect

POLSHEK PARTNERSHIP LLP
320 West 13th Street
New York, New York 10014
212.807.7171

Coordinating Architects

POLK STANLEY YEARY ARCHITECTS Ltd
700 South Schiller Street
501.378.0878

WITSELL EVANS RASCO
901 West Third Street
Little Rock, Arkansas 72201
501.374.5300

WOODS CARADINE ARCHITECTS
2200 South Main Street
Little Rock, Arkansas 72206
501.374.4060

Landscape Architects

HARGREAVES ASSOCIATES
118 Magazine Street
Cambridge, Massachusettes 02139
617.661.0070

LANDSCAPE ARCHITECTURE, Inc.
2300 Cottondale Lane Suite 202
Little Rock, Arkansas 72202
501.374.5610

Structural Engineer

LESLIE E. ROBERTSON ASSOC., RLLP
30 Broad Street, 47th Floor
New York, New York 10004
212.750.9000

MEP Engineers

FLACK + KURTZ Inc.
475 Fifth Avenue
New York, New York 10017
212.532.9600

CROMWELL ARCHITECTS ENGINEERS
101 South Spring Street
Little Rock, Arkansas 72201
501.372.2900


Curtainwall Consultant

R. A. HEINTGES ARCHITECTS
126 Fifth Avenue, 9th Floor
New York, New York 10011
212.652-2966

Seal

4	ASI # 24	10/24/03
3	ASI # 22	08/01/03
2	ASI # 20	06/06/03
1	ASI # 12	02/07/02
	100% Construction Documents	09/27/02
	90% Progress Printing	08/30/02
	100% Struct./ CD Progress	07/01/02
	100% Steel & Concrete CD & Architectural CD Progress	05/15/02
	100% Design Development*	03/01/02
	Issue	Date

*Issued originally on A526 & A527

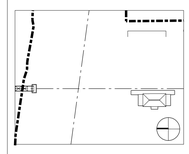

Job No. 9908


Scale 1/4"=1'-0"

Date September 27, 2002

Title
MUSEUM BUILDING RESTROOMS: PLANS AND ELEVATIONS

Sheet No.
A530

FOR OFFICIAL USE ONLY

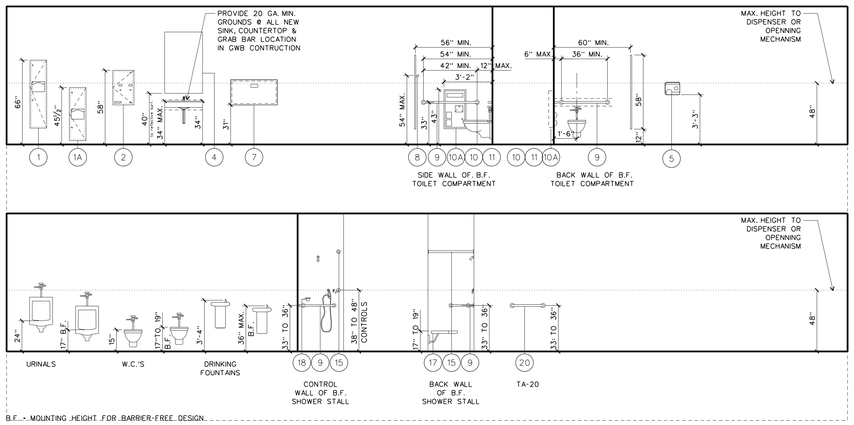

B.F. - MOUNTING HEIGHT FOR BARRIER-FREE DESIGN.

TYPICAL MOUNTING HEIGHTS DIAGRAM

1/4" = 1'-0"

ToiletAccSchedule.dgn

40

TYPICAL MOUNTING HEIGHTS (ACCESSORIES & FIXTURES)

COMMENTS:
1. TOILET ROOM ACCESSORIES SHOULD BE MOUNTED WITH THEIR DISPENSING MECHANISM, COIN SLOTS & DISPENSING OPENINGS @:
- 54" A.F.F. MAX. FOR SIDE REACH,
- 48" A.F.F. MAX. FOR FRONT REACH.
HEIGHTS PROVIDED MEET FRONT REACH REQUIREMENTS.

TOILET ACCESSORY SCHEDULE

ITEM*	DESCRIPTION	MFR	MODEL*	FINISH	MOUNT	REMARKS
TA-1	PAPER TOWEL DISPENSER & WASTE RECEPTACLE	BOBRICK	B-3803	SATIN FINISH STAINLESS STEEL	RECESSED	5⅞" MIN. RECESSED DEPTH
TA-1A	PAPER TOWEL DISPENSER & WASTE RECEPTACLE	BOBRICK	B-39603	SATIN FINISH STAINLESS STEEL	RECESSED	9 " MIN. RECESSED DEPTH
TA-2	SANITARY NAPKIN & TAMPON VENDOR	BOBRICK	B-3500	SATIN FINISH STAINLESS STEEL	RECESSED	4" MIN. RECESSED DEPTH
TA-3	SOAP DISPENSER	BOBRICK	B-8221	STAINLESS STEEL	LAVATORY	-
TA-4	MIRROR WITH FRAME	BOBRICK	B-165	SATIN FINISH STAINLESS STEEL	SURFACE	SPECIFY SIZE
TA-4A	MIRROR WITH FRAME AND SHELF	BOBRICK	B-166-2436	SATIN FINISH STAINLESS STEEL	SURFACE	SPECIFY SIZE
TA-5	HAND DRYER	WORLD DRYER	DXA5	BRUSHED ST. STL. COVER	SURFACE	SPECIFY SIZE
TA-6	FACIAL TISSUE DISPENSER	BOBRICK	B-355	SATIN FINISH STAINLESS STEEL	RECESSED	4" MIN. RECESSED DEPTH
TA-7	BABY CHANGING STATION	BROCAR	100 SS-C	SS EXTERIOR & PLASTIC INTERIOR	RECESSED	3½" MIN. RECESSED DEPTH
TA-8	HAT AND COAT HOOK	BOBRICK	B-682	SATIN FINISH TAINLESS STEEL	SURFACE	-
TA-9	GRAB BAR	BOBRICK	B-6806.99 36" & 42" LENGTH	PEENED GRIP	SURFACE	-
TA-10	SEAT-COVER/TOILET TISSUE DISPENSER SANITARY NAPKIN DISPOSAL	BOBRICK	B-3571	SATIN FINISH STAINLESS STEEL	PARTITION	-
TA-10A	SEAT-COVER/TOILET TISSUE DISPENSER SANITARY NAPKIN DISPOSAL	BOBRICK	B-3574	SATIN FINISH STAINLESS STEEL	RECESSED	4" MIN. RECESSED DEPTH
TA-11	SEAT-COVER/TOILET TISSUE DISPENSER	BOBRICK	B-3471	SATIN FINISH STAINLESS STEEL	PARTITION	-
TA-11A	SEAT-COVER/TOILET TISSUE DISPENSER	BOBRICK	B-3471	SATIN FINISH STAINLESS STEEL	RECESSED	4" MIN. RECESSED DEPTH
TA-15	SHOWER CURTIAN ROD	BOBRICK	B-6047	STAINLESS STEEL	SURFACE	-
TA-16	MOP AND BROOM HOLDER	BOBRICK	B-239X34	SATIN FINISH STAINLESS STEEL	SURFACE	-
TA-17	SHOWER SEAT	BOBRICK	B-5181	SOLID PHENOLIC	SURFACE	-
TA-18	SOAP DISH	BOBRICK	B-680	STAINLESS STEEL	SURFACE	-
TA-20	EXTRA-HEAVY-DUTY TOWEL BAR	BOBRICK	B-550	SATIN FINISH STAINLESS STEEL	SURFACE	-


TOILET ACCESSORIES SCHEDULE

COMMENTS:
1. COORDINATE PARTITION CHASE DEPTH WITH MOUNTING CLEARANCES NOTED IN 'REMARKS' COLUMN. DELETE REMARKS AFTER COORDINATING.

2. RECOMMENDED WOMEN'S OR UNISEX TOILET ROOM ACCESSORIES:
- 1 OR 1A (NOTE 'A')
- 2
- 3 (NOTE 'B')
- 4 OR 4A (NOTE 'C')
- 7 OR 7A (NOTE 'D')
- 9
- 10 OR 10A


3. RECOMMENDED MEN'S TOILET ROOM ACCESSORIES:
- 1 OR 1A (NOTE 'A')
- 3 (NOTE 'B')
- 4 OR 4A (NOTE 'C')
- 7 OR 7A (NOTE 'D')
- 9
- 11 OR 11A

NOTES:
A. VERIFY PAPER TYPE REQUIREMENTS.
B. COORDINATE DISPENSER WITH SPECIFIED LAVATORY. USE 5 & 18 IF LAVATORY/COUNTER TOP CAN NOT ACCOMMODATE DISPENSER 4.
C. IF SHELF IS USED, VERIFY CLEARANCES OF LAVATORY HARDWARE. USE FULL WIDTH MIRROR AT COUNTER TOPS.
D. USE AT PUBLIC TOILETS ONLY. SELECT MAKE BASED ON FINISH PREFERENCES.

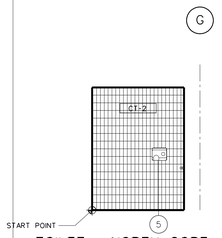


TOILET - NORTH CORE NORTH ELEVATION

SCALE: 1/4" = 1'-0" i-elev-bath 35

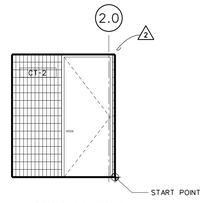


TOILET - NORTH CORE WEST ELEVATION

SCALE: 1/4" = 1'-0" i-elev-bath 34

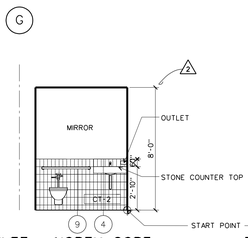


TOILET - NORTH CORE SOUTH ELEVATION

SCALE: 1/4" = 1'-0" i-elev-bath 33

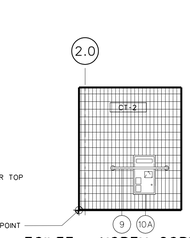


TOILET - NORTH CORE EAST ELEVATION

SCALE: 1/4" = 1'-0" i-elev-bath 32

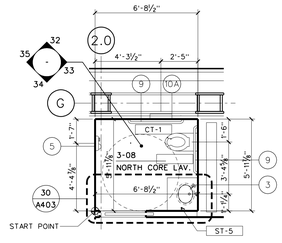

PLAN: NORTH CORE

SCALE: 1/4" = 1'-0" i-elev-bath 31

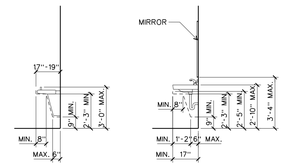


A. DRINKING FOUNTAIN B. LAVATORY

D.F. & LAVATORY CLEARENCES


1/4" = 1'-0"

30

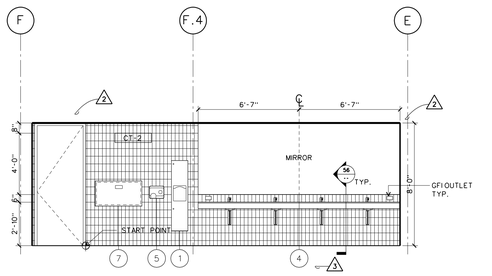


WOMEN'S TOILET - TYPICAL NORTH ELEVATION

SCALE: 1/4" = 1'-0" i-elev-bath 24

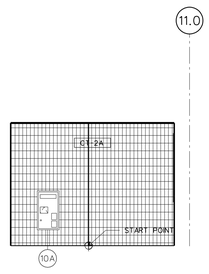


WOMEN'S TOILET - TYPICAL WEST ELEVATION

SCALE: 1/4" = 1'-0" i-elev-bath 23

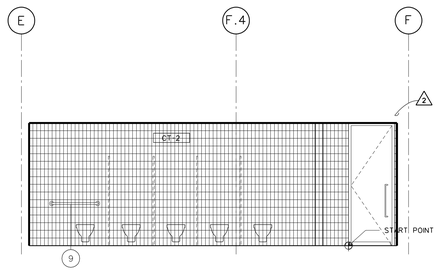


WOMEN'S TOILET - TYPICAL SOUTH ELEVATION

SCALE: 1/4" = 1'-0" i-elev-bath 22

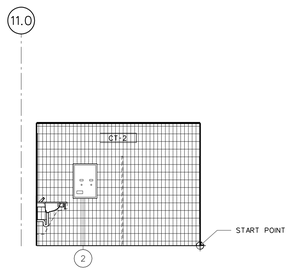


WOMEN'S TOILET - TYPICAL EAST ELEVATION

SCALE: 1/4" = 1'-0" i-elev-bath 21

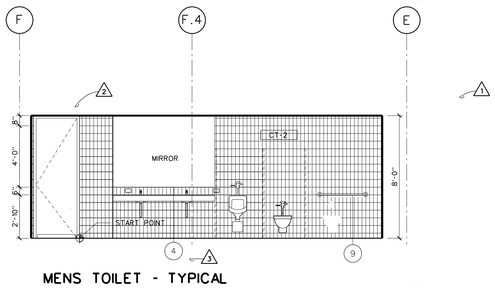


MENS TOILET - TYPICAL NORTH ELEVATION

SCALE: 1/4" = 1'-0" i-elev-bath 14

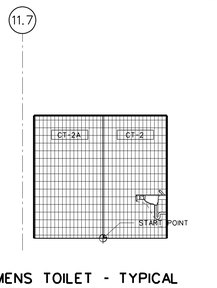


MENS TOILET - TYPICAL WEST ELEVATION

SCALE: 1/4" = 1'-0" i-elev-bath 13

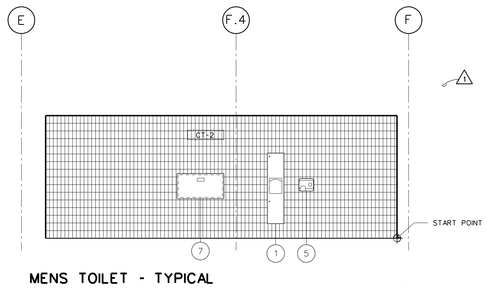


MENS TOILET - TYPICAL SOUTH ELEVATION

SCALE: 1/4" = 1'-0" i-elev-bath 12

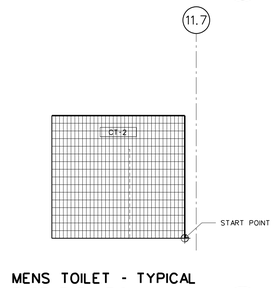

MENS TOILET - TYPICAL EAST ELEVATION

SCALE: 1/4" = 1'-0" i-elev-bath 11

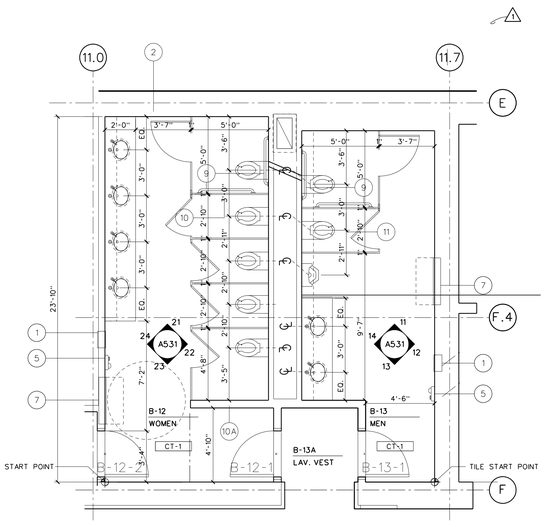

PLAN: BASEMENT LEVEL

SCALE: 1/4" = 1'-0" i-elev-bath 10

WILLIAM J. CLINTON PRESIDENTIAL CENTER

LITTLE ROCK, ARKANSAS

Architect
POLSHEK PARTNERSHIP LLP
320 West 13th Street
New York, New York 10014
212.807.7171

Coordinating Architects
POLK STANLEY YEARY ARCHITECTS Ltd
700 South Schiller Street
Little Rock, Arkansas 72201
501.378.0878

WITSELL EVANS RASCO
901 West Third Street
Little Rock, Arkansas 72201
501.374.5300

WOODS CARADINE ARCHITECTS
2200 South Main Street
Little Rock, Arkansas 72206
501.374.4060

Landscape Architects
HARGREAVES ASSOCIATES
118 Magazine Street
Cambridge, Massachusettes 02139
617.661.0070

LANDSCAPE ARCHITECTURE, Inc.
2300 Cottondale Lane Suite 202
Little Rock, Arkansas 72202
501.374.5610

Structural Engineer
LESLIE E. ROBERTSON ASSOC., RLLP
30 Broad Street, 47th Floor
New York, New York 10004
212.750.9000

MEP Engineers
FLACK + KURTZ Inc.
475 Fifth Avenue
New York, New York 10017
212.532.9600

CROMWELL ARCHITECTS ENGINEERS
101 South Spring Street
Little Rock, Arkansas 72201
501.372.2900

Curtainwall Consultant
R. A. HEINTGES ARCHITECTS
126 Fifth Avenue, 9th Floor
New York, New York 10011
212.652-2966

Seal

3	ASI # 22	08/01/03
2	ASI # 20	06/06/03
1	ASI # 12	02/07/02
	100% Construction Documents	09/27/02
	90% Progress Printing	08/30/02
	100% Struct./ CD Progress	07/01/02
	100% Steel & Concrete CD & Architectural CD Progress	05/15/02
	100% Design Development*	03/01/02
	Issue	Date

*Issued originally as A528

Job No. 9908


Scale 1/4"=1'-0"

Date September 27, 2002

Title
MUSEUM BUILDING RESTROOMS: PLANS, ELEVATIONS, & SCHEDULE


Sheet No.
A531

FOR OFFICIAL USE ONLY

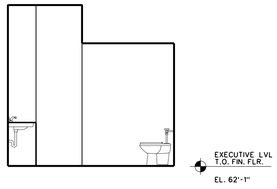


NORTH ELEV. 5-11 BATHROOM — 43

SCALE: 1/4" = 1' b-inel21.dgn

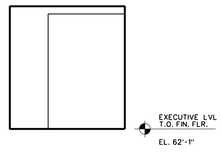


WEST ELEV. 5-11 BATHROOM — 42

SCALE: 1/4" = 1' b-inel21.dgn

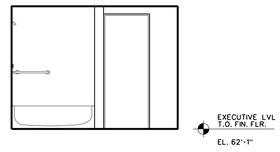


SOUTH ELEV. 5-11 BATHROOM — 41

SCALE: 1/4" = 1' b-inel21.dgn

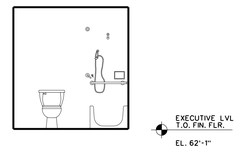

EAST ELEV. 5-11 BATHROOM — 40

SCALE: 1/4" = 1' b-inel21.dgn

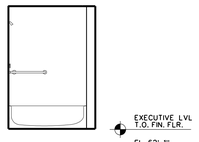


NORTH ELEV. 5-09 BATHROOM — 33

SCALE: 1/4" = 1' b-inel24.dgn




WEST ELEV. 5-09 BATHROOM — 32

SCALE: 1/4" = 1' b-inel24.dgn

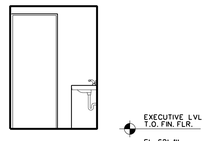


SOUTH ELEV. 5-09 BATHROOM — 31

SCALE: 1/4" = 1' b-inel24.dgn

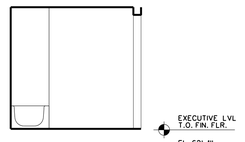

EAST ELEV. 5-09 BATHROOM — 30

SCALE: 1/4" = 1' b-inel24.dgn

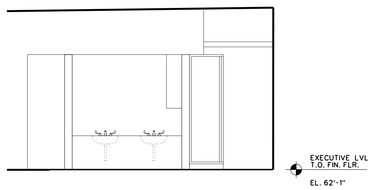


WEST ELEV. BEDROOM 1 — 22

SCALE: 1/4" = 1' b-inel26.dgn


EAST ELEV. (1) BEDROOM 1 — 21

SCALE: 1/4" = 1' b-inel-28.dgn

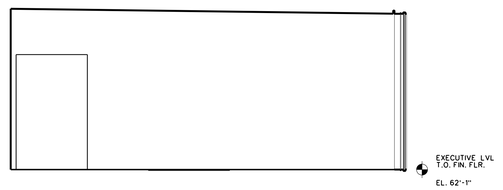


EAST ELEVATION (2) BEDROOM 2 — 20

SCALE: 1/4"= 1'- b-inel-28.dgn

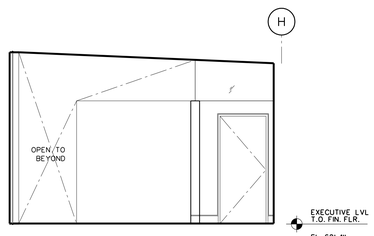

XXXXXXXXXX
XXXXXXXXXX

SCALE: XX " = XX'-XX" REF FILE NAME — 11

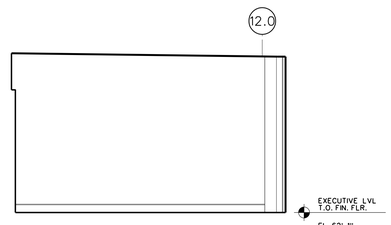

XXXXXXXXXX
XXXXXXXXXX

SCALE: XX " = XX'-XX" REF FILE NAME — 10

WILLIAM J. CLINTON PRESIDENTIAL CENTER

LITTLE ROCK, ARKANSAS

Architect

POLSHEK PARTNERSHIP LLP
320 West 13th Street
New York, New York 10014
212.807.7171

Coordinating Architects

POLK STANLEY YEARY ARCHITECTS Ltd
700 South Schiller Street
Little Rock, Arkansas 72201
501.378.0878

WITSELL EVANS RASCO
901 West Third Street
Little Rock, Arkansas 72201
501.374.5300

WOODS CARADINE ARCHITECTS
2200 South Main Street
Little Rock, Arkansas 72206
501.374.4060

Landscape Architects

HARGREAVES ASSOCIATES
118 Magazine Street
Cambridge, Massachusettes 02139
617.661.0070

LANDSCAPE ARCHITECTURE, Inc.
2300 Cottondale Lane Suite 202
Little Rock, Arkansas 72202
501.374.5610

Structural Engineer

LESLIE E. ROBERTSON ASSOC., RLLP
30 Broad Street, 47th Floor
New York, New York 10004
212.750.9000

MEP Engineers

FLACK + KURTZ Inc.
475 Fifth Avenue
New York, New York 10017
212.532.9600


CROMWELL ARCHITECTS ENGINEERS
101 South Spring Street
Little Rock, Arkansas 72201
501.372.2900

Curtainwall Consultant

R. A. HEINTGES ARCHITECTS
126 Fifth Avenue, 9th Floor
New York, New York 10011
212.652-2966

Seal

Issue	Date
100% Construction Documents	09/27/02

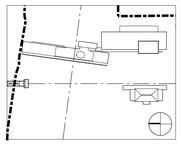

Job No. 9908


Scale 1/4"=1'-0"

Date September 27, 2002

Title MUSEUM BUILDING RESTROOMS: PLANS AND ELEVATIONS

Sheet No. A532

FOR OFFICIAL USE ONLY

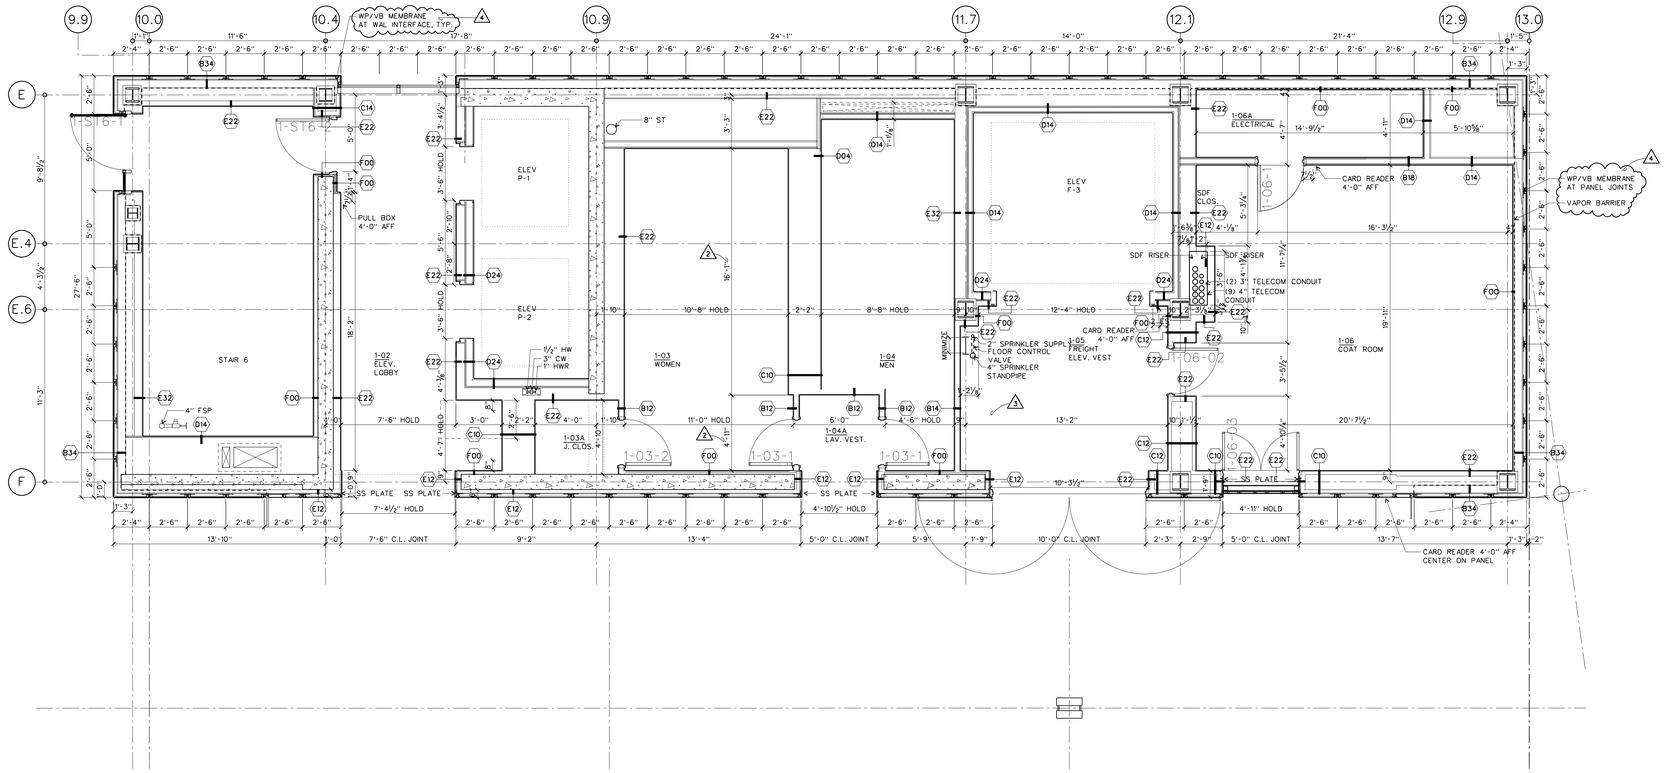


MAIN CORE: PLAN AT GROUND LEVEL

SCALE: 1/4" = 1'-0"

base/core 1.dgn

20

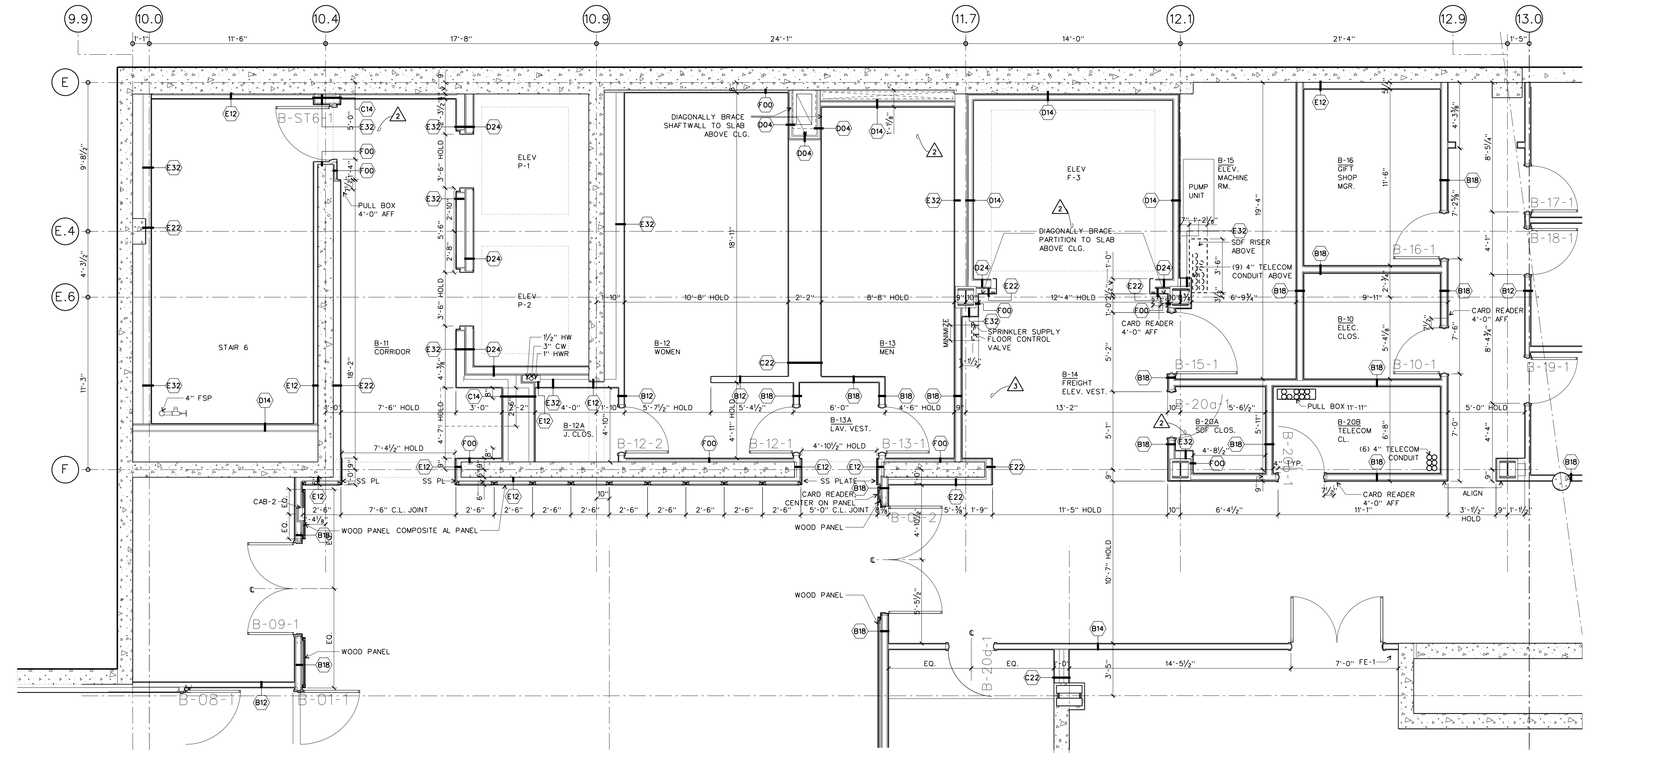

MAIN CORE: PLAN AT BASEMENT LEVEL

SCALE: 1/4" = 1'-0"

base/core 1.dgn

10

WILLIAM J. CLINTON PRESIDENTIAL CENTER

LITTLE ROCK, ARKANSAS

Architect

POLSHEK PARTNERSHIP LLP
320 West 13th Street
New York, New York 10014
212.807.7171

Coordinating Architects

POLK STANLEY YEARY ARCHITECTS Ltd
700 South Schiller Street
Little Rock, Arkansas 72201
501.378.0878

WITSELL EVANS RASCO
901 West Third Street
Little Rock, Arkansas 72201
501.374.5300

WOODS CARADINE ARCHITECTS
2200 South Main Street
Little Rock, Arkansas 72206
501.374.4060

Landscape Architects

HARGREAVES ASSOCIATES
118 Magazine Street
Cambridge, Massachusettes 02139
617.661.0070

LANDSCAPE ARCHITECTURE, Inc.
2300 Cottondale Lane Suite 202
Little Rock, Arkansas 72202
501.374.5610

Structural Engineer

LESLIE E. ROBERTSON ASSOC., RLLP
30 Broad Street, 47th Floor
New York, New York 10004
212.750.9000

MEP Engineers

FLACK + KURTZ Inc.
475 Fifth Avenue
New York, New York 10017
212.532.9600

CROMWELL ARCHITECTS ENGINEERS
101 South Spring Street
Little Rock, Arkansas 72201
501.372.2900

Curtainwall Consultant

R. A. HEINTGES ARCHITECTS
126 Fifth Avenue, 9th Floor
New York, New York 10011
212.652-2966

Seal

Issue	Date
4 ASI #22	08/01/03
3 ASI #	01/09/03
2 Addendum #7	12/20/02
1 Addendum #2	11/15/02

Job No. 9908

Scale 1/4" = 1'-0"

Date September 27, 2002


Title

ENLARGED CORE PLANS, BASEMENT & GROUND LEVELS

Sheet No.

A540

FOR OFFICIAL USE ONLY

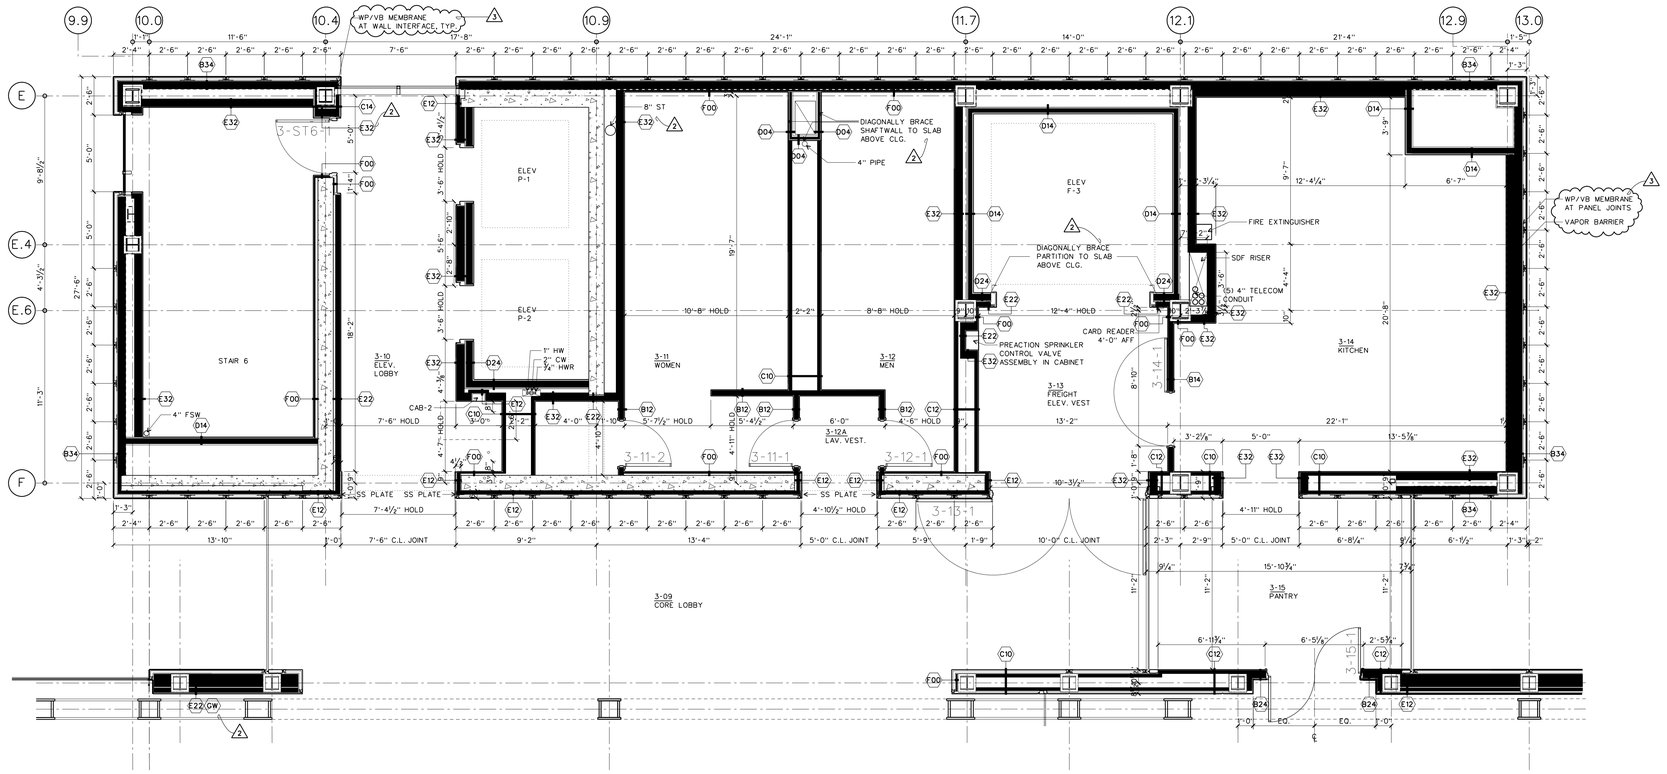


MAIN CORE: PLAN AT LOWER MUSEUM LEVEL

SCALE: 1/4" = 1'-0"

base/core 2.dgn

20

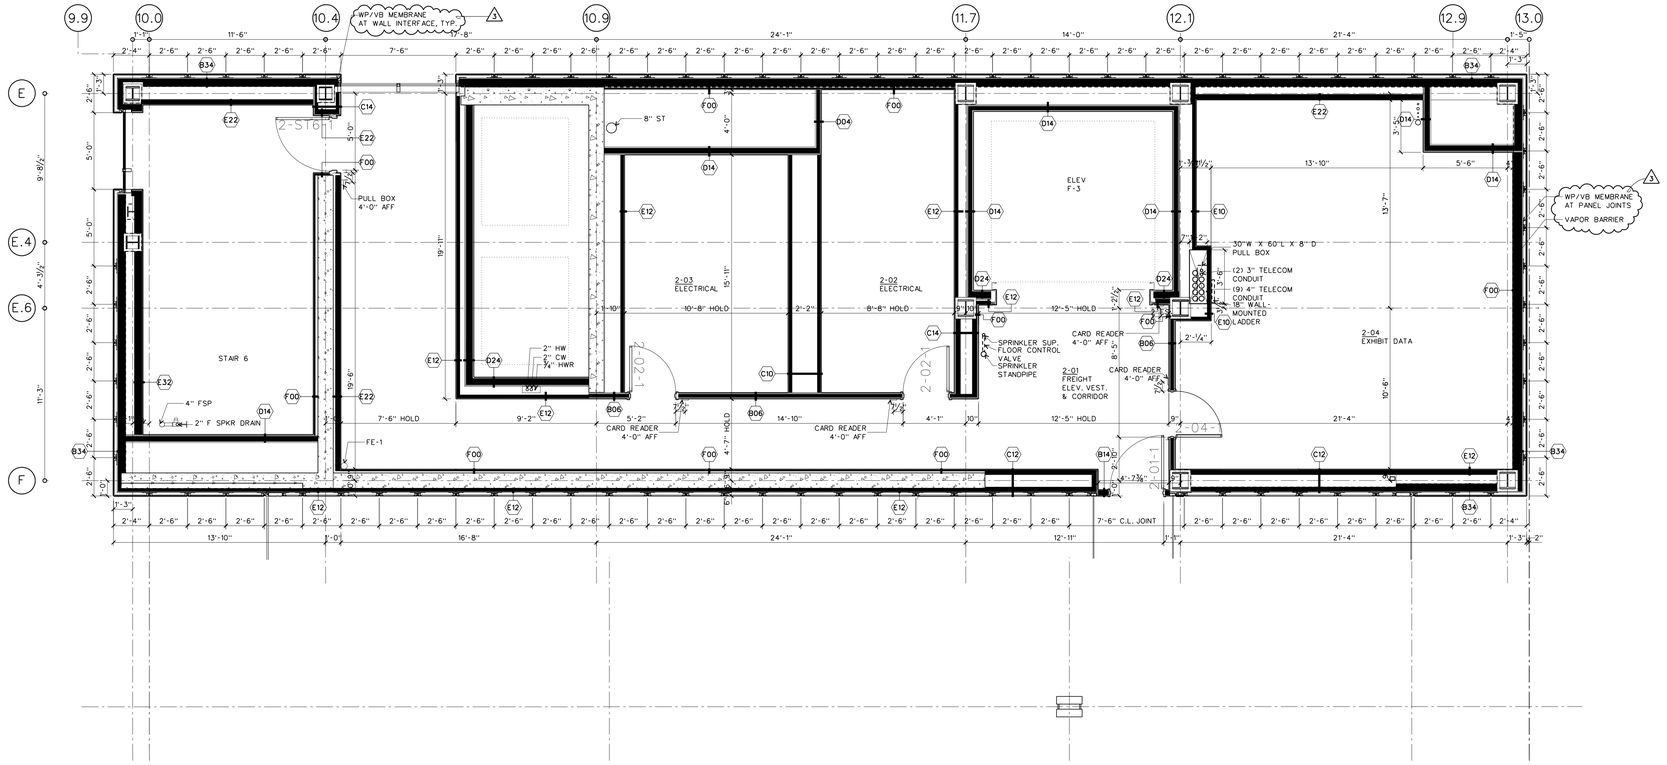

MAIN CORE: PLAN AT SECOND LEVEL

SCALE: 1/4" = 1'-0"

base/core 2.dgn

10

WILLIAM J. CLINTON PRESIDENTIAL CENTER

LITTLE ROCK, ARKANSAS

Architect

POLSHEK PARTNERSHIP LLP
320 West 13th Street
New York, New York 10014
212.807.7171

Coordinating Architects

POLK STANLEY YEARY ARCHITECTS Ltd
700 South Schiller Street
Little Rock, Arkansas 72201
501.378.0878

WITSELL EVANS RASCO
901 West Third Street
Little Rock, Arkansas 72201
501.374.5300

WOODS CARADINE ARCHITECTS
2200 South Main Street
Little Rock, Arkansas 72206
501.374.4060

Landscape Architects

HARGREAVES ASSOCIATES
118 Magazine Street
Cambridge, Massachusettes 02139
617.661.0070

LANDSCAPE ARCHITECTURE, Inc.
2300 Cottondale Lane Suite 202
Little Rock, Arkansas 72202
501.374.5610

Structural Engineer

LESLIE E. ROBERTSON ASSOC., RLLP
30 Broad Street, 47th Floor
New York, New York 10004
212.750.9000

MEP Engineers

FLACK + KURTZ Inc.
475 Fifth Avenue
New York, New York 10017
212.532.9600


CROMWELL ARCHITECTS ENGINEERS
101 South Spring Street
Little Rock, Arkansas 72201
501.372.2900

Curtainwall Consultant

R. A. HEINTGES ARCHITECTS
126 Fifth Avenue, 9th Floor
New York, New York 10011
212.652-2966

Seal

Issue	Date
3 ASI #22	08/01/03
2 Addendum #7	12/20/02
1 Addendum #2	11/15/02

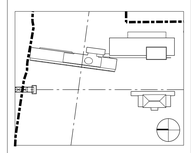

Job No. 9908


Scale 1/4" = 1'-0"

Date September 27, 2002

Title ENLARGED CORE PLANS, SECOND & LOWER MUSEUM LEVELS

Sheet No. 1 A541

FOR OFFICIAL USE ONLY

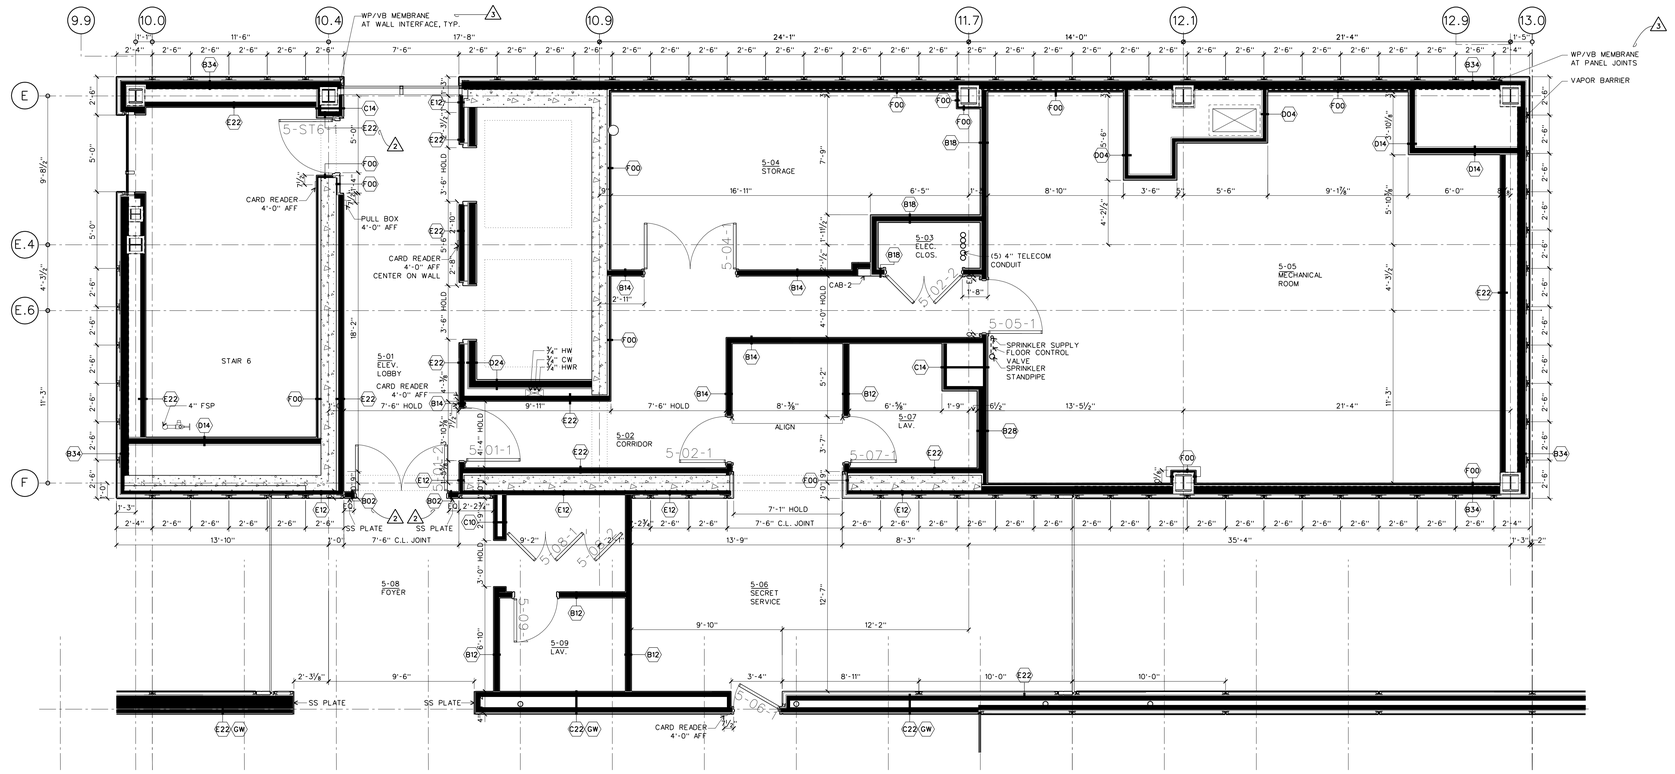


MAIN CORE: PLAN AT EXECUTIVE LEVEL

SCALE: 1/4" = 1'-0"

base/core 3.dgn

20

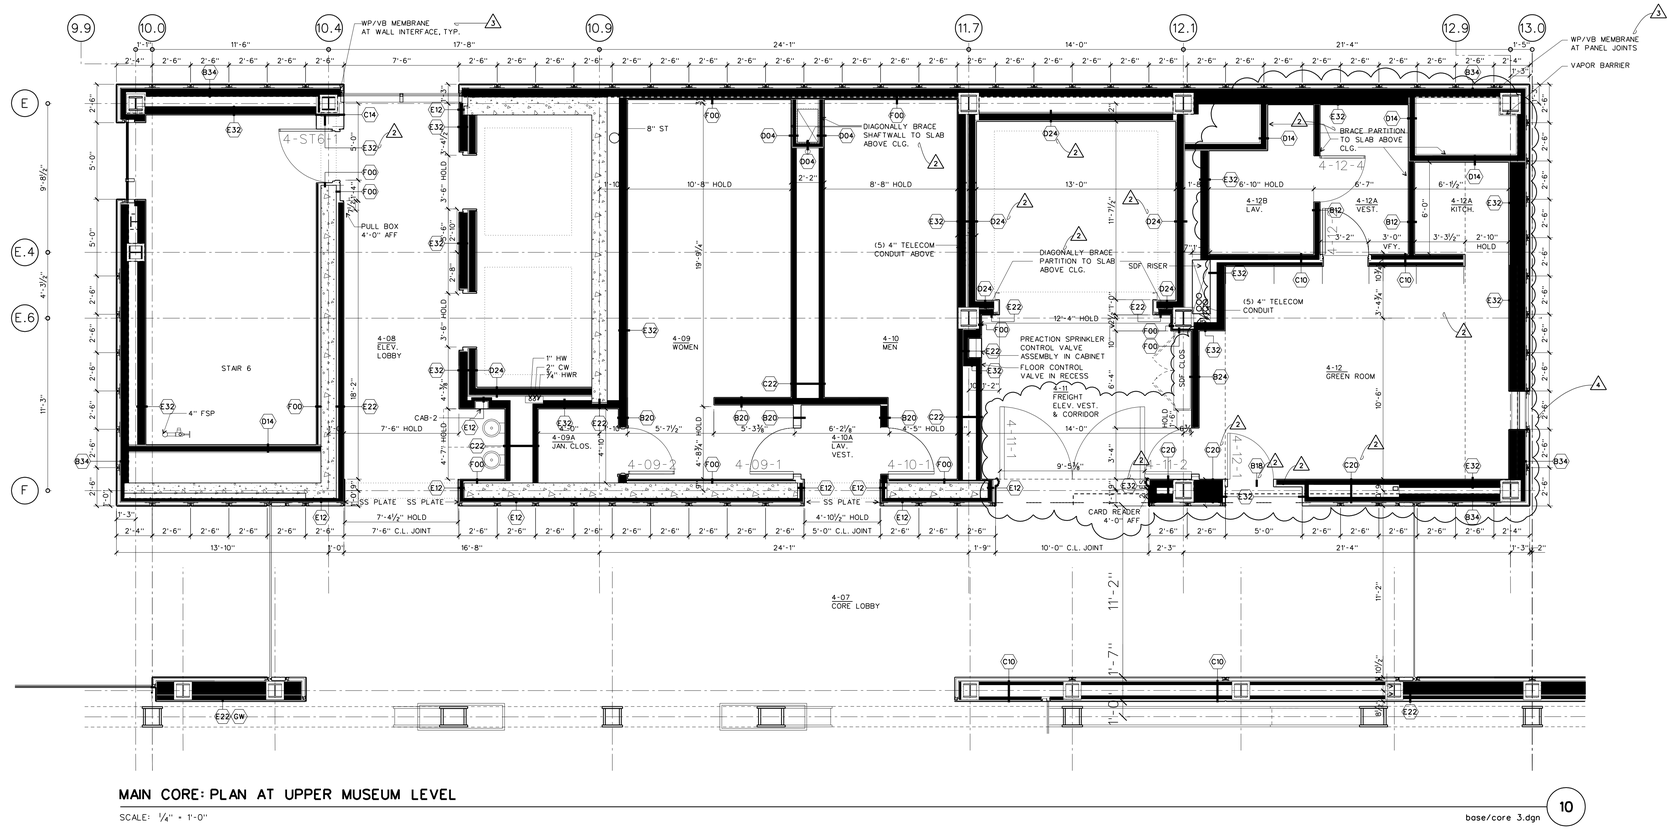

MAIN CORE: PLAN AT UPPER MUSEUM LEVEL

SCALE: 1/4" = 1'-0"

base/core 3.dgn

10

WILLIAM J. CLINTON PRESIDENTIAL CENTER

LITTLE ROCK, ARKANSAS

Architect

POLSHEK PARTNERSHIP LLP
320 West 13th Street
New York, New York 10014
212.807.7171

Coordinating Architects

POLK STANLEY YEARY ARCHITECTS Ltd
700 South Schiller Street
Little Rock, Arkansas 72201
501.378.0878

WITSELL EVANS RASCO
901 West Third Street
Little Rock, Arkansas 72201
501.374.5300

WOODS CARADINE ARCHITECTS
2200 South Main Street
Little Rock, Arkansas 72206
501.374.4060

Landscape Architects

HARGREAVES ASSOCIATES
118 Magazine Street
Cambridge, Massachusettes 02139
617.661.0070

LANDSCAPE ARCHITECTURE, Inc.
2300 Cottondale Lane Suite 202
Little Rock, Arkansas 72202
501.374.5610

Structural Engineer

LESLIE E. ROBERTSON ASSOC., RLLP
30 Broad Street, 47th Floor
New York, New York 10004
212.750.9000

MEP Engineers

FLACK + KURTZ Inc.
475 Fifth Avenue
New York, New York 10017
212.532.9600

CROMWELL ARCHITECTS ENGINEERS
101 South Spring Street
Little Rock, Arkansas 72201
501.372.2900

Curtainwall Consultant

R. A. HEINTGES ARCHITECTS
126 Fifth Avenue, 9th Floor
New York, New York 10011
212.652-2966

Seal

Issue	Date
4 ASI #24	10/24/03
3 ASI #22	08/01/03
2 Addendum #7	12/20/02
1 Addendum #2	11/15/02

Job No. 9908


Scale 1/4" = 1'-0"

Date September 27, 2002

Title ENLARGED CORE PLANS, UPPER MUSEUM & EXECUTIVE LEVELS

Sheet No. 4 A542

FOR OFFICIAL USE ONLY

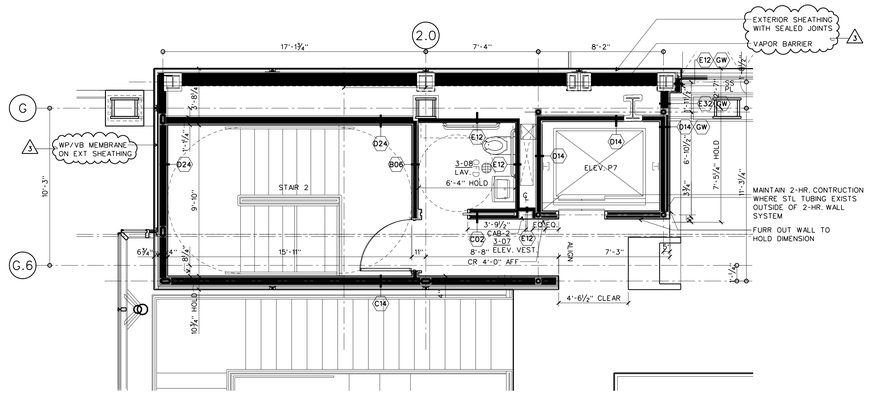


NORTH CORE: PLAN AT UPPER MUSEUM LEVEL

SCALE: 1/4" = 1'-0"

details/d-core-n01.dgn

30

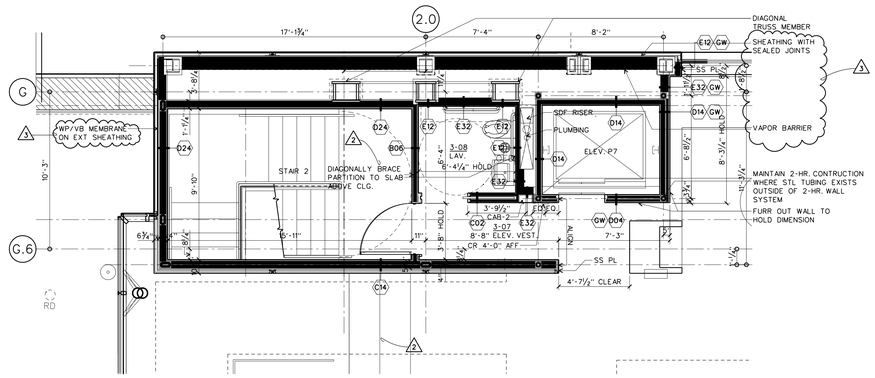


NORTH CORE: PLAN AT LOWER MUSEUM LEVEL

SCALE: 1/4" = 1'-0"

details/d-core-n01.dgn

20

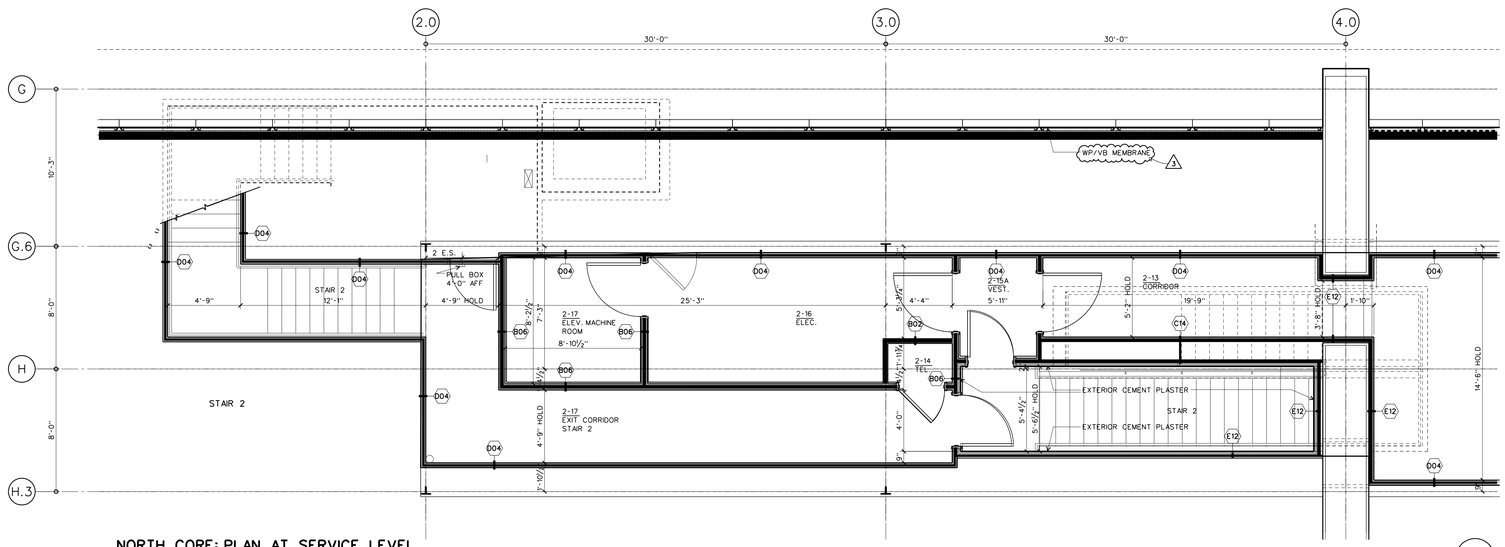

NORTH CORE: PLAN AT SERVICE LEVEL

SCALE: 1/4" = 1'-0"

details/d-core-n01.dgn

10

WILLIAM J. CLINTON PRESIDENTIAL CENTER

LITTLE ROCK, ARKANSAS

Architect

POLSHEK PARTNERSHIP LLP
320 West 13th Street
New York, New York 10014
212.807.7171

Coordinating Architects

POLK STANLEY YEARY ARCHITECTS Ltd
700 South Schiller Street
Little Rock, Arkansas 72201
501.378.0878

WITSELL EVANS RASCO
901 West Third Street
Little Rock, Arkansas 72201
501.374.5300

WOODS CARADINE ARCHITECTS
2200 South Main Street
Little Rock, Arkansas 72206
501.374.4060

Landscape Architects

HARGREAVES ASSOCIATES
118 Magazine Street
Cambridge, Massachusettes 02139
617.661.0070

LANDSCAPE ARCHITECTURE, Inc.
2300 Cottondale Lane Suite 202
Little Rock, Arkansas 72202
501.374.5610

Structural Engineer

LESLIE E. ROBERTSON ASSOC., RLLP
30 Broad Street, 47th Floor
New York, New York 10004
212.750.9000

MEP Engineers

FLACK + KURTZ Inc.
475 Fifth Avenue
New York, New York 10017
212.532.9600

CROMWELL ARCHITECTS ENGINEERS
101 South Spring Street
Little Rock, Arkansas 72201
501.372.2900

Curtainwall Consultant

R. A. HEINTGES ARCHITECTS
126 Fifth Avenue, 9th Floor
New York, New York 10011
212.652-2966

Seal

Issue	Date
1 ASI #22	08/01/03
2 Addendum #7	12/20/02
1 Addendum #2	11/15/02

Job No. 9908

Scale 1/4" = 1'-0"


Date September 27, 2002

Title

ENLARGED NORTH CORE PLANS

Sheet No. 1 A543

FOR OFFICIAL USE ONLY

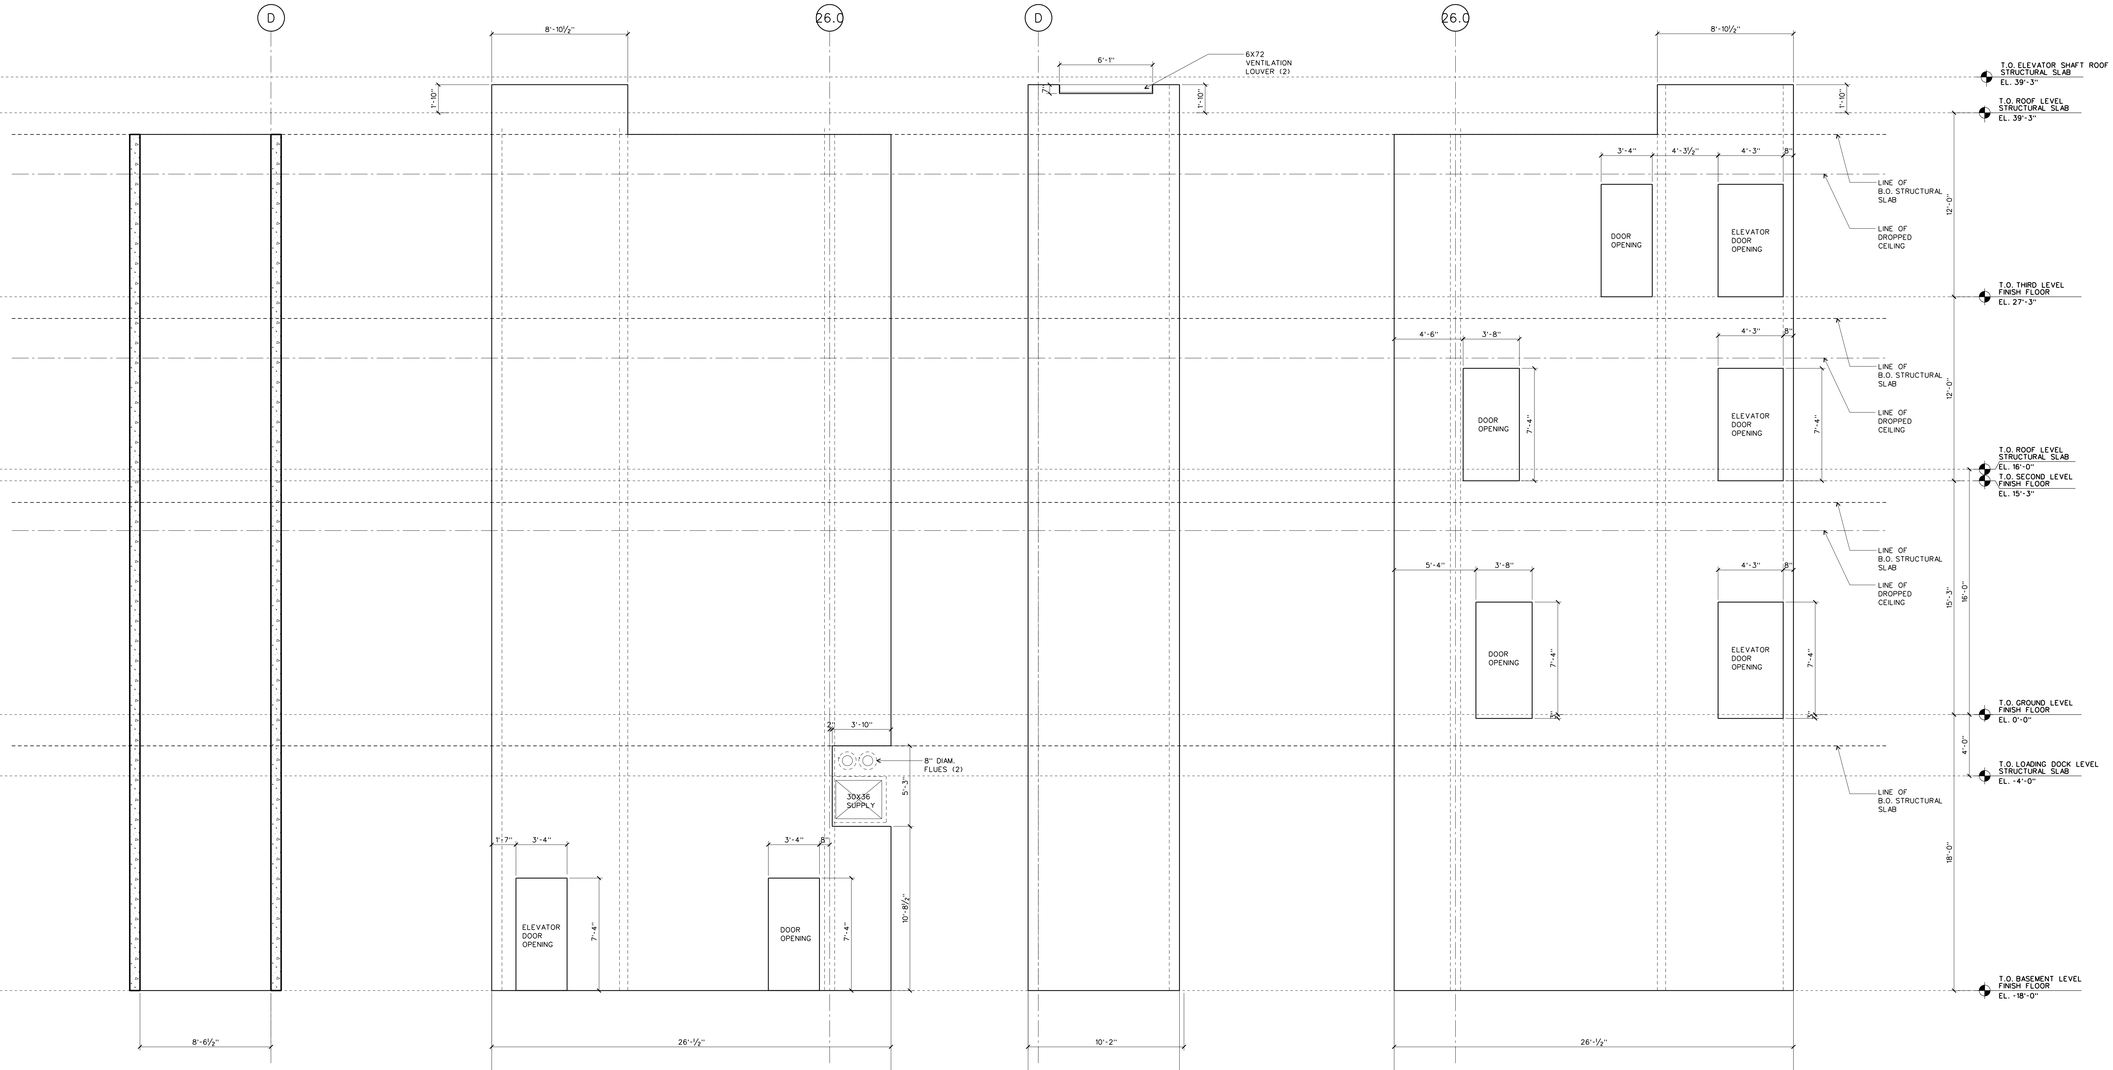

NORTH WALL ELEVATION
SCALE: ¼" = 1'-0" PLANS/STAIR 10 10

EAST WALL ELEVATION
SCALE: ¼" = 1'-0" PLANS/STAIR 10 13

SOUTH WALL ELEVATION
SCALE: ¼" = 1'-0" PLANS/STAIR 10 12

WEST WALL ELEVATION
SCALE: ¼" = 1'-0" PLANS/STAIR 10 11

WILLIAM J. CLINTON PRESIDENTIAL CENTER

LITTLE ROCK, ARKANSAS

Architect

POLSHEK PARTNERSHIP LLP
320 West 13th Street
New York, New York 10014
212.807.7171

Coordinating Architects

POLK STANLEY YEARY ARCHITECTS Ltd
700 South Schiller Street
Little Rock, Arkansas 72201
501.378.0878

WITSELL EVANS RASCO
901 West Third Street
Little Rock, Arkansas 72201
501.374.5300

WOODS CARADINE ARCHITECTS
2200 South Main Street
Little Rock, Arkansas 72206
501.374.4060

Landscape Architects

HARGREAVES ASSOCIATES
118 Magazine Street
Cambridge, Massachusettes 02139
617.661.0070

LANDSCAPE ARCHITECTURE, Inc.
2300 Cottondale Lane Suite 202
Little Rock, Arkansas 72202
501.374.5610

Structural Engineer

LESLIE E. ROBERTSON ASSOC., RLLP
30 Broad Street, 47th Floor
New York, New York 10004
212.750.9000

MEP Engineers

FLACK + KURTZ Inc.
475 Fifth Avenue
New York, New York 10017
212.532.9600


CROMWELL ARCHITECTS ENGINEERS
101 South Spring Street
Little Rock, Arkansas 72201
501.372.2900

Curtainwall Consultant

R. A. HEINTGES ARCHITECTS
126 Fifth Avenue, 9th Floor
New York, New York 10011
212.652-2966

Seal

Issue	Date
100% Construction Documents	09/27/02
90% Progress Printing	08/30/02
ASI #05	08/20/02
100% Struct./ CD Progress	07/01/02
Bridge Bldg. Substructure	06/14/02
100% Steel & Concrete CD	05/15/02
& Architectural CD Progress	
100% Design Development	03/01/02

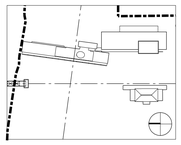

Job No.
9908

Scale
1/4"=1'-0"


Date
September 27, 2002

Title

STAIR 10 SHEAR WALL ELEVATIONS

Sheet No.
A546

FOR OFFICIAL USE ONLY

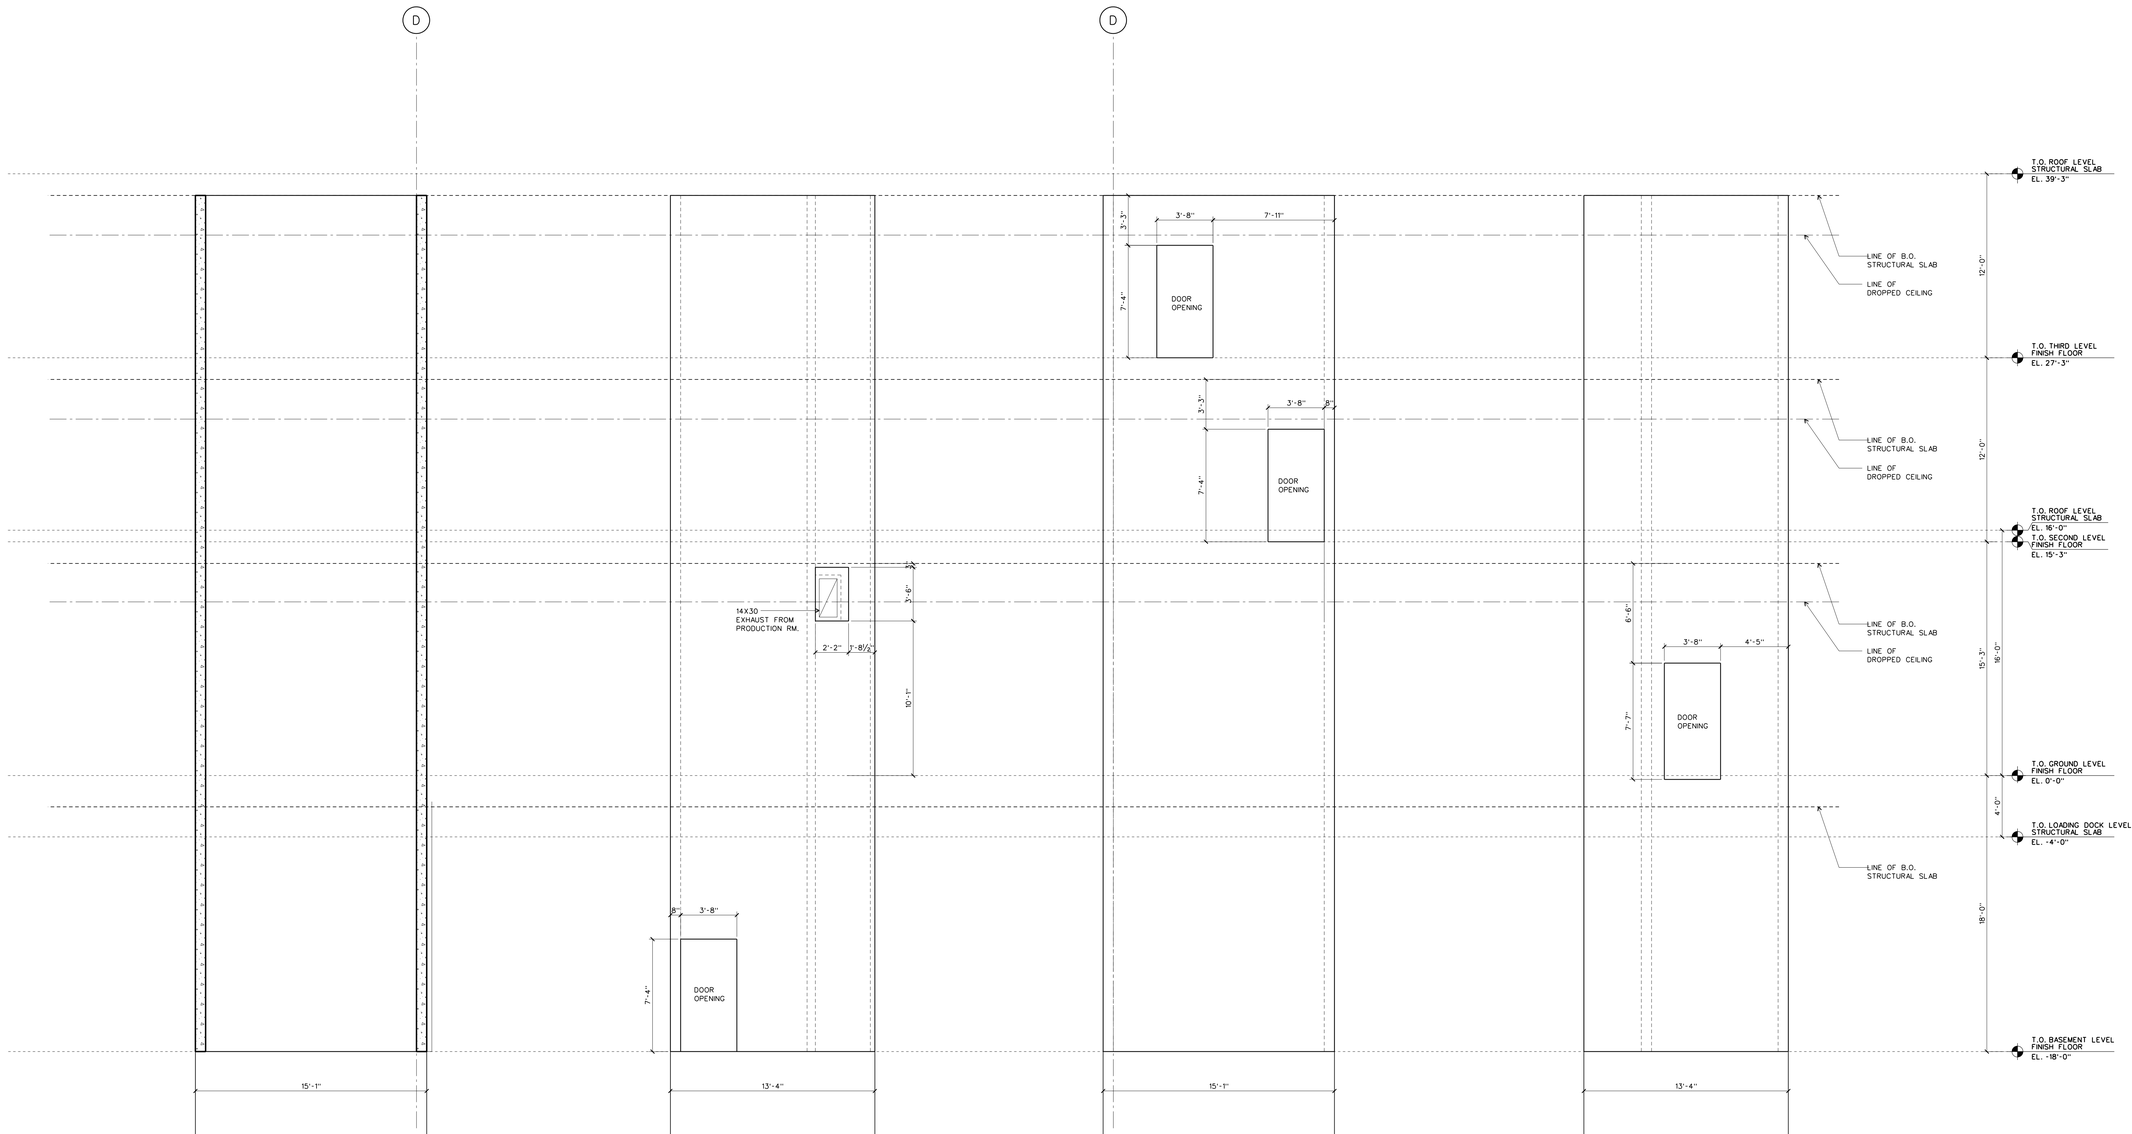

NORTH WALL ELEVATION
SCALE: ¼" = 1'-0" PLANS/STAIR 11 10

EAST WALL ELEVATION
SCALE: ¼" = 1'-0" PLANS/STAIR 11 13

SOUTH WALL ELEVATION
SCALE: ¼" = 1'-0" PLANS/STAIR 11 12

WEST WALL ELEVATION
SCALE: ¼" = 1'-0" PLANS/STAIR 11 11

WILLIAM J. CLINTON PRESIDENTIAL CENTER

LITTLE ROCK, ARKANSAS

Architect

POLSHEK PARTNERSHIP LLP
320 West 13th Street
New York, New York 10014
212.807.7171

Coordinating Architects

POLK STANLEY YEARY ARCHITECTS Ltd
700 South Schiller Street
Little Rock, Arkansas 72201
501.378.0878

WITSELL EVANS RASCO
901 West Third Street
Little Rock, Arkansas 72201
501.374.5300

WOODS CARADINE ARCHITECTS
2200 South Main Street
Little Rock, Arkansas 72206
501.374.4060

Landscape Architects

HARGREAVES ASSOCIATES
118 Magazine Street
Cambridge, Massachusettes 02139
617.661.0070

LANDSCAPE ARCHITECTURE, Inc.
2300 Cottondale Lane Suite 202
Little Rock, Arkansas 72202
501.374.5610

Structural Engineer

LESLIE E. ROBERTSON ASSOC., RLLP
30 Broad Street, 47th Floor
New York, New York 10004
212.750.9000

MEP Engineers

FLACK + KURTZ Inc.
475 Fifth Avenue
New York, New York 10017
212.532.9600


CROMWELL ARCHITECTS ENGINEERS
101 South Spring Street
Little Rock, Arkansas 72201
501.372.2900

Curtainwall Consultant

R. A. HEINTGES ARCHITECTS
126 Fifth Avenue, 9th Floor
New York, New York 10011
212.652-2966

Seal

Issue	Date
100% Construction Documents	09/27/02
90% Progress Printing	08/30/02
ASI #05	08/20/02
100% Struct./ CD Progress	07/01/02
Bridge Bldg. Substructure	06/14/02
100% Steel & Concrete CD	05/15/02
& Architectural CD Progress	
100% Design Development	03/01/02

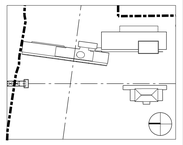

Job No. 9908

Scale 1/4"=1'-0"

Date September 27, 2002


Title

STAIR 11 SHEAR WALL ELEVATIONS

Sheet No.


A547

FOR OFFICIAL USE ONLY

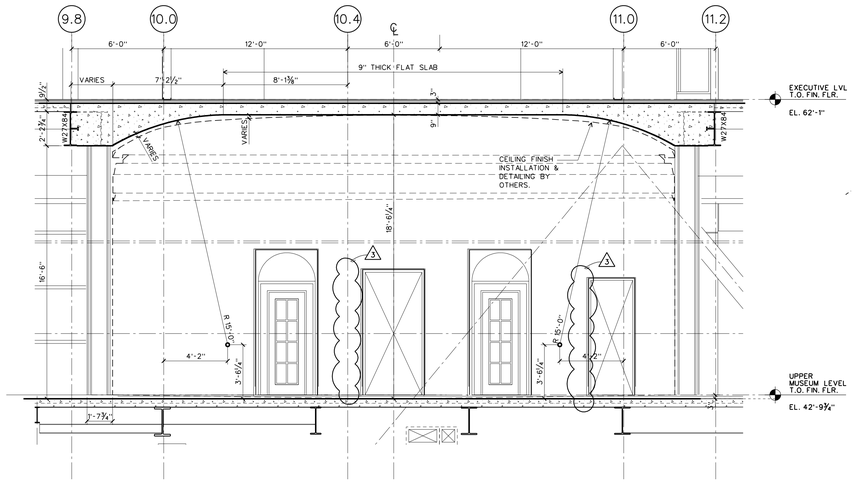


NORTH-SECTION AT OVAL OFFICE

SCALE: ¼" = 1'-0" OVAL.DGN 21

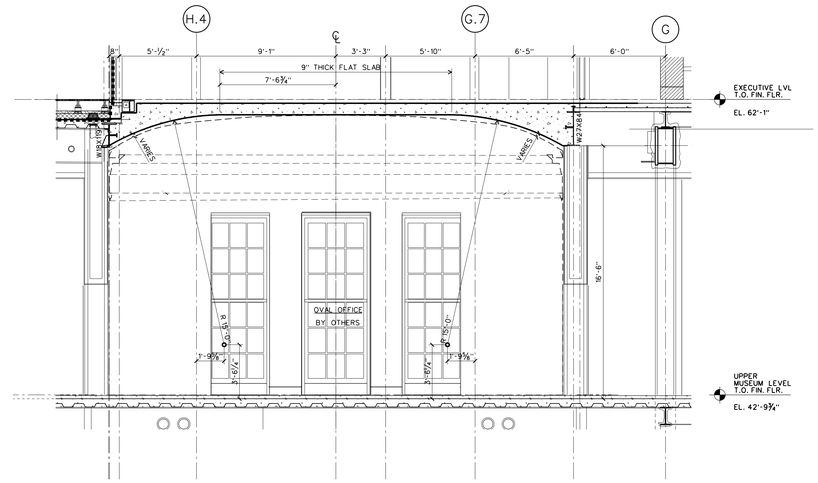


EAST-WEST SECTION AT OVAL OFFICE

SCALE: ¼" = 1'-0" OVAL.DGN 20

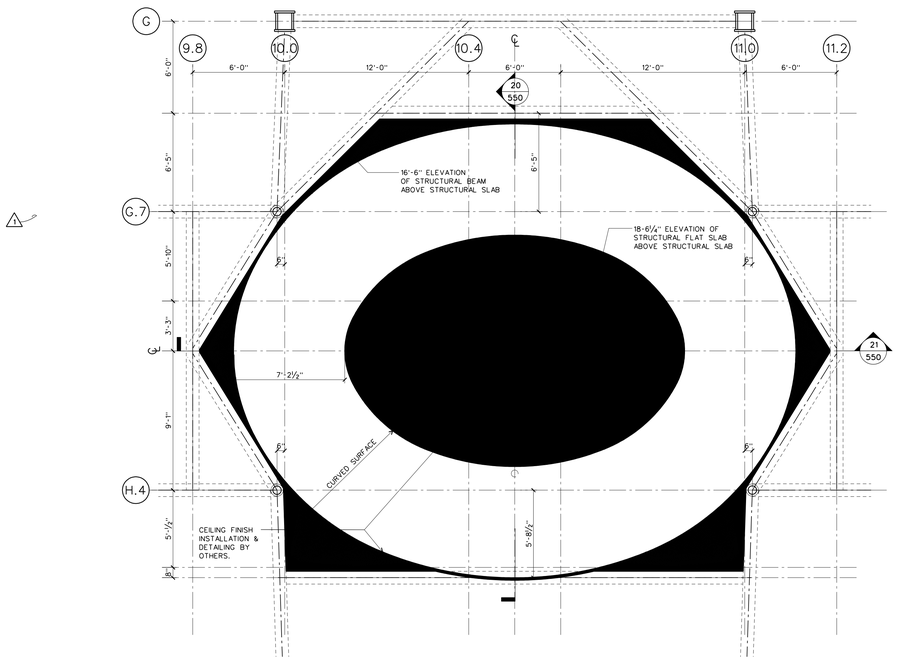

REFLECTED CEILING PLAN AT OVAL OFFICE

SCALE: ¼" = 1'-0" OVAL.DGN 11

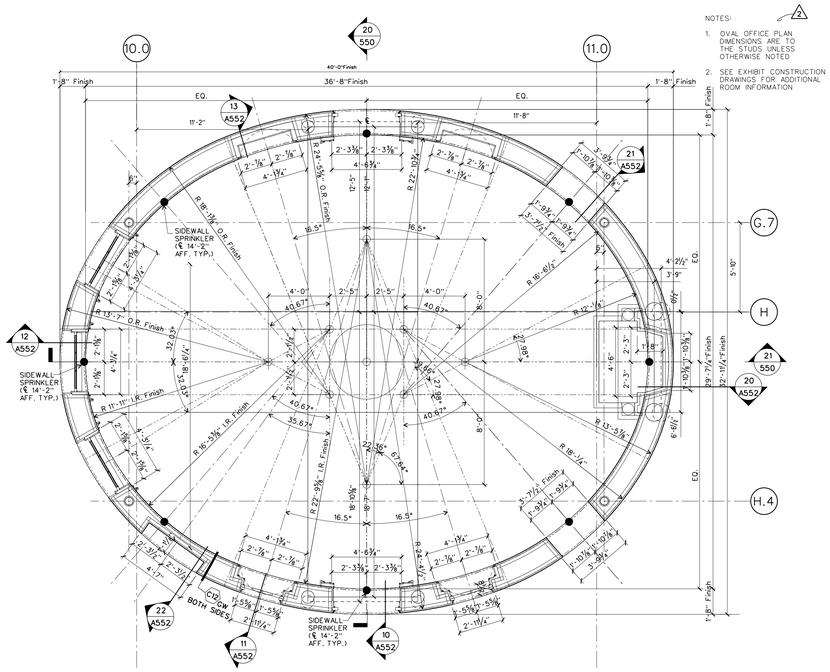

PLAN AT OFFICE

SCALE: ¼" = 1'-0" OVAL.DGN 10

WILLIAM J. CLINTON PRESIDENTIAL CENTER

LITTLE ROCK, ARKANSAS

Architect

POLSHEK PARTNERSHIP LLP
320 West 13th Street
New York, New York 10014
212.807.7171

Coordinating Architects

POLK STANLEY YEARY ARCHITECTS Ltd
700 South Schiller Street
Little Rock, Arkansas 72201
501.378.0878

WITSELL EVANS RASCO
901 West Third Street
Little Rock, Arkansas 72201
501.374.5300

WOODS CARADINE ARCHITECTS
2200 South Main Street
Little Rock, Arkansas 72206
501.374.4060

Landscape Architects

HARGREAVES ASSOCIATES
118 Magazine Street
Cambridge, Massachusettes 02139
617.661.0070

LANDSCAPE ARCHITECTURE, Inc.
2300 Cottondale Lane Suite 202
Little Rock, Arkansas 72202
501.374.5610

Structural Engineer

LESLIE E. ROBERTSON ASSOC., RLLP
30 Broad Street, 47th Floor
New York, New York 10004
212.750.9000

MEP Engineers

FLACK + KURTZ Inc.
475 Fifth Avenue
New York, New York 10017
212.532.9600

CROMWELL ARCHITECTS ENGINEERS
101 South Spring Street
Little Rock, Arkansas 72201
501.372.2900

Curtainwall Consultant

R. A. HEINTGES ARCHITECTS
126 Fifth Avenue, 9th Floor
New York, New York 10011
212.652-2966

Seal

Issue	Date
3 ASI # 19	05/07/03
2 ASI # 13	02/14/03
1 ASI # 10	01/27/03
100% Construction Documents	09/27/02
90% Progress Printing	08/30/02
100% Struct./ CD Progress	07/01/02

Job No. 9908

Scale 1/4" = 1'-0"

Date September 27, 2002

Title


GEOMETRY DRAWING OF OVAL OFFICE STRUCTURAL DOME

Sheet No. A550

FOR OFFICIAL USE ONLY


White House Oval Office
Long Axis: 35'-10"
Short Axis: 29'-0"
Height: 18'-6"

Line of Rise:• 16'-7"
•the point at which the ceiling starts to arch

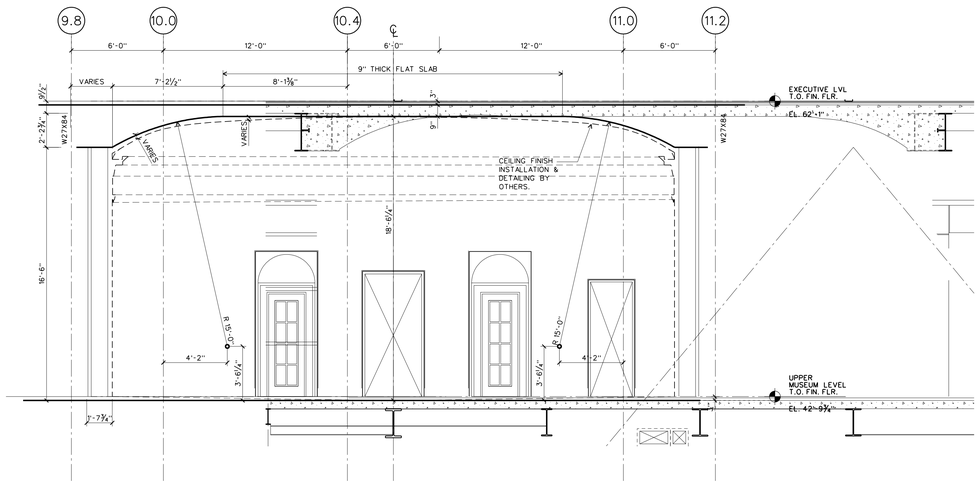


NORTH-SECTION AT OVAL OFFICE

SCALE: ¼" = 1'-0" OVAL.DGN 21

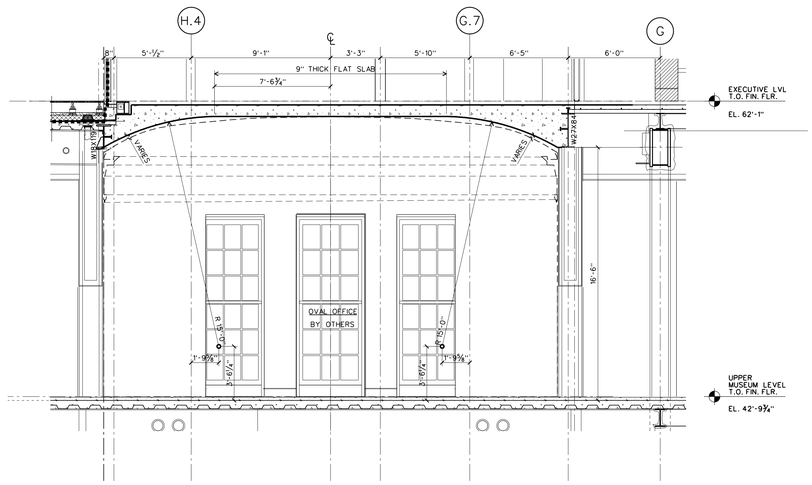


EAST-WEST SECTION AT OVAL OFFICE

SCALE: ¼" = 1'-0" OVAL.DGN 20

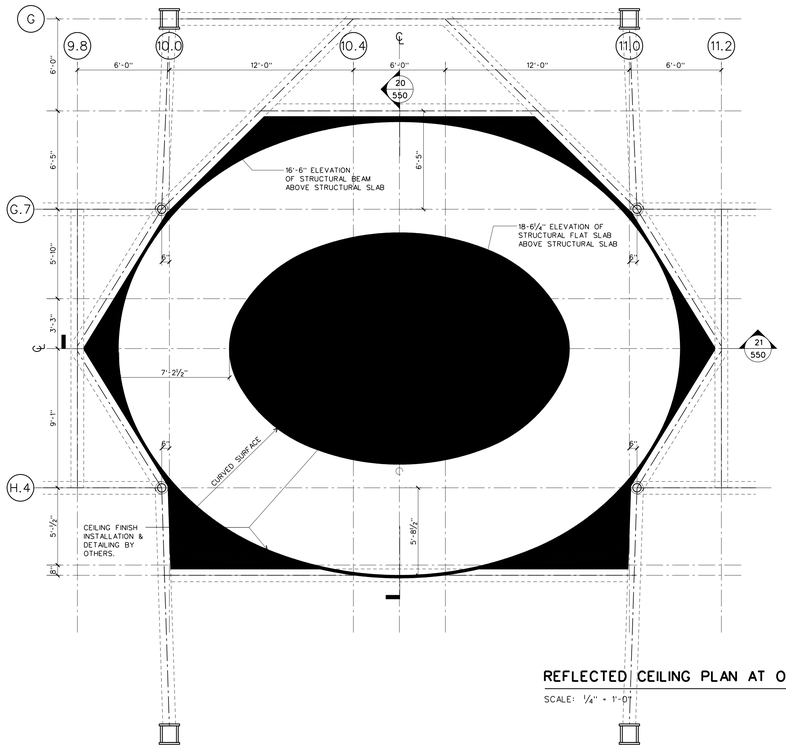

REFLECTED CEILING PLAN AT OVAL OFFICE

SCALE: ¼" = 1'-0" OVAL.DGN 11

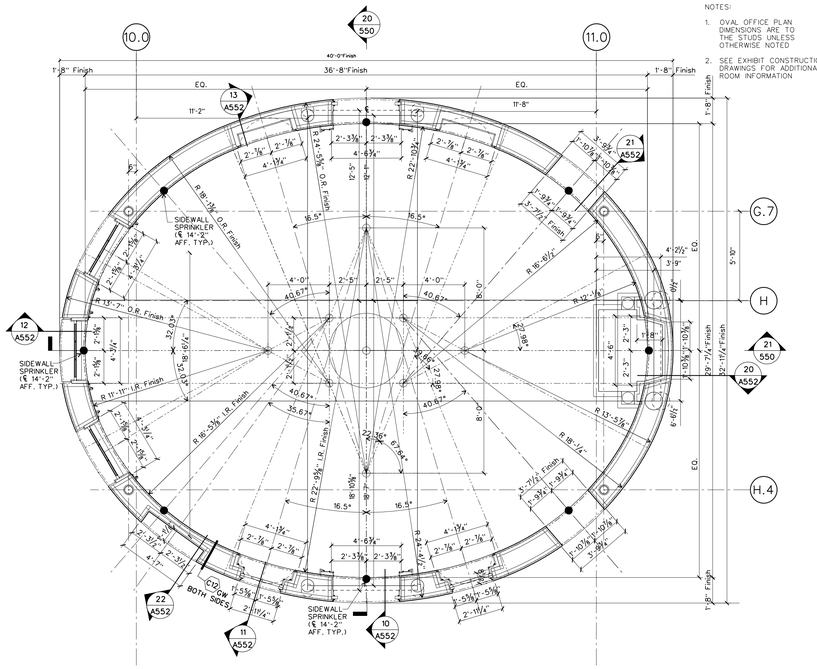

PLAN AT OFFICE

SCALE: ¼" = 1'-0" OVAL.DGN 10

WILLIAM J. CLINTON PRESIDENTIAL CENTER

LITTLE ROCK, ARKANSAS

Architect

POLSHEK PARTNERSHIP LLP
320 West 13th Street
New York, New York 10014
212.807.7171

Coordinating Architects

POLK STANLEY YEARY ARCHITECTS Ltd
700 South Schiller Street
Little Rock, Arkansas 72201
501.378.0878

WITSELL EVANS RASCO
901 West Third Street
Little Rock, Arkansas 72201
501.374.5300

WOODS CARADINE ARCHITECTS
2200 South Main Street
Little Rock, Arkansas 72206
501.374.4060

Landscape Architects

HARGREAVES ASSOCIATES
118 Magazine Street
Cambridge, Massachusettes 02139
617.661.0070

LANDSCAPE ARCHITECTURE, Inc.
2300 Cottondale Lane Suite 202
Little Rock, Arkansas 72202
501.374.5610

Structural Engineer

LESLIE E. ROBERTSON ASSOC., RLLP
30 Broad Street, 47th Floor
New York, New York 10004
212.750.9000

MEP Engineers

FLACK + KURTZ Inc.
475 Fifth Avenue
New York, New York 10017
212.532.9600

CROMWELL ARCHITECTS ENGINEERS
101 South Spring Street
Little Rock, Arkansas 72201
501.372.2900

Curtainwall Consultant

R. A. HEINTGES ARCHITECTS
126 Fifth Avenue, 9th Floor
New York, New York 10011
212.652-2966

Seal

Issue	Date
100% Construction Documents	09/27/02
90% Progress Printing	08/30/02
100% Struct./ CD Progress	07/01/02

Job No. 9908

Scale 1/4" = 1'-0"

Date September 27, 2002


Title

GEOMETRY DRAWING OF OVAL OFFICE STRUCTURAL DOME

Sheet No.


A550

FOR OFFICIAL USE ONLY

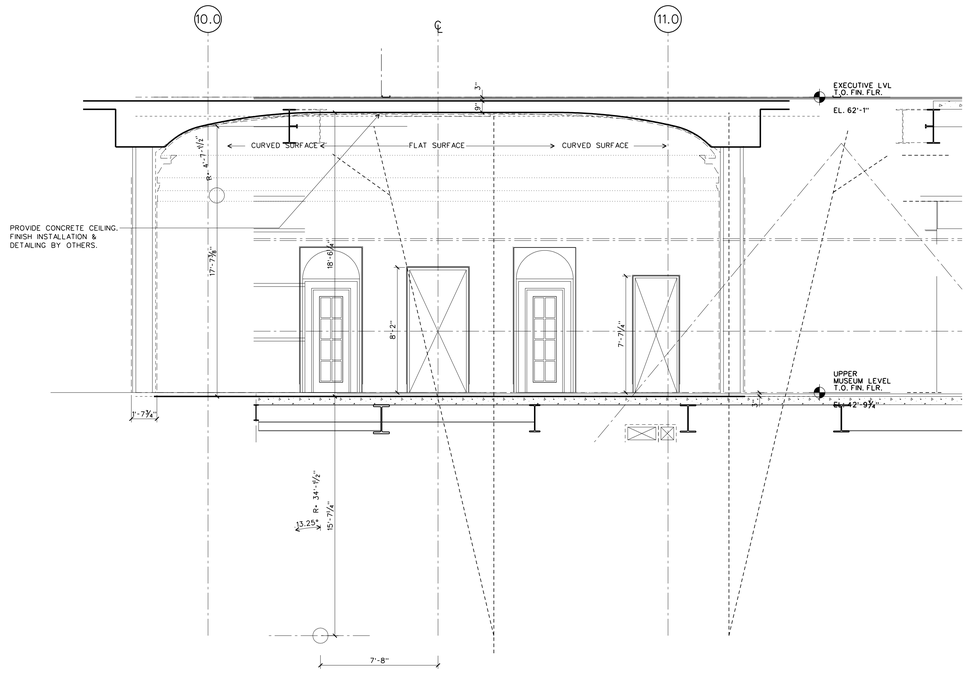


NORTH-SECTION AT OVAL OFFICE

SCALE: 1/4" = 1'-0" OVAL.DGN 21

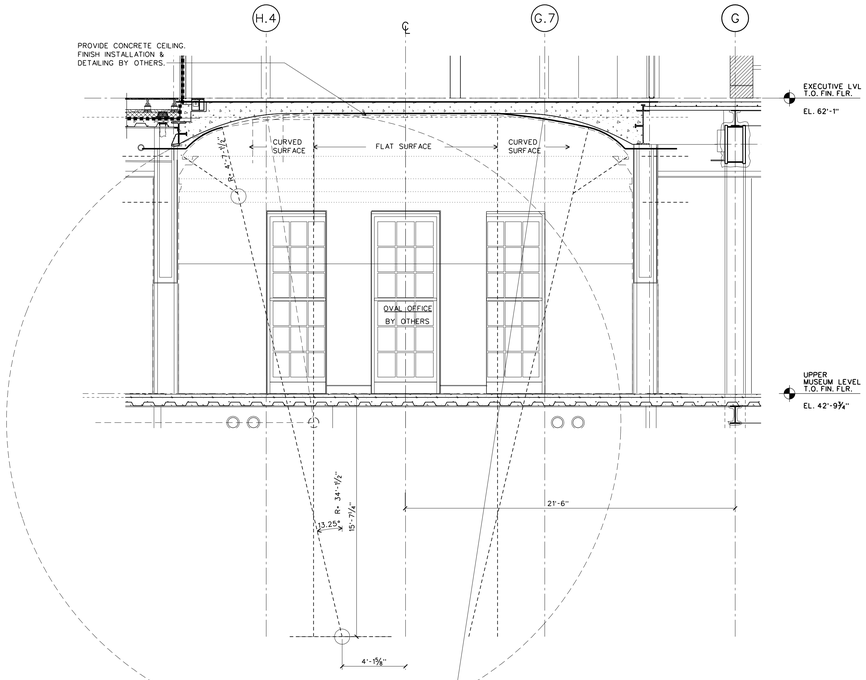


EAST-WEST SECTION AT OVAL OFFICE

SCALE: 1/4" = 1'-0" OVAL.DGN 20

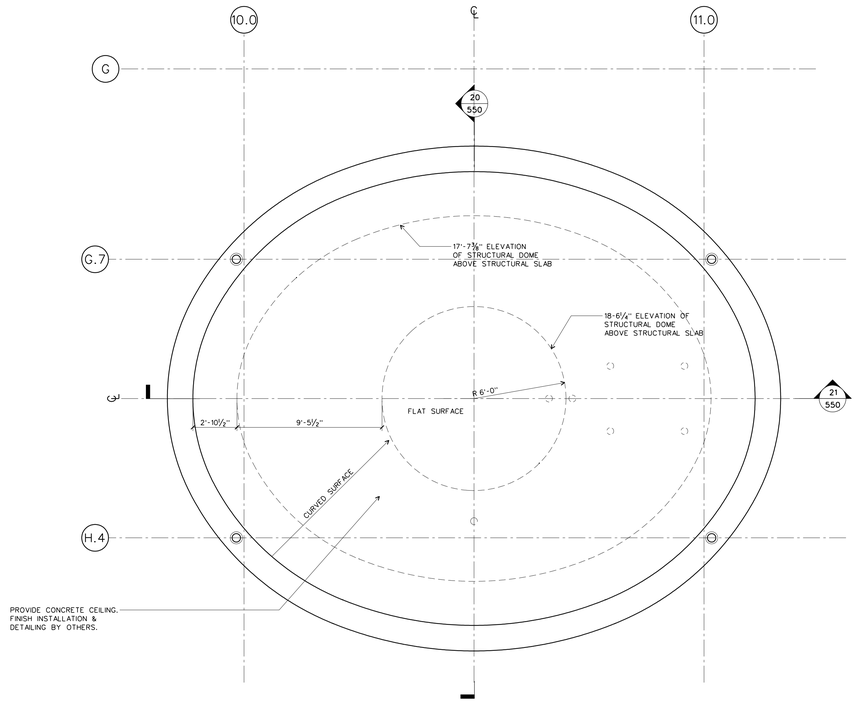

REFLECTED CEILING PLAN AT OVAL OFFICE

SCALE: 1/4" = 1'-0" OVAL.DGN 11

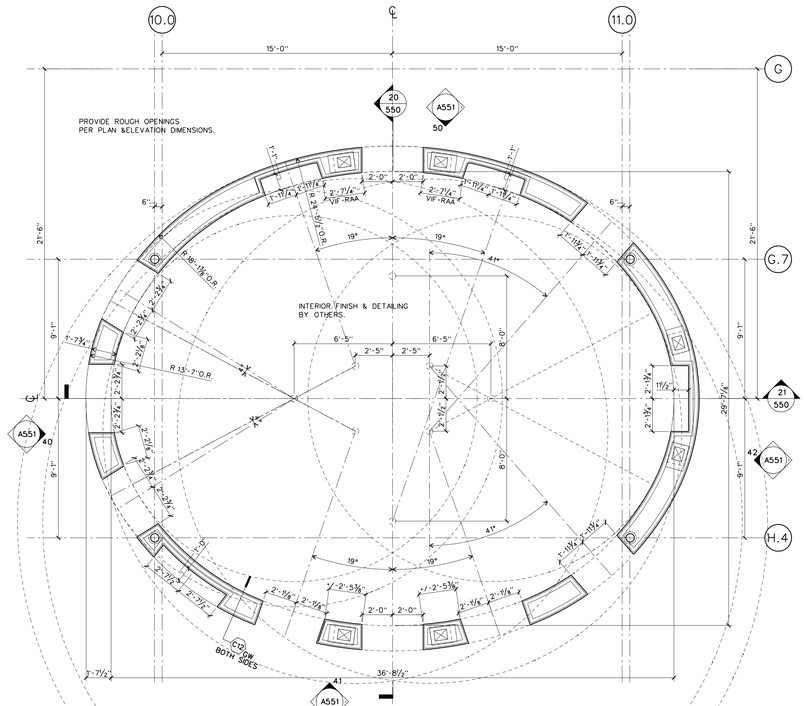

PLAN AT OFFICE

SCALE: 1/4" = 1'-0" OVAL.DGN 10

WILLIAM J. CLINTON PRESIDENTIAL CENTER

LITTLE ROCK, ARKANSAS

Architect

POLSHEK PARTNERSHIP LLP
320 West 13th Street
New York, New York 10014
212.807.7171

Coordinating Architects

POLK STANLEY YEARY ARCHITECTS Ltd
700 South Schiller Street
Little Rock, Arkansas 72201
501.378.0878

WITSELL EVANS RASCO
901 West Third Street
Little Rock, Arkansas 72201
501.374.5300

WOODS CARADINE ARCHITECTS
2200 South Main Street
Little Rock, Arkansas 72206
501.374.4060

Landscape Architects

HARGREAVES ASSOCIATES
118 Magazine Street
Cambridge, Massachusettes 02139
617.661.0070

LANDSCAPE ARCHITECTURE, Inc.
2300 Cottondale Lane Suite 202
Little Rock, Arkansas 72202
501.374.5610

Structural Engineer

LESLIE E. ROBERTSON ASSOC., RLLP
30 Broad Street, 47th Floor
New York, New York 10004
212.750.9000

MEP Engineers

FLACK + KURTZ Inc.
475 Fifth Avenue
New York, New York 10017
212.532.9600


CROMWELL ARCHITECTS ENGINEERS
101 South Spring Street
Little Rock, Arkansas 72201
501.372.2900

Curtainwall Consultant

R. A. HEINTGES ARCHITECTS
126 Fifth Avenue, 9th Floor
New York, New York 10011
212.652-2966

Seal

Issue	Date
100% Construction Documents	09/27/02
90% Progress Printing	08/30/02
100% Struct./ CD Progress	07/01/02

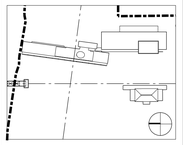

Job No. 9908

Scale 1/4" = 1'-0"

Date September 27, 2002


Title

GEOMETRY DRAWING OF OVAL OFFICE STRUCTURAL DOME

Sheet No.


A550

FOR OFFICIAL USE ONLY

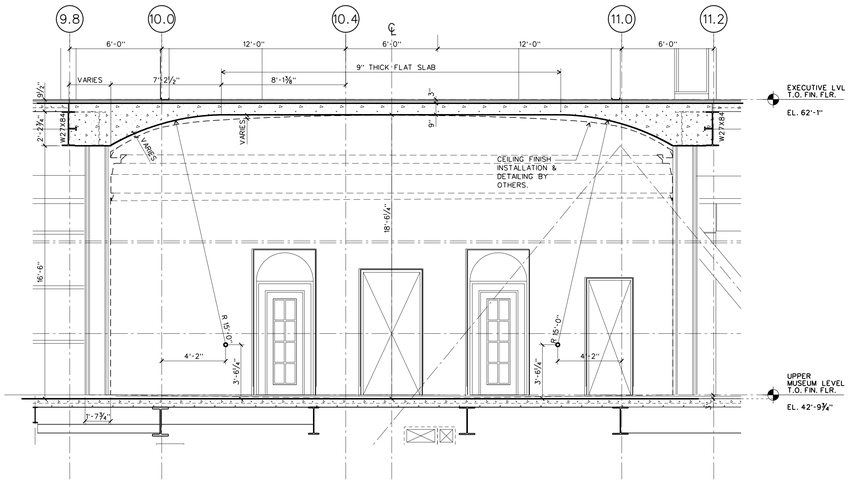


NORTH-SECTION AT OVAL OFFICE

SCALE: ¼" = 1'-0" OVAL.DGN 21

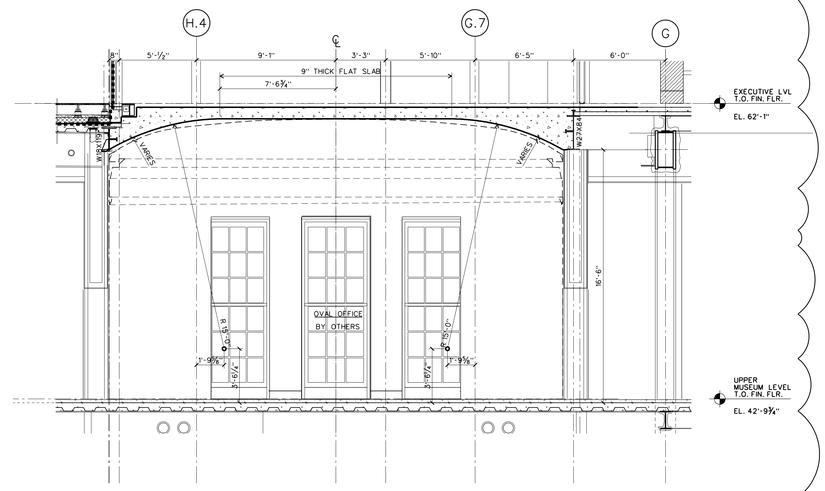


EAST-WEST SECTION AT OVAL OFFICE

SCALE: ¼" = 1'-0" OVAL.DGN 20

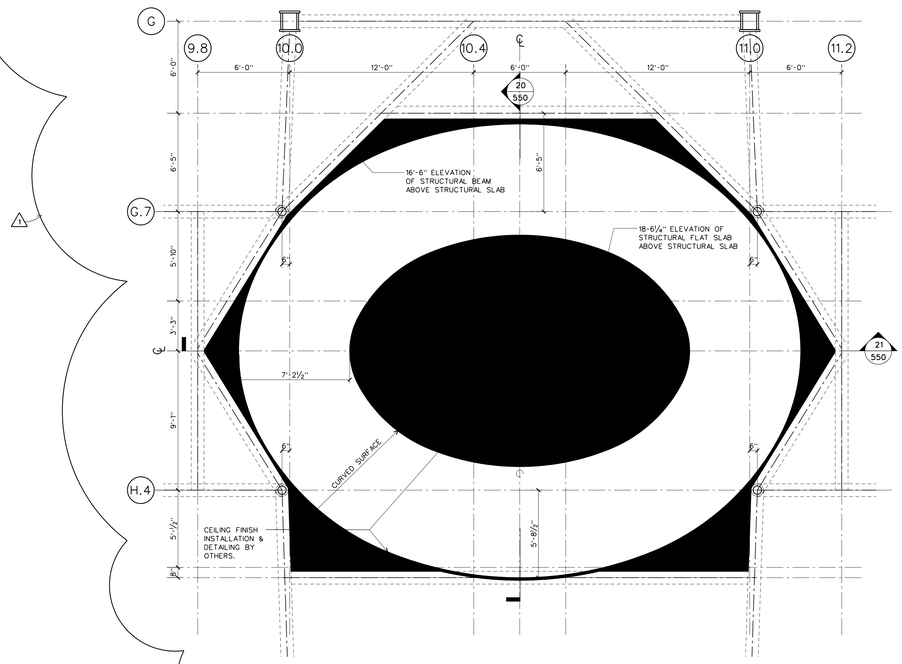

REFLECTED CEILING PLAN AT OVAL OFFICE

SCALE: ¼" = 1'-0" OVAL.DGN 11

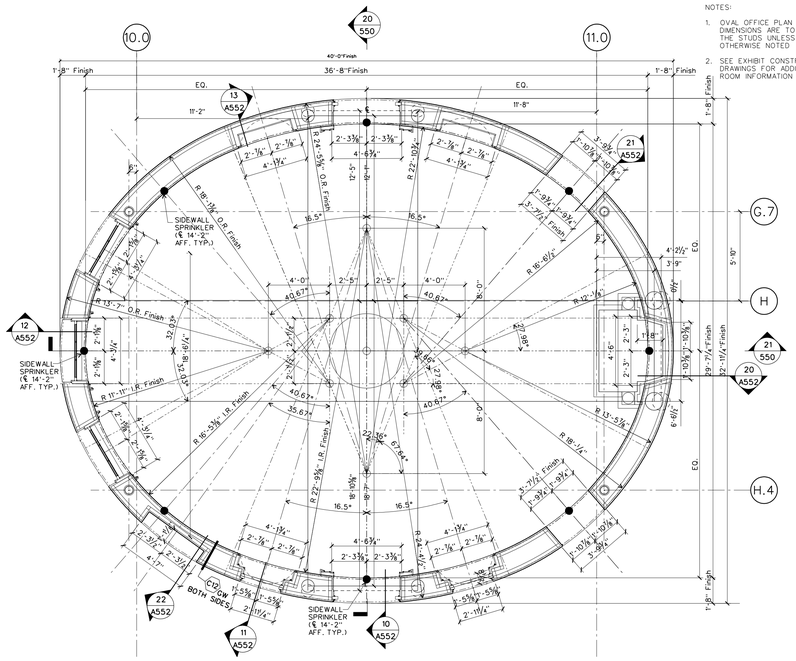

PLAN AT OFFICE

SCALE: ¼" = 1'-0" OVAL.DGN 10

WILLIAM J. CLINTON PRESIDENTIAL CENTER

LITTLE ROCK, ARKANSAS

Architect

POLSHEK PARTNERSHIP LLP
320 West 13th Street
New York, New York 10014
212.807.7171

Coordinating Architects

POLK STANLEY YEARY ARCHITECTS Ltd
700 South Schiller Street
Little Rock, Arkansas 72201
501.378.0878

WITSELL EVANS RASCO
901 West Third Street
Little Rock, Arkansas 72201
501.374.5300

WOODS CARADINE ARCHITECTS
2200 South Main Street
Little Rock, Arkansas 72206
501.374.4060

Landscape Architects

HARGREAVES ASSOCIATES
118 Magazine Street
Cambridge, Massachusettes 02139
617.661.0070

LANDSCAPE ARCHITECTURE, Inc.
2300 Cottondale Lane Suite 202
Little Rock, Arkansas 72202
501.374.5610

Structural Engineer

LESLIE E. ROBERTSON ASSOC., RLLP
30 Broad Street, 47th Floor
New York, New York 10004
212.750.9000

MEP Engineers

FLACK + KURTZ Inc.
475 Fifth Avenue
New York, New York 10017
212.532.9600

CROMWELL ARCHITECTS ENGINEERS
101 South Spring Street
Little Rock, Arkansas 72201
501.372.2900

Curtainwall Consultant

R. A. HEINTGES ARCHITECTS
126 Fifth Avenue, 9th Floor
New York, New York 10011
212.652-2966

Seal

Issue	Date
1 ASI # 10	01/27/03
100% Construction Documents	09/27/02
90% Progress Printing	08/30/02
100% Struct./ CD Progress	07/01/02

Job No. 9908

Scale 1/4" = 1'-0"

Date September 27, 2002


Title

GEOMETRY DRAWING OF OVAL OFFICE STRUCTURAL DOME

Sheet No.


A550

FOR OFFICIAL USE ONLY

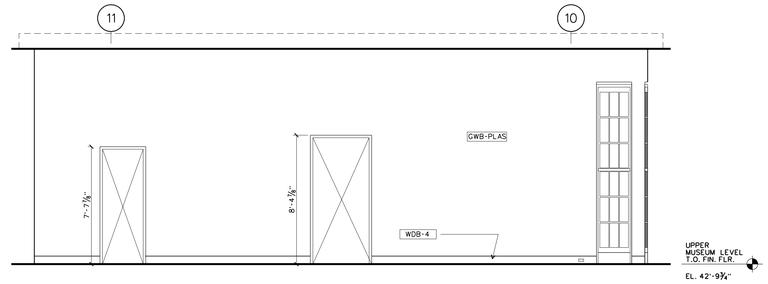


4-02 SKY LOBBY: PARTIAL WEST ELEVATION 50

SCALE: ¼" = 1'-0" 9908/base/elev/b-inel15

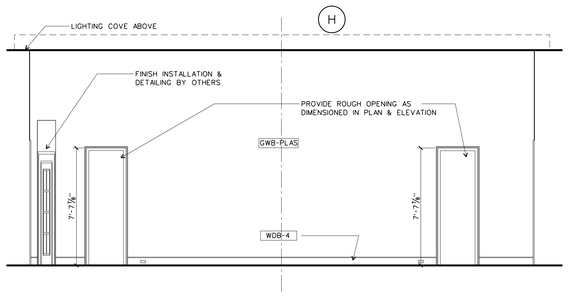


4-02 SKY LOBBY: PARTIAL NORTH ELEVATION 42

SCALE: ¼" = 1'-0" 9908/base/elev/b-inel15

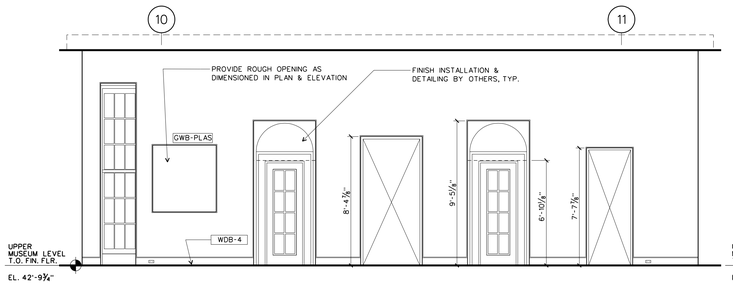


4-02 SKY LOBBY: PARTIAL WEST ELEVATION 41

SCALE: ¼" = 1'-0" 9908/base/elev/b-inel15

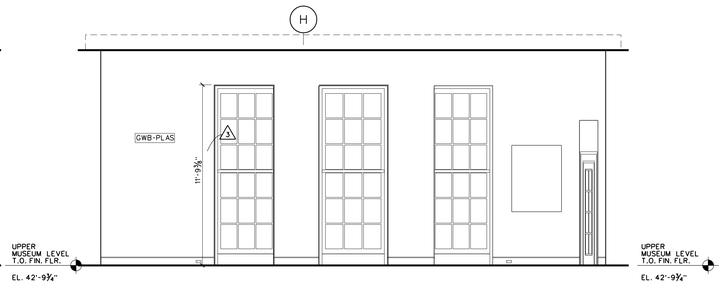


4-02 SKY LOBBY: PARTIAL SOUTH ELEVATION 40

SCALE: ¼" = 1'-0" 9908/base/elev/b-inel15

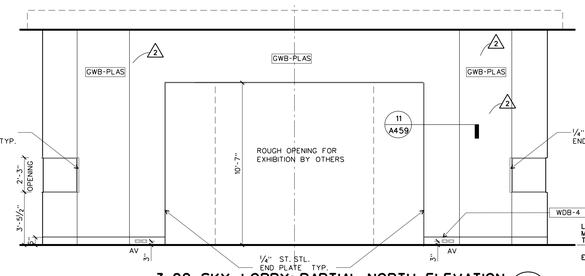


3-02 SKY LOBBY: PARTIAL NORTH ELEVATION 32

SCALE: ¼" = 1'-0" 9908/base/elev/b-inel15

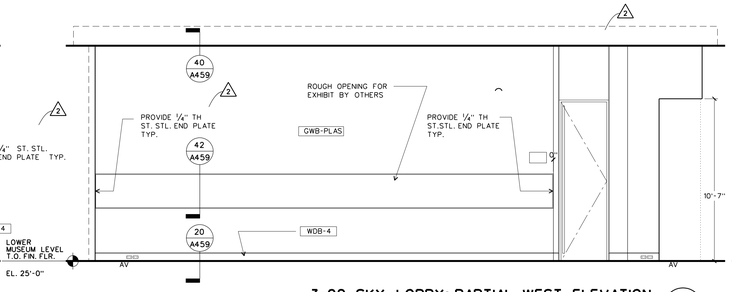


3-02 SKY LOBBY: PARTIAL WEST ELEVATION 31

SCALE: ¼" = 1'-0" 9908/base/elev/b-inel15

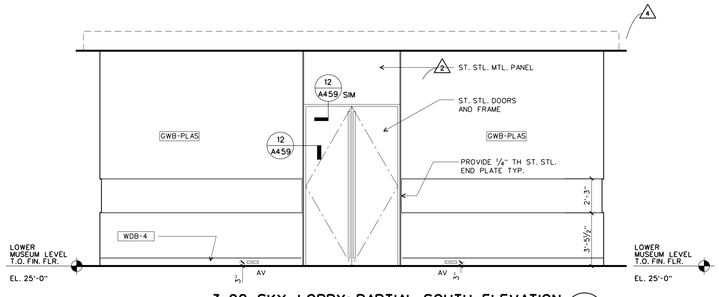


3-02 SKY LOBBY: PARTIAL SOUTH ELEVATION 30

SCALE: ¼" = 1'-0" 9908/base/elev/b-inel15

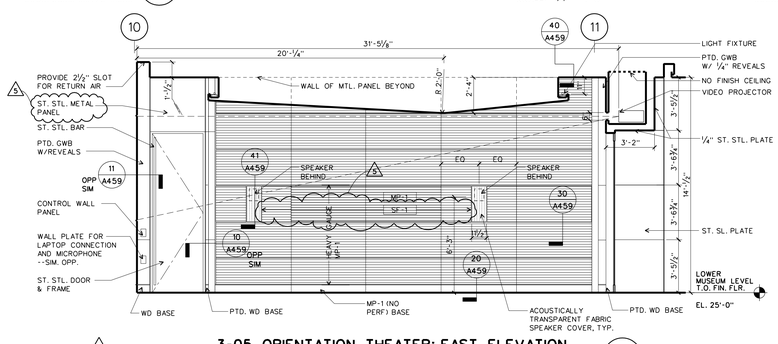


3-05 ORIENTATION THEATER: EAST ELEVATION 21

SCALE: ¼" = 1'-0" 9908/base/elev/b-inel14

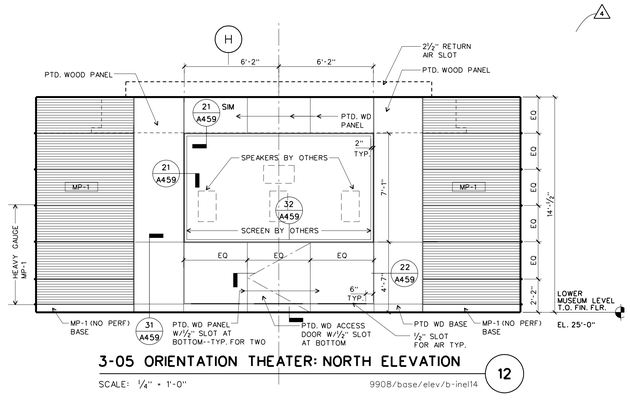


3-05 ORIENTATION THEATER: NORTH ELEVATION 12

SCALE: ¼" = 1'-0" 9908/base/elev/b-inel14

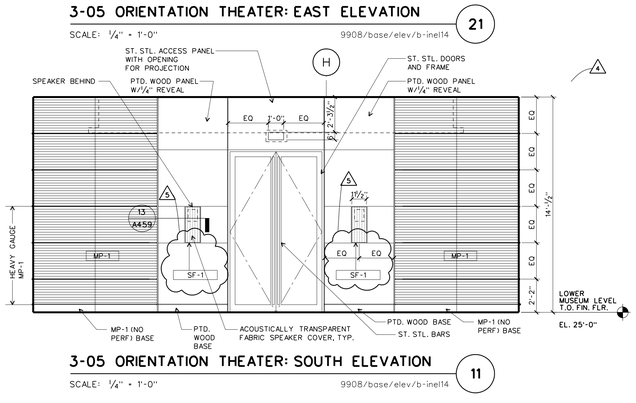

3-05 ORIENTATION THEATER: SOUTH ELEVATION 11

SCALE: ¼" = 1'-0" 9908/base/elev/b-inel14

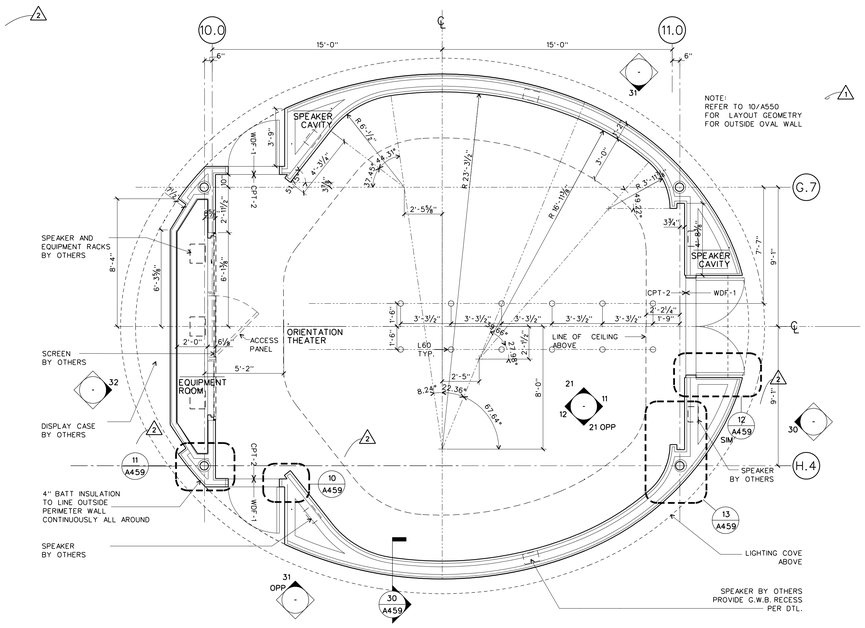

3-05 ORIENTATION THEATER: ENLARGED PLAN 10

SCALE: ¼" = 1'-0" 9908/base/plans/orientation

WILLIAM J. CLINTON PRESIDENTIAL CENTER

LITTLE ROCK, ARKANSAS

Architect

POLSHEK PARTNERSHIP LLP
320 West 13th Street
New York, New York 10014
212.807.7171

Coordinating Architects

POLK STANLEY YEARY ARCHITECTS Ltd
700 South Schiller Street
Little Rock, Arkansas 72201
501.378.0878

WITSELL EVANS RASCO
901 West Third Street
Little Rock, Arkansas 72201
501.374.5300

WOODS CARADINE ARCHITECTS
2200 South Main Street
Little Rock, Arkansas 72206
501.374.4060

Landscape Architects

HARGREAVES ASSOCIATES
118 Magazine Street
Cambridge, Massachusettes 02139
617.661.0070

LANDSCAPE ARCHITECTURE, Inc.
2300 Cottondale Lane Suite 202
Little Rock, Arkansas 72202
501.374.5610

Structural Engineer

LESLIE E. ROBERTSON ASSOC., RLLP
30 Bread Street, 47th Floor
New York, New York 10004
212.750.9000

MEP Engineers

FLACK + KURTZ Inc.
475 Fifth Avenue
New York, New York 10017
212.532.9600

CROMWELL ARCHITECTS ENGINEERS
101 South Spring Street
Little Rock, Arkansas 72201
501.372.2900

Curtainwall Consultant

R. A. HEINTGES ARCHITECTS
126 Fifth Avenue, 9th Floor
New York, New York 10011
212.652-2966

Seal

5	ASI # 23	09/12/03
4	ASI # 20	06/06/03
3	ASI # 19	05/07/03
2	ASI # 18	04/18/03
1	ASI # 15	02/28/03
	100% Construction Documents	09/27/02
	90% Progress Printing	08/30/02
	100% Struct./ CD Progress	07/01/02
	Issue	Date

Job No. 9908

Scale 1/4" = 1'-0"

Date September 27, 2002


Title

ORIENTATIONTHEATER: ENLARGED PLANS AND ELEVATIONS

Sheet No.


A551

FOR OFFICIAL USE ONLY

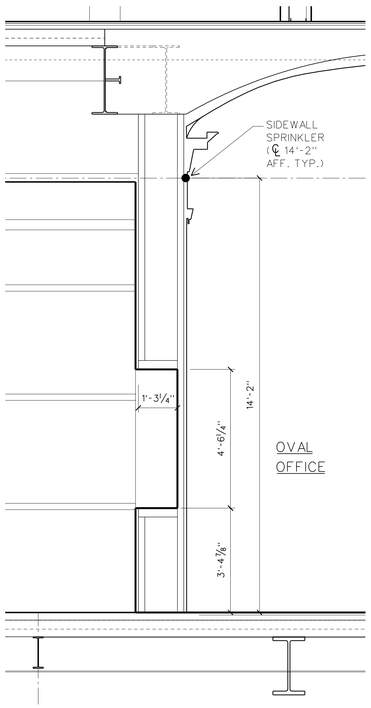


OVAL OFFICE WALL SECTION

SCALE: ½" = 1'-0" OVAL4.DGN 22

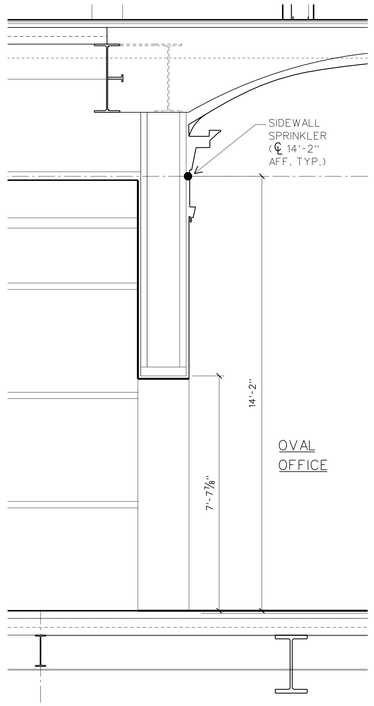


OVAL OFFICE WALL SECTION

SCALE: ½" = 1'-0" OVAL4.DGN 21

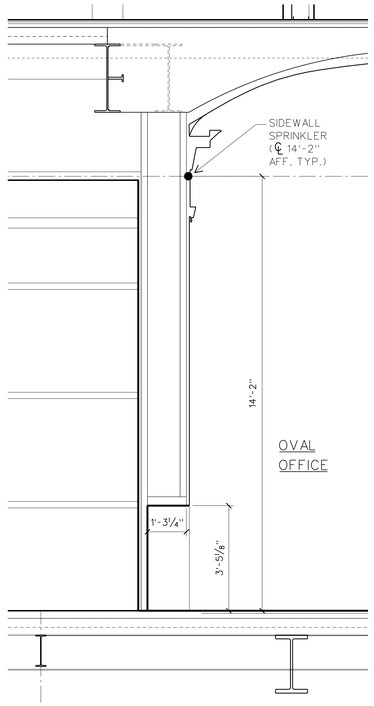


OVAL OFFICE WALL SECTION

SCALE: ½" = 1'-0" OVAL4.DGN 20

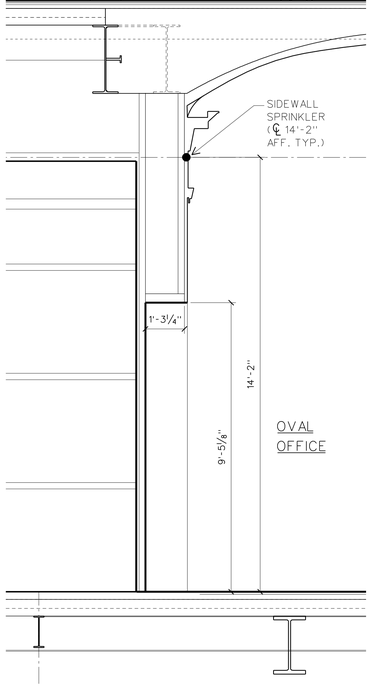


OVAL OFFICE WALL SECTION

SCALE: ½" = 1'-0" OVAL4.DGN 13

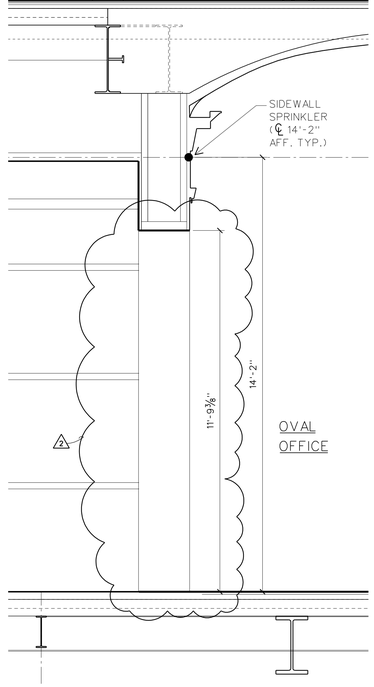


OVAL OFFICE WALL SECTION

SCALE: ½" = 1'-0" OVAL4.DGN 12

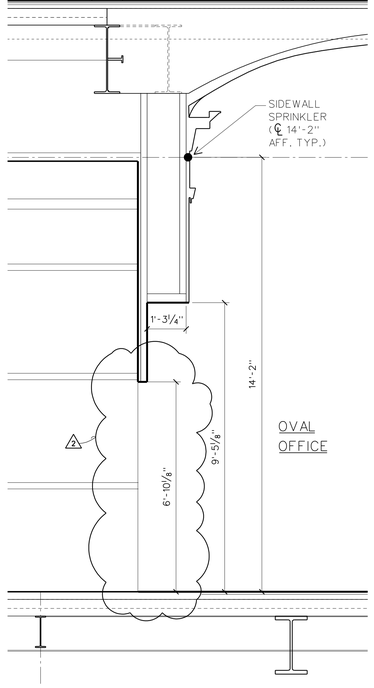

OVAL OFFICE WALL SECTION

SCALE: ½" = 1'-0" OVAL4.DGN 11

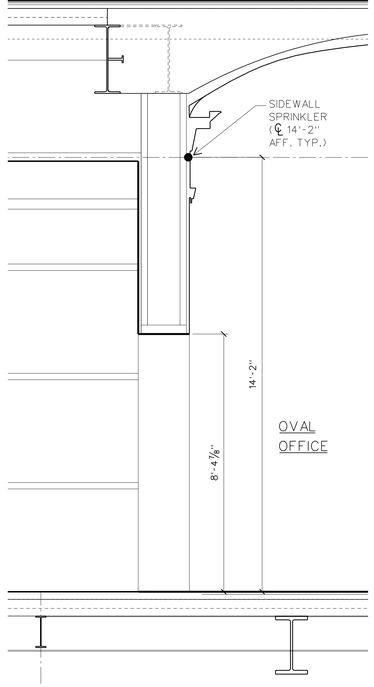

OVAL OFFICE WALL SECTION

SCALE: ½" = 1'-0" OVAL4.DGN 10

NOTES:

1. OVAL OFFICE SECTIONS ARE DIMENSIONED TO THE STUDS UNLESS OTHERWISE NOTED
2. SEE EXHIBIT CONSTRUCTION DRAWINGS FOR ADDITIONAL ROOM INFORMATION

WILLIAM J. CLINTON PRESIDENTIAL CENTER

LITTLE ROCK, ARKANSAS

Architect

POLSHEK PARTNERSHIP LLP
320 West 13th Street
New York, New York 10014
212.807.7171

Coordinating Architects

POLK STANLEY YEARY ARCHITECTS Ltd
700 South Schiller Street
Little Rock, Arkansas 72201
501.378.0878

WITSELL EVANS RASCO
901 West Third Street
Little Rock, Arkansas 72201
501.374.5300

WOODS CARADINE ARCHITECTS
2200 South Main Street
Little Rock, Arkansas 72206
501.374.4060

Landscape Architects

HARGREAVES ASSOCIATES
118 Magazine Street
Cambridge, Massachusettes 02139
617.661.0070

LANDSCAPE ARCHITECTURE, Inc.
2300 Cottondale Lane Suite 202
Little Rock, Arkansas 72202
501.374.5610

Structural Engineer

LESLIE E. ROBERTSON ASSOC., RLLP
30 Broad Street, 47th Floor
New York, New York 10004
212.750.9000

MEP Engineers

FLACK + KURTZ Inc.
475 Fifth Avenue
New York, New York 10017
212.532.9600


CROMWELL ARCHITECTS ENGINEERS
101 South Spring Street
Little Rock, Arkansas 72201
501.372.2900

Curtainwall Consultant

R. A. HEINTGES ARCHITECTS
126 Fifth Avenue, 9th Floor
New York, New York 10011
212.652-2966

Seal

2	ASI # 15	02/28/03
1	ASI # 13	02/14/03
	Issue	Date

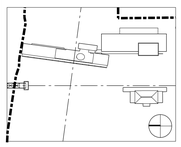

Job No. 9908

Scale 1/4" = 1'-0"

Date September 27, 2002


Title

OVAL OFFICE
WALL SECTIONS


Sheet No. SDA-048

A552


FOR OFFICIAL USE ONLY

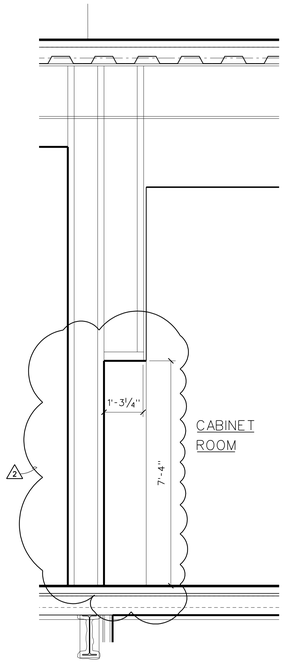


CABINET ROOM SECTION — SCALE: ½" = 1'-0" — CABINET.DGN — 34

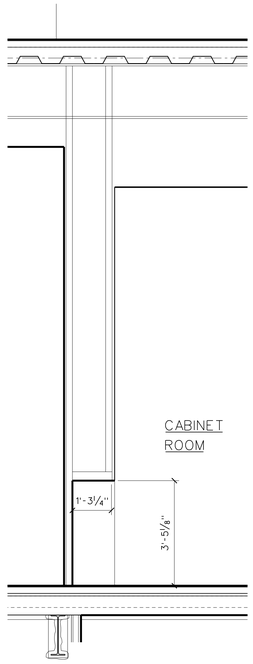


CABINET ROOM SECTION — SCALE: ½" = 1'-0" — CABINET.DGN — 33

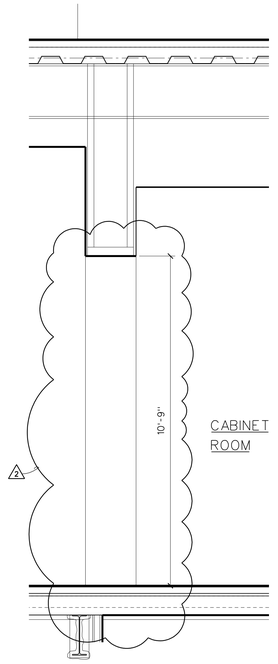


CABINET ROOM SECTION — SCALE: ½" = 1'-0" — CABINET.DGN — 32

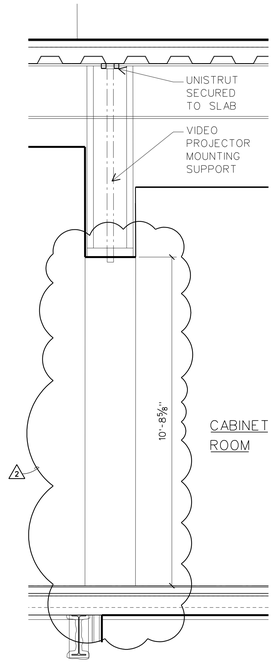


CABINET ROOM SECTION — SCALE: ½" = 1'-0" — CABINET.DGN — 31

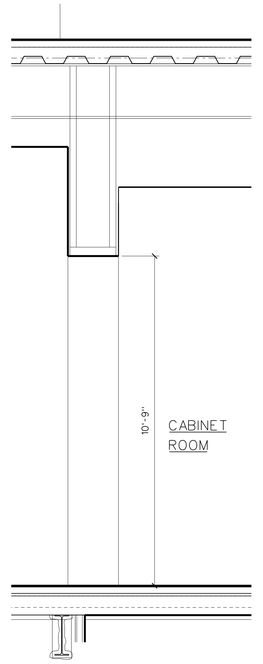


CABINET ROOM SECTION — SCALE: ½" = 1'-0" — CABINET.DGN — 30

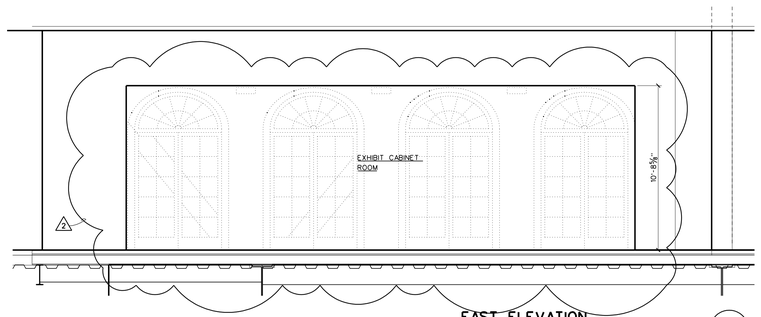


EAST ELEVATION — SCALE: ¼" = 1'-0" — CABINET.DGN — 22

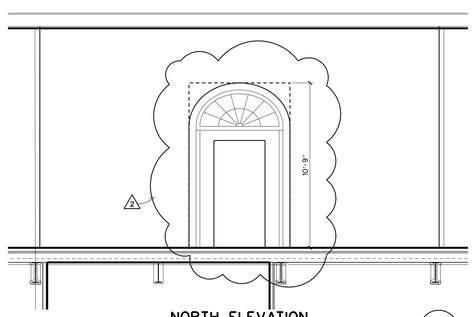

NORTH ELEVATION — SCALE: ¼" = 1'-0" — CABINET.DGN — 21

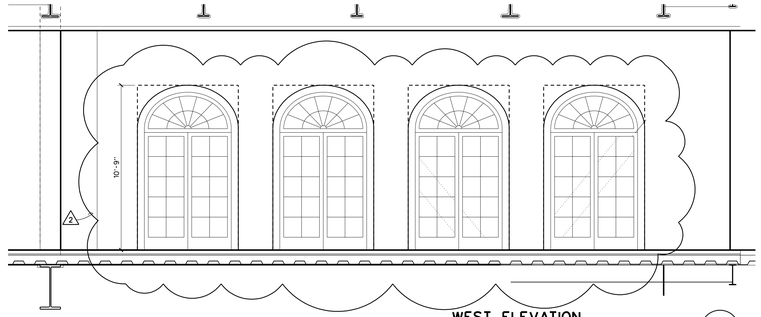


WEST ELEVATION — SCALE: ¼" = 1'-0" — CABINET.DGN — 20

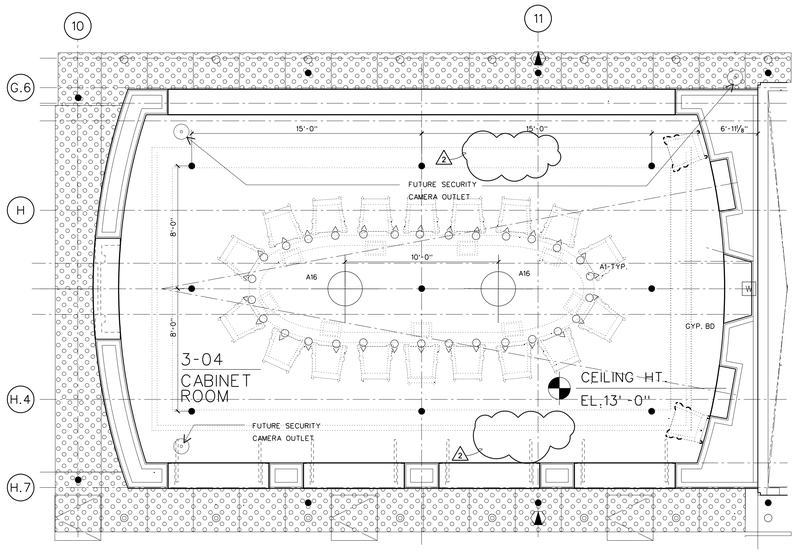

CABINET ROOM CEILING PLAN — SCALE: ¼" = 1'-0" — CABINET.DGN — 11

NOTES:

1. CABINET ROOM SECTIONS ARE DIMENSIONED TO THE STUDS UNLESS OTHERWISE NOTED
2. SEE EXHIBIT CONSTRUCTION DRAWINGS FOR ADDITIONAL ROOM INFORMATION

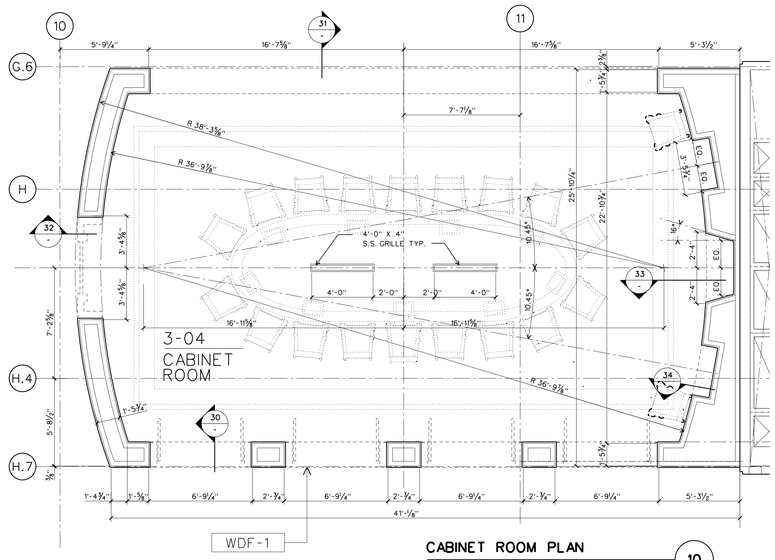

CABINET ROOM PLAN — SCALE: ¼" = 1'-0" — CABINET.DGN — 10

FOR OFFICIAL USE ONLY

WILLIAM J. CLINTON PRESIDENTIAL CENTER

LITTLE ROCK, ARKANSAS

Architect

POLSHEK PARTNERSHIP LLP
320 West 13th Street
New York, New York 10014
212.807.7171

Coordinating Architects

POLK STANLEY YEARY ARCHITECTS Ltd
700 South Schiller Street
Little Rock, Arkansas 72201
501.378.0878

WITSELL EVANS RASCO
901 West Third Street
Little Rock, Arkansas 72201
501.374.5300

WOODS CARADINE ARCHITECTS
2200 South Main Street
Little Rock, Arkansas 72206
501.374.4060

Landscape Architects

HARGREAVES ASSOCIATES
118 Magazine Street
Cambridge, Massachusettes 02139
617.661.0070

LANDSCAPE ARCHITECTURE, Inc.
2300 Cottondale Lane Suite 202
Little Rock, Arkansas 72202
501.374.5610

Structural Engineer

LESLIE E. ROBERTSON ASSOC., RLLP
30 Bread Street, 47th Floor
New York, New York 10004
212.750.9000

MEP Engineers

FLACK + KURTZ Inc.
475 Fifth Avenue
New York, New York 10017
212.532.9600

CROMWELL ARCHITECTS ENGINEERS
101 South Spring Street
Little Rock, Arkansas 72201
501.372.2900

Curtainwall Consultant

R. A. HEINTGES ARCHITECTS
126 Fifth Avenue, 9th Floor
New York, New York 10011
212.652-2966

Seal

Issue	Date
1 ASI # 13	02/14/03

Job No. 9908

Scale 1/4" = 1'-0"

Date September 27, 2002

Title
CABINET ROOM PLANS, ELEVATIONS & SECTIONS

Sheet No. SDA-049
1 A553



BASEMENT LEVEL REFLECTED CEILING PLAN B

SCALE: 1/8" - 1'-0"

RCP-00B.DGN

10

FOR OFFICIAL USE ONLY

WILLIAM J. CLINTON PRESIDENTIAL CENTER

LITTLE ROCK, ARKANSAS

Architect

POLSHEK PARTNERSHIP LLP
320 West 13th Street
New York, New York 10014
212.807.7171

Coordinating Architects

POLK STANLEY YEARY ARCHITECTS Ltd
700 South Schiller Street
Little Rock, Arkansas 72201
501.378.0878

WITSELL EVANS RASCO
901 West Third Street
Little Rock, Arkansas 72201
501.374.5300

WOODS CARADINE ARCHITECTS
2200 South Main Street
Little Rock, Arkansas 72206
501.374.4060

Landscape Architects

HARGREAVES ASSOCIATES
118 Magazine Street
Cambridge, Massachusettes 02139
617.661.0070

LANDSCAPE ARCHITECTURE, Inc.
2300 Cottondale Lane Suite 202
Little Rock, Arkansas 72202
501.374.5610

Structural Engineer

LESLIE E. ROBERTSON ASSOC., RLLP
30 Broad Street, 47th Floor
New York, New York 10004
212.750.9000

MEP Engineers

FLACK + KURTZ Inc.
475 Fifth Avenue
New York, New York 10017
212.532.9600

CROMWELL ARCHITECTS ENGINEERS
101 South Spring Street
Little Rock, Arkansas 72201
501.372.2900

Curtainwall Consultant

R. A. HEINTGES ARCHITECTS
126 Fifth Avenue, 9th Floor
New York, New York 10011
212.652-2966

Seal

8	ASI #29	03/05/04
7	ASI #25	12/19/03
6	ASI #24	10/24/03
5	ASI #23	09/12/03
4	ASI #20	08/06/03
3	ASI #19	05/07/02
2	ASI #18	04/18/02
1	Addendum #2	11/15/02
	100% Construction Documents	09/27/02
	90% Progress Printing	08/30/02
	100% Struct./ CD Progress	07/01/02
	Bridge Bldg. Substructure	06/14/02
	100% Steel & Concrete CD	05/15/02
	& Architectural CD Progress	
	100% Design Development	03/01/02
	Issue	Date


Job No.
9908

Scale
1/8" = 1'-0"

Date
September 27, 2002

Title
BASEMENT LEVEL PARTIAL REFLECTED CEILING PLAN

Sheet No.
A600b

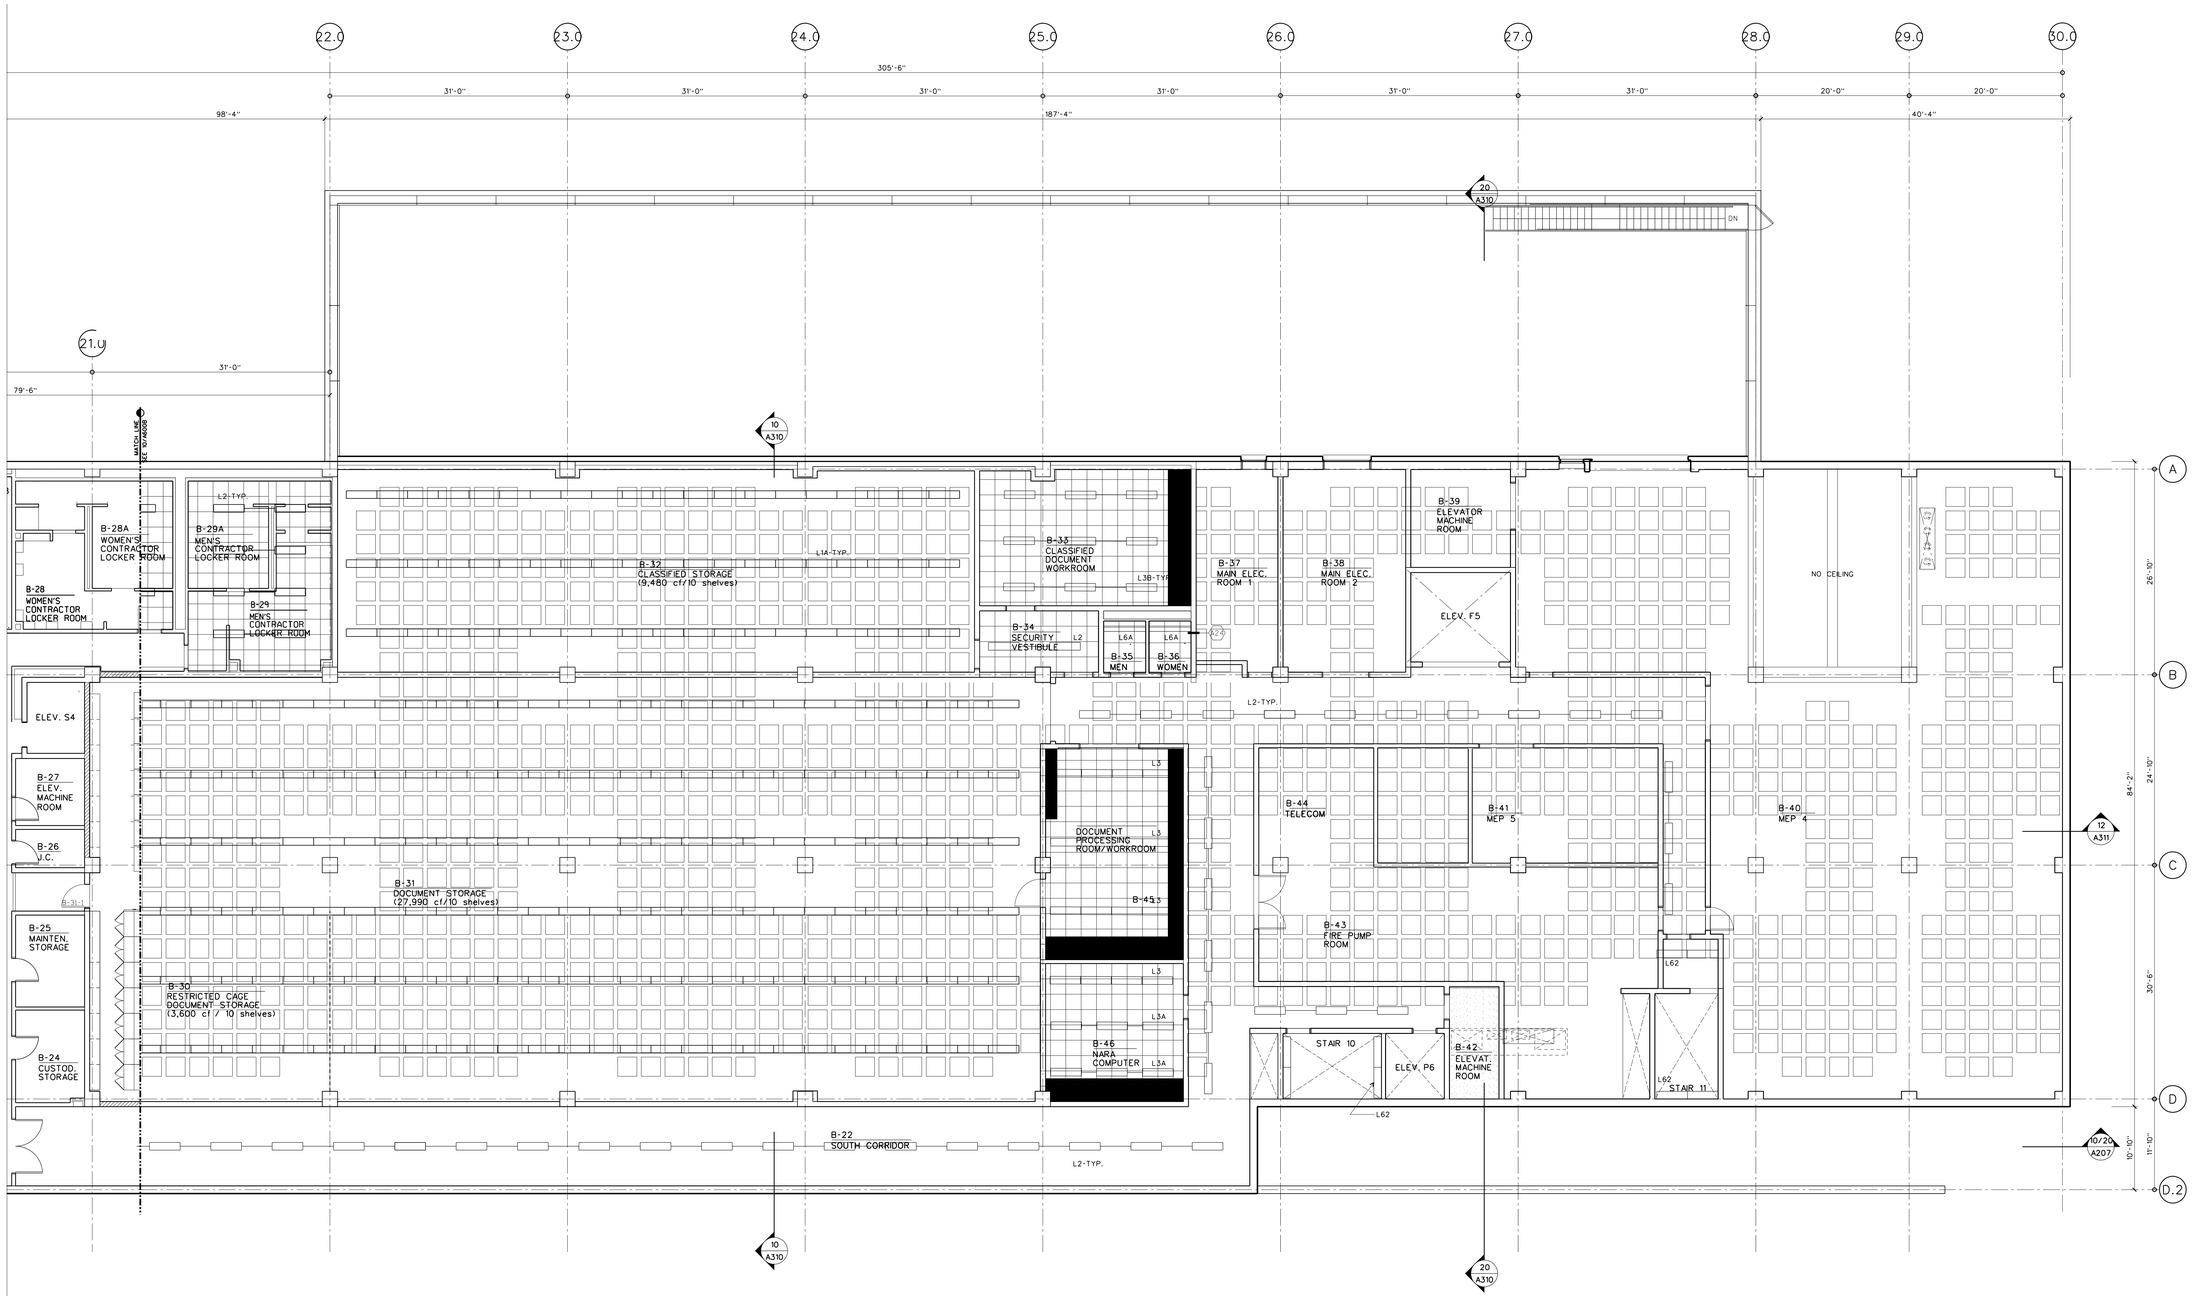

BASEMENT LEVEL REFLECTED CEILING PLAN C

SCALE: 1/8" = 1'-0"

RFP-00B.DGN

10

FOR OFFICIAL USE ONLY

WILLIAM J. CLINTON PRESIDENTIAL CENTER

LITTLE ROCK, ARKANSAS

Architect

POLSHEK PARTNERSHIP LLP
320 West 13th Street
New York, New York 10014
212.807.7171

Coordinating Architects

POLK STANLEY YEARY ARCHITECTS Ltd
700 South Schiller Street
Little Rock, Arkansas 72201
501.378.0878

WITSELL EVANS RASCO
901 West Third Street
Little Rock, Arkansas 72201
501.374.5300

WOODS CARADINE ARCHITECTS
2200 South Main Street
Little Rock, Arkansas 72206
501.374.4060

Landscape Architects

HARGREAVES ASSOCIATES
118 Magazine Street
Cambridge, Massachusettes 02139
617.661.0070

LANDSCAPE ARCHITECTURE, Inc.
2300 Cottondale Lane Suite 202
Little Rock, Arkansas 72202
501.374.5610

Structural Engineer

LESLIE E. ROBERTSON ASSOC., RLLP
30 Broad Street, 47th Floor
New York, New York 10004
212.750.9000

MEP Engineers

FLACK + KURTZ Inc.
475 Fifth Avenue
New York, New York 10017
212.532.9600


CROMWELL ARCHITECTS ENGINEERS
101 South Spring Street
Little Rock, Arkansas 72201
501.372.2900

Curtainwall Consultant

R. A. HEINTGES ARCHITECTS
126 Fifth Avenue, 9th Floor
New York, New York 10011
212.652-2966

Seal

Issue	Date
100% Construction Documents	09/27/02
90% Progress Printing	08/30/02
ASI #05	08/20/02
100% Struct./ CD Progress	07/01/02
Bridge Bldg. Substructure	06/14/02
100% Steel & Concrete CD & Architectural CD Progress	05/15/02
100% Design Development	03/01/02

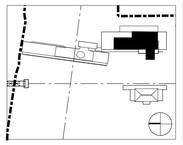


Job No.
9908

Scale
1/8" = 1'-0"

Date
September 27, 2002


Title
BASEMENT LEVEL PARTIAL REFLECTED CEILING PLAN

Sheet No.
A600c

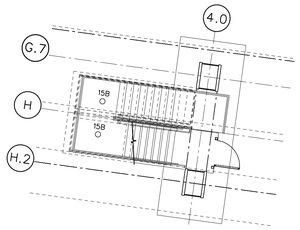

REFLECTED CEILING PLAN AT STAIR 2 LANDING (20)

SCALE: 1/8" = 1'-0" RCP-00B.DGN

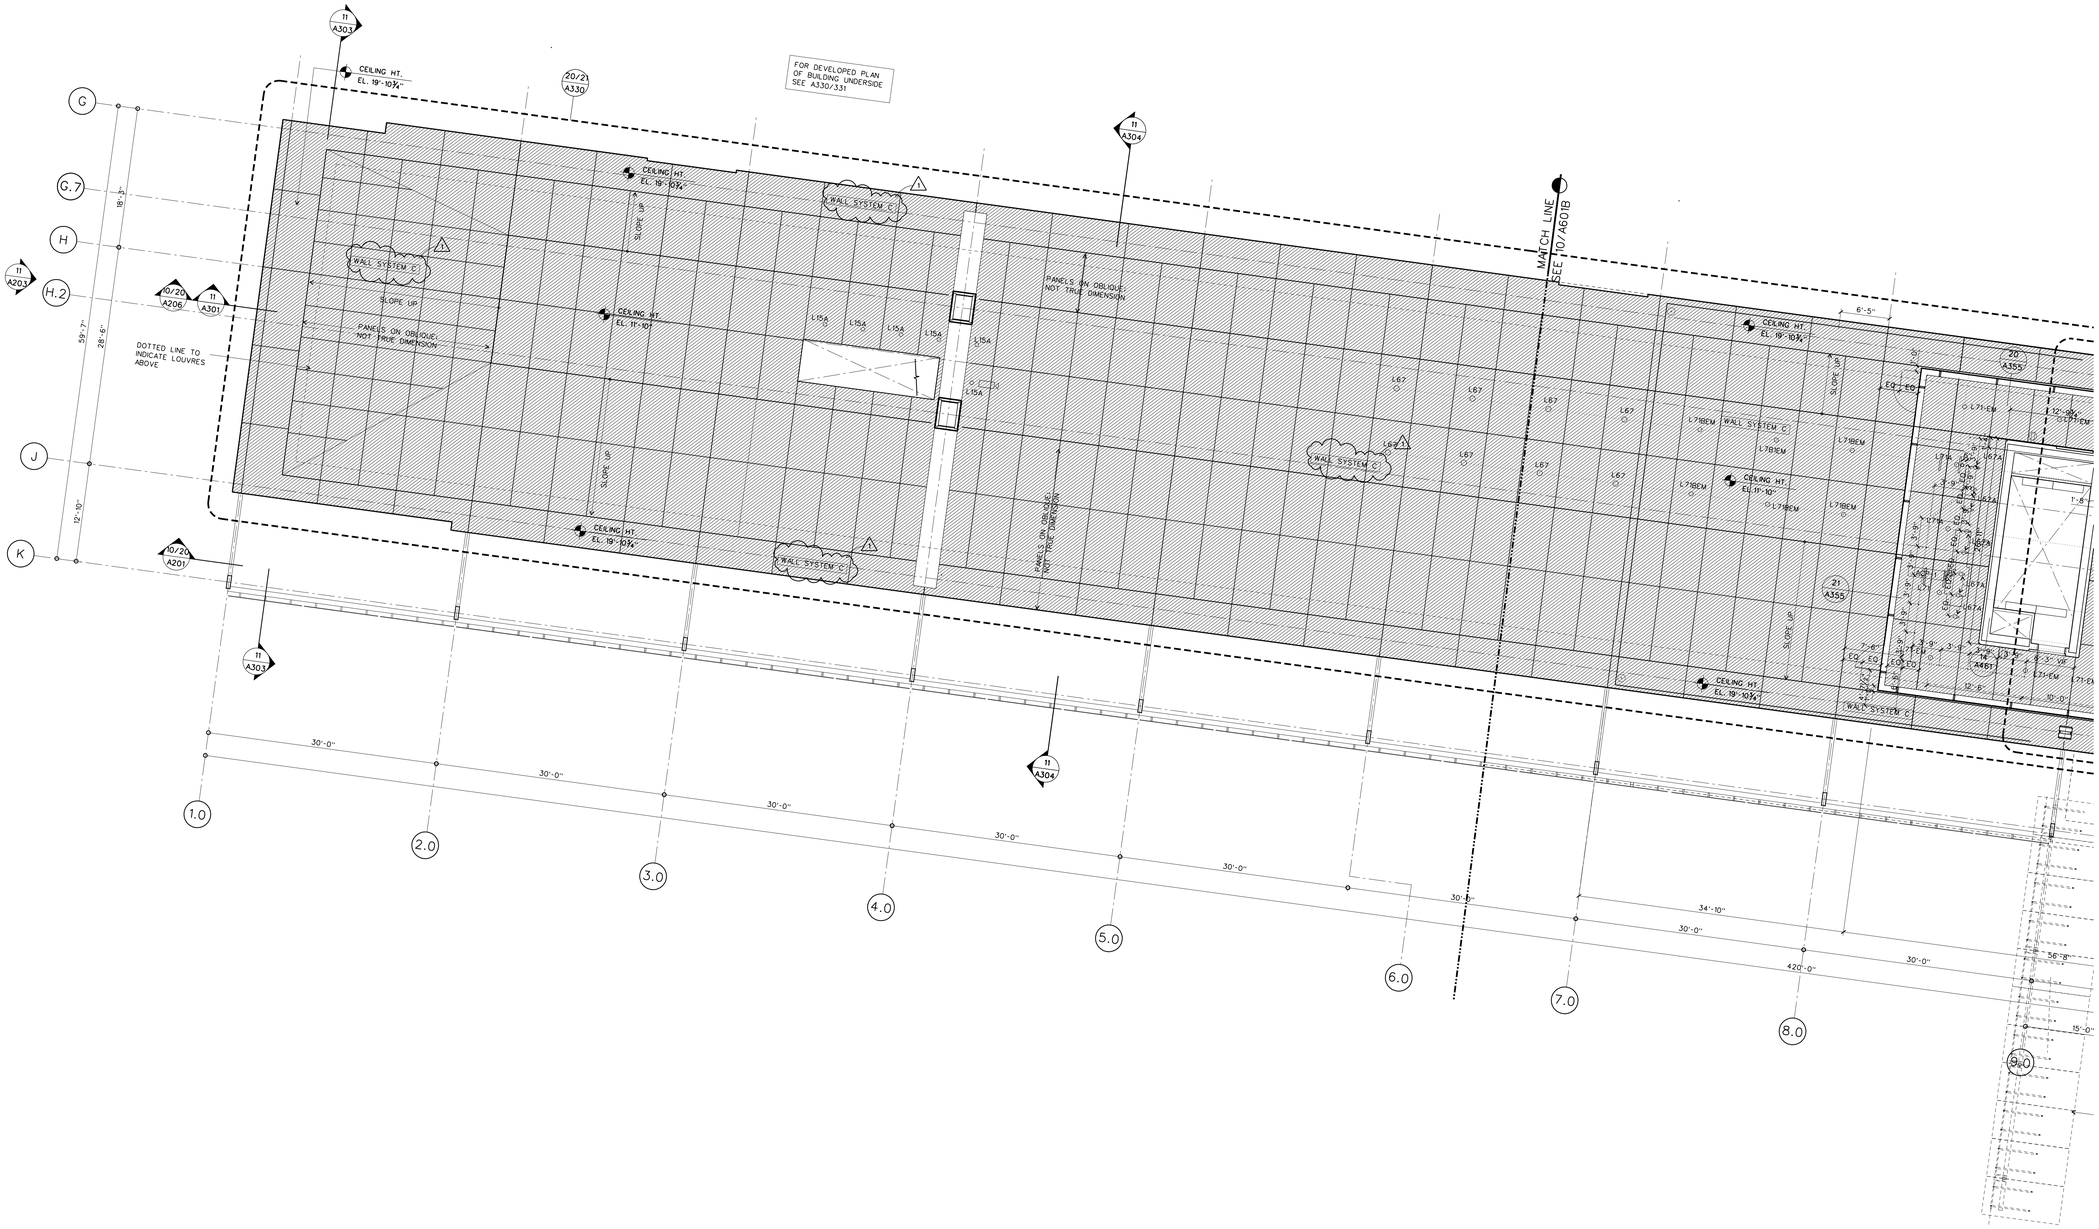

GROUND LEVEL REFLECTED CEILING PLAN A

SCALE: 1/8" = 1'-0" RCP-01.DGN (10)

WILLIAM J. CLINTON PRESIDENTIAL CENTER

LITTLE ROCK, ARKANSAS

Architect

POLSHEK PARTNERSHIP LLP
320 West 13th Street
New York, New York 10014
212.807.7171

Coordinating Architects

POLK STANLEY YEARY ARCHITECTS Ltd
700 South Schiller Street
Little Rock, Arkansas 72201
501.378.0878

WITSELL EVANS RASCO
901 West Third Street
Little Rock, Arkansas 72201
501.374.5300

WOODS CARADINE ARCHITECTS
2200 South Main Street
Little Rock, Arkansas 72206
501.374.4060

Landscape Architects

HARGREAVES ASSOCIATES
118 Magazine Street
Cambridge, Massachusettes 02139
617.661.0070

LANDSCAPE ARCHITECTURE, Inc.
2300 Cottondale Lane Suite 202
Little Rock, Arkansas 72202
501.374.5610

Structural Engineer

LESLIE E. ROBERTSON ASSOC., RLLP
30 Bread Street, 47th Floor
New York, New York 10004
212.750.9000

MEP Engineers

FLACK + KURTZ Inc.
475 Fifth Avenue
New York, New York 10017
212.532.9600


CROMWELL ARCHITECTS ENGINEERS
101 South Spring Street
Little Rock, Arkansas 72201
501.372.2900

Curtainwall Consultant

R. A. HEINTGES ARCHITECTS
126 Fifth Avenue, 9th Floor
New York, New York 10011
212.652-2966

Seal

1	ASI #18	04/18/03
	100% Construction Documents	09/27/02
	90% Progress Printing	08/30/02
	100% Struct./ CD Progress	07/01/02
	Bridge Bldg. Substructure	06/14/02
	100% Steel & Concrete CD	05/15/02
	& Architectural CD Progress	
	100% Design Development	03/01/02
	Issue	Date

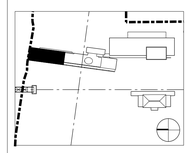

Job No.
9908


Scale
1/8" = 1'-0"

Date
September 27, 2002

Title
GROUND LEVEL PARTIAL REFLECTED CEILING PLAN

Sheet No.
A601a

FOR OFFICIAL USE ONLY

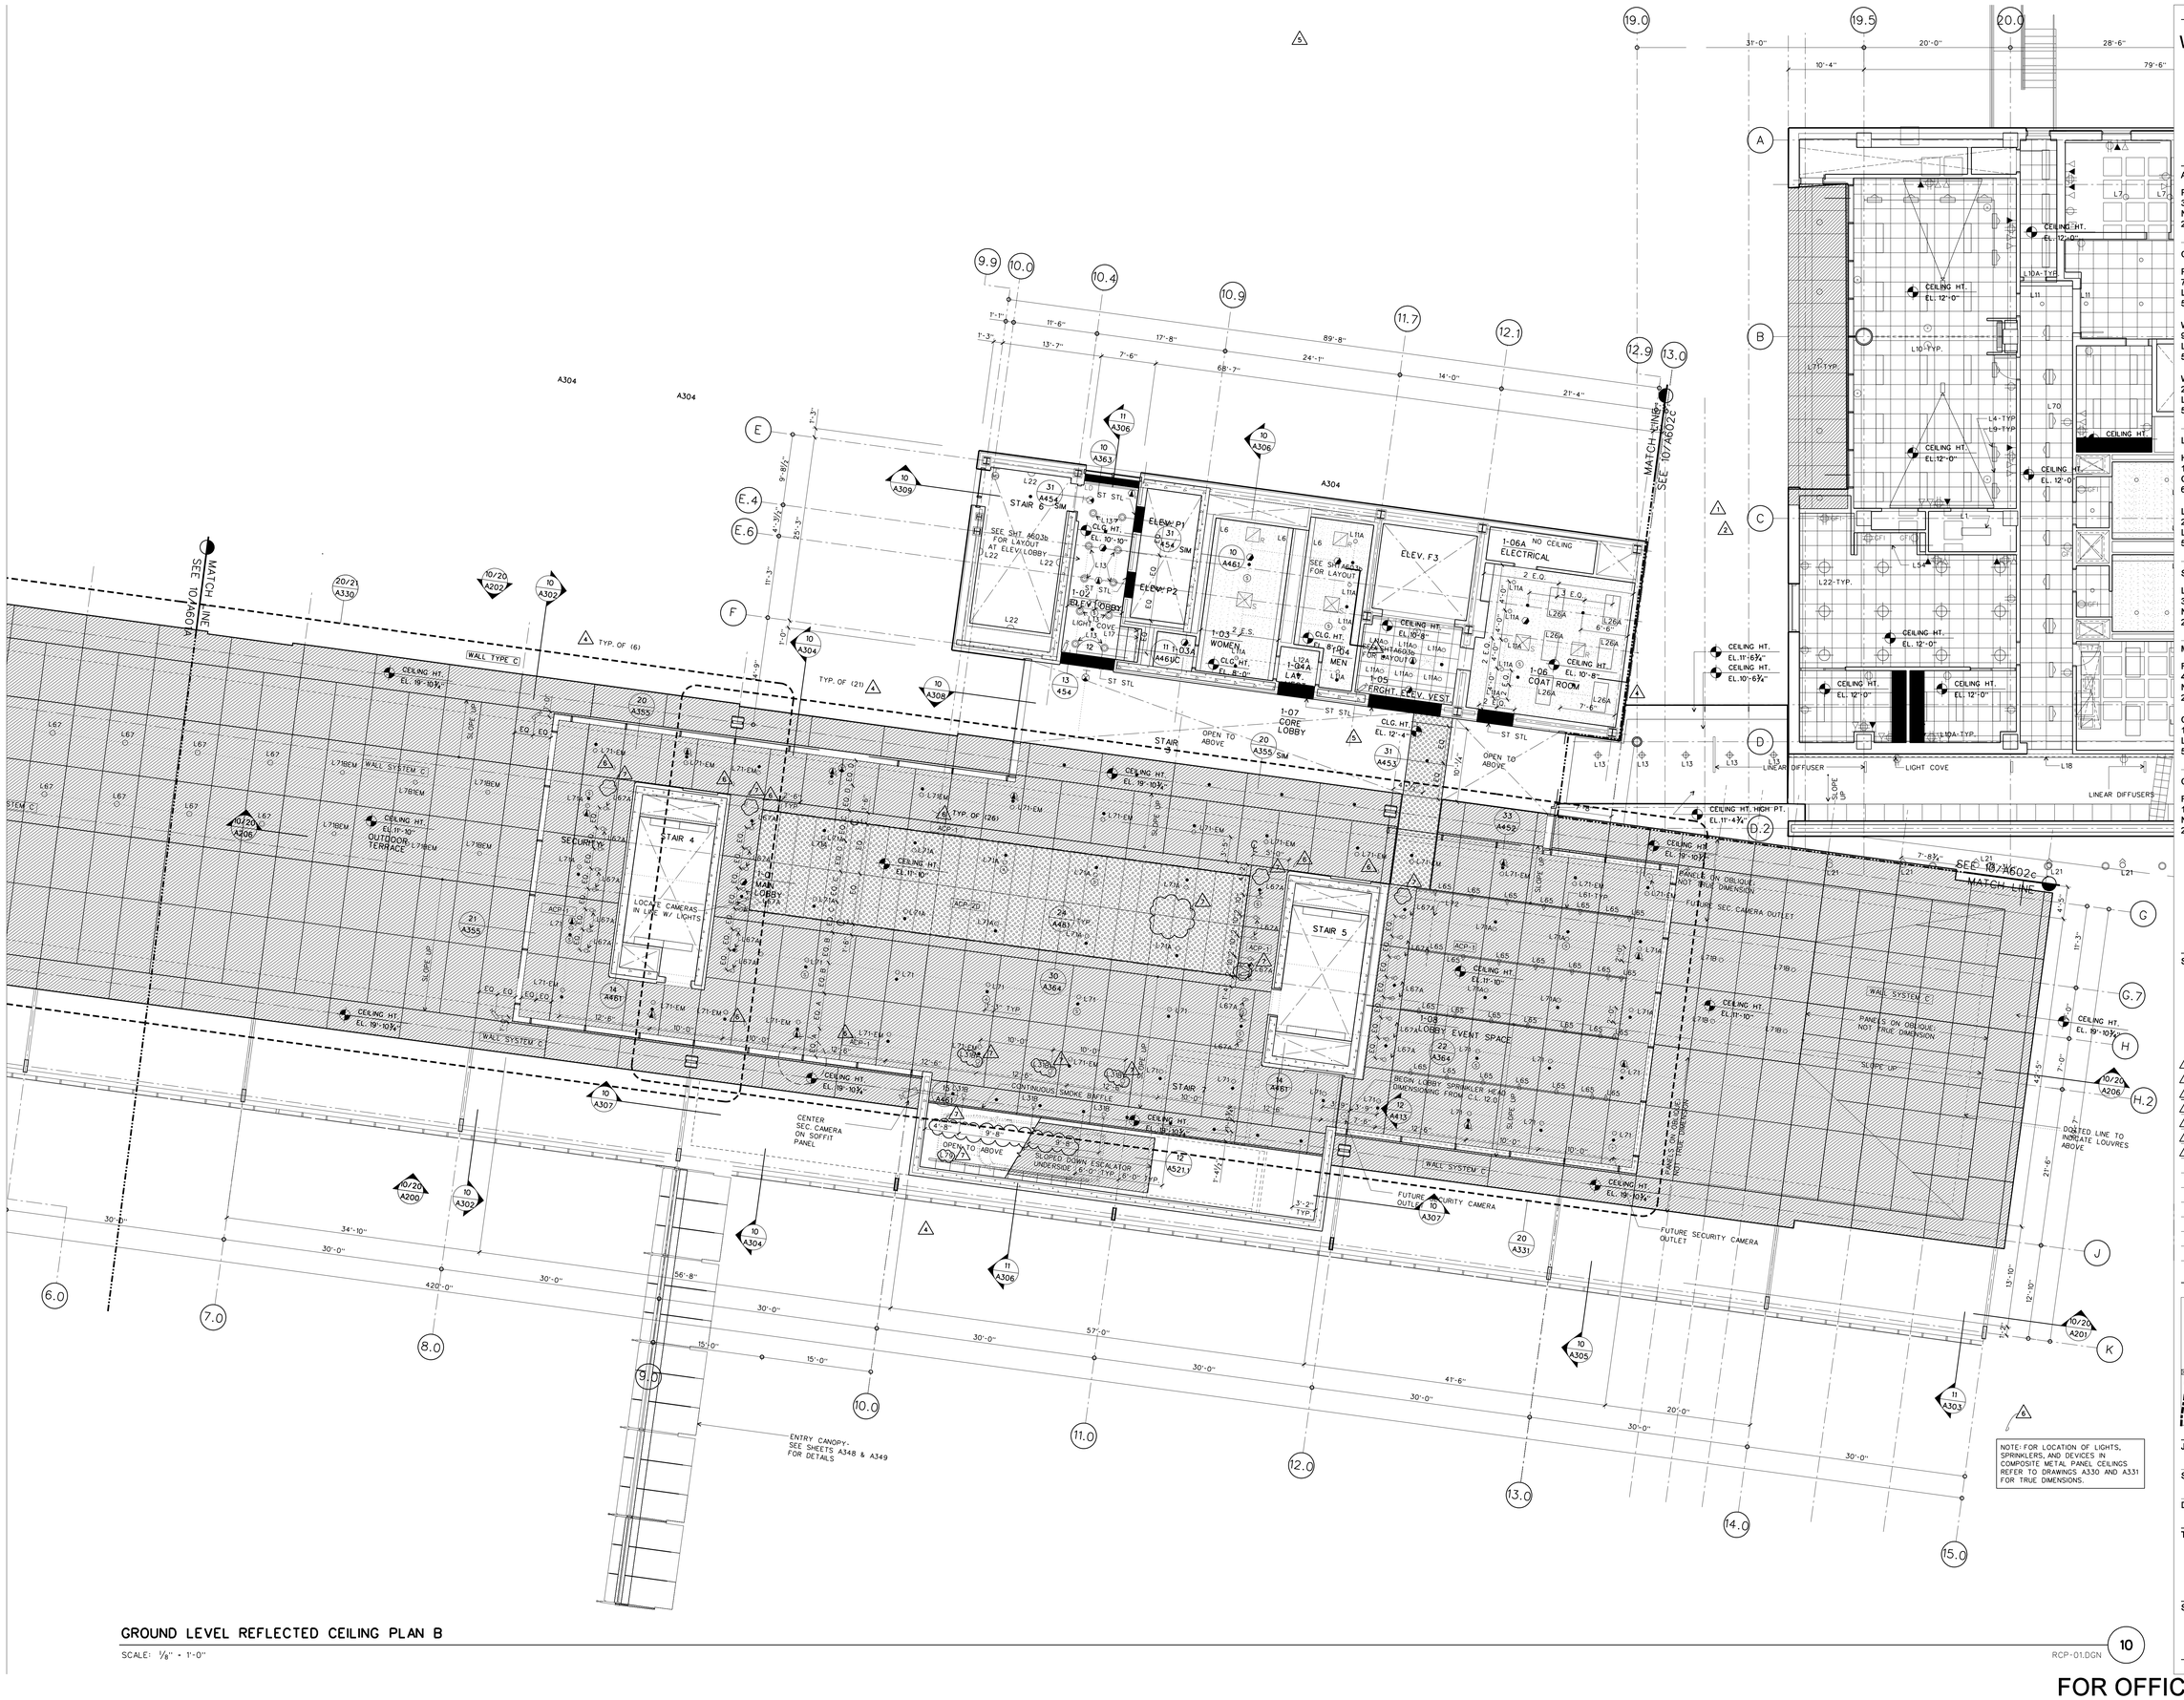

WILLIAM J. CLINTON PRESIDENTIAL CENTER

LITTLE ROCK, ARKANSAS

Architect

POLSHEK PARTNERSHIP LLP
320 West 13th Street
New York, New York 10014
212.807.7171

Coordinating Architects

POLK STANLEY YEARY ARCHITECTS Ltd
700 South Schiller Street
Little Rock, Arkansas 72201
501.378.0878

WITSELL EVANS RASCO
901 West Third Street
Little Rock, Arkansas 72201
501.374.5300

WOODS CARADINE ARCHITECTS
2200 South Main Street
Little Rock, Arkansas 72206
501.374.4060

Landscape Architects

HARGREAVES ASSOCIATES
118 Magazine Street
Cambridge, Massachusettes 02139
617.661.0070

LANDSCAPE ARCHITECTURE, Inc.
2300 Cottondale Lane Suite 202
Little Rock, Arkansas 72202
501.374.5610

Structural Engineer

LESLIE E. ROBERTSON ASSOC., RLLP
30 Broad Street, 47th Floor
New York, New York 10004
212.750.9000

MEP Engineers

FLACK + KURTZ Inc.
475 Fifth Avenue
New York, New York 10017
212.532.9600

CROMWELL ARCHITECTS ENGINEERS
101 South Spring Street
Little Rock, Arkansas 72201
501.372.2900

Curtainwall Consultant

R. A. HEINTGES ARCHITECTS
126 Fifth Avenue, 9th Floor
New York, New York 10011
212.652-2966

Seal

7	ASI. #32	04/09/04
6	ASI. #29	03/05/04
5	ASI #25	12/19/03
4	ASI #24	10/24/03
3	ASI #20	06/06/03
2	ASI #19	05/07/03
1	ASI #18	04/18/03
	100% Construction Documents	09/27/02
	90% Progress Printing	08/30/02
	100% Struct./ CD Progress	07/01/02
	Bridge Bldg. Substructure	06/14/02
	100% Steel & Concrete CD	05/15/02
	& Architectural CD Progress	
	100% Design Development	03/01/02
	Issue	Date

Job No. 9908

Scale 1/8" = 1'-0"

Date September 27, 2002


Title

GROUND LEVEL PARTIAL REFLECTED CEILING PLAN

Sheet No.

A601b

FOR OFFICIAL USE ONLY

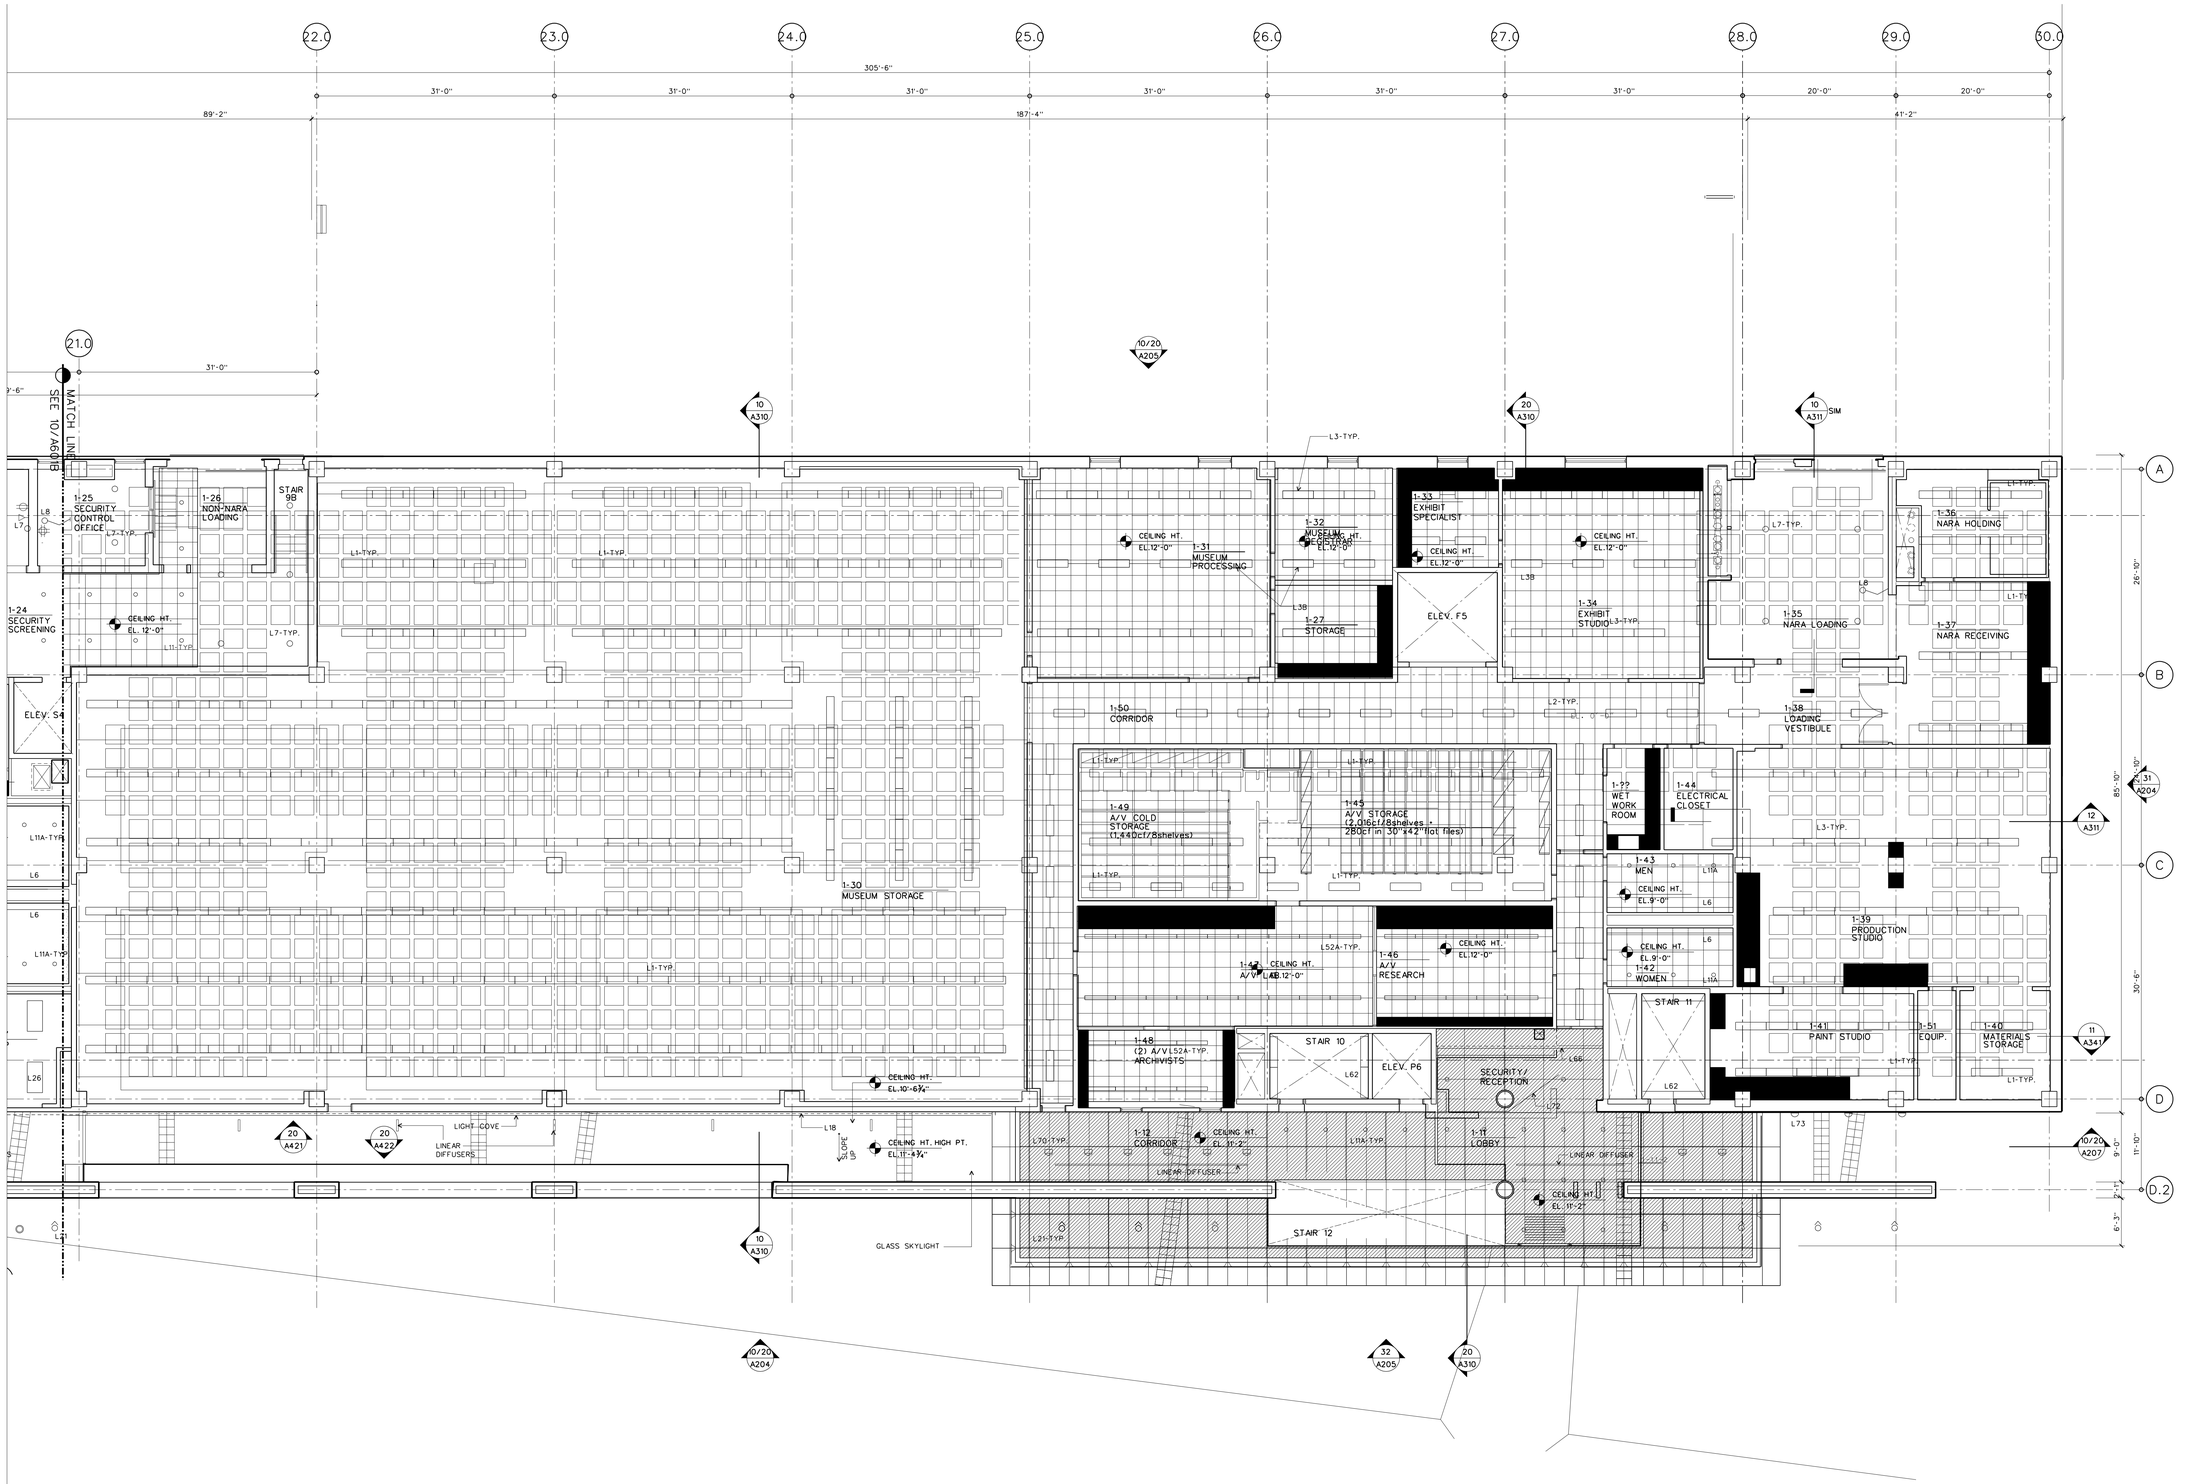

GROUND LEVEL REFLECTED CEILING PLAN C

SCALE: 1/8" = 1'-0"

RCP-01.DGN

10

WILLIAM J. CLINTON PRESIDENTIAL CENTER

LITTLE ROCK, ARKANSAS

Architect

POLSHEK PARTNERSHIP LLP
320 West 13th Street
New York, New York 10014
212.807.7171

Coordinating Architects

POLK STANLEY YEARY ARCHITECTS Ltd
700 South Schiller Street
Little Rock, Arkansas 72201
501.378.0878

WITSELL EVANS RASCO
901 West Third Street
Little Rock, Arkansas 72201
501.374.5300

WOODS CARADINE ARCHITECTS
2200 South Main Street
Little Rock, Arkansas 72206
501.374.4060

Landscape Architects

HARGREAVES ASSOCIATES
118 Magazine Street
Cambridge, Massachusettes 02139
617.661.0070

LANDSCAPE ARCHITECTURE, Inc.
2300 Cottondale Lane Suite 202
Little Rock, Arkansas 72202
501.374.5610

Structural Engineer

LESLIE E. ROBERTSON ASSOC., RLLP
30 Broad Street, 47th Floor
New York, New York 10004
212.750.9000

MEP Engineers

FLACK + KURTZ Inc.
475 Fifth Avenue
New York, New York 10017
212.532.9600

CROMWELL ARCHITECTS ENGINEERS
101 South Spring Street
Little Rock, Arkansas 72201
501.372.2900

Curtainwall Consultant

R. A. HEINTGES ARCHITECTS
126 Fifth Avenue, 9th Floor
New York, New York 10011
212.652-2966

Seal

Issue	Date
100% Construction Documents	09/27/02
90% Progress Printing	08/30/02
ASI #05	08/20/02
100% Struct./ CD Progress	07/01/02
Bridge Bldg. Substructure	06/14/02
100% Steel & Concrete CD & Architectural CD Progress	05/15/02
100% Design Development	03/01/02

Job No. 9908

Scale 1/8" = 1'-0"

Date September 27, 2002


Title

GROUND LEVEL PARTIAL REFLECTED CEILING PLAN

Sheet No.

A601c

FOR OFFICIAL USE ONLY

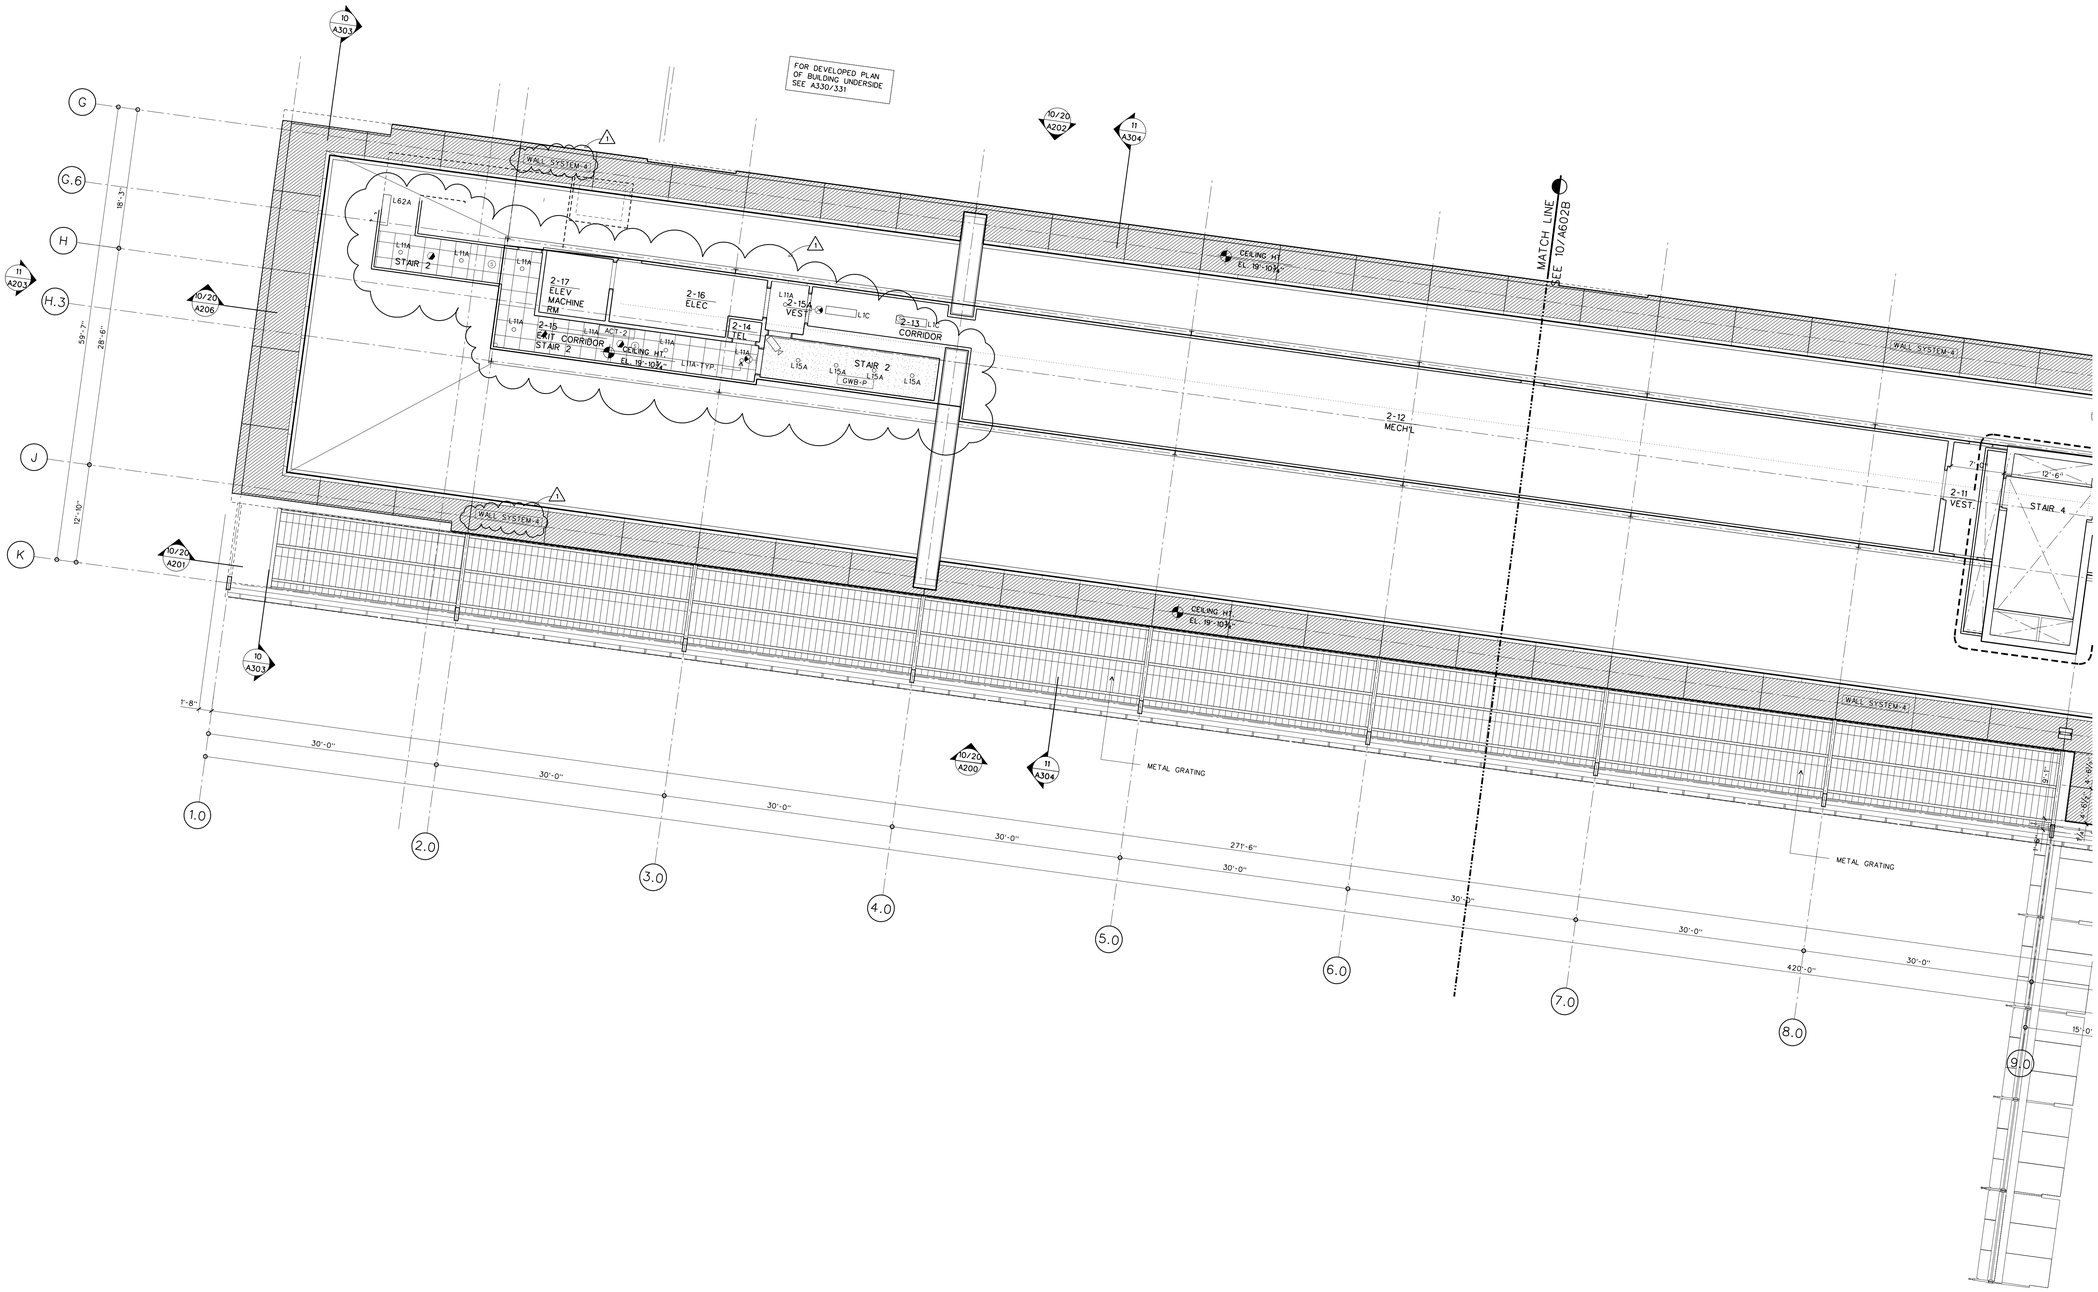

SECOND LEVEL REFLECTED CEILING PLAN A

SCALE: 1/8" = 1'-0"

RCP-02.DGN

10

WILLIAM J. CLINTON PRESIDENTIAL CENTER

LITTLE ROCK, ARKANSAS

Architect

POLSHEK PARTNERSHIP LLP
320 West 13th Street
New York, New York 10014
212.807.7171

Coordinating Architects

POLK STANLEY YEARY ARCHITECTS Ltd
700 South Schiller Street
Little Rock, Arkansas 72201
501.378.0878

WITSELL EVANS RASCO
901 West Third Street
Little Rock, Arkansas 72201
501.374.5300

WOODS CARADINE ARCHITECTS
2200 South Main Street
Little Rock, Arkansas 72206
501.374.4060

Landscape Architects

HARGREAVES ASSOCIATES
118 Magazine Street
Cambridge, Massachusettes 02139
617.661.0070

LANDSCAPE ARCHITECTURE, Inc.
2300 Cottondale Lane Suite 202
Little Rock, Arkansas 72202
501.374.5610

Structural Engineer

LESLIE E. ROBERTSON ASSOC., RLLP
30 Broad Street, 47th Floor
New York, New York 10004
212.750.9000

MEP Engineers

FLACK + KURTZ Inc.
475 Fifth Avenue
New York, New York 10017
212.532.9600


CROMWELL ARCHITECTS ENGINEERS
101 South Spring Street
Little Rock, Arkansas 72201
501.372.2900

Curtainwall Consultant

R. A. HEINTGES ARCHITECTS
126 Fifth Avenue, 9th Floor
New York, New York 10011
212.652-2966

Seal

1	ASI #018	04/18/03
	100% Construction Documents	09/27/02
	90% Progress Printing	08/30/02
	100% Struct./ CD Progress	07/01/02
	100% Steel & Concrete CD	05/15/02
	& Architectural CD Progress	
	100% Design Development	03/01/02
	Issue	Date

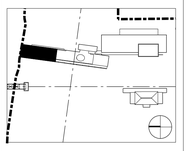

Job No. 9908

Scale 1/8" = 1'-0"

Date September 27, 2002


Title

SECOND LEVEL PARTIAL REFLECTED CEILING PLAN

Sheet No.

A602a

FOR OFFICIAL USE ONLY

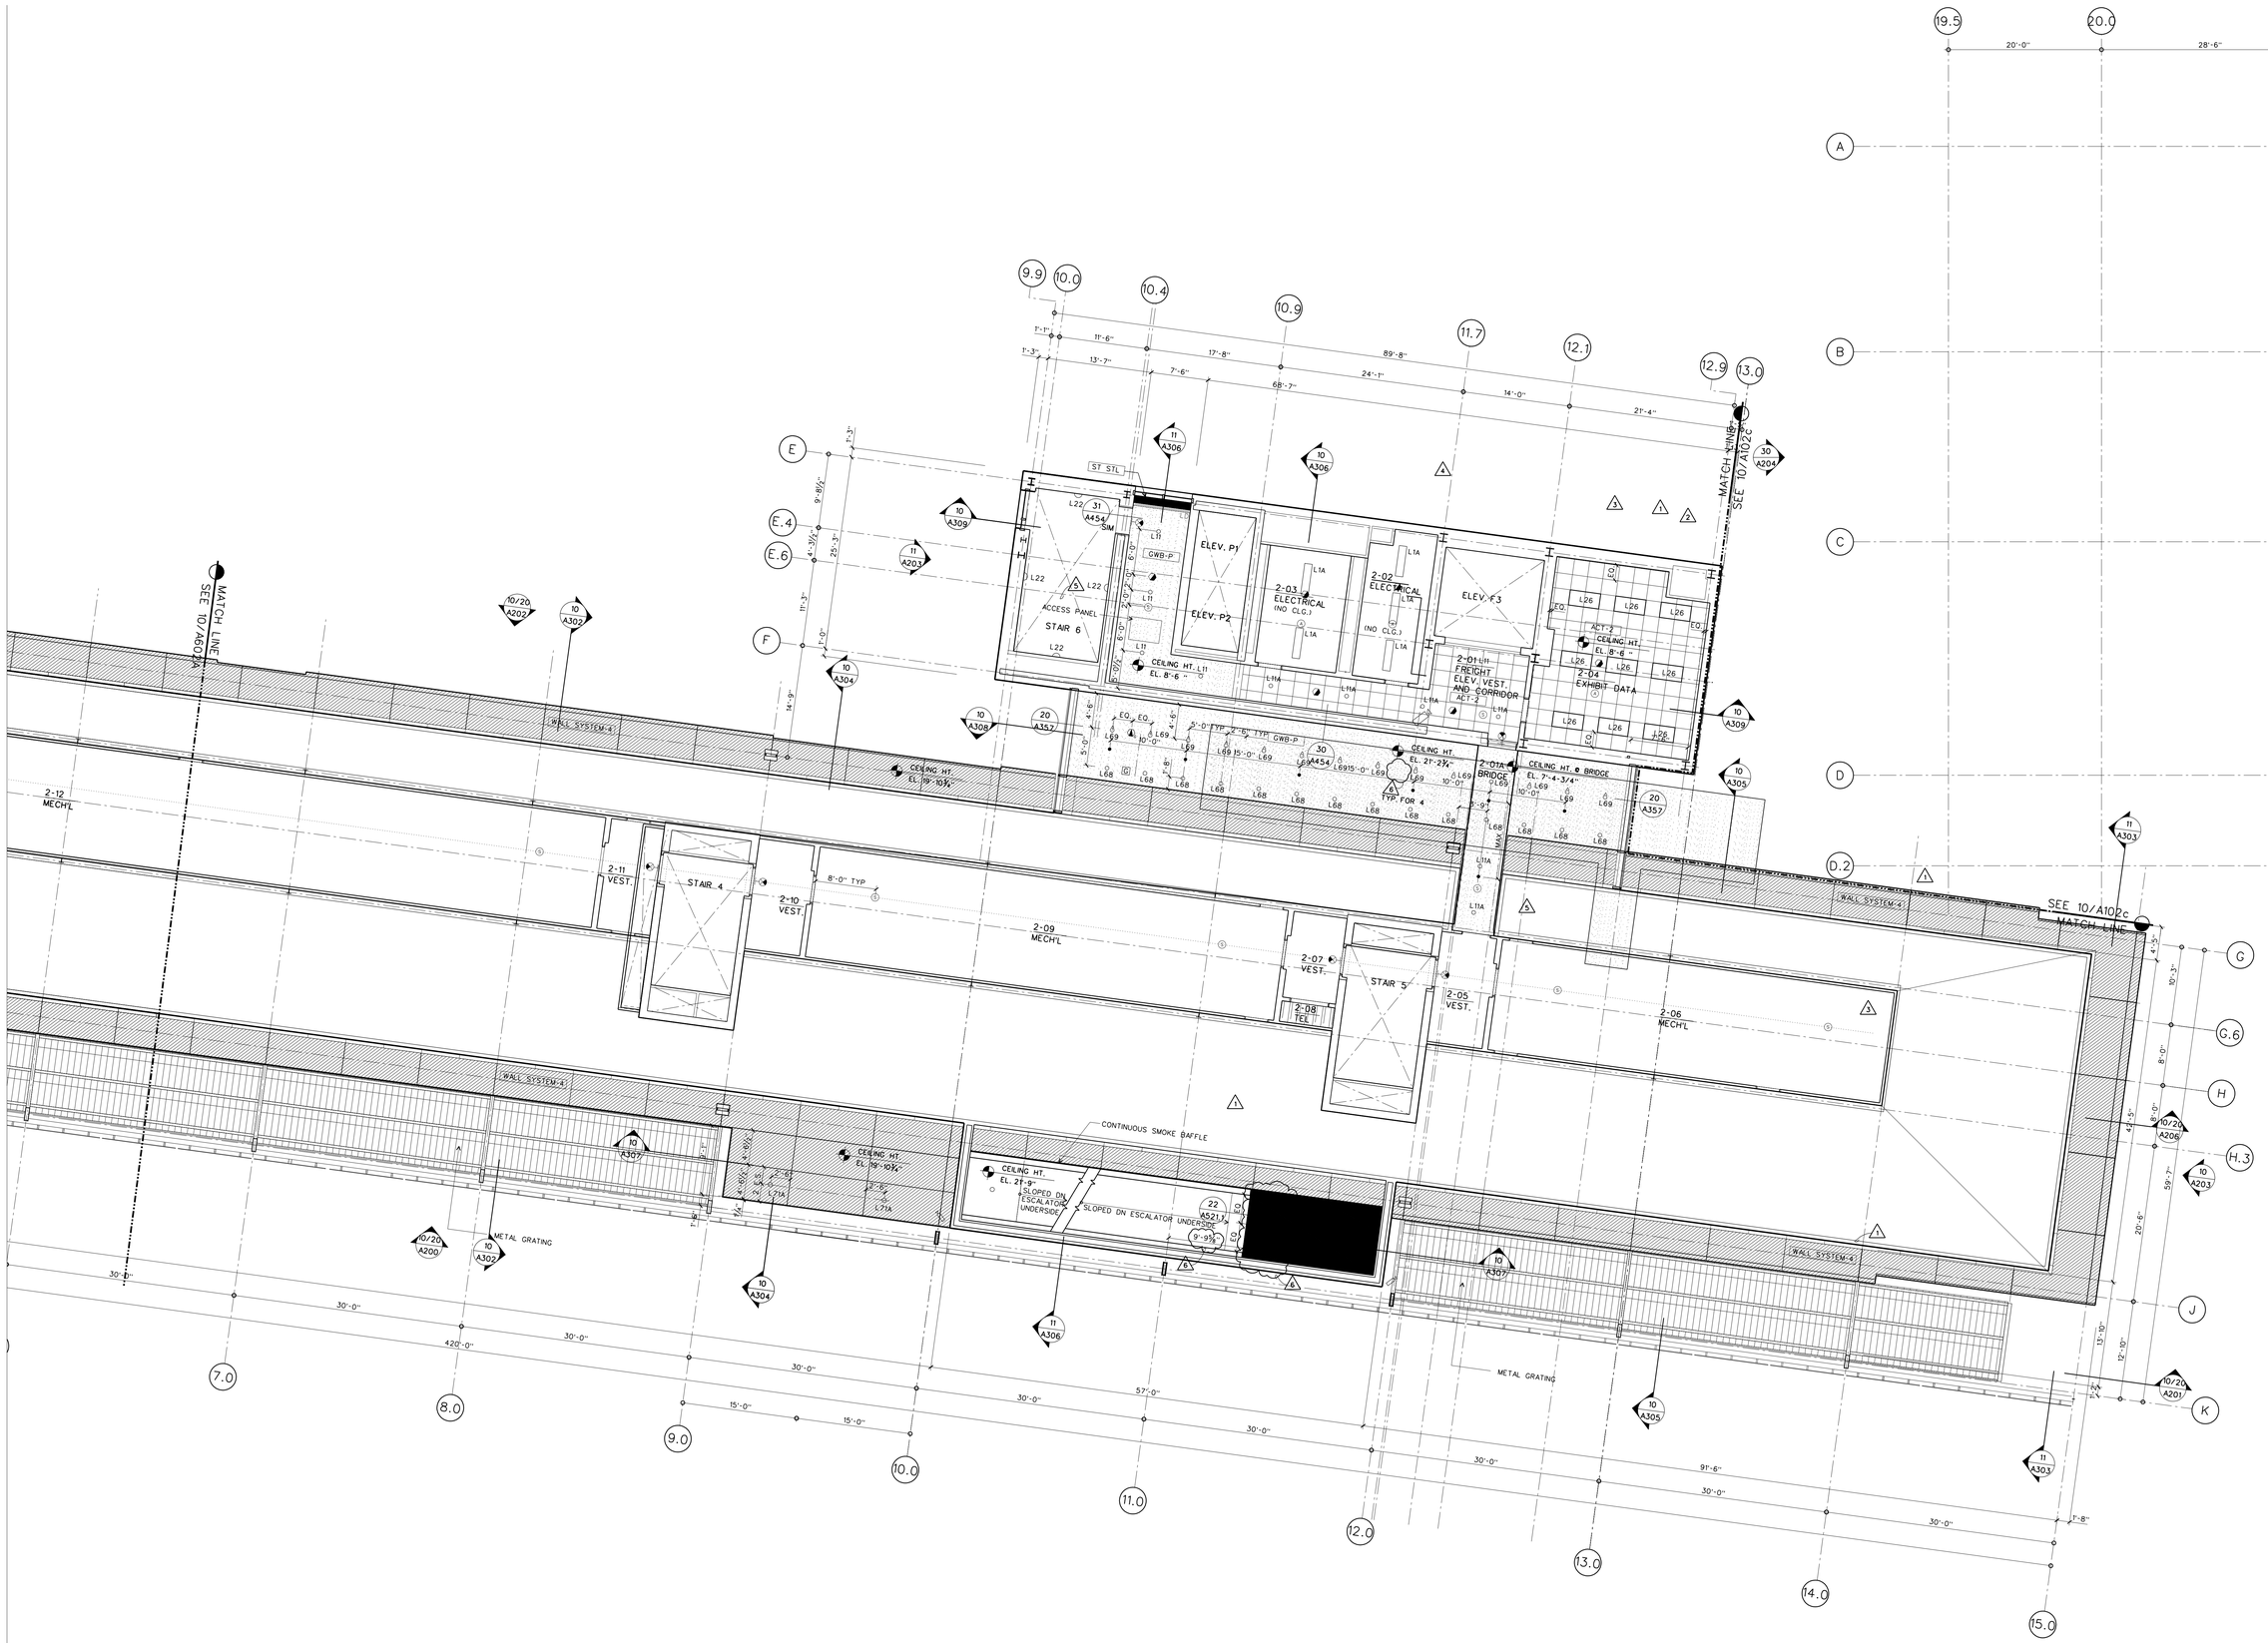

SECOND LEVEL REFLECTED CEILING PLAN B

SCALE: 1/8" = 1'-0"

RCP-02.DGN

10

FOR OFFICIAL USE ONLY

WILLIAM J. CLINTON PRESIDENTIAL CENTER

LITTLE ROCK, ARKANSAS

Architect

POLSHEK PARTNERSHIP LLP
320 West 13th Street
New York, New York 10014
212.807.7171

Coordinating Architects

POLK STANLEY YEARY ARCHITECTS Ltd
700 South Schiller Street
Little Rock, Arkansas 72201
501.378.0878

WITSELL EVANS RASCO
901 West Third Street
Little Rock, Arkansas 72201
501.374.5300

WOODS CARADINE ARCHITECTS
2200 South Main Street
Little Rock, Arkansas 72206
501.374.4060

Landscape Architects

HARGREAVES ASSOCIATES
118 Magazine Street
Cambridge, Massachusettes 02139
617.661.0070

LANDSCAPE ARCHITECTURE, Inc.
2300 Cottondale Lane Suite 202
Little Rock, Arkansas 72202
501.374.5610

Structural Engineer

LESLIE E. ROBERTSON ASSOC., RLLP
30 Broad Street, 47th Floor
New York, New York 10004
212.750.9000

MEP Engineers

FLACK + KURTZ Inc.
475 Fifth Avenue
New York, New York 10017
212.532.9600

CROMWELL ARCHITECTS ENGINEERS
101 South Spring Street
Little Rock, Arkansas 72201
501.372.2900

Curtainwall Consultant

R. A. HEINTGES ARCHITECTS
126 Fifth Avenue, 9th Floor
New York, New York 10011
212.652-2966

Seal

	Issue	Date
6	ASI #29	03/05/04
5	ASI #25	12/19/03
4	ASI #24	10/24/03
3	ASI #20	06/06/03
2	ASI #19	05/07/03
1	ASI #18	04/18/03
	100% Construction Documents	09/27/02
	90% Progress Printing	08/30/02
	100% Struct./ CD Progress	07/01/02
	100% Steel & Concrete CD & Architectural CD Progress	05/15/02
	100% Design Development	03/01/02

Job No. 9908

Scale 1/8" = 1'-0"


Date September 27, 2002

Title

SECOND LEVEL PARTIAL REFLECTED CEILING PLAN

Sheet No.

A602b

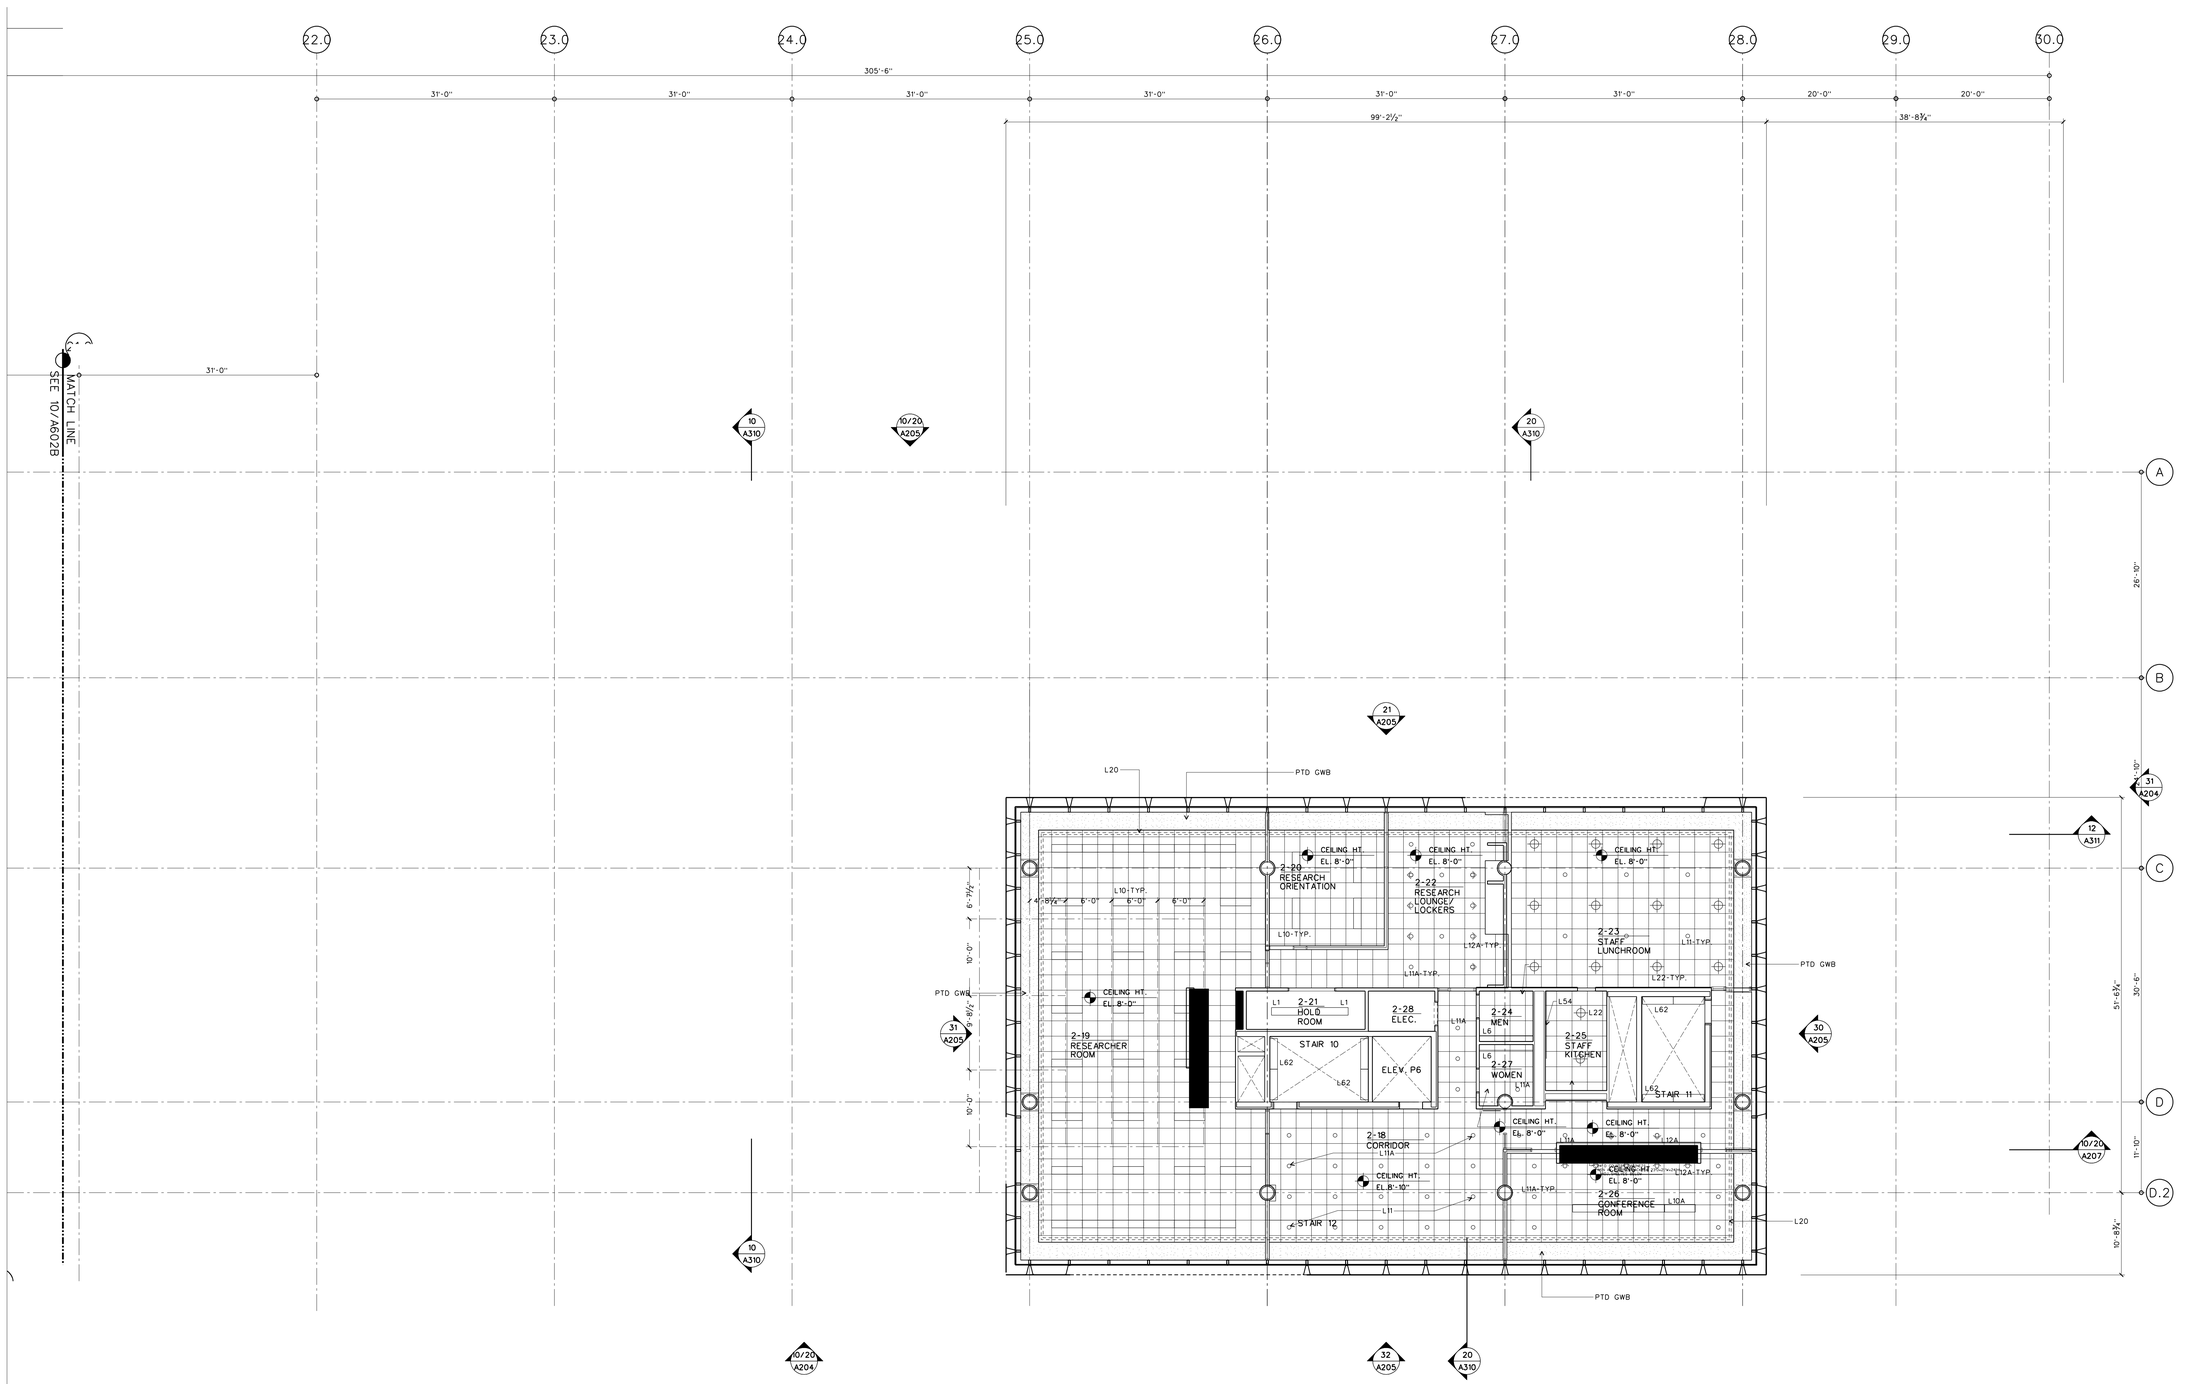

SECOND LEVEL REFLECTED CEILING PLAN C

SCALE: 1/8" = 1'-0"

RCP-02.DGN

10

WILLIAM J. CLINTON PRESIDENTIAL CENTER

LITTLE ROCK, ARKANSAS

Architect

POLSHEK PARTNERSHIP LLP
320 West 13th Street
New York, New York 10014
212.807.7171

Coordinating Architects

POLK STANLEY YEARY ARCHITECTS Ltd
700 South Schiller Street
Little Rock, Arkansas 72201
501.378.0878

WITSELL EVANS RASCO
901 West Third Street
Little Rock, Arkansas 72201
501.374.5300

WOODS CARADINE ARCHITECTS
2200 South Main Street
Little Rock, Arkansas 72206
501.374.4060

Landscape Architects

HARGREAVES ASSOCIATES
118 Magazine Street
Cambridge, Massachusettes 02139
617.661.0070

LANDSCAPE ARCHITECTURE, Inc.
2300 Cottondale Lane Suite 202
Little Rock, Arkansas 72202
501.374.5610

Structural Engineer

LESLIE E. ROBERTSON ASSOC., RLLP
30 Broad Street, 47th Floor
New York, New York 10004
212.750.9000

MEP Engineers

FLACK + KURTZ Inc.
475 Fifth Avenue
New York, New York 10017
212.532.9600


CROMWELL ARCHITECTS ENGINEERS
101 South Spring Street
Little Rock, Arkansas 72201
501.372.2900

Curtainwall Consultant

R. A. HEINTGES ARCHITECTS
126 Fifth Avenue, 9th Floor
New York, New York 10011
212.652-2966

Seal

Issue	Date
100% Construction Documents	09/27/02
90% Progress Printing	08/30/02
ASI #05	08/20/02
100% Struct./ CD Progress	07/01/02
Bridge Bldg. Substructure	06/14/02
100% Steel & Concrete CD & Architectural CD Progress	05/15/02
100% Design Development	03/01/02

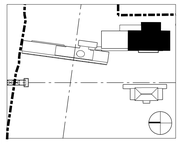

Job No. 9908

Scale 1/8" = 1'-0"

Date September 27, 2002


Title

SECOND LEVEL PARTIAL REFLECTED CEILING PLAN

Sheet No.

A602c

FOR OFFICIAL USE ONLY

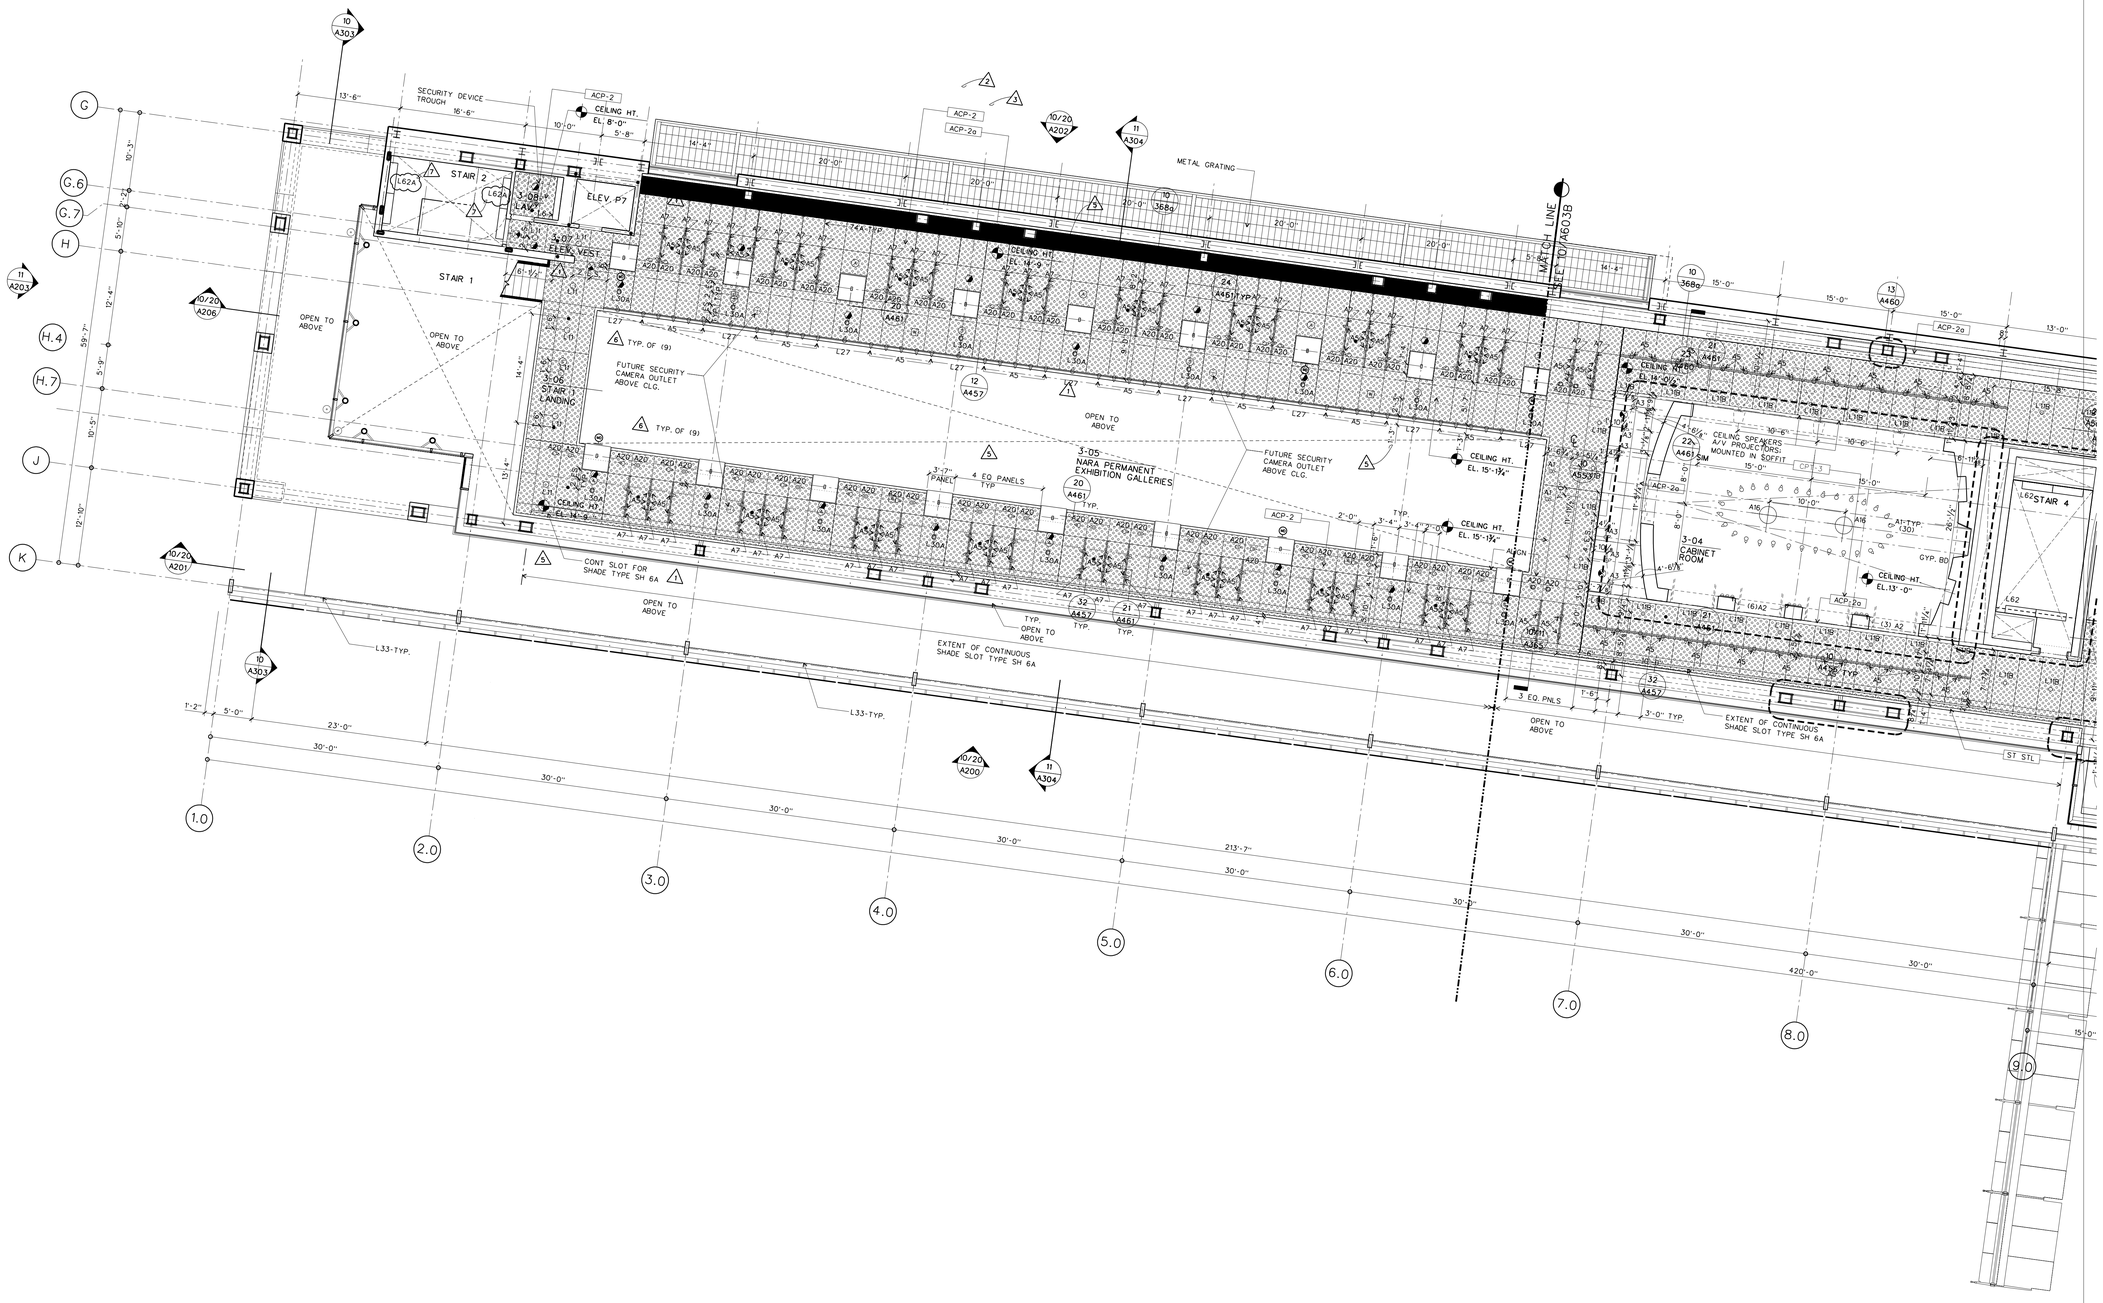

LOWER MUSEUM LEVEL REFLECTED CEILING PLAN A

SCALE: 1/8" = 1'-0"

RCP-03.DGN

10

WILLIAM J. CLINTON PRESIDENTIAL CENTER

LITTLE ROCK, ARKANSAS

Architect

POLSHEK PARTNERSHIP LLP
320 West 13th Street
New York, New York 10014
212.807.7171

Coordinating Architects

POLK STANLEY YEARY ARCHITECTS Ltd
700 South Schiller Street
Little Rock, Arkansas 72201
501.378.0878

WITSELL EVANS RASCO
901 West Third Street
Little Rock, Arkansas 72201
501.374.5300

WOODS CARADINE ARCHITECTS
2200 South Main Street
Little Rock, Arkansas 72206
501.374.4060

Landscape Architects

HARGREAVES ASSOCIATES
118 Magazine Street
Cambridge, Massachusettes 02139
617.661.0070

LANDSCAPE ARCHITECTURE, Inc.
2300 Cottondale Lane Suite 202
Little Rock, Arkansas 72202
501.374.5610

Structural Engineer

LESLIE E. ROBERTSON ASSOC., RLLP
30 Broad Street, 47th Floor
New York, New York 10004
212.750.9000

MEP Engineers

FLACK + KURTZ Inc.
475 Fifth Avenue
New York, New York 10017
212.532.9600

CROMWELL ARCHITECTS ENGINEERS
101 South Spring Street
Little Rock, Arkansas 72201
501.372.2900

Curtainwall Consultant

R. A. HEINTGES ARCHITECTS
126 Fifth Avenue, 9th Floor
New York, New York 10011
212.652-2966

Seal

1	ASI #25	12/19/03
6	ASI #24	10/24/03
5	ASI #23	09/12/03
4	ASI #20	06/06/03
3	ASI #19	05/07/03
2	ASI #18	04/18/03
1	Addendum #2	11/15/02
	100% Construction Documents	09/27/02
	90% Progress Printing	08/30/02
	100% Struct./ CD Progress	07/01/02
	100% Steel & Concrete CD	05/15/02
	& Architectural CD Progress	
	100% Design Development	03/01/02
	Issue	Date

Job No.
9908


Scale
1/8" = 1'-0"


Date
September 27, 2002

Title
MUSEUM LOWER LEVEL PARTIAL REFLECTED CEILING PLAN

Sheet No.
A603a

FOR OFFICIAL USE ONLY

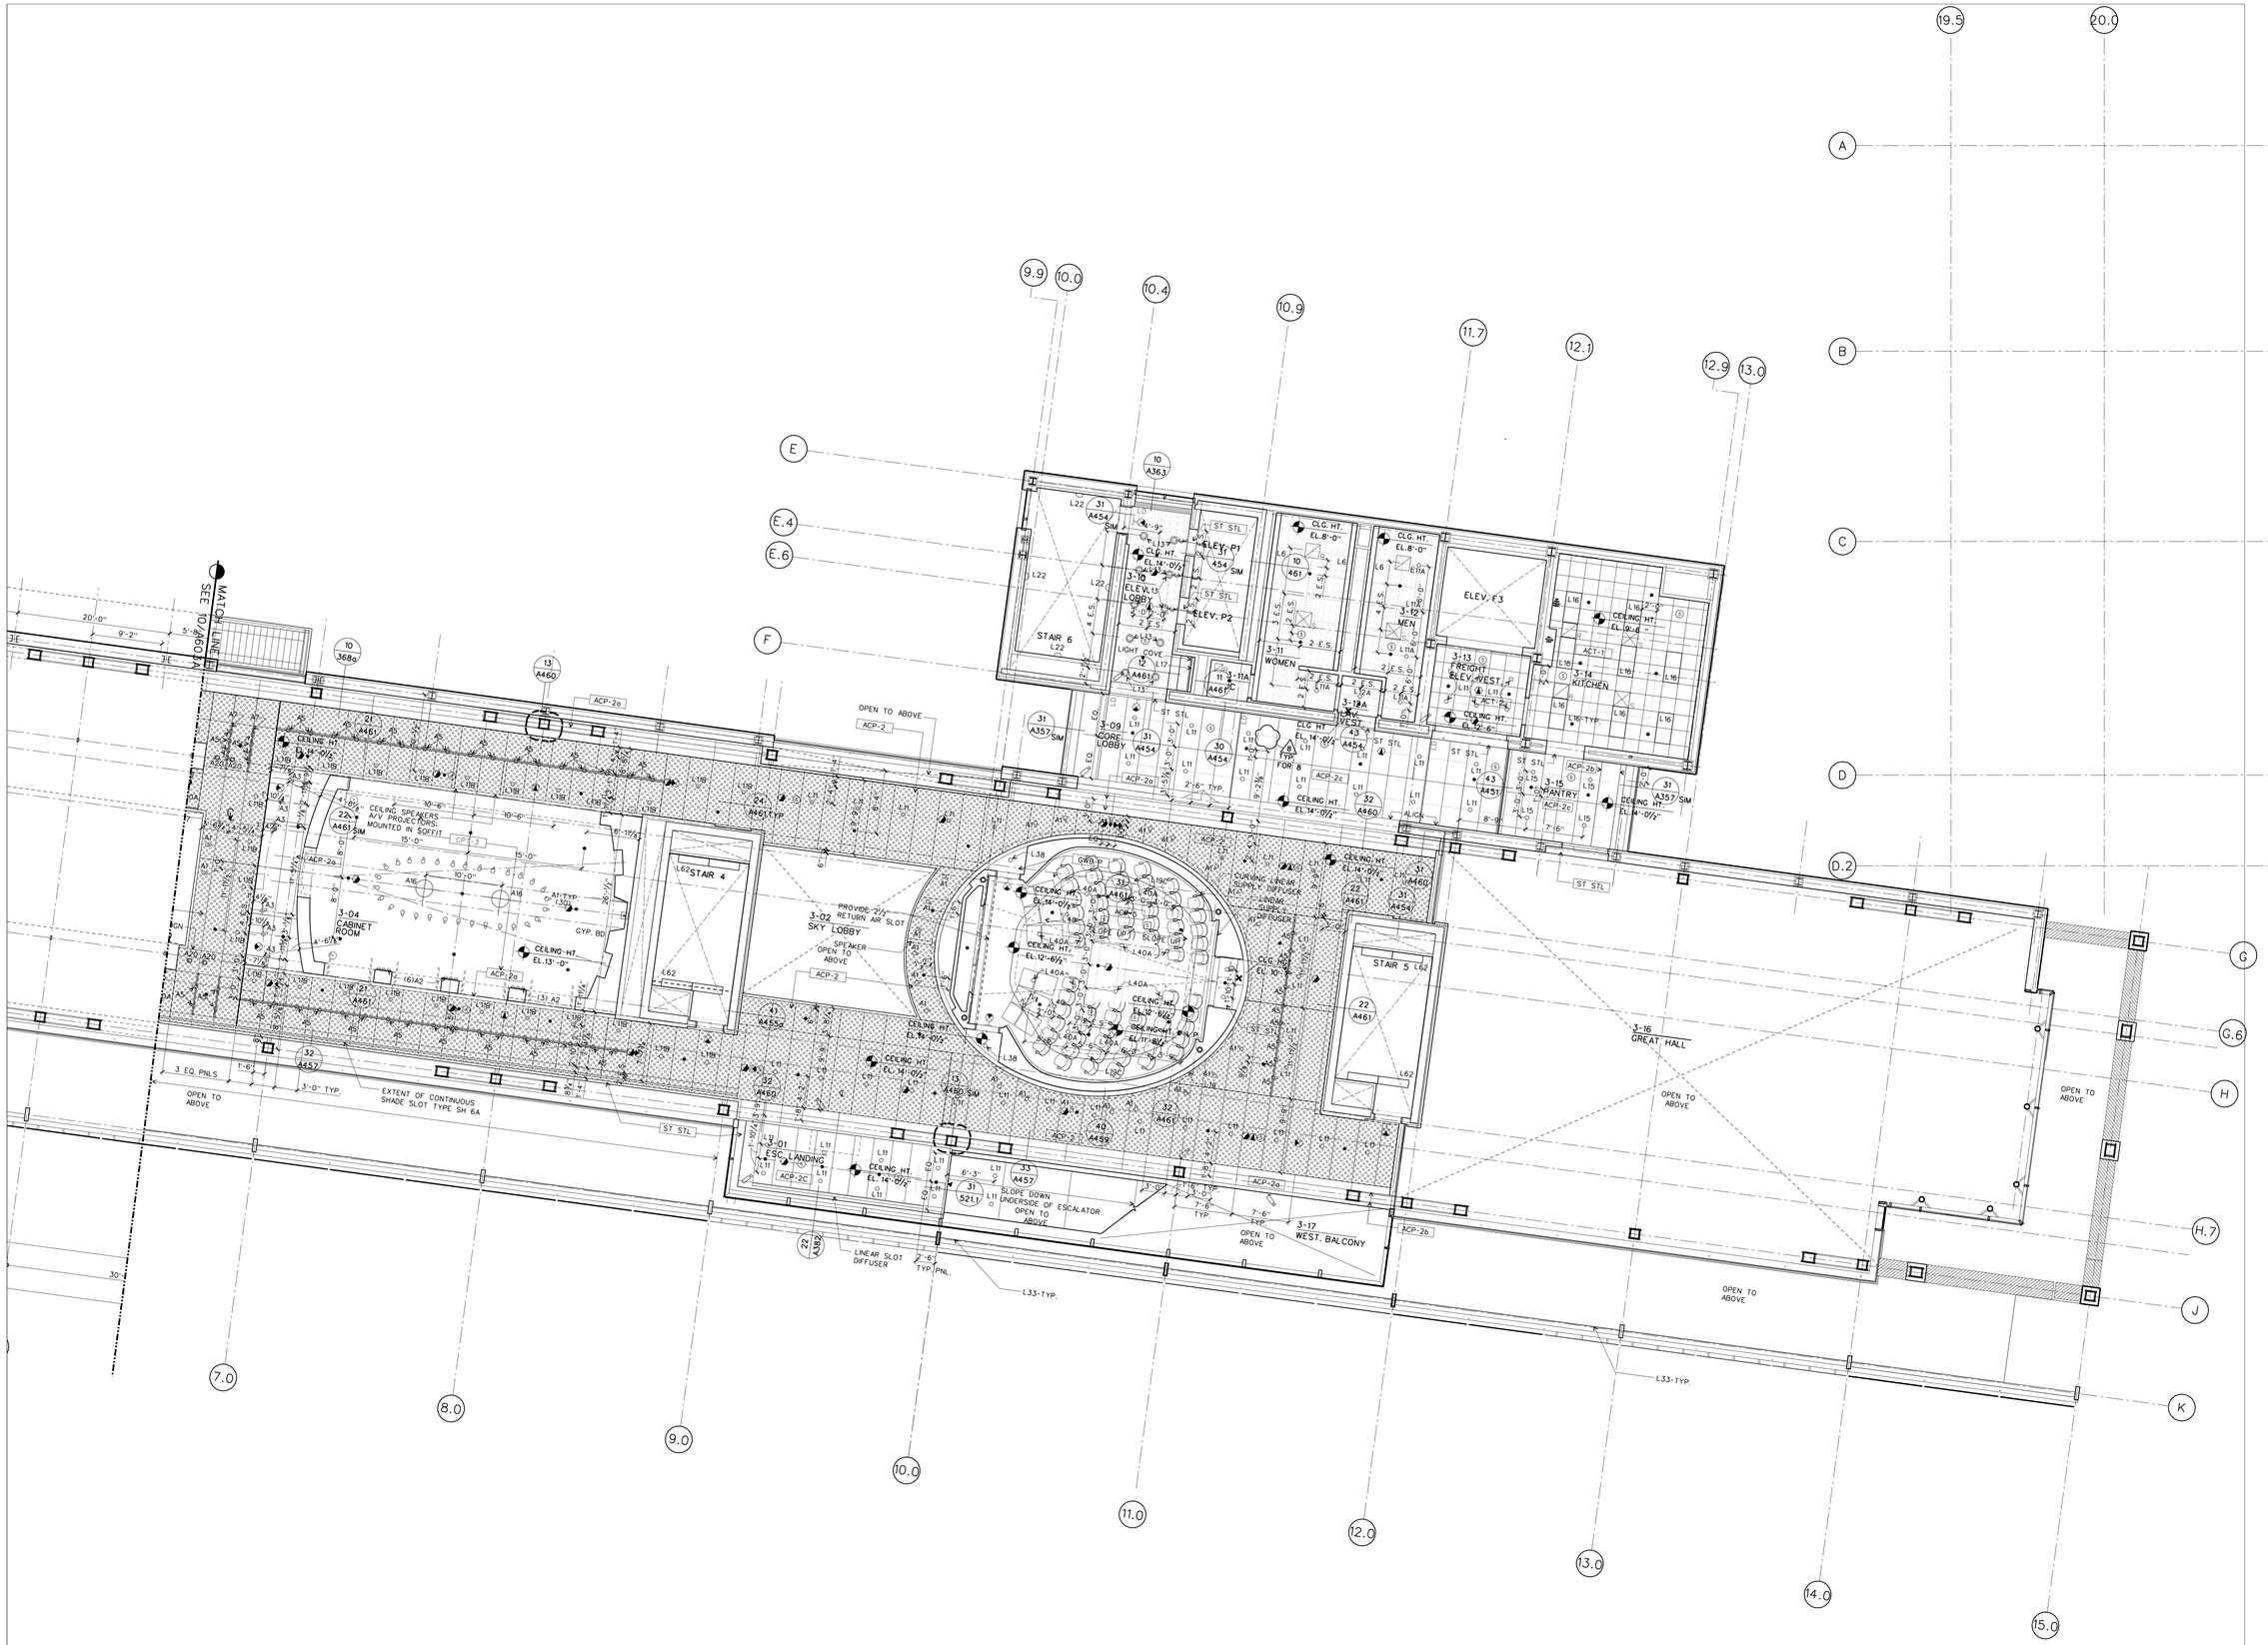
19.5
20.0
9.9
10.0
10.4
10.9
11.7
12.1
12.9
13.0
A
B
C
D
D.2
E
E.4
E.6
F
G
G.6
H
H.7
J
K
7.0
8.0
9.0
10.0
11.0
12.0
13.0
14.0
15.0
MATCH LINE SEE 10/A604
STAIR 6
ELEV. P1
ELEV. P2
ELEV. F3
3-10 ELEV. LOBBY
3-11 WOMEN
3-12 MEN
3-13 FREIGHT ELEV. WEST
3-14 KITCHEN
3-19A WEST
3-09 CORE LOBBY
3-15 PANTRY
3-04 CABINET ROOM
3-02 SKY LOBBY
STAIR 4
STAIR 5
3-16 GREAT HALL
3-17 WEST. BALCONY
ESC. LANDING
OPEN TO ABOVE
ACP-2
ACP-2a
ACP-2b
ACP-2c
ACP-3a
ST STL
CEILING HT. EL. 14'-0½"
CEILING HT. EL. 13'-0"
CEILING HT. EL. 12'-6½"
CLG. HT. EL. 8'-0"
CLG HT. EL. 9'-4"
CLG HT. EL. 10'-0"
CLG HT. EL. 14'-0½"
CLG HT. EL. 14'-0½"
CEILING HT. EL. 14'-0½"
CEILING HT. EL. 14'-0½"
CEILING HT. EL. 14'-0½"
CEILING HT. EL. 14'-0½"
CEILING HT. EL. 12'-6½"
CEILING HT. EL. 12'-6½"
CEILING HT. EL. 14'-0½"
CEILING HT. EL. 14'-0½"
CEILING HT. EL. 14'-0½"
CEILING HT. EL. 14'-0

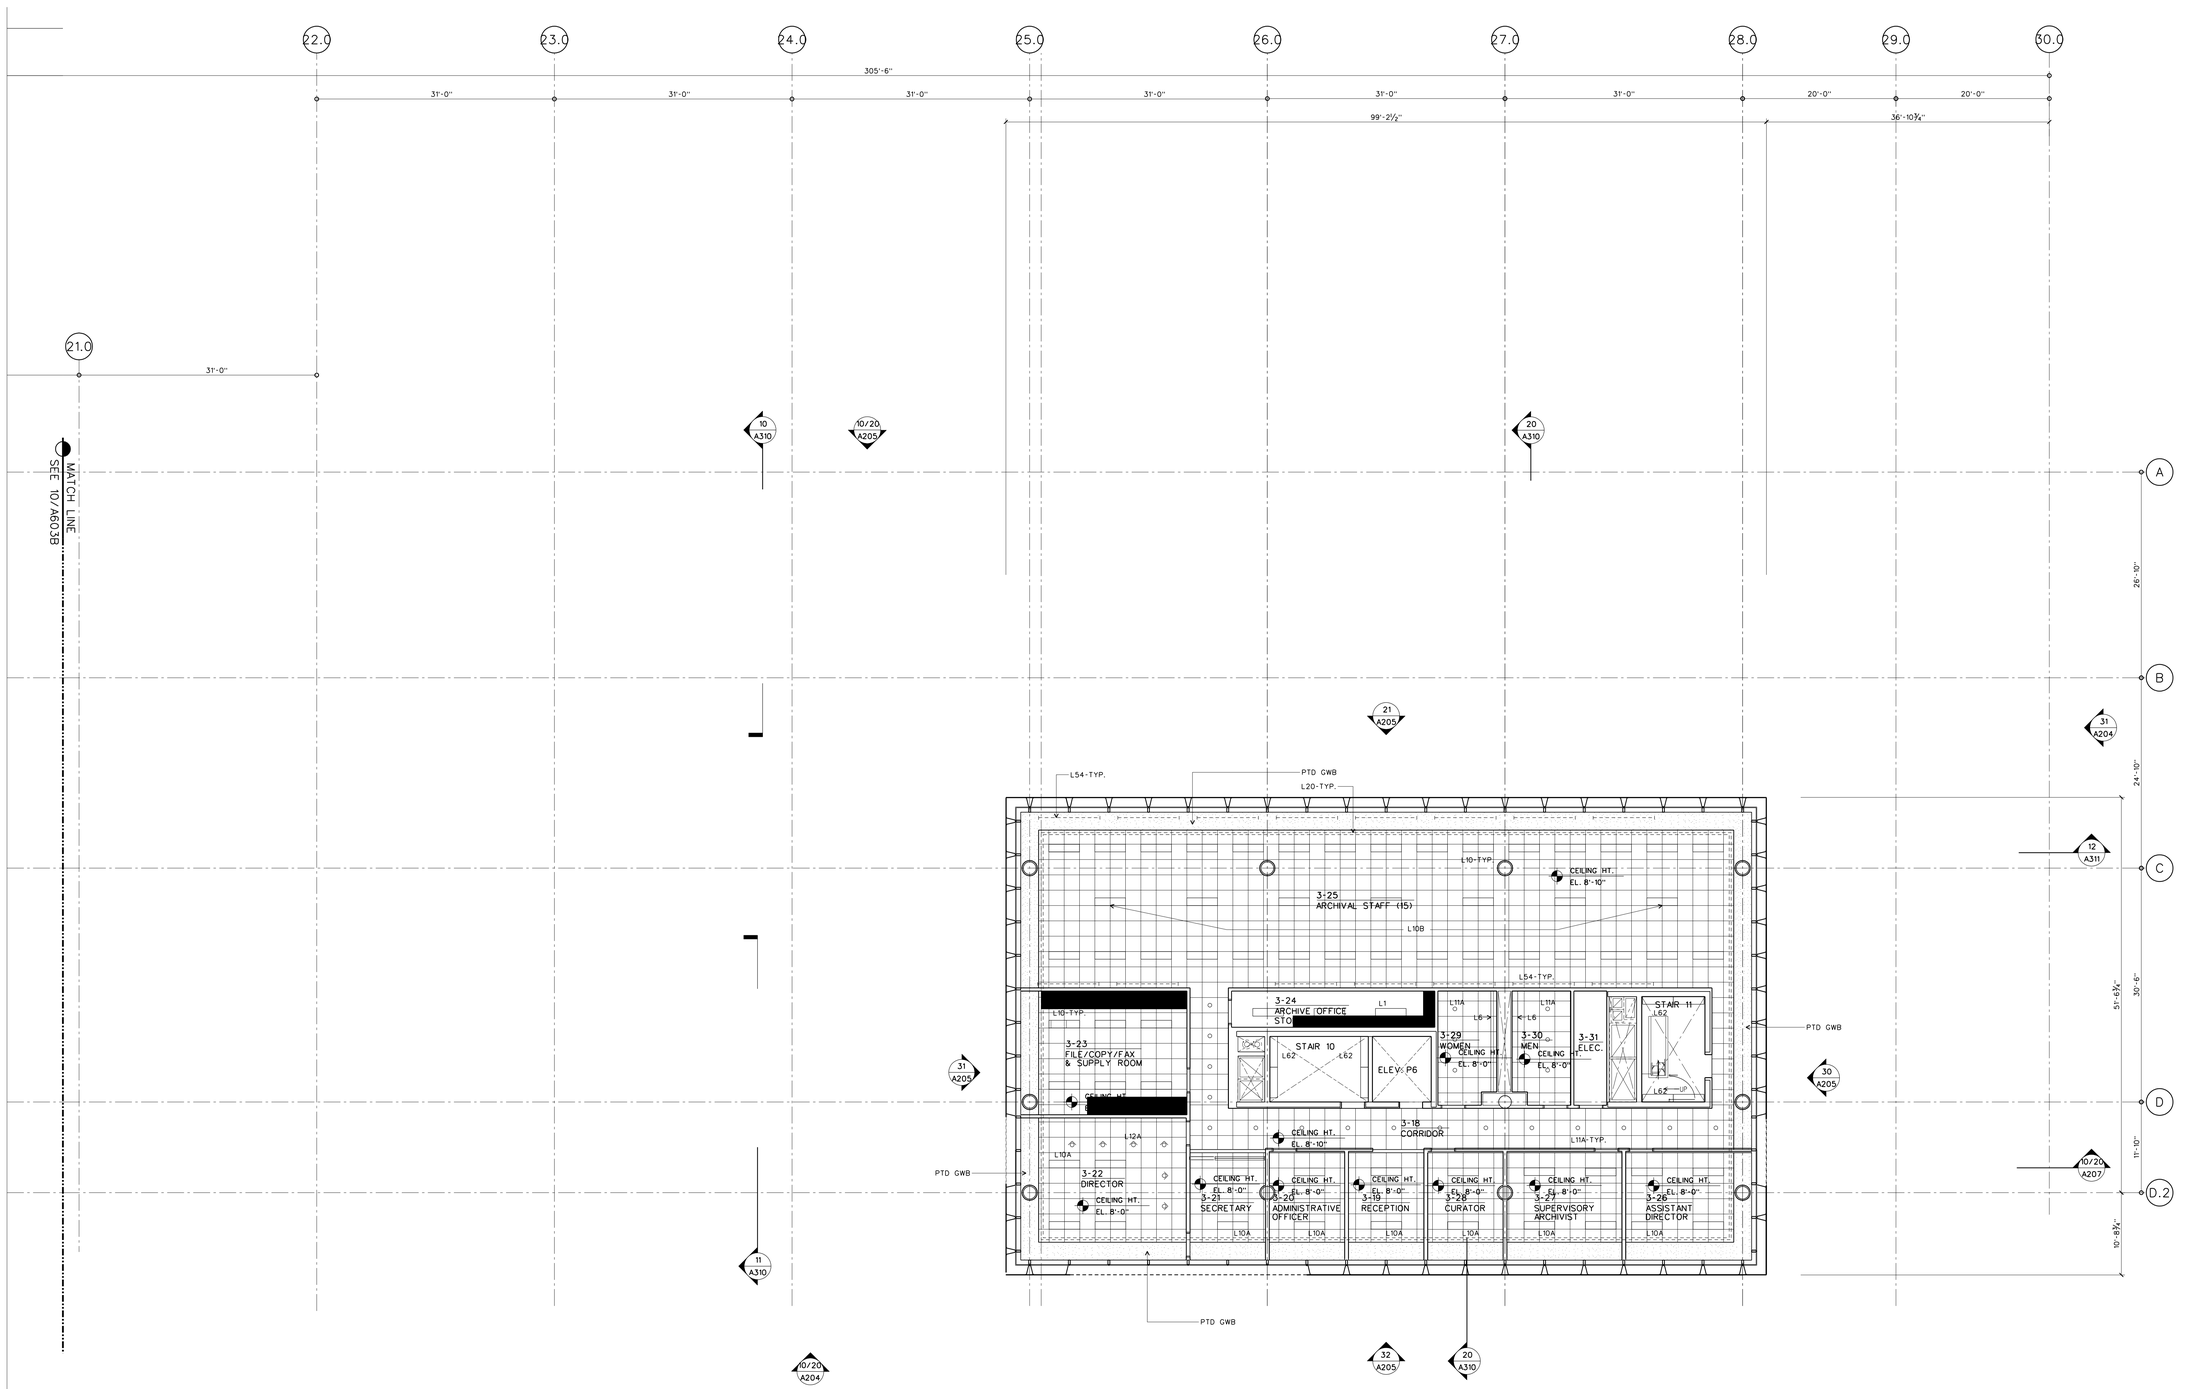

LOWER MUSEUM LEVEL REFLECTED CEILING PLAN C

SCALE: 1/8" = 1'-0"

RCP-03.DGN

10

WILLIAM J. CLINTON PRESIDENTIAL CENTER

LITTLE ROCK, ARKANSAS

Architect

POLSHEK PARTNERSHIP LLP
320 West 13th Street
New York, New York 10014
212.807.7171

Coordinating Architects

POLK STANLEY YEARY ARCHITECTS Ltd
700 South Schiller Street
Little Rock, Arkansas 72201
501.378.0878

WITSELL EVANS RASCO
901 West Third Street
Little Rock, Arkansas 72201
501.374.5300

WOODS CARADINE ARCHITECTS
2200 South Main Street
Little Rock, Arkansas 72206
501.374.4060

Landscape Architects

HARGREAVES ASSOCIATES
118 Magazine Street
Cambridge, Massachusettes 02139
617.661.0070

LANDSCAPE ARCHITECTURE, Inc.
2300 Cottondale Lane Suite 202
Little Rock, Arkansas 72202
501.374.5610

Structural Engineer

LESLIE E. ROBERTSON ASSOC., RLLP
30 Broad Street, 47th Floor
New York, New York 10004
212.750.9000

MEP Engineers

FLACK + KURTZ Inc.
475 Fifth Avenue
New York, New York 10017
212.532.9600


CROMWELL ARCHITECTS ENGINEERS
101 South Spring Street
Little Rock, Arkansas 72201
501.372.2900

Curtainwall Consultant

R. A. HEINTGES ARCHITECTS
126 Fifth Avenue, 9th Floor
New York, New York 10011
212.652-2966

Seal

Issue	Date
100% Construction Documents	09/27/02
90% Progress Printing	08/30/02
ASI #05	08/20/02
100% Struct./ CD Progress	07/01/02
Bridge Bldg. Substructure	06/14/02
100% Steel & Concrete CD	05/15/02
& Architectural CD Progress	
100% Design Development	03/01/02

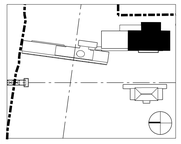

Job No.
9908


Scale
1/8" = 1'-0"

Date
September 27, 2002

Title
THIRD LEVEL PARTIAL REFLECTED CEILING PLAN

Sheet No.
A603c


FOR OFFICIAL USE ONLY

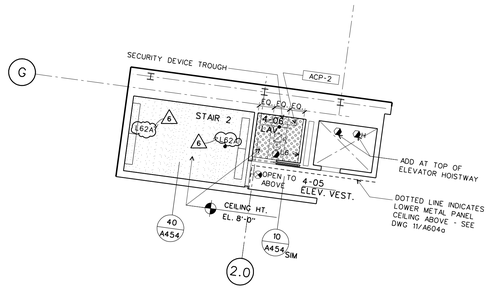

UPPER MUSEUM LEVEL ELEVATOR AND STAIR 1 CORE REFLECTED CEILING PLAN A

SCALE: 1/8" = 1'-0"

20

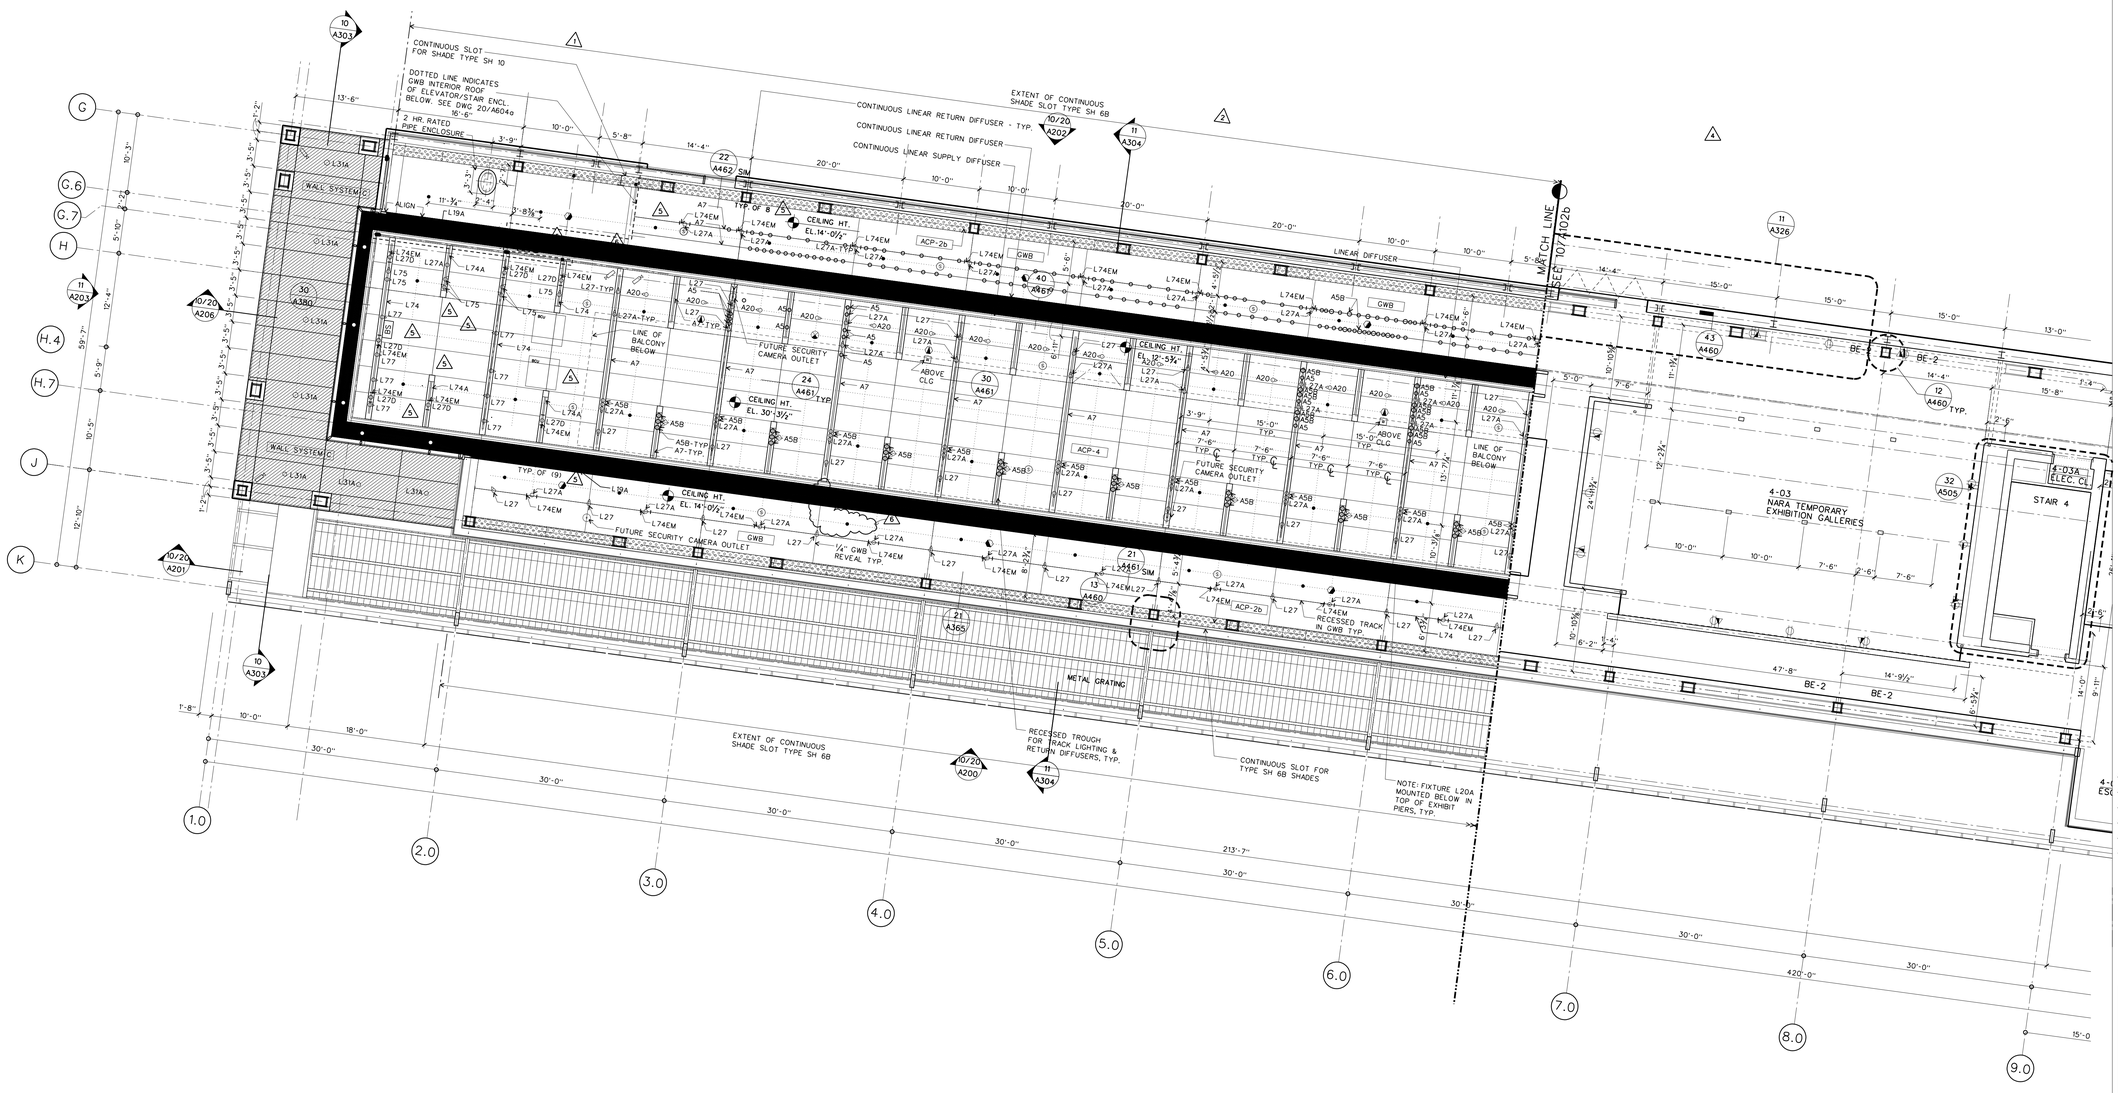

UPPER MUSEUM LEVEL REFLECTED CEILING PLAN A

SCALE: 1/8" = 1'-0"

10

RCP-04.DGN

FOR OFFICIAL USE ONLY

WILLIAM J. CLINTON PRESIDENTIAL CENTER

LITTLE ROCK, ARKANSAS

Architect

POLSHEK PARTNERSHIP LLP
320 West 13th Street
New York, New York 10014
212.807.7171

Coordinating Architects

POLK STANLEY YEARY ARCHITECTS Ltd
700 South Schiller Street
Little Rock, Arkansas 72201
501.378.0878

WITSELL EVANS RASCO
901 West Third Street
Little Rock, Arkansas 72201
501.374.5300

WOODS CARADINE ARCHITECTS
2200 South Main Street
Little Rock, Arkansas 72206
501.374.4060

Landscape Architects

HARGREAVES ASSOCIATES
118 Magazine Street
Cambridge, Massachusettes 02139
617.661.0070

LANDSCAPE ARCHITECTURE, Inc.
2300 Cottondale Lane Suite 202
Little Rock, Arkansas 72202
501.374.5610

Structural Engineer

LESLIE E. ROBERTSON ASSOC., RLLP
30 Broad Street, 47th Floor
New York, New York 10004
212.750.9000

MEP Engineers

FLACK + KURTZ Inc.
475 Fifth Avenue
New York, New York 10017
212.532.9600


CROMWELL ARCHITECTS ENGINEERS
101 South Spring Street
Little Rock, Arkansas 72201
501.372.2900

Curtainwall Consultant

R. A. HEINTGES ARCHITECTS
126 Fifth Avenue, 9th Floor
New York, New York 10011
212.652-2966

Seal

6	ASI #25	10/24/03
5	ASI #24	10/24/03
4	ASI #23	09/12/03
3	ASI #20	06/06/03
2	ASI #18	04/18/03
1	Addendum #2	11/15/02
	100% Construction Documents	09/27/02
	90% Progress Printing	08/30/02
	100% Struct./ CD Progress	07/01/02
	100% Steel & Concrete CD	05/15/02
	& Architectural CD Progress	
	100% Design Development	03/01/02
	Issue	Date

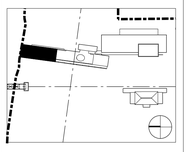


Job No.
9908

Scale
1/8" = 1'-0"

Date
September 27, 2002

Title
MUSEUM
UPPER LEVEL
PARTIAL REFLECTED
CEILING PLAN

Sheet No.
A604a

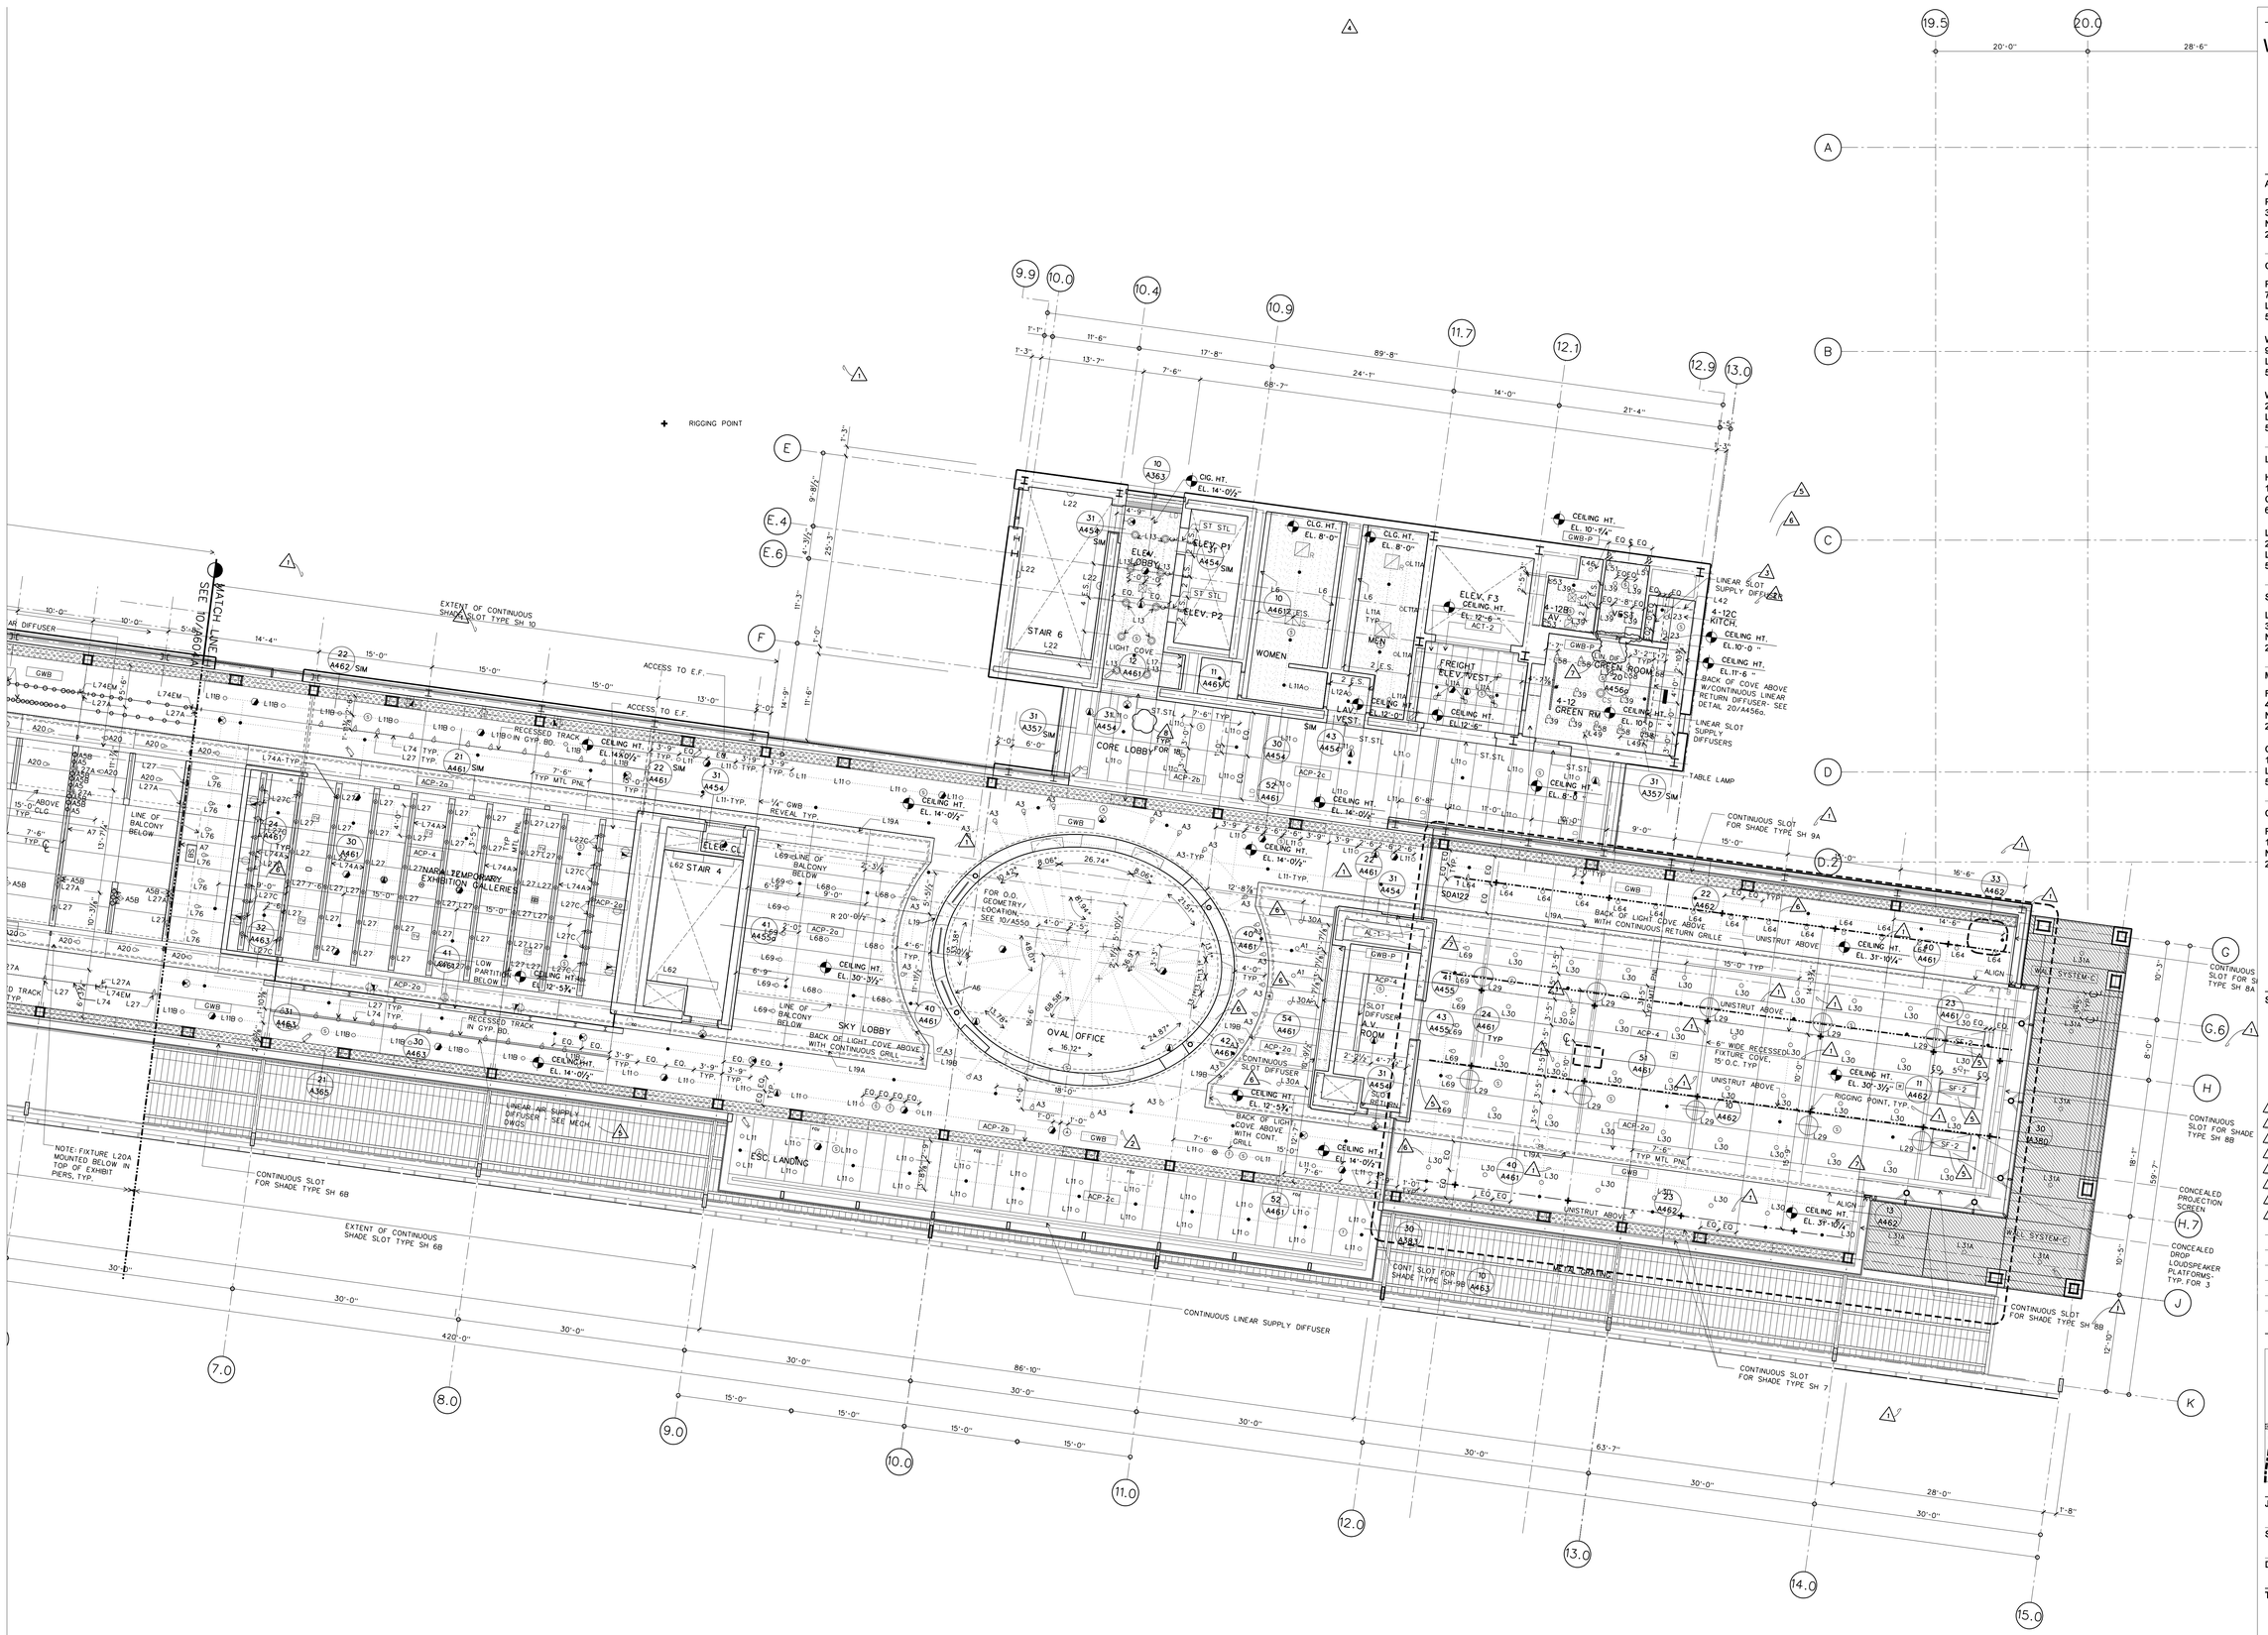

UPPER MUSEUM LEVEL REFLECTED CEILING PLAN B

SCALE: 1/8" = 1'-0"

RCP-04.DGN

10

WILLIAM J. CLINTON PRESIDENTIAL CENTER

LITTLE ROCK, ARKANSAS

Architect

POLSHEK PARTNERSHIP LLP
320 West 13th Street
New York, New York 10014
212.807.7171

Coordinating Architects

POLK STANLEY YEARY ARCHITECTS Ltd
700 South Schiller Street
Little Rock, Arkansas 72201
501.378.0878

WITSELL EVANS RASCO
901 West Third Street
Little Rock, Arkansas 72201
501.374.5300

WOODS CARADINE ARCHITECTS
2200 South Main Street
Little Rock, Arkansas 72206
501.374.4060

Landscape Architects

HARGREAVES ASSOCIATES
118 Magazine Street
Cambridge, Massachusettes 02139
617.661.0070

LANDSCAPE ARCHITECTURE, Inc.
2300 Cottondale Lane Suite 202
Little Rock, Arkansas 72202
501.374.5610

Structural Engineer

LESLIE E. ROBERTSON ASSOC., RLLP
30 Broad Street, 47th Floor
New York, New York 10004
212.750.9000

MEP Engineers

FLACK + KURTZ Inc.
475 Fifth Avenue
New York, New York 10017
212.532.9600

CROMWELL ARCHITECTS ENGINEERS
101 South Spring Street
Little Rock, Arkansas 72201
501.372.2900

Curtainwall Consultant

R. A. HEINTGES ARCHITECTS
126 Fifth Avenue, 9th Floor
New York, New York 10011
212.652-2966

Seal

7	ASI #29	03/05/04
6	ASI #25	12/19/03
5	ASI #24	10/24/03
4	ASI #23	09/12/03
3	ASI #20	06/06/03
2	ASI #18	04/18/03
1	ASI #15	02/28/03
0	Addendum #2	11/15/02
	100% Construction Documents	09/27/02
	90% Progress Printing	08/30/02
	100% Struct./ CD Progress	07/01/02
	100% Steel & Concrete CD	05/15/02
	& Architectural CD Progress	
	100% Design Development	03/01/02
	Issue	Date

Job No.
9908


Scale
1/8" = 1'-0"

Date
September 27, 2002

Title
MUSEUM
UPPER LEVEL
PARTIAL REFLECTED
CEILING PLAN

Sheet No.
A604b

FOR OFFICIAL USE ONLY

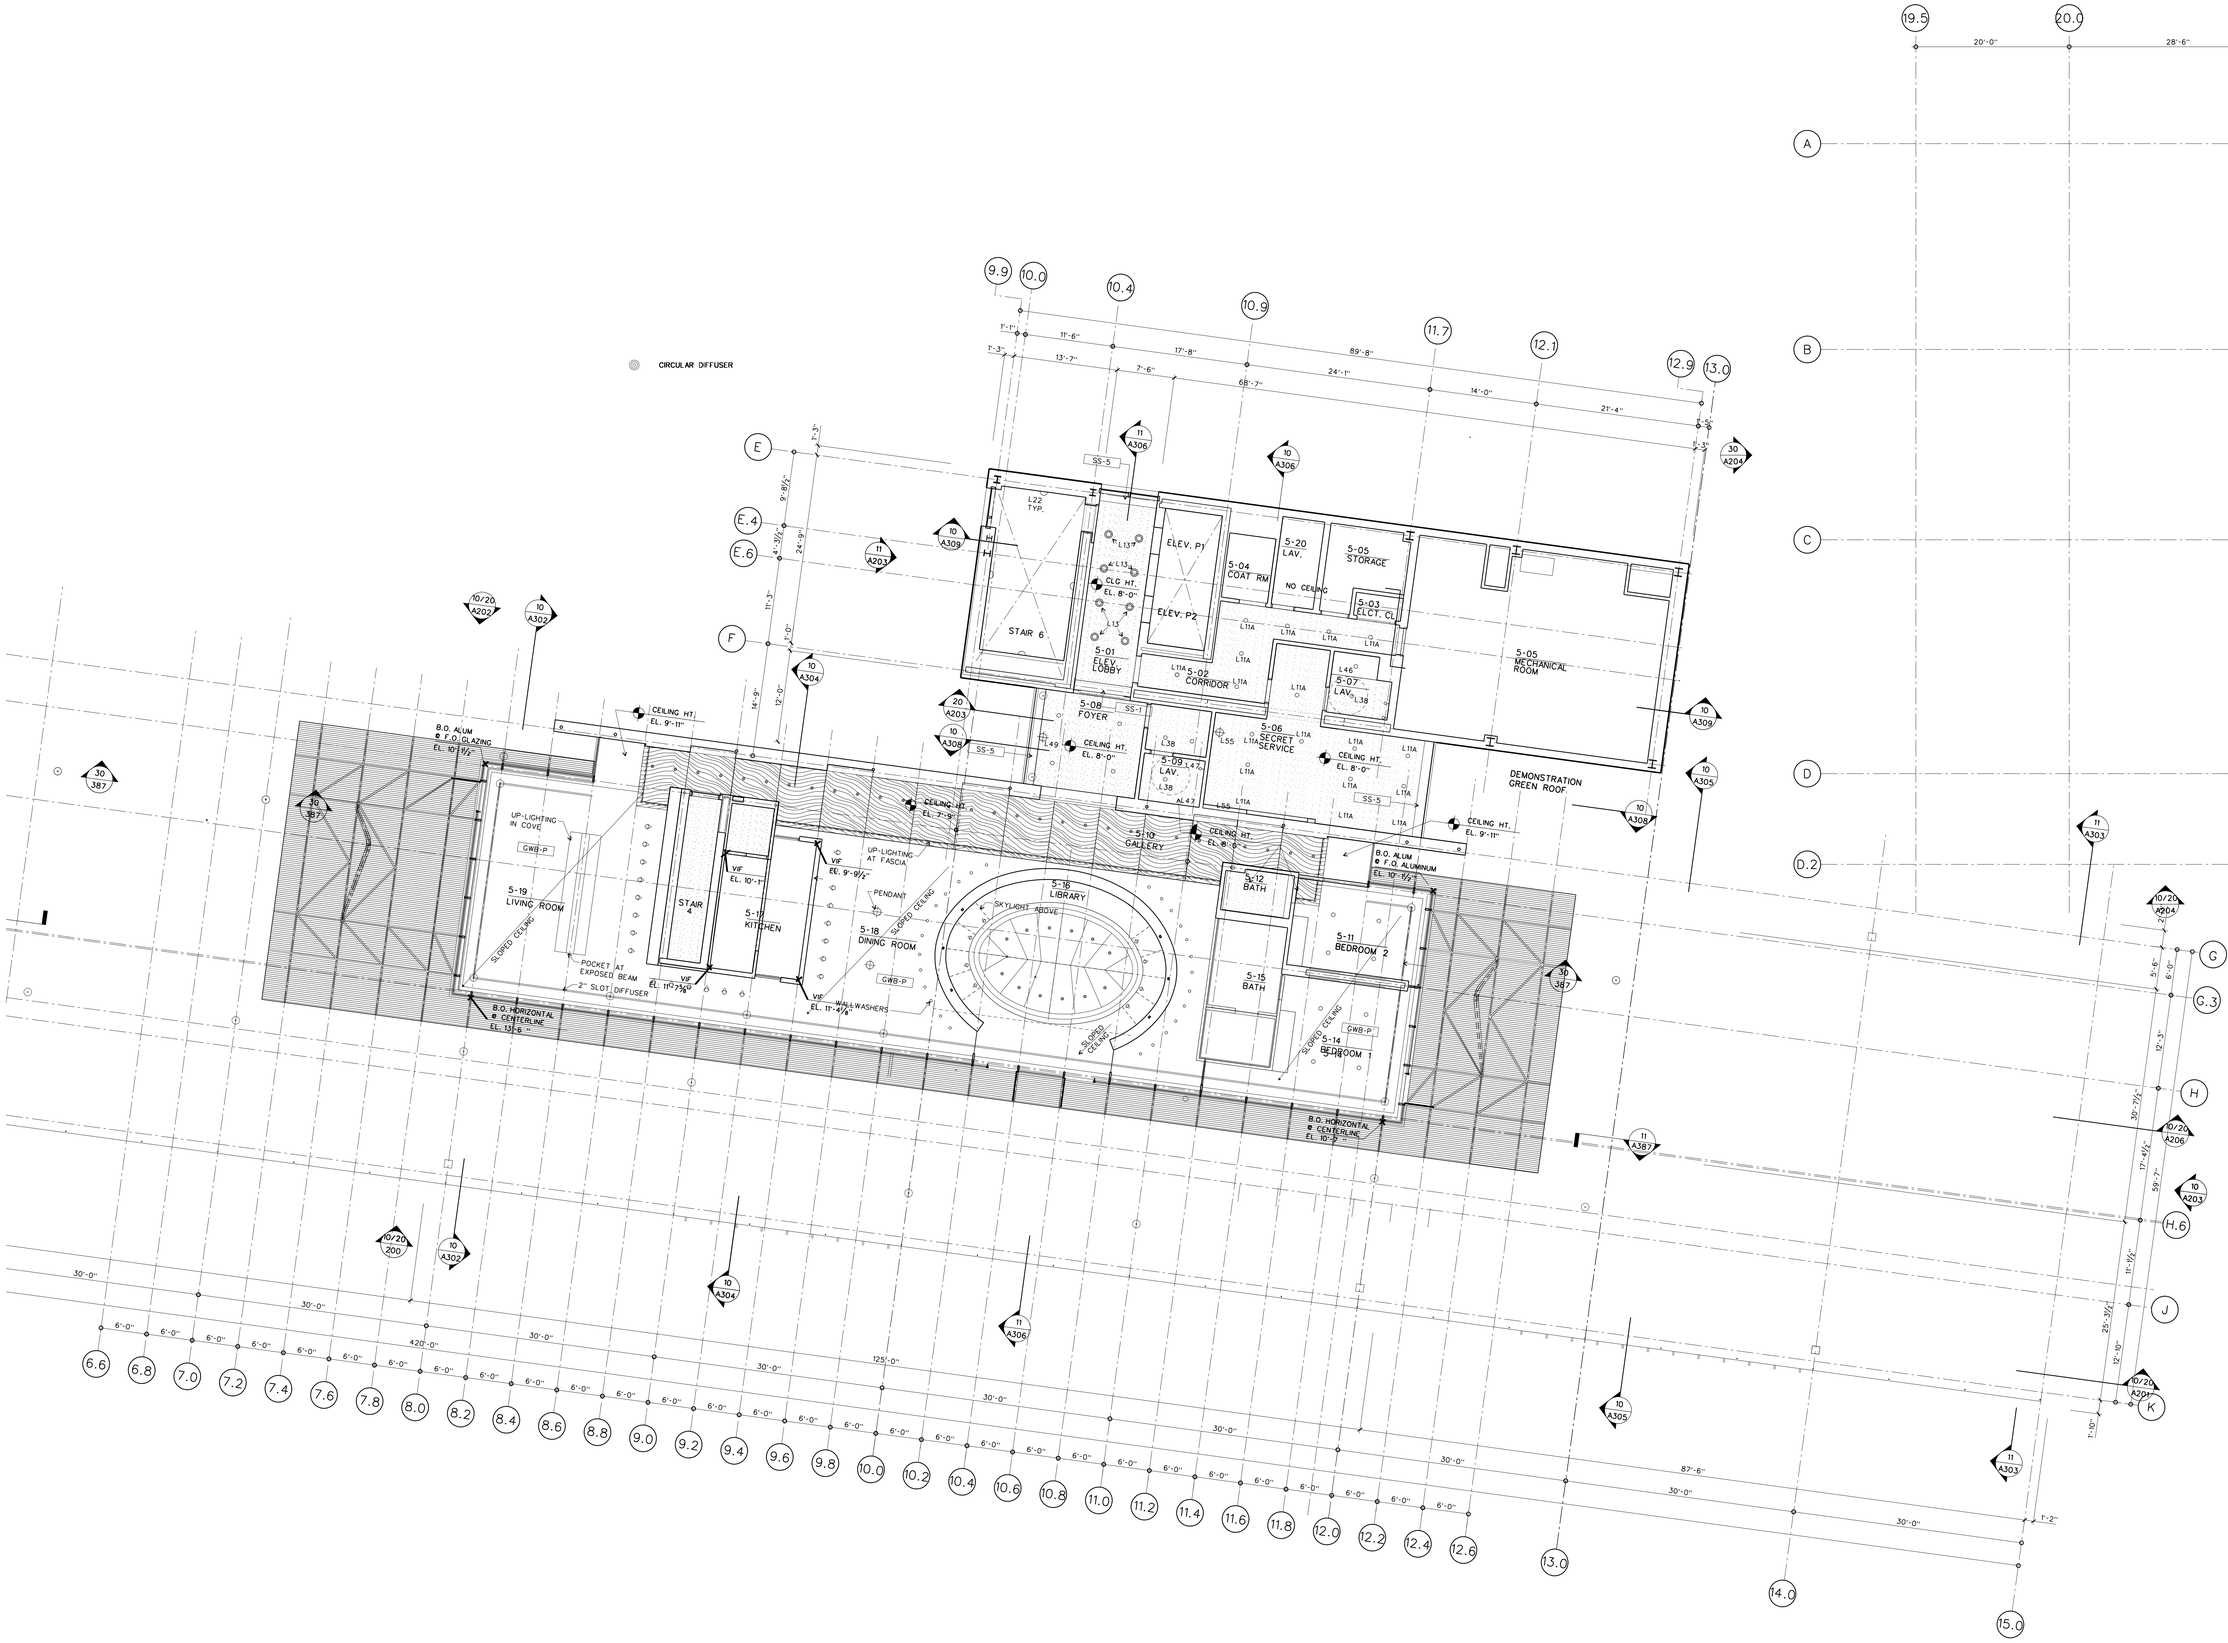

EXECUTIVE LEVEL REFLECTED CEILING PLAN

SCALE: 1/8" = 1'-0"

AFP-05.DGN

10

WILLIAM J. CLINTON PRESIDENTIAL CENTER

LITTLE ROCK, ARKANSAS

Architect

POLSHEK PARTNERSHIP LLP
320 West 13th Street
New York, New York 10014
212.807.7171

Coordinating Architects

POLK STANLEY YEARY ARCHITECTS Ltd
700 South Schiller Street
Little Rock, Arkansas 72201
501.378.0878

WITSELL EVANS RASCO
901 West Third Street
Little Rock, Arkansas 72201
501.374.5300

WOODS CARADINE ARCHITECTS
2200 South Main Street
Little Rock, Arkansas 72206
501.374.4060

Landscape Architects

HARGREAVES ASSOCIATES
118 Magazine Street
Cambridge, Massachusettes 02139
617.661.0070

LANDSCAPE ARCHITECTURE, Inc.
2300 Cottondale Lane Suite 202
Little Rock, Arkansas 72202
501.374.5610

Structural Engineer

LESLIE E. ROBERTSON ASSOC., RLLP
30 Broad Street, 47th Floor
New York, New York 10004
212.750.9000

MEP Engineers

FLACK + KURTZ Inc.
475 Fifth Avenue
New York, New York 10017
212.532.9600

CROMWELL ARCHITECTS ENGINEERS
101 South Spring Street
Little Rock, Arkansas 72201
501.372.2900

Curtainwall Consultant

R. A. HEINTGES ARCHITECTS
126 Fifth Avenue, 9th Floor
New York, New York 10011
212.652-2966

Seal

Issue	Date
100% Construction Documents	09/27/02
90% Progress Printing	08/30/02
100% Struct./ CD Progress	07/01/02
100% Steel & Concrete CD & Architectural CD Progress	05/15/02
100% Design Development	03/01/02

Job No. 9908


Scale 1/8" = 1'-0"

Date September 27, 2002

Title EXECUTIVE LEVEL REFLECTED CEILING PLAN

Sheet No. A605b

FOR OFFICIAL USE ONLY

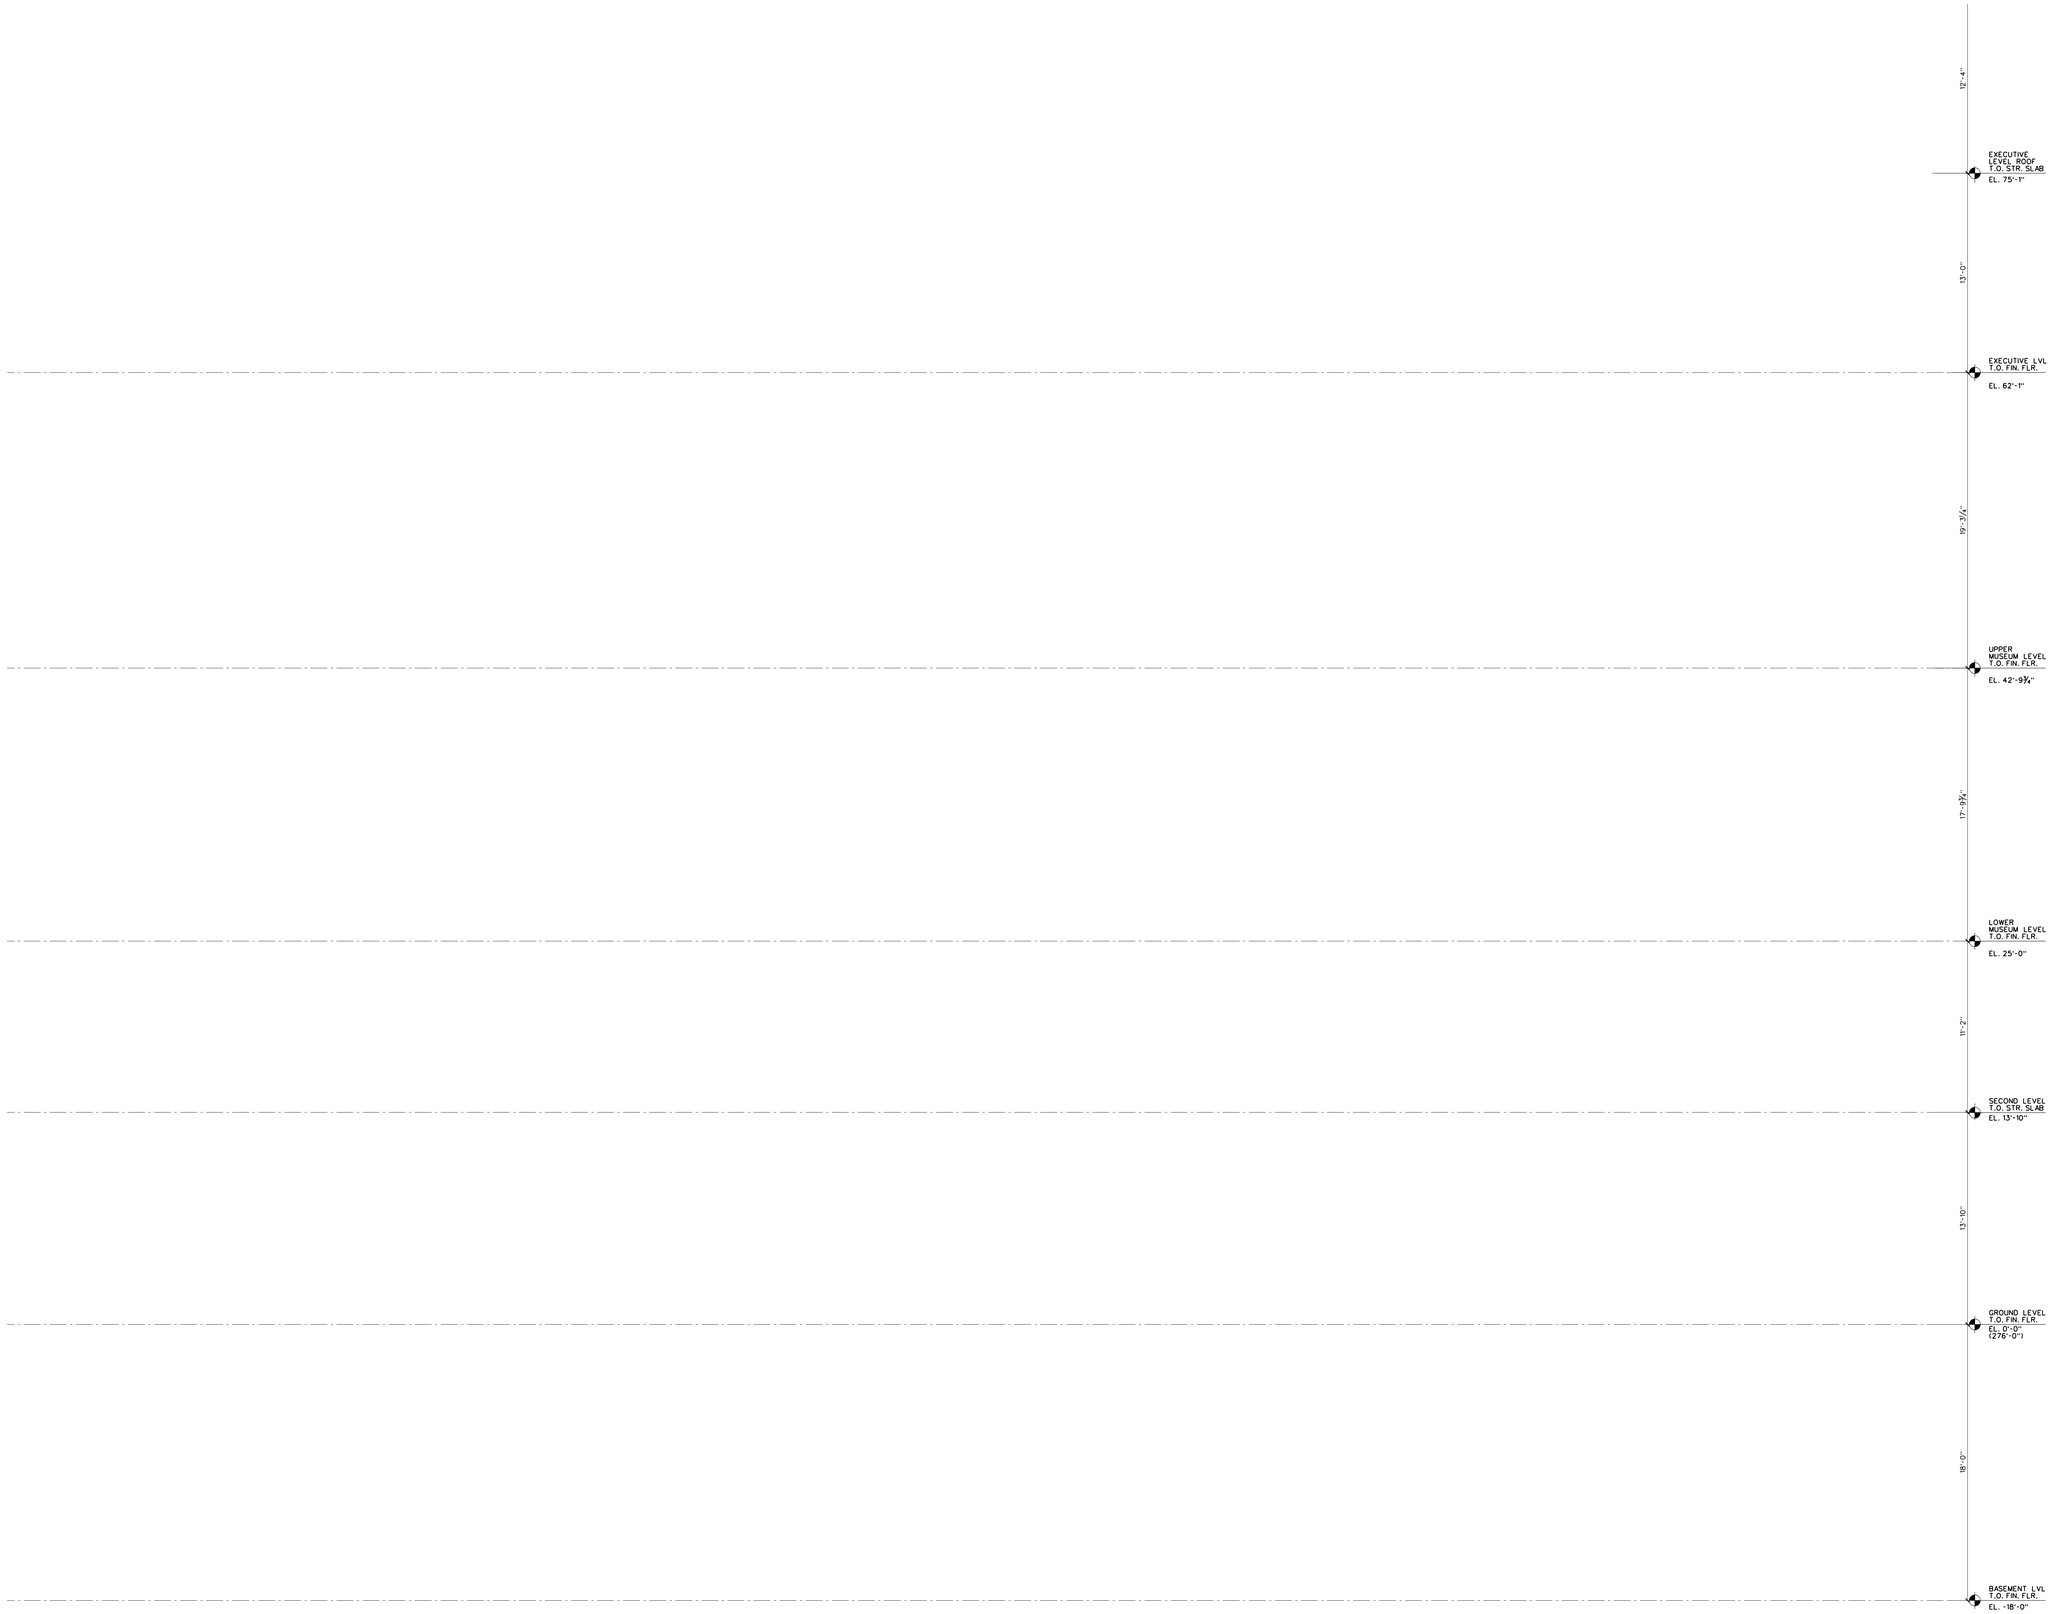

EAST WALL ELEVATION 10
SCALE: 1/4" = 1'-0" PLANS/STAIR 4

NORTH WALL ELEVATION 13
SCALE: 1/4" = 1'-0" PLANS/STAIR 4

WEST WALL ELEVATION 12
SCALE: 1/4" = 1'-0" PLANS/STAIR 4

SOUTH WALL ELEVATION 11
SCALE: 1/4" = 1'-0" PLANS/STAIR 4

WILLIAM J. CLINTON PRESIDENTIAL CENTER

LITTLE ROCK, ARKANSAS

Architect

POLSHEK PARTNERSHIP LLP
320 West 13th Street
New York, New York 10014
212.807.7171

Coordinating Architects

POLK STANLEY YEARY ARCHITECTS Ltd
700 South Schiller Street
Little Rock, Arkansas 72201
501.378.0878

WITSELL EVANS RASCO
901 West Third Street
Little Rock, Arkansas 72201
501.374.5300

WOODS CARADINE ARCHITECTS
2200 South Main Street
Little Rock, Arkansas 72206
501.374.4060

Landscape Architects

HARGREAVES ASSOCIATES
118 Magazine Street
Cambridge, Massachusettes 02139
617.661.0070

LANDSCAPE ARCHITECTURE, Inc.
2300 Cottondale Lane Suite 202
Little Rock, Arkansas 72202
501.374.5610

Structural Engineer

LESLIE E. ROBERTSON ASSOC., RLLP
30 Broad Street, 47th Floor
New York, New York 10004
212.750.9000

MEP Engineers

FLACK + KURTZ Inc.
475 Fifth Avenue
New York, New York 10017
212.532.9600


CROMWELL ARCHITECTS ENGINEERS
101 South Spring Street
Little Rock, Arkansas 72201
501.372.2900

Curtainwall Consultant

R. A. HEINTGES ARCHITECTS
126 Fifth Avenue, 9th Floor
New York, New York 10011
212.652-2966

Seal

Issue	Date
100% Construction Documents	09/27/02
90% Progress Printing	08/30/02
ASI #05	08/20/02
100% Struct./ CD Progress	07/01/02
Bridge Bldg. Substructure	06/14/02
100% Steel & Concrete CD & Architectural CD Progress	05/15/02
100% Design Development	03/01/02

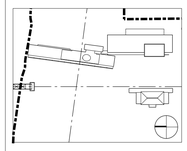

Job No.
9908

Scale
1/4"=1'-0"

Date
September 27, 2002


Title

STAIR 4 SHEAR WALL ELEVATIONS

Sheet No.

A710

FOR OFFICIAL USE ONLY

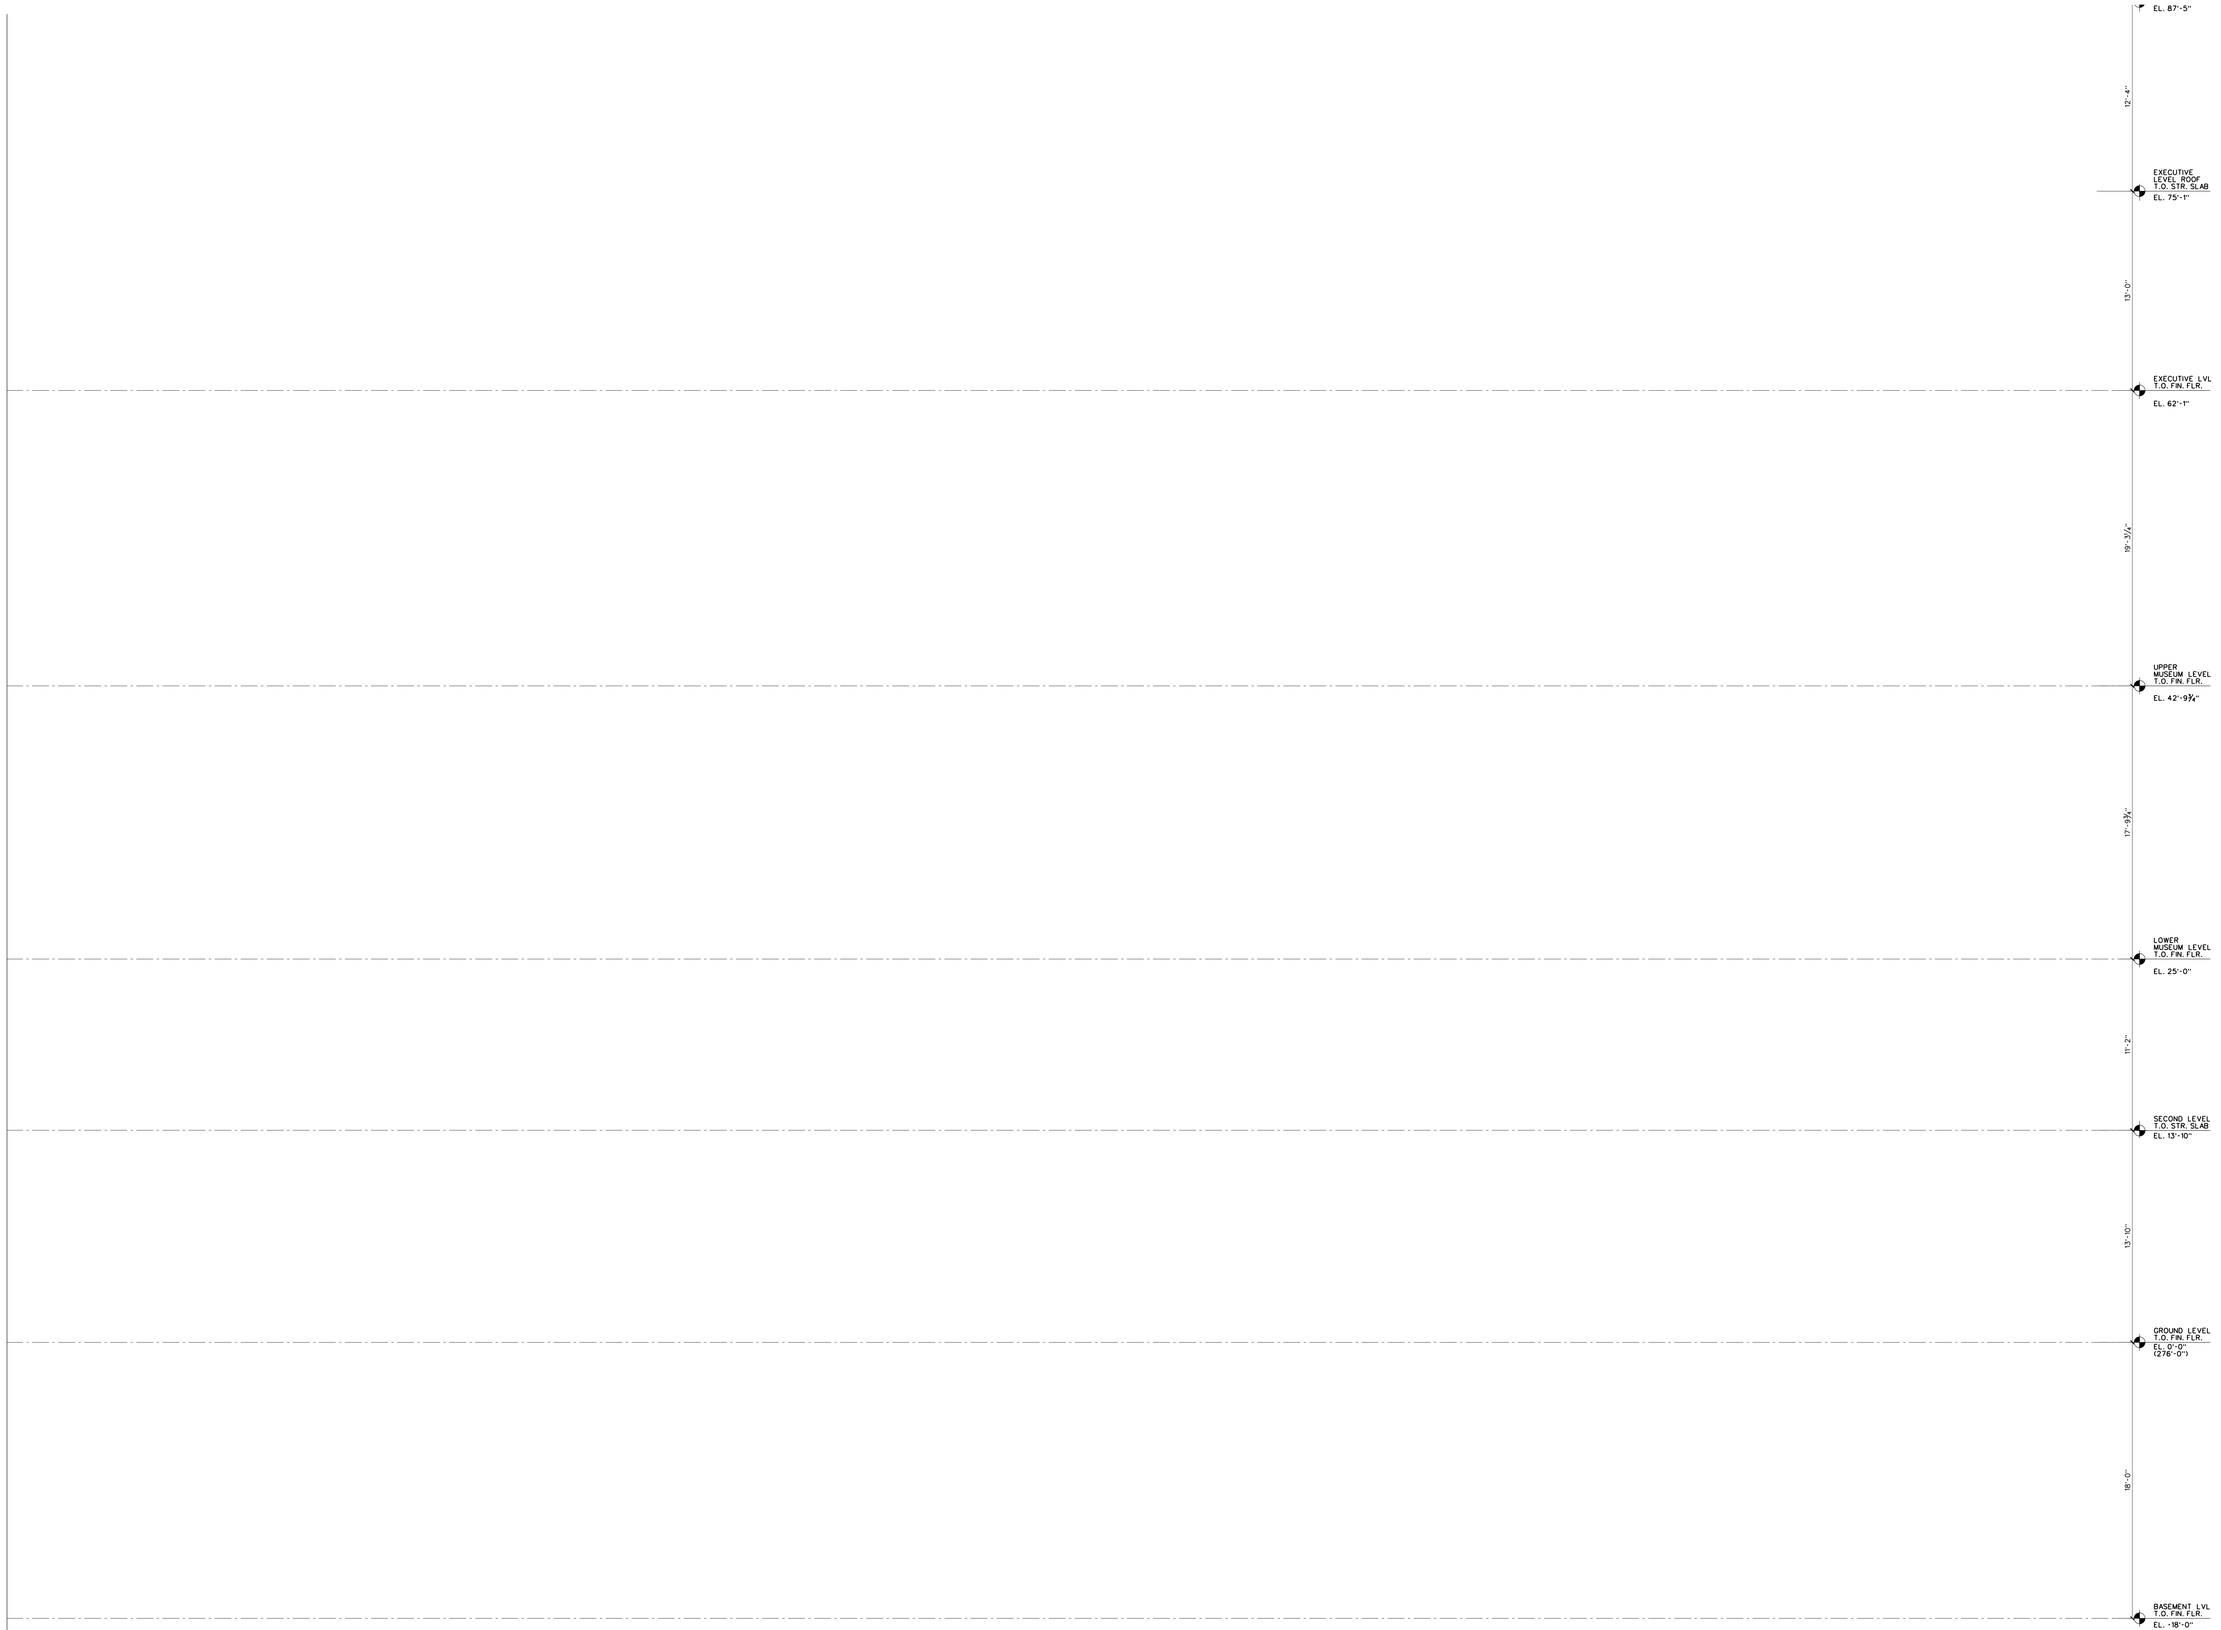

EAST ELEVATION
SCALE: 1/4" = 1'-0" PLANS/STAIR 5 13

NORTH ELEVATION
SCALE: 1/4" = 1'-0" PLANS/STAIR 5 12

WEST ELEVATION
SCALE: 1/4" = 1'-0" PLANS/STAIR 5 11

SOUTH ELEVATION
SCALE: 1/4" = 1'-0" PLANS/STAIR 5 10

WILLIAM J. CLINTON PRESIDENTIAL CENTER

LITTLE ROCK, ARKANSAS

Architect

POLSHEK PARTNERSHIP LLP
320 West 13th Street
New York, New York 10014
212.807.7171

Coordinating Architects

POLK STANLEY YEARY ARCHITECTS Ltd
700 South Schiller Street
Little Rock, Arkansas 72201
501.378.0878

WITSELL EVANS RASCO
901 West Third Street
Little Rock, Arkansas 72201
501.374.5300

WOODS CARADINE ARCHITECTS
2200 South Main Street
Little Rock, Arkansas 72206
501.374.4060

Landscape Architects

HARGREAVES ASSOCIATES
118 Magazine Street
Cambridge, Massachusettes 02139
617.661.0070

LANDSCAPE ARCHITECTURE, Inc.
2300 Cottondale Lane Suite 202
Little Rock, Arkansas 72202
501.374.5610

Structural Engineer

LESLIE E. ROBERTSON ASSOC., RLLP
30 Broad Street, 47th Floor
New York, New York 10004
212.750.9000

MEP Engineers

FLACK + KURTZ Inc.
475 Fifth Avenue
New York, New York 10017
212.532.9600


CROMWELL ARCHITECTS ENGINEERS
101 South Spring Street
Little Rock, Arkansas 72201
501.372.2900

Curtainwall Consultant

R. A. HEINTGES ARCHITECTS
126 Fifth Avenue, 9th Floor
New York, New York 10011
212.652-2966

Seal

Issue	Date
100% Construction Documents	09/27/02
90% Progress Printing	08/30/02
ASI #05	08/20/02
100% Struct./ CD Progress	07/01/02
Bridge Bldg. Substructure	06/14/02
100% Steel & Concrete CD	05/15/02
& Architectural CD Progress	
100% Design Development	03/01/02

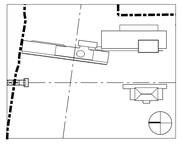

Job No. 9908

Scale 1/4" = 1'-0"

Date September 27, 2002


Title

STAIR 5
SHEAR WALL
ELEVATIONS

Sheet No.

A711

FOR OFFICIAL USE ONLY

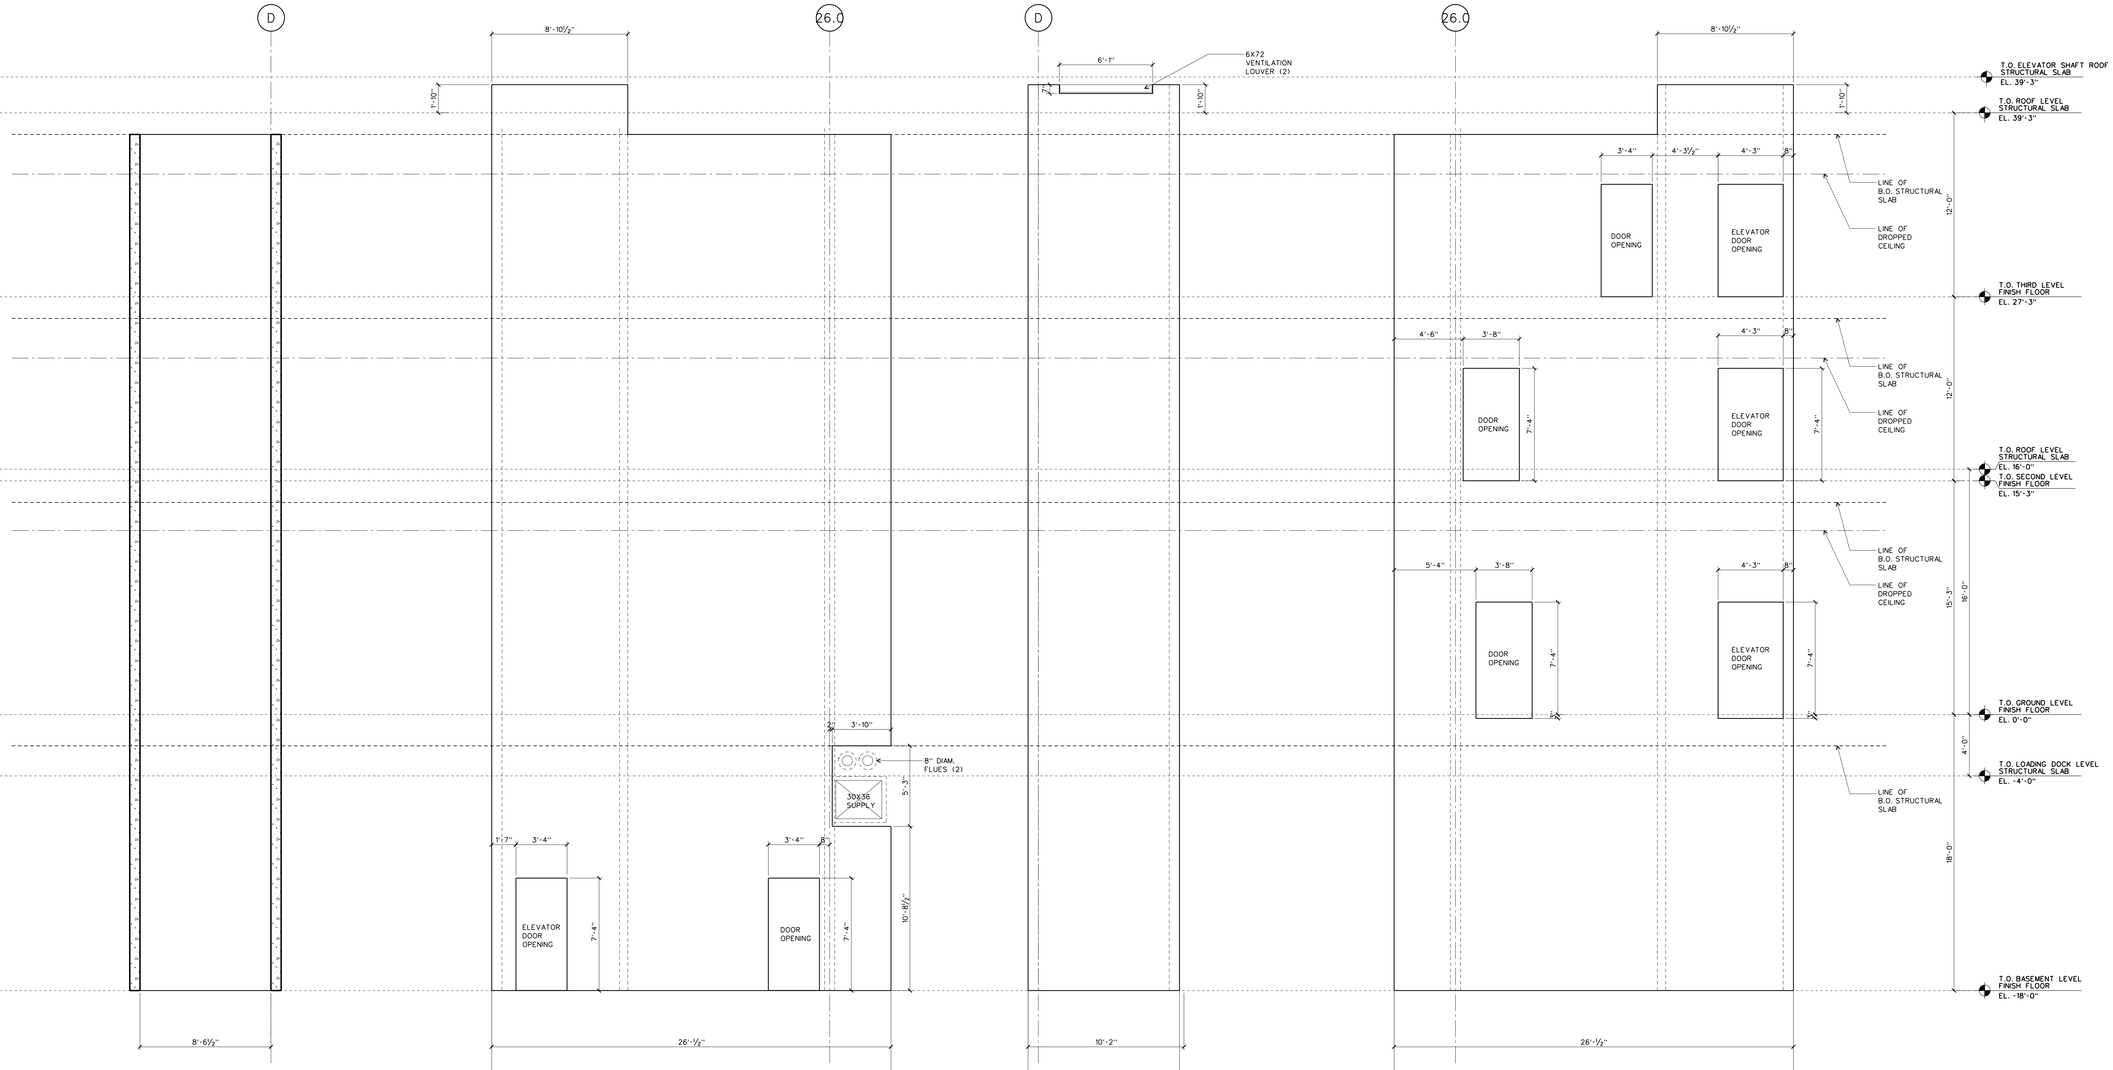

NORTH WALL ELEVATION
SCALE: ¼" = 1'-0" PLANS/STAIR 10 10

EAST WALL ELEVATION
SCALE: ¼" = 1'-0" PLANS/STAIR 10 13

SOUTH WALL ELEVATION
SCALE: ¼" = 1'-0" PLANS/STAIR 10 12

WEST WALL ELEVATION
SCALE: ¼" = 1'-0" PLANS/STAIR 10 11

WILLIAM J. CLINTON PRESIDENTIAL CENTER

LITTLE ROCK, ARKANSAS

Architect

POLSHEK PARTNERSHIP LLP
320 West 13th Street
New York, New York 10014
212.807.7171

Coordinating Architects

POLK STANLEY YEARY ARCHITECTS Ltd
700 South Schiller Street
Little Rock, Arkansas 72201
501.378.0878

WITSELL EVANS RASCO
901 West Third Street
Little Rock, Arkansas 72201
501.374.5300

WOODS CARADINE ARCHITECTS
2200 South Main Street
Little Rock, Arkansas 72206
501.374.4060

Landscape Architects

HARGREAVES ASSOCIATES
118 Magazine Street
Cambridge, Massachusettes 02139
617.661.0070

LANDSCAPE ARCHITECTURE, Inc.
2300 Cottondale Lane Suite 202
Little Rock, Arkansas 72202
501.374.5610

Structural Engineer

LESLIE E. ROBERTSON ASSOC., RLLP
30 Broad Street, 47th Floor
New York, New York 10004
212.750.9000

MEP Engineers

FLACK + KURTZ Inc.
475 Fifth Avenue
New York, New York 10017
212.532.9600


CROMWELL ARCHITECTS ENGINEERS
101 South Spring Street
Little Rock, Arkansas 72201
501.372.2900

Curtainwall Consultant

R. A. HEINTGES ARCHITECTS
126 Fifth Avenue, 9th Floor
New York, New York 10011
212.652-2966

Seal

Issue	Date
100% Construction Documents	09/27/02
90% Progress Printing	08/30/02
ASI #05	08/20/02
100% Struct./ CD Progress	07/01/02
Bridge Bldg. Substructure	06/14/02
100% Steel & Concrete CD	05/15/02
& Architectural CD Progress	
100% Design Development	03/01/02

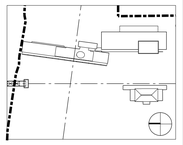

Job No.
9908

Scale
1/4"=1'-0"


Date
September 27, 2002

Title

STAIR 10 SHEAR WALL ELEVATIONS

Sheet No.
A720

FOR OFFICIAL USE ONLY

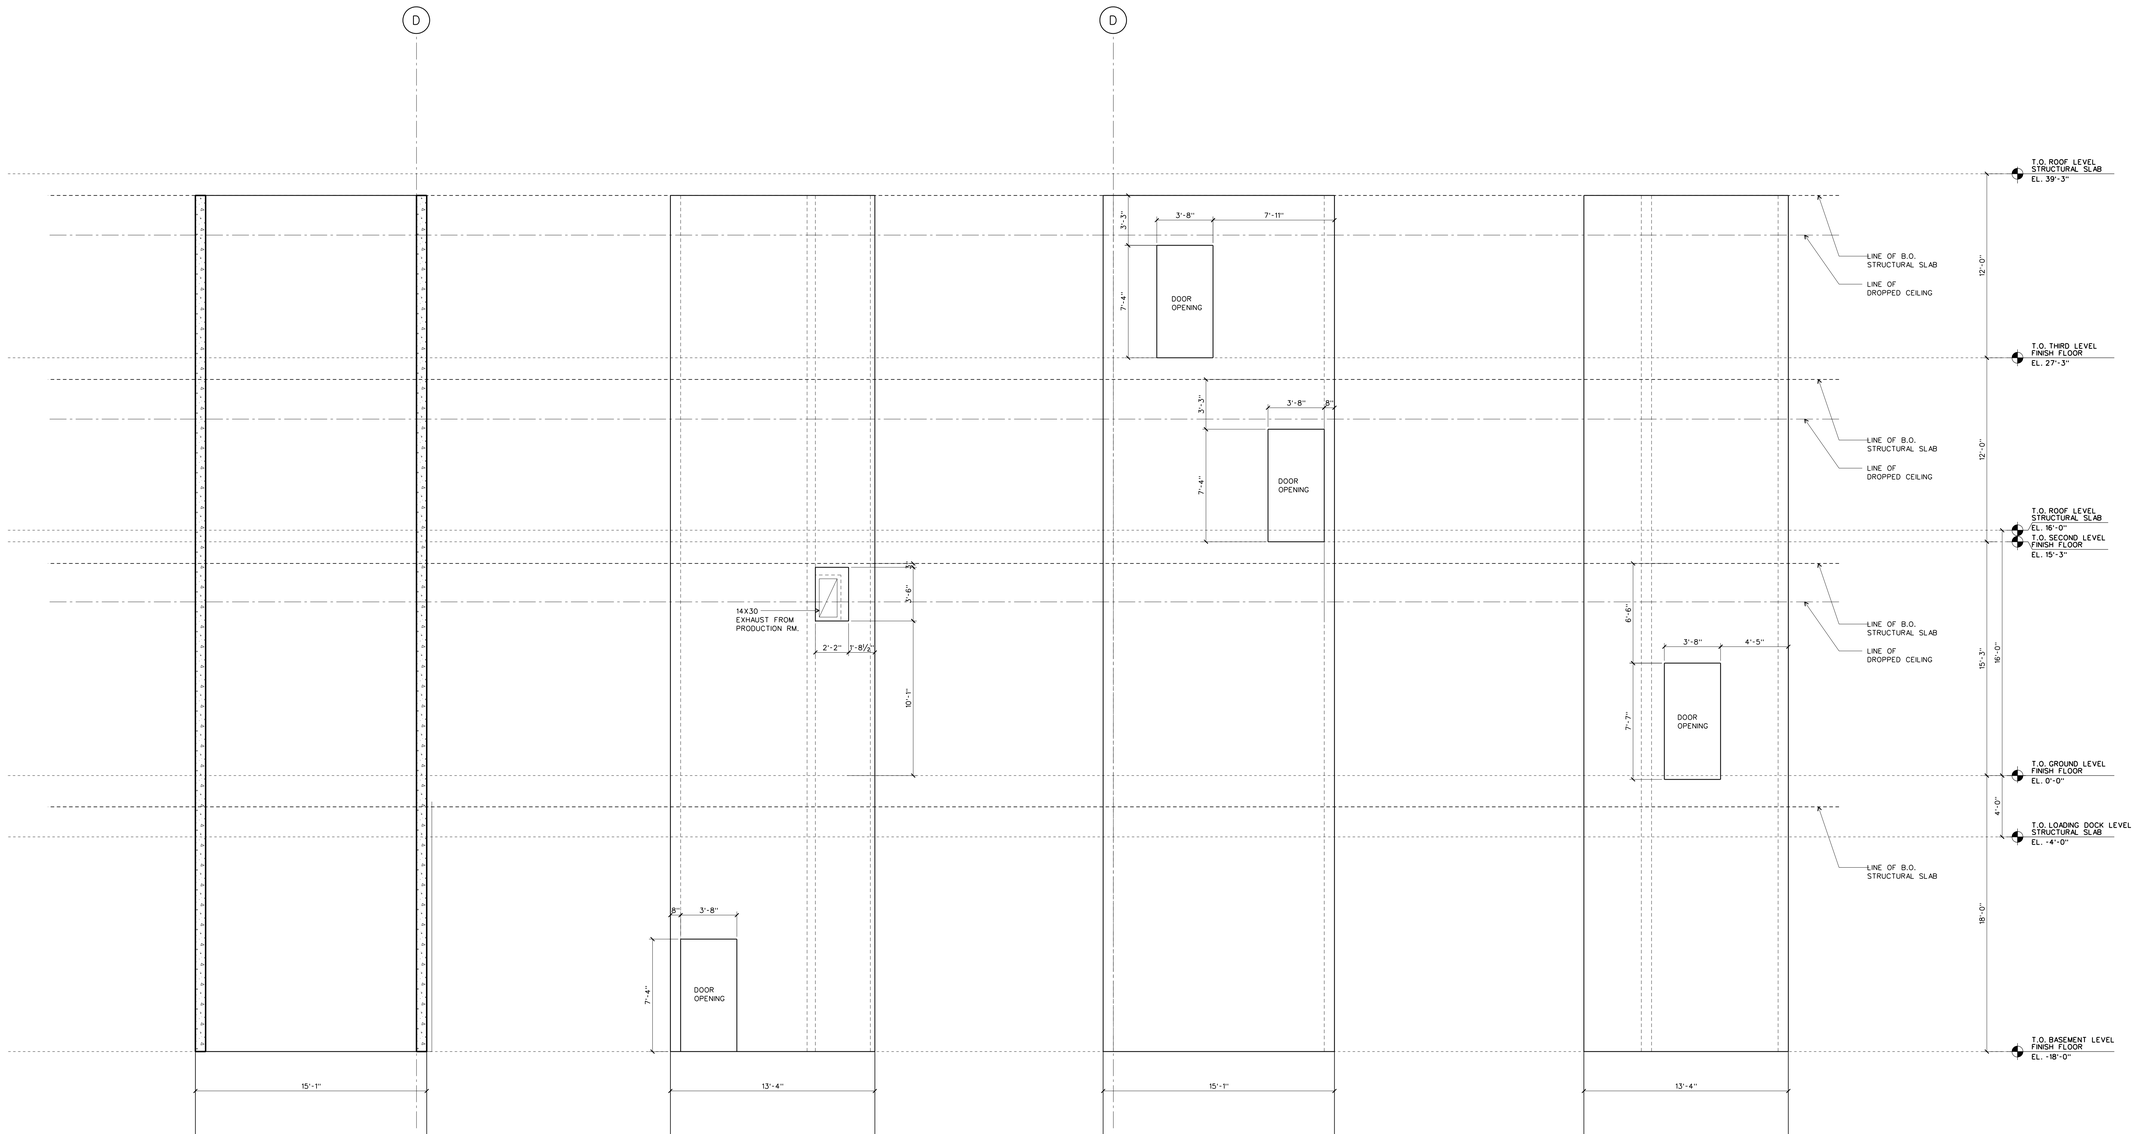

NORTH WALL ELEVATION
SCALE: ¼" = 1'-0" PLANS/STAIR 11 10

EAST WALL ELEVATION
SCALE: ¼" = 1'-0" PLANS/STAIR 11 13

SOUTH WALL ELEVATION
SCALE: ¼" = 1'-0" PLANS/STAIR 11 12

WEST WALL ELEVATION
SCALE: ¼" = 1'-0" PLANS/STAIR 11 11

WILLIAM J. CLINTON PRESIDENTIAL CENTER

LITTLE ROCK, ARKANSAS

Architect

POLSHEK PARTNERSHIP LLP
320 West 13th Street
New York, New York 10014
212.807.7171

Coordinating Architects

POLK STANLEY YEARY ARCHITECTS Ltd
700 South Schiller Street
Little Rock, Arkansas 72201
501.378.0878

WITSELL EVANS RASCO
901 West Third Street
Little Rock, Arkansas 72201
501.374.5300

WOODS CARADINE ARCHITECTS
2200 South Main Street
Little Rock, Arkansas 72206
501.374.4060

Landscape Architects

HARGREAVES ASSOCIATES
118 Magazine Street
Cambridge, Massachusettes 02139
617.661.0070

LANDSCAPE ARCHITECTURE, Inc.
2300 Cottondale Lane Suite 202
Little Rock, Arkansas 72202
501.374.5610

Structural Engineer

LESLIE E. ROBERTSON ASSOC., RLLP
30 Broad Street, 47th Floor
New York, New York 10004
212.750.9000

MEP Engineers

FLACK + KURTZ Inc.
475 Fifth Avenue
New York, New York 10017
212.532.9600


CROMWELL ARCHITECTS ENGINEERS
101 South Spring Street
Little Rock, Arkansas 72201
501.372.2900

Curtainwall Consultant

R. A. HEINTGES ARCHITECTS
126 Fifth Avenue, 9th Floor
New York, New York 10011
212.652-2966

Seal

Issue	Date
100% Construction Documents	09/27/02
90% Progress Printing	08/30/02
ASI #05	08/20/02
100% Struct./ CD Progress	07/01/02
Bridge Bldg. Substructure	06/14/02
100% Steel & Concrete CD	05/15/02
& Architectural CD Progress	
100% Design Development	03/01/02

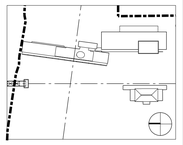

Job No. 9908

Scale 1/4"=1'-0"

Date September 27, 2002

Title

STAIR 11 SHEAR WALL ELEVATIONS

Sheet No.

A721

FOR OFFICIAL USE ONLY