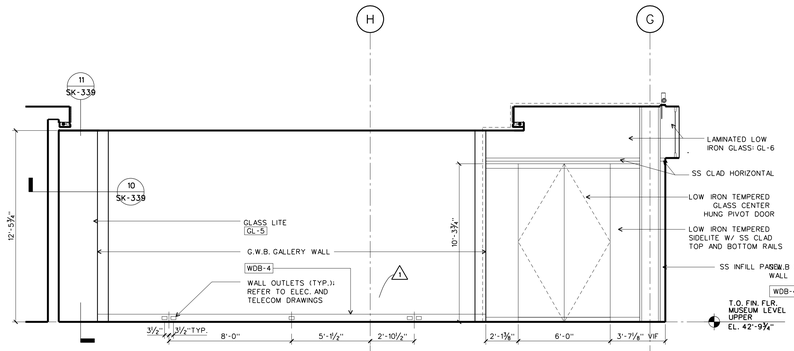

4-03 NARA TEMPORARY EXHIB. GALLERY: SOUTH ELEVATION 31

base/elev/b-inel31.dgn

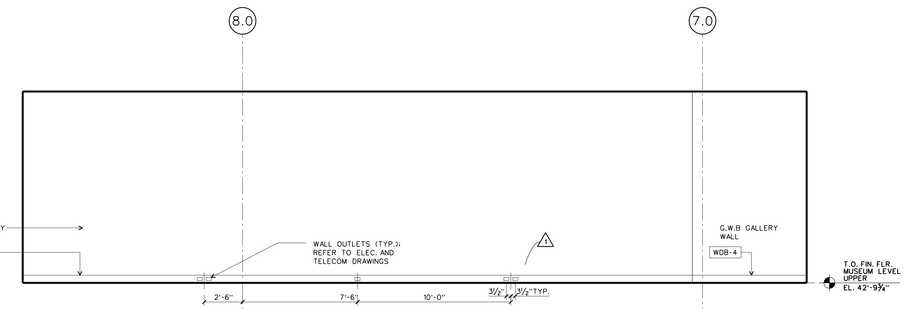

4-03 NARA TEMPORARY EXHIB. GALLERY: EAST ELEVATION 30

base/elev/b-inel31.dgn

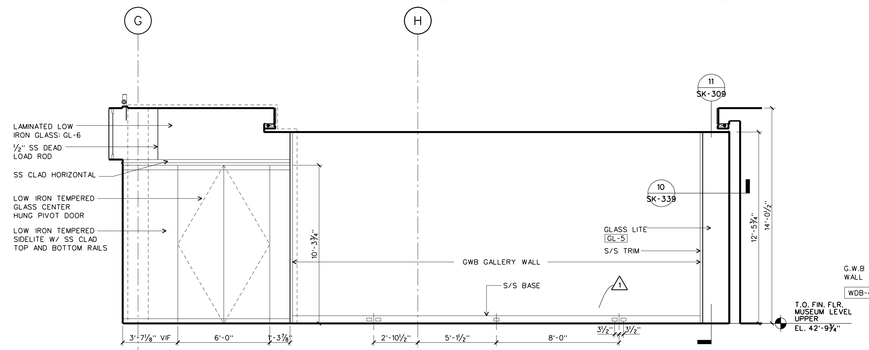

4-03 NARA TEMPORARY EXHIB. GALLERY: SOUTH ELEVATION 31

base/elev/b-inel31.dgn

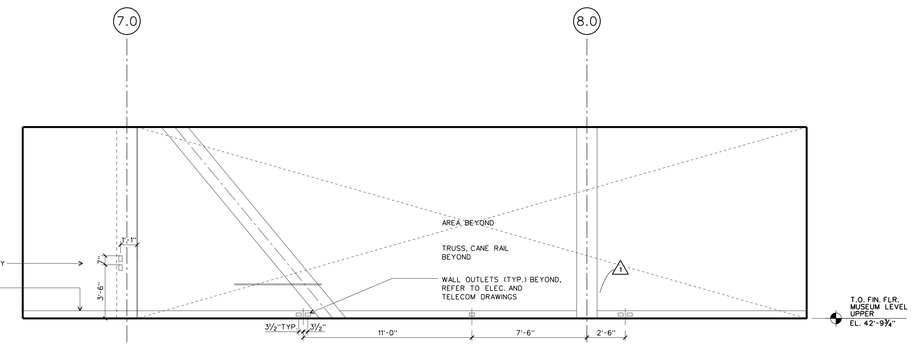

4-03 NARA TEMPORARY EXHIB. GALLERY: EAST ELEVATION 30

base/elev/b-inel31.dgn

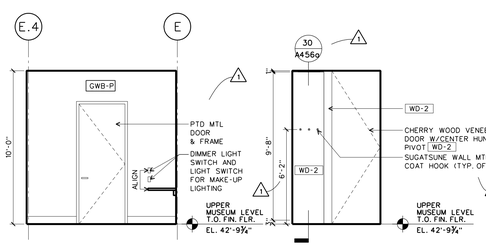

4-12A VESTIBULE : NORTH ELEV. 27

base/elev/b-inel30.dgn

4-12A VESTIBULE : WEST ELEV. 26

base/elev/b-inel30.dgn

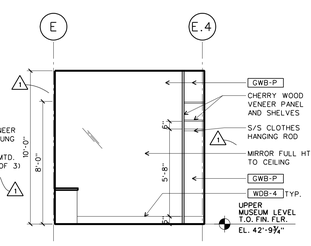

4-12A VESTIBULE : SOUTH ELEV. 25

base/elev/b-inel30.dgn

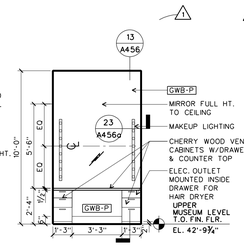

4-12A VESTIBULE : EAST ELEV. 24

base/elev/b-inel30.dgn

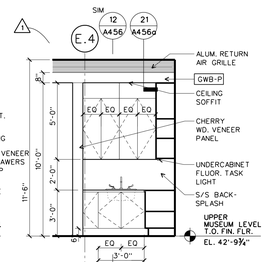

4-12C KITCHEN : NORTH ELEV. 23

base/elev/b-inel30.dgn

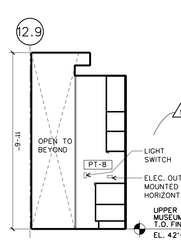

4-12C KITCHEN : WEST ELEV. 22

base/elev/b-inel30.dgn

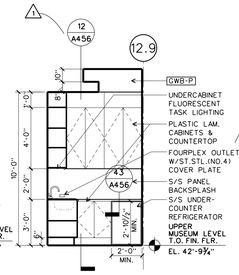

4-12C KITCHEN : EAST ELEV. 21

base/elev/b-inel30.dgn

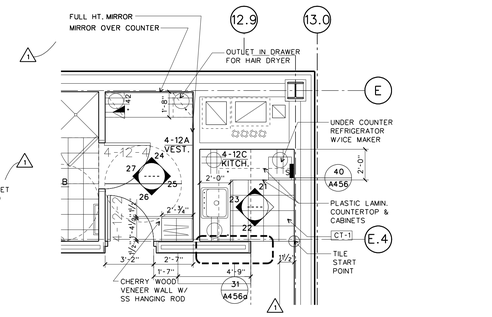

4-12A VESTIBULE AND 4-12C KITCHEN ENLARGED FLOOR PLAN

base/elev/b-inel30.dgn

NOTES:

- COAT HOOK - SUGATSUNE #DSH-01 SATIN FINISH
- CABINET DOOR PULLS - #DS30/S SATIN FINISH
- KITCHEN SINK - ELKAY DLR-1919-10
- KITCHEN FAUCET - ELKAY LK-4101
- REFRIGERATOR - SUB-ZERO 249FFI

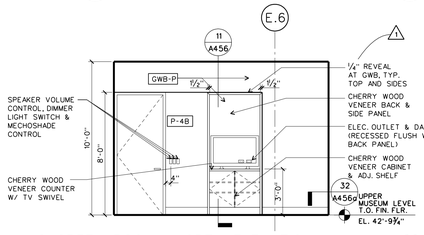

4-12 GREEN ROOM : NORTH ELEVATION 13

base/elev/b-inel30.dgn

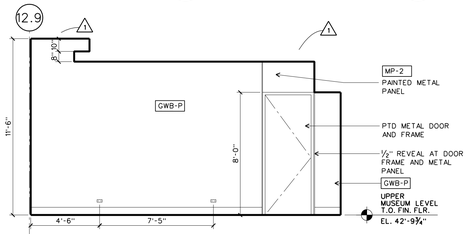

4-12 GREEN ROOM: WEST ELEVATION 12

base/elev/b-inel30.dgn

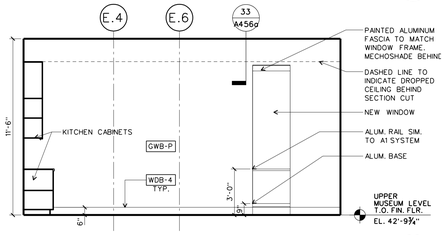

4-12 GREEN ROOM : SOUTH ELEVATION 11

base/elev/b-inel30.dgn

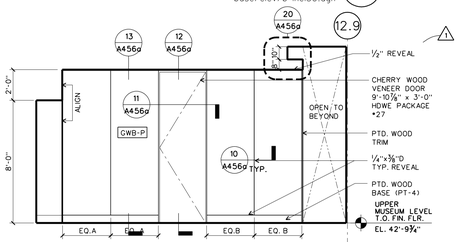

4-12 GREEN ROOM: EAST ELEVATION 10

base/elev/b-inel30.dgn

WILLIAM J. CLINTON PRESIDENTIAL CENTER

LITTLE ROCK, ARKANSAS

Architect

POLSHEK PARTNERSHIP LLP
320 West 13th Street
New York, New York 10014
212.807.7171

Coordinating Architects

POLK STANLEY YEARY ARCHITECTS Ltd
700 South Schiller Street
Little Rock, Arkansas 72201
501.378.0878

WITSELL EVANS RASCO
901 West Third Street
Little Rock, Arkansas 72201
501.374.5300

WOODS CARADINE ARCHITECTS
2200 South Main Street
Little Rock, Arkansas 72206
501.374.4060

Landscape Architects

HARGREAVES ASSOCIATES
118 Magazine Street
Cambridge, Massachusettes 02139
617.661.0070

LANDSCAPE ARCHITECTURE, Inc.
2300 Cottondale Lane Suite 202
Little Rock, Arkansas 72202
501.374.5610

Structural Engineer

LESLIE E. ROBERTSON ASSOC., RLLP
30 Broad Street, 47th Floor
New York, New York 10004
212.750.9000

MEP Engineers

FLACK + KURTZ Inc.
475 Fifth Avenue
New York, New York 10017
212.532.9600

CROMWELL ARCHITECTS ENGINEERS
101 South Spring Street
Little Rock, Arkansas 72201
501.372.2900

Curtainwall Consultant

R. A. HEINTGES ARCHITECTS
126 Fifth Avenue, 9th Floor
New York, New York 10011
212.652-2966

Seal

Issue	Date
1 ASI #24	10/24/03
ASI #23	09/12/03

Job No. 9908

Scale 1/4" = 1'-0"

Date September 27, 2002

Title

MUSEUM BUILDING INTERIOR ELEVATIONS:

Sheet No. SDA-132

A414a

FOR OFFICIAL USE ONLY