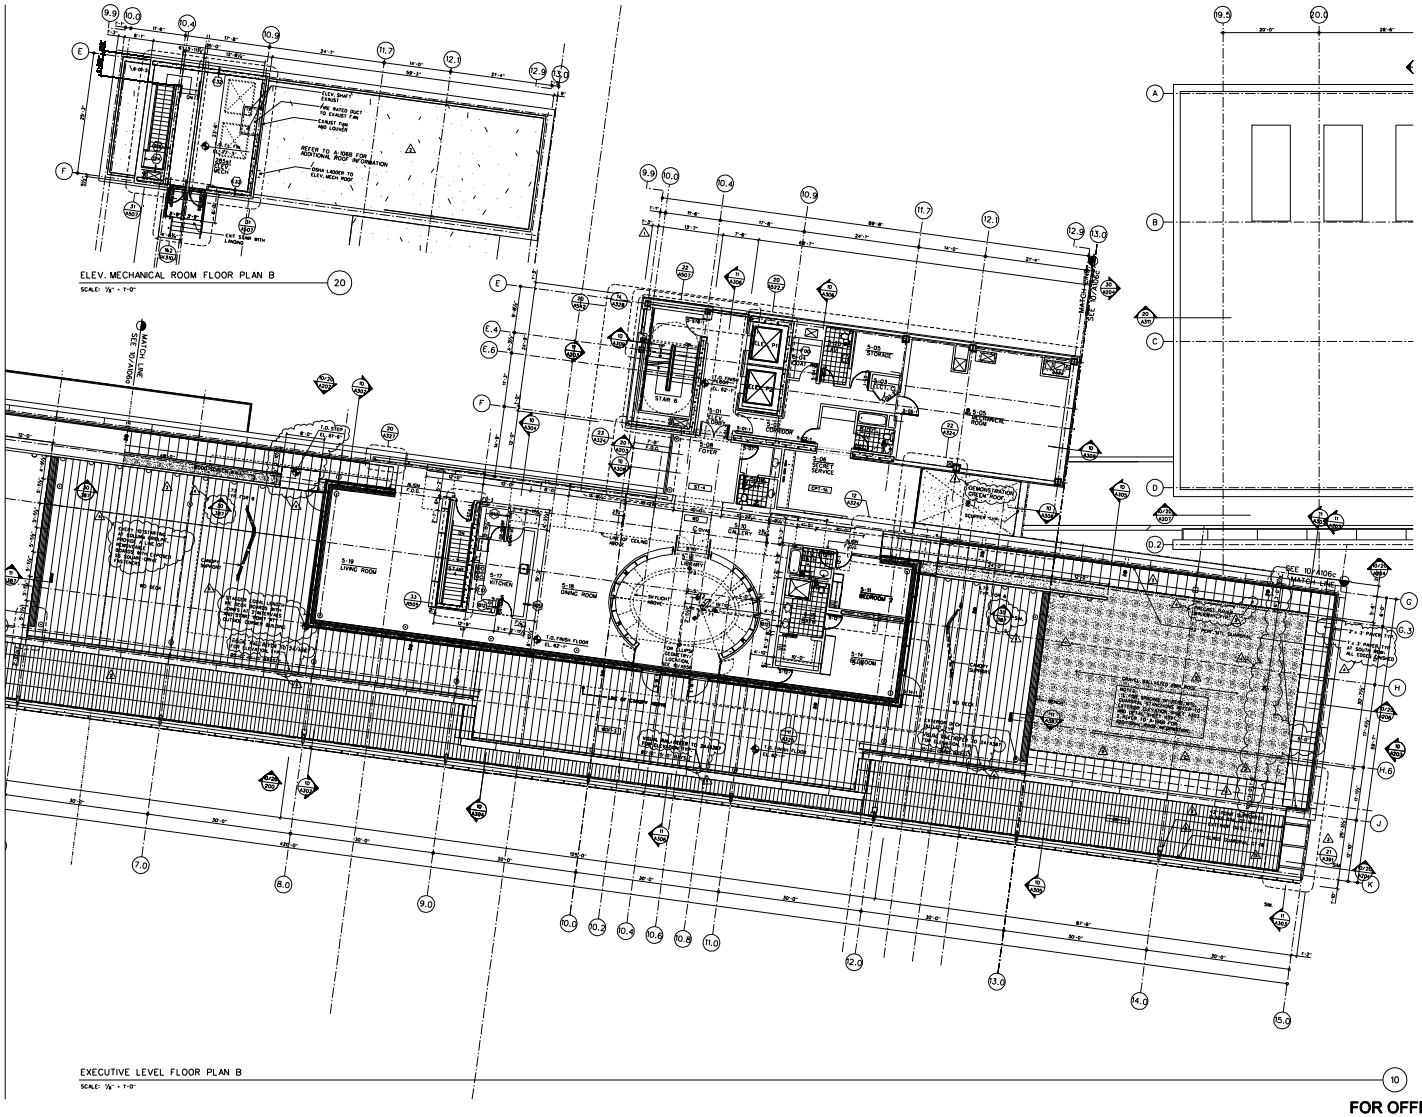

WILLIAM J. CLINTON PRESIDENTIAL CENTER

LITTLE ROCK, ARKANSAS

Architect

POLSHEK PARTNERSHIP LLP
320 West 13th Street
New York, New York 10014
212.807.7171

Coordinating Architects

POLK STANLEY YEARY ARCHITECTS Ltd
700 South Schiller Street
Little Rock, Arkansas 72201
501.375.0979

WITSELL EVANS RADCO
501 West Third Street
Little Rock, Arkansas 72201
501.374.5500

WOODS CARADINE ARCHITECTS
2300 South Main Street
Little Rock, Arkansas 72206
501.374.4669

Landscape Architects

HARGREAVES ASSOCIATES
116 Magazine Street
Cambridge, Massachusetts 02139
617.661.5070

LANDSCAPE ARCHITECTURE, Inc.
2300 Colonnade Lane Suite 302
Little Rock, Arkansas 72202
501.374.5010

Structural Engineer

LESLIE E. ROBERTSON ASSOC., RLLP
30 Broad Street, 47th Floor
New York, New York 10004
212.750.9000

MEP Engineers

FLACK + KURTZ Inc.
475 Fifth Avenue
New York, New York 10017
212.532.2600

CROMWELL ARCHITECTS ENGINEERS
101 South Spring Street
Little Rock, Arkansas 72201
501.372.3900

Curtainwall Consultant

R. A. HEINTGES ARCHITECTS
135 Fifth Avenue, 5th Floor
New York, New York 10011
212.852-3200

Seal

Issue	Date
AIS #30	09/26/01
AIS #33	02/25/02
AIS #10	04/18/02
Addendum #3	11/15/02
100% Construction Documents	05/27/02
50% Progress Pricing	08/26/02
100% Shell / CD Progress	02/14/03
100% Shell & Concrete CD	05/16/03
S. Architectural CD Progress	
100% Design Development Issue	10/01/02

Date

Job No. 0009

Scale 1/8" = 1'-0"

Date September 27, 2002

Title

EXECUTIVE LEVEL PARTIAL PLAN

Sheet No.

A105b

FOR OFFICIAL USE ONLY