

**WILLIAM J CLINTON
PRESIDENTIAL
CENTER**

LITTLE ROCK, ARKANSAS

Architect
POLSHEK PARTNERSHIP LLP
320 West 13th Street
New York, New York 10014
212 807 7171

Coordinating Architects
POLK STANLEY YEARY ARCHITECTS LTD
700 South Schiller Street
Little Rock, Arkansas 72201
501 378 0878

WITSELL EVANS RASCO
201 West Third Street
Little Rock, Arkansas 72201
501 374 5300

WOODS CARADINE ARCHITECTS
2200 South Main Street
Little Rock, Arkansas 72208
501 374 4060

Landscape Architects
HARGREAVES ASSOCIATES
118 Magazine Street
Cambridge Massachusetts 02139
617 861 0070

LANDSCAPE ARCHITECTURE, Inc.
2300 Cottondale Lane Suite 202
Little Rock Arkansas 72202
501 374 5610

Structural Engineer
LESLIE E. ROBERTSON ASSOC RLLP
30 Broad Street, 47th Floor
New York, New York 10004
212.750.9000

MEP Engineers
FLACK + KURTZ Inc.
475 Fifth Avenue
New York, New York 10017
212 532 9600


CROMMELL ARCHITECTS ENGINEERS
101 South Spring Street
Little Rock, Arkansas 72201
501 372.2900

Curtainwall Consultant
R. A. HEINTGES ARCHITECTS
125 Fifth Avenue 9th Floor
New York, New York 10011
212 652-2966

Seal



100% Construction Documents	09/27/02
90% Progress Printing	08/30/02
100% Struct./ CD Progress	07/01/02
100% Steel & Concrete CD	05/15/02
& Architectural CD Progress	
100% Design Development	03/01/02
Issue	Date

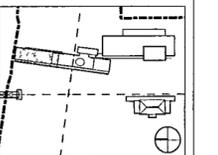


Job No. 9908
Scale 1/8" = 1'-0"
Date September 27, 2002
Title

MUSEUM
UPPER LEVEL
PARTIAL PLAN

Sheet No.

A104a

1/3 Nov 1 Delivery
2/3 _____
3/3 _____

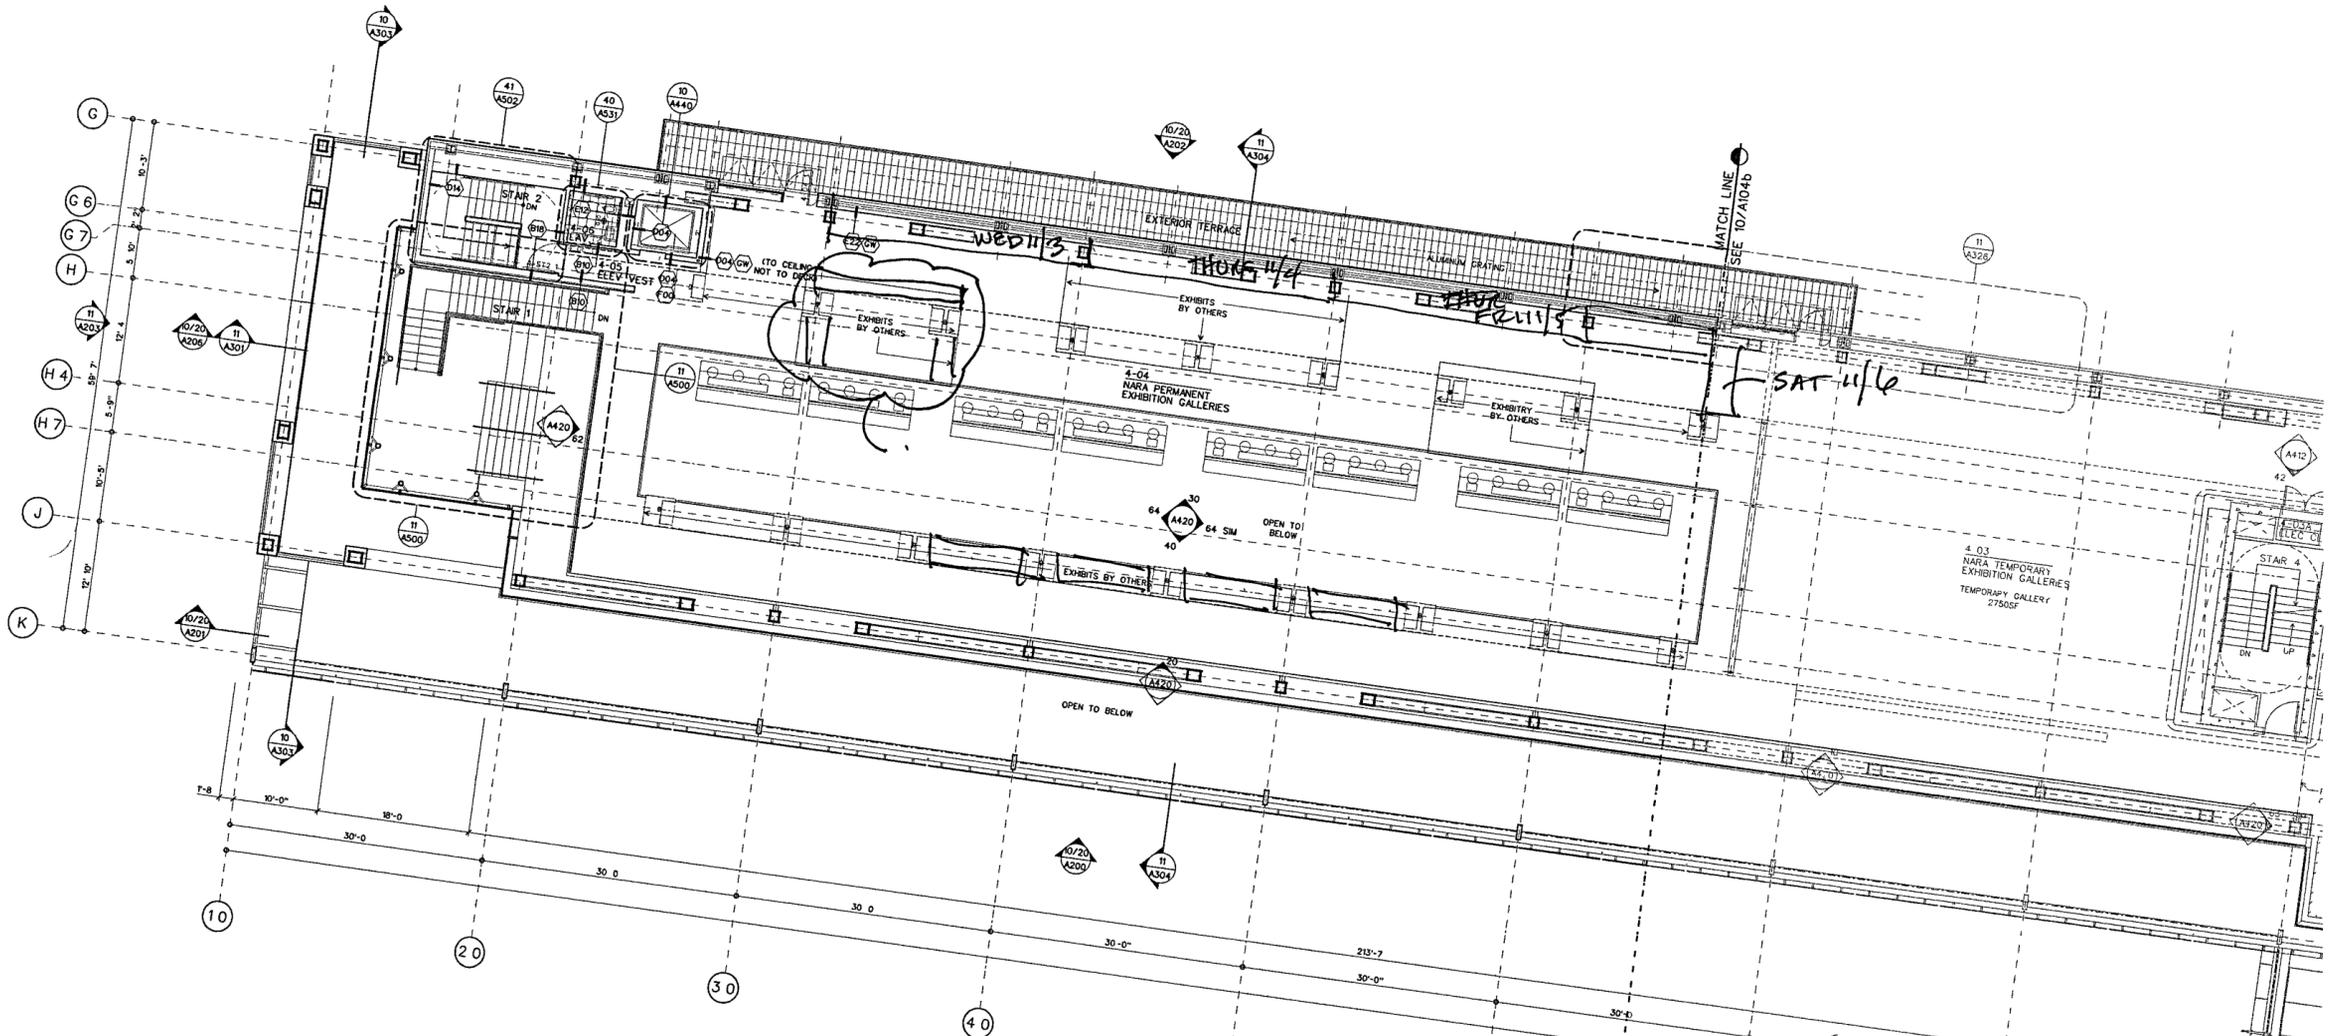

Delivery

Asse
11/1/04

DIST. B. Harris

- D. Alsobrook
- E. Polson
- B. Linn
- S. Sheidt
- A.S.

MUSEUM UPPER LEVEL FLOOR PLAN A

SCALE 1/8" = 1'-0"

AW

AFP-04 DGN

10

FOR OFFICIAL USE ONLY