

**WILLIAM J. CLINTON
PRESIDENTIAL
CENTER**

LITTLE ROCK, ARKANSAS

Architect
POLSHEK PARTNERSHIP LLP
 320 West 13th Street
 New York, New York 10014
 212.607.7171

Coordinating Architects
POLK STANLEY YEARY ARCHITECTS Ltd
 700 South Gardner Street
 Little Rock, Arkansas 72201
 501.378.0878

WTSBELL EVANS & RASCO
 501 West Third Street
 Little Rock, Arkansas 72201
 501.374.5300

WOODS CARADINE ARCHITECTS
 2200 South Main Street
 Little Rock, Arkansas 72206
 501.374.4060

Landscape Architects
HARGREAVES ASSOCIATES
 118 Magazine Street
 Cambridge, Massachusetts 02139
 617.861.0070

LANDSCAPE ARCHITECTURE, Inc.
 2300 Cottrill Lane Suite 202
 Little Rock, Arkansas 72202
 501.374.8610

Structural Engineer
LESLIE E. ROBERTSON ASSOC., RLLP
 30 Broad Street, 4th Floor
 New York, New York 10017
 212.750.9000


MEP Engineers
FLACK + KURTZ Inc.
 475 Fifth Avenue
 New York, New York 10017
 212.532.9600

CROMMELL ARCHITECTS ENGINEERS
 101 South Spring Street
 Little Rock, Arkansas 72201
 501.372.2900

Cost/Estimate Consultant
R.A. HEINTGES ARCHITECTS
 128 Fifth Avenue, 9th Floor
 New York, New York 10011
 212.655.2668



Revision	Date
1	11/22/02
2	11/15/02
3	10/23/02
4	08/27/02
5	06/30/02
6	07/01/02
7	05/15/02
8	03/01/02

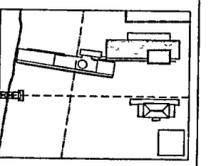


Job No. PPA 9008
 PSY 428D

Scale 1/4" = 1'-0"


Date September 27, 2002

Title ARCHIVE BUILDING SECTIONS

Sheet No. A310

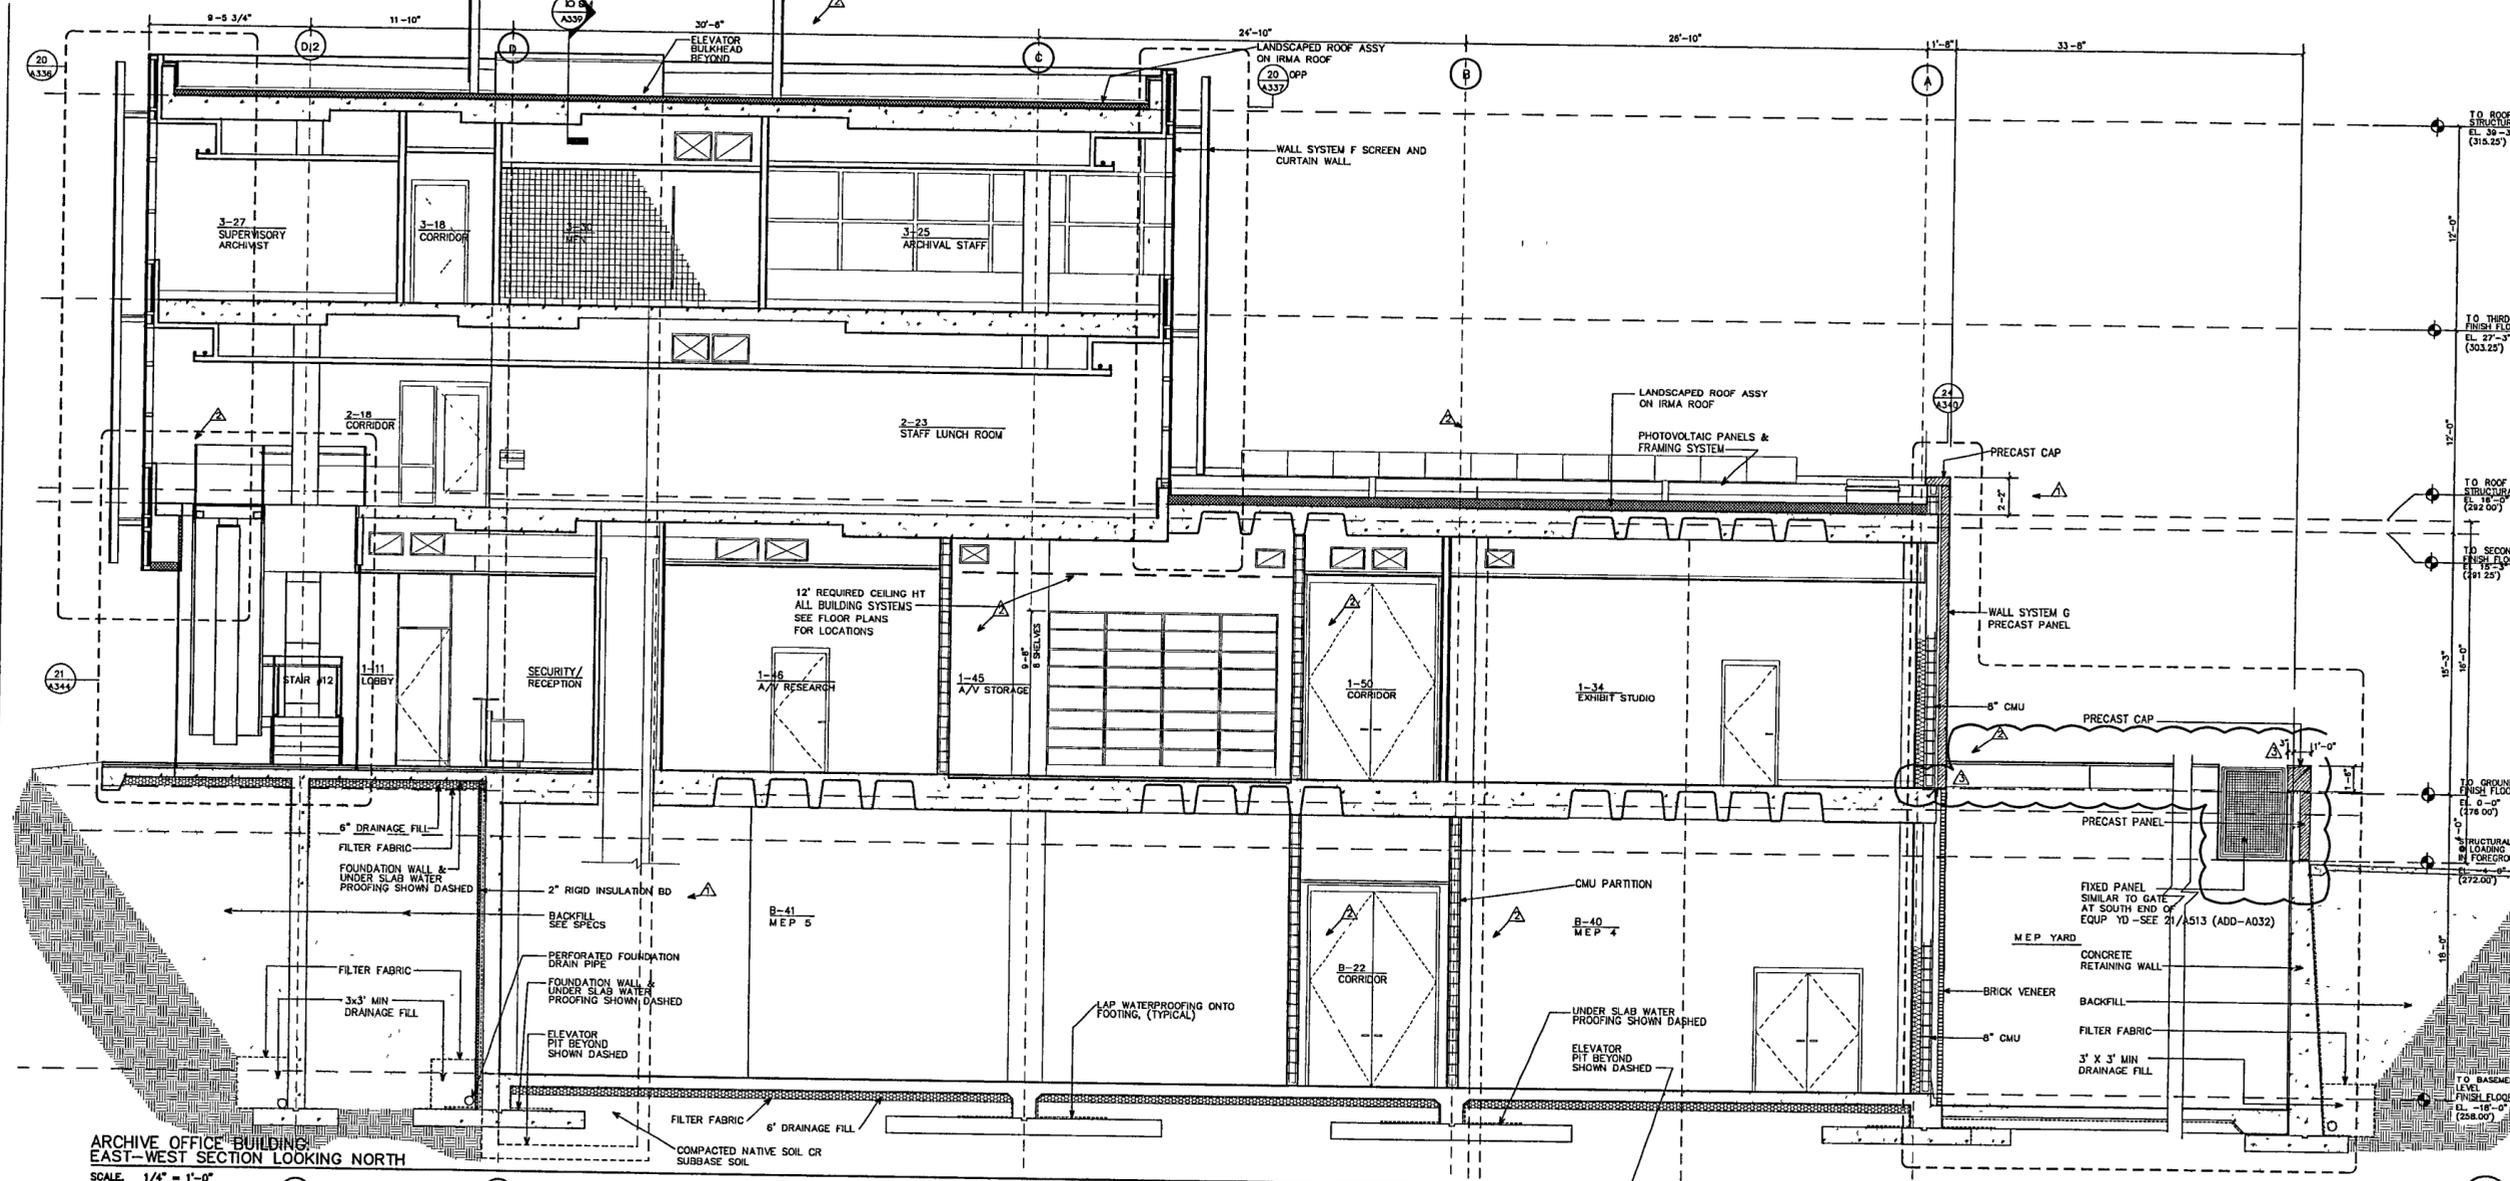

ARCHIVE OFFICE BUILDING
 EAST-WEST SECTION LOOKING NORTH
 SCALE: 1/4" = 1'-0"

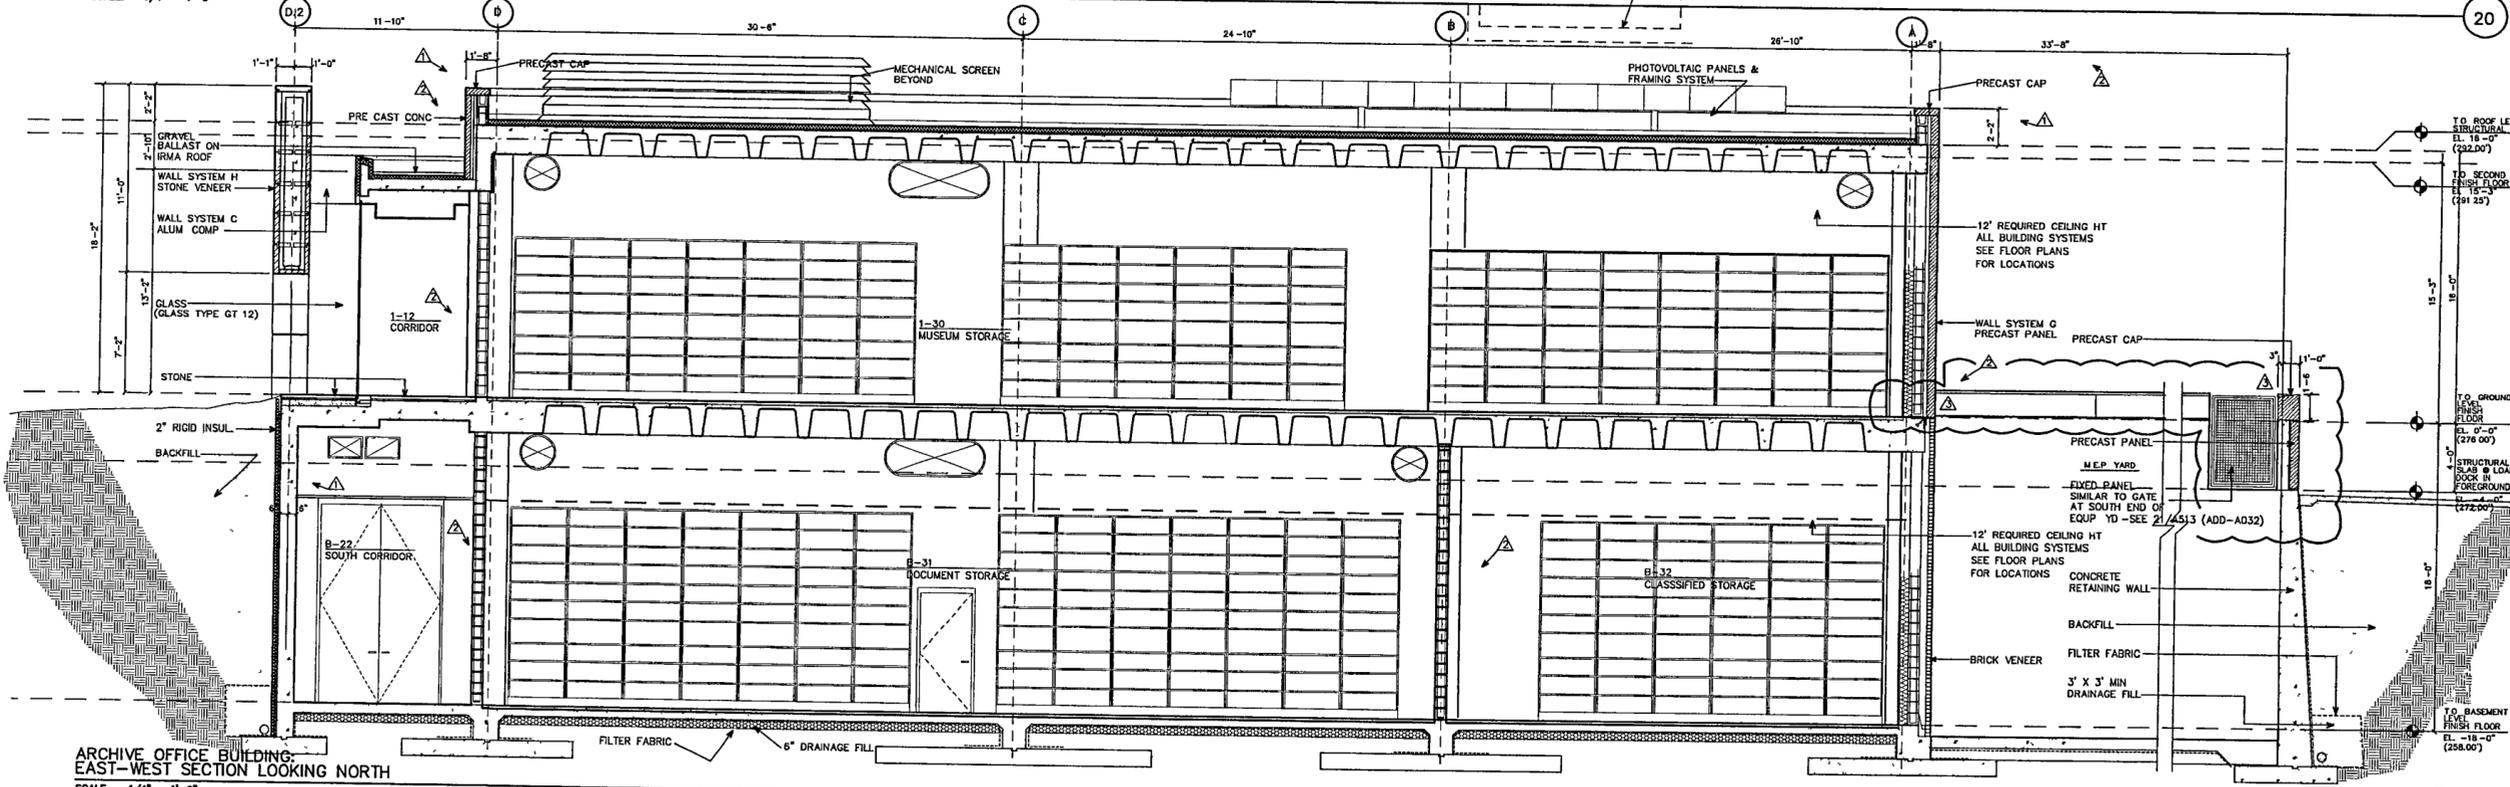

ARCHIVE OFFICE BUILDING
 EAST-WEST SECTION LOOKING NORTH
 SCALE: 1/4" = 1'-0"

MONDAY, DECEMBER 02, 2002 9:45 AM