

**WILLIAM J CLINTON
PRESIDENTIAL
CENTER**

LITTLE ROCK, ARKANSAS

Architect
POLSHKE PARTNERSHIP LLP
320 West 13th Street
New York, New York 10014
212 607 7171

Coordinating Architects
POLK STANLEY YEARY ARCHITECTS Ltd
700 South Schiller Street
Little Rock, Arkansas 72201
501 378 0878

WITSELL EVANS RASCO
601 West Third Street
Little Rock, Arkansas 72201
501 374 5300

WOODS GARADINE ARCHITECTS
2200 South Main Street
Little Rock, Arkansas 72206
501 374 4060

Landscape Architects
HARGREAVES ASSOCIATES
118 Magazine Street
Cambridge, Massachusetts 02139
617 661 0070


LANDSCAPE ARCHITECTURE Inc.
2300 Cottondale Lane Suite 202
Little Rock, Arkansas 72202
501 374 5810

Structural Engineer
LESLIE E ROBERTSON ASSOC, RLLP
30 Broad Street, 47th Floor
New York, New York 10004
212 750 9000


MEP Engineers
FLACK + KURTZ Inc
475 Fifth Avenue
New York, New York 10017
212 552 9600

CROMMELL ARCHITECTS ENGINEERS
101 South Spring Street
Little Rock, Arkansas 72201
501 372 2300

Curtainwall Consultant
R. A. HEINTGES ARCHITECTS
125 Fifth Avenue, 9th Floor
New York, New York 10011
212 652-2966

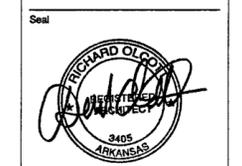

100% Construction Documents	09/27/02
90% Progress Printing	08/30/02
100% Structl/ CD Progress	07/01/02
Bridge Bldg Substructure	09/14/02
100% Design Development	03/01/02
Issue	Date

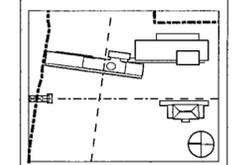


Job No 9908
Scale 1/2" = 1'-0"
Date September 27, 2002
Title

**WALL SYSTEM A1
PLANS, ELEVATION
AND SECTION**

Sheet No

A320


FOR OFFICIAL USE ONLY

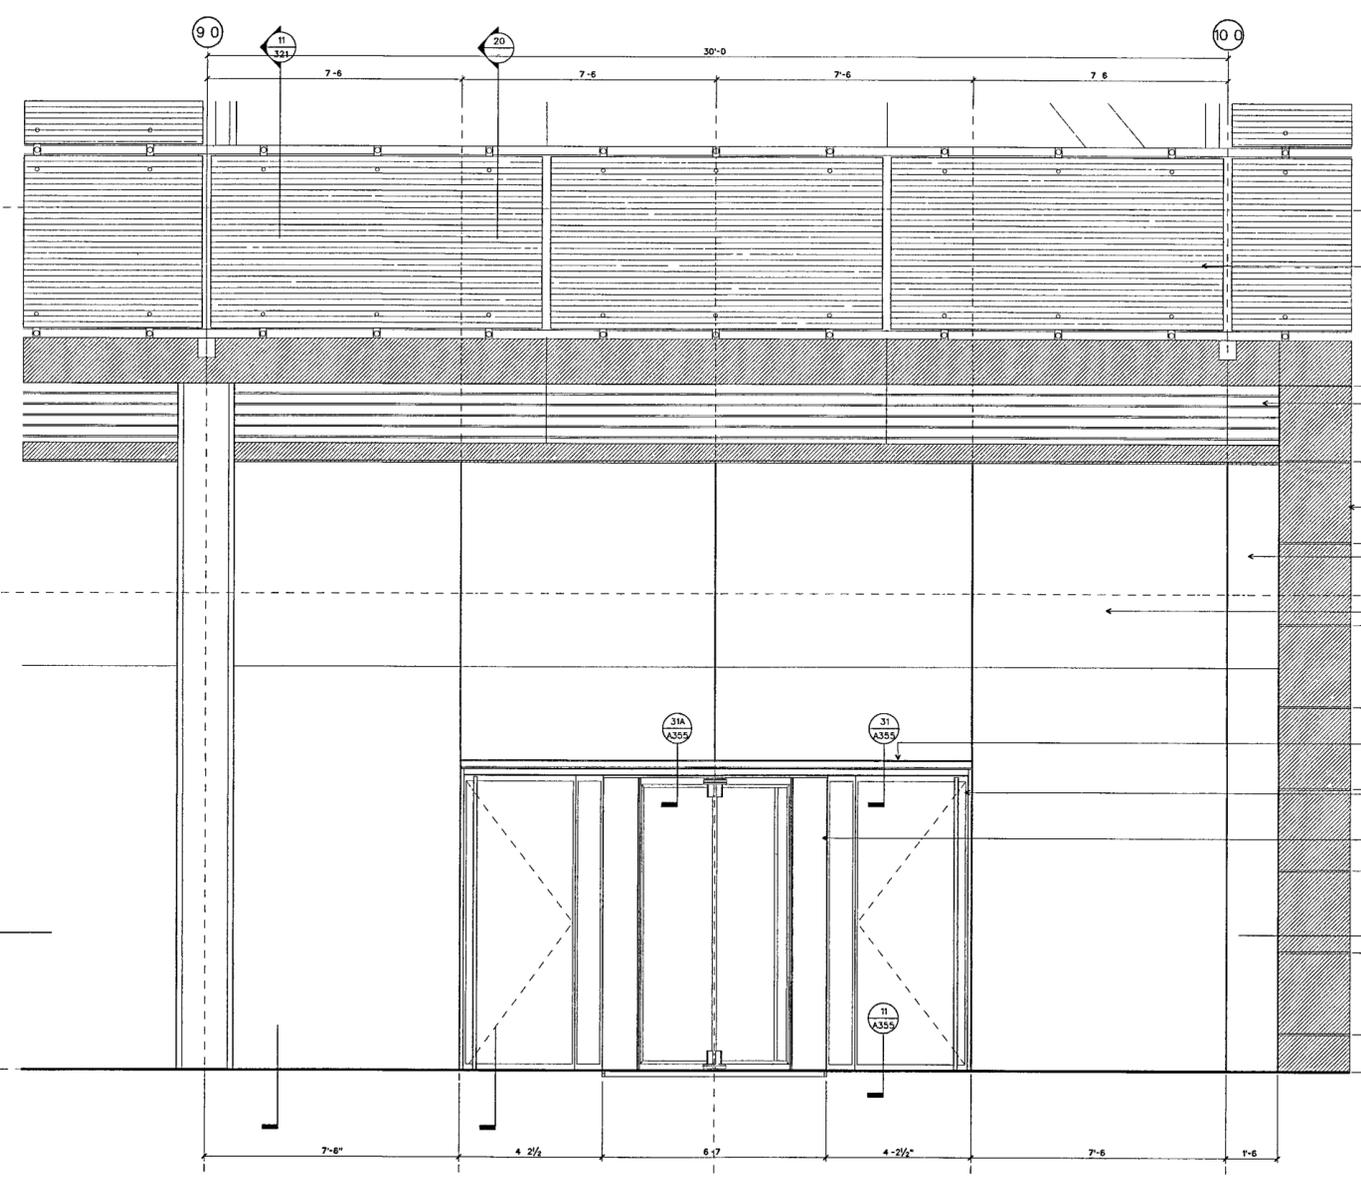

WALL SYSTEM A1: ELEVATION AT ENTRY

SCALE 1/2" = 1'-0"


DETAILS/DTL-CWA 21

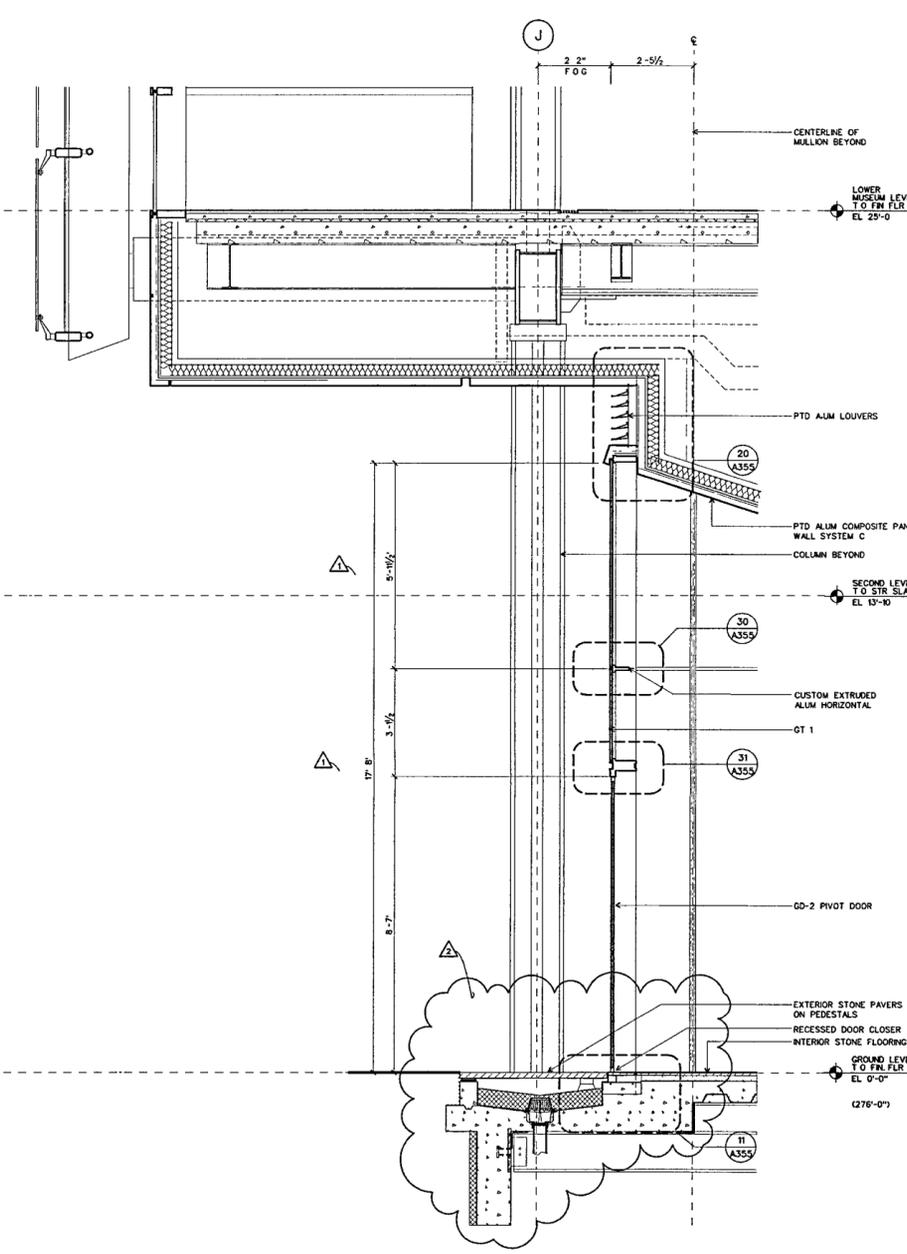

WALL SYSTEM A1: WALL SECTION AT ENTRY

SCALE 1/2" = 1'-0"


DETAILS/DTL-CWA 20

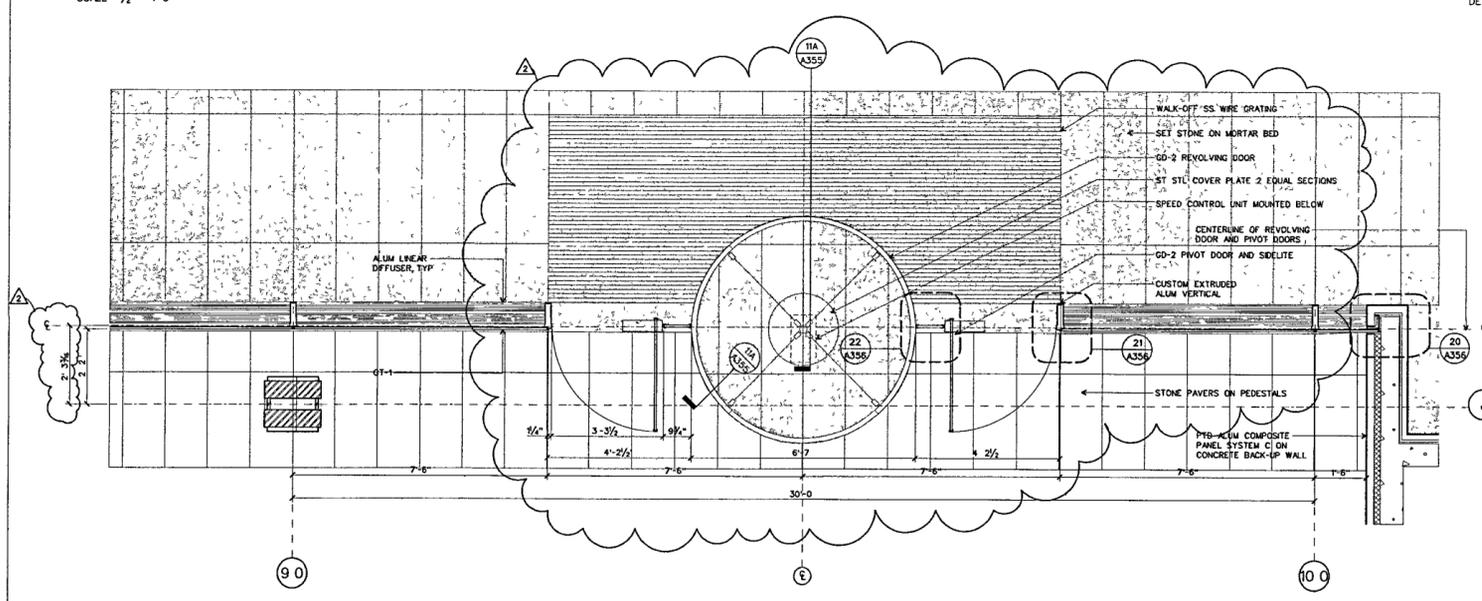

WALL SYSTEM A1: PLAN SECTION AT ENTRY

SCALE 1/2" = 1'-0"

DETAILS/DTL-CWA 11

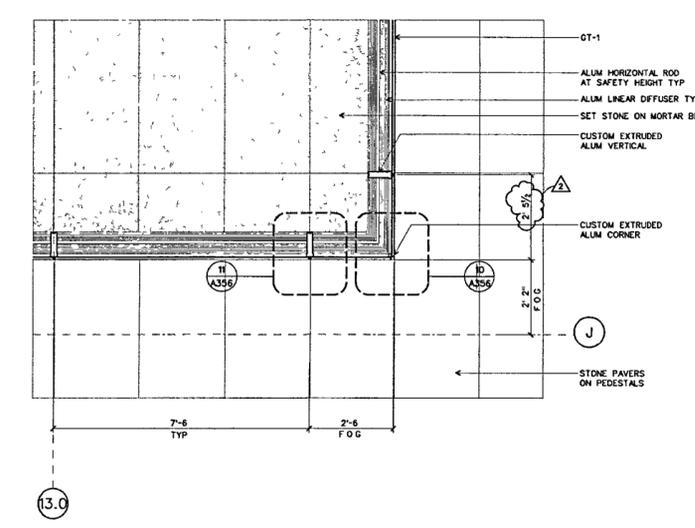

WALL SYSTEM A1: PLAN SECTION AT LOBBY CORNER

SCALE 1/2" = 1'-0"

DETAILS/DTL-CWA 10