

**WILLIAM J CLINTON
PRESIDENTIAL
CENTER**

LITTLE ROCK, ARKANSAS

Architect
POLSHAK PARTNERSHIP LLP
320 West 13th Street
New York, New York 10014
212 607 7171

Coordinating Architects
POLK STANLEY YEARY ARCHITECTS LTD
700 South Schuler Street
Little Rock, Arkansas 72201
501 378 0878

WITSELL EVANS RASCO
501 West Third Street
Little Rock, Arkansas 72201
501 374 5300

WOODS CARADINE ARCHITECTS
2200 South Main Street
Little Rock, Arkansas 72206
501 374 4060

Landscape Architects
HARGREAVES ASSOCIATES
118 Magazine Street
Cambridge, Massachusetts 02139
617 661 0070


LANDSCAPE ARCHITECTURE, Inc.
2300 Cottondale Lane Suite 202
Little Rock, Arkansas 72202
501 374 6810

Structural Engineer
LESLIE E ROBERTSON ASSOC, RLLP
30 Broad Street, 47th Floor
New York, New York 10004
212 750 9000


MEP Engineers
FLACK + KURTZ Inc
473 Fifth Avenue
New York, New York 10017
212.532.9600

CROMWELL ARCHITECTS ENGINEERS
101 South Spring Street
Little Rock, Arkansas 72201
501 372 2900

Curtainwall Consultant
R. A. HEINTGES ARCHITECTS
128 Fifth Avenue, 9th Floor
New York, New York 10011
212 652-2966

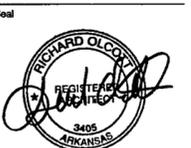

100% Construction Documents	08/27/02
90% Progress Printing	08/30/02
100% Struct/CD Progress	07/10/02
Bridge Bldg Substructure	06/14/02
100% Design Development	03/01/02
Issue	Date

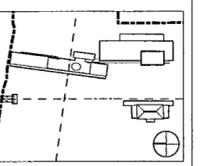

Job No 9908

Scale 1/2" = 1'-0"


Date September 27 2002

Title


**WALL SYSTEM A2
SECTIONS**

Sheet No


A323

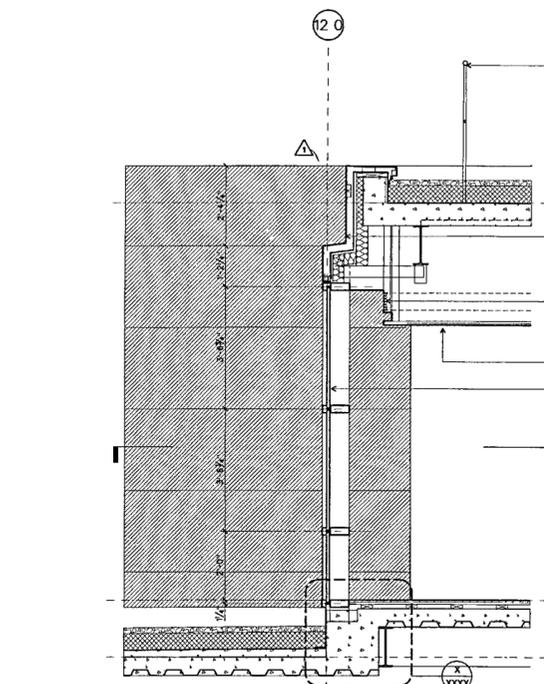


WALL SYSTEM A2: WALL SECTION AT NECK, EXEC SOUTH
SCALE 1/2" = 1'-0" DETAILS/DTL-CWA4

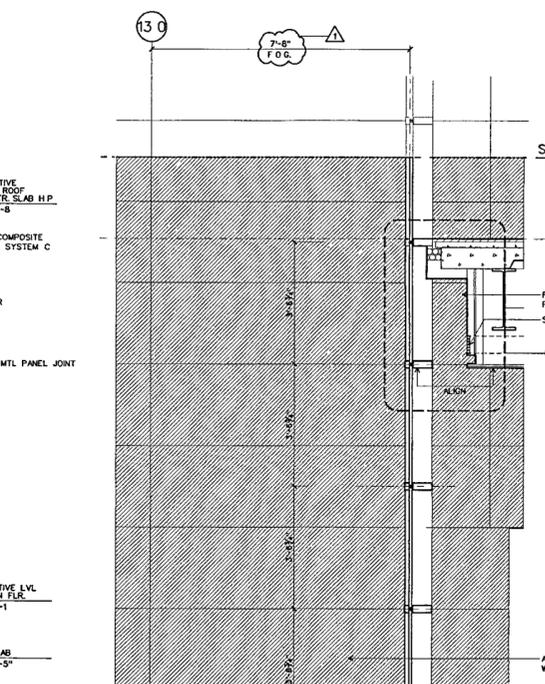


WALL SYSTEM A2: WALL SECTION AT NECK, SOUTH
SCALE 1/2" = 1'-0" DETAILS/DTL-CWA4

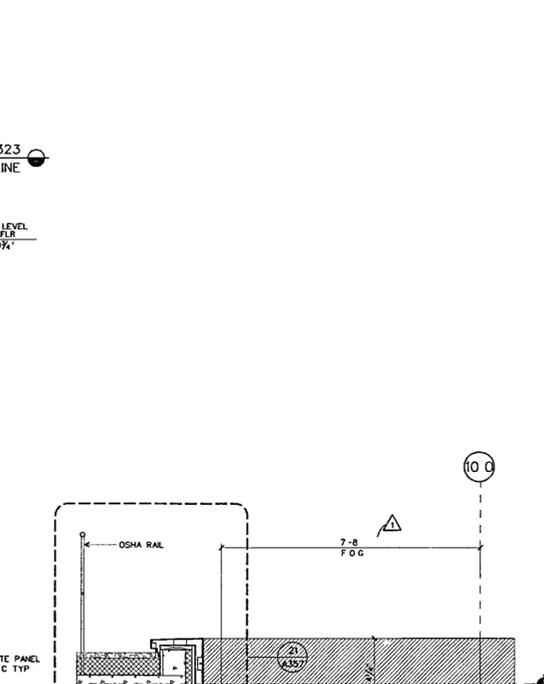


WALL SYSTEM A2: WALL SECTION AT NECK, NORTH
SCALE 1/2" = 1'-0" DETAILS/DTL-CWA4

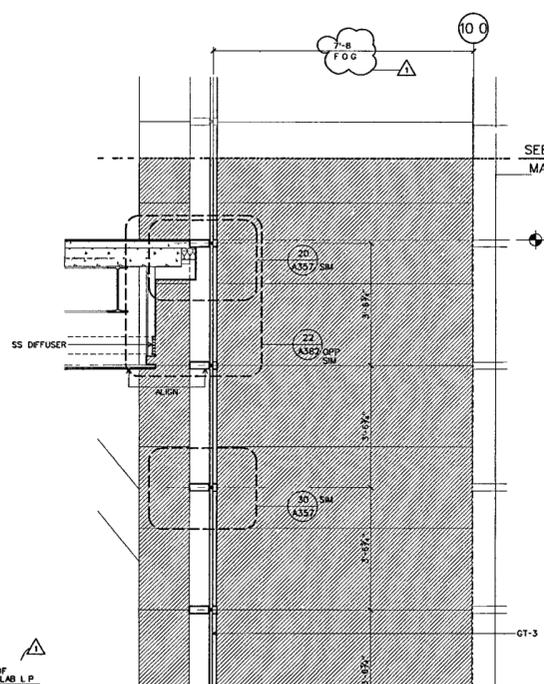


WALL SYSTEM A2: WALL SECTION AT NECK, NORTH
SCALE 1/2" = 1'-0" DETAILS/DTL-CWA4

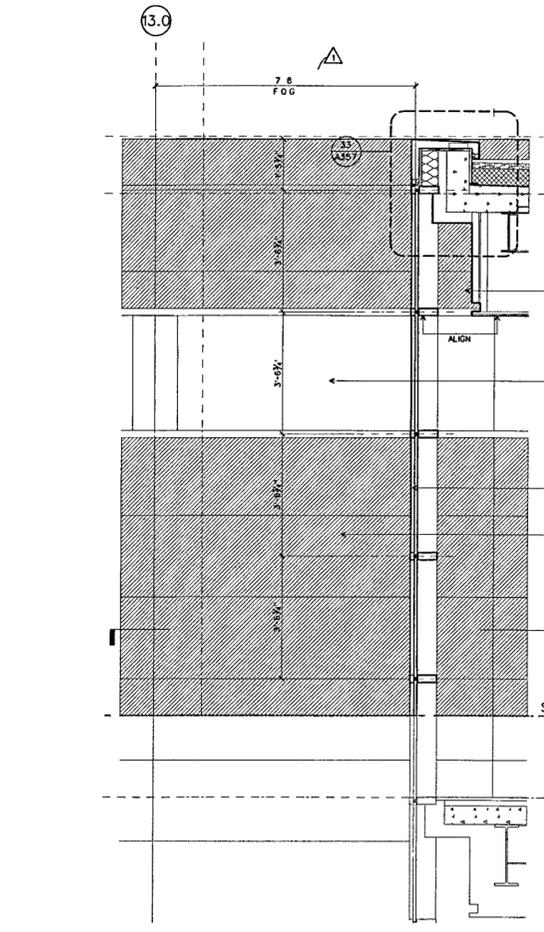


WALL SYSTEM A2: WALL SECTION AT NECK, SOUTH
SCALE 1/2" = 1'-0" DETAILS/DTL-CWA4

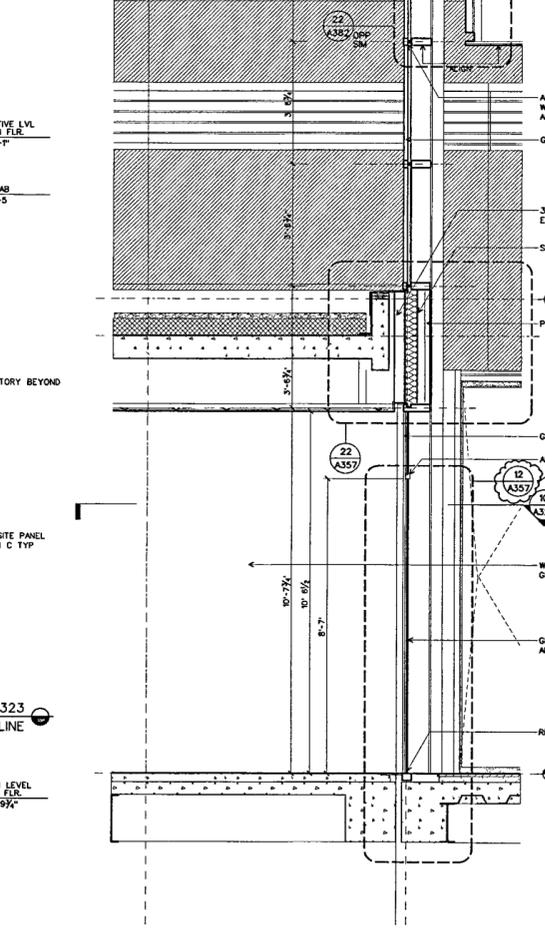

WALL SYSTEM A2: WALL SECTION AT NECK, SOUTH
SCALE 1/2" = 1'-0" DETAILS/DTL-CWA4

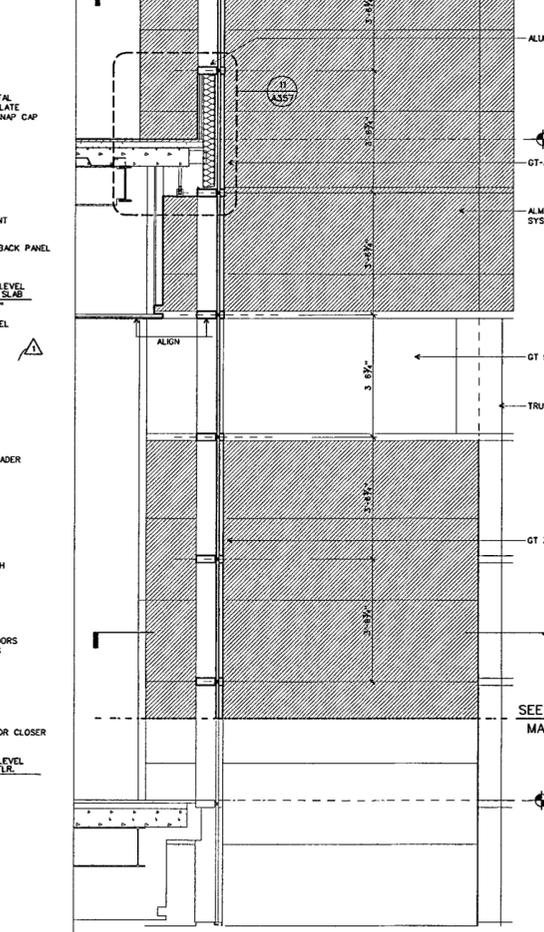

WALL SYSTEM A2: WALL SECTION AT NECK, NORTH
SCALE 1/2" = 1'-0" DETAILS/DTL-CWA4

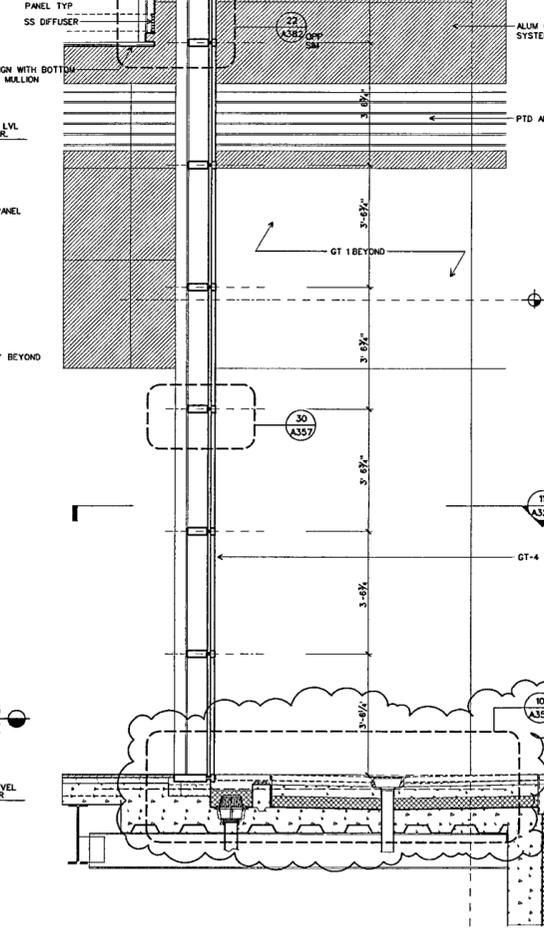

WALL SYSTEM A2: WALL SECTION AT NECK, NORTH
SCALE 1/2" = 1'-0" DETAILS/DTL-CWA4

FOR OFFICIAL USE ONLY