

**WILLIAM J CLINTON
PRESIDENTIAL
CENTER**

LITTLE ROCK, ARKANSAS

Architect
POLISHEK PARTNERSHIP LLP
320 West 13th Street
New York, New York 10014
212 807 7171

Coordinating Architects
POLK STANLEY YEARY ARCHITECTS LTD
700 South Schiller Street
Little Rock, Arkansas 72201
501 378 0878

WITSELL EVANS RASCO
901 West Third Street
Little Rock, Arkansas 72201
501 374 5300

WOODS CADARINE ARCHITECTS
2200 South Main Street
Little Rock, Arkansas 72206
501 374 4060

Landscape Architects
HARGREAVES ASSOCIATES
118 Magazine Street
Cambridge, Massachusetts 02139
617 861 0070


LANDSCAPE ARCHITECTURE, Inc.
2300 Cottondale Lane Suite 202
Little Rock, Arkansas 72202
501 374 5510

Structural Engineer
LESLIE E. ROBERTSON ASSOC, RLLP
30 Broad Street, 47th Floor
New York, New York 10004
212 750 9000


MEP Engineers
FLACK + KURTZ Inc.
475 Fifth Avenue
New York, New York 10017
212.532.9600

CROMWELL ARCHITECTS ENGINEERS
101 South Spring Street
Little Rock, Arkansas 72201
501 372 2900

Curtainwall Consultant
R. A. HEINTGES ARCHITECTS
128 5th Avenue, 9th Floor
New York, New York 10011
212 552-2966

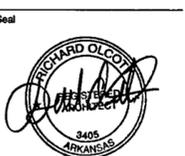

Issue	Date
100% Construction Documents	09/27/02
90% Progress Printing	08/30/02
100% Struct/CD Progress	07/10/02
Bridge Bldg Substructure	06/14/02
100% Design Development	03/01/02

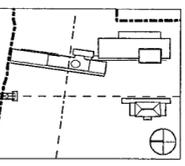


Job No 9908
Scale 1/2" = 1'-0"
Date September 27 2002
Title


**WALL SYSTEM
A2 AND A3
PLANS**

Sheet No


A324

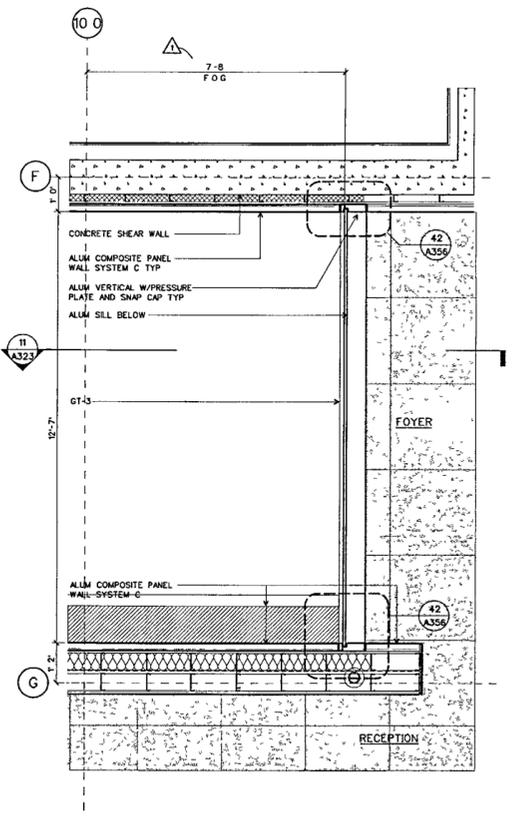


WALL SYSTEM A2: PLAN AT EXECUTIVE LEVEL
SCALE 1/2" = 1'-0" DETAILS/DTL-CWAS 23

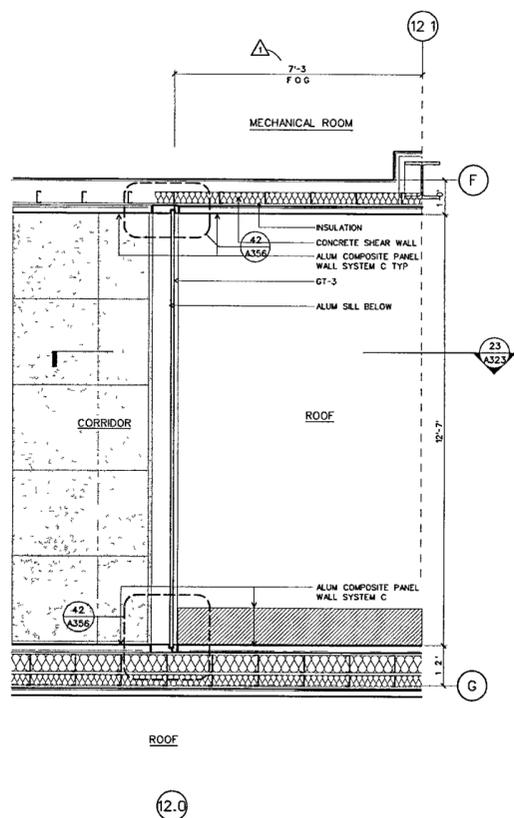


WALL SYSTEM A2: PLAN AT EXECUTIVE LEVEL
SCALE 1/2" = 1'-0" DETAILS/DTL-CWAS 22

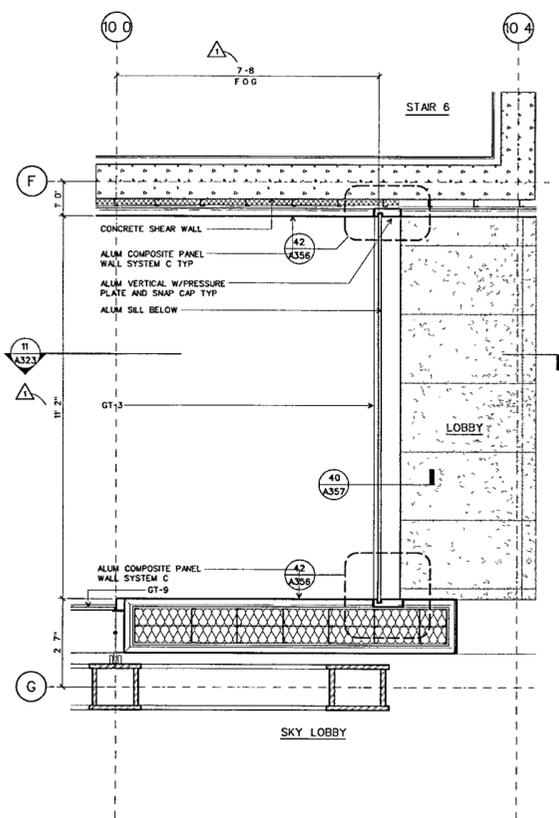


WALL SYSTEM A2: PLAN AT UPPER MUSEUM LEVEL
SCALE 1/2" = 1'-0" DETAILS/DTL-CWAS 21

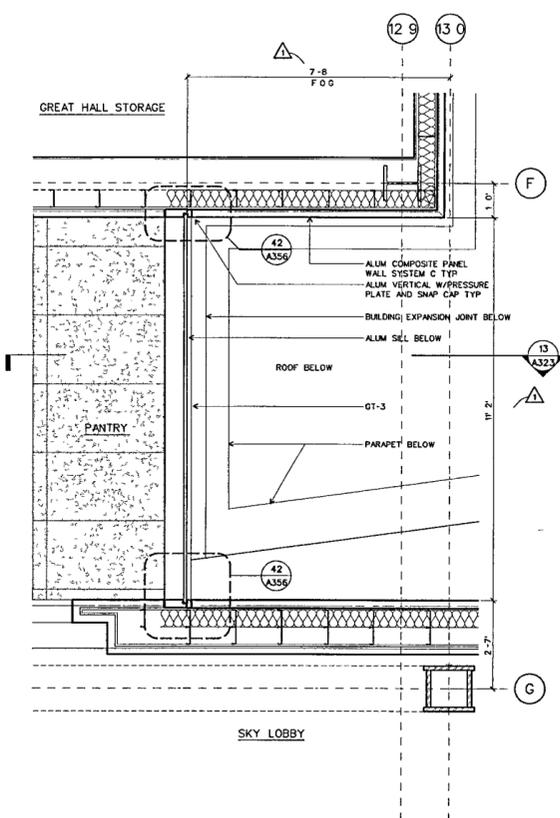


WALL SYSTEM A2: PLAN AT UPPER MUSEUM LEVEL
SCALE 1/2" = 1'-0" DETAILS/DTL-CWAS 20

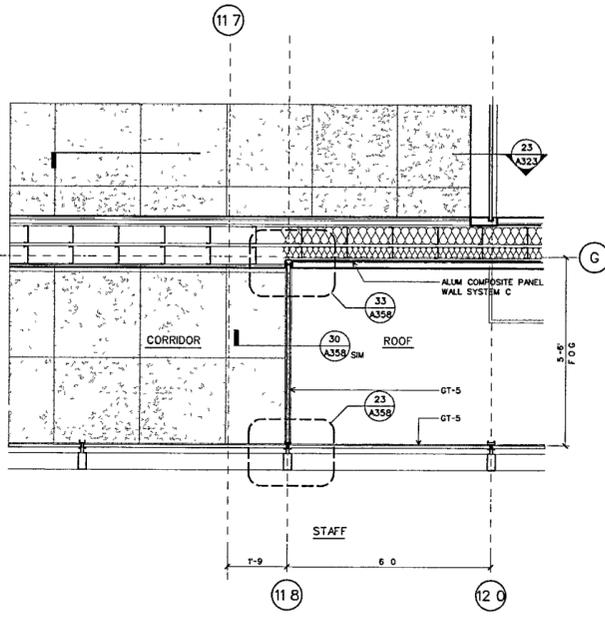

WALL SYSTEM A3: PLAN AT EXECUTIVE LEVEL
SCALE 1/2" = 1'-0" DETAILS/DTL-CWAS 12

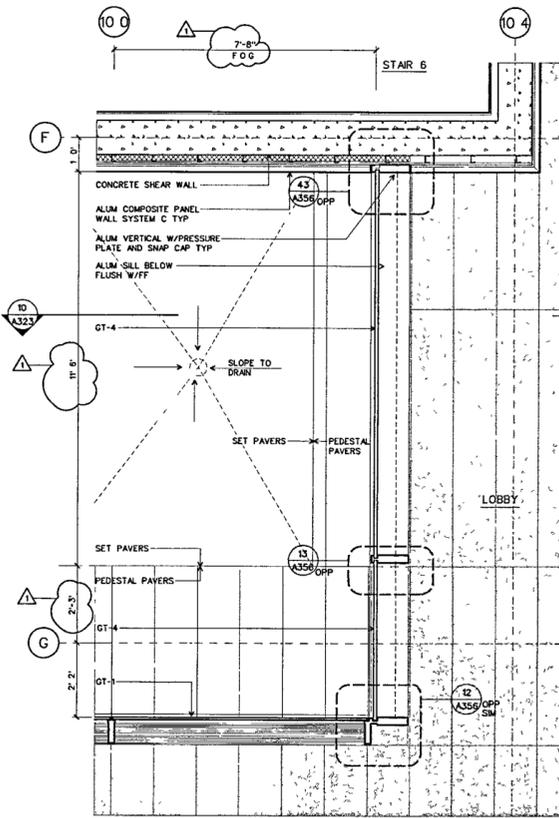

WALL SYSTEM A2: PLAN AT GROUND LEVEL
SCALE 1/2" = 1'-0" DETAILS/DTL-CWAS 11

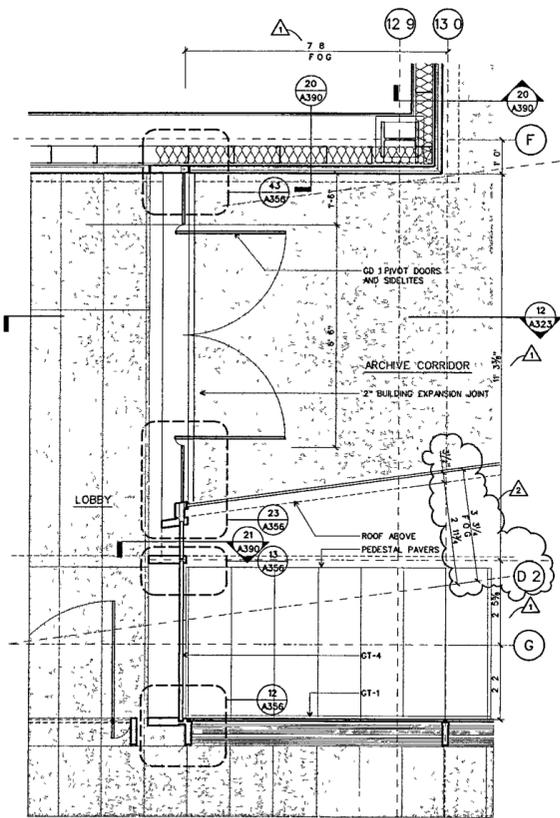

WALL SYSTEM A2: PLAN AT GROUND LEVEL
SCALE 1/2" = 1'-0" DETAILS/DTL-CWAS 10

FOR OFFICIAL USE ONLY