


WALL SYSTEM A3 ELEVATION AT SOUTHWEST CORNER

SCALE 1/2" = 1'-0"


DETAILS/DTL-CWAE 21

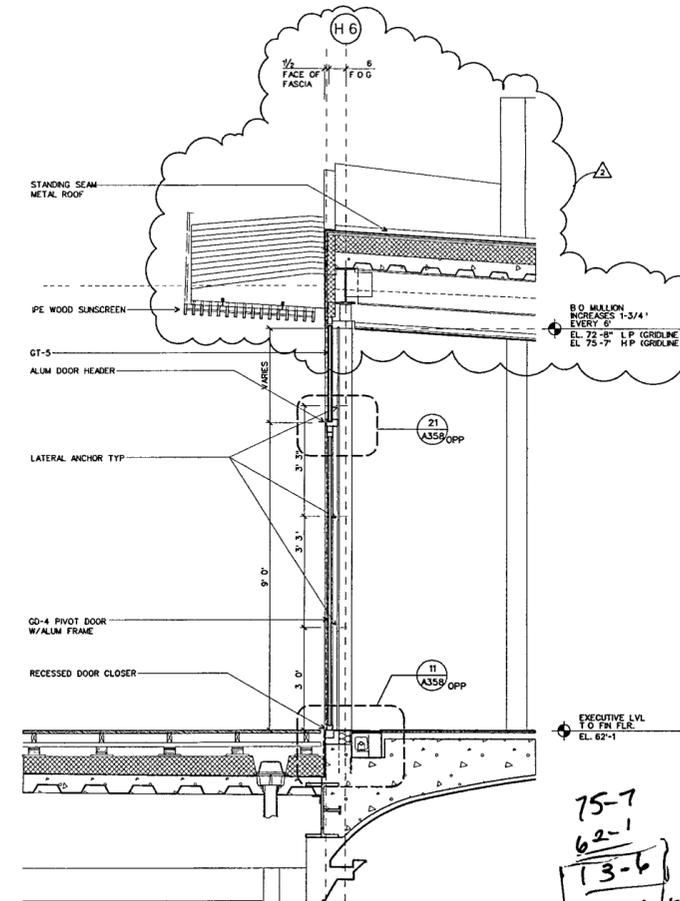

WALL SYSTEM A3- WALL SECTION THRU OVAL

SCALE 1/2" = 1'-0"


DETAILS/DTL-CWAE 20

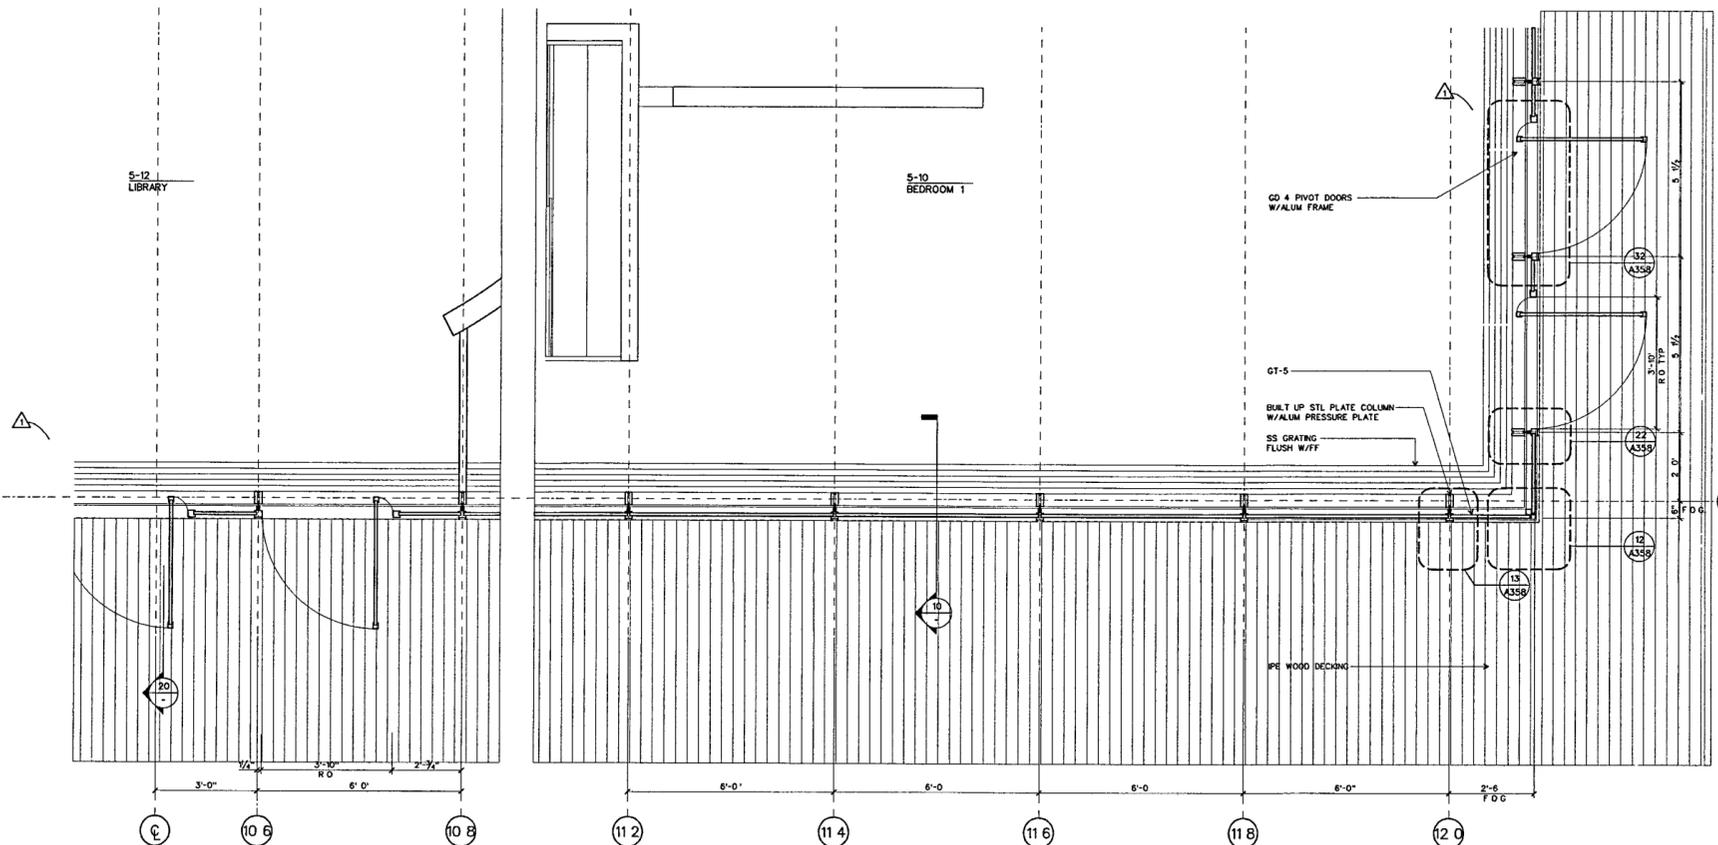

WALL SYSTEM A3: PLAN SECTION AT SOUTHWEST CORNER

SCALE 1/2" = 1'-0"

DETAILS/DTL-CWAE 11

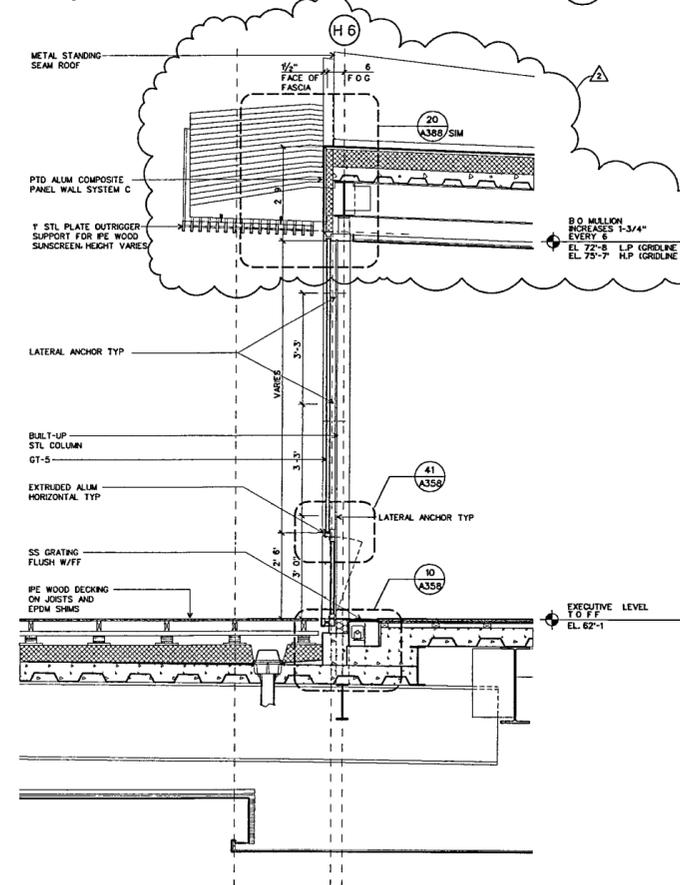

WALL SYSTEM A3: WALL SECTION, TYP

SCALE 1/2" = 1'-0"

DETAILS/DTL-CWAE 10

WILLIAM J CLINTON
PRESIDENTIAL
CENTER

LITTLE ROCK, ARKANSAS

Architect
POLSHEK PARTNERSHIP LLP
320 West 13th Street
New York, New York 10014
212 807 7171

Coordinating Architects
POLK STANLEY YEARY ARCHITECTS Ltd
700 South Schiller Street
Little Rock, Arkansas 72201
501 379 0878

WITSELL EVANS RASCO
901 West Third Street
Little Rock, Arkansas 72201
501 374 5300

WOODS CARADINE ARCHITECTS
2200 South Main Street
Little Rock, Arkansas 72206
501 374 4060

Landscape Architects
HARGREAVES ASSOCIATES
118 Magazine Street
Cambridge, Massachusetts 02139
617 661 0370


LANDSCAPE ARCHITECTURE, Inc.
2300 Cottondale Lane Suite 202
Little Rock, Arkansas 72202
501 374 5610

Structural Engineer
LESLIE E ROBERTSON ASSOC RLLP
30 Broad Street, 47th Floor
New York, New York 10004
212 750 8000


MEP Engineers
FLACK + KURTZ Inc.
475 Fifth Avenue
New York, New York 10017
212 552 9600

CROMWELL ARCHITECTS ENGINEERS
101 South Spring Street
Little Rock, Arkansas 72201
501 372 2900

Curtainwall Consultant
R. A. HEINTGES ARCHITECTS
128 Fifth Avenue, 9th Floor
New York, New York 10011
212.652.2996

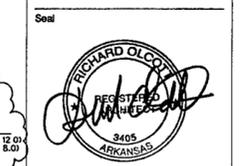

100% Construction Documents	09/27/02
90% Progress Printing	08/30/02
100% Struct./ CD Progress	07/01/02
100% Design Development	03/01/02
Issue	Date

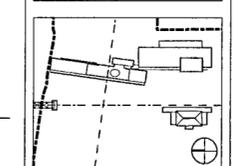

Job No 9908
Scale 1/2" = 1'-0"
Date September 27, 2002

Title
WALL SYSTEM A3
PLAN, ELEVATION,
AND SECTIONS

Sheet No
A325