

**WILLIAM J CLINTON
PRESIDENTIAL
CENTER**

LITTLE ROCK, ARKANSAS

Architect
POLSHAK PARTNERSHIP LLP
320 West 13th Street
New York, New York 10014
212 607 7171

Coordinating Architects
POLK STANLEY YEARY ARCHITECTS Ltd
700 South Schuler Street
Little Rock, Arkansas 72201
501 378 0878

WITSELL EVANS RASCO
901 West Third Street
Little Rock, Arkansas 72201
501 374 5300

WOODS CARADINE ARCHITECTS
2200 South Main Street
Little Rock, Arkansas 72206
501 374 4060

Landscape Architects
HARGREAVES ASSOCIATES
118 Magazine Street
Cambridge, Massachusetts 02139
617 661 0070


LANDSCAPE ARCHITECTURE Inc.
2300 Cottondale Lane Suite 202
Little Rock, Arkansas 72202
501 374 6610

Structural Engineer
LESLIE E. ROBERTSON ASSOC., RLLP
30 Broad Street, 47th Floor
New York, New York 10004
212 750 9000


MEP Engineers
FLACK + KURTZ Inc
475 Fifth Avenue
New York, New York 10017
212 532 9600

CRONWELL ARCHITECTS ENGINEERS
101 South Spring Street
Little Rock, Arkansas 72201
501 372 2900

Curtainwall Consultant
R. A. HEINTGES ARCHITECTS
126 Fifth Avenue, 9th Floor
New York, New York 10011
212.652-2968

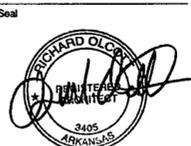


100% Construction Documents	09/27/02
100% Struct./ CD Progress	07/01/02
100% Design Development	03/01/02
Issue	Date

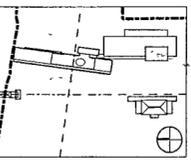

Job No 9908
Scale 1-1/2" = 1'-0"
Date September 27, 2002
Title

**WALL SYSTEM A3
ELEVATION AND
SECTIONS**


Sheet No
A325a

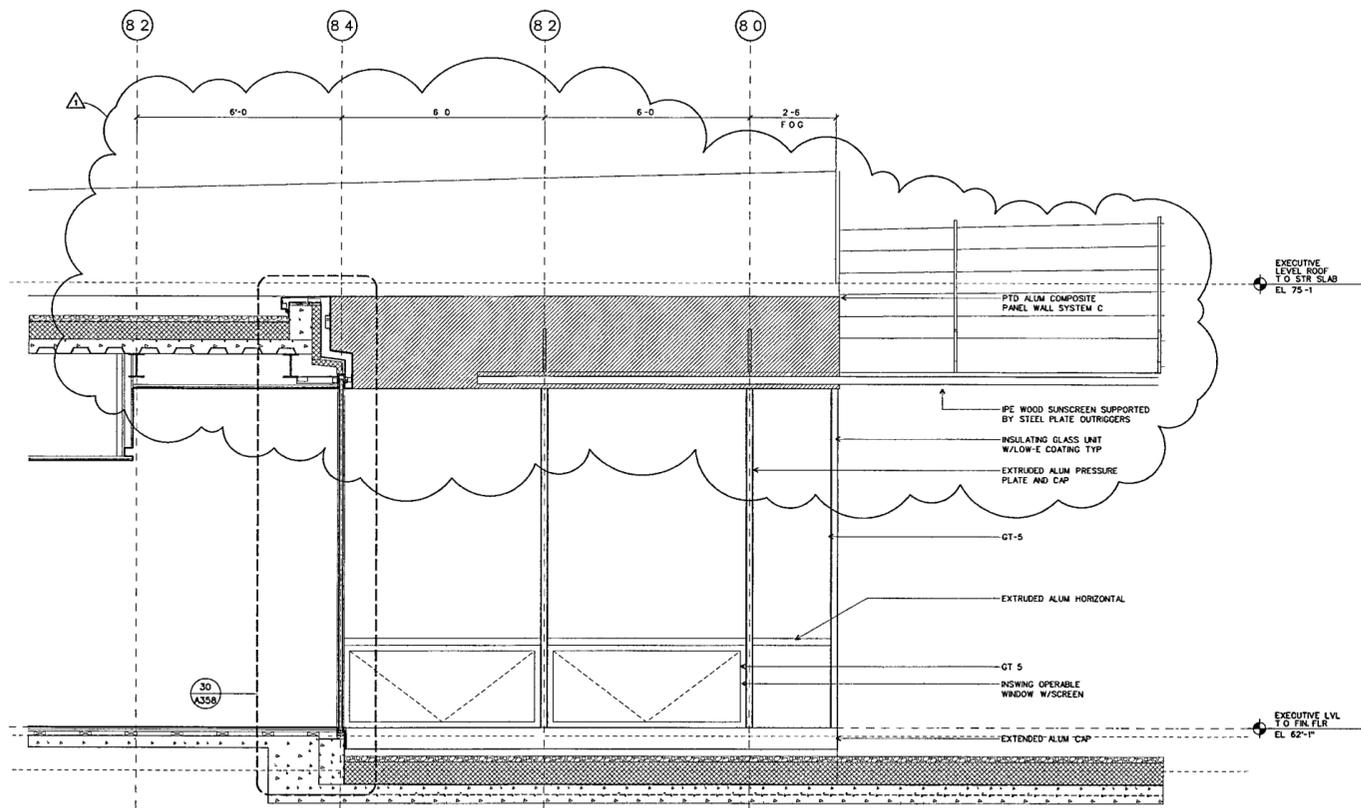

WALL SYSTEM A3: EAST ELEVATION AT NORTH CORNER AND SECTION THROUGH GALLERY

SCALE 1/2" = 1'-0"

DETAILS/DTL-CW47 20

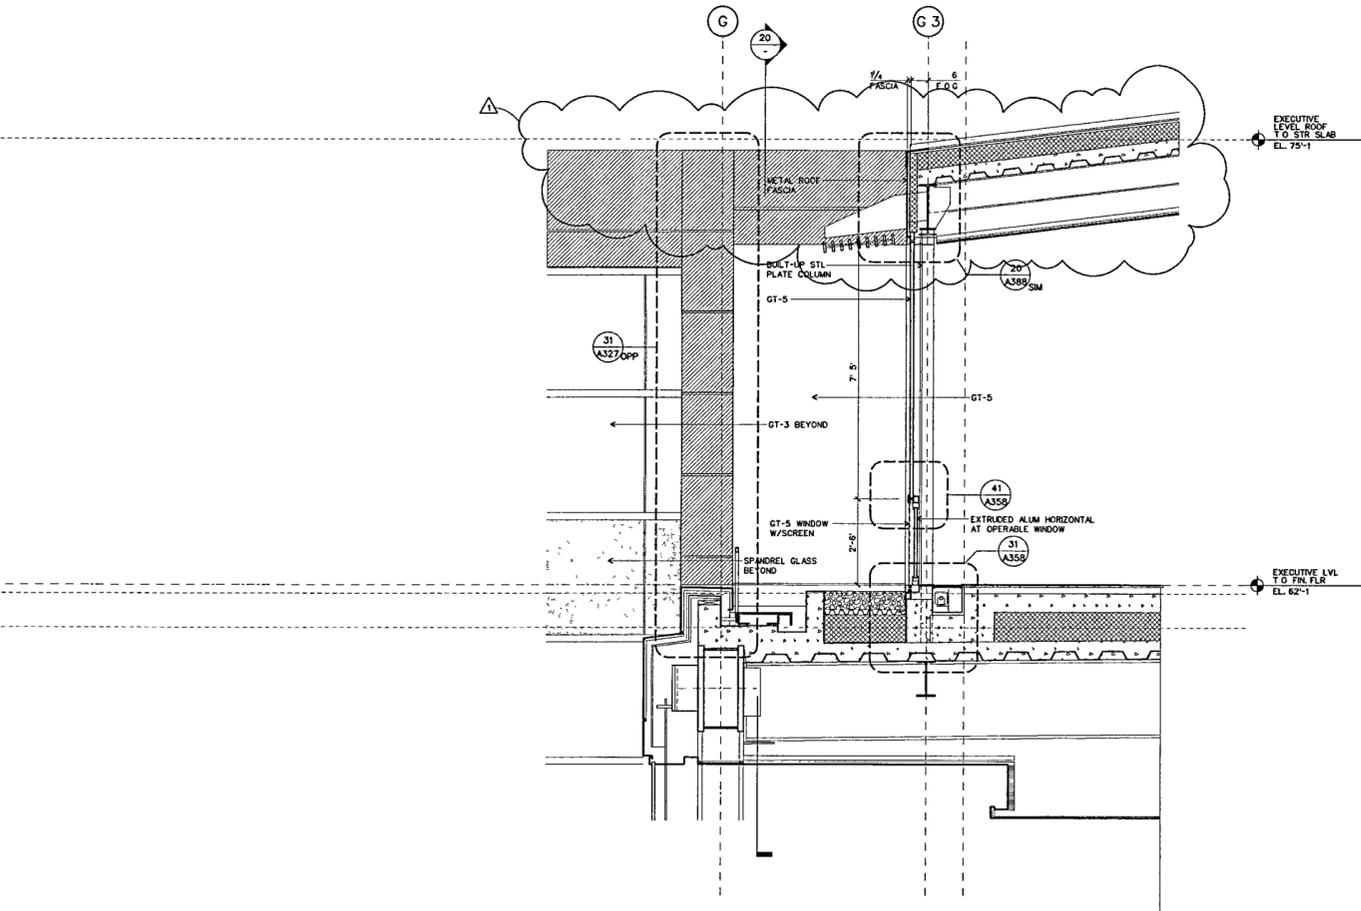

WALL SYSTEM A3: WALL SECTION THRU WINDOW

SCALE 1/2" = 1'-0"

DETAILS/DTL-CW47 10