

**WILLIAM J CLINTON  
PRESIDENTIAL  
CENTER**

LITTLE ROCK, ARKANSAS

Architect  
POLSHAK PARTNERSHIP LLP  
320 West 13th Street  
New York, New York 10014  
212.807.7171

Coordinating Architects  
POLK STANLEY YEARY ARCHITECTS LTD  
700 South Schiller Street  
Little Rock, Arkansas 72201  
501.378.0878  
WITSELL EVANS RASCO  
501 West Third Street  
Little Rock, Arkansas 72201  
501.374.5300  
WOODS CARADINE ARCHITECTS  
2200 South Main Street  
Little Rock, Arkansas 72206  
501.374.4060

Landscape Architects  
HARGREAVES ASSOCIATES  
118 Magazine Street  
Cambridge, Massachusetts 02139  
617.661.0070


LANDSCAPE ARCHITECTURE, Inc.  
2300 Cottondale Lane Suite 202  
Little Rock, Arkansas 72202  
501.374.5810

Structural Engineer  
LESLIE E ROBERTSON ASSOC., RLLP  
30 Broad Street, 47th Floor  
New York, New York 10004  
212.750.9000


MEP Engineers  
FLACK + KURTZ Inc.  
475 Fifth Avenue  
New York, New York 10017  
212.632.9600

CROMMELL ARCHITECTS ENGINEERS  
101 South Spring Street  
Little Rock, Arkansas 72201  
501.372.2900

Curtainwall Consultant  
R. A. HEINTGES ARCHITECTS  
125 Fifth Avenue, 5th Floor  
New York, New York 10011  
212.652-2968

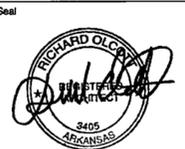

100% Construction Documents	09/27/02
90% Progress Printing	08/30/02
100% Struct./CD Progress	07/01/02
100% Design Development	03/01/02
Issue	Date

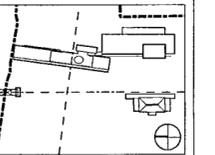


Job No. 9908  
Scale 1/2" = 1'-0"  
Date September 27, 2002  
Title

**WALL SYSTEM C  
PLANS AND SECTIONS**

Sheet No.

**A327**

FOR OFFICIAL USE ONLY

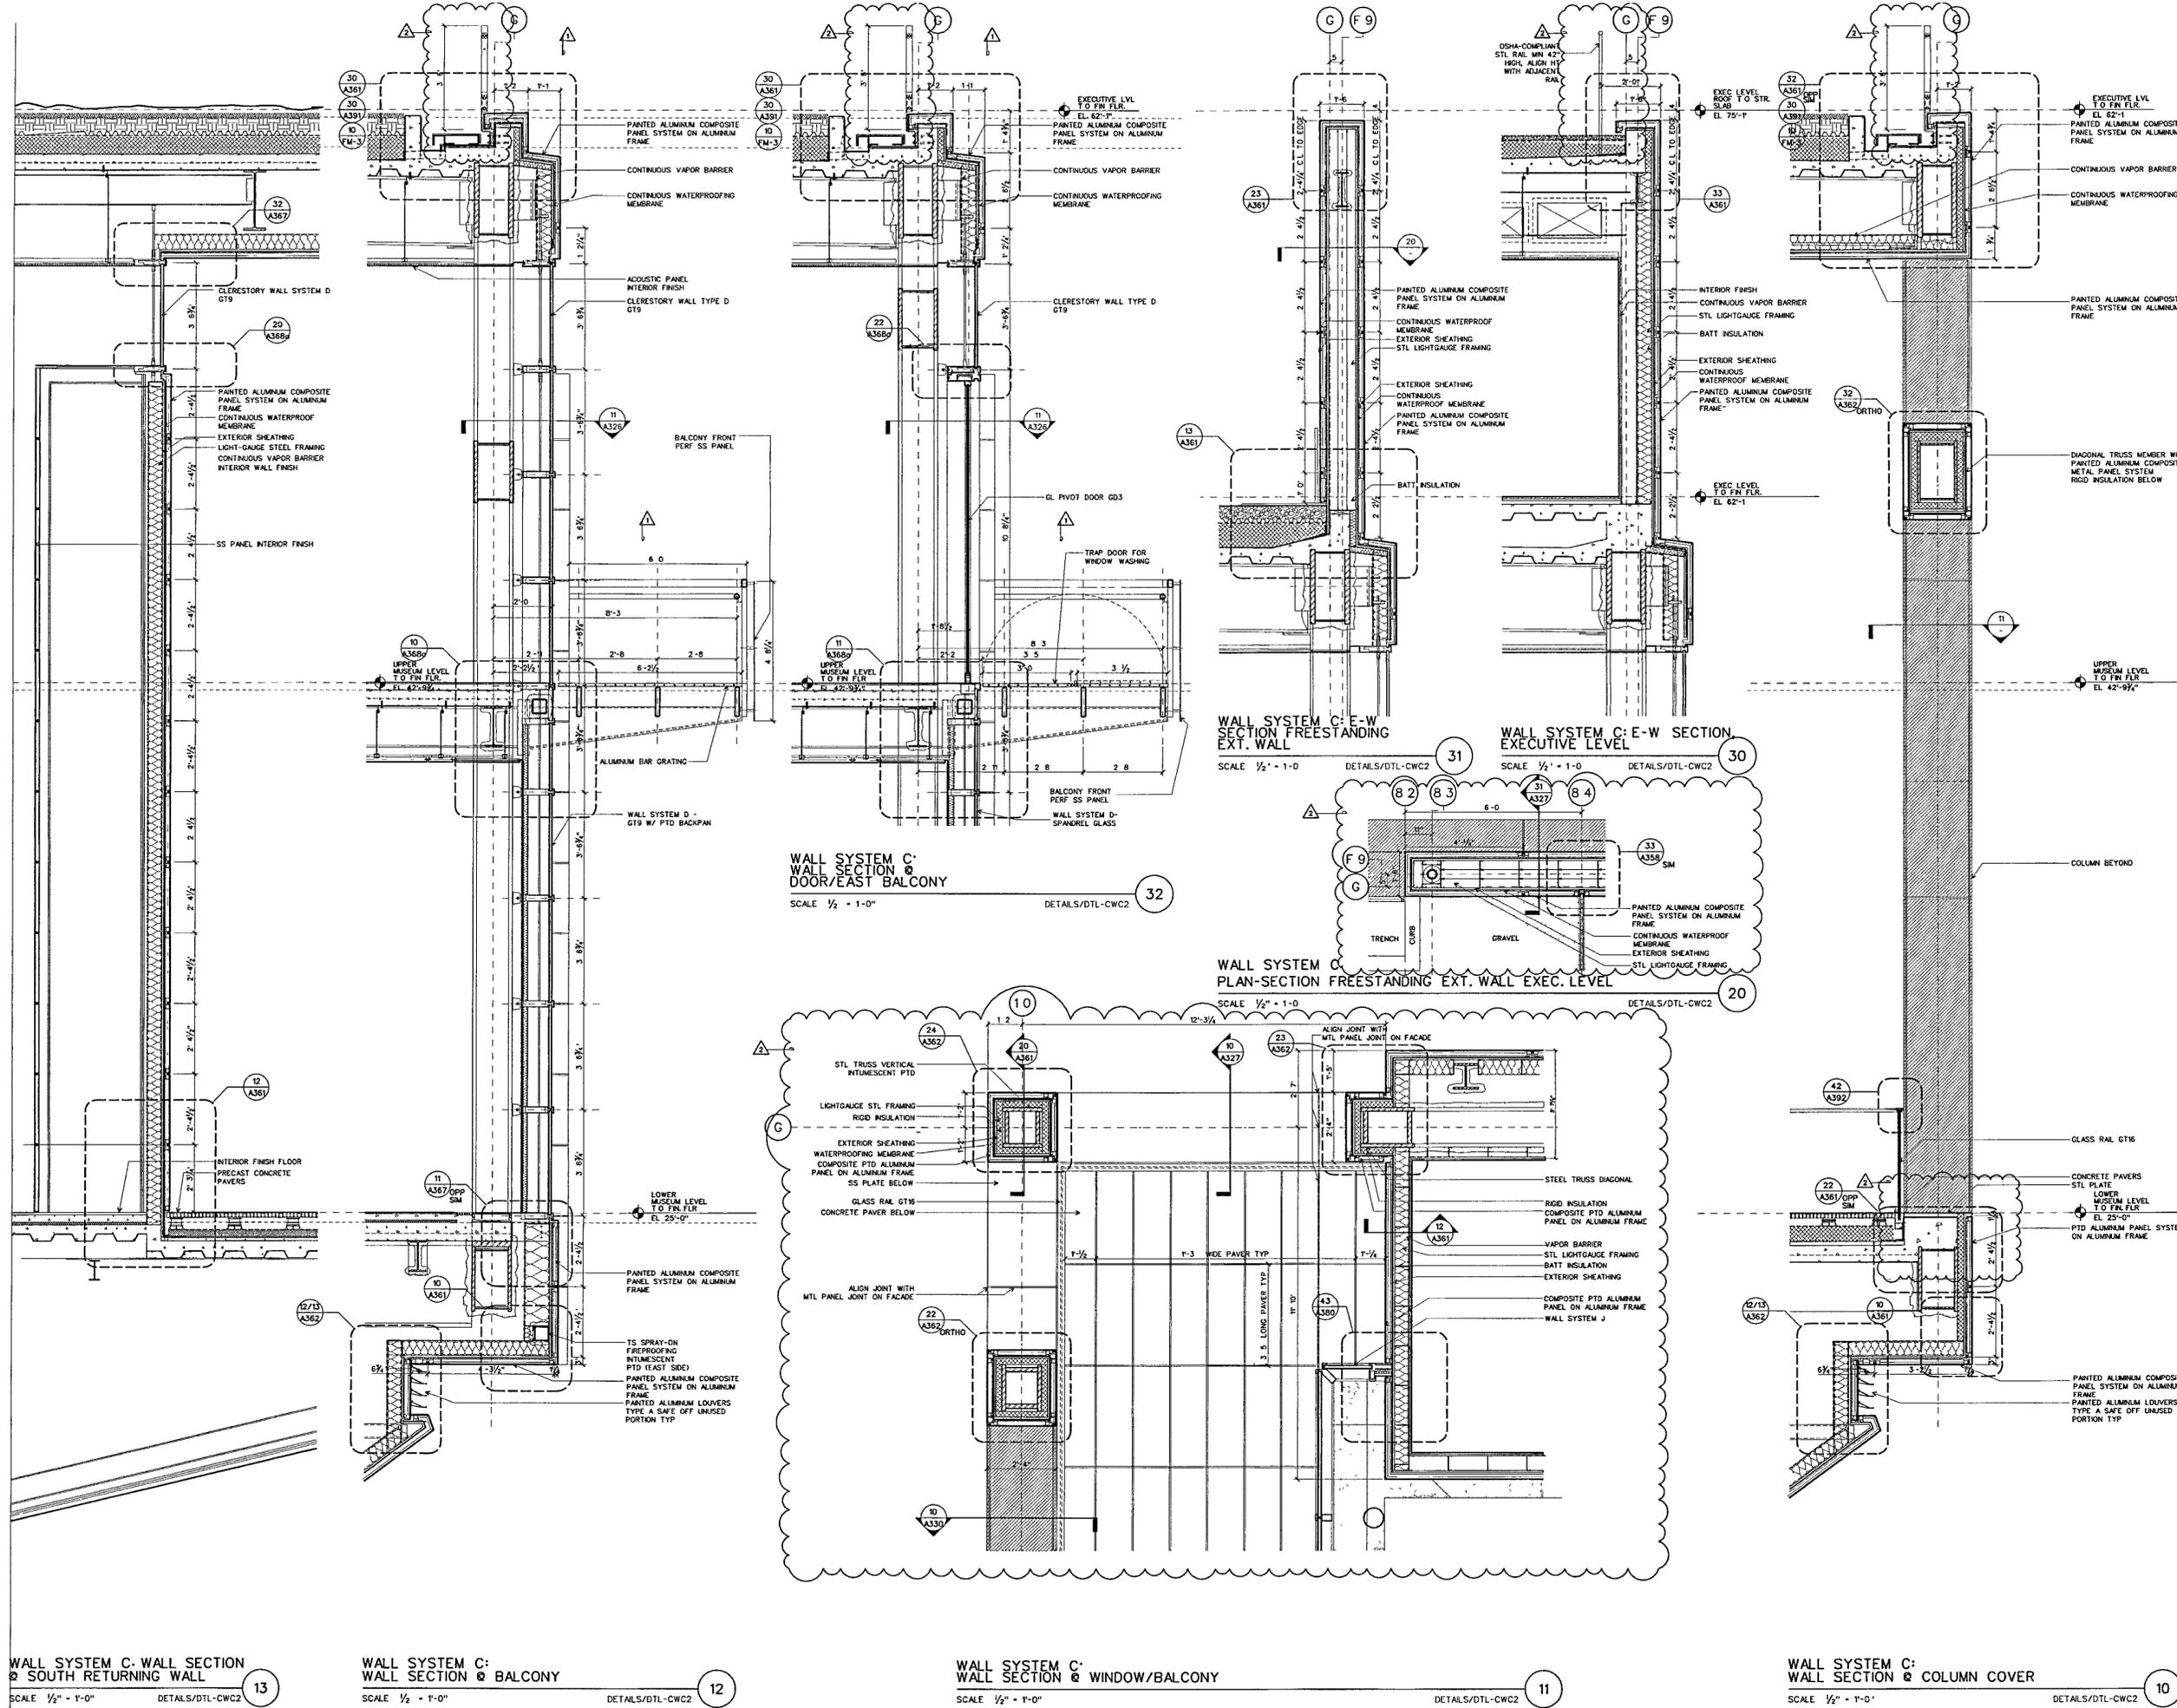

WALL SYSTEM C: WALL SECTION @ SOUTH RETURNING WALL

WALL SYSTEM C: WALL SECTION @ BALCONY

WALL SYSTEM C: WALL SECTION @ WINDOW/BALCONY

WALL SYSTEM C: WALL SECTION @ COLUMN COVER