

**WILLIAM J CLINTON
PRESIDENTIAL
CENTER**

LITTLE ROCK, ARKANSAS

Architect
POLSHEK PARTNERSHIP LLP
320 West 13th Street
New York, New York 10014
212 867 7171

Coordinating Architects
POLK STANLEY YEARY ARCHITECTS LTD
700 South Schiller Street
Little Rock, Arkansas 72201
501 378 0878

WITSELL EVANS RASCO
501 West Third Street
Little Rock, Arkansas 72201
501 374 5300

WOODS CARADINE ARCHITECTS
2200 South Main Street
Little Rock, Arkansas 72206
501 374 4060

Landscape Architects
HARGREAVES ASSOCIATES
118 Magazine Street
Cambridge, Massachusetts 02139
617 661 0070


LANDSCAPE ARCHITECTURE Inc.
2300 Cottondale Lane Suite 202
Little Rock, Arkansas 72202
501 374 5510

Structural Engineer
LESLIE E ROBERTSON ASSOC, RLLP
30 Broad Street, 47th Floor
New York, New York 10004
212 750 9000


MEP Engineers
FLACK + KURTZ Inc.
475 Fifth Avenue
New York, New York 10017
212 532 9000

CROMWELL ARCHITECTS ENGINEERS
101 South Spring Street
Little Rock, Arkansas 72201
501 372 2200

Curtainwall Consultant
R. A. HEINTGES ARCHITECTS
125 Fifth Avenue 9th Floor
New York, New York 10011
212 652-2968

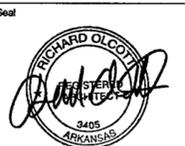

100% Construction Documents	08/27/02
90% Progress Printing	08/30/02
100% Struct / CD Progress	07/01/02
Bridge Bldg Substructure	06/14/02
100% Design Development	03/01/02
Issue	Date

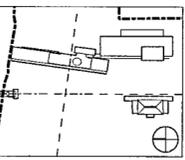

Job No 9908

Scale 1/2" = 1'-0"

Date September 27, 2002


Title

WALL SYSTEM C
PLAN AND SECTIONS

Sheet No

A328

FOR OFFICIAL USE ONLY

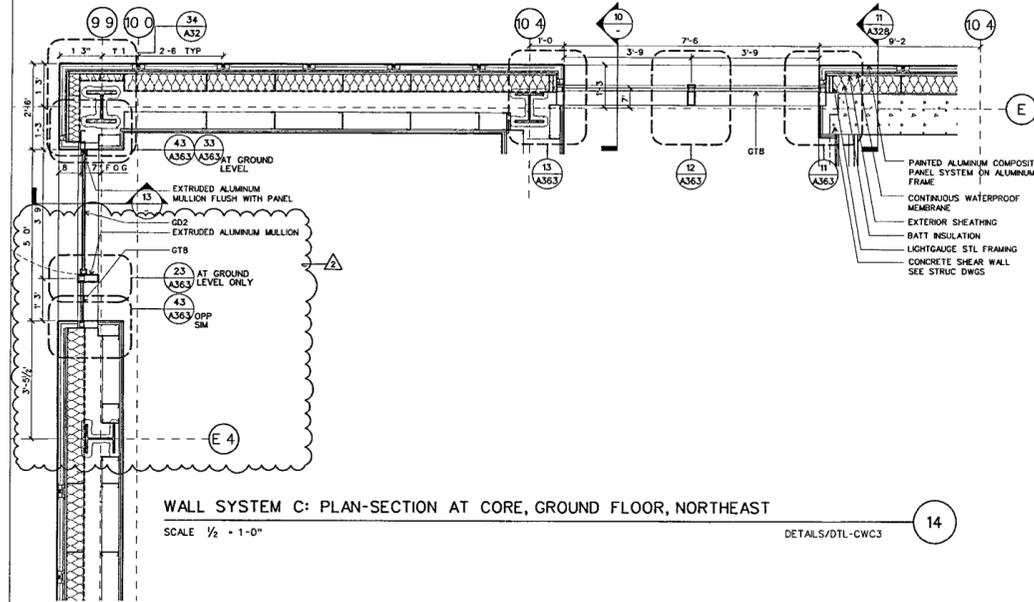


WALL SYSTEM C: PLAN-SECTION AT CORE, GROUND FLOOR, NORTHEAST

SCALE 1/2" = 1'-0"

DETAILS/DTL-CWC3

14

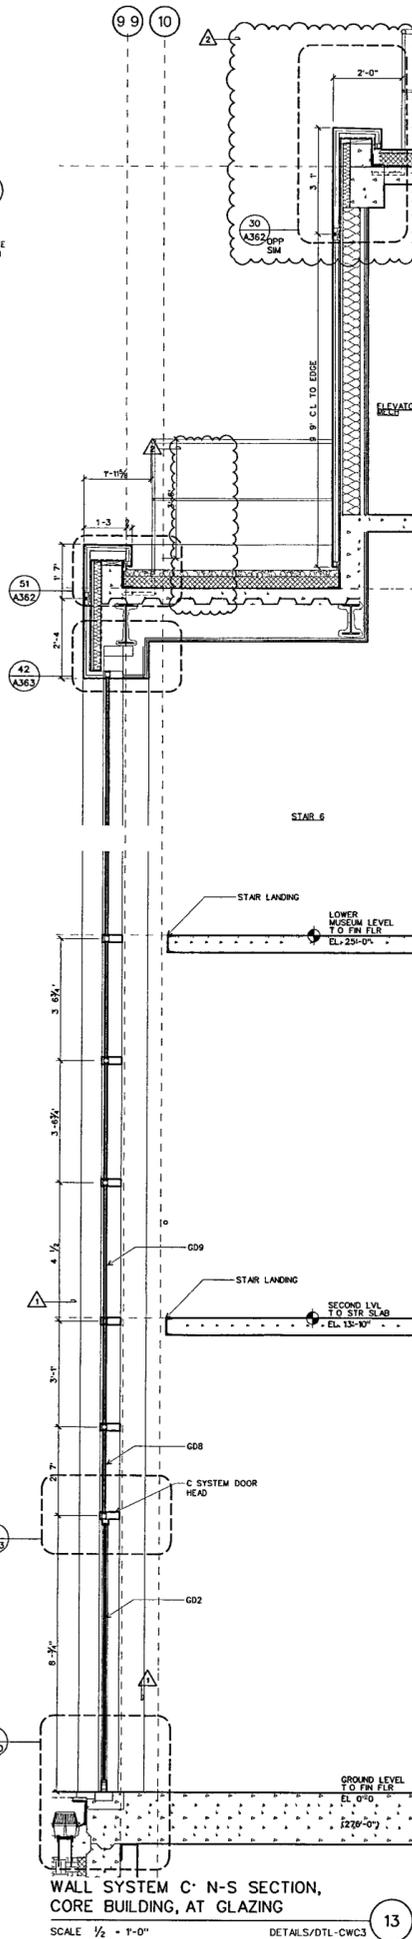


WALL SYSTEM C: N-S SECTION, CORE BUILDING, AT GLAZING

SCALE 1/2" = 1'-0"

DETAILS/DTL-CWC3

13

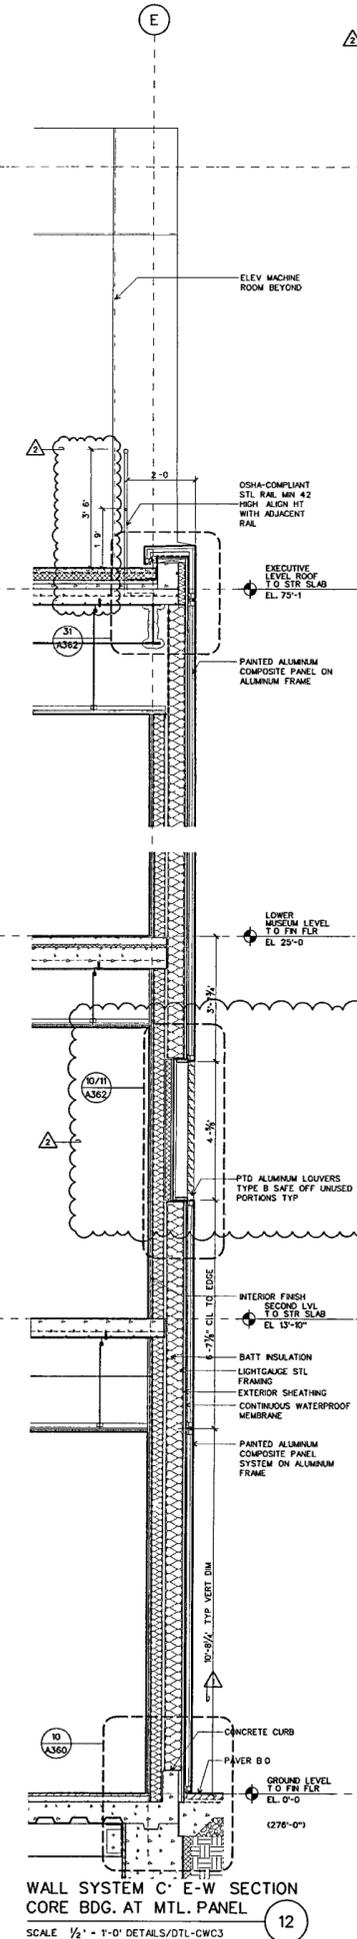


WALL SYSTEM C: E-W SECTION, CORE BLDG. AT MTL. PANEL

SCALE 1/2" = 1'-0"

DETAILS/DTL-CWC3

12

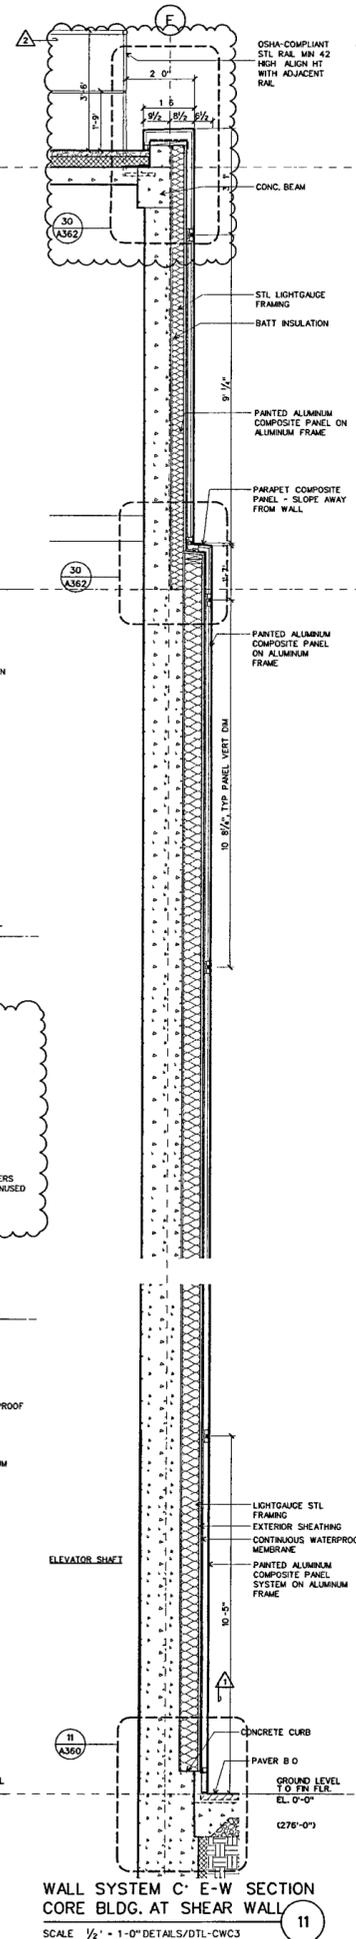


WALL SYSTEM C: E-W SECTION, CORE BLDG. AT SHEAR WALL

SCALE 1/2" = 1'-0"

DETAILS/DTL-CWC3

11

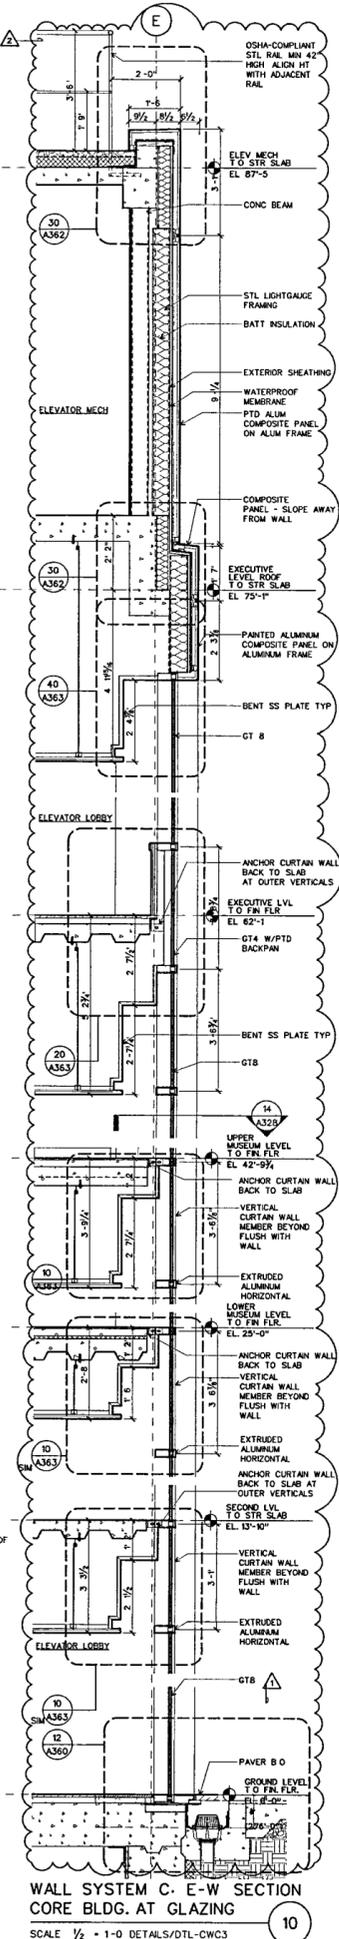

WALL SYSTEM C: E-W SECTION, CORE BLDG. AT GLAZING

SCALE 1/2" = 1'-0"

DETAILS/DTL-CWC3

10