

**WILLIAM J CLINTON
PRESIDENTIAL
CENTER**

LITTLE ROCK, ARKANSAS

Architect
POLSHEK PARTNERSHIP LLP
320 West 13th Street
New York, New York 10014
212 807 7171

Coordinating Architects
POLK STANLEY YEARY ARCHITECTS LTD
700 South Schiller Street
Little Rock, Arkansas 72201
501 378 0878

WITSELL EVANS RASCO
501 West Third Street
Little Rock, Arkansas 72201
501 374 5300

WOODS CARADINE ARCHITECTS
2200 South Main Street
Little Rock, Arkansas 72206
501 374 4060

Landscape Architects
HARGREAVES ASSOCIATES
118 Magazine Street
Cambridge, Massachusetts 02139
617 861 0070

LANDSCAPE ARCHITECTURE, Inc.
2300 Cottondale Lane Suite 202
Little Rock, Arkansas 72202
501 374 5610

Structural Engineer
LESLIE E. ROBERTSON ASSOC. RLLP
30 Broad Street, 47th Floor
New York, New York 10004
212 750 9000


MEP Engineers
FLACK + KURTZ, Inc.
475 Fifth Avenue
New York, New York 10017
212 532 0600

CROMWELL ARCHITECTS ENGINEERS
101 South Spring Street
Little Rock, Arkansas 72201
501 372 2900

Curtainwall Consultant
R. A. HEINTGES ARCHITECTS
425 Fifth Avenue, 9th Floor
New York, New York 10011
212 652 2568




100% Construction Documents	09/27/02
90% Progress Printing	08/30/02
100% Struct./CD Progress*	07/01/02
Issue	Date
*New sheet / former A330 now A331	

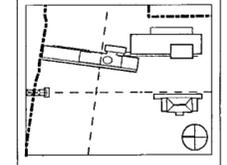


Job No. 9908
Scale AS NOTED
Date September 27, 2002
Title
WALL SYSTEM C SECTION AND DEVELOPED RCP

Sheet No. **A330**

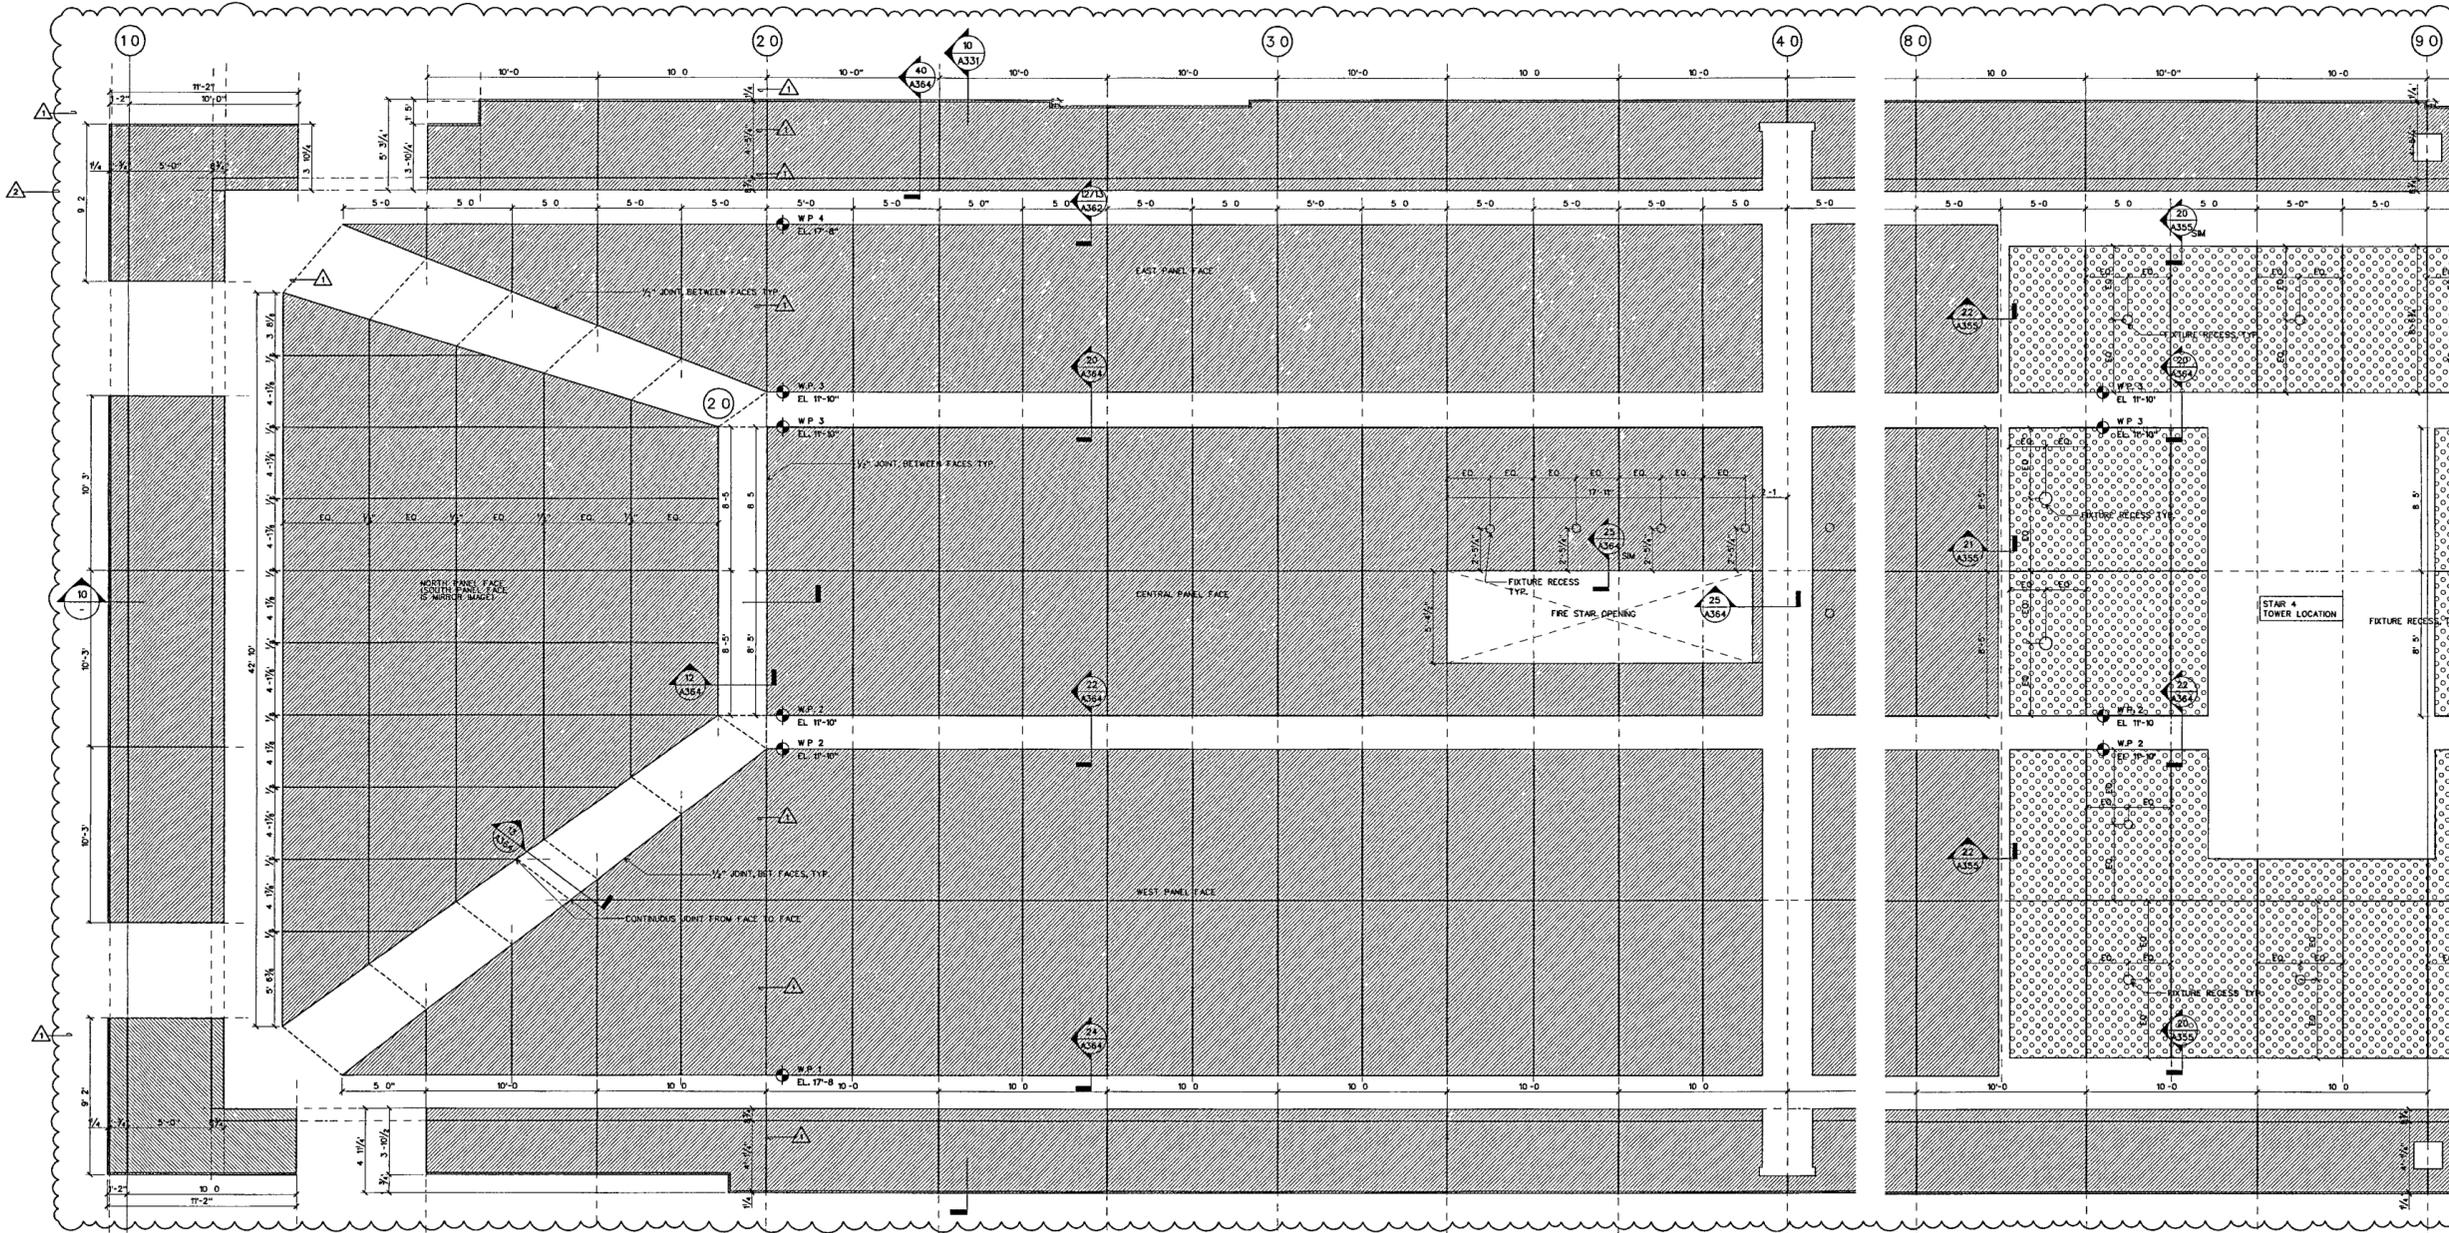

WALL SYSTEM C: DEVELOPED UNDERSIDE PLAN AT NORTH END OF BRIDGE
SCALE 1/4" = 1'-0"

WALL SYSTEM C: DEVELOPED UNDERSIDE PLAN AT NORTH END OF LOBBY
SCALE 1/4" = 1'-0"

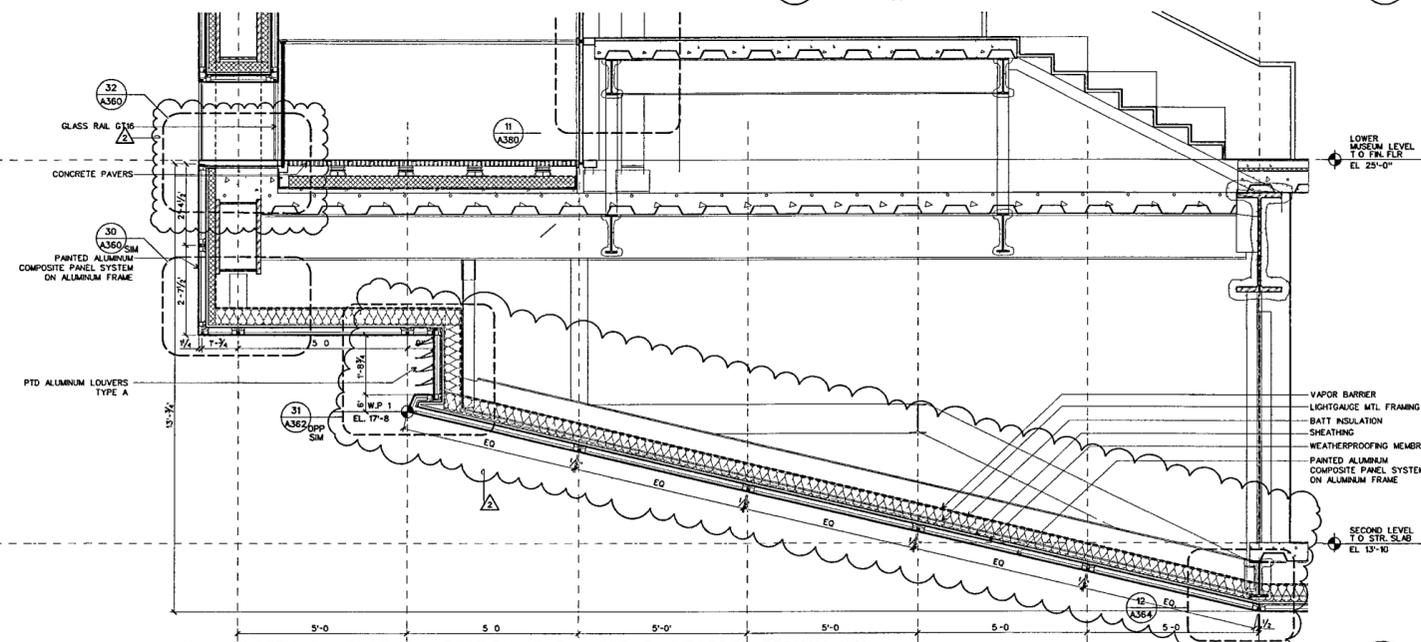

WALL SYSTEM C: LONGITUDINAL SECTION AT CHAMFERING UNDERSIDE TERMINATION
SCALE 1/2" = 1'-0"